

Architect's Supplemental Instructions

Architect's Project No:
04561.01

Architect's ASI No: 010

Project:
Webster University
Interdisciplinary Science
Building

Date Issued: 07/21/2016

Contract Date: 06/24/2016

Reason Code: 05 A/E Scope

Discipline Code: 03 Electrical

Owner:
Webster University

Architect:
Cannon Design
1100 Clark Avenue
St. Louis, MO 63102

Contractor:
Paric Construction

Contract For: General Construction

The Work shall be carried out in accordance with the following supplemental instructions issued in accordance with the Contract Documents without change in Contract Sum or Contract Time. Indicate your acceptance of these instructions for minor change to the Work as consistent with the Contract Documents and return a copy to the Architect within fourteen (14) business days of the date of issuance of these instructions. If you feel a change in Contract Sum or Contract Time is warranted, please submit an itemized quotation for the changes for approval within fourteen (14) business days of the date of issuance of these instructions prior to proceeding on the Work. Proceeding with the Work in accordance with these instructions indicates your acknowledgement that there will be no change.

Attachments:

Drawings:

Sheets E0100, E0101.A, E0503, E0504

St. Louis
Baltimore
Boston
Buffalo
Calgary
Chicago
Houston
Los Angeles
Mumbai
New York
Phoenix
San Francisco
Shanghai
Toronto
Vancouver
Victoria
Washington DC

Architect's Supplemental Instructions

Page 2

Description:

Please submit an itemized proposal for changes in contract Sum and Contract Time for proposed modifications to the Contract Documents described herein:

SHEET E0100 LEVEL 0 FLOOR PLAN – ELECTRICAL

- Changed circuiting for elevator sump pump ESP-1 and sump pump SP-3 to panel 1SL1.
- Changed power for sump pumps SP-1 & SP-2 to panel 1SH1

SHEET E0101.A LEVEL 01 AREA A FLOOR PLAN – ELECTRICAL & AUXILIARY

- Changed circuiting for elevator sump pump ESP-1 to panel 1SL1.

SHEET E0503 PANEL SCHEDULES

- Moved sump pumps from panel BNL1 to 1SL1
- Moved sump pumps from panel BNH1 to 1SH1

SHEET E0504 PANEL SCHEDULES

- Moved sump pumps from panel 1NL1 to 1SL1

Issued by Architect: Bill Shaw, William Tao & Associates, Inc.

Accepted by Contractor:

THE SEALS(S) AND SIGNATURE(S) APPLY ONLY TO THE DOCUMENT TO WHICH THEY ARE AFFIXED, AND EXPRESSLY DISCLAIM ANY RESPONSIBILITY FOR ALL OTHER PLANS, SPECIFICATIONS, ESTIMATES, REPORTS OR OTHER DOCUMENTS OR INSTRUMENTS RELATING TO OR INTENDED TO BE USED FOR ANY PART OR PARTS OF THE ARCHITECTURAL OR ENGINEERING PROJECT.



Webster University
Interdisciplinary Science
Building

CANNONDESIGN

1100 Clark Avenue
St. Louis, Missouri 63102
T: 314.241.6250
F: 314.241.2570

William Tao & Associates, Inc.
MEP/FP Engineer
7955 Manchester Road, Suite 125
St. Louis, MO 63143
314-884-7600

David Mason & Associates, Inc.
Structural & Civil Engineer
800 South Vandeventer Avenue
St. Louis, MO 63110
314.534.1053

Faith Group
Technology
3101 S. Hanley Rd, Suite 100
St. Louis, MO 63143
314.591.2225

Kuhlmann Leavitt, Inc.
Environmental Graphics & Signage
7400 Pershing Ave
St. Louis, MO 63130
314.725.6616

KWA Architects
Architecture
8721 Litzinger Road
St. Louis, MO 63124
314.962.2560

Spellman Brady & Company
Interior Designer
8251 Maryland Avenue, Suite 300
St. Louis, MO 63105
314.862.0070

SWT Design
Landscape Architect
7722 Big Bend Blvd
St. Louis, MO 63119
314.644.5700


Webb Engineering Services, Inc.
Plumbing & Fire Protection
1400 S. 3rd Street, Suite 201
St. Louis, MO 63104
314.588.0600

GENERAL NOTES:

- DO NOT SCALE DRAWINGS. REFER TO ARCHITECTURAL PLANS AND ELEVATIONS FOR LOCATION AND ORIENTATION OF DEVICES. WHERE LOCATIONS ARE NOT INDICATED ON ARCHITECTURAL DRAWINGS, COORDINATE LOCATION AND ORIENTATION OF DEVICES IN FIELD WITH ARCHITECT PRIOR TO ROUGH-IN.
- ALL DEVICES SHOWN ARE NEW UNLESS NOTED OTHERWISE.
- ALL DEVICES TO REMAIN ARE INDICATED WITH A THIN SOLID LINE WEIGHT AND SUBSCRIPT "EX".
- CONTRACTOR SHALL VISIT PRIOR TO BID SUBMITTALS TO DETERMINE SITE CONDITIONS EFFECTING THE EXECUTION OF WORK. FAILURE TO BE ACQUAINTED WITH EXISTING CONDITIONS WILL NOT BE JUSTIFICATION FOR ADDITIONAL SERVICES.
- PROVIDE FACE PLATES ON ALL J-BOXES ABANDONED IN FINISHED FLOOR, WALL OR CEILINGS. COORDINATE COLOR AND FINISH WITH ARCHITECT. CONTRACTOR TO VERIFY QUANTITY IN THE FIELD.
- WHERE EXPOSED CONDUIT IS NOTED, CONTRACTOR SHALL IDENTIFY ROUTING IN FIELD AND OBTAIN ARCHITECT'S APPROVAL OF ROUTING PRIOR TO ROUGH-IN. EXPOSED CONDUIT SHALL BE ROUTED TIGHT TO STRUCTURE.
- ALL SINGLE PHASE BRANCH CIRCUITS SHOWN SHALL HAVE DEDICATED NEUTRALS TO MEET NEC SECTION 210.4 MULTI-WIRE BRANCH CIRCUIT REQUIREMENTS.
- REFER TO TECHNOLOGY DRAWINGS FOR CONDUIT ROUGH-IN OIDATA, VOICE AND A/V.
- ALL 120V BRANCH CIRCUITS ON THIS SHEET SHALL BE FED FROM PANEL BNL1 UNLESS NOTED OTHERWISE.

KEYED NOTES


- E01** REFER TO EQUIPMENT DATA SCHEDULE FOR BRANCH CIRCUIT INFORMATION.
- E12** PROVIDE A DUCT MOUNTED SMOKE DETECTOR IN THE COMBINED SUPPLY DUCT OF AHU-3 & AHU-4. BOTH AIR HANDLING UNITS SHALL SHUT DOWN UPON ACTIVATION OF THE DUCT MOUNTED SMOKE DETECTOR.
- E18** PROVIDE POWER AND FINAL CONNECTION TO ELEVATOR SUMP PUMP. COORDINATE EXACT LOCATION WITH PLUMBING CONTRACTOR PRIOR TO ROUGH-IN.
- E53** COORDINATE QUANTITY AND LOCATION OF TAMPER AND FLOW SWITCHES WITH FIRE PROTECTION CONTRACTOR.
- E55** PROVIDE POWER TO BUILDING AUTOMATION SYSTEM PANEL. COORDINATE LOCATION WITH AUTOMATION CONTRACTOR.
- E78** PROVIDE POWER TO ELECTRONIC TRAP PRIMER FOR A COMPLETE INSTALLATION, REFER TO PLUMBING DRAWINGS FOR EXACT LOCATION.

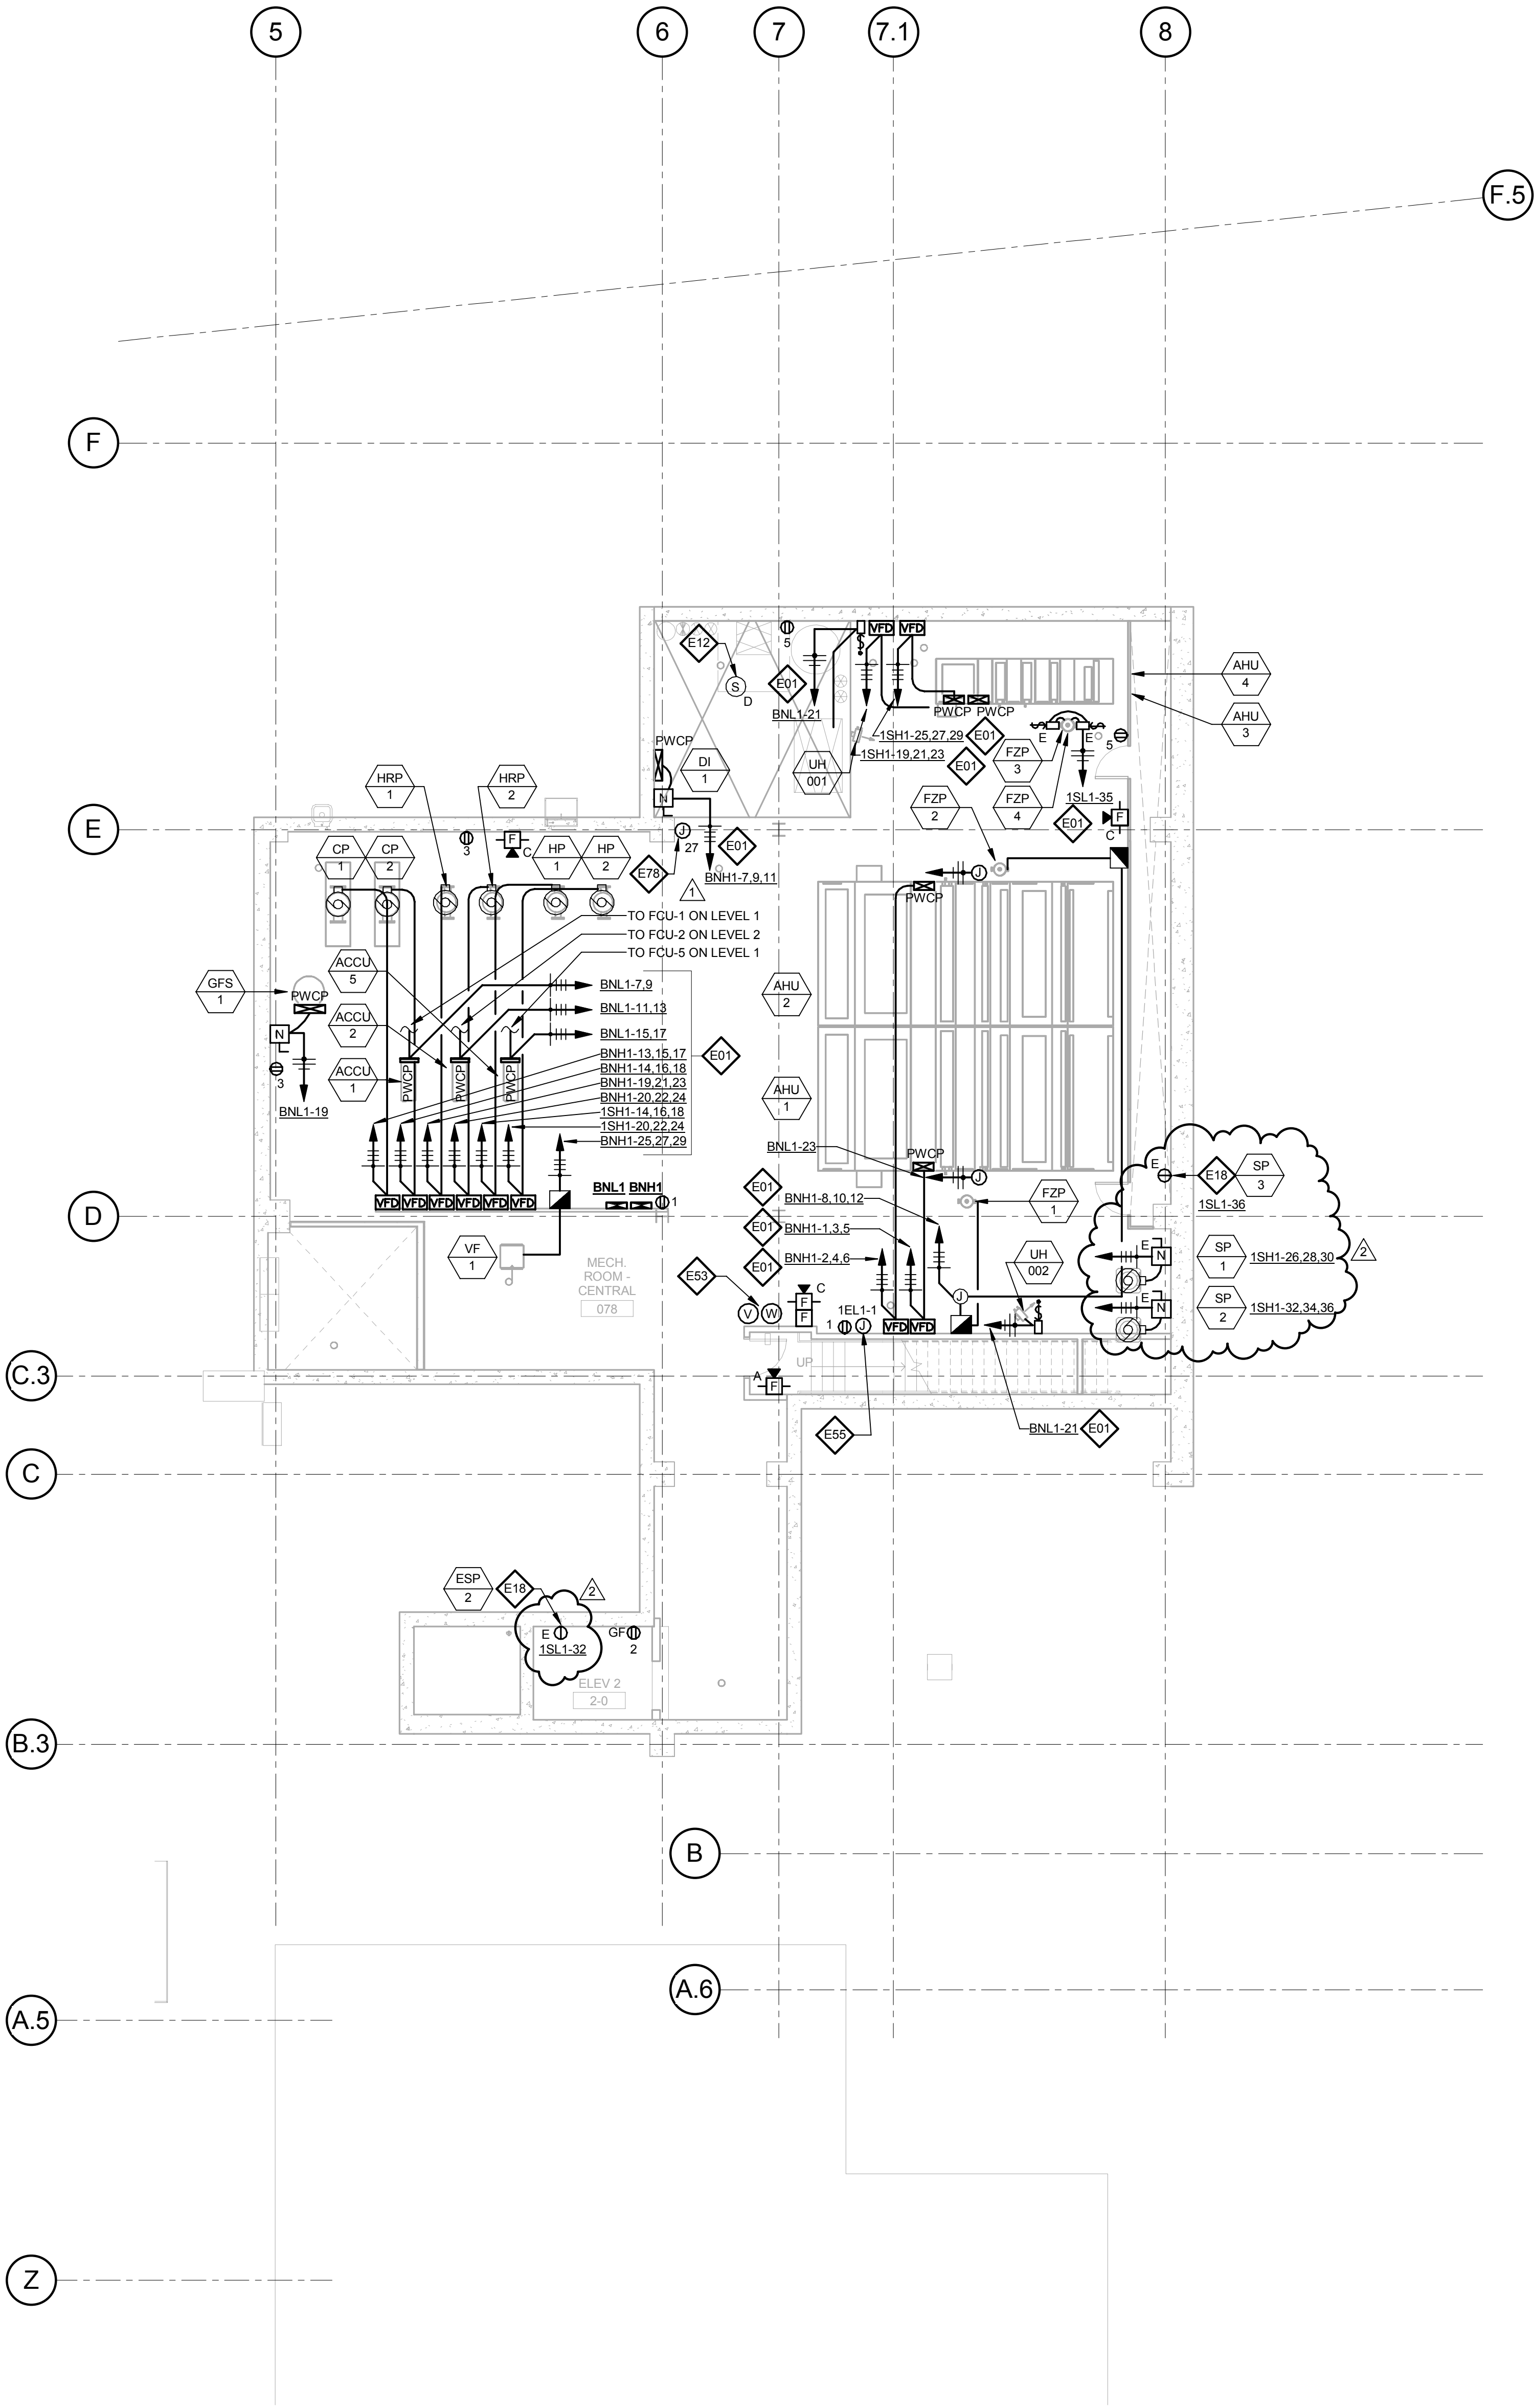

1 LEVEL 00 - AREA A - ELECTRICAL POWER PLAN

1/8" = 1'-0"

2	ASI-010	21 JULY 2016
1	ADDENDUM 2-4	24 MAY 2016
-	ISSUED FOR CONSTRUCTION (BP2)	01 MAR 2016

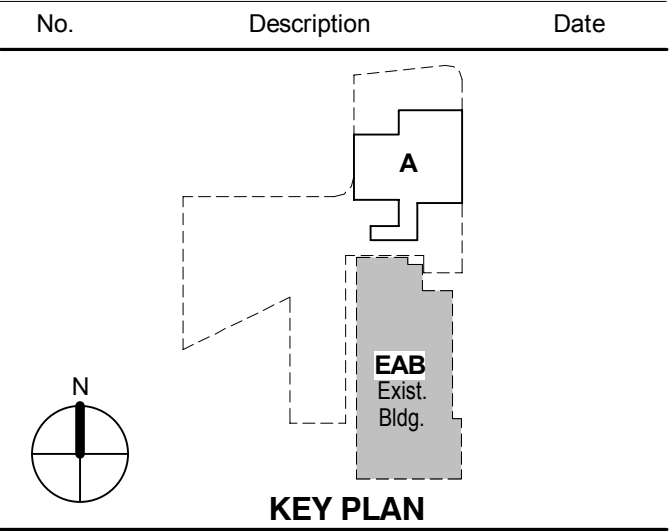

Drawing Title:

LEVEL 00 FLOOR PLAN -
ELECTRICAL

Project No.: 04561.01 Checked by:

E0100

© Cannon Design 2015

© Cannon Design 2016. All rights reserved. No part of this document may be reproduced or transmitted in any form or by any means, electronic or mechanical, including photocopying, recording, or by any information storage and retrieval system, without written authorization by The Cannon Corporation.

7/21/2016 2:28:47 PM


7/21/2016 2:28:47 PM

WTA 14127.01

D:\Autodesk\Revit 2015 Local\14127.01\WU_WTA-ME_BS1.nvt

1 LEVEL 01 - AREA A - FLOOR PLAN - POWER AND AUXILIARY

1/8" = 1'-0"

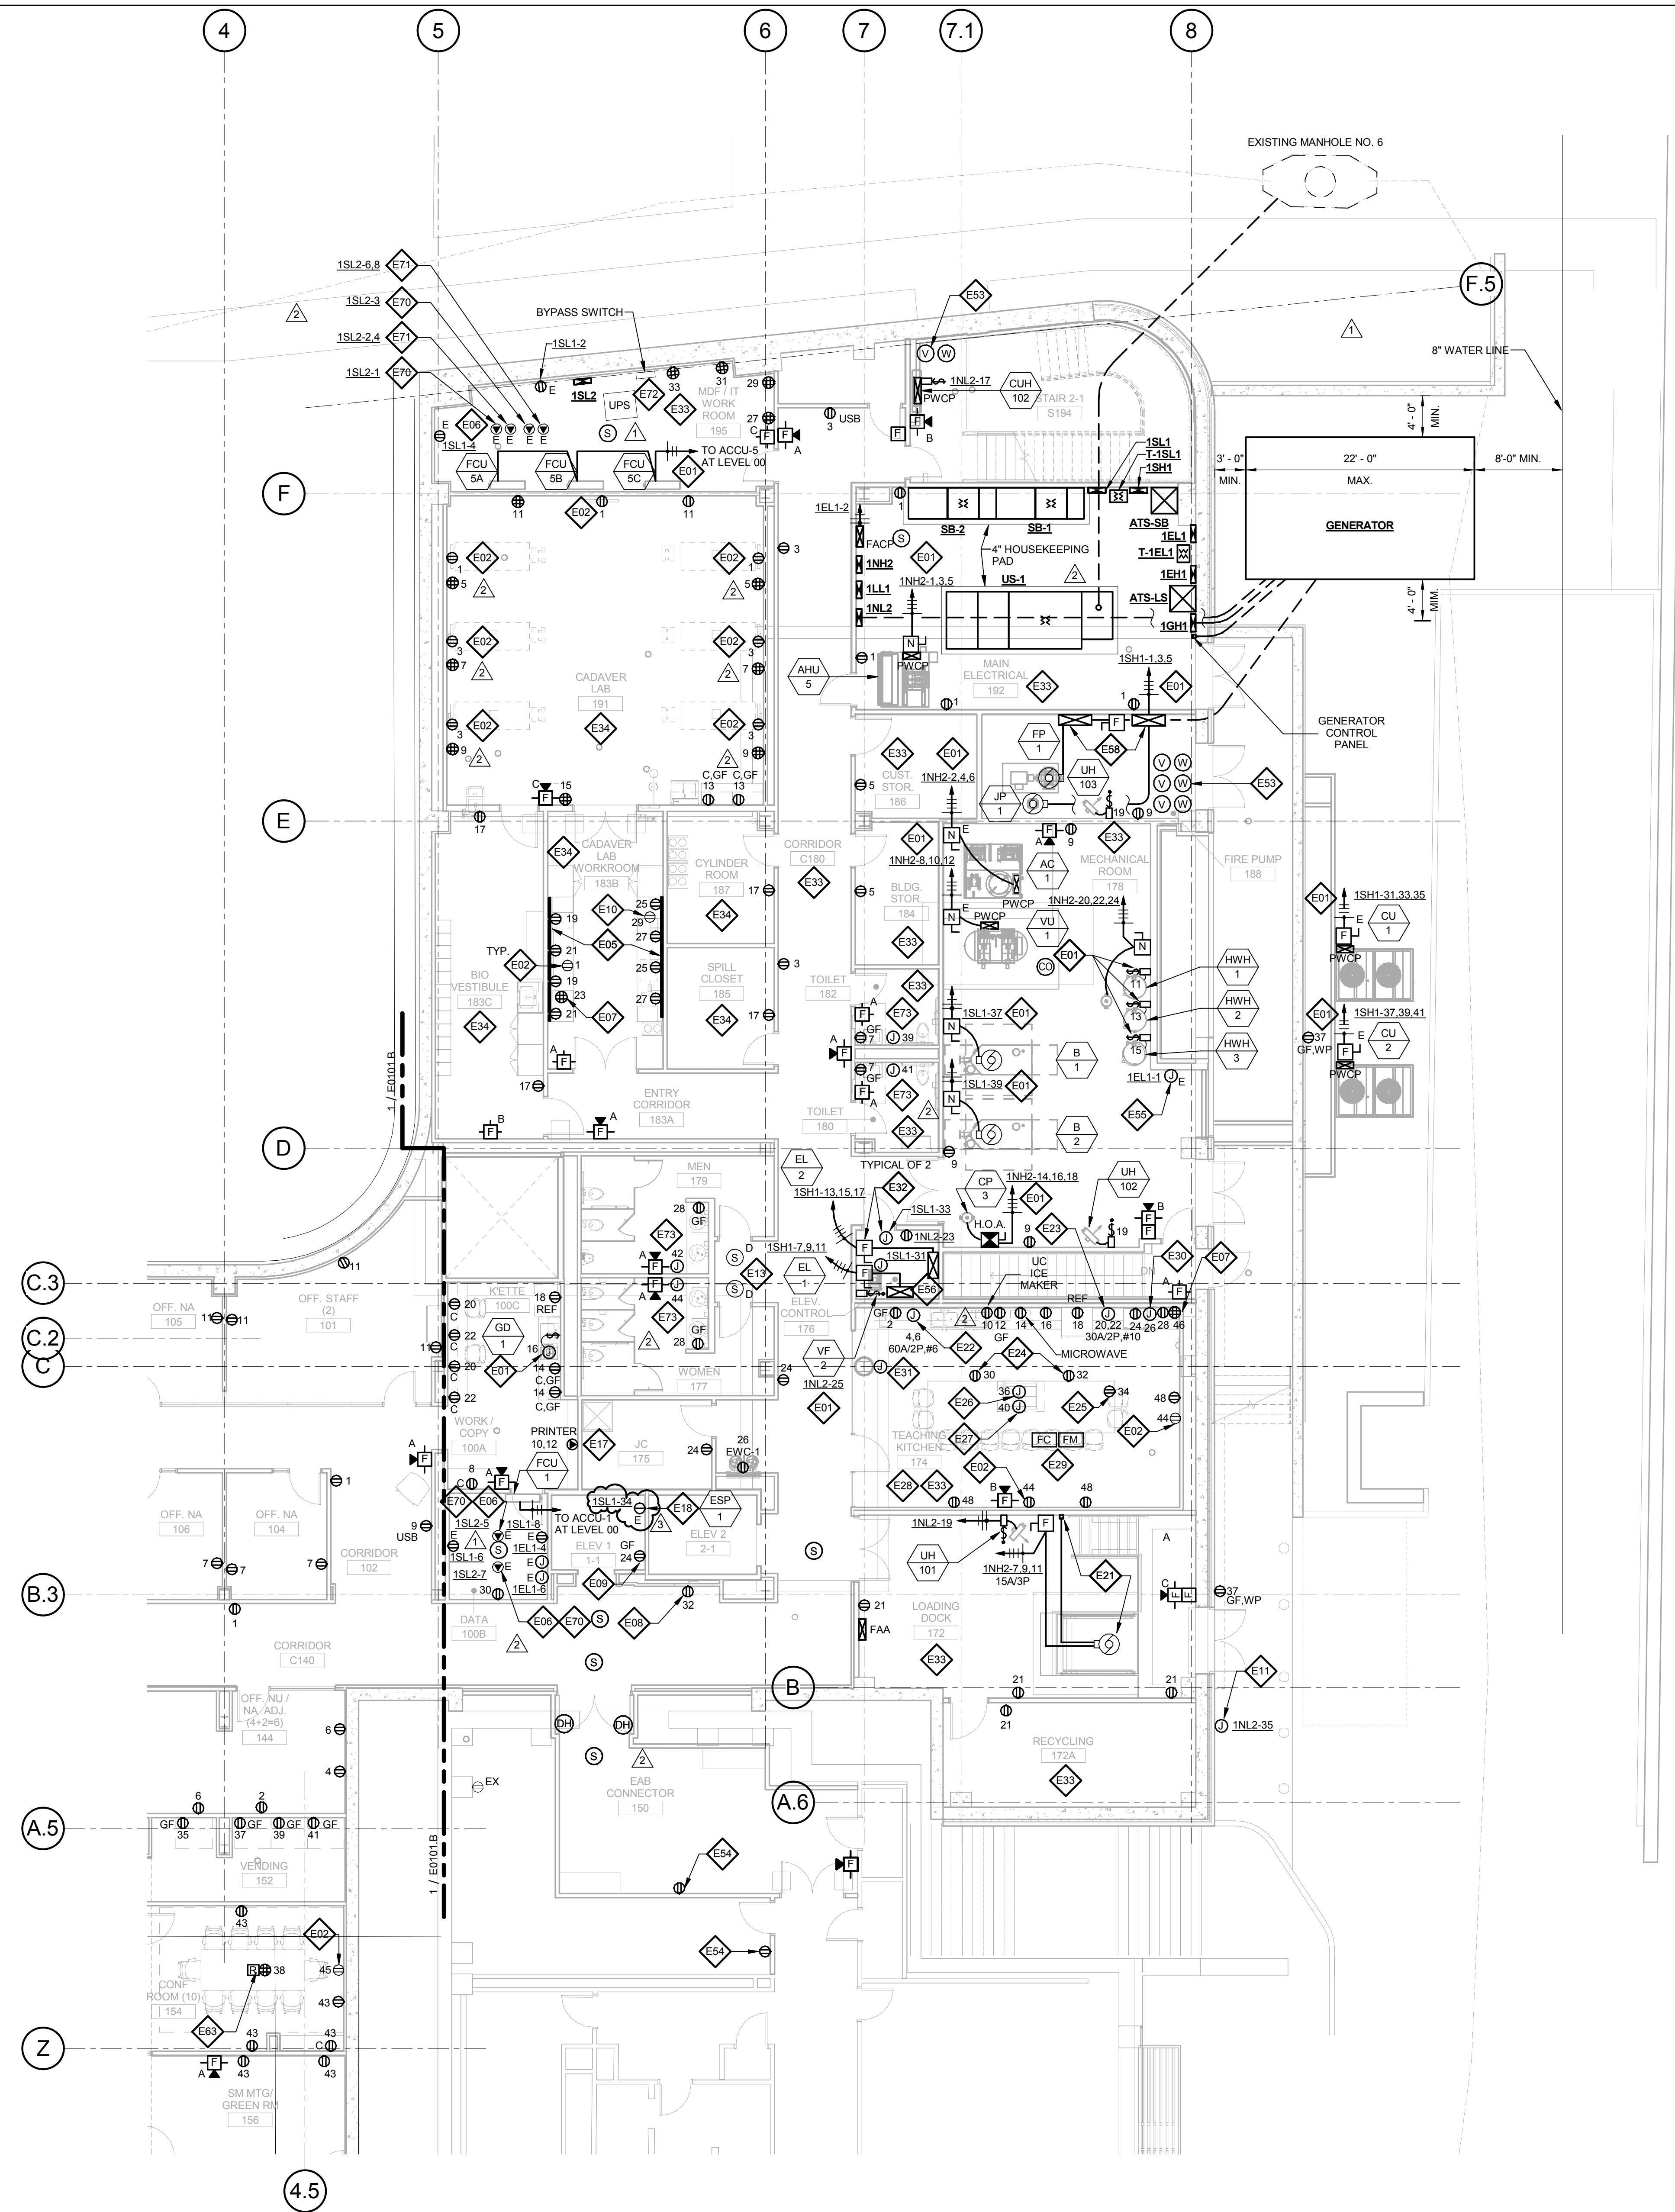

GENERAL NOTES:

- DO NOT SCALE DRAWINGS. REFER TO ARCHITECTURAL PLANS AND ELEVATIONS FOR LOCATION AND ORIENTATION OF DEVICES. WHERE LOCATIONS ARE NOT INDICATED ON ARCHITECTURAL DRAWINGS, COORDINATE LOCATION AND ORIENTATION OF DEVICES IN FIELD WITH ARCHITECT PRIOR TO ROUGH-IN.
- ALL DEVICES SHOWN ARE NEW UNLESS NOTED OTHERWISE.
- ALL DEVICES TO REMAIN ARE INDICATED WITH A THIN SOLID LINE WEIGHT AND SUBSCRIPT "EX".
- CONTRACTOR SHALL VISIT PRIOR TO BID SUBMITTALS TO DETERMINE SITE CONDITIONS EFFECTING THE EXECUTION OF WORK. FAILURE TO BE ACQUAINTED WITH EXISTING CONDITIONS WILL NOT BE JUSTIFICATION FOR ADDITIONAL SERVICES.
- PROVIDE FACE PLATES ON ALL J-BOXES ABANDONED IN FINISHED FLOOR, WALL OR CEILINGS. COORDINATE COLOR AND FINISH WITH ARCHITECT. CONTRACTOR TO VERIFY QUANTITY IN THE FIELD.
- WHERE EXPOSED CONDUIT IS NOTED, CONTRACTOR SHALL IDENTIFY ROUTING IN FIELD AND OBTAIN ARCHITECT'S APPROVAL OF ROUTING PRIOR TO ROUGH-IN. EXPOSED CONDUIT SHALL BE ROUTED TIGHT TO STRUCTURE.
- ALL SINGLE PHASE BRANCH CIRCUITS SHOWN SHALL HAVE DEDICATED NEUTRALS. TO MEET NEC SECTION 210.4 MULTI-WIRE BRANCH CIRCUIT REQUIREMENTS.
- REFER TO TECHNOLOGY DRAWINGS FOR CONDUIT ROUGH-IN OIDA, VOICE AND AV.
- ALL 120V BRANCH CIRCUITS ON THIS SHEET SHALL BE FED FROM PANEL 1NL1 UNLESS NOTED OTHERWISE.

KEYED NOTES

- REFER TO EQUIPMENT DATA SCHEDULE FOR BRANCH CIRCUIT INFORMATION.
- PROVIDE NEW RECEPTACLE FOR MONITOR. COORDINATE MOUNTING HEIGHT WITH ARCHITECTURAL ELEVATIONS AND TECHNOLOGY PLANS.
- PROVIDE NEW TWO SECTION ALUMINUM RACEWAY, WIREMOLD AL4320 WITH RECEPTACLES MOUNTED 24" ON CENTER UNLESS NOTED OR SHOWN OTHERWISE. PROVIDE ALL ACCESSORIES FOR A COMPLETE INSTALLATION. REFER TO ARCHITECTURAL ELEVATIONS FOR MOUNTING HEIGHT AND LENGTH. SEE DETAILS ON SHEET E402.
- OUTLET SHALL BE MOUNTED TO THE BACK SIDE OF THE TELECOMMUNICATION RACK AND FED FROM ABOVE. COORDINATE EXACT MOUNTING HEIGHT AND LOCATION WITH TELECOMMUNICATIONS CONTRACTOR PRIOR TO INSTALLATION.
- OUTLET FOR RACK MOUNTED A/V EQUIPMENT. COORDINATE MOUNTING HEIGHT AND EXACT LOCATION WITH ARCHITECTURAL ELEVATIONS AND A/V DRAWINGS.
- OUTLET FOR DIGITAL SIGNAGE. COORDINATE MOUNTING HEIGHT AND EXACT LOCATION WITH ARCHITECTURAL ELEVATIONS AND A/V DRAWINGS.
- MOUNT RECEPTACLE IN ELEVATOR PIT. COORDINATE EXACT LOCATION WITH ELEVATOR CONTRACTOR.
- UNDERCOUNTER REFRIGERATOR. COORDINATE EXACT LOCATION AND MOUNTING HEIGHT WITH ARCHITECTURAL PLANS AND ELEVATIONS.
- PROVIDE POWER AND FINAL CONNECTION TO WALL MOUNTED BLUE LIGHT EMERGENCY INTERCOM STATION.
- PROVIDE A DUCT MOUNTED SMOKE DETECTOR(S) AT RETURN AIR GRILLE OF AHU-1 & AHU-2. BOTH AIR HANDLING UNITS SHALL SHUT DOWN UPON ACTIVATION OF THE DUCT MOUNTED SMOKE DETECTOR(S). PROVIDE REMOTE INDUCTOR LIGHT(S) IN CEILING BELOW.
- PROVIDE NEMA 6-30R, 30A-208V RECEPTACLE FOR PRINTER. CONTRACTOR SHALL VERIFY PRINTER PLUG TYPE WITH OWNERS REPRESENTATIVE PRIOR TO ROUGH-IN.
- PROVIDE POWER AND FINAL CONNECTION TO ELEVATOR SUMP PUMP. COORDINATE EXACT LOCATION WITH PLUMBING CONTRACTOR PRIOR TO ROUGH-IN.
- PROVIDE POWER AND FINAL CONNECTION TO DOCK LEVELER AND CONTROLS PER MANUFACTURERS WRITTEN INSTRUCTIONS. COORDINATE CONTROL AND DISCONNECT LOCATION WITH DOCK LEVELER INSTALLER PRIOR TO INSTALLATION.
- PROVIDE POWER AND FINAL CONNECTION TO DISH WASHER. REFER TO KITCHEN EQUIPMENT DRAWINGS FOR ADDITIONAL INFORMATION.
- PROVIDE POWER AND FINAL CONNECTION TO DOUBLE OVEN. REFER TO KITCHEN EQUIPMENT DRAWINGS FOR ADDITIONAL INFORMATION.
- RECEPTACLE MOUNTED IN COUNTER APRON. REFER TO ARCHITECTURAL DRAWINGS AND ELEVATIONS FOR EXACT LOCATION.
- RECEPTACLE MOUNTED INSIDE CABINET FOR COMPUTER. REFER TO ARCHITECTURAL DRAWINGS AND ELEVATIONS FOR EXACT LOCATION.
- PROVIDE POWER AND FINAL CONNECTION TO DROP IN COOK TOP. REFER TO KITCHEN EQUIPMENT DRAWINGS FOR ADDITIONAL INFORMATION.
- PROVIDE POWER AND FINAL CONNECTION TO ISLAND HOOD. REFER TO KITCHEN EQUIPMENT DRAWINGS FOR ADDITIONAL INFORMATION.
- REFER TO KITCHEN EQUIPMENT DRAWINGS FOR MOUNTING HEIGHTS OF ALL ELECTRICAL DEVICES IN THIS ROOM AND FOR POWER REQUIREMENTS PRIOR TO ROUGH-IN.
- PROVIDE FIRE ALARM MONITOR MODULE AND CONTROL MODULE CONNECTED TO FIRE ALARM SYSTEM AT HOOD. PROVIDE WIRING BETWEEN HOOD AND FIRE SUPPRESSION SYSTEM. REFER TO KITCHEN HOOD EXTINGUISHING SYSTEM WIRING DIAGRAM, ON SHEET E402.
- PROVIDE POWER FOR HOOD FIRE PROTECTION SYSTEM. INTERCONNECT EXHAUST FANS AND MAKE-UP AIR FANS TO MICRO SWITCH IN FIRE PROTECTION CABINET. REFER TO KITCHEN HOOD EXTINGUISHING SYSTEM WIRING DIAGRAM.
- PROVIDE J-BOX AND CONDUIT IN WALL FOR REMOTE MANUAL PULL STATION. REFER TO KITCHEN EQUIPMENT DRAWINGS FOR ADDITIONAL INFORMATION.
- PROVIDE POWER MODULE SWITCH FOR ELEVATOR AND A JUNCTION BOX WITH A 120V/20A CIRCUIT FOR CONNECTION OF ELEVATOR CONTROLS. PROVIDE ALL FINAL CONNECTIONS TO ELEVATOR CONTROLLER AND ELEVATOR CAB PER MANUFACTURERS WRITTEN INSTRUCTIONS. REFER TO ONE-LINE DIAGRAM FOR ADDITIONAL INFORMATION.
- ALL 120V BRANCH CIRCUITS IN THIS ROOM SHALL BE FED FROM PANEL 1NL2.
- ALL 120V BRANCH CIRCUITS IN THIS ROOM SHALL BE FED FROM PANEL 1LL1.
- COORDINATE QUANTITY AND LOCATION OF TAMPER AND FLOW SWITCHES WITH FIRE PROTECTION CONTRACTOR.
- EXTEND CIRCUIT FROM EXISTING RECEPTACLES SERVING THIS AREA.
- PROVIDE POWER TO BUILDING AUTOMATION SYSTEM PANEL. COORDINATE LOCATION WITH AUTOMATION CONTRACTOR.
- SEE ELEVATOR DETAIL ON SHEET E4042 FOR ADDITIONAL POWER & FIRE ALARM REQUIREMENTS.
- FIRE PUMP CONTROLLER AND JOCKEY PUMP CONTROLLER SEE ONE LINE DIAGRAM FOR FEEDER INFORMATION.
- PROVIDE A 2HR FIRE CLASSIFIED 4-GANG MULTI-SERVICE STEEL RECESSED FLOOR BOX EQUAL TO WIREMOLD CAT. NO. RFB45-FC WITH A BRASS FLANGED COVER CAT. NO. FFBTCBS-NA. THE FLOOR BOX SHALL HAVE ALL NECESSARY MOUNTING BRACKETS FOR (2) 20A DUPLEX RECEPTACLE, (1) GANG - DATA/VOICE (SEE TECHNOLOGY DRAWINGS FOR DEVICE TYPES), (1) GANG - AV (SEE AV DRAWINGS FOR DEVICE TYPES). THE BOX SHALL BE INSTALLED PER MANUFACTURERS WRITTEN INSTRUCTIONS SO THAT THE COVER IS FLUSH WITH THE FLOOR.
- PROVIDE NEMA L5-20R, 20A-120V TWIST LOCK RECEPTACLE FOR RACK MOUNTED PDU. COORDINATE EXACT LOCATION AND MOUNTING HEIGHT WITH TECHNOLOGY CONTRACTOR.
- PROVIDE NEMA L5-20R, 30A-208V TWIST LOCK RECEPTACLE FOR RACK MOUNTED PDU. COORDINATE EXACT LOCATION AND MOUNTING HEIGHT WITH TECHNOLOGY CONTRACTOR.
- UPS AND EXTERNAL BYPASS SWITCH FURNISHED BY OWNER AND INSTALLED BY CONTRACTOR. REFER TO TECHNOLOGY DRAWINGS AND ONE-LINE DIAGRAM FOR ADDITIONAL INFORMATION.
- PROVIDE POWER AND FINAL CONNECTIONS FOR ELECTRIC HAND DRYER.

THE SEAL(S) AND SIGNATURE(S) APPLY ONLY TO THE DOCUMENT TO WHICH THEY ARE AFFIXED, AND EXPRESSLY DISCLAIM ANY RESPONSIBILITY FOR ALL OTHER PLANS, SPECIFICATIONS, ESTIMATES, REPORTS OR OTHER DOCUMENTS OR INSTRUMENTS RELATING TO OR INTENDED TO BE USED FOR ANY PART OR PARTS OF THE ARCHITECTURAL OR ENGINEERING PROJECT.



Webster University
Interdisciplinary Science
Building

CANNONDESIGN

1100 Clark Avenue
St. Louis, Missouri 63102
T: 314.241.6250
F: 314.241.2570

William Tao & Associates, Inc.
MEP/FP Engineer
7955 Manchester Road, Suite 125
St. Louis, MO 63143
314-884-7600

David Mason & Associates, Inc.
Structural & Civil Engineer
800 South Vandeventer Avenue
St. Louis, MO 63110
314.534.1053

Faith Group
Technology
3101 S. Hanley Rd., Suite 100
St. Louis, MO 63143
314.591.2229

Kuhlmann Leavitt, Inc.
Environmental Graphics & Signage
7400 Pershing Ave.
St. Louis, MO 63130
314.725.6616

KWA Architects
Architecture
8721 Litzinger Road
St. Louis, MO 63124
314.962.2560

Spellman Brady & Company
Interior Designer
8251 Maryland Avenue, Suite 300
St. Louis, MO 63105
314.862.0070

SWT Design
Landscape Architect
7722 Big Bend Blvd.
St. Louis, MO 63119
314.644.5700

Webb Engineering Services, Inc.
Planning & Fire Protection
1400 S. 3rd Street, Suite 201
St. Louis, MO 63104
314.588.0600

3	ASH-010	21 JULY 2016
2	ADDENDUM 2-2	19 APRIL 2016
1	ADDENDUM 2-1	17 MAR 2016
-	ISSUED FOR CONSTRUCTION (BP2)	01 MAR 2016

No.	Description	Date
1	KEY PLAN	

KEY PLAN

LEVEL 01 AREA A FLOOR PLAN - ELECTRICAL & AUXILIARY

Project No.: 04561.01

Checked by:

E0101.A

© Cannon Design 2016

THE SEAL(S) AND SIGNATURE(S) APPLY ONLY TO THE DOCUMENT TO WHICH THEY ARE AFFIXED, AND EXPRESSLY DISCLAIM ANY RESPONSIBILITY FOR ALL OTHER PLANS, SPECIFICATIONS, ESTIMATES, REPORTS OR OTHER DOCUMENTS OR INSTRUMENTS RELATING TO OR INTENDED TO BE USED FOR ANY PART OR PARTS OF THE ARCHITECTURAL OR ENGINEERING PROJECT.



Webster University
Interdisciplinary Science
Building

CANNONDESIGN

1100 Clark Avenue
St. Louis, Missouri 63102
T: 314.241.6250
F: 314.241.2570

William Tao & Associates, Inc.
MEP/FP Engineer
7955 Manchester Road, Suite 125
St. Louis, MO 63143
314-884-7600

David Mason & Associates, Inc.
Structural & Civil Engineer
800 South Vandeventer Avenue
St. Louis, MO 63110
314.534.1053

Faith Group
Technology
3101 S. Hanley Rd., Suite 100
St. Louis, MO 63143
314.591.2228

Kuhlmann Leavitt, Inc.
Environmental Graphics & Signage
7400 Pershing Ave.
St. Louis, MO 63130
314.725.6616

KWA Architects
Architecture
8721 Litzinger Road
St. Louis, MO 63124
314.962.2560

Spellman Brady & Company
Interior Designer
8251 Maryland Avenue, Suite 300
St. Louis, MO 63105
314.862.0070

SWT Design
Landscape Architect
7722 Big Bend Blvd.
St. Louis, MO 63119
314.644.5700

Webb Engineering Services, Inc.
Plumbing & Fire Protection
1400 S. 3rd Street, Suite 201
St. Louis, MO 63104
314.588.0600

4 ASI-010 21 JULY 2016
3 ADDENDUM 2-4 24 MAY 2016
2 ADDENDUM 2-2 19 APRIL 2016
1 ADDENDUM 2-1 17 MAR 2016
- ISSUED FOR CONSTRUCTION (BP2) 01 MAR 2016

Drawing Title:

PANEL SCHEDULES

Project No.: 04561.01 Checked by:

E0503

© Cannon Design 2015

Panel: BNH1

Location:
Supply From: US-1
Mounting: S
Enclosure: Type 1

Volts: 480/277 Wye
Phases: 3
Wires: 4

A.I.C. Rating: 22,000
Mains Type: MCB
Mains Rating: 400 A
MCB Rating:

CKT	Circuit Description	Trip	Poles	A	B	C	Poles	Trip	Circuit Description	CKT
3	AHU-1	180 A	3	22160	22160			3	180 A AHU-2	4
5										6
7				2105	886					8
9	DI-1	15 A	3		2105	886		3	15 A FZP-1 & FZP-2	10
11										12
13				9418	0					14
15	CP-1	70 A	3		9418	0		3	70 A CP-2 (NON SIMULTANEOUS LOAD)	16
17										18
19				5817	0					20
21	HRP-1	45 A	3		5817	0		3	45 A HRP-2 (NON SIMULTANEOUS LOAD)	22
23										24
25				582	0			--	-- Space	26
27	VF-1	15 A	3		582	0		--	-- Space	28
29								--	-- Space	30
31	Space	--	--	0	0			--	-- Space	32
33	Space	--	--		0	0		--	-- Space	34
35	Space	--	--			0	0	--	-- Space	36
37	Mech Room - Central 078 (Lighting)	20 A	1	1216	0			--	-- Space	38
39	Space	20 A	1			0	0	--	-- Space	40
41	Space	20 A	1				0	0	--	42
Total Load:				64344 VA	63128 VA	63128 VA				
Total Amps:				232 A	228 A	228 A				

Notes:

Panel: 1GH1

Location: MAIN ELECTRICAL 192
Supply From: ATS-LS
Mounting: Surface
Enclosure: Type 1

Volts: 480/277 Wye
Phases: 3
Wires: 4

A.I.C. Rating: 22,000
Mains Type: MLO
Mains Rating: 600 A
MCB Rating:

CKT	Circuit Description	Trip	Poles	A	B	C	Poles	Trip	Circuit Description	CKT
1	ATS-LS	225 A	3	6431	73694			3	400 A ATS-SB	2
3										4
5		--	--	0	0			--	-- Space	6
7	Space	--	--					--	-- Space	8
9	Space	--	--		0	0		--	-- Space	10
11	Space	--	--			0	0	--	-- Space	12
13	Space	--	--	0	0			--	-- Space	14
15	Space	--	--		0	0		--	-- Space	16
17	Space	--	--			0	0	--	-- Space	18
19	Space	--	--	0	0			--	-- Space	20
21	Space	--	--		0	0		--	-- Space	22
23	Space	--	--			0	0	--	-- Space	24
25	Space	--	--	0	0			--	-- Space	26
27	Space	--	--		0	0		--	-- Space	28
29	Space	--	--			0	0	--	-- Space	30
Total Load:				80125 VA	77340 VA	77960 VA				
Total Amps:				290 A	279 A	282 A				

Notes:

Panel: 1NH1

Location: ELEC 110B
Supply From: US-1
Mounting: S
Enclosure: Type 1

Volts: 480/277 Wye
Phases: 3
Wires: 4

A.I.C. Rating: 22,000
Mains Type: MCB/SFL
Mains Rating: 175 A
MCB Rating:

CKT	Circuit Description			Trip	Poles	A	B	C	Poles	Trip	Circuit Description			CKT
1	Space			20 A	1	0	1769			1	20 A	Exterior Lighting		2
3	Space			20 A	1		0	2728		1	20 A	Lighting Conf. Rooms, Lecture Hall		4
5	Space			20 A	1			0	1658	1	20 A	Lighting Offices, Exam Rooms,		6
7	Space			20 A	1	0	2103			1	20 A	Lighting Classrooms, Labs		8
9	Space			20 A	1		0	2768		1	20 A	Lighting West Commons, Corridor		10
11	Space			20 A	1			0	2300	1	20 A	Lighting Cadaver Lab, Restrooms, Work/Copy		12
13	Space			20 A	1	0	1679			1	20 A	Lighting Utility Rooms, Kitchen		14
15	Space			20 A	1		0	762		1	20 A	Lighting East Corridor		16
17	Space			20 A	1				0	0	1	20 A	Space	18
19	Space			20 A	1	0	0			1	20 A	Space		20
21	Space			20 A	1			0	0	1	20 A	Space		22
23	Space			20 A	1				0	0	1	20 A	Space	24
25	Space			20 A	1	0	0			1	20 A	Space		26
27	Space			20 A	1			0	0	1	20 A	Space		28
29	Space			20 A	1				0	0	1	20 A	Space	30
31	Space		--	--	--	0	0			--	--	Space		32
33	Space		--	--	--		0	0		--	--	Space		34
35	Space		--	--	--				0	0	--	--	Space	36
37	Space		--	--	--	0	0			--	--	Space		38
39	Space		--	--	--		0	0		--	--	Space		40
41	Space		--	--	--				0	0	--	--	Space	42
Total Load:						5551 VA	6258 VA	3958 VA						
Total Amps:						21 A	23 A	14 A						

Notes:

Panel: 1EL1

Location: MAIN ELECTRICAL 192
Supply From: T-1EL1
Mounting: Surface
Enclosure: Type 1

Volts: 120/208 Wye
Phases: 3
Wires: 4

A.I.C. Rating: 10,000
Mains Type: MCB
Mains Rating: 100 A
MCB Rating:

CKT	Circuit Description	Trip	Poles	A	B	C	Poles	Trip	Circuit Description	CKT
1	MECHANICAL ROOM 078 - BAS	20 A	1	360	100			1	20 A MAIN ELECTRICAL 192 - FACP	2
3	110B, 210B, 310A, 410 - BAS	20 A	1		1060	180		1	20 A DATA 100B - SECURITY EQUIPMENT	4
5	Elec 110B - Fire Door	15 A	1			1176	180	1	20 A DATA 100B - SECURITY EQUIPMENT	6
7	Elec 210B - Fire Door	15 A	1	1176	180			1	20 A DATA 200B - SECURITY EQUIPMENT	8
9	Elec 310A - Fire Door	15 A	1		1176	180		1	20 A DATA 200B - SECURITY EQUIPMENT	10
11	Elec 410 - Fire Door	15 A	1			1176	180	1	20 A DATA 300B - SECURITY EQUIPMENT	12
13	Spare	20 A	1	0	180			1	20 A DATA 400B - SECURITY EQUIPMENT	14
15	Spare	20 A	1		0	0		1	20 A Spare	16
17	Spare	20 A	1			0	0	1	20 A Spare	18
19	Spare	20 A	1	0	0			1	20 A Spare	20
21	Spare	20 A	1		0	0		1	20 A Spare	22
23	Spare	20 A	1			0	0	1	20 A Spare	24
25	Space	--	--	0	0			--	-- Space	26
27	Space	--	--		0	0		--	-- Space	28
29	Space	--	--			0	0	--	-- Space	30
Total Load:				1996 VA	2596 VA	2712 VA				
Total Amps:				17 A	22 A	23 A				

Notes:

Panel: 1EH1

Location: MAIN ELECTRICAL 192
Supply From: ATS-LS
Mounting: S
Enclosure: Type 1

Volts: 480/277 Wye
Phases: 3
Wires: 4

A.I.C. Rating: 22,000
Mains Type: MCB
Mains Rating: 225 A
MCB Rating:

CKT	Circuit Description	Trip	Poles	A	B	C	Poles	Trip	Circuit Description	CKT
1	T-1EL1, 1EL1	45 A	3	1996	555			1	20 A Exterior Site Lighting	2
3					2596	278		1	20 A Mech Room - Central 078 (Lighting)	4
5	West Exterior Emerg. Lighting	20 A	1	456	1823			1	20 A 1st Floor West Emerg. Lighting	6
7	North Stair Lighting	20 A	1		532	1434		1	20 A 1st Floor East Emerg. Lighting	8
11	West Stair Lighting	20 A	1			532	2870	1	20 A 2nd Floor West Emerg. Lighting	10
13	Spare	20 A	1	0	2987			1	20 A 2nd Floor East Emerg. Lighting	12
15	Spare	20 A	1		0	3217		1	20 A 3rd Floor Emerg. Lighting	14
17	Spare	20 A	1			0	0	1	20 A 4th Floor Emerg. Lighting	16
19	Spare	20 A	1	0	0			1	20 A Spare	18
21	Spare	20 A	1		0	0		1	20 A Spare	20
23	Spare	20 A	1			0	0	1	20 A Spare	22
25	Spare	20 A	1	0	0			1	20 A Spare	24
27	Spare	20 A	1		0	0		1	20 A Spare	26
29	Spare	20 A	1			0	0	1	20 A Spare	28
31	Space	--	--	0	0			--	-- Space	30
33	Space	--	--		0	0		--	-- Space	32
35	Space	--	--			0	0	--	-- Space	34
37	Space	--	--	0	0			--	-- Space	36
39	Space	--	--		0	0		--	-- Space	38
41	Space	--	--			0	0	--	-- Space	40
Total Load:				7818 VA	8057 VA	7900 VA				
Total Amps:				28 A	29 A	29 A				

Notes:

Panel: 1SL1

Location: MAIN ELECTRICAL 192
Supply From: T-1SL1
Mounting: S
Enclosure: Type 1

Volts: 120/208 Wye
Phases: 3
Wires: 4

A.I.C. Rating: 10,000
Mains Type: MCB
Mains Rating: 150 A
MCB Rating:

CKT	Circuit Description	Trip	Poles	A	B	C	Poles	Trip	Circuit Description	CKT
1	Power Rm. 289A - Incinerator	20 A	1	192 180				20 A	MDF Room 195 - Wall	2
3	Spare	20 A	1		0 180			1	20 A MDF Room 195 - Wall	4
5	Power Rm. 289A - (-20) Freezer	20 A	1			1225 180		1	20 A Data 100B - Wall	6
7	Power Rm. 289A - Liquid Nitrogen Dewar	20 A	1	180 180				1	20 A Data 100B - Wall	8
9	Power Rm. 289B	20 A	1		180 180			1	20 A Data 200B - Wall	10
11	Power Rm. 291 - Freezer	20 A	1			600 180		1	20 A Data 200B - Wall	12
13	Power Rm. 391 - Refrigerator	20 A	1	492 180				1	20 A Data 300B - Wall	14
15	Power Rm. 389	20 A	1		180 180			1	20 A Data 300B - Wall	16
17	Power Rm. 374A - Incubator	20 A	1			600 180		1	20 A Data 400B - Wall	18
19	Power Rm. 374A - Incubator	20 A	1	432 180				1	20 A Data 400B - Wall	20
21	Power Rm. 368 - Freezer	20 A	1		600 0			1	20 A Spare	22
23	Spare	20 A	1			0 0		1	20 A Spare	24
25	Power Rm. 374B - (-80) Freezer	20 A	1	1920 0				1	20 A Spare	26
27	Power Rm. 374B - Freezer	20 A	1		984 0			1	20 A Spare	28
29	Organ's Bio Lab 378 - Fish Tank	20 A	1			360 0		1	20 A Spare	30
31	Elevator Control Room 176	20 A	1	180 1176				1	20 A Elevator 2 Pkt - ESP-2	32
33	Elevator Control Room 178	20 A	1		180 1176			1	20 A Elevator 1 Pkt - ESP-2	34
35	Mechanical Room Central 078 - FZP-3 & 4	20 A	1			1056 1176		1	20 A MECHANICAL ROOM 078 - SP-1	36
37	Mechanical Room 178 - B-1	20 A	1	1224 4000						38
39	Mechanical Room 179 - B-2	20 A	1		1224 2500			1	150 A TSL2 (UPS)	40
41	Organ's Bio Lab 378 - Fish Tank	20 A	1			360 2500				42
Total Load:				10516 VA	7564 VA			8417 VA		

THE SEAL(S) AND SIGNATURE(S) APPLY ONLY TO THE DOCUMENT TO WHICH THEY ARE AFFIXED, AND EXPRESSLY DISCLAIM ANY RESPONSIBILITY FOR ALL OTHER PLANS, SPECIFICATIONS, ESTIMATES, REPORTS OR OTHER DOCUMENTS OR INSTRUMENTS RELATING TO OR INTENDED TO BE USED FOR ANY PART OR PARTS OF THE ARCHITECTURAL OR ENGINEERING PROJECT.



Webster University
Interdisciplinary Science
Building

CANNONDESIGN

1100 Clark Avenue
St. Louis, Missouri 63102
T: 314.241.6250
F: 314.241.2570

William Tao & Associates, Inc.
ME/PFP Engineer
7955 Manchester Road, Suite 125
St. Louis, MO 63143
314-884-7600

David Mason & Associates, Inc.
Structural & Civil Engineer
800 South Vandeventer Avenue
St. Louis, MO 63110
314.534.1053

Faith Group
Technology
3101 S. Hanley Rd., Suite 100
St. Louis, MO 63143
314.591.2228

Kuhlmann Leavitt, Inc.
Environmental Graphics & Signage
7400 Pershing Ave.
St. Louis, MO 63130
314.725.6616

KWA Architects
Architecture
8721 Litzinger Road
St. Louis, MO 63124
314.962.2560

Spellman Brady & Company
Interior Designer
8251 Maryland Avenue, Suite 300
St. Louis, MO 63105
314.862.0070

SWT Design
Landscape Architect
7722 Big Bend Blvd.
St. Louis, MO 63119
314.644.5700

Webb Engineering Services, Inc.
Planning & Fire Protection
1400 S. 3rd Street, Suite 201
St. Louis, MO 63104
314.588.0600

Panel: 1NL2

Location: MAIN ELECTRICAL 192
Supply From: SB-1
Mounting: S
Enclosure: Type 1

Volts: 120/208 Wye
Phases: 3
Wires: 4

A.I.C. Rating: 10,000
Main Type: MLO
Mains Rating: 225 A
MCB Rating:

CKT	Circuit Description	Trip	Poles	A	B	C	Poles	Trip	Circuit Description	CKT
1	Main Electrical 192 - Receptacles	20 A	1	720 180				1	20 A Teaching Kitchen 174 - Counter	2
3	Corridor C180 - Receptacles	20 A	1		540 4118			1	60 A Teaching Kitchen 174 - Dish Washer	4
5	Bldg. Stor. 184, Cust. Stor. 186 - Receptacles	20 A	1			360 4118		2	20 A Spare	6
7	Toilet 180, 182 - Receptacles	20 A	1	360 0				1	20 A Teaching Kitchen 174 - Ice Machine	8
9	Mechanical Room 178 - Receptacles	20 A	1		720 1800			1	20 A Teaching Kitchen 174 - Counter	10
11	Mechanical Room 178 - HHW-1	20 A	1			720 180		1	20 A Teaching Kitchen 174 - Microwave	12
13	Mechanical Room 178 - HHW-2	20 A	1	720 1500				1	20 A Teaching Kitchen 174 - Refrigerator	14
15	Mechanical Room 178 - HHW-3	20 A	1		720 180			1	20 A Teaching Kitchen 174 - Double Oven	16
17	Stair 2-1 - CUH-102	15 A	1			40 1000		2	30 A Teaching Kitchen 174 - Island Apron	18
19	Dock 172 - UH-101, Mech Rm 178 UH-102	15 A	1	48 2700				1	20 A Teaching Kitchen 174 - Island Computer	20
21	Loading Dock 172, Recycling 172A - ...	20 A	1		720 2700			1	20 A Teaching Kitchen 174 - Wall Receptacles	22
23	Elevator Control Room - Receptacle	20 A	1			180 180		1	20 A Spare	24
25	Elevator Control Room - VF-2	15 A	1	350 180				1	20 A Spare	26
27	MDF Room - Receptacles	20 A	1		360 180			1	20 A Spare	28
29	MDF Room - Receptacles	20 A	1			360 180		1	20 A Spare	30
31	MDF Room - Receptacles	20 A	1	360 180				1	20 A Spare	32
33	MDF Room - Receptacles	20 A	1		360 180			1	20 A Spare	34
35	BLUE LIGHT EMERGENCY STATION	20 A	1			180 600		1	20 A Spare	36
37	Exterior - East Wall	20 A	1	360 0				1	20 A Spare	38
39	Toilet 182 - Electric Hand Dryer	20 A	1		1490 1800			1	20 A Spare	40
41	Toilet 180 - Electric Hand Dryer	20 A	1			1490 0		1	20 A Spare	42
43	Spare	20 A	1	0 360				1	20 A Spare	44
45	Spare	20 A	1		0 360			1	20 A Spare	46
47	Spare	20 A	1			0 540		1	20 A Spare	48
49	Spare	20 A	1	0 0				1	20 A Spare	50
51	Spare	20 A	1		0 0			1	20 A Spare	52
53	Spare	20 A	1			0 0		1	20 A Spare	54
Total Load:				8018 VA	16228 VA	10128 VA				
Total Amps:				67 A	138 A	87 A				

Notes:

Panel: 1NL1

Location: ELEC 110B
Supply From: SB-1
Mounting: S
Enclosure: Type 1

Volts: 120/208 Wye
Phases: 3
Wires: 4

A.I.C. Rating: 10,000
Main Type: MCB/SFL
Mains Rating: 225 A
MCB Rating:

CKT	Circuit Description	Trip	Poles	A	B	C	Poles	Trip	Circuit Description	CKT
1	Power Elec 11.0B.1	20 A	1	900 VA 360 VA				1	20 A Office NUNNA ADJ 144 - Receptacles	2
3	Power Mock Beds Stor. 7.10	20 A	1		540 VA 360 VA			1	20 A Office NUNNA ADJ 144 - Receptacles	4
5	Power Nursing 7.03.3	20 A	1			540 VA 360 VA		1	20 A Office NUNNA ADJ 144 - Receptacles	6
7	Power Anesthesia 6.08.3	20 A	1	540 VA 180 VA				1	20 A Work/Copy 100A - Counter	8
9	Power Corridor 102 USB	20 A	1		180 VA 180 VA			2	30 A Work/Copy 100A - Printer	10
11	Power Staff (2) 9.06.1	20 A	1			720 VA 180 VA		1	20 A K'tette 100C - Counter	12
13	Power Anesthesia 6.08.2	20 A	1	720 VA 360 VA				1	30 A K'tette 100C - GD-1	14
15	Power Nursing 7.03.2	20 A	1		720 VA 1656...			1	20 A K'tette 100C - Refrigerator	16
17	Power Nursing 7.03.4	20 A	1			720 VA 1000...		1	20 A K'tette 100C - Desk	18
19	Power Nursing 7.03.6	20 A	1	180 VA 360 VA				1	20 A K'tette 100C - Desk	20
21	Power Mock Beds 7.10	20 A	1		720 VA 360 VA			1	20 A Elev 1 Pit, JC 175, Corridor C180	22
23	Power Conf Rm 24 Seats 10.06 Monitor	20 A	1			360 VA 540 VA		1	20 A Elev 1 Pit, JC 175, Corridor C180	24
25	Power Conference Room 24 Seats 10.06	20 A	1	360 VA 370 VA				1	20 A Elev 1 Pit, JC 175, Corridor C180	26
27	Power Conference Room 24 Seats 10.06	20 A	1		540 VA 360 VA			1	20 A Women 177, Men 179	28
29	Power Conference Room 24 Seats 10.06	20 A	1			540 VA 180 VA		1	20 A Data 100B	30
31	Power Conference Room 24 Seats 10.06	20 A	1	360 VA 180 VA				1	20 A Corridor 177 - Digital Signage	32
33	Power Commons-2 10.04-2	20 A	1		540 VA 0 VA			1	20 A Spare	34
35	Power Vending 11.28	20 A	1			180 VA 720 VA		1	20 A Spare	36
37	Power Vending 11.28	20 A	1		180 VA 180 VA			1	20 A Spare	38
39	Power Vending 11.28	20 A	1			180 VA 720 VA		1	20 A Power Conference Room 24 Seats - Shades	40
41	Power Vending 11.28	20 A	1			180 VA 1490...		1	20 A Men 179 - Electric Hand Dryer	42
43	Power Conf Rm 154	20 A	1	1260... 1490...				1	20 A Women 177 - Electric Hand Dryer	44
45	Power Conf Rm 154 Monitor	20 A	1		180 VA 540 VA			1	20 A Power Courtyard Bollard - Receptacles	46
47	Power Sim Mfg/ Green Rm 156 Monitor	20 A	1			180 VA 360 VA		1	20 A Power Courtyard Bollard - Receptacles	48
49	Vest, C153 - Elec Door Opener	20 A	1	360 VA 540 VA				1	20 A Power	50
51	Vest, C153 - CUH-101	15 A	1		40 VA 0 VA			1	20 A Spare	52
53	Fire Protection Room 137A - FPA-1	15 A	1			528 VA 360 VA		1	20 A Exterior Receptacle	54
55	Spare	20 A	1	0 VA 0 VA				1	20 A Spare	56
57	Spare	20 A	1		0 VA 0 VA			1	20 A Spare	58
59	Spare	20 A	1			0 VA 0 VA		1	20 A Spare	60
Total Load:				8890 VA	7816 VA	9136 VA				
Total Amps:				75 A	65 A	78 A				

Notes:

Panel: 1LL1

Location: MAIN ELECTRICAL 192
Supply From: SB-2
Mounting: S
Enclosure: Type 1

Volts: 120/208 Wye
Phases: 3
Wires: 4

A.I.C. Rating: 10,000
Main Type: MLO
Mains Rating: 225 A
MCB Rating:

CKT	Circuit Description	Trip	Poles	A	B	C	Poles	Trip	Circuit Description	CKT
1	Cadaver Lab 191 - Projector / Motorized Screen	20 A	1	720 0				1	20 A Spare	2
3	Cadaver Lab 191 - Monitors	20 A	1		720 0			1	20 A Spare	4
5	Cadaver Lab 191 - Tables	20 A	1			720 0		1	20 A Spare	6
7	Cadaver Lab 191 - Tables	20 A	1	720 0				1	20 A Spare	8
9	Cadaver Lab 191 - Tables	20 A	1		720 0			1	20 A Spare	10
11	Cadaver Lab 191 - Teacher	20 A	1			540 0		1	20 A Spare	12
13	Cadaver Lab 191 - Counter	20 A	1	360 0				1	20 A Spare	14
15	Power CADAVER Lab 191	20 A	1		360 0			1	20 A Spare	16
17	185, 187, 193C - Receptacles	20 A	1			720 0		1	20 A Spare	18
19	Cadaver Lab Workroom 183B - Surface...	20 A	1	360 0				1	20 A Spare	20
21	Cadaver Lab Workroom 183B - Surface...	20 A	1		360 0			1	20 A Spare	22
23	Cadaver Lab Workroom 183B - A/V Cabinet	20 A	1			180 0		1	20 A Spare	24
25	Cadaver Lab Workroom 183B - Surface...	20 A	1	360 0				1	20 A Spare	26
27	Cadaver Lab Workroom 183B - Surface...	20 A	1		360 0			1	20 A Spare	28
29	Cadaver Lab Workroom 183B - UC Refrigerator	20 A	1			500 0		1	20 A Spare	30
31		20 A	1	0				1	20 A Spare	32
33		20 A	1		0			1	20 A Spare	34
35	Spare	20 A	1			0 0		1	20 A Spare	36
37	Spare	20 A	1	0 0				1	20 A Spare	38
39	Spare	20 A	1		0 0			1	20 A Spare	40
41	Spare	20 A	1			0 0		1	20 A Spare	42
Total Load:				2520 VA	2520 VA	2660 VA				
Total Amps:				21 A	21 A	22 A				

Notes:

Panel: 2NL1

Location: ELEC 210B
Supply From: SB-1
Mounting: S
Enclosure: Type 1

Volts: 120/208 Wye
Phases: 3
Wires: 4

A.I.C. Rating: 10,000
Main Type: MCB
Mains Rating: 225 A
MCB Rating:

CKT	Circuit Description	Trip	Poles	A	B	C	Poles	Trip	Circuit Description	CKT
1	Power Rm. C210A, C230, 210B	20 A	1	720 VA 180 VA				1	20 A Classroom 231 - Floor Box	2
3	Power Rm. 212, 214	20 A	1		720 VA 180 VA			1	20 A Classroom 231 - Floor Box	4
5	Power Rm. 206, 208	20 A	1			540 VA 180 VA		1	20 A Classroom 231 - Floor Box	6
7	Power Rm. 202, 206	20 A	1	720 VA 180 VA				1	20 A Classroom 231 - Floor Box	8
9	Power Rm. 203	20 A	1		180 VA 180 VA			1	20 A Classroom 233 - Floor Box	10
11	Power Rm. 203	20 A	1			180 VA 180 VA		1	20 A Classroom 233 - Floor Box	12
13	Power Rm. 203, 205	20 A	1	540 VA 180 VA				1	20 A Classroom 233 - Floor Box	14
15	Power Rm 203 A/V Receptacle	20 A	1		360 VA 360 VA			1	20 A Classroom 231 - A/V Cabinet	16
17	Power Rm. 205, 207, 209	20 A	1			720 VA 360 VA		1	20 A Classroom 233 - A/V Cabinet	18
19	Power Rm. 209, 211, 215	20 A	1	720 VA 180 VA				1	20 A Classroom 231 - Floor Box	20
21	Power Rm. 215	20 A	1		180 VA 180 VA			1	20 A Classroom 231 - Floor Box	22
23	Power Rm. 215	20 A	1			360 VA 180 VA		1	20 A Work/Copy 200A - Counter	24
25	Power Rm. 231, 233	20 A	1	720 VA 360 VA				1	20 A Break 200C - Desk	26
27	Power Rm. 231	20 A	1		430 VA 360 VA			1	20 A Break 200C - Desk	28
29	Power Rm. 233	20 A	1			430 VA 1000...		1	20 A Break 200C - Refrigerator	30
31	Power Rm. 233, 235	20 A	1	1080... 1656...				1	20 A Break 200C - GD-2	32
33	Spare	20 A	1		0 VA 360 VA			1	20 A Break 200C - Counter	34
35	Power Rm. C250, C250B, C230	20 A	1			720 VA 180 VA			20 A Work/Copy 200A - Printer	36
37	Power Rm. C280	20 A	1	720 VA 180 VA				2		38
39	Elevator Lobby - Digital Signage	20 A	1		180 VA 360 VA			1	20 A Lact 275 - Receptacle	40
41	Women 277, Men 279	20 A	1			360 VA 180 VA		1	20 A Data 200B - Receptacle	42
43	EW-C-2	20 A	1	370 VA 80 VA				1	15 A EAB Connector - CUH-203, CUH-204	44
45	Power SCIN Convertible Classroom/General...	20 A	1		1080... 500 VA			1	20 A EAB Connector - Electric Door Opener	46
47	Power General Classroom - Shades	20 A	1			720 VA 0 VA		1	20 A Spare	48
49	Vest, C250A - Elec Door Openers	20 A	1	1000... 0 VA				1	20 A Spare	50
51	Vest, C250A - CUH-201, Vest C230A - ...	15 A	1		80 VA 0 VA			1	20 A Spare	52
53	Vest, C230A - Elec Door Openers	20 A	1			1000... 0 VA		1	20 A Spare	54
55	Men 279 - Electric Hand Dryer	20 A	1	1490... 0 VA				1	20 A Spare	56
57	Women 277 - Electric Hand Dryer	20 A	1		1490... 0 VA			1	20 A Spare	58
59	Spare	20 A	1			0 VA 0 VA		1	20 A Spare	60
Total Loads:				11076 VA	7180 VA	7290 VA				
Total Amps:				92 A	60 A	61 A				