

Architect's Supplemental Instructions

Architect's Project No:
04561.01

Architect's ASI No: 021

Project:
Webster University
Interdisciplinary Science
Building

Date Issued: 08/17/2016

Contract Date:

Reason Code: 05 A/E Scope

Discipline Code: 07 7 General Construction
(Architectural)

St. Louis
Baltimore
Boston
Buffalo
Calgary
Chicago
Houston
Los Angeles
Mumbai
New York
Phoenix
San Francisco
Shanghai
Toronto
Vancouver
Victoria
Washington DC

Owner:
Webster University

Architect:
Cannon Design
1100 Clark Avenue
St. Louis, MO 63102

Contractor:
Paric Construction

Contract For: General construction

The Work shall be carried out in accordance with the following supplemental instructions issued in accordance with the Contract Documents without change in Contract Sum or Contract Time. Indicate your acceptance of these instructions for minor change to the Work as consistent with the Contract Documents and return a copy to the Architect within fourteen (14) business days of the date of issuance of these instructions. If you feel a change in Contract Sum or Contract Time is warranted, please submit an itemized quotation for the changes for approval within fourteen (14) business days of the date of issuance of these instructions prior to proceeding on the Work. Proceeding with the Work in accordance with these instructions indicates your acknowledgement that there will be no change.

Attachments:

Drawings: S0107, S0303 and S0305

1100 Clark Avenue
St. Louis, Missouri
63102
T: 314.241.6250
F: 314.241.2570
www.cannondesign.com

Reason Codes:
#1. Jurisdictional Agency
#2. Constructor Driven
#3. Document Inconsistency
#4. Fast Track Driven
#5. A/E Scope
#6. Owners Scope
#7. Unforeseeable Conditions
#8. Other

Discipline Codes
#1. Demo-demolition
#2. Div1-Division 1 items on the spec book
(this item is not used)
#3. Electrical
#4. Elevator
#5. Equipment (Changes in equipment,
Owner Purchased)
#6. Fire Protection

Discipline Codes
#7. General Construction (Architectural)
#8. General Conditions (Div. 1)
#9. HVAC
#10. Other
#11. Plumbing
#12. Site Work/Landscaping
#13. Structural

Architect's Supplemental Instructions

Page 2

Description:


Revisions to Roof Screen base connections. Revised edge of bent plate on north and west edges of west wing. Revised opening size/location at D-8.

Please submit an itemized proposal for changes in contract Sum and Contract Time for proposed modifications to the Contract Documents described herein:

Issued by Architect:

Jill Walker, DMA.

Accepted by Contractor:

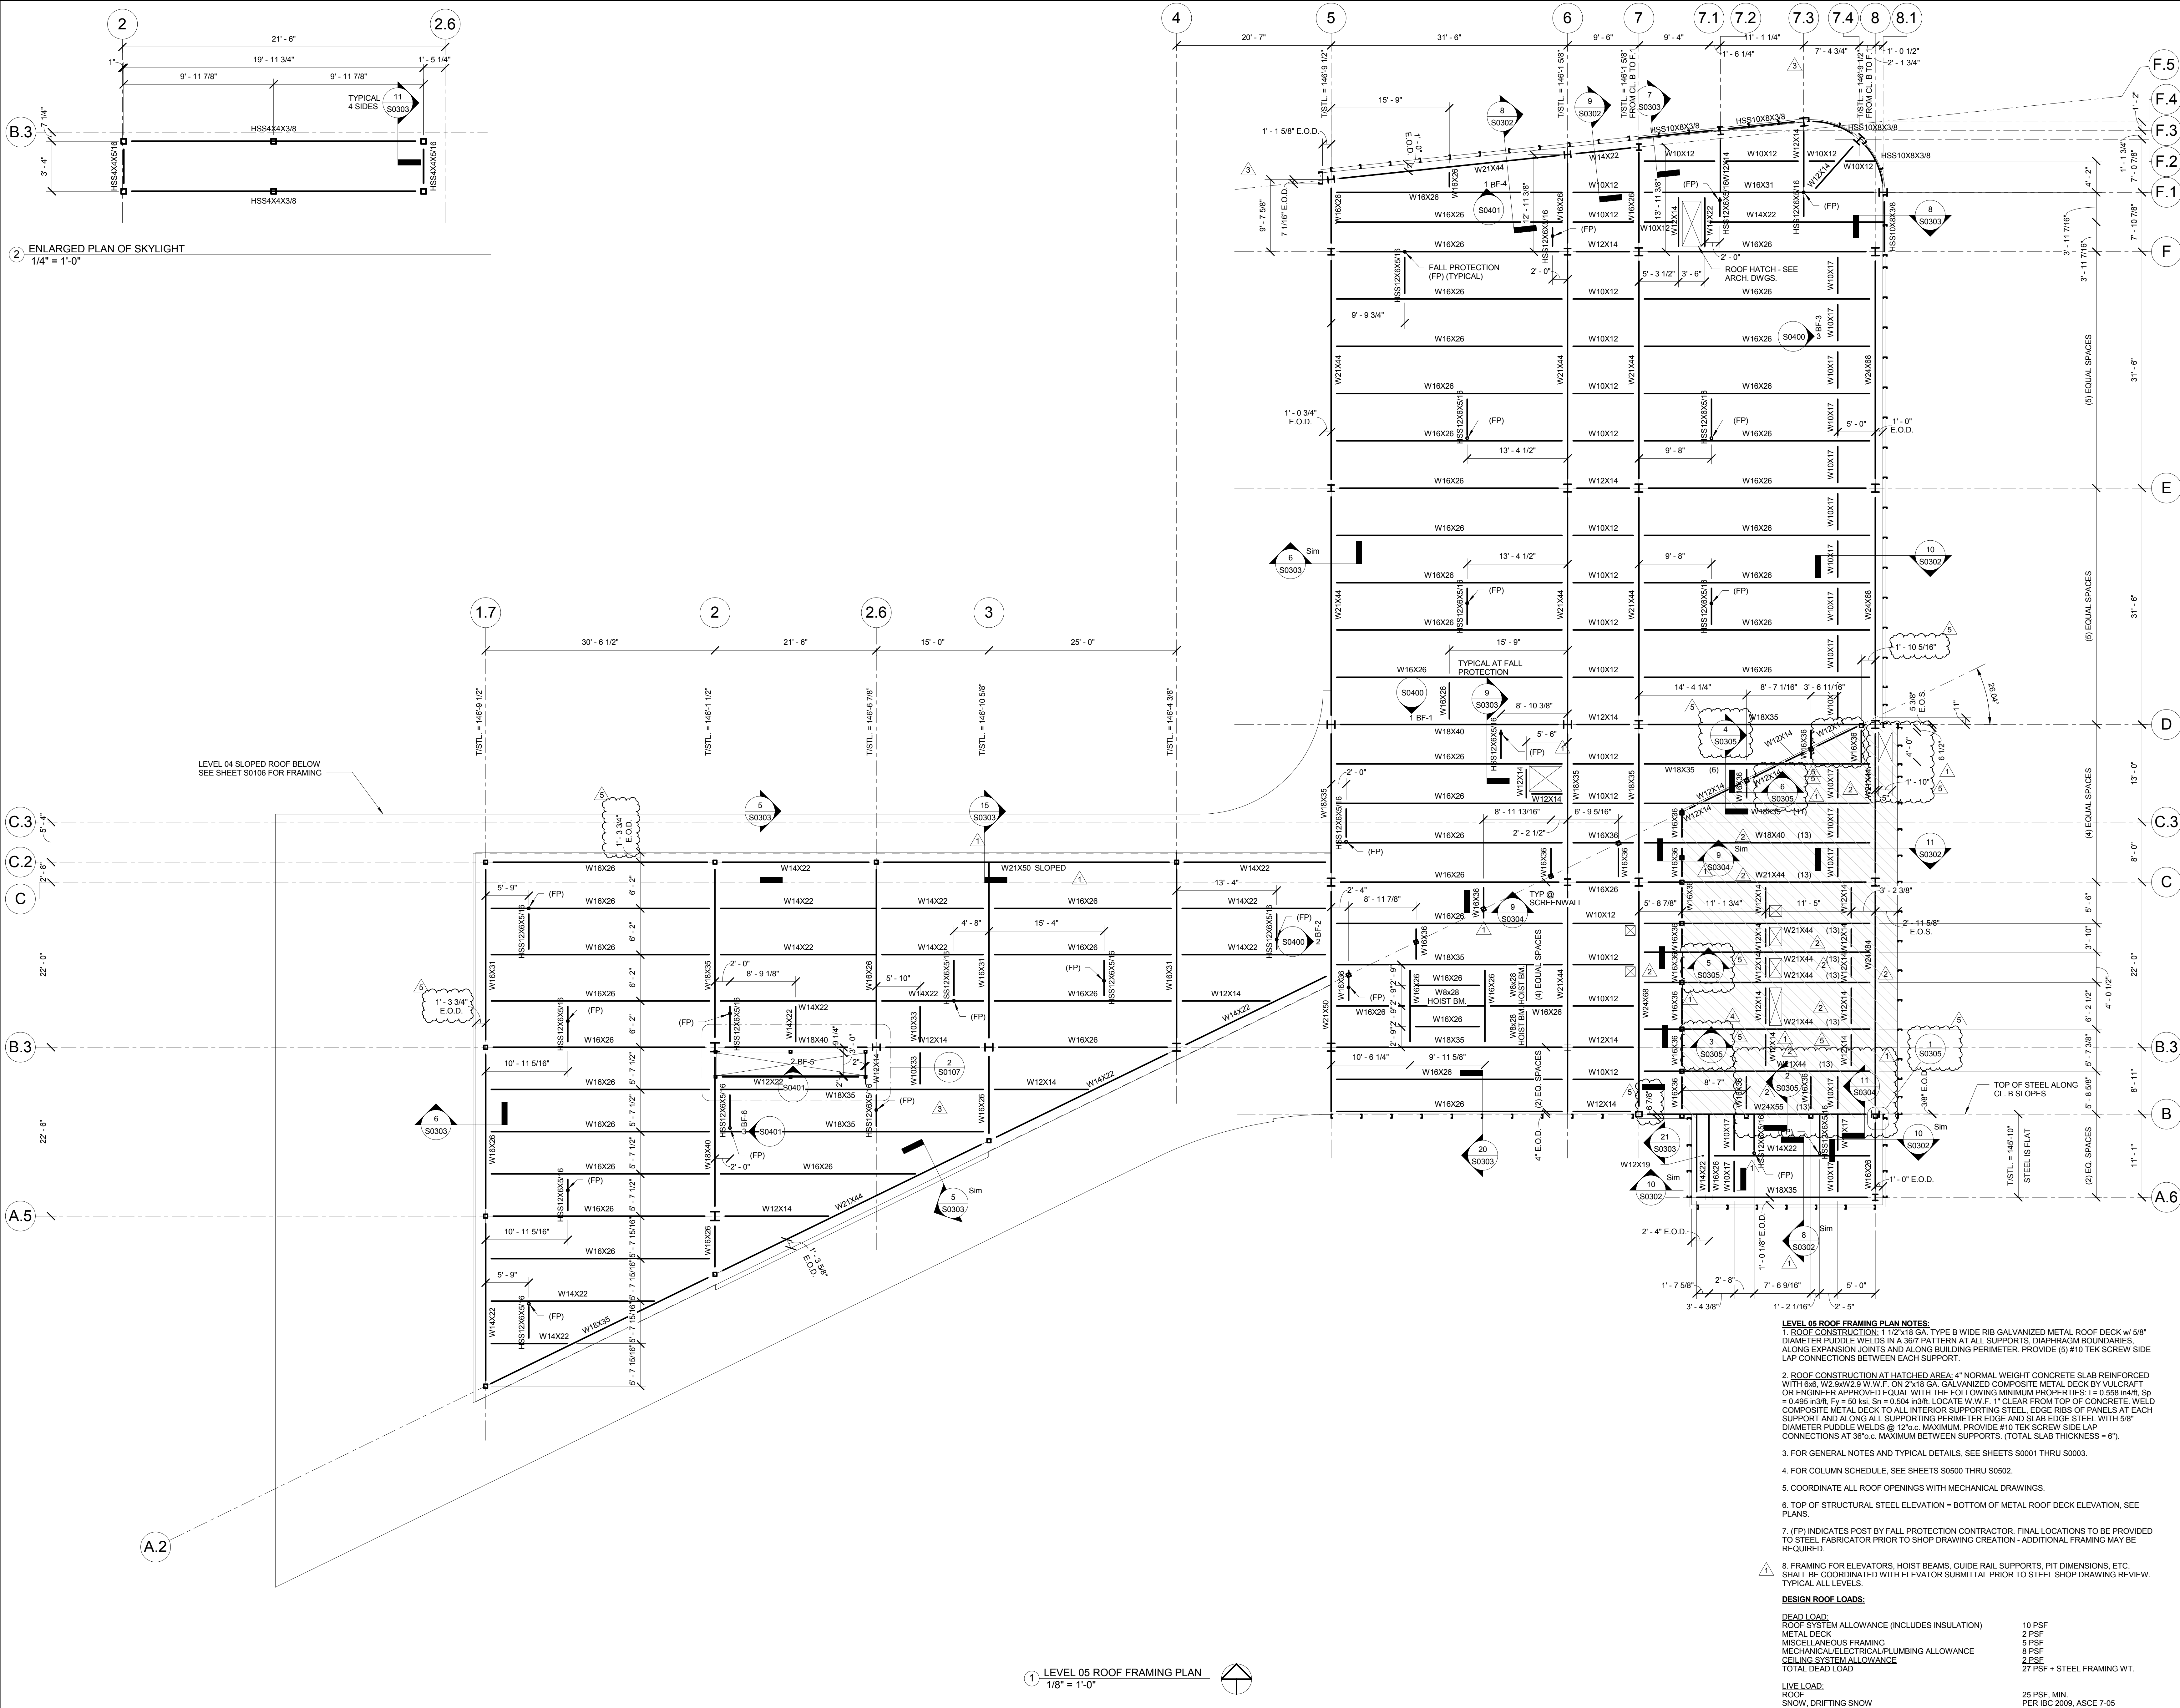

5	ASI 021	19 AUG 2016
4	ADDENDUM 1-11	13 MAY 2016
3	ADDENDUM 1-7	16 MAR 2016
2	ADDENDUM 1-3	02 FEB 2016
1	ADDENDUM 1-1	29 JAN 2016
- ISSUED FOR CONSTRUCTION (BPT)		15 JAN 2016
No.	Description	Date


Drawing Title:

LEVEL 05 ROOF FRAMING
PLAN

Project No.: 04561.01

Checked by:

S0107

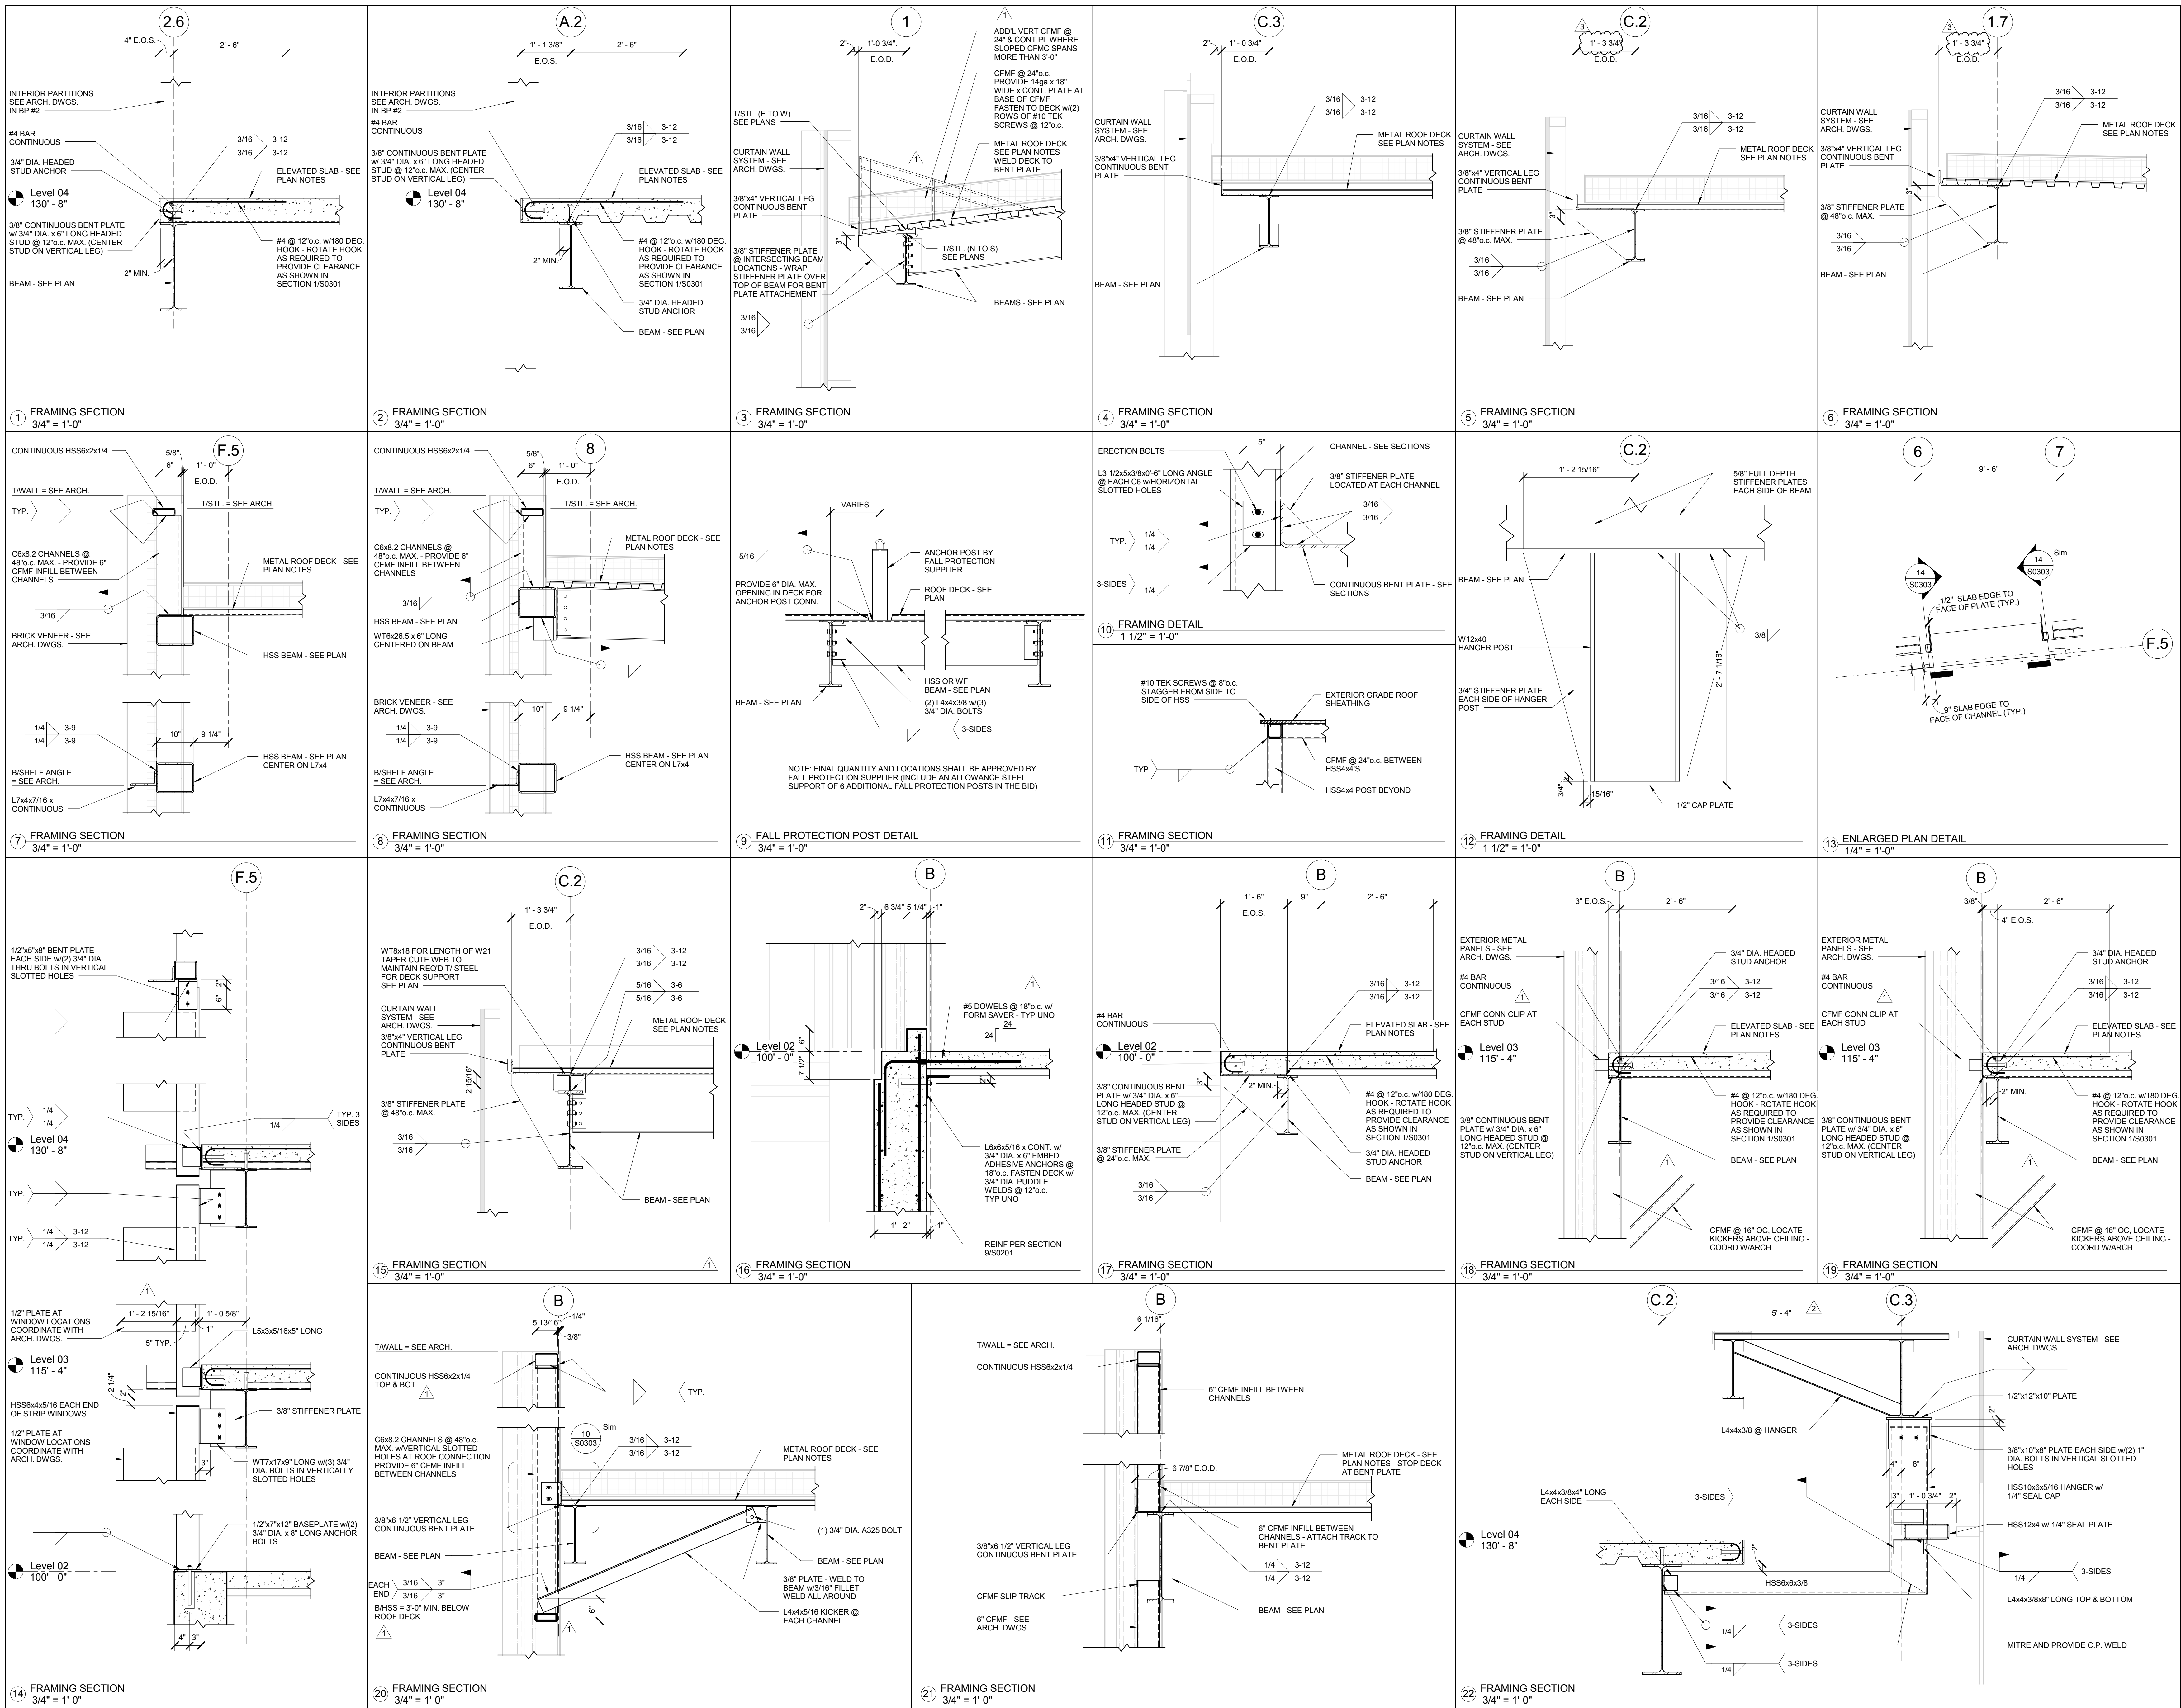


3	ASI 021	19 AUG 2016
2	ADDENDUM 1-11	13 MAY 2016
1	ADDENDUM 1-1	29 JAN 2016
-	ISSUED FOR CONSTRUCTION (BPI)	15 JAN 2016
No.	Description	Date

Drawing Title:


**FRAMING SECTIONS AND
DETAILS**

Project No.: 04561.01 Checked by:


S0303

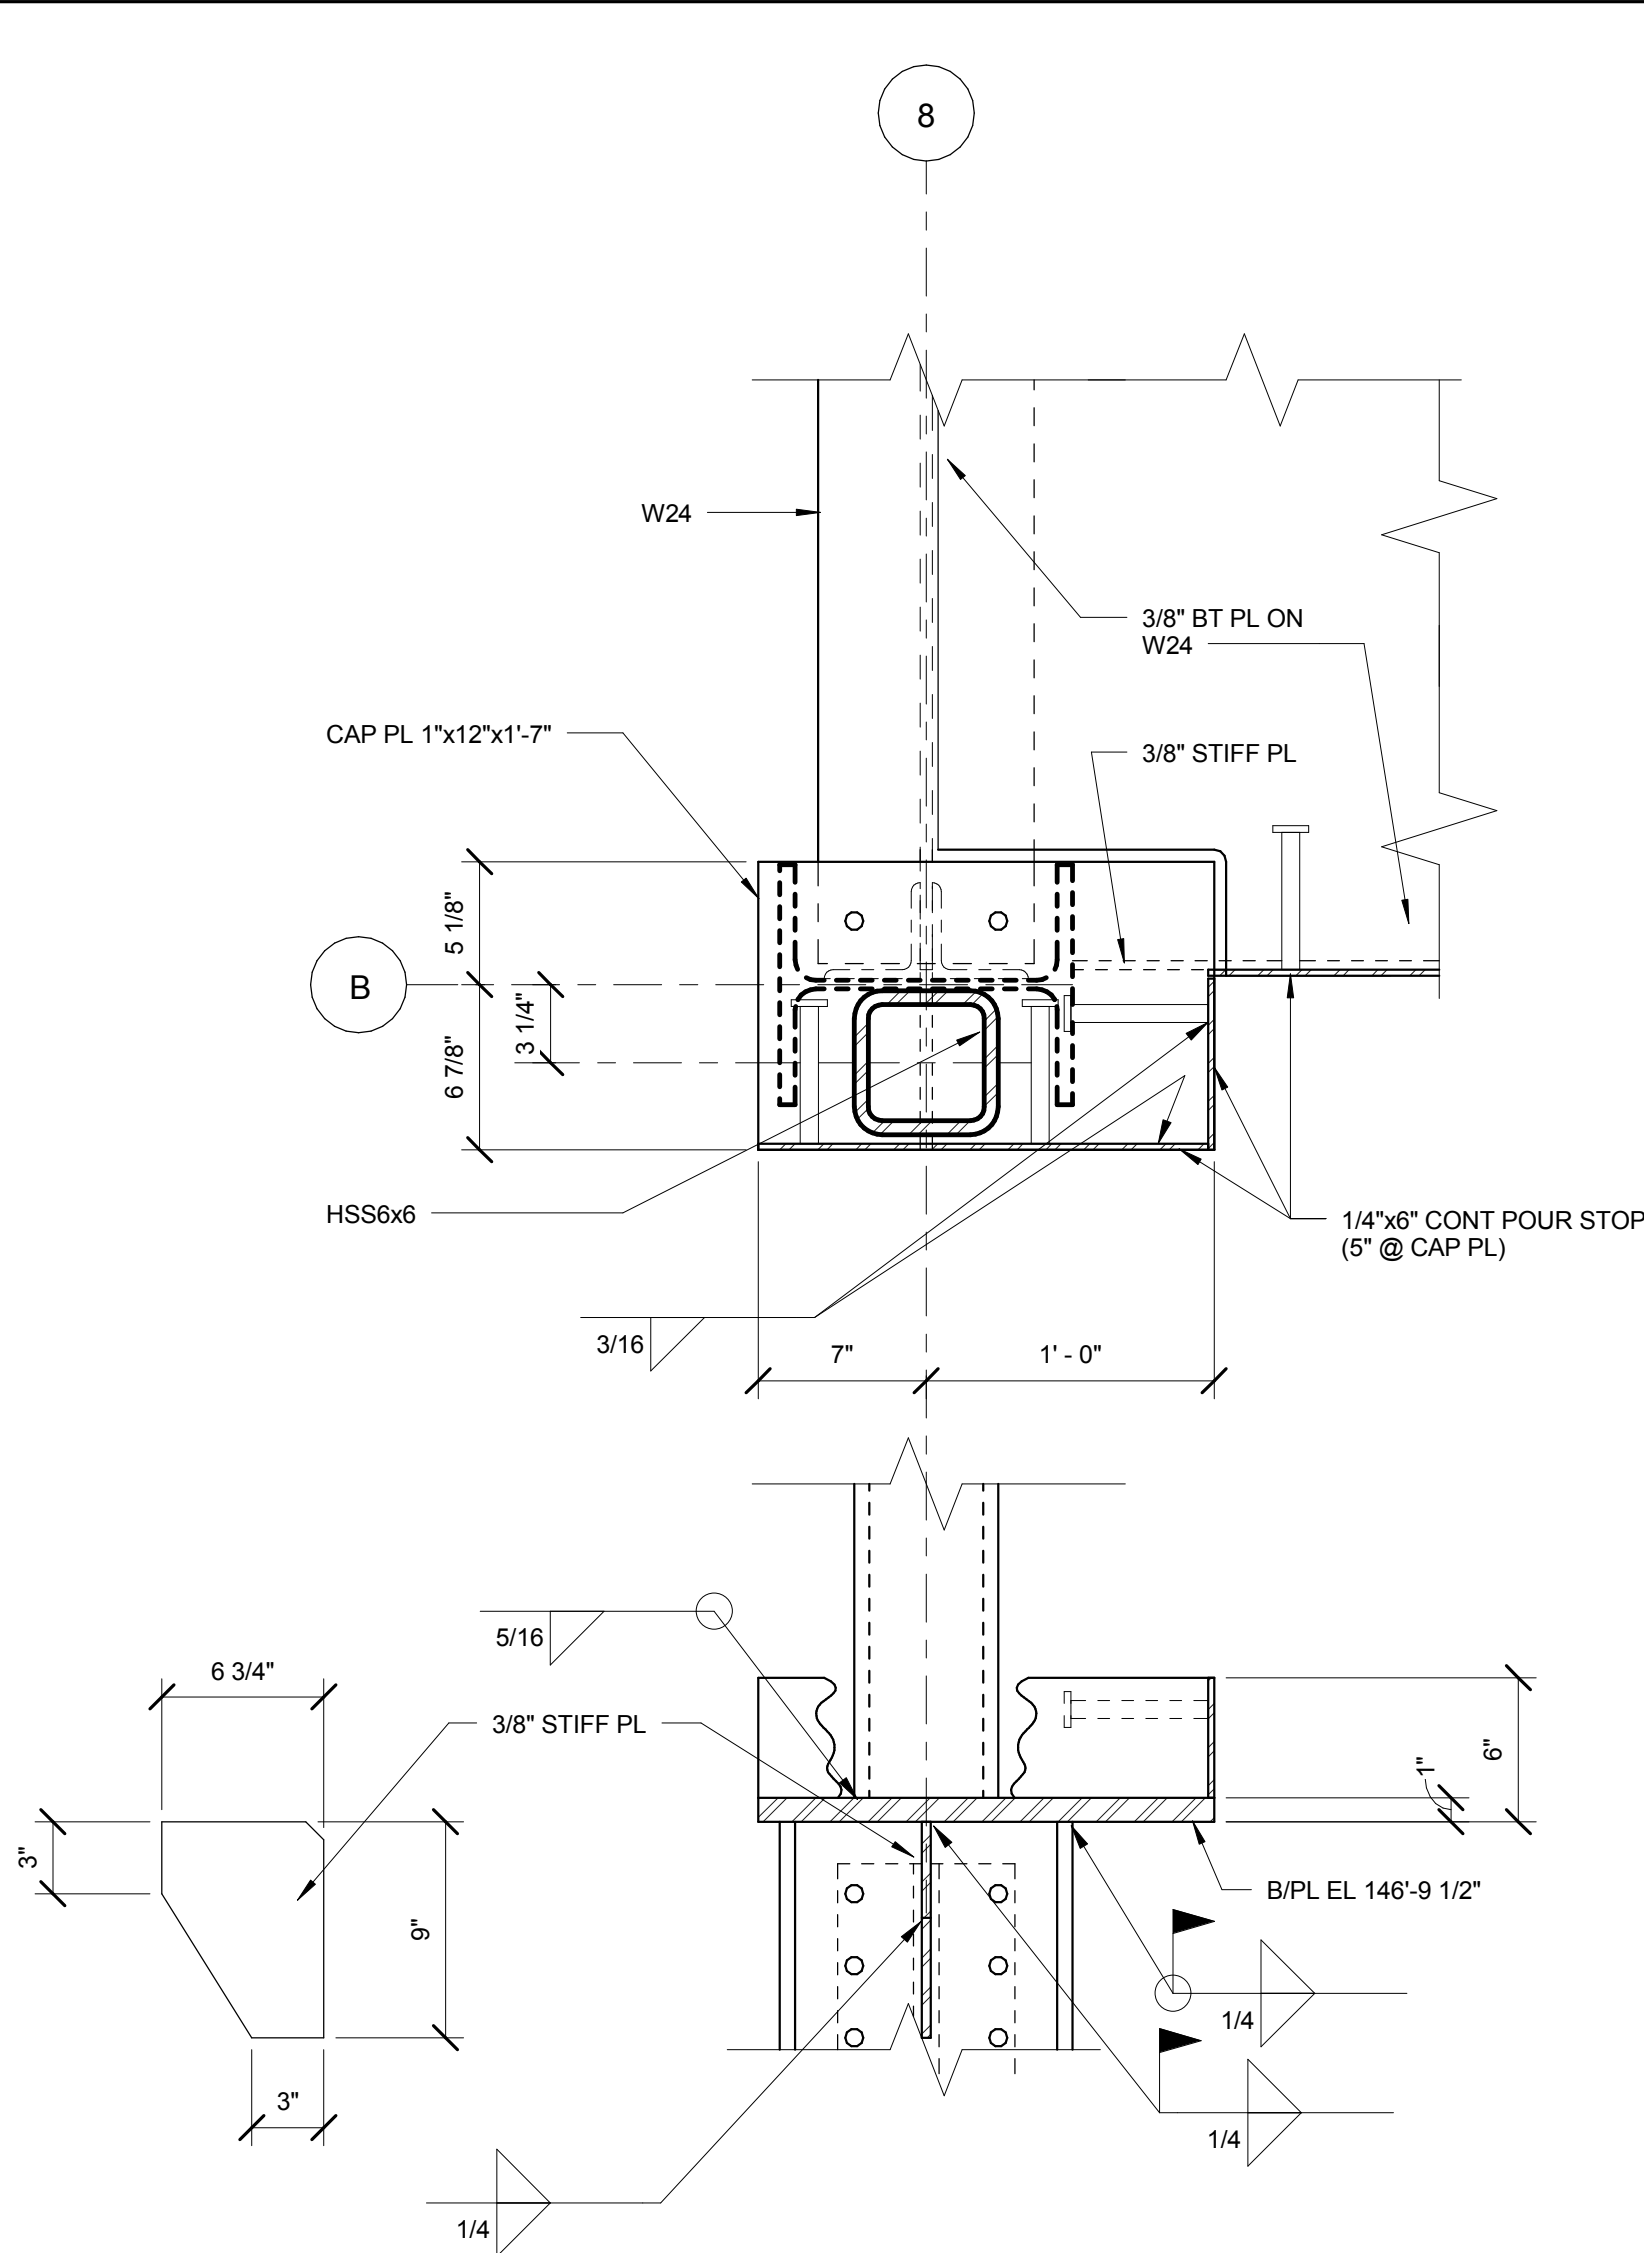


1 CAP PLATE B-8
1 1/2" = 1'-0"

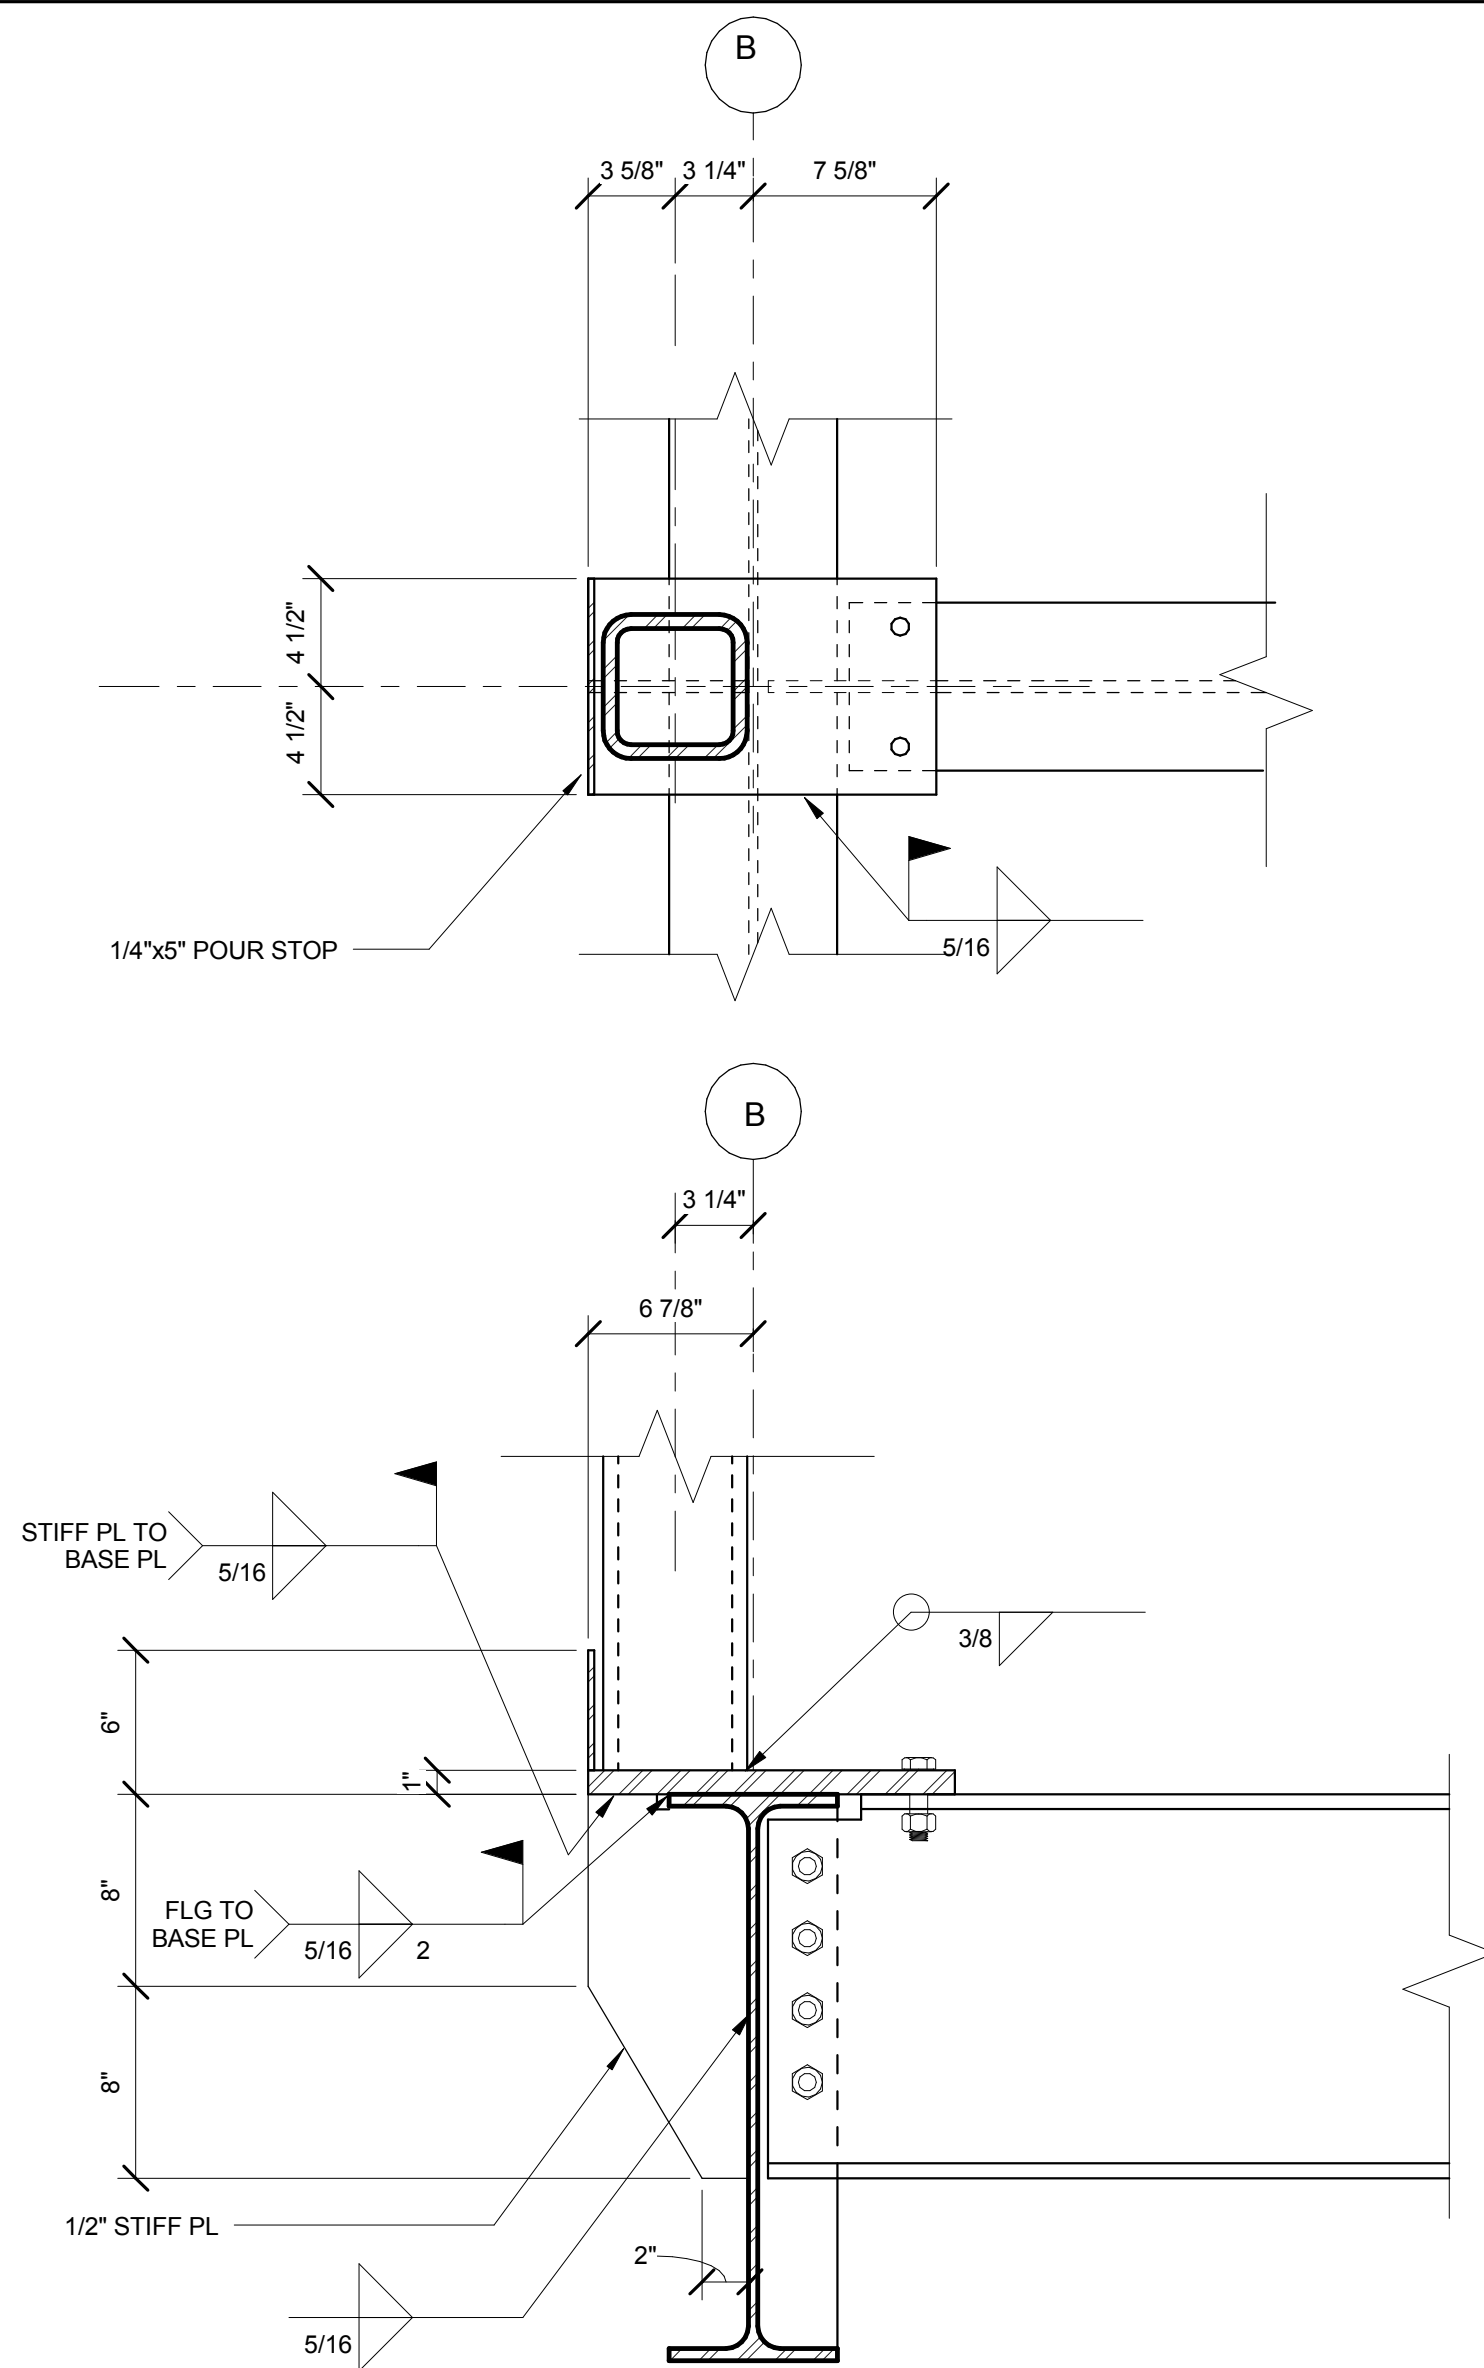


2 CAP PLATE ALONG GRID B OPPOSITE BEAM FRAMING
1 1/2" = 1'-0"

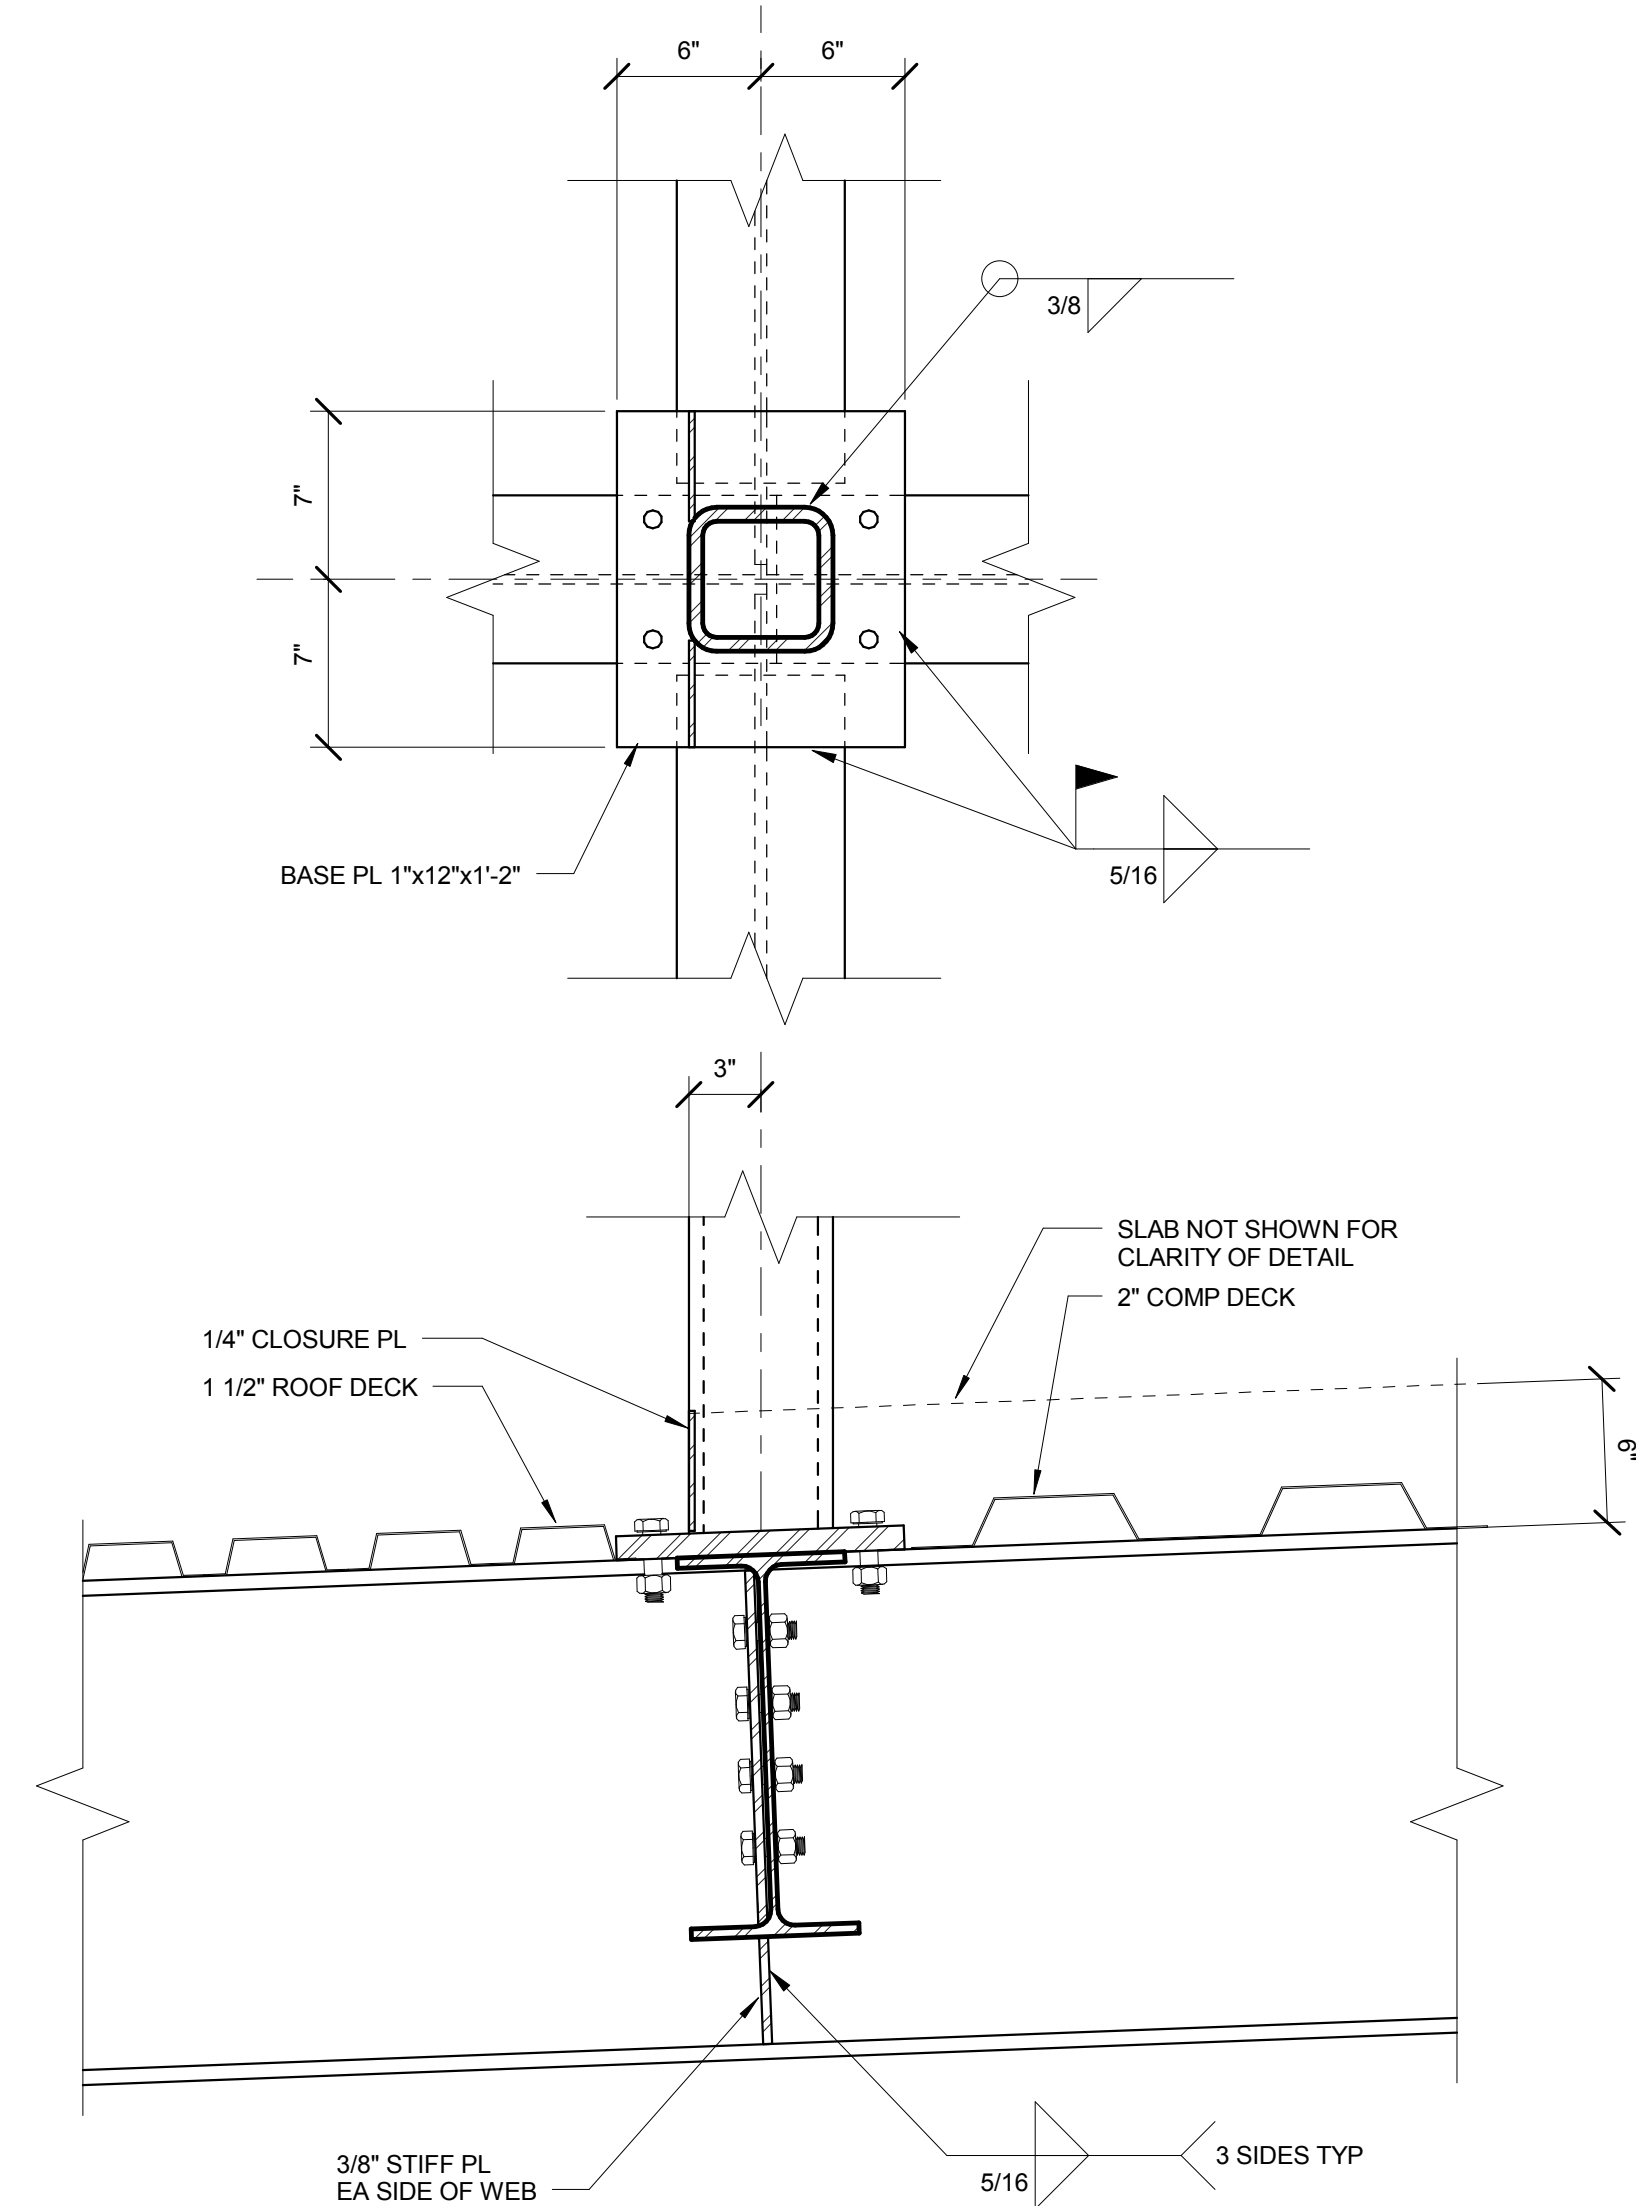


3 CAP PLATE FOR 5 POST ON W21X44 DETAIL
1 1/2" = 1'-0"

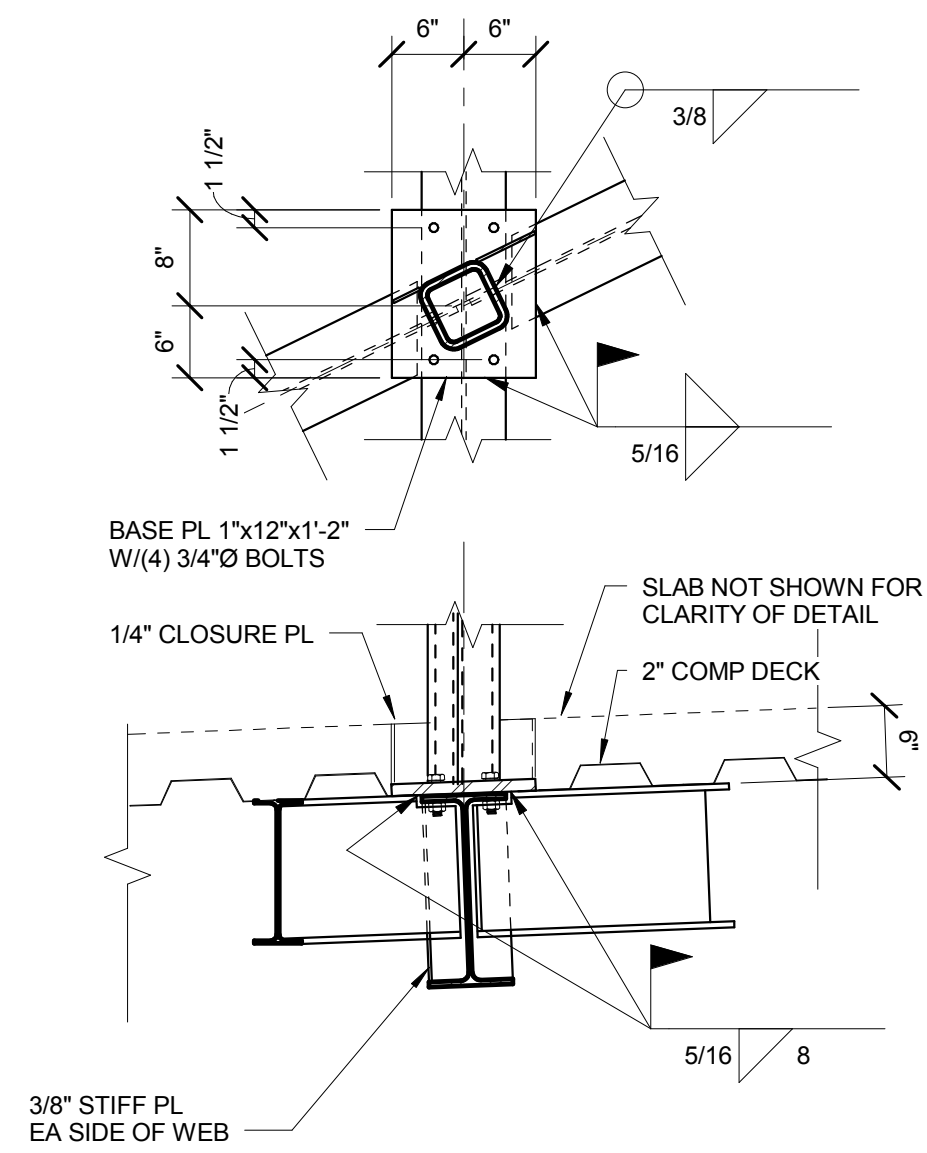

6 3 POST +1 @ NORTH FACE
3/4" = 1'-0"

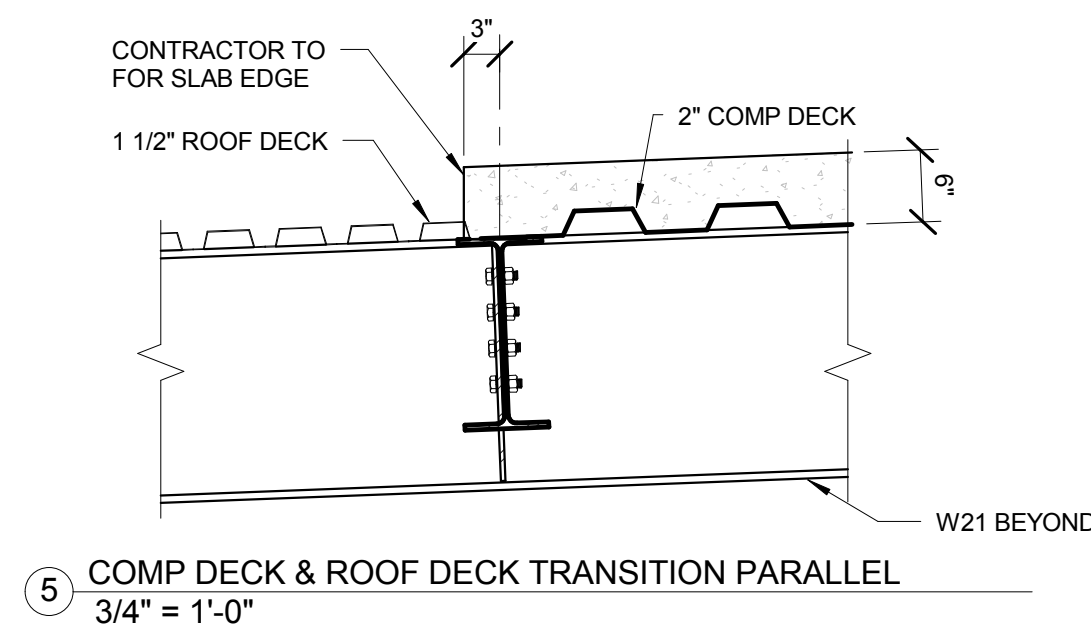

5 COMP DECK & ROOF DECK TRANSITION PARALLEL
3/4" = 1'-0"

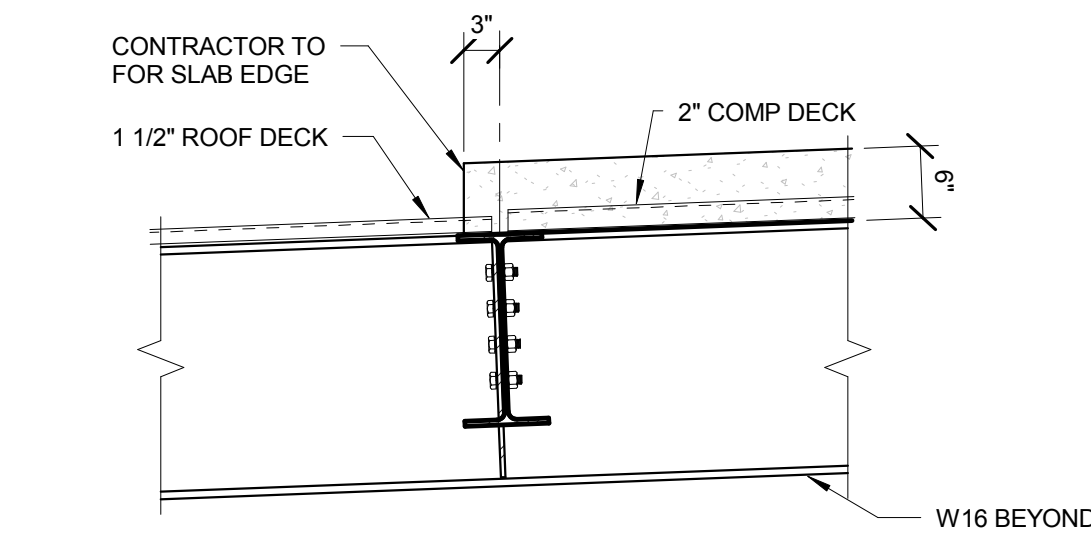

4 COMP DECK & ROOF DECK TRANSITION PERPENDICULAR
3/4" = 1'-0"