

Architect's Supplemental Instructions

Architect's Project No:
04561.01

Architect's ASI No: 023

Project:
Webster University
Interdisciplinary Science
Building

Date Issued: 08/23/2016

Contract Date:

Reason Code: 05 A/E Scope

Discipline Code: 07 7 General Construction
(Architectural)

St. Louis
Baltimore
Boston
Buffalo
Calgary
Chicago
Houston
Los Angeles
Mumbai
New York
Phoenix
San Francisco
Shanghai
Toronto
Vancouver
Victoria
Washington DC

Owner:
Webster University

Architect:
Cannon Design
1100 Clark Avenue
St. Louis, MO 63102

Contractor:
Paric Construction

Contract For: General construction

The Work shall be carried out in accordance with the following supplemental instructions issued in accordance with the Contract Documents without change in Contract Sum or Contract Time. Indicate your acceptance of these instructions for minor change to the Work as consistent with the Contract Documents and return a copy to the Architect within fourteen (14) business days of the date of issuance of these instructions. If you feel a change in Contract Sum or Contract Time is warranted, please submit an itemized quotation for the changes for approval within fourteen (14) business days of the date of issuance of these instructions prior to proceeding on the Work. Proceeding with the Work in accordance with these instructions indicates your acknowledgement that there will be no change.

Attachments:

Drawings: S0104, S0105, S0106, S0107, S0302 and S0303

1100 Clark Avenue
St. Louis, Missouri
63102
T: 314.241.6250
F: 314.241.2570
www.cannondesign.com

Reason Codes:
#1. Jurisdictional Agency
#2. Constructor Driven
#3. Document Inconsistency
#4. Fast Track Driven
#5. A/E Scope
#6. Owners Scope
#7. Unforeseeable Conditions
#8. Other

Discipline Codes
#1. Demo-demolition
#2. Div1-Division 1 items on the spec book
(this item is not used)
#3. Electrical
#4. Elevator
#5. Equipment (Changes in equipment,
Owner Purchased)
#6. Fire Protection

Discipline Codes
#7. General Construction (Architectural)
#8. General Conditions (Div. 1)
#9. HVAC
#10. Other
#11. Plumbing
#12. Site Work/Landscaping
#13. Structural

Architect's Supplemental Instructions

Page 2

Description:

S0104:

Dimensional revisions at Grids F.5-5.

S0105:

Dimensional revisions at Grids F.5-5.

S0106:

Deck edge revision along Grid 1.7.

S0107:

Dimensional revisions at Grids F.5-5.

S0302:

Revisions to Detail numbers 5, 6, and 7.

S0303:

Revisions to Detail numbers 4, 5, 6, and 14. Detail 14 was updated in ASI 18, but not clouded. No additional information has been added to detail 14.

Please submit an itemized proposal for changes in contract Sum and Contract Time for proposed modifications to the Contract Documents described herein:

Issued by Architect:

Jill Walker, DMA.

Accepted by Contractor:

1100 Clark Avenue
St. Louis, Missouri 63102
T: 314.241.6250
F: 314.241.2570

William Tao & Associates, Inc.
MEP/FP Engineer
7955 Manchester Road, Suite 12
St. Louis, MO 63143
314-884-7600

David Mason & Associates, Inc.
Structural & Civil Engineer
800 South Vandeventer Avenue
St. Louis, MO 63110
314.534.1053

**Faith Group
Technology**
3101 S. Hanley Rd, Suite 100
St. Louis, MO 63143
314.991.2228


Kuhlmann Leavitt, Inc.
Environmental Graphics & Signs
7400 Pershing Ave
St. Louis, MO 63130
314.725.6616

KWA Architects
Architecture
9721 Litzinger Road
St. Louis, MO 63124
314.962.2560

Spellman Brady & Company
Interior Designer
8251 Maryland Avenue, Suite 300
St. Louis, MO 63105
314.862.0070

SWT Design
Landscape Architect
7722 Big Bend Blvd
St. Louis, MO 63119
314.644.5700

Webb Engineering Services, Inc.
Plumbing & Fire Protection
1400 S. 3rd Street, Suite 201
St. Louis, MO 63104
314.588.0600

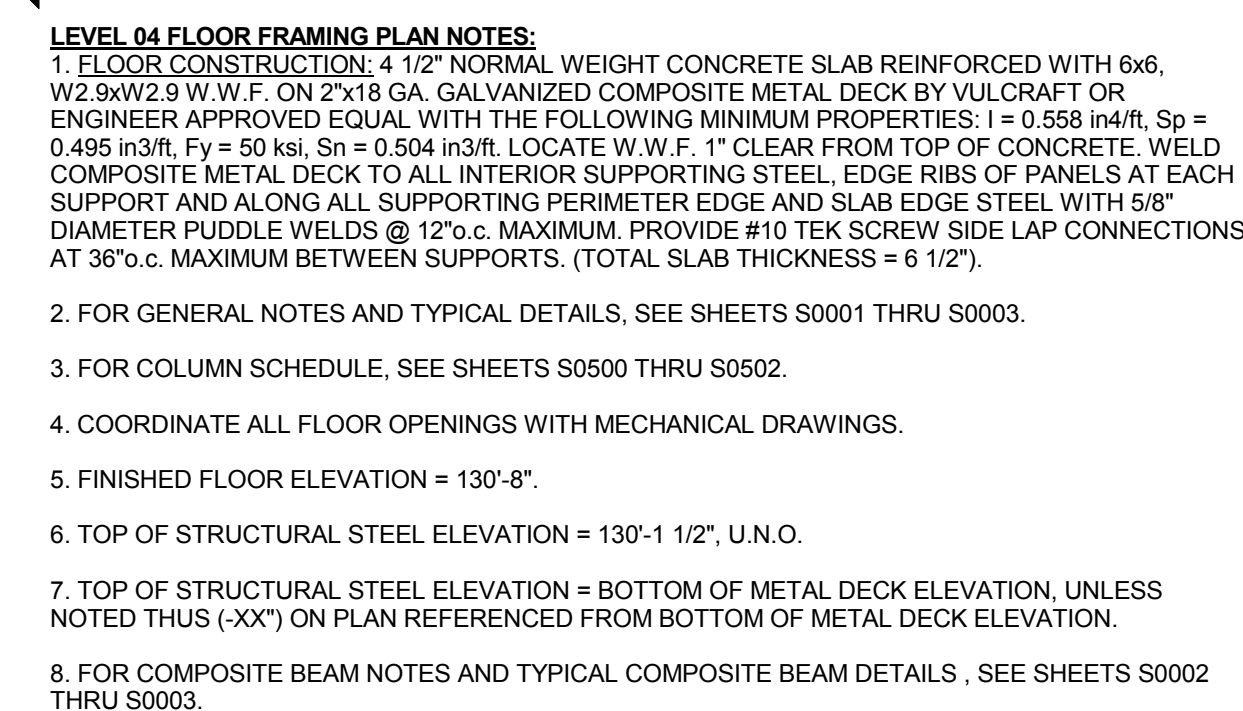

<u>DESIGN FLOOR LOADS:</u>	
FLOOR DEAD LOAD:	
4 1/2" NORMAL WEIGHT CONCRETE SLAB ON	
COMPOSITE DECK (6 1/2" TOTAL THICKNESS)	67 PSF
2" COMPOSITE METAL DECK	2 PSF
CONCRETE OVER RUN ALLOWANCE	5 PSF
MISCELLANEOUS FRAMING	5 PSF
MECHANICAL/ELECTRICAL/PLUMBING/FP ALLOWANCE	8 PSF
CEILING SYSTEM ALLOWANCE	2 PSF
TOTAL DEAD LOAD	89 PSF + STEEL FRAMING WT.

<u>LIVE LOAD:</u>	
TYPICAL FLOOR	100 PSF
CORRIDOR AT ENTRY LEVELS	80 PSF

4	ASI 023	23 AUG 2016
3	ASI 018	19 AUG 2016
2	ADDENDUM 1-7	16 MAR 2016
1	ADDENDUM 1-1	29 JAN 2016
-	ISSUED FOR CONSTRUCTION (BP1)	15 JAN 2016
No.	Description	Date

Drawing Title

**LEVEL 04 FLOOR
FRAMING PLAN**

Project No.: 04561.01 Checked by

S0105

© Cannon Design 2014

© Cannon Design 2015



7	ASI 023	23 AUG 2016
6	ASI 018	19 AUG 2016
5	ASI 021	19 AUG 2016
4	ADDENDUM 1-11	13 MAY 2016
3	ADDENDUM 1-7	16 MAR 2016
2	ADDENDUM 1-3	02 FEB 2016
1	ADDENDUM 1-1	29 JAN 2016
-	ISSUED FOR CONSTRUCTION (BPT)	15 JAN 2016
No.	Description	Date


Drawing Title:

LEVEL 05 ROOF FRAMING
PLAN

Project No.: 04561.01

Checked by:

S0107

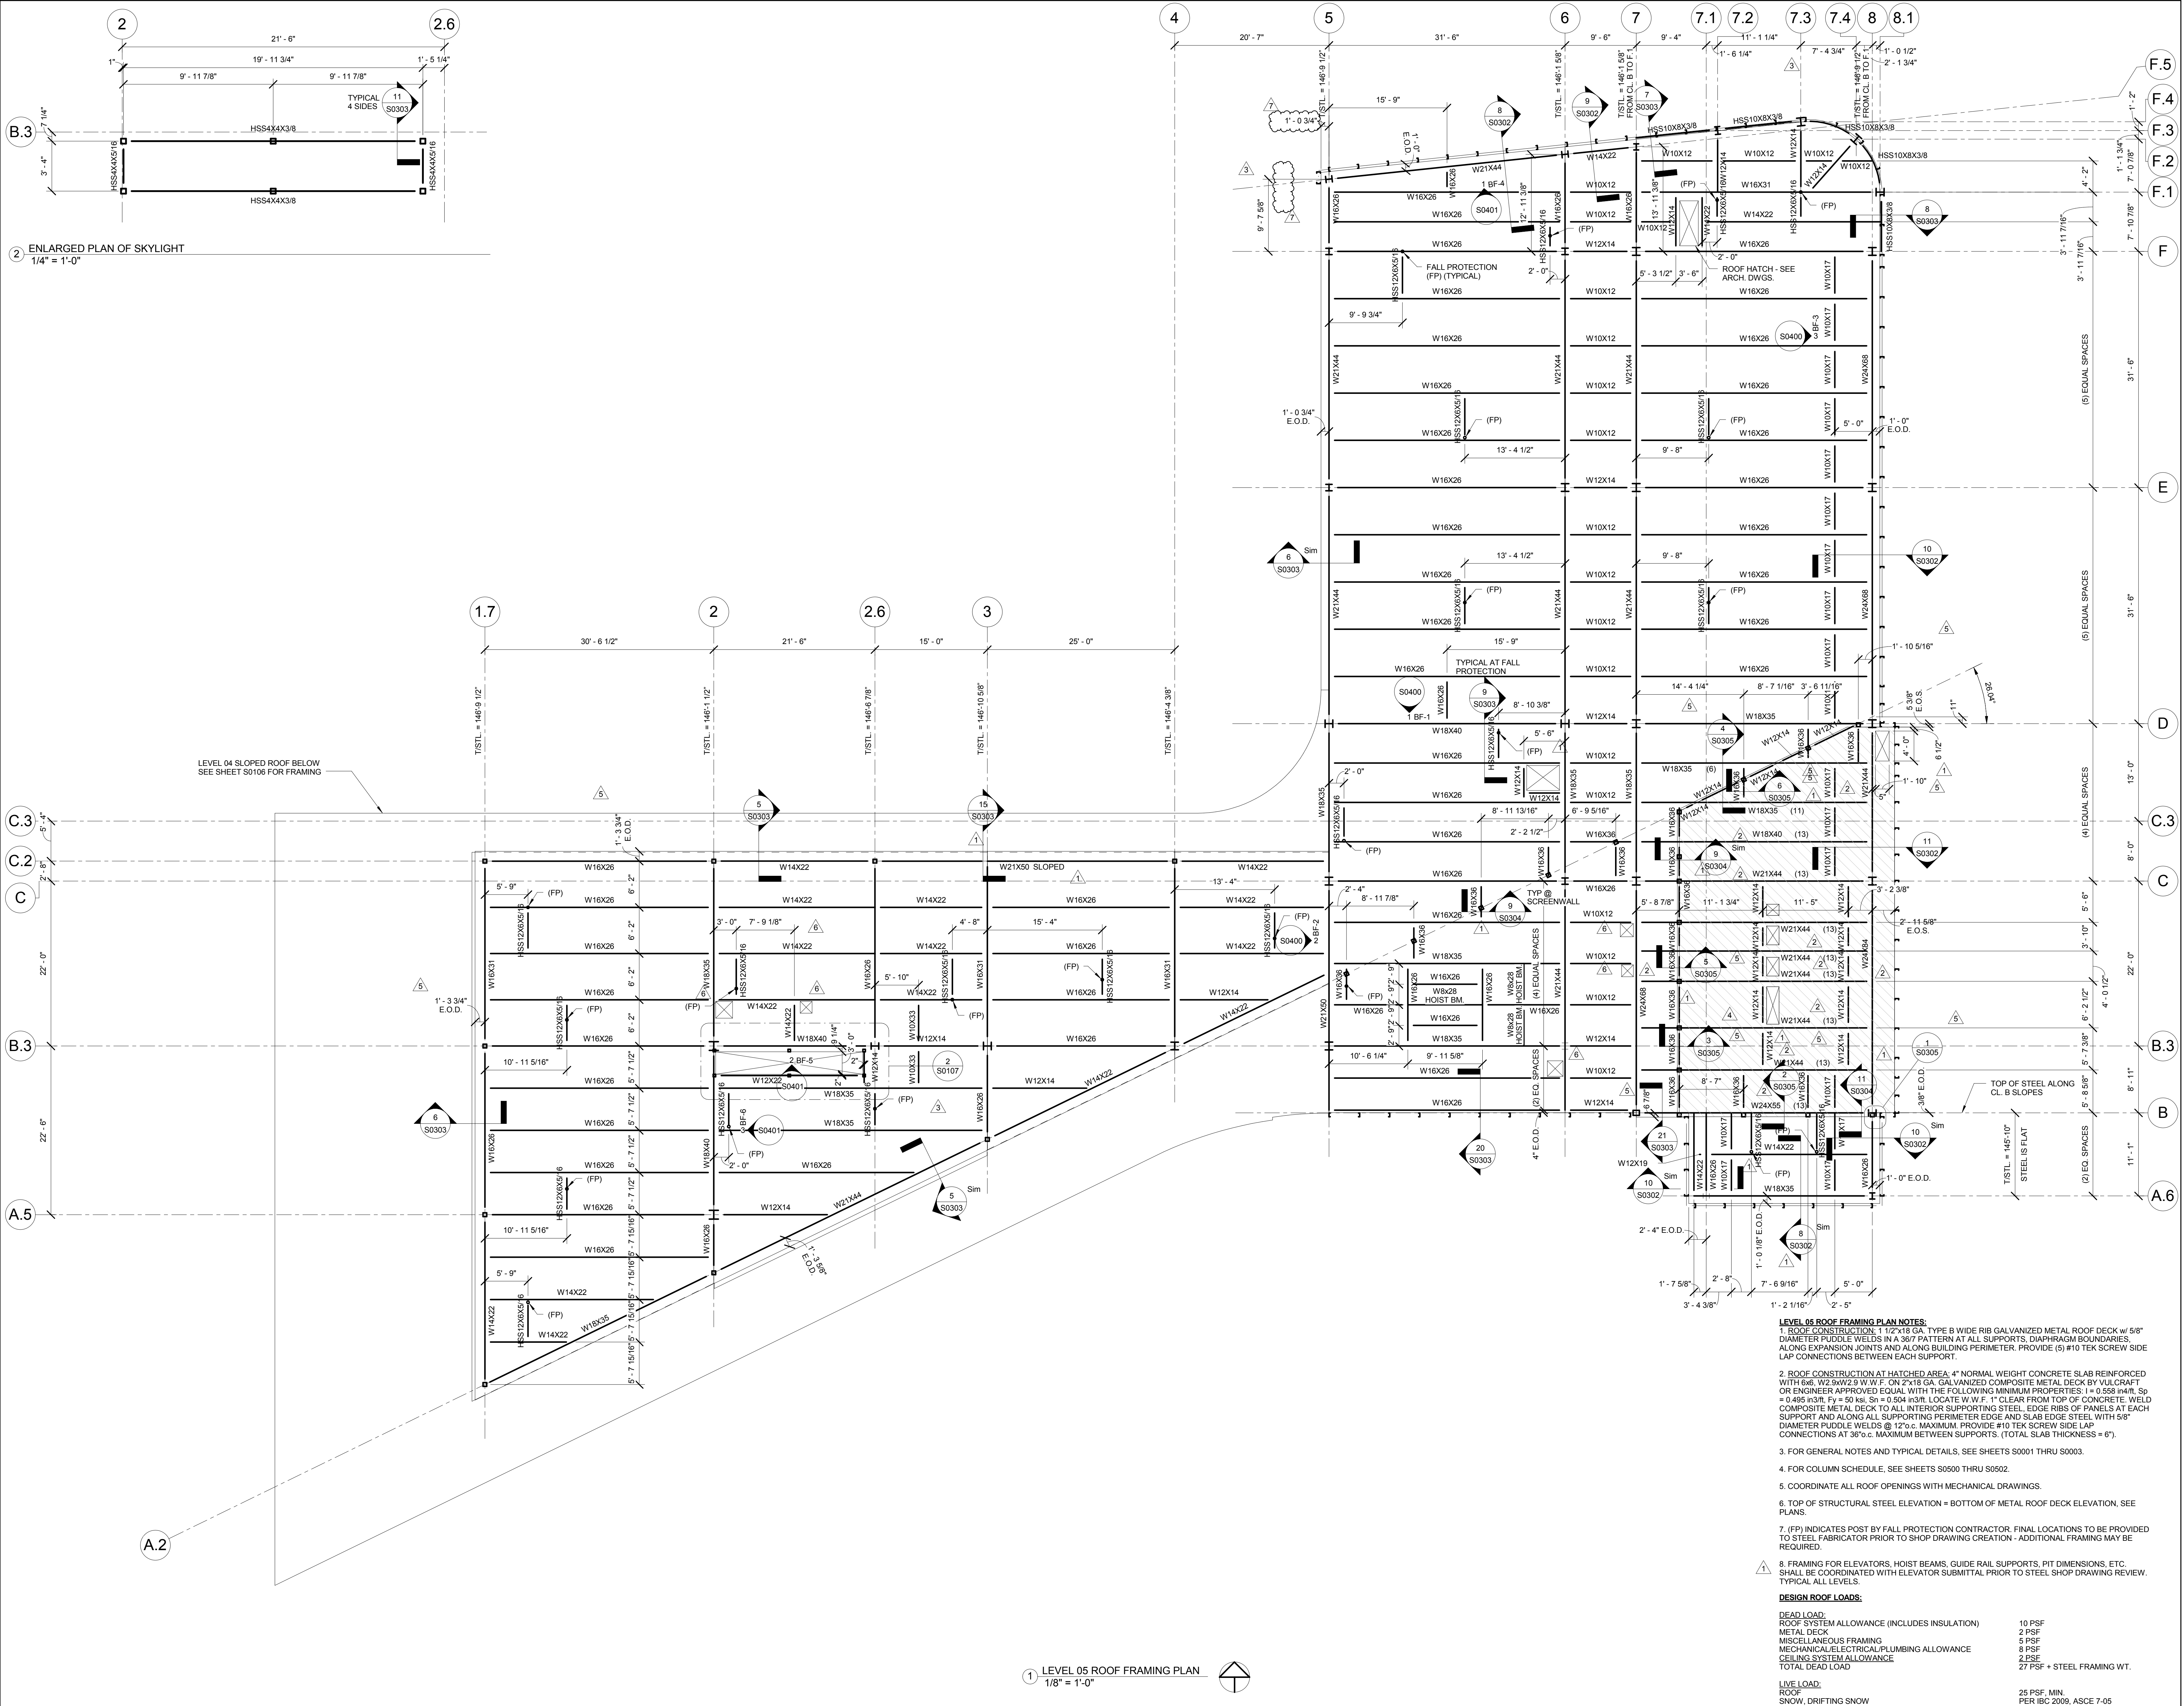



5	ASI 023	23 AUG 2016
4	ASI 018	19 AUG 2016
3	ASI 021	19 AUG 2016
2	ADDENDUM 1-11	13 MAY 2016
1	ADDENDUM 1-1	29 JAN 2016
-	ISSUED FOR CONSTRUCTION (BP1)	15 JAN 2016
No.	Description	Date

Drawing Title:

**FRAMING SECTIONS AND
DETAILS**

Project No.: 04561.01

Checked by:

S0303

