

Architect's Supplemental Instructions

Architect's Project No:
04561.01

Architect's ASI No: 050

Project:
Webster University
Interdisciplinary Science
Building

Date Issued: 02/16/2017

Contract Date:

Reason Code: 06 Owner Scope

Discipline Code: 09 Mechanical

Owner:
Webster University

Architect:
Cannon Design
1100 Clark Avenue
St. Louis, MO 63102

Contractor:
Paric Construction

Contract For: General Construction

The Work shall be carried out in accordance with the following supplemental instructions issued in accordance with the Contract Documents without change in Contract Sum or Contract Time. Indicate your acceptance of these instructions for minor change to the Work as consistent with the Contract Documents and return a copy to the Architect within fourteen (14) business days of the date of issuance of these instructions. If you feel a change in Contract Sum or Contract Time is warranted, please submit an itemized quotation for the changes for approval within fourteen (14) business days of the date of issuance of these instructions prior to proceeding on the Work. Proceeding with the Work in accordance with these instructions indicates your acknowledgement that there will be no change.

Attachments:

Drawings:

Sheets M0101.A, M0101.B, M0102.A, M0102.B, M0103.A, M0202, M0301

St. Louis
Baltimore
Boston
Buffalo
Calgary
Chicago
Houston
Los Angeles
Mumbai
New York
Phoenix
San Francisco
Shanghai
Toronto
Vancouver
Victoria
Washington DC

Architect's Supplemental Instructions

Page 2

Description:

Please submit an itemized proposal for changes in contract Sum and Contract Time for proposed modifications to the Contract Documents described herein:

SHEET M0101.A

- Revised boiler and domestic water heater combustion air inlet connections at louver. Louver was previously modified on Architectural plans issued for Addendum 1-9.
- Modify Keyed Note #47
- Modify Keyed Note #48
- Add Keyed Note #70
- Add Keyed Note #71
- Add Keyed Note #72

SHEET M0101.B

- Modify thermostat locations.

SHEET M0102.A

- Modify thermostat locations.

SHEET M0102.B

- Modify thermostat locations.

SHEET M0103.A

- Modify thermostat location for VAV-322.

SHEET M0202

- Modify boiler and domestic water heater combustion air inlet connections at louver. Louver was previously modified on Architectural plans issued for Addendum 1-9.
- Modify Keyed Note #47
- Modify Keyed Note #48
- Add Keyed Note #70
- Add Keyed Note #71
- Add Keyed Note #72

SHEET M0301



- Modify Sections #1 and #2 for boiler and domestic water heater combustion air inlet connections at louver.
- Clarify Gas pipe wall penetration to be below louver. Louver was previously modified on Architectural plans issued for Addendum 1-9.

Issued by Architect: Mike Nolte, William Tao & Associates, Inc.

Architect's Supplemental Instructions

Page 3

Accepted by Contractor:

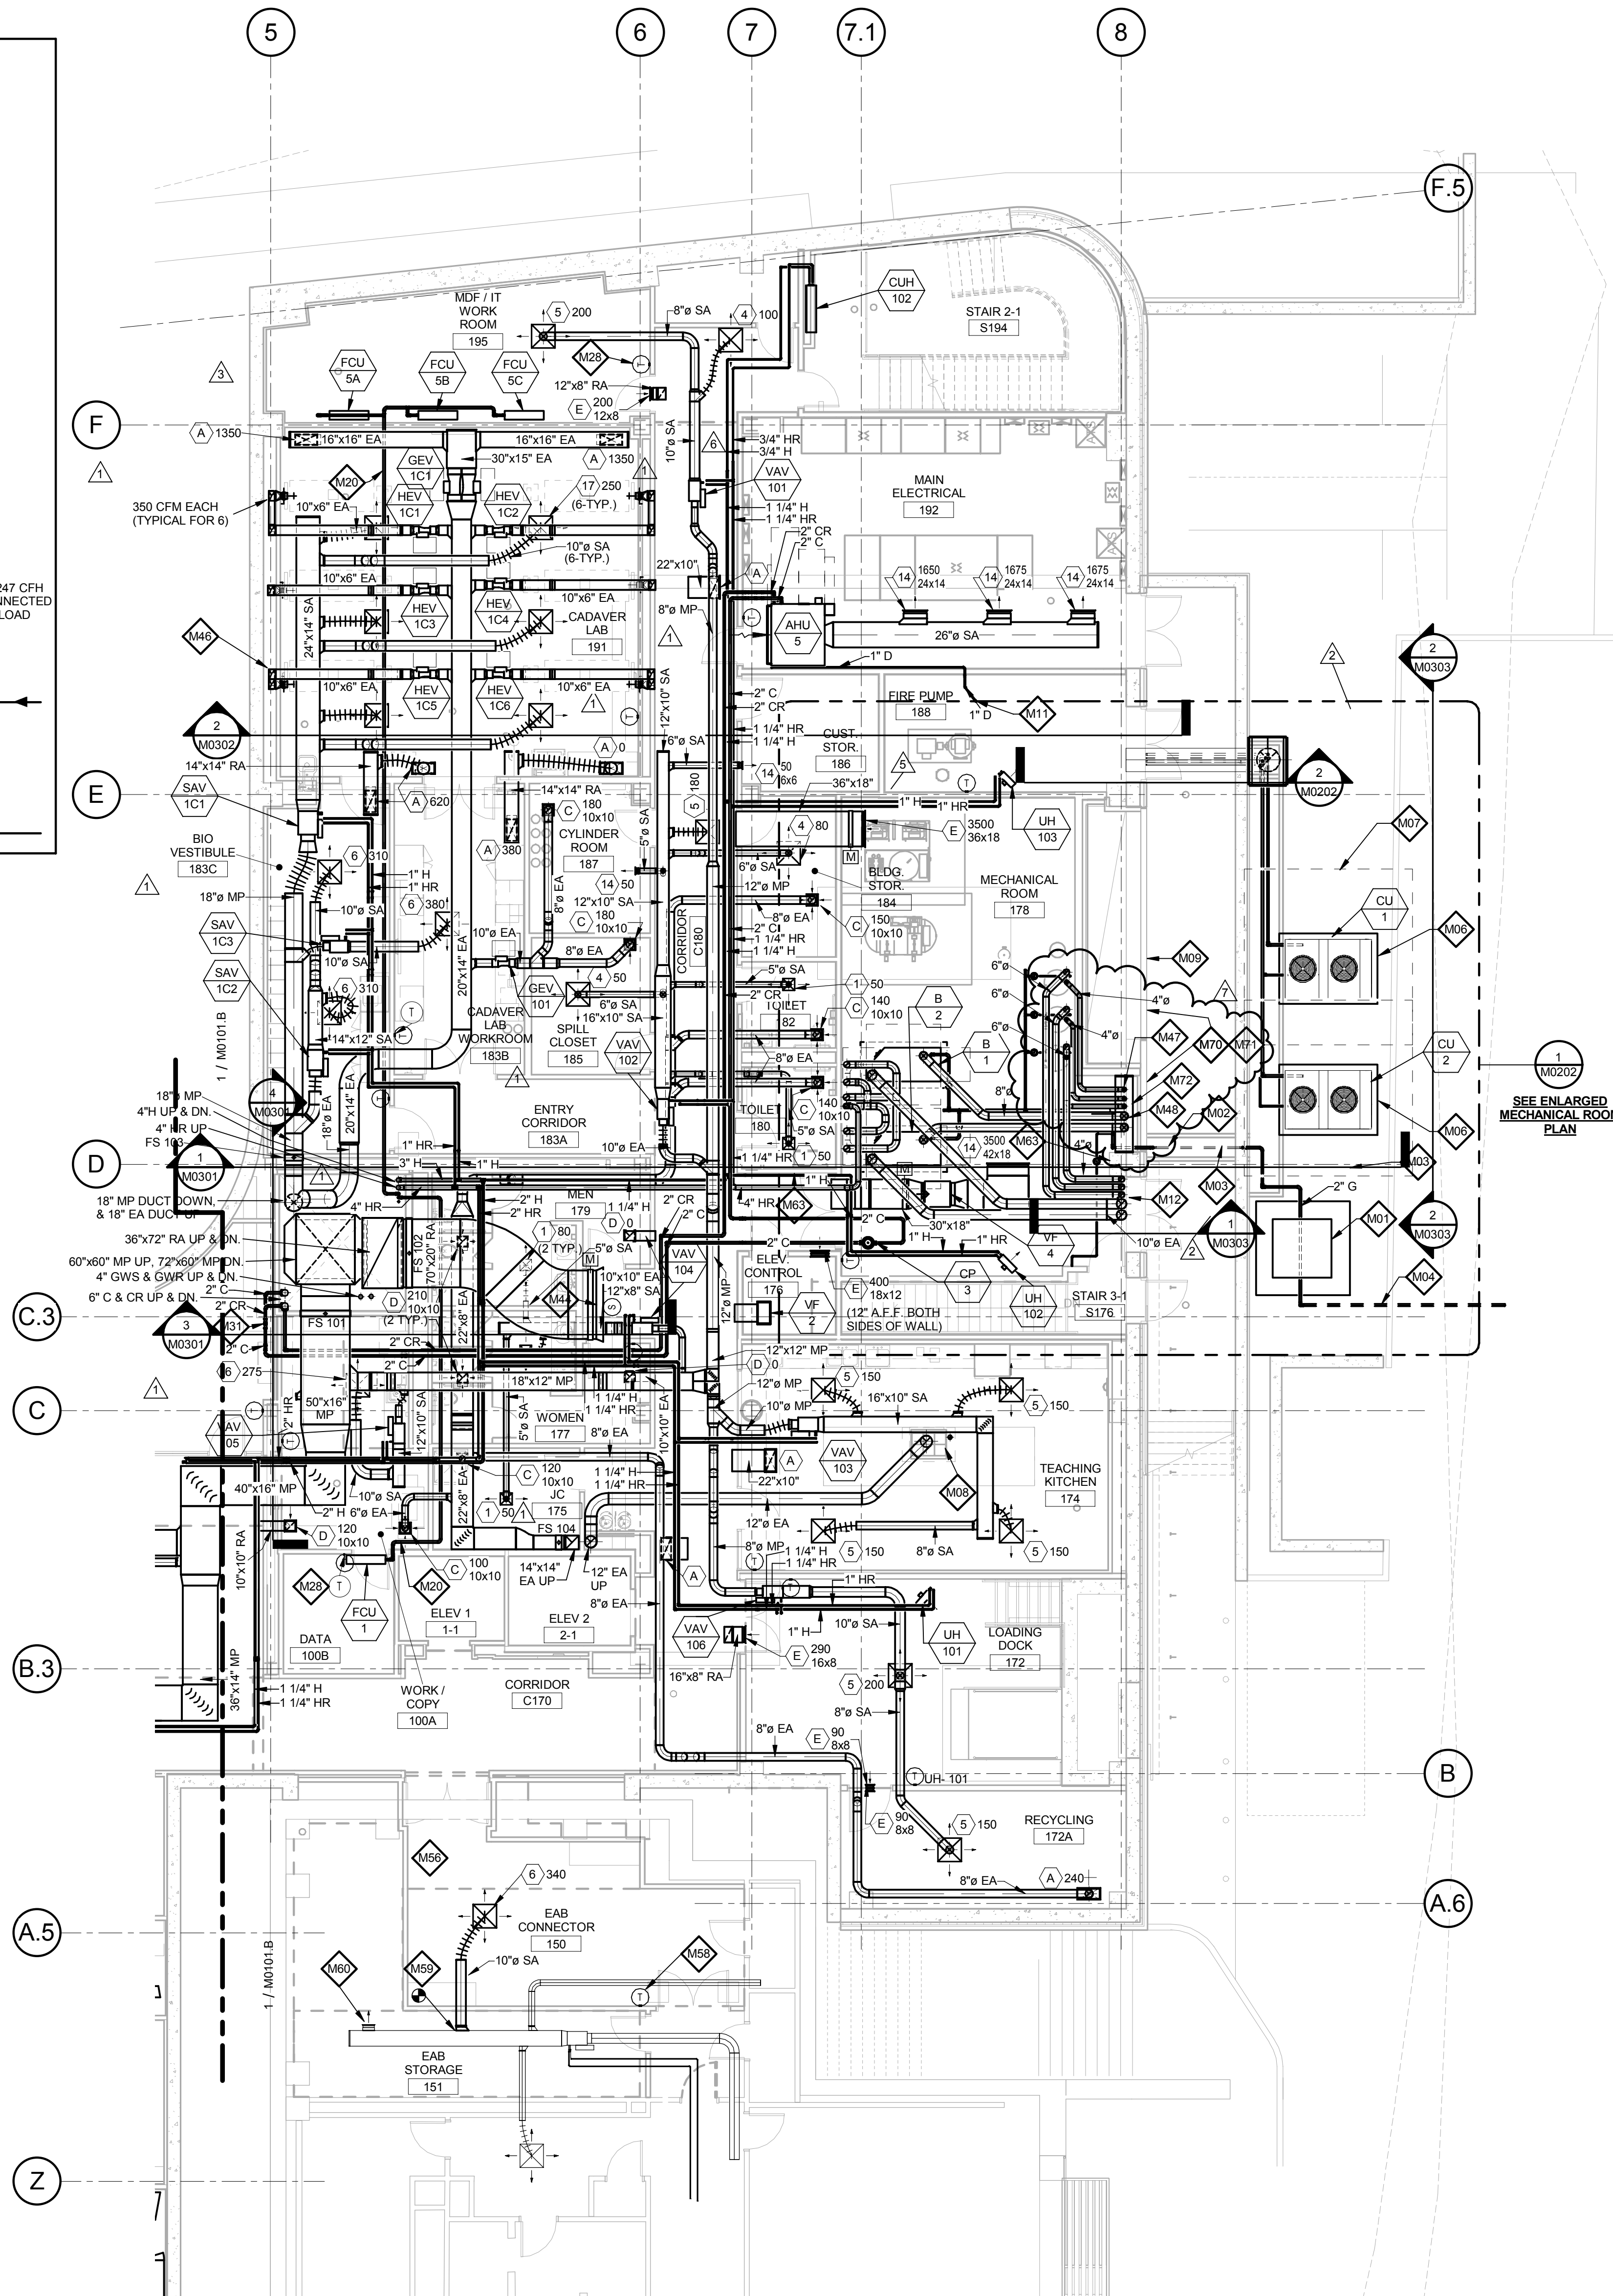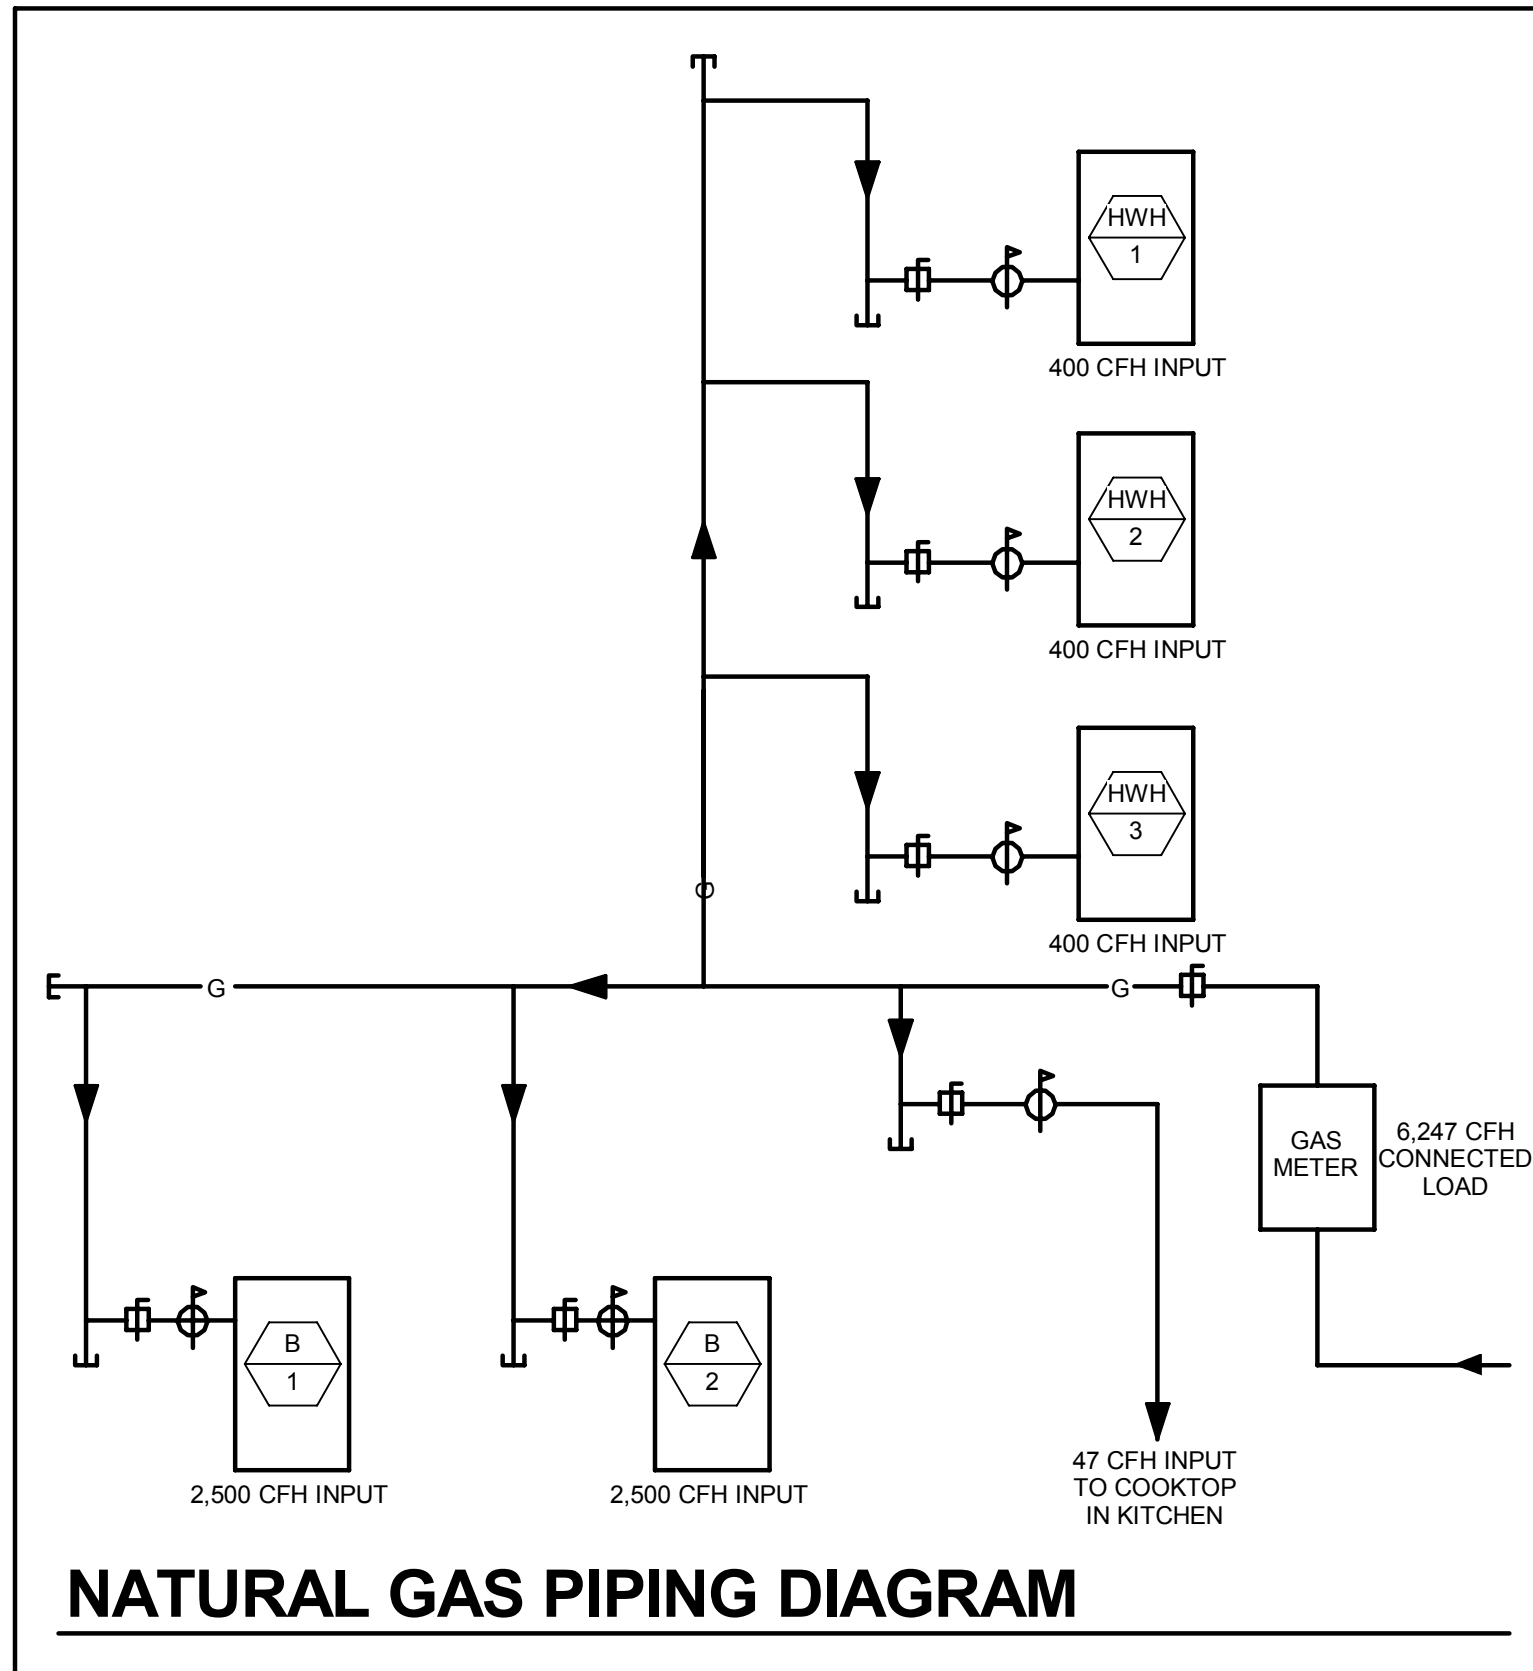

GENERAL NOTES:

- Because of the limited space available to install all of the mechanical work, coordination between the various trades is of the utmost importance. This contractor shall coordinate with all other trades prior to the fabrication and installation of any work.
- Refer to the reflected ceiling plans for ceiling construction, ceiling grid layout, ceiling mounted devices, and coordinate exact location and mounting type of all air devices.
- All ductwork upstream of terminal units shall be Medium Pressure (MP). All ductwork downstream of terminal units shall be Low Pressure (LP). Refer to specifications.
- All ductwork dimensions indicated on plans are sheet metal sizes. All medium pressure ductwork shall be unlined, externally insulated. All low pressure ductwork shall be lined. See specifications.
- All mitered 90° rectangular elbows shall be furnished with turning vanes having maximum $c = 0.12$. All smooth radius rectangular elbows shall have a throat radius greater than one half the duct width, unless furnished with splitter vanes. Under no circumstances shall the throat radius be less than one third the duct width. Unless otherwise noted or specified.
- Contractor shall furnish and install volume dampers for each duct take-off unless otherwise noted. See detail.
- Maximum length of Low Pressure (LP) flexible ductwork shall be 8'-0". Round LP duct of lengths greater than 8'-0" shall be rigid round. Flexible duct sizes on plans shall be neck size of diffusers or as indicated. See specifications.
- Maximum length of Medium Pressure (MP) flexible ductwork shall be 2'-0". Round MP duct of lengths greater than 2'-0" shall be rigid round. Flexible duct sizes on plans shall be air Terminal Unit inlet size or as indicated. See specifications.
- All ductwork runouts to Air Terminal Units and diffusers shall be the connection size unless otherwise noted.
- Piping runouts to terminal units shall be 3/4" unless otherwise noted. Refer to reheat box schedule.
- Verify exact location of thermostats, humidistats, BAS sensors, and other exposed control sensors with architectural elevations and drawings before installation.
- Schedule systems or equipment shut downs required for new construction with owner two weeks in advance. Some premium time work may be required.
- Refer to piping details for final connections to equipment.
- Provide service shut-off valves in major piping branch lines. All connections to risers and each building wing, A & B.

KEYED NOTES

- M01** PROPOSED GAS METER LOCATION: COORDINATE WITH LOCAL NATURAL GAS UTILITY COMPANY FOR METER SET SIZED FOR A TOTAL CONNECTED LOAD OF 6,247-CFH WITH A DELIVERY PRESSURE OF 2-PSIG. PROVIDE CONCRETE METER PAD PER THE LOCAL GAS COMPANY'S REQUIREMENTS AND SIZE.
- M02** 2-INCH MAIN BUILDING NATURAL GAS LINE ABOVE GRADE WITH SHUT-OFF VALVE.
- M03** 2-INCH NATURAL GAS LINE IN OPEN TRENCH WITH STEEL GRATING. SEE CIVIL DRAWINGS. SUPPORT PIPING WITH STAINLESS STEEL UNISTRUT FRAMING, MINIMUM 2-INCHES ABOVE TRENCH FLOOR.
- M04** NATURAL GAS MAIN EXTENSION BELOW GRADE BY LOCAL GAS COMPANY.
- M06** CONCRETE BASE FOR MECHANICAL EQUIPMENT, SEE CIVIL DRAWINGS. VERIFY SIZE WITH APPROVED SHOP DRAWINGS.
- M07** DASHED LINES INDICATE RECOMMENDED SERVICE, COIL PULLING SPACE, FILTER REMOVAL SPACE, AND/OR AIRFLOW CLEARANCES.
- M08** 3/4-INCH NATURAL GAS LINE BELOW SLAB WITHIN VENTED SLEEVE. SEE LOWER LEVEL FLOOR PLAN FOR CONTINUATION. PROVIDE GAS SHUT-OFF VALVE AND FLEXIBLE HOSE ADAPTER. FINAL CONNECTION TO COOK TOP BY KITCHEN EQUIPMENT INSTALLER.
- M09** OUTSIDE AIR INTAKE LOUVER, SEE ARCHITECTURAL DRAWINGS.
- M11** TERMINATE COOLING COIL DRAIN LINE OVER NEAREST FLOOR DRAIN OR INDIRECT WASTE. PROVIDE TRAP AS INDICATED ON PIPING DETAIL.
- M12** BOILER AND DOMESTIC WATER HEATER FLUES UP THROUGH ROOF.
- M20** REFRIGERANT LIQUID AND SUCTION PIPING BETWEEN DX COOLING COILS AND CONDENSING UNITS. COORDINATE PIPE SIZES WITH MANUFACTURER. PROVIDE 3/4" DRAIN LINE. ROUTE WITH REFRIGERANT PIPING, AND TERMINATE DRAINS FROM FCU-1, 2, 5A, 5B, AND 5C OVER FLOOR DRAIN IN LOWER LEVEL MECHANICAL ROOM. TERMINATE DRAINS FROM FCU-3 AND 4 OVER SERVICE SINK IN JANITORS CLOSET 375.
- M28** BAS TEMPERATURE SENSOR TO MONITOR IT/TCOM SPACES. FCU CONTROLLED BY UNIT MOUNTED THERMOSTAT.
- M31** 3-WAY CONTROL VALVE, SEE CHILLED WATER PIPING DIAGRAM.
- M44** AIRFLOW MEASURING STATION, KELE MODEL KOAMS FURNISHED WITH INLET BELL FOR PLENUM APPLICATIONS LOCATED IN MINIMUM OA DUCT OR RETURN AIR INLET ON EACH FLOOR.
- M46** EXHAUST DUCT DOWN THROUGH CHASE FOR DOWNDRAFT TABLE. VERIFY DUCT CONNECTION SIZE AND LOCATION. PROVIDE MANUAL DAMPER AND CONNECTION ADAPTER TO TABLE.
- M47** CONNECT DOMESTIC WATER HEATER COMBUSTION AIR DUCTS TO TOP OF PLENUM BOX AT LOUVER.
- M48** CONNECT HEATING HOT WATER BOILER COMBUSTION AIR DUCTS TO TOP OF PLENUM BOX AT LOUVER.
- M56** MODIFY EXISTING LOW PRESSURE SUPPLY DUCTWORK IN THIS AREA FOR NEW WALLS. REMOVE EXISTING DUCT MOUNTED AIR DEVICES AND PATCH DUCTWORK AIR-TIGHT. INSTALL NEW CEILING DIFFUSERS AND RETURN AIR GRILLE AS SHOWN AND AS REQUIRED FOR NEW CEILINGS.
- M57** REMOVE EXISTING DUCT MOUNTED AIR DEVICE AND CAP WITH SHEETMETAL. SEAL AIR-TIGHT.
- M58** NEW LOCATION FOR EXISTING TEMPERATURE SENSOR.
- M59** NEW CONNECTION TO EXISTING DUCTWORK.
- M60** EXISTING AIR DEVICE TO REMAIN. BALANCE TO 60-CFM.
- M61** RELOCATION EXISTING TEMPERATURE SENSOR.
- M63** INSTALL BOILER SAFETY SWITCH AND SIGN. COORDINATE LOCATION WITH OWNER, ARCHITECT, AND ALL OTHER TRADES.
- M70** REFER TO ARCHITECTURAL PLANS FOR ADDITIONAL LOUVER INFORMATION.
- M71** BLANK OFF ALL UNUSED PORTIONS OF LOUVER WITH INSULATED METAL PANEL PAINTED BLACK BEHIND LOUVER.
- M72** PROVIDE 78"x18" INSULATED PLENUM BOX AT LOUVER FOR COMBUSTION AIR INTAKES. SLOPE BOTTOM OF PLENUM PER DETAIL ON SHEET M0501.

THE SEALS(S) AND SIGNATURE(S) APPLY ONLY TO THE DOCUMENT TO WHICH THEY ARE AFFIXED, AND EXPRESSLY DISCLAIM ANY RESPONSIBILITY FOR ALL OTHER PLANS, SPECIFICATIONS, ESTIMATES, REPORTS OR OTHER DOCUMENTS OR INSTRUMENTS RELATING TO OR INTENDED TO BE USED FOR ANY PART OR PARTS OF THE ARCHITECTURAL OR ENGINEERING PROJECT.

Webster
UNIVERSITY

Webster University
Interdisciplinary Science
Building

CANNONDESIGN

1100 Clark Avenue
St. Louis, Missouri 63102
T: 314.241.6250
F: 314.241.2570

William Tao & Associates, Inc.
MEP/FP Engineer
7955 Manchester Road, Suite 125
St. Louis, MO 63143
314-884-7600

David Mason & Associates, Inc.
Structural & Civil Engineer
800 South Vandeventer Avenue
St. Louis, MO 63110
314.534.1053

Faith Group
Technology
3101 S. Hanley Rd., Suite 100
St. Louis, MO 63143
314.591.2225

Kuhlmann Leavitt, Inc.
Environmental Graphics & Signage
7400 Pershing Ave.
St. Louis, MO 63130
314.725.6616


KWA Architects
Architecture
8721 Litzinger Road
St. Louis, MO 63124
314.962.2560

Spellman Brady & Company
Interior Designer
8251 Maryland Avenue, Suite 300
St. Louis, MO 63105
314.862.0070

SWT Design
Landscape Architect
7722 Big Bend Blvd.
St. Louis, MO 63119
314.644.5700

Webb Engineering Services, Inc.
Planning & Fire Protection
1400 S. 3rd Street, Suite 201
St. Louis, MO 63104
314.588.0600

7	ASI-059	16 FEB 2017
6	ASI-043	20 DEC 2016
5	ASI-034	04 NOV 2016
4	ASI-032	18 OCT 2016
3	ADDENDUM 2-4	24 MAY 2016
2	ADDENDUM 2-2	19 APRIL 2016
1	ADDENDUM 2-1	17 MAR 2016
-	ISSUED FOR CONSTRUCTION (BP2)	01 MAR 2016

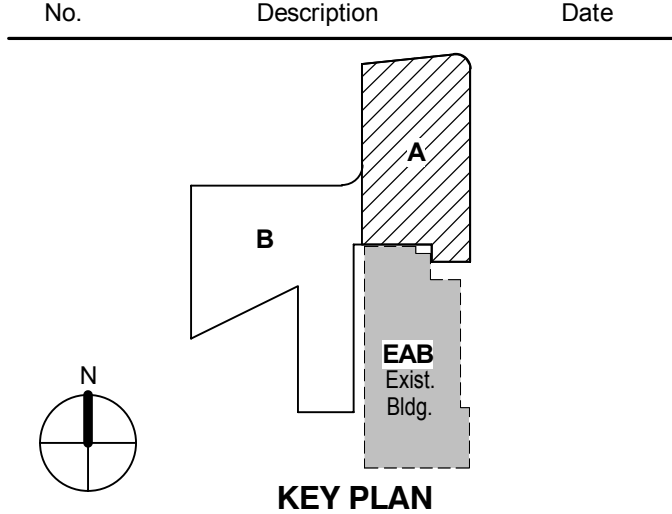

LEVEL 01 AREA A FLOOR PLAN - MECHANICAL


Project No.: 04561.01 Checked by:

M0101.A



© Cannon Design 2015

© Cannon Design 2015
All rights reserved. No part of this document may be reproduced or transmitted in any form or by any means, electronic or mechanical, including photocopying, recording, or by any information storage and retrieval system, without written authorization by The Cannon Corporation.
2/16/2017 11:08:39 AM

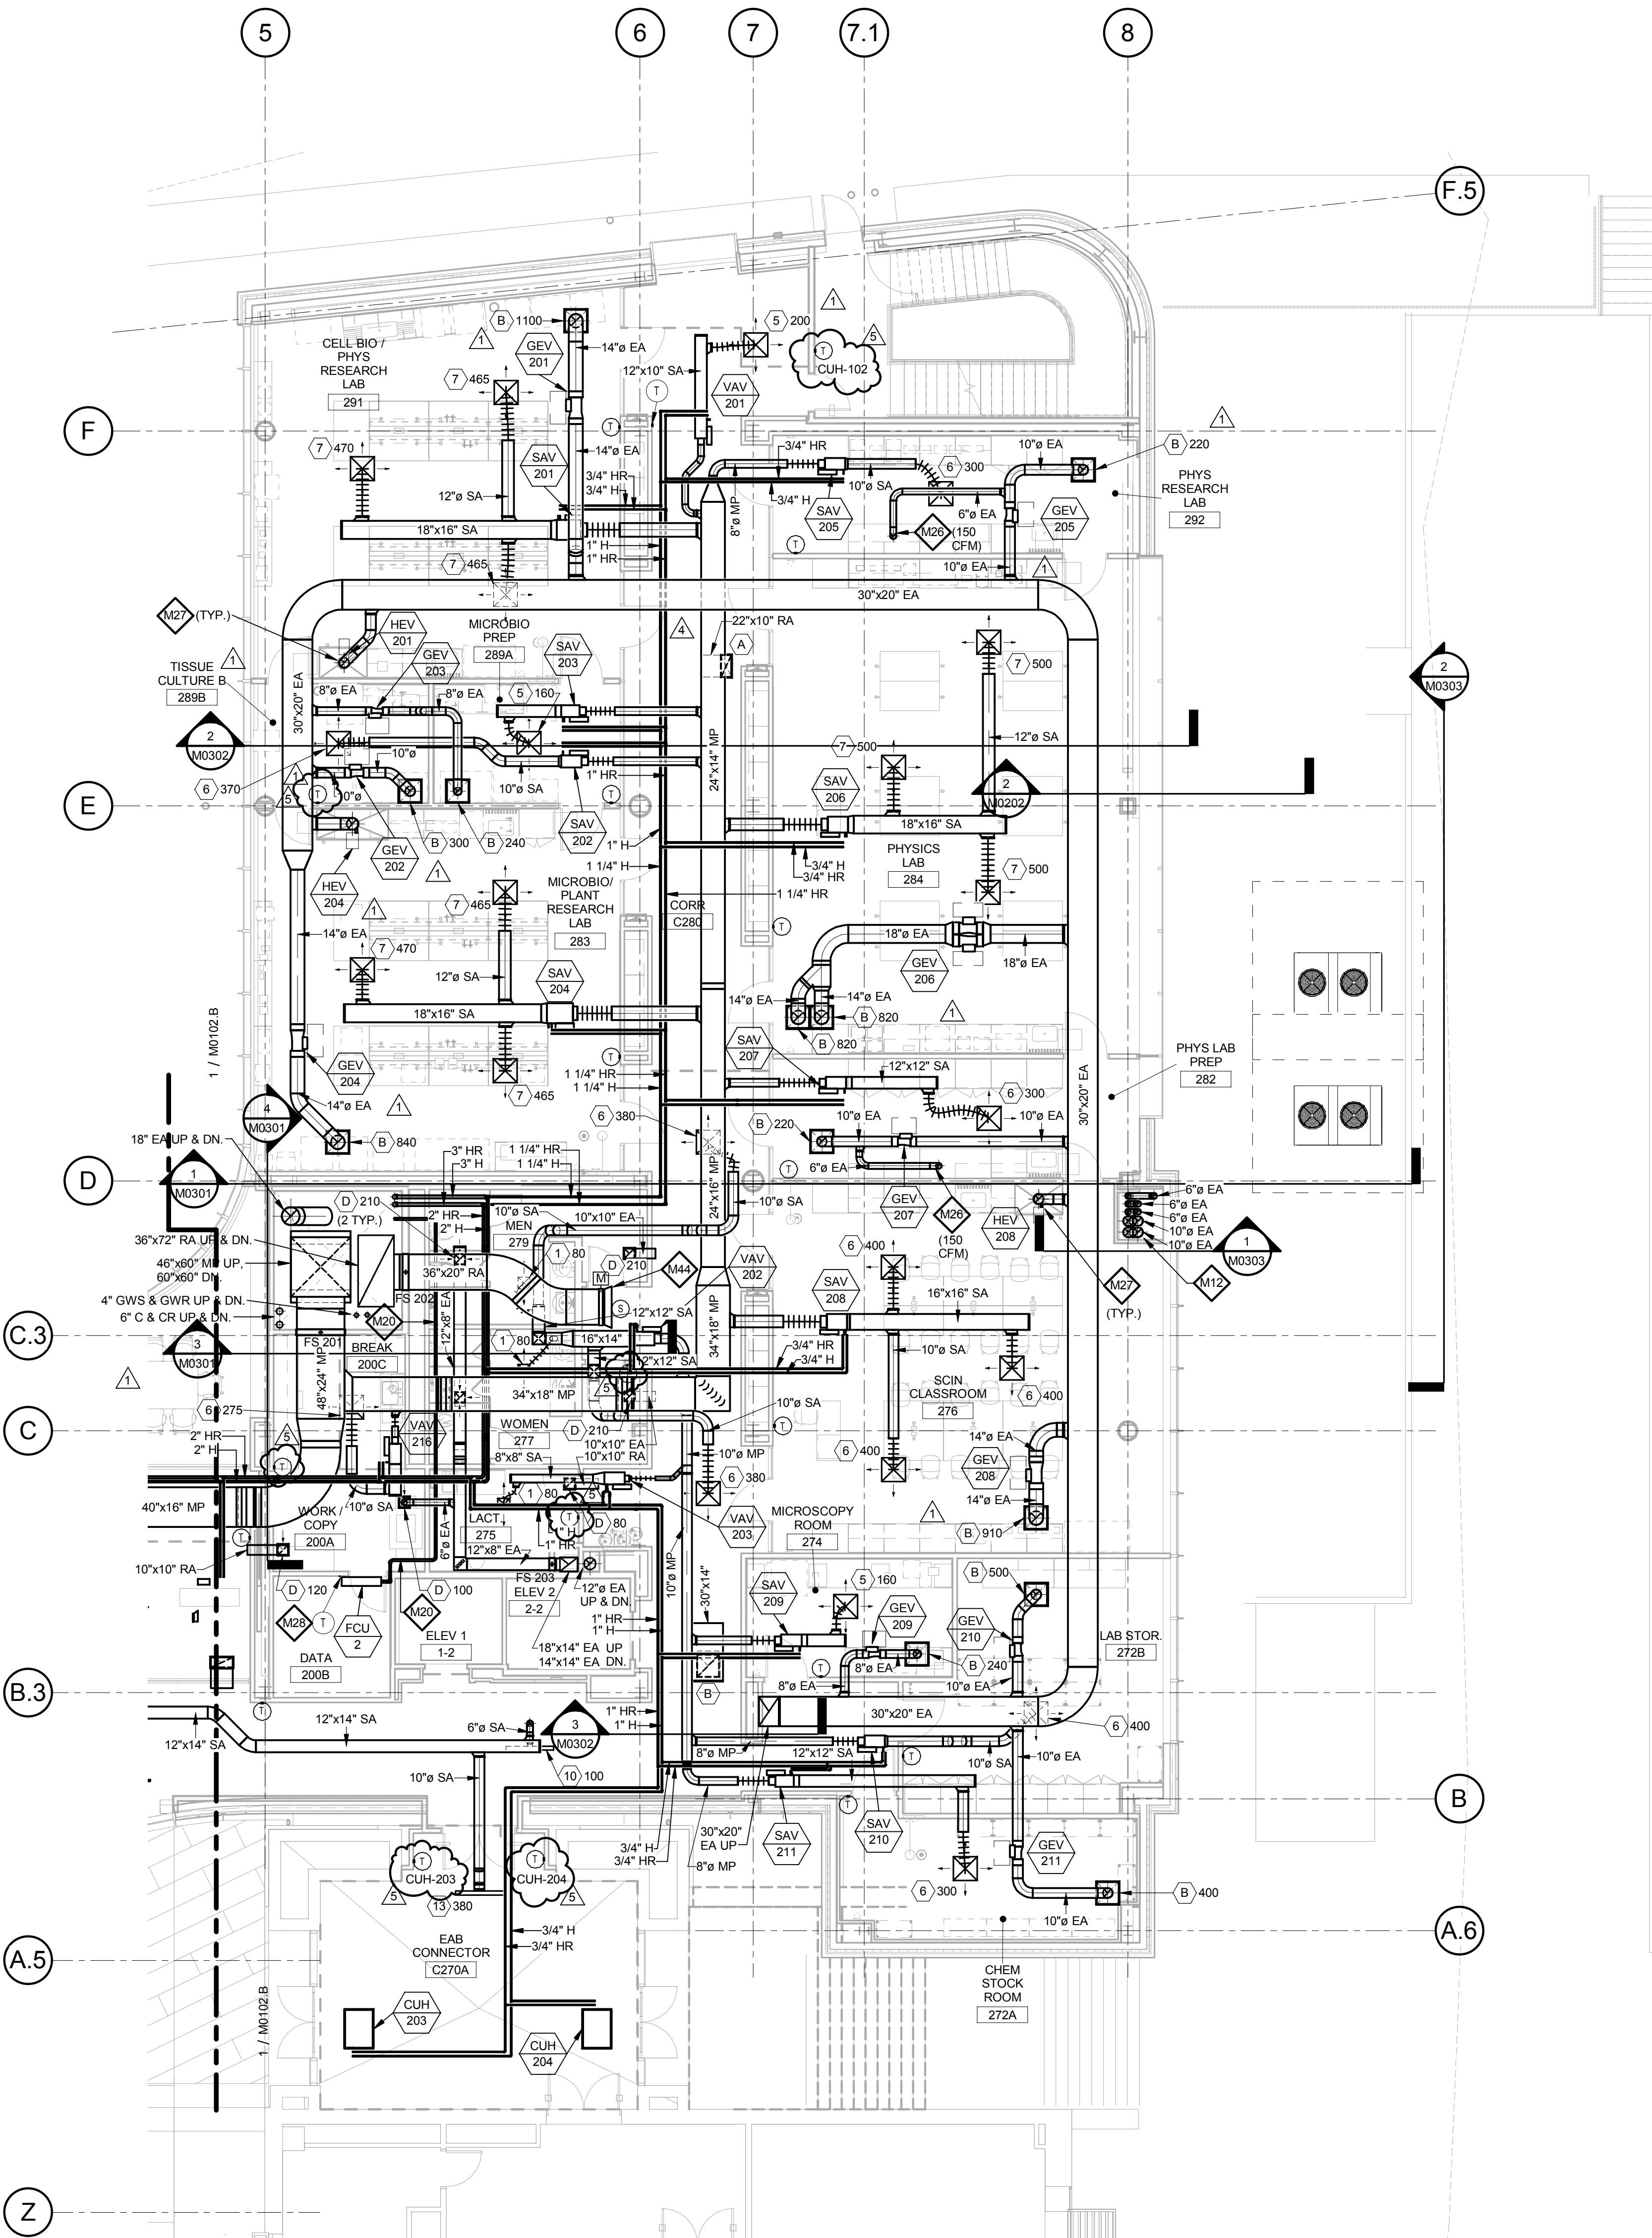

GENERAL NOTES:

- Because of the limited space available to install all of the mechanical work, coordination between the various trades is of the utmost importance. This contractor shall coordinate with all other trades prior to the fabrication and installation of any work.
- Refer to the reflected ceiling plans for ceiling construction, ceiling grid layout, ceiling mounted devices, and coordinate exact location and mounting type of all air devices.
- All ductwork upstream of terminal units shall be Medium Pressure (MP). All ductwork downstream of terminal units shall be Low Pressure (LP). Refer to specifications.
- All ductwork dimensions indicated on plans are sheet metal sizes. All medium pressure ductwork shall be unlined, externally insulated. All low pressure ductwork shall be lined. See specifications.
- All mitered 90° rectangular elbows shall be furnished with turning vanes having maximum $c = 0.12$. All smooth radius rectangular elbows shall have a throat radius greater than one half the duct width, unless furnished with splitter vanes. Under no circumstances shall the throat radius be less than one third the duct width. Unless otherwise noted or specified.
- Contractor shall furnish and install volume dampers for each duct take-off unless otherwise noted. See detail.
- Maximum length of Low Pressure (LP) flexible ductwork shall be 8'-0". Round LP duct of lengths greater than 8'-0" shall be rigid round. Flexible duct sizes on plans shall be neck size of diffusers or as indicated. See specifications.
- Maximum length of Medium Pressure (MP) flexible ductwork shall be 2'-0". Round MP duct of lengths greater than 2'-0" shall be rigid round. Flexible duct sizes on plans shall be air Terminal Unit inlet size or as indicated. See specifications.
- All ductwork runouts to Air Terminal Units and diffusers shall be the connection size unless otherwise noted.
- Piping runouts to terminal units shall be 3/4" unless otherwise noted. Refer to reheat box schedule.
- Verify exact location of thermostats, humidistats, BAS sensors, and other exposed control sensors with architectural elevations and drawings before installation.
- Schedule systems or equipment shut downs required for new construction with owner two weeks in advance. Some premium time work may be required.
- Refer to piping details for final connections to equipment.
- Provide service shut-off valves in major piping branch lines. All connections to risers and each building wing: A & B.

KEYED NOTES

- M12** BOILER AND DOMESTIC WATER HEATER FLUES UP THROUGH ROOF.
- M20** REFRIGERANT LIQUID AND SUCTION PIPING BETWEEN DX COOLING COILS AND CONDENSING UNITS. COORDINATE PIPE SIZES WITH MANUFACTURER. PROVIDE 3/4" DRAIN LINE, ROUTE WITH REFRIGERANT PIPING, AND TERMINATE DRAINS FROM FCU-1, 2, 5A, 5B, AND 5C OVER FLOOR DRAIN IN LOWER LEVEL MECHANICAL ROOM. TERMINATE DRAINS FROM FCU-3 AND 4 OVER SERVICE SINK IN JANITORS CLOSET 375.
- M26** 6-INCH ROUND EXHAUST DUCT FOR SNORKEL EXHAUST. COORDINATE FINAL CONNECTION TO SNORKEL WITH ARCHITECTURAL DRAWINGS.
- M27** INSTALL HOOD EXHAUST VALVE IN VERTICAL POSITION NEAR HOOD. ELBOWS SHALL HAVE 1.5 DIAMETER RADIUS. USE 1.0 DIAMETER RADIUS ELBOWS ONLY WHERE NECESSARY.
- M28** BAS TEMPERATURE SENSOR TO MONITOR IT/COM SPACES. FCU CONTROLLED BY UNIT MOUNTED THERMOSTAT.
- M44** AIRFLOW MEASURING STATION, KELE MODEL KOAMS FURNISHED WITH INLET BELL FOR PLENUM APPLICATIONS LOCATED IN MINIMUM OA DUCT OR RETURN AIR INLET ON EACH FLOOR.

THE SEALS(S) AND SIGNATURE(S) APPLY ONLY TO THE DOCUMENT TO WHICH THEY ARE AFFIXED, AND EXPRESSLY DISCLAIM ANY RESPONSIBILITY FOR ALL OTHER PLANS, SPECIFICATIONS, ESTIMATES, REPORTS OR OTHER DOCUMENTS OR INSTRUMENTS RELATING TO OR INTENDED TO BE USED FOR ANY PART OR PARTS OF THE ARCHITECTURAL OR ENGINEERING PROJECT.

Webster
UNIVERSITY

Webster University
Interdisciplinary Science
Building

CANNONDESIGN

1100 Clark Avenue
St. Louis, Missouri 63102
T: 314.241.6250
F: 314.241.2570

William Tao & Associates, Inc.
MEP/FP Engineer
7955 Manchester Road, Suite 125
St. Louis, MO 63143
314-884-7600

David Mason & Associates, Inc.
Structural & Civil Engineer
800 South Vandeventer Avenue
St. Louis, MO 63110
314.534.1053

Faith Group
Technology
3101 S. Hanley Rd., Suite 100
St. Louis, MO 63143
314.591.2229

Kuhmann Leavitt, Inc.
Environmental Graphics & Signage
7400 Pershing Ave.
St. Louis, MO 63130
314.725.6616


KWA Architects
Architecture
8721 Litzinger Road
St. Louis, MO 63124
314.962.2560

Spellman Brady & Company
Interior Designer
8251 Maryland Avenue, Suite 300
St. Louis, MO 63105
314.862.0070

SWT Design
Landscape Architect
7722 Big Bend Blvd
St. Louis, MO 63119
314.644.5700

Webb Engineering Services, Inc.
Planning & Fire Protection
1400 S. 3rd Street, Suite 201
St. Louis, MO 63104
314.588.0600

5	ASI-050	16 FEB 2017
4	ASI-043	20 DEC 2016
3	ASI-034	04 NOV 2016
2	ASI-032	18 OCT 2016
1	ADDENDUM 2-1	17 MAR 2016
-	ISSUED FOR CONSTRUCTION (BP2)	01 MAR 2016

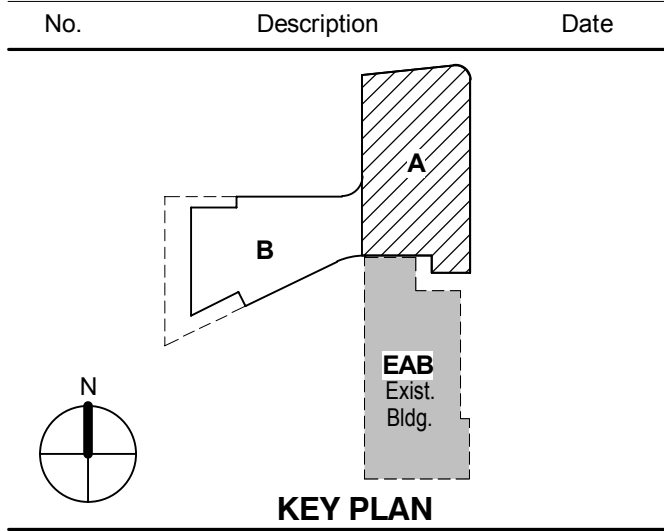

Drawing Title:

**LEVEL 02 AREA A FLOOR
PLAN - MECHANICAL**


Project No.: 04561.01 Checked by:

M0102.A

© Cannon Design 2015

© Cannon Design 2015
All rights reserved. No part of this document may be reproduced or transmitted in any form or by any means, electronic or mechanical, including photocopying, recording, or by any information storage and retrieval system, without written authorization by The Cannon Corporation.
2/16/2017 11:07:59 AM

2/16/2017 11:07:58 AM WTA 14127.01 D:\Autodesk\Revit 2015 Local\14127.01.WU_WTA_ME_CAR.rvt

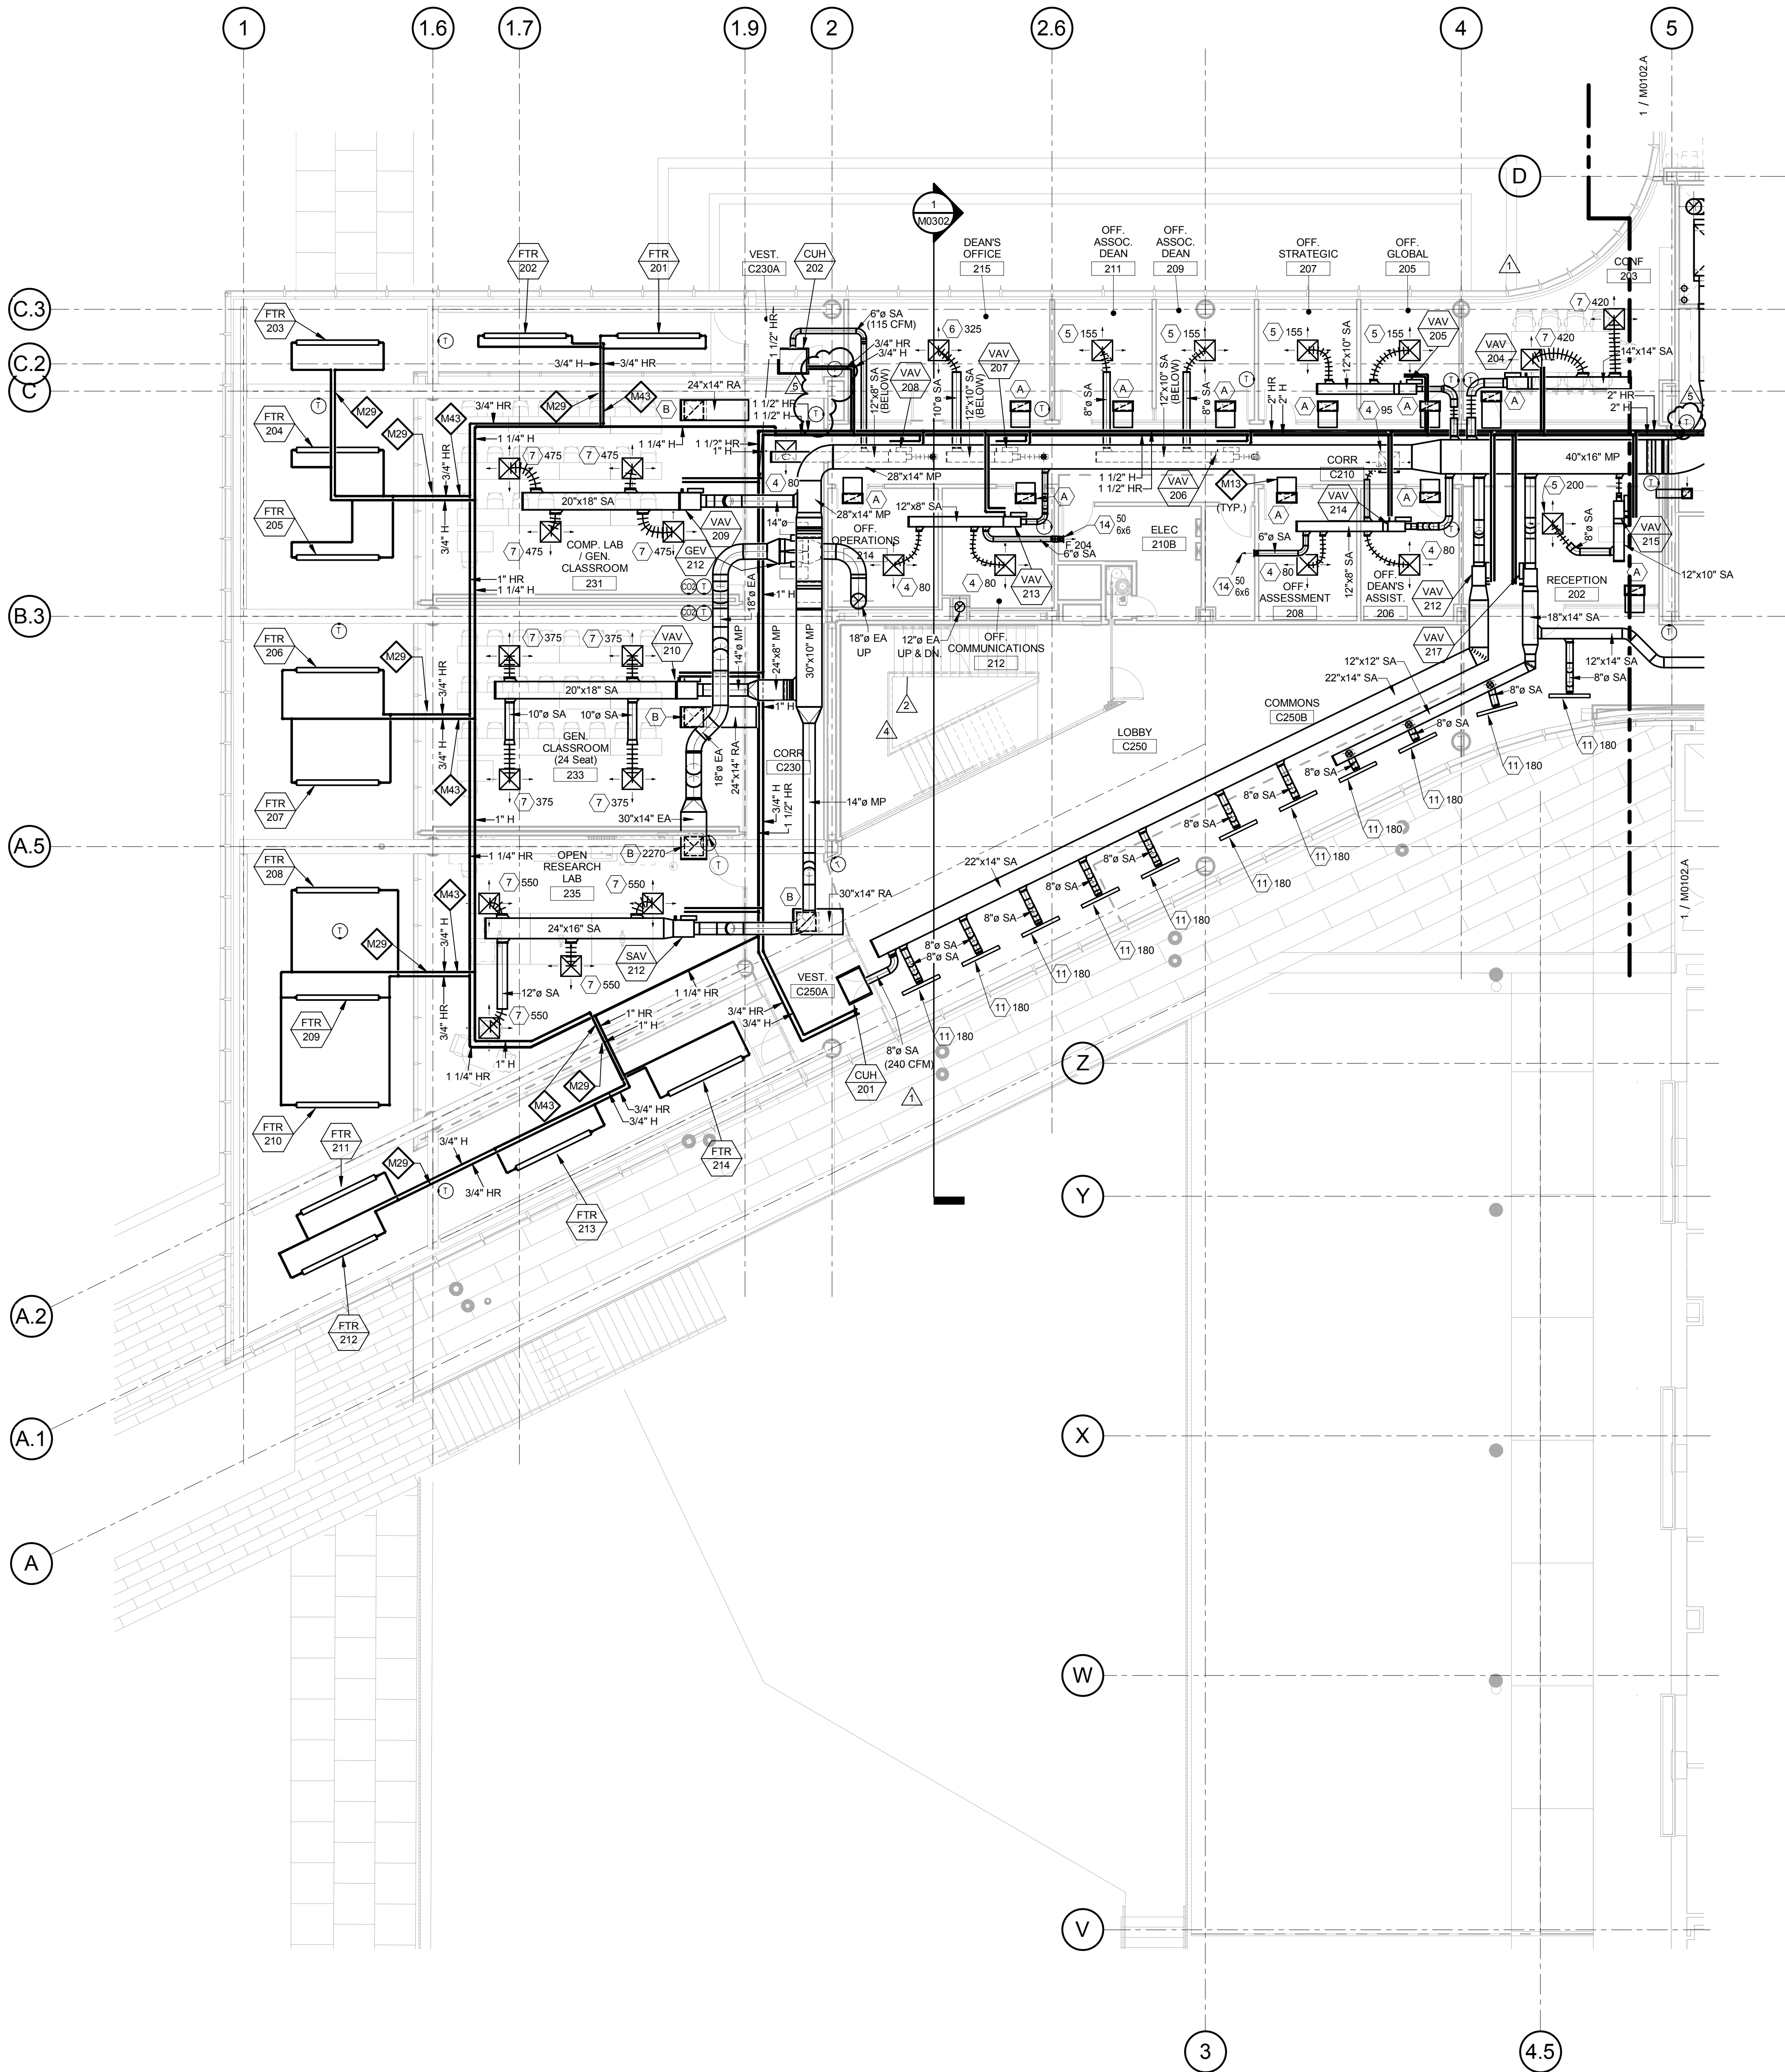

1 LEVEL 02 - AREA B - MECHANICAL PLAN
1/8" = 1'-0"

GENERAL NOTES:

- A. Because of the limited space available to install all of the mechanical work, coordination between the various trades is of the utmost importance. This contractor shall coordinate with all other trades prior to the fabrication and installation of any work.
- B. Refer to the reflected ceiling plans for ceiling construction, ceiling grid layout, ceiling mounted devices, and coordinate exact location and mounting type of all air devices.
- C. All ductwork upstream of terminal units shall be Medium Pressure (MP). All ductwork downstream of terminal units shall be Low Pressure (LP). Refer to specifications.
- D. All ductwork dimensions indicated on plans are sheet metal sizes. All medium pressure ductwork shall be unlined, externally insulated. All low pressure ductwork shall be lined. See specifications.
- E. All mitered 90° rectangular elbows shall be furnished with turning vanes having maximum c = 0.12. All smooth radius rectangular elbows shall have a throat radius greater than one half the duct width, unless furnished with splitter vanes. Under no circumstances shall the throat radius be less than one third the duct width. Unless otherwise noted or specified.
- F. Contractor shall furnish and install volume dampers for each duct take-off unless otherwise noted. See detail.
- G. Maximum length of Low Pressure (LP) flexible ductwork shall be 8'-0". Round LP duct of lengths greater than 8'-0" shall be rigid round. Flexible duct sizes on plans shall be neck size of diffusers or as indicated. See specifications.
- H. Maximum length of Medium Pressure (MP) flexible ductwork shall be 2'-0". Round MP duct of lengths greater than 2'-0" shall be rigid round. Flexible duct sizes on plans shall be air Terminal Unit inlet size or as indicated. See specifications.
- I. All ductwork runouts to Air Terminal Units and diffusers shall be the connection size unless otherwise noted.
- J. Piping runouts to terminal units shall be 3/4" unless otherwise noted. Refer to reheat box schedule.
- K. Verify exact location of thermostats, humidistats, BAS sensors, and other exposed control sensors with architectural elevations and drawings before installation.
- L. Schedule systems or equipment shut downs required for new construction with owner two weeks in advance. Some premium time work may be required.
- M. Refer to piping details for final connections to equipment.
- N. Provide service shut-off valves in major piping branch lines. All connections to risers and each building wing, A & B.

KEYED NOTES

- M13 LINED RETURN AIR TRANSFER DUCT, 22x10 TYPICAL UNLESS NOTED OTHERWISE.
- M28 BAS TEMPERATURE SENSOR TO MONITOR IT/TCOM SPACES. FCU CONTROLLED BY UNIT MOUNTED THERMOSTAT.
- M29 PIPING THROUGH HOLE IN BEAM. COORDINATE WITH STRUCTURAL DRAWINGS.
- M43 INSTALL CONTROL VALVES AND SERVICE SHUT-OFF VALVES ABOVE ACCESSIBLE CEILING. PROVIDE FLOW MEASURING AND BALANCING VALVE AT EACH FTR ELEMENT. BALANCE WATER FLOW BEFORE OVERHANG ENCLOSURE IS INSTALLED.

THE SEALS(S) AND SIGNATURE(S) APPLY ONLY TO THE DOCUMENT TO WHICH THEY ARE AFFIXED, AND EXPRESSLY DISCLAIM ANY RESPONSIBILITY FOR ALL OTHER PLANS, SPECIFICATIONS, ESTIMATES, REPORTS OR OTHER DOCUMENTS OR INSTRUMENTS RELATING TO OR INTENDED TO BE USED FOR ANY PART OR PARTS OF THE ARCHITECTURAL OR ENGINEERING PROJECT.

Webster
UNIVERSITY

Webster University
Interdisciplinary Science
Building

CANNONDESIGN

1100 Clark Avenue
St. Louis, Missouri 63102
T: 314.241.6250
F: 314.241.2570

William Tao & Associates, Inc.
ME/P/FP Engineer
7955 Manchester Road, Suite 125
St. Louis, MO 63143
314-884-7600

David Mason & Associates, Inc.
Structural & Civil Engineer
800 South Vandeventer Avenue
St. Louis, MO 63110
314.534.1053

Faith Group
Technology
3101 S. Hanley Rd., Suite 100
St. Louis, MO 63143
314.591.2225

Kuhmann Leavitt, Inc.
Environmental Graphics & Signage
7400 Pershing Ave.
St. Louis, MO 63130
314.725.6616


KWA Architects
Architecture
8721 Litzinger Road
St. Louis, MO 63124
314.962.2560

Spellman Brady & Company
Interior Designer
8251 Maryland Avenue, Suite 300
St. Louis, MO 63105
314.862.0070

SWT Design
Landscape Architect
7722 Big Bend Blvd.
St. Louis, MO 63119
314.644.5700

Webb Engineering Services, Inc.
Plumbing & Fire Protection
1400 S. 3rd Street, Suite 201
St. Louis, MO 63104
314.588.0600

5	ASI-050	16 FEB 2017
4	ASI-043	20 DEC 2016
3	ASI-032	18 OCT 2016
2	ASI-009	01 AUG 2016
1	ADDENDUM 2-1	17 MAR 2016
-	ISSUED FOR CONSTRUCTION (BP2)	01 MAR 2016

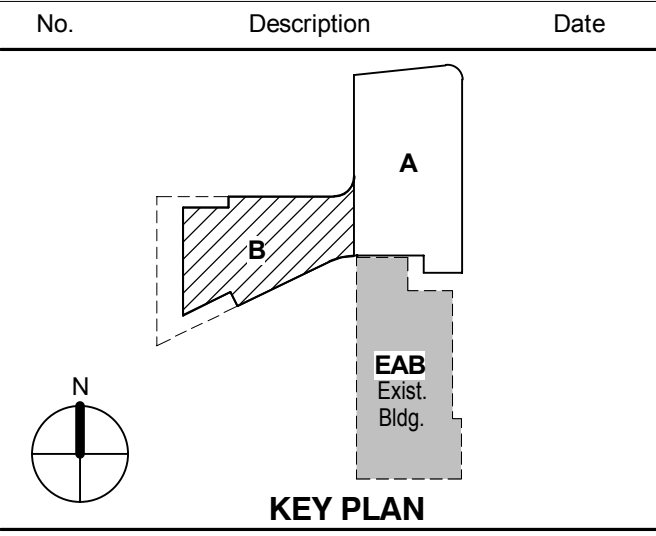

Drawing Title:

**LEVEL 02 AREA B FLOOR
PLAN - MECHANICAL**

Project No.: 04561.01 Checked by:

M0102.B

© Cannon Design 2015



THE SEAL(S) AND SIGNATURE(S) APPLY ONLY TO THE DOCUMENT TO WHICH THEY ARE AFFIXED, AND EXPRESSLY DISCLAIM ANY RESPONSIBILITY FOR ALL OTHER PLANS, SPECIFICATIONS, ESTIMATES, REPORTS OR OTHER DOCUMENTS OR INSTRUMENTS RELATING TO OR INTENDED TO BE USED FOR ANY PART OR PARTS OF THE ARCHITECTURAL OR ENGINEERING PROJECT.



Webster University
Interdisciplinary Science
Building

CANNONDESIGN

1100 Clark Avenue
St. Louis, Missouri 63102
T: 314.241.6250
F: 314.241.2570

William Tao & Associates, Inc.
MEP/FP Engineer
7955 Manchester Road, Suite 125
St. Louis, MO 63143
314-884-7600

David Mason & Associates, Inc.
Structural & Civil Engineer
800 South Vandeventer Avenue
St. Louis, MO 63110
314.534.1053

Faith Group
Technology
3101 S. Hanley Rd., Suite 100
St. Louis, MO 63143
314.591.2228

Kuhlmann Leavitt, Inc.
Environmental Graphics & Signage
7400 Pershing Ave.
St. Louis, MO 63130
314.725.6616

KWA Architects
Architecture
8721 Litzinger Road
St. Louis, MO 63124
314.962.2560

Spellman Brady & Company
Interior Designer
8251 Maryland Avenue, Suite 300
St. Louis, MO 63105
314.862.0070

SWT Design
Landscape Architect
1722 Big Bend Blvd.
St. Louis, MO 63119
314.644.5700

Webb Engineering Services, Inc.
Plumbing & Fire Protection
1400 S. 3rd Street, Suite 201
St. Louis, MO 63104
314.588.0600

AREA A SECTION - (LOOKING NORTH)

1/8" = 1'-0"

AREA A SECTION - (LOOKING NORTH)

1/8" = 1'-0"

AREA A SECTION - (LOOKING NORTH)