

Architect's Supplemental Instructions

Architect's Project No:
04561.01

Architect's ASI No: 057

Project:
Webster University
Interdisciplinary Science
Building

Date Issued: 04/06/2017

Contract Date:

Reason Code: 06 Owner's Scope

Discipline Code: 07 7 General Construction
(Architectural)

St. Louis
Baltimore
Boston
Buffalo
Calgary
Chicago
Houston
Los Angeles
Mumbai
New York
Phoenix
San Francisco
Shanghai
Toronto
Vancouver
Victoria
Washington DC

Owner:
Webster University

Architect:
Cannon Design
1100 Clark Avenue
St. Louis, MO 63102

Contractor:
Paric Construction

Contract For: General construction

The Work shall be carried out in accordance with the following supplemental instructions issued in accordance with the Contract Documents without change in Contract Sum or Contract Time. Indicate your acceptance of these instructions for minor change to the Work as consistent with the Contract Documents and return a copy to the Architect within fourteen (14) business days of the date of issuance of these instructions. If you feel a change in Contract Sum or Contract Time is warranted, please submit an itemized quotation for the changes for approval within fourteen (14) business days of the date of issuance of these instructions prior to proceeding on the Work. Proceeding with the Work in accordance with these instructions indicates your acknowledgement that there will be no change.

Attachments:

Sheets:
A0103.A, A0205, A0509.A, A0509.B, A0607, A0703.A, A0802.

1100 Clark Avenue
St. Louis, Missouri
63102
T: 314.241.6250
F: 314.241.2570
www.cannondesign.com

Reason Codes:
#1. Jurisdictional Agency
#2. Constructor Driven
#3. Document Inconsistency
#4. Fast Track Driven
#5. A/E Scope
#6. Owners Scope
#7. Unforeseeable Conditions
#8. Other

Discipline Codes
#1. Demo-demolition
#2. Div1-Division 1 items on the spec book
(this item is not used)
#3. Electrical
#4. Elevator
#5. Equipment (Changes in equipment,
Owner Purchased)
#6. Fire Protection

Discipline Codes
#7. General Construction (Architectural)
#8. General Conditions (Div. 1)
#9. HVAC
#10. Other
#11. Plumbing
#12. Site Work/Landscaping
#13. Structural

Architect's Supplemental Instructions

Page 2

Description:

Casework revisions and Partition revisions for Aquarium in room 378.


Railings removed for west rain garden.

Please submit an itemized proposal for changes in contract Sum and Contract Time for proposed modifications to the Contract Documents described herein:


Issued by Architect: Kelvin Patel, CannonDesign;

Accepted by Contractor:


© Cannon Design 2015
All rights reserved. No part of this document may be reproduced or transmitted in any form or by any means, electronic or mechanical, including photocopying, recording, or by any information storage and retrieval system, without written authorization by The Cannon Corporation.
4/9/2017 6:05:57 PM

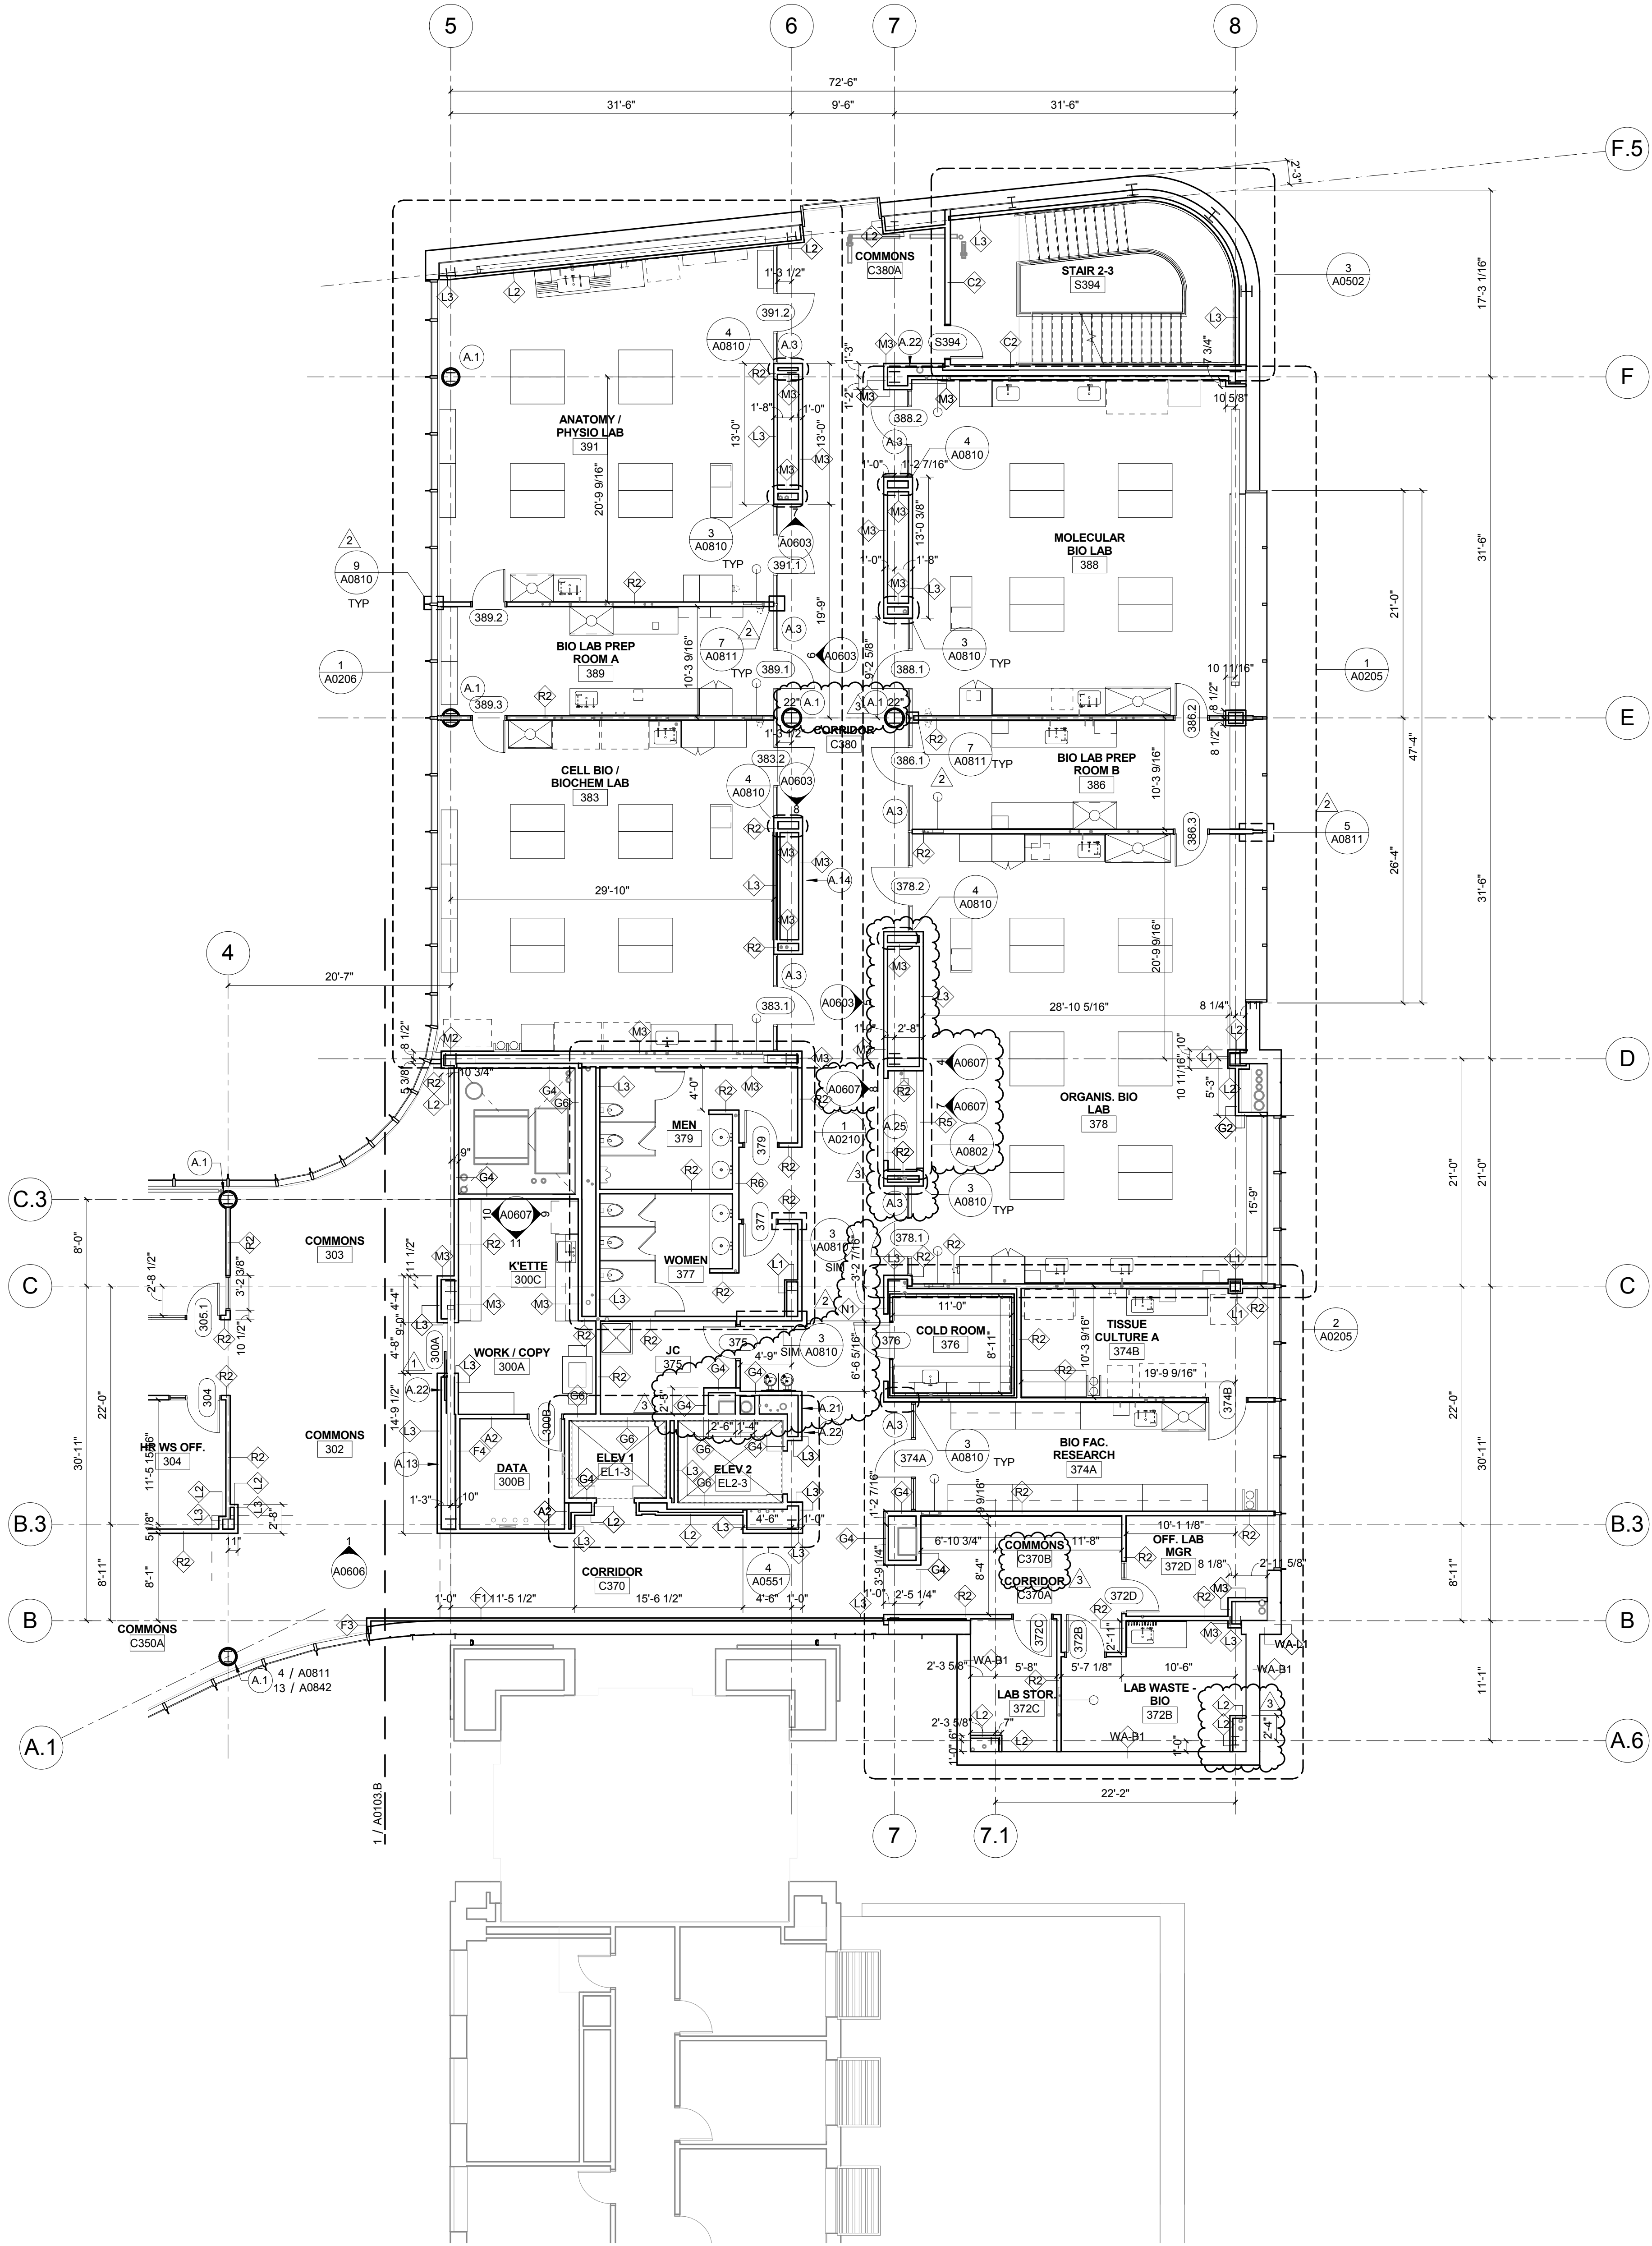

2 LEVEL 03 - BIOLOGY - EAST SIDE-S
1/4" = 1'-0"

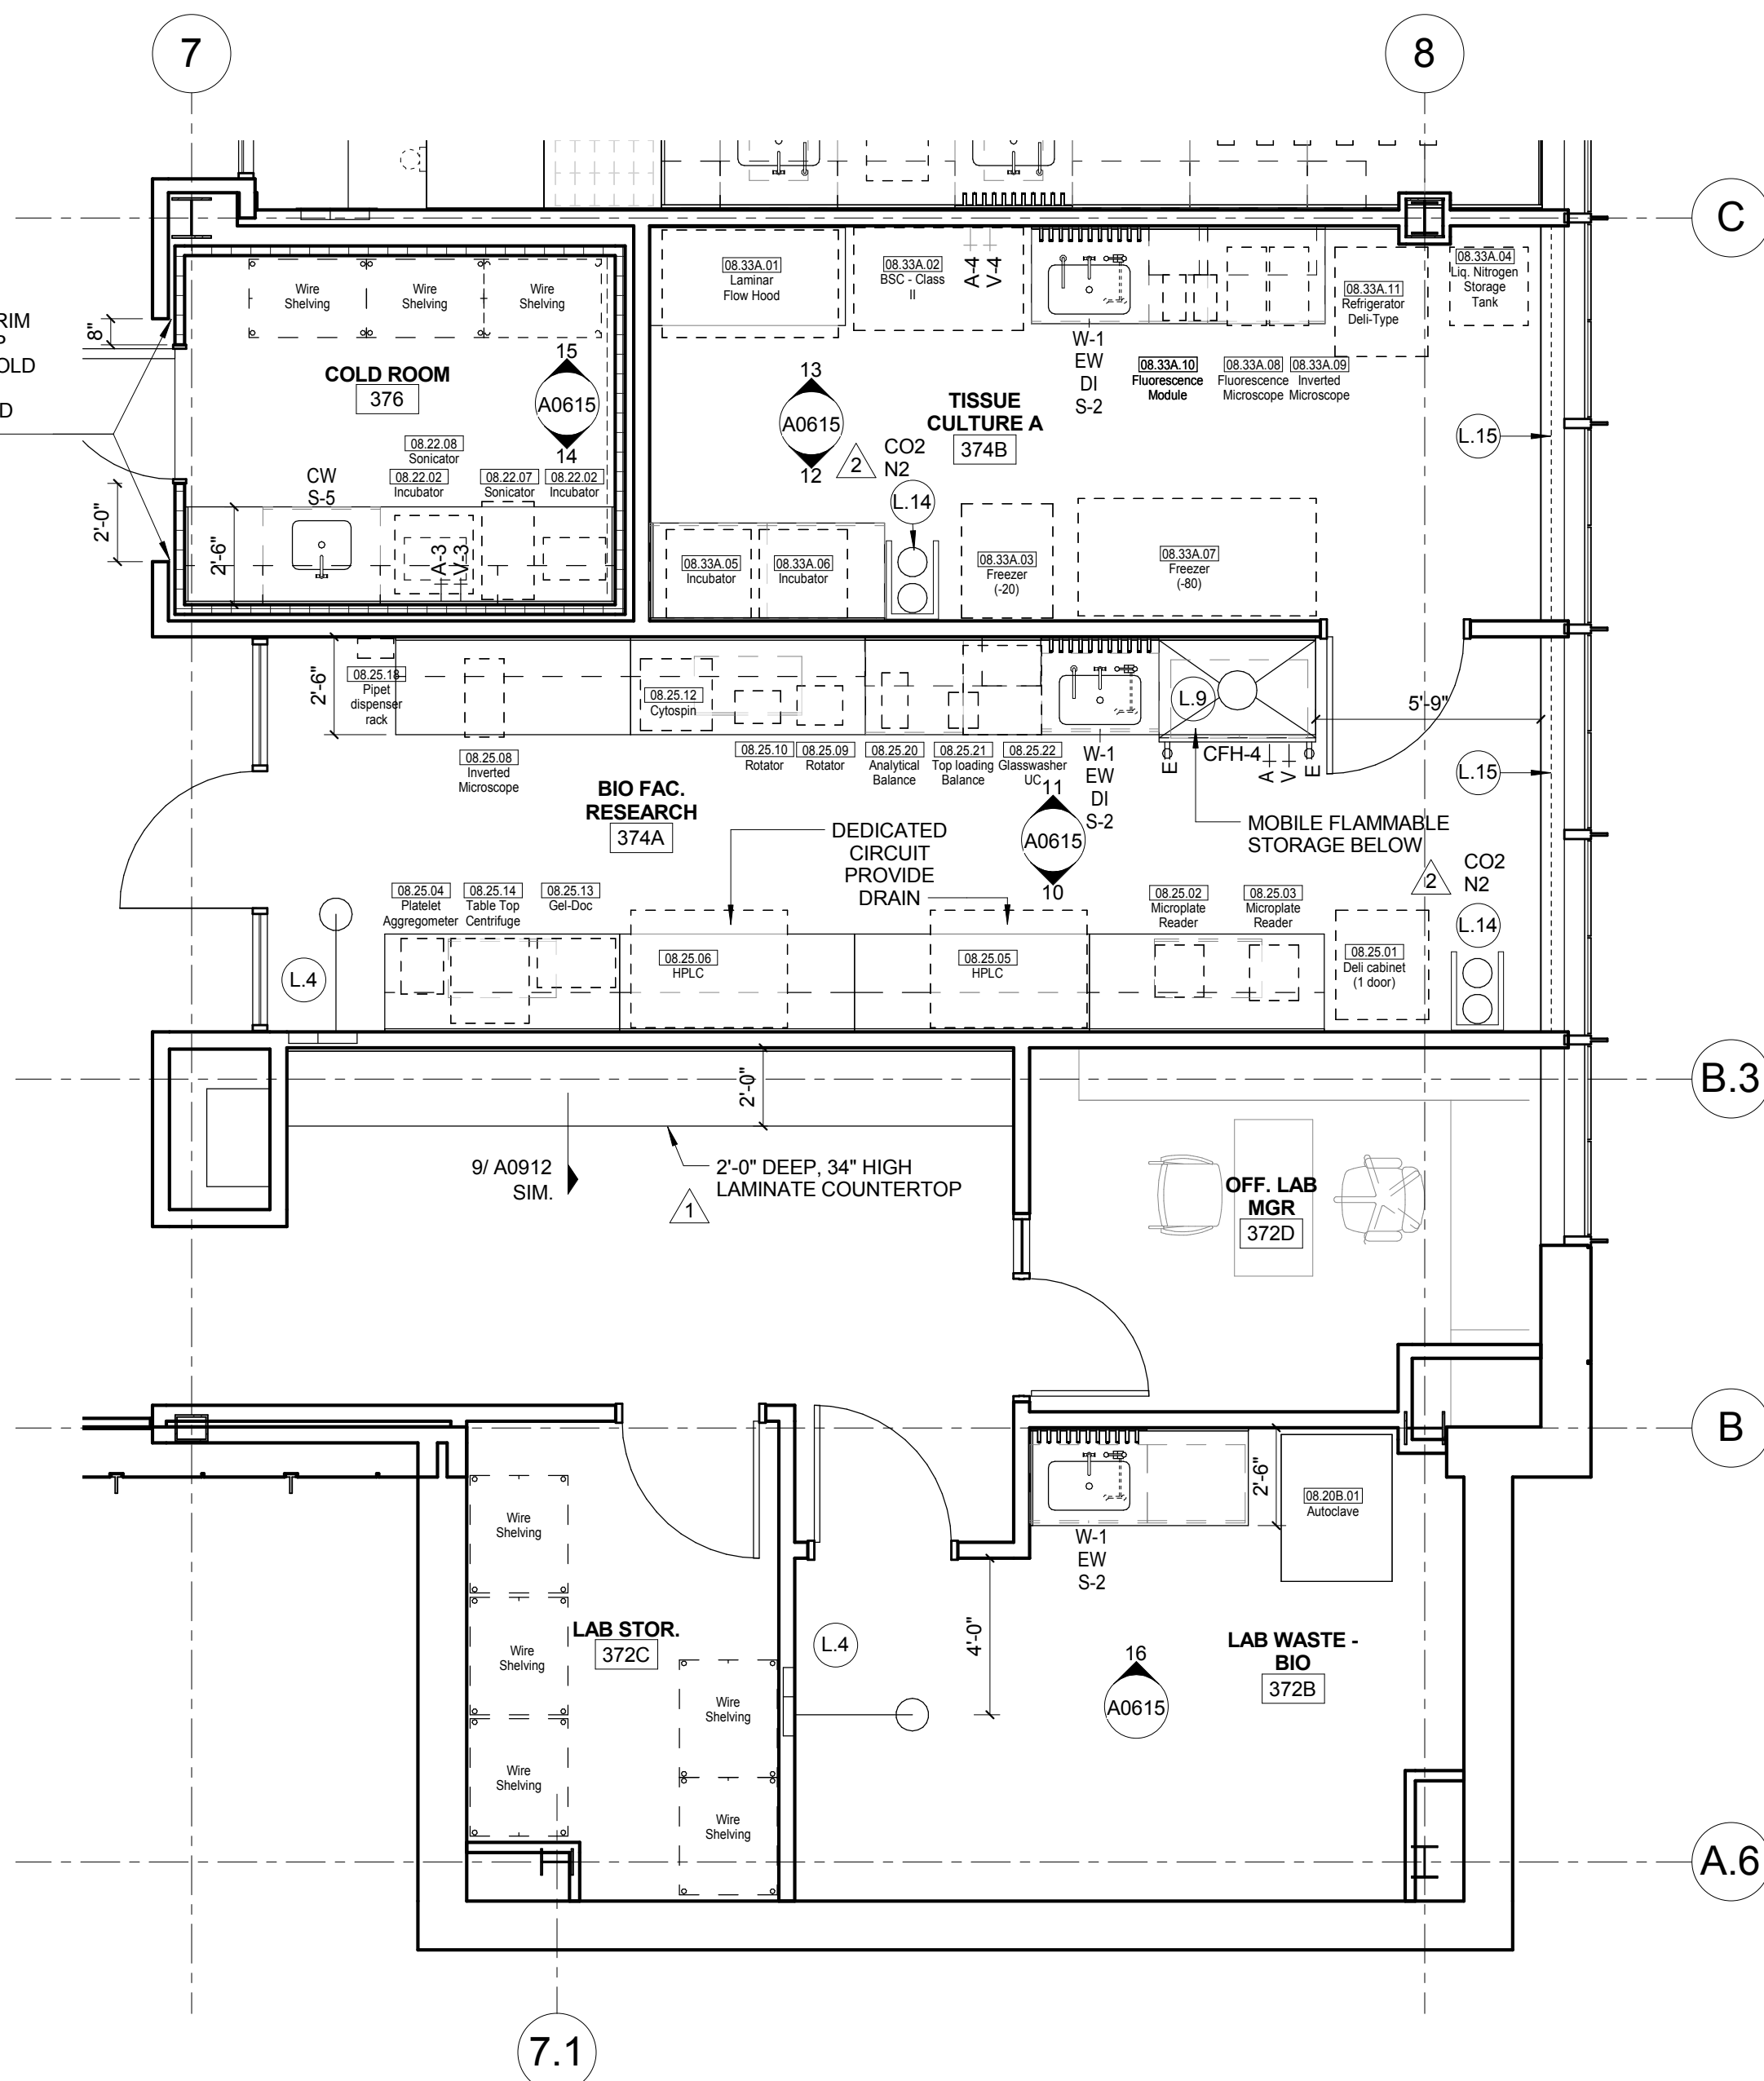

1 LEVEL 03 - BIOLOGY - EAST SIDE-N
1/4" = 1'-0"

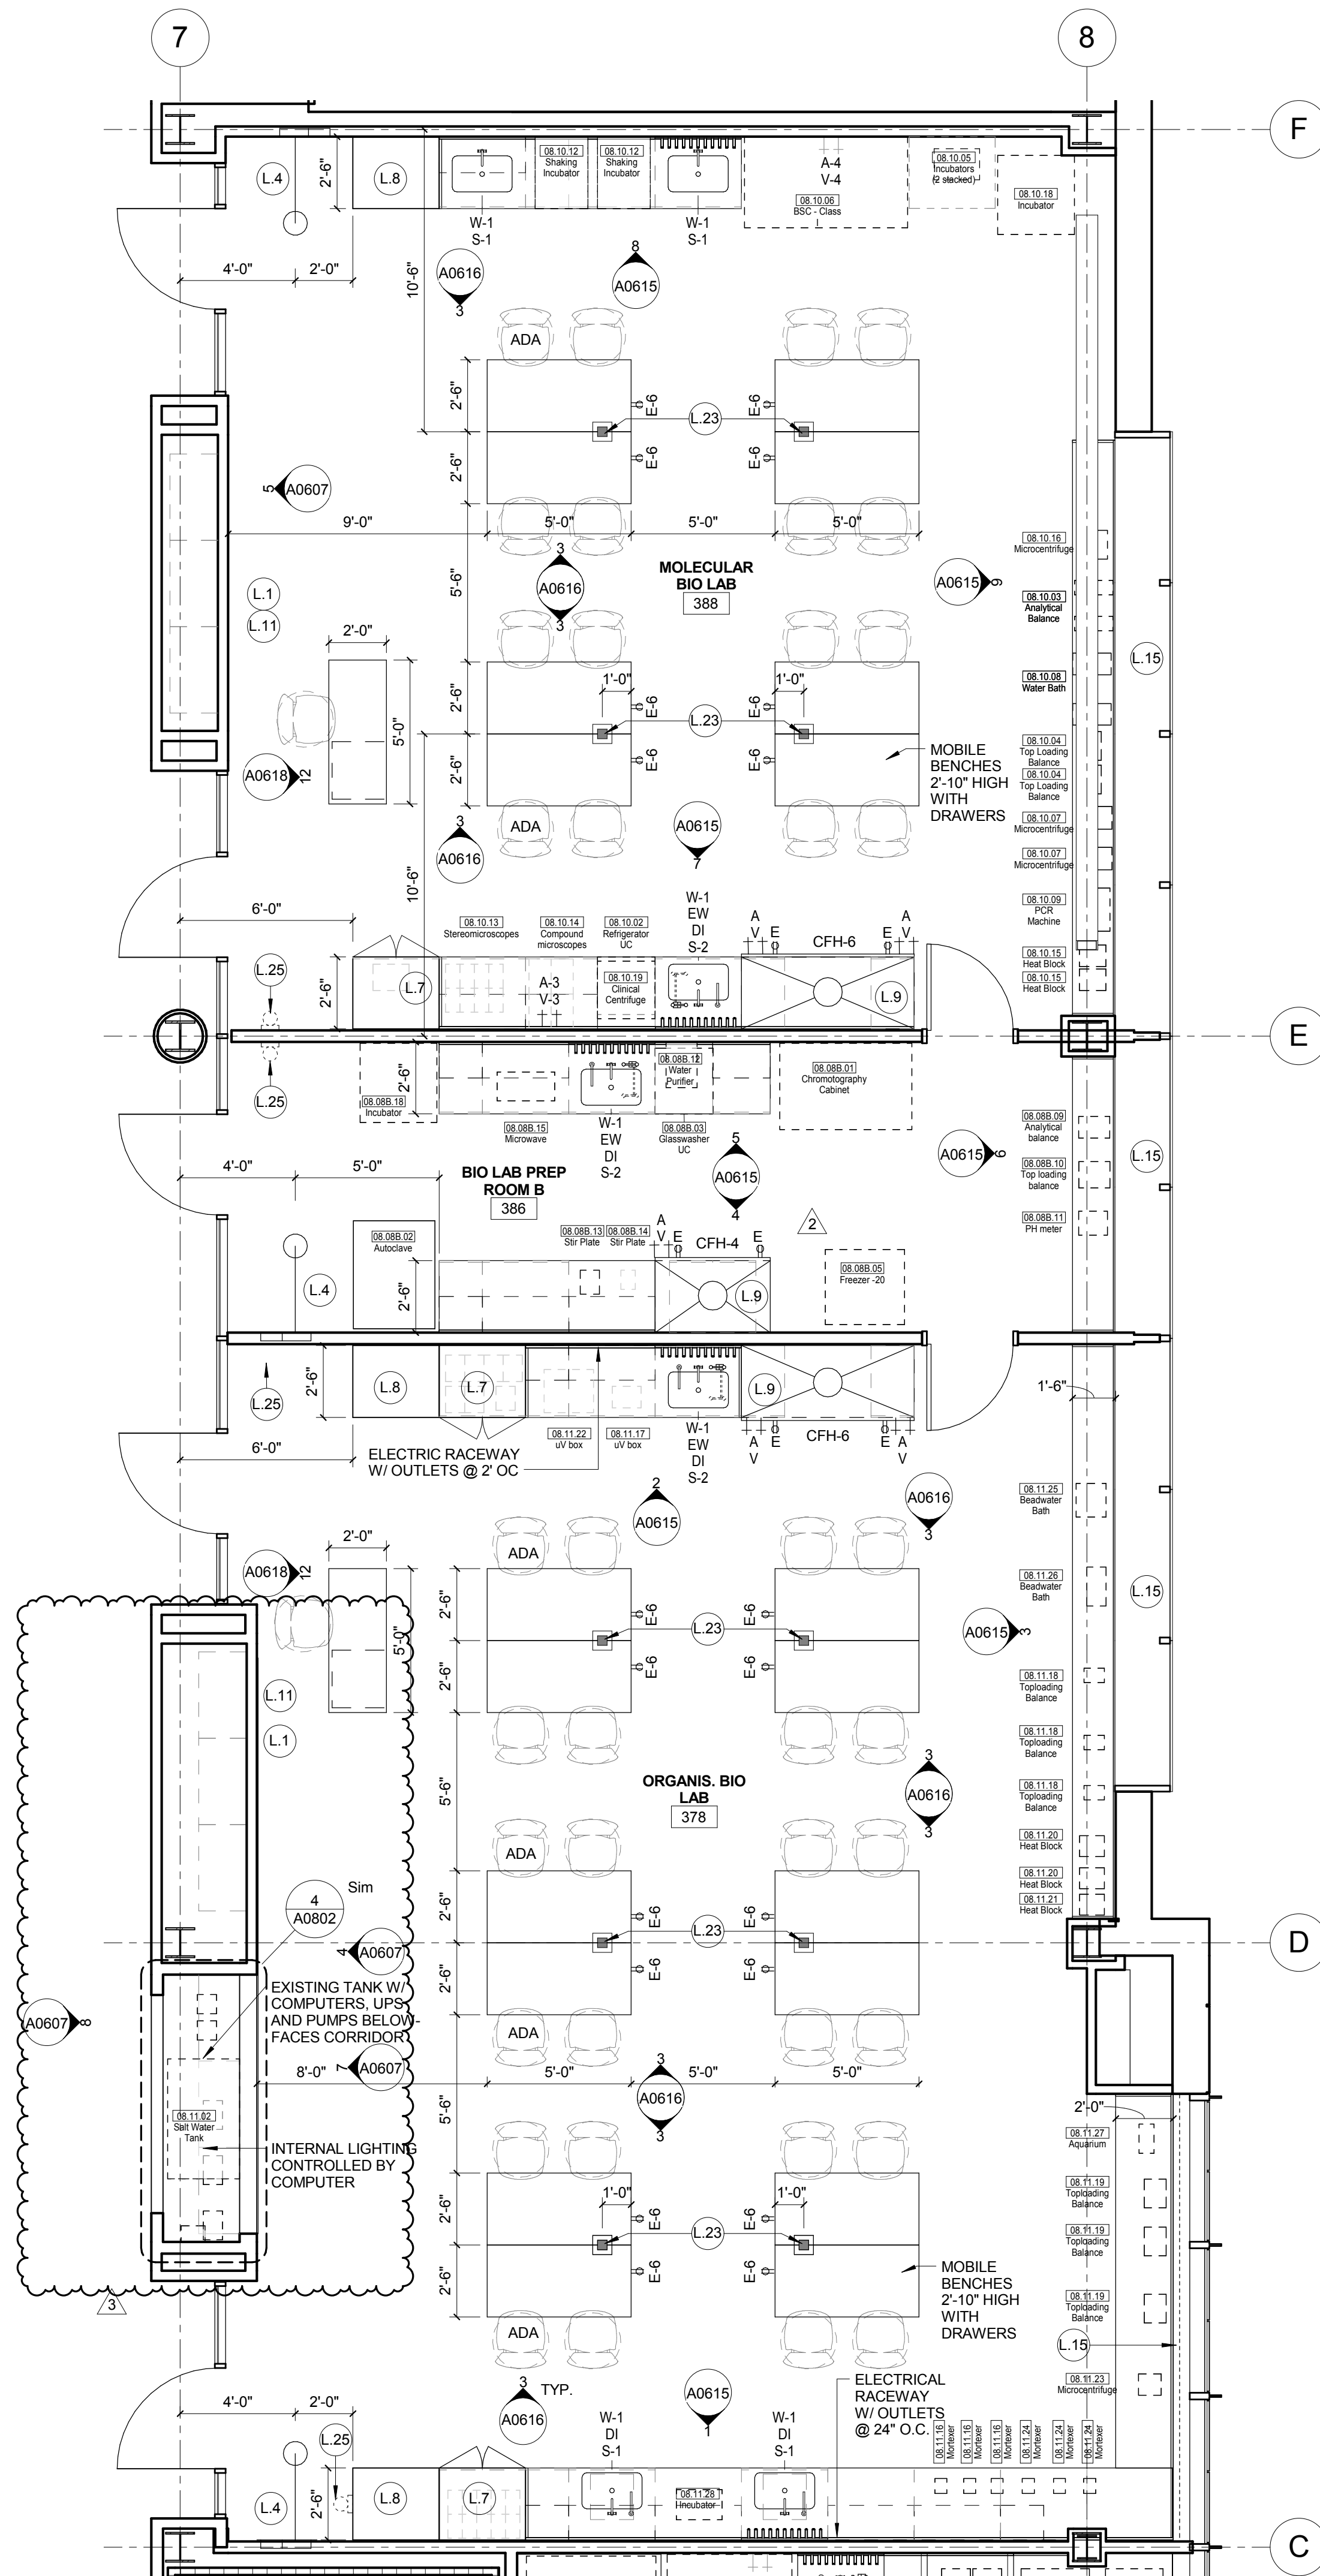

LAB KEYED NOTE LEGEND

- L.1 WRITABLE AND PROJECTABLE SURFACE. DIMENSIONS AS NOTED
L.2 RECESSED, CEILING MOUNTED PROJECTION SCREEN
L.3 WALL MOUNTED PROJECTOR ABOVE
L.4 EMERGENCY SAFETY SHOWER WITH EYEWASH
L.5 11513 CHEMICAL FUME HOOD W/ STORAGE BELOW. TYPICAL FUME HOOD TO HAVE ELECTRIC AND UTILITIES AS INDICATED.
L.7 WOOD LAB CASEWORK MICROSCOPE CAB
L.8 WOOD LAB CASEWORK. TALL CABINET WITH OPEN CUBBIES FOR BOOK BAG STORAGE.
L.9 11513 CHEMICAL FUME HOOD - ACCESSIBLE - WITH MOBILE STORAGE BELOW, WHERE SHOWN. TYPICAL FUME HOOD TO HAVE ELECTRIC, AND UTILITIES AS INDICATED.
L.11 CABS BELOW WHITEBOARD
L.12 CAMERA FOR SKYPE INTERVIEW
L.14 GAS CYLINDER STORAGE RACK (CFI), CYLINDERS TO BE "OFOI"
L.15 RECESSED MOTORIZED ROOM DARKENING / BLACKOUT SHADES. USE DOUBLE SHADES AT WEST CLASSROOMS LEVEL 02 AND LECTURE HALL. REFER TO REFLECTED CEILING PLANS LCO MONITOR
L.16 MOBILE LABORATORY CASEWORK SYSTEM. SEE DETAIL 09A0911.
L.19 MOVEABLE WOOD LABORATORY CASEWORK. TABLE WITH MODIFIED EPOXY COUNTERTOP, WALL CABINETS AS SHOWN ON ELEVATION
L.20 FIXED WOOD LABORATORY CASEWORK. BASE CABINETS, MODIFIED EPOXY COUNTERTOP, WALL CABINETS AS SHOWN ON ELEVATION
L.21 SEE CEILING PLAN FOR CEILING MOUNTED UNISTRUT SYSTEM SUPPORTED BY STRUCTURE ABOVE
L.22 8" DEEP x 8" WIDE TRENCH WITH METAL COVER TO RECEIVE FLOOR FINISH TO MATCH ADJACENT FLOOR
L.23 FLOOR BOX FOR ELECTRICAL & DATA
L.24 09 6886 DRY ERASE FINISH (AWC-1)
L.25 PROVIDE BLOCKS FOR FIRE EXTINGUISHER, MOUNTING HEIGHT - 3'-0" TO TOP OF EXTINGUISHER. FIRE EXTINGUISHER & ITS BRACKET BY OWNER.
L.26 POINT EXHAUST (SNORKEL) FOR SOLDERING. SEE DETAIL 5/ A0913.

LAB UTILITY LEGEND


- CW WATER COLD WATER FAUCET, DECK MOUNTED GOOSENECK WITH SERRATED NOZZLE, VACUUM BREAKER
W-1 WATER GENERAL MIXING FAUCET, DECK MOUNTED WITH VACUUM BREAKER, SERRATED NOZZLE.
DI WATER PROCESS COLD WATER SUPPLY
PWS WATER PROCESS COLD WATER RETURN
EW WATER EYEWASH, DECK MOUNTED, AUTOFLOW SWING-DOWN
DH WATER DRENCH HOSE
G GAS FUME HOOD CONTROL
V VAC FUME HOOD CONTROL
V-3 VAC WALL MOUNTED, SINGLE SERRATED OUTLET
V-1 VAC TURRET BASE, SINGLE SERRATED OUTLET
V-4 VAC OUTLET FOR BIOSAFETY CABINET CONNECTIONS
V-5 VAC QUICK DISCONNECT FOR OVERHEAD SERVICE CARRIER
A-1 AIR FUME HOOD CONTROL
A-3 AIR TURRET BASE, SINGLE SERRATED OUTLET
A-4 AIR WALL MOUNTED, SINGLE SERRATED OUTLET
A-5 AIR QUICK DISCONNECT FOR OVERHEAD SERVICE CARRIER
N NITROGEN FUMEHOOD CONTROL
ELEC. DUPLEX OUTLET (GF) ON FUME HOOD
E-1 COUNTERTOP MOUNTED PEDESTAL, (1) DUPLEX ELECTRICAL OUTLET
E-2 ELEC. COUNTERTOP MOUNTED PEDESTAL, (2) DUPLEX ELECTRICAL OUTLET
E-3 ELEC. WALL MOUNTED, (1) DUPLEX ELECTRICAL OUTLET
E-5 ELEC. DUPLEX ELECTRICAL OUTLET ON OVERHEAD SERVICE CARRIER
E-6 ELEC. DUPLEX ELECTRICAL OUTLET ON TABLE APRON
D DATA DATA OUTLET
D-1 DATA COUNTERTOP MOUNTED PEDESTAL, (2) DATA OUTLETS
D-5 DATA DATA OUTLET ON OVERHEAD SERVICE CARRIER
D-6 DATA DATA OUTLET ON TABLE APRON
S CLIP SINK LIPPED MODIFIED EPOXY CUP SINK, 9"x3"W OVAL (DROP-IN)
S-1 SINK LIPPED MODIFIED EPOXY ADA SINK 25"Lx15"Wx10"D (DROP-IN)
S-2 SINK LIPPED MODIFIED EPOXY ADA SINK 25"Lx15"Wx5"D (DROP-IN)
S-3 SINK STAINLESS STEEL SINK 25"Lx15"Wx10"D (DROP-IN)
S-4 SINK STAINLESS STEEL ADA SINK 25"Lx15"Wx5"D (DROP-IN)
S-5 SINK LIPPED MODIFIED EPOXY ADA SINK 18"Lx15"Wx5"D (DROP-IN)
S-6 SINK LIPPED MODIFIED EPOXY SINK, 36"Lx15"Wx10"D (DROP-IN)
OSC OVERHEAD SERVICE CARRIER. SEE DETAIL 10 / A0913
PTD PAPER TOWEL DISPENSER

CHEMICAL FUME HOOD LEGEND


- CFH-4 4'-0" WIDE CHEMICAL FUME HOOD
CFH-6 6'-0" WIDE CHEMICAL FUME HOOD

LAB GENERAL NOTES

- ALL DIMENSIONS ARE TO GWB FACE PARTITION OR COLUMN
- CENTER LINE U.N.O.
- OWNER FURNISHED OWNER INSTALLED (OFOI) ITEMS ARE SHOWN DASHED FOR REFERENCE ONLY. COORDINATE SIZE AND INSTALLATION REQUIREMENTS WITH OWNERS REPRESENTATIVE.
- CENTER LINE OF SINKS, U.N.O.
- ALL APRONS AT OPEN KNEE SPACE TO BE 4" U.N.O. PROVIDE APRON OF SOLID WOOD WITH EASED BOTTOM EDGE. FINISH TO MATCH VENEER SPECIES. MAINTAIN MINIMUM 2" CLEAR ABOVE FLOOR FINISH.
- CENTER ALL COUNTERTOP MOUNTED UTILITY OUTLETS ON CENTER OF CASEWORK U.N.O.
- ALL SURFACE MOUNTED RACEWAY TO HAVE OUTLETS AT 2'-0" O.C. AND SHALL BE MOUNTED DIRECTLY ABOVE BACKSPLASH U.N.O.
- ALL BACKSPLASHES TO BE 4" HIGH U.N.O.
- DASHED LINES ON ELEVATIONS INDICATED ADJUSTABLE SHELVE INSIDE CASEWORK
- PROVIDE FINISHED BACK PANEL AT KNEE SPACES BELOW ALL FUMEHOODS. TYPICAL. SIMILAR TO DETAIL
- PROVIDE FINISHED BACK PANEL AT ALL KNEE SPACES. TYPICAL
- PROVIDE LOCK AND KEY WHERE A CIRCLE NEXT TO DRAWER OR DOOR HANDLE IS SHOWN OR WHERE NOTED
- RESEE SHEETS A0914 FOR LABORATORY CASEWORK / MILLWORK DETAILS
- FOR TYPICAL MOUNTING HEIGHTS REF. 1/A0911
- ALL CASEWORK TO BE WOOD U.N.O.
- ALL CASEWORK IS LABORATORY CASEWORK UNLESS NOTED AS MILLWORK OR OFOI. SEE DIVISION 12 3553 - LABORATORY CASEWORK FOR SPECIFICATIONS
- ALL EQUIPMENT ITEMS HAVE A EQUIPMENT TAG - XX-XX-XX. SEE SHEETS A1104 FOR EQUIPMENT SCHEDULES
- PROVIDE PAPER TOWEL DISPENSER (PTD) AT EACH SINK LOCATION.

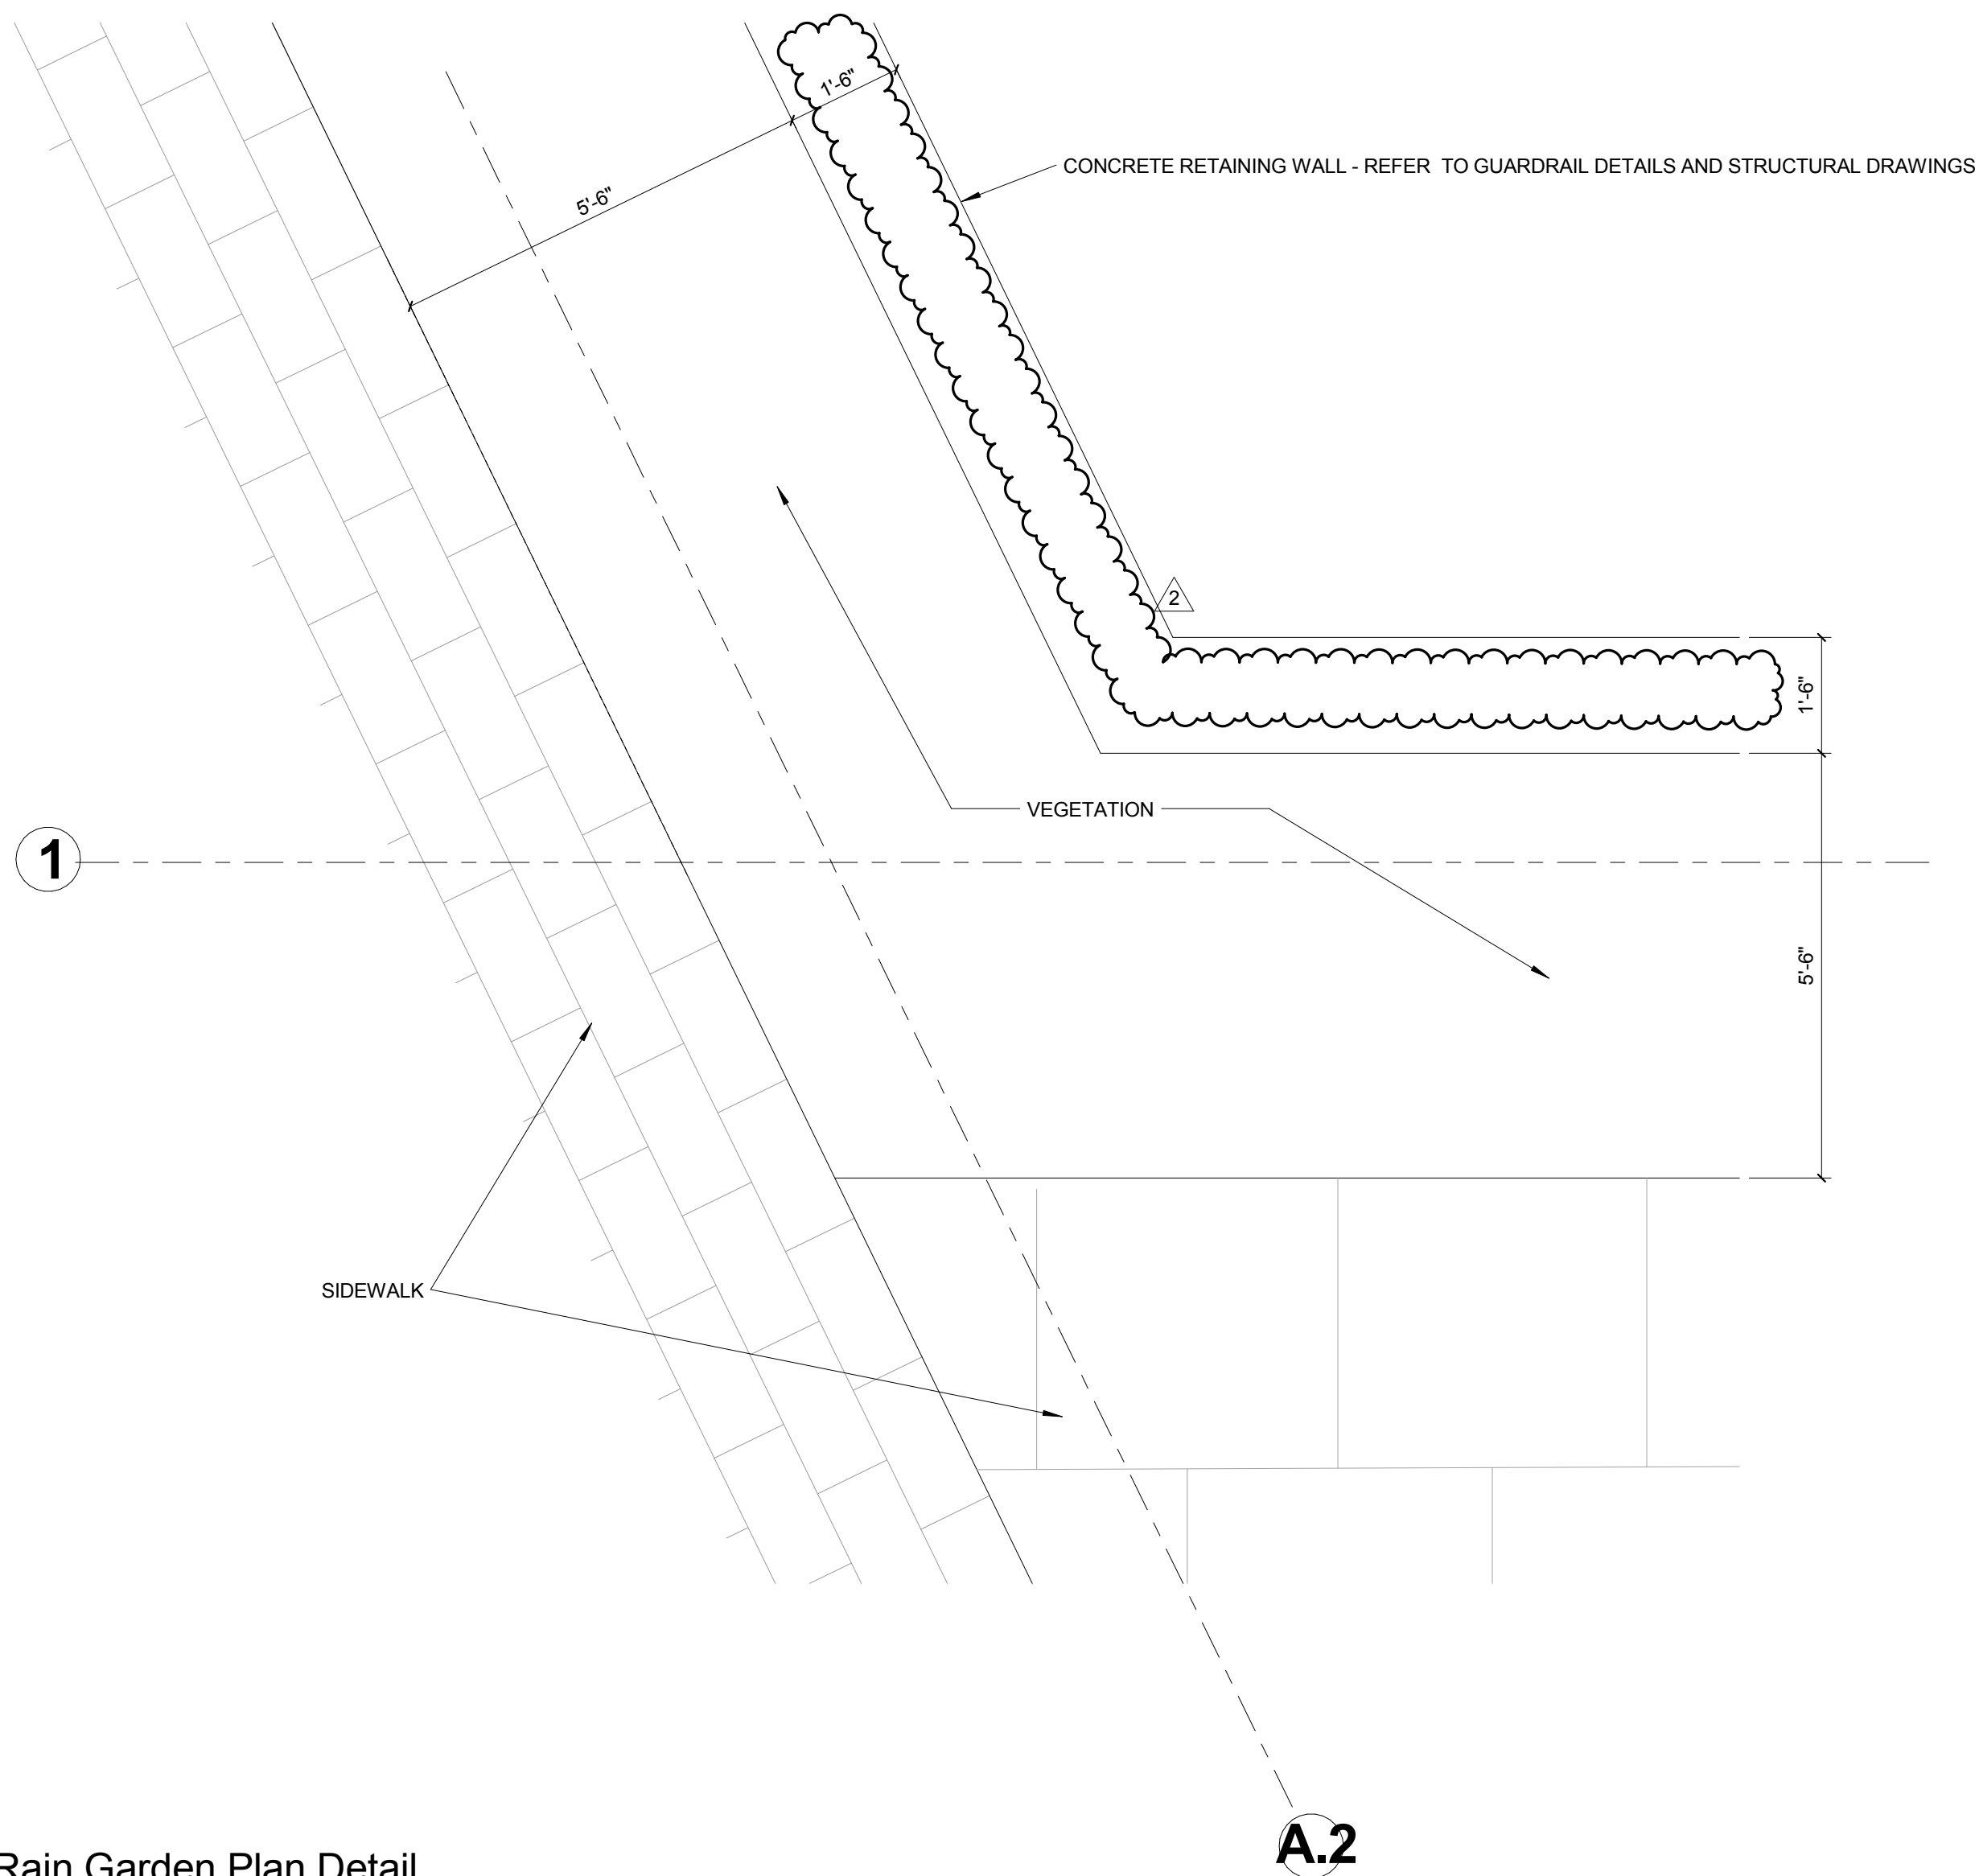

2 Rain Garden Plan Detail
1/2" = 1'-0"

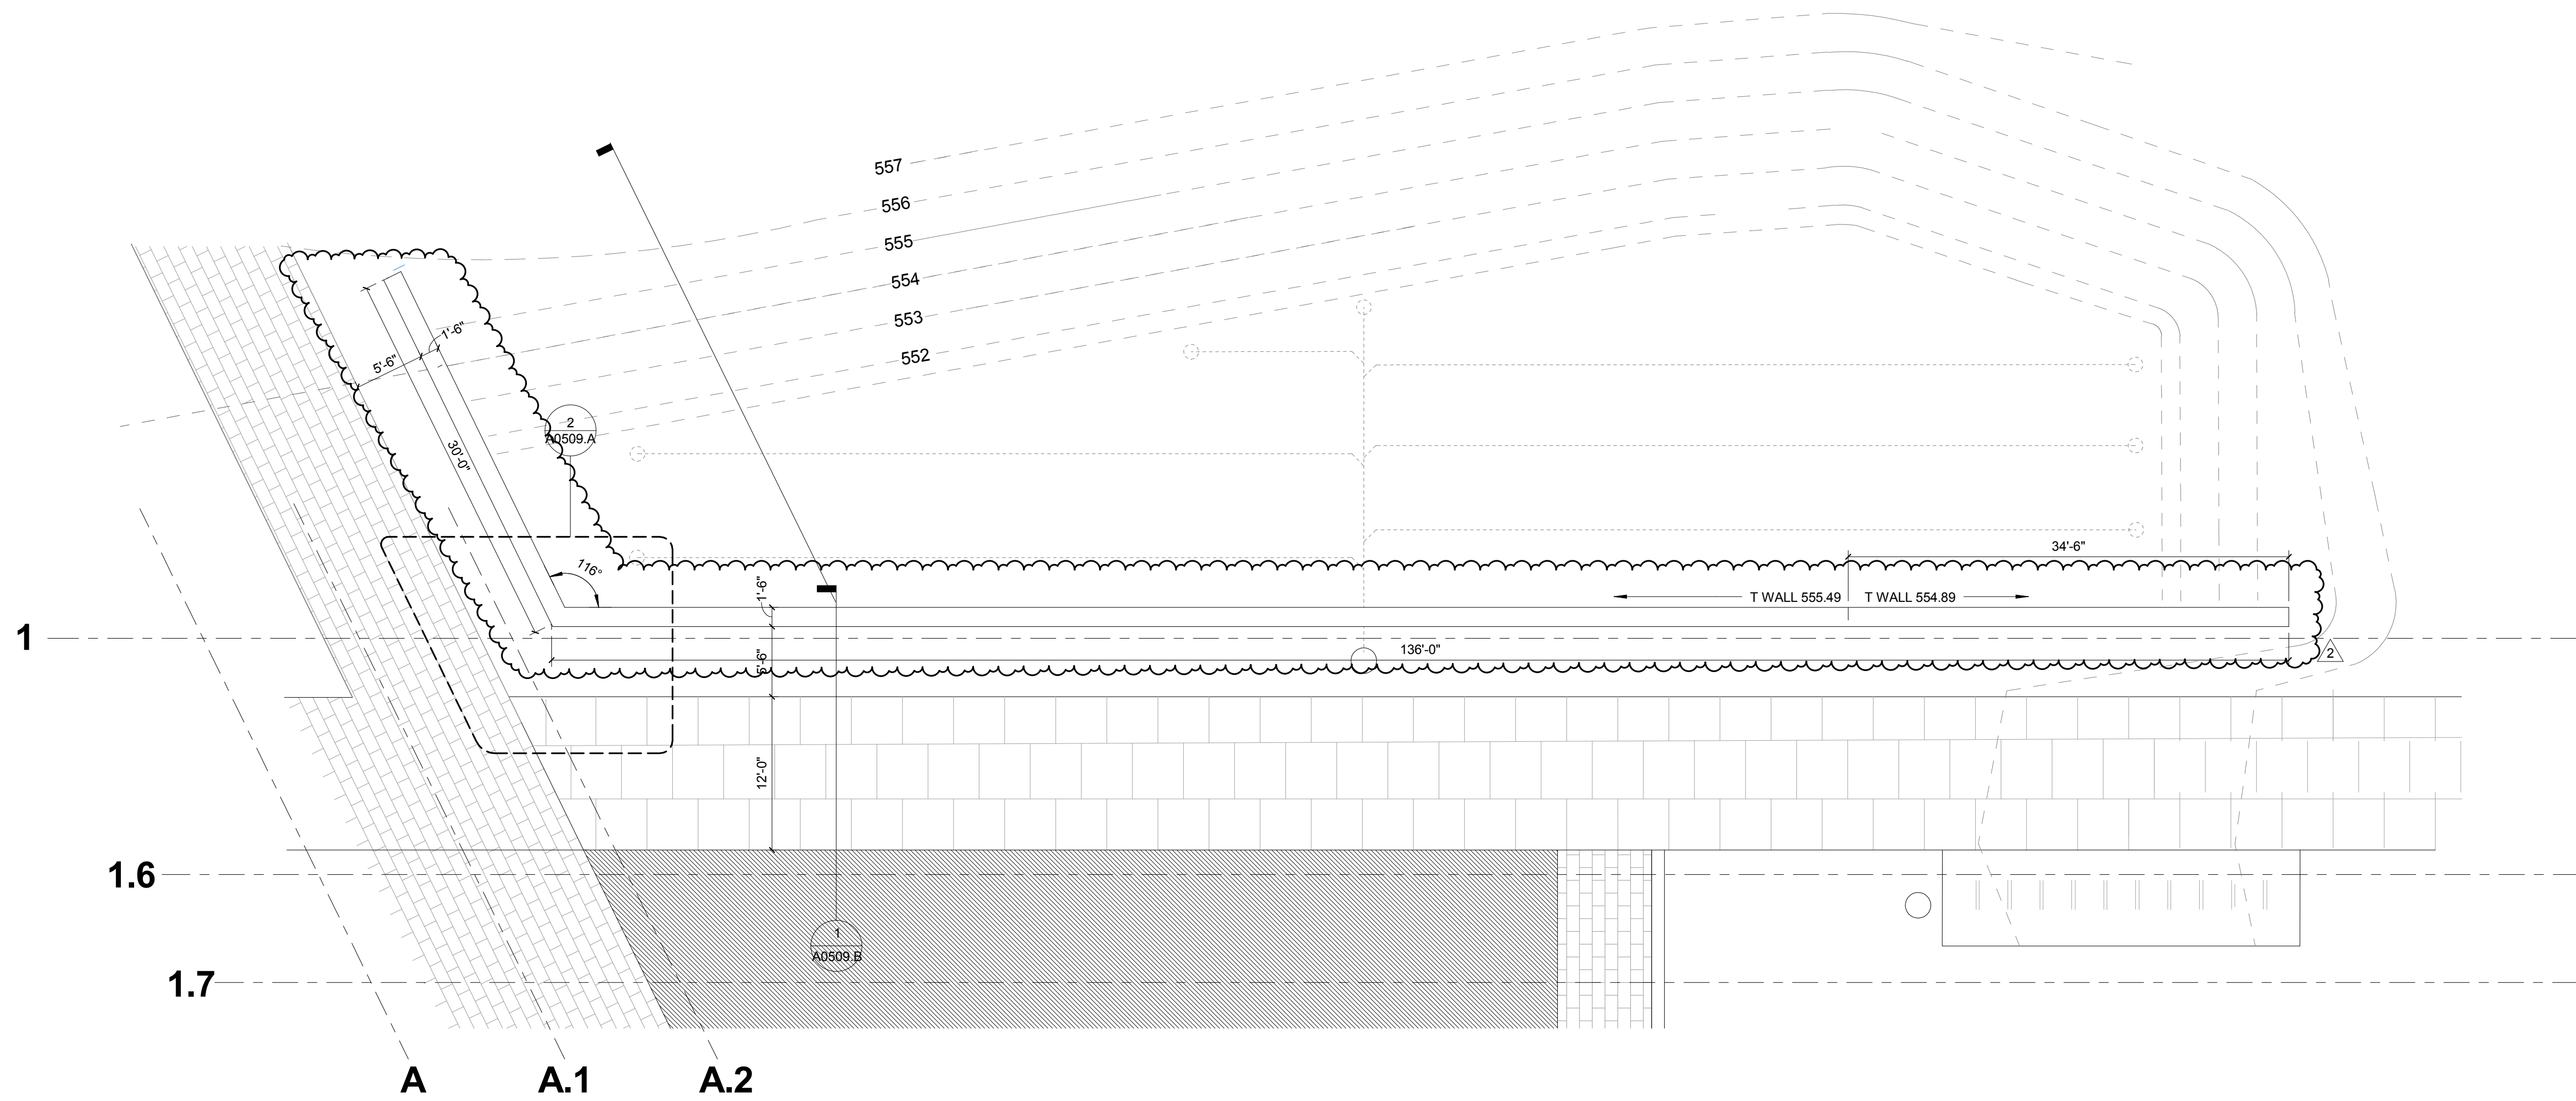

1 RAIN GARDEN PLAN
1/8" = 1'-0"

2	ASI-057	06 APR 2017
1	ASI-003	01 AUG 2016
-	ISSUED FOR CONSTRUCTION (BP1)	15 JAN 2016
No.	Description	Date

Drawing Title:

SITE WALLS - RAIN
GARDEN

Project No.: 04561.01

Checked by:

A0509.A

2	ASI-057	06 APR 2017
1	ASI-003	01 AUG 2016
ISSUED FOR CONSTRUCTION (BP1)		
No.	Description	Date


Drawing Title:

SITE WALLS - RAIN
GARDEN


Project No.: 04561.01

Checked by:


A0509.B

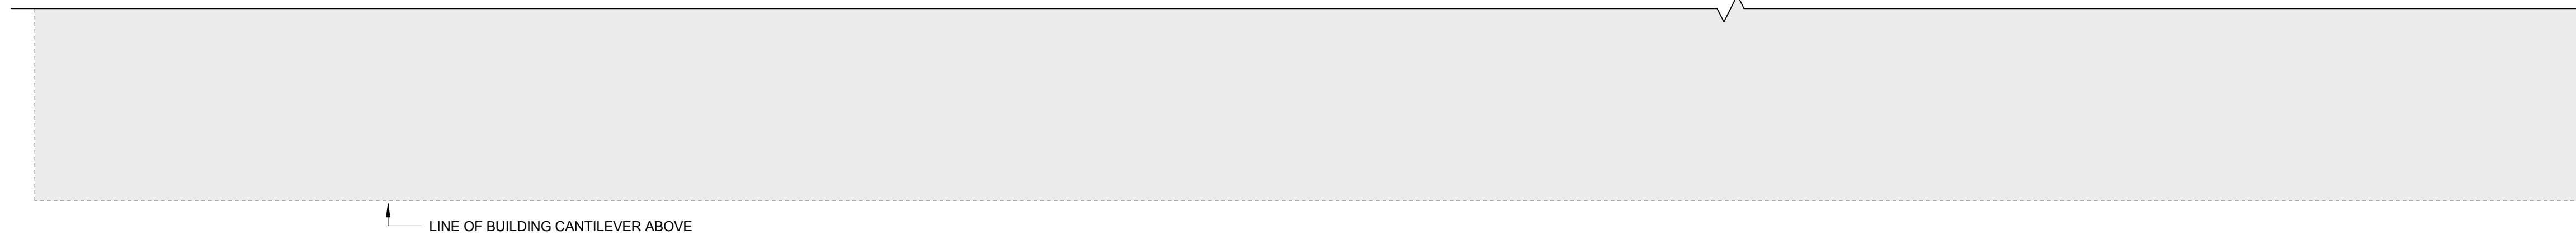


2 RAIN GARDEN EAST WALL
1/4" = 1'-0"

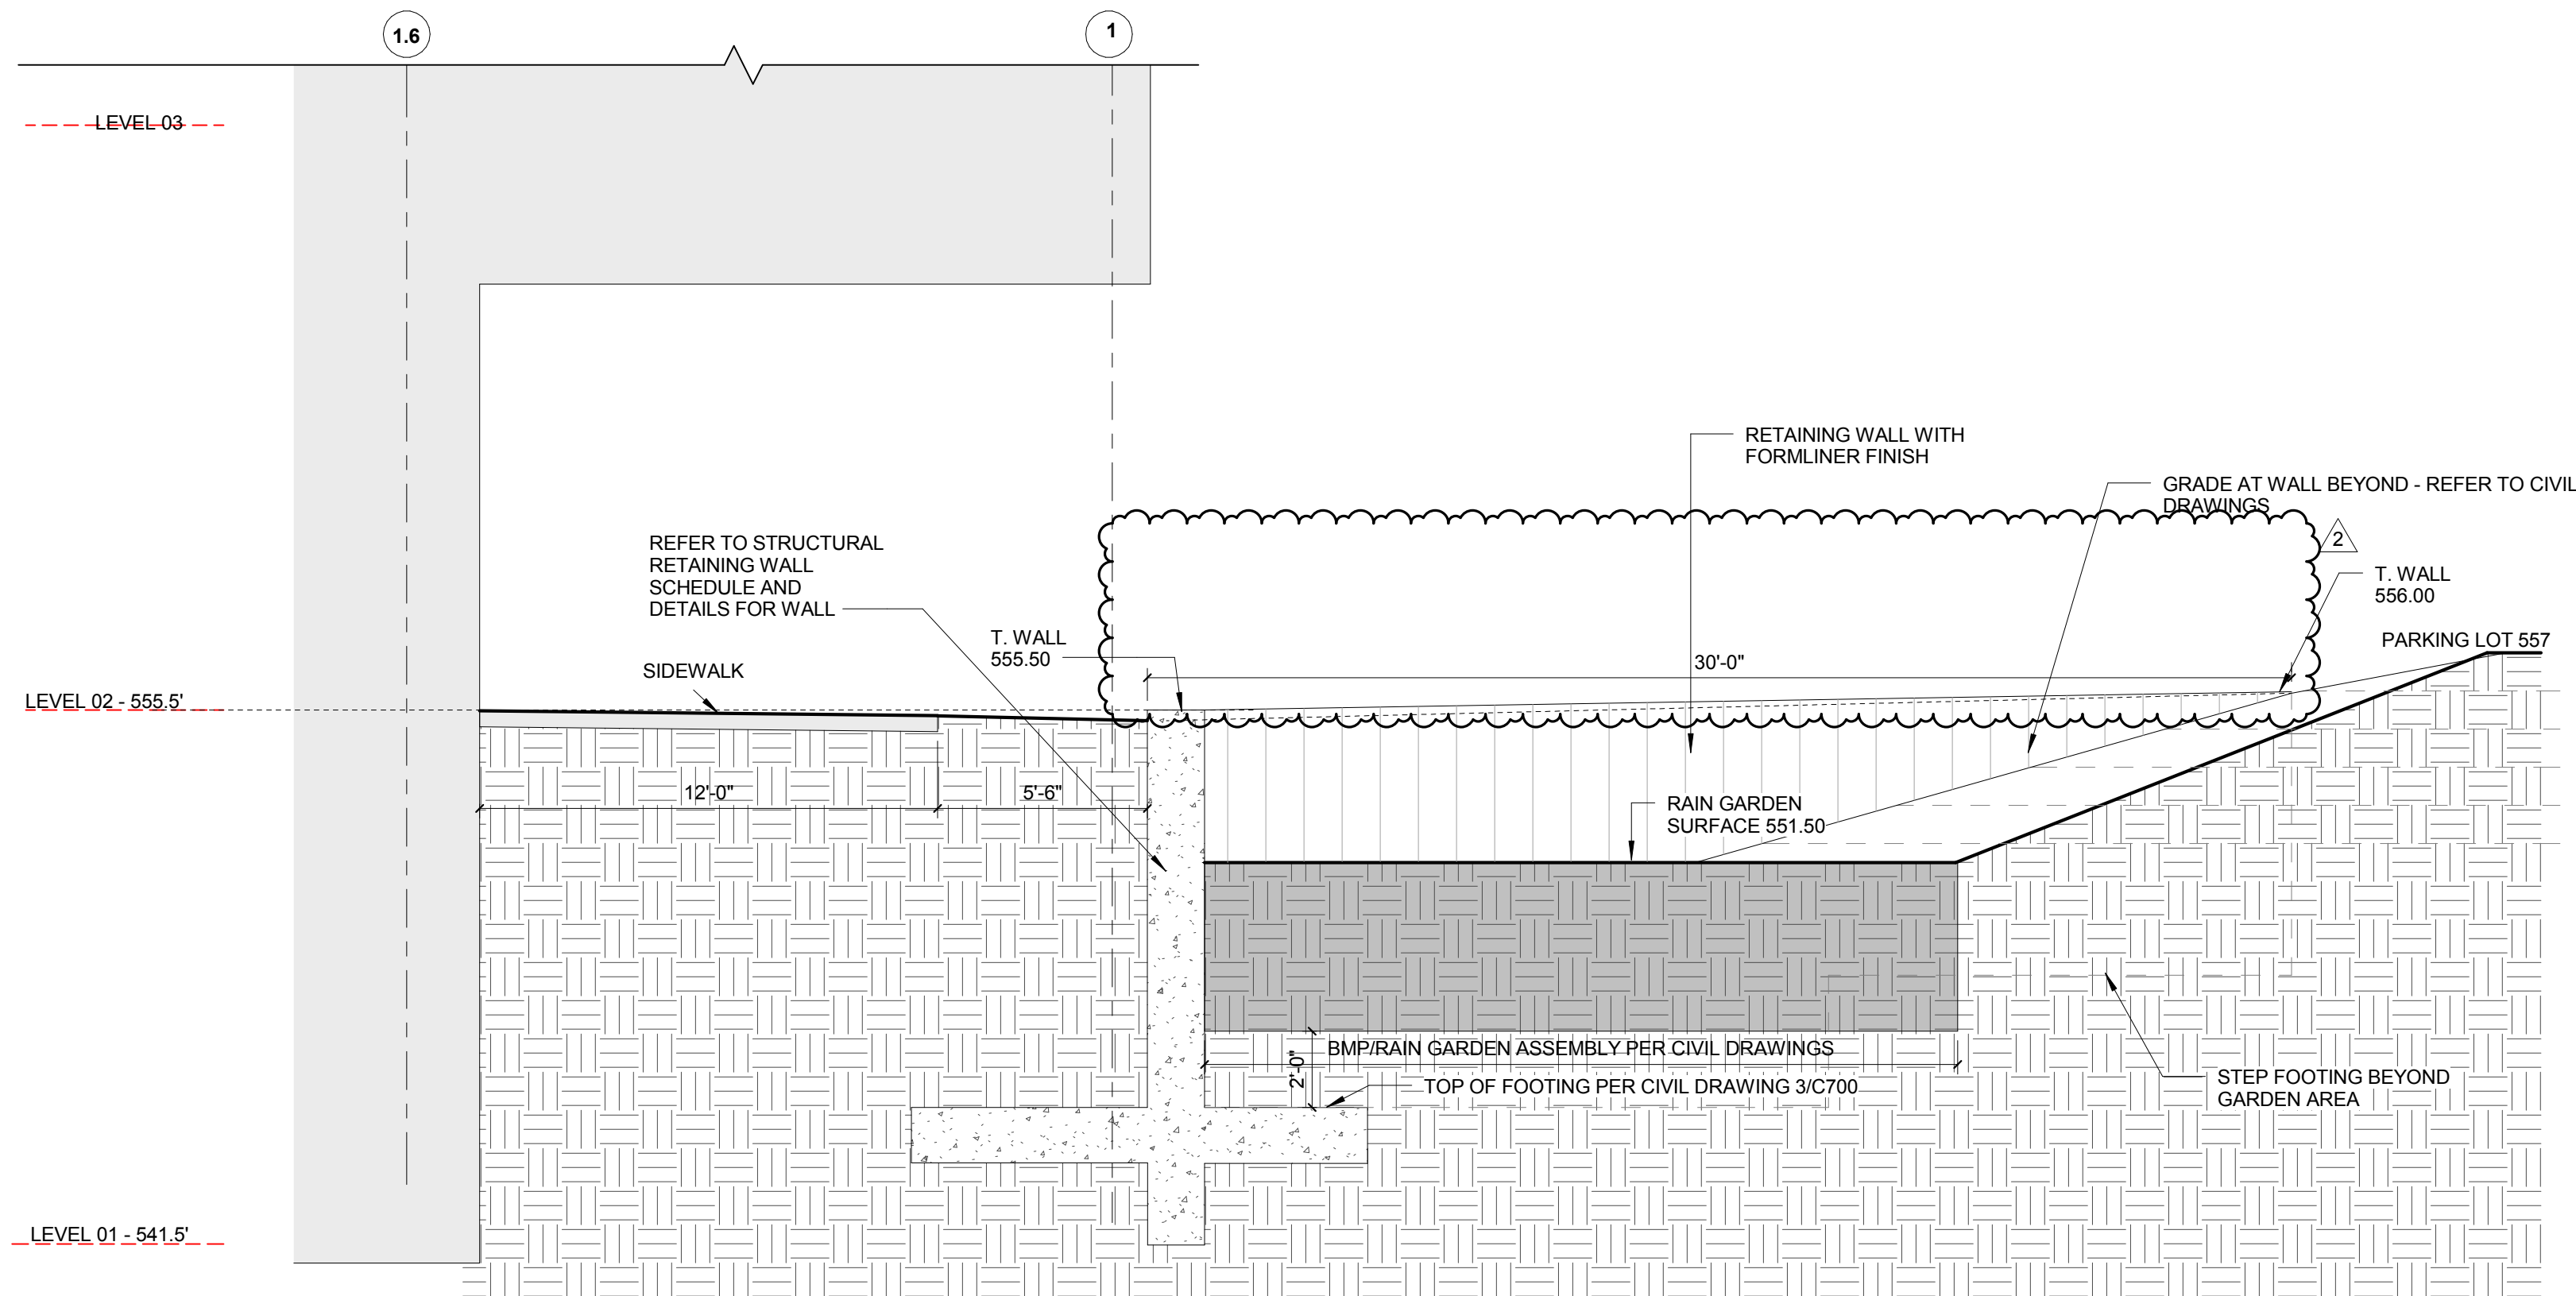

1 RAIN GARDEN SOUTH WALL
1/4" = 1'-0"

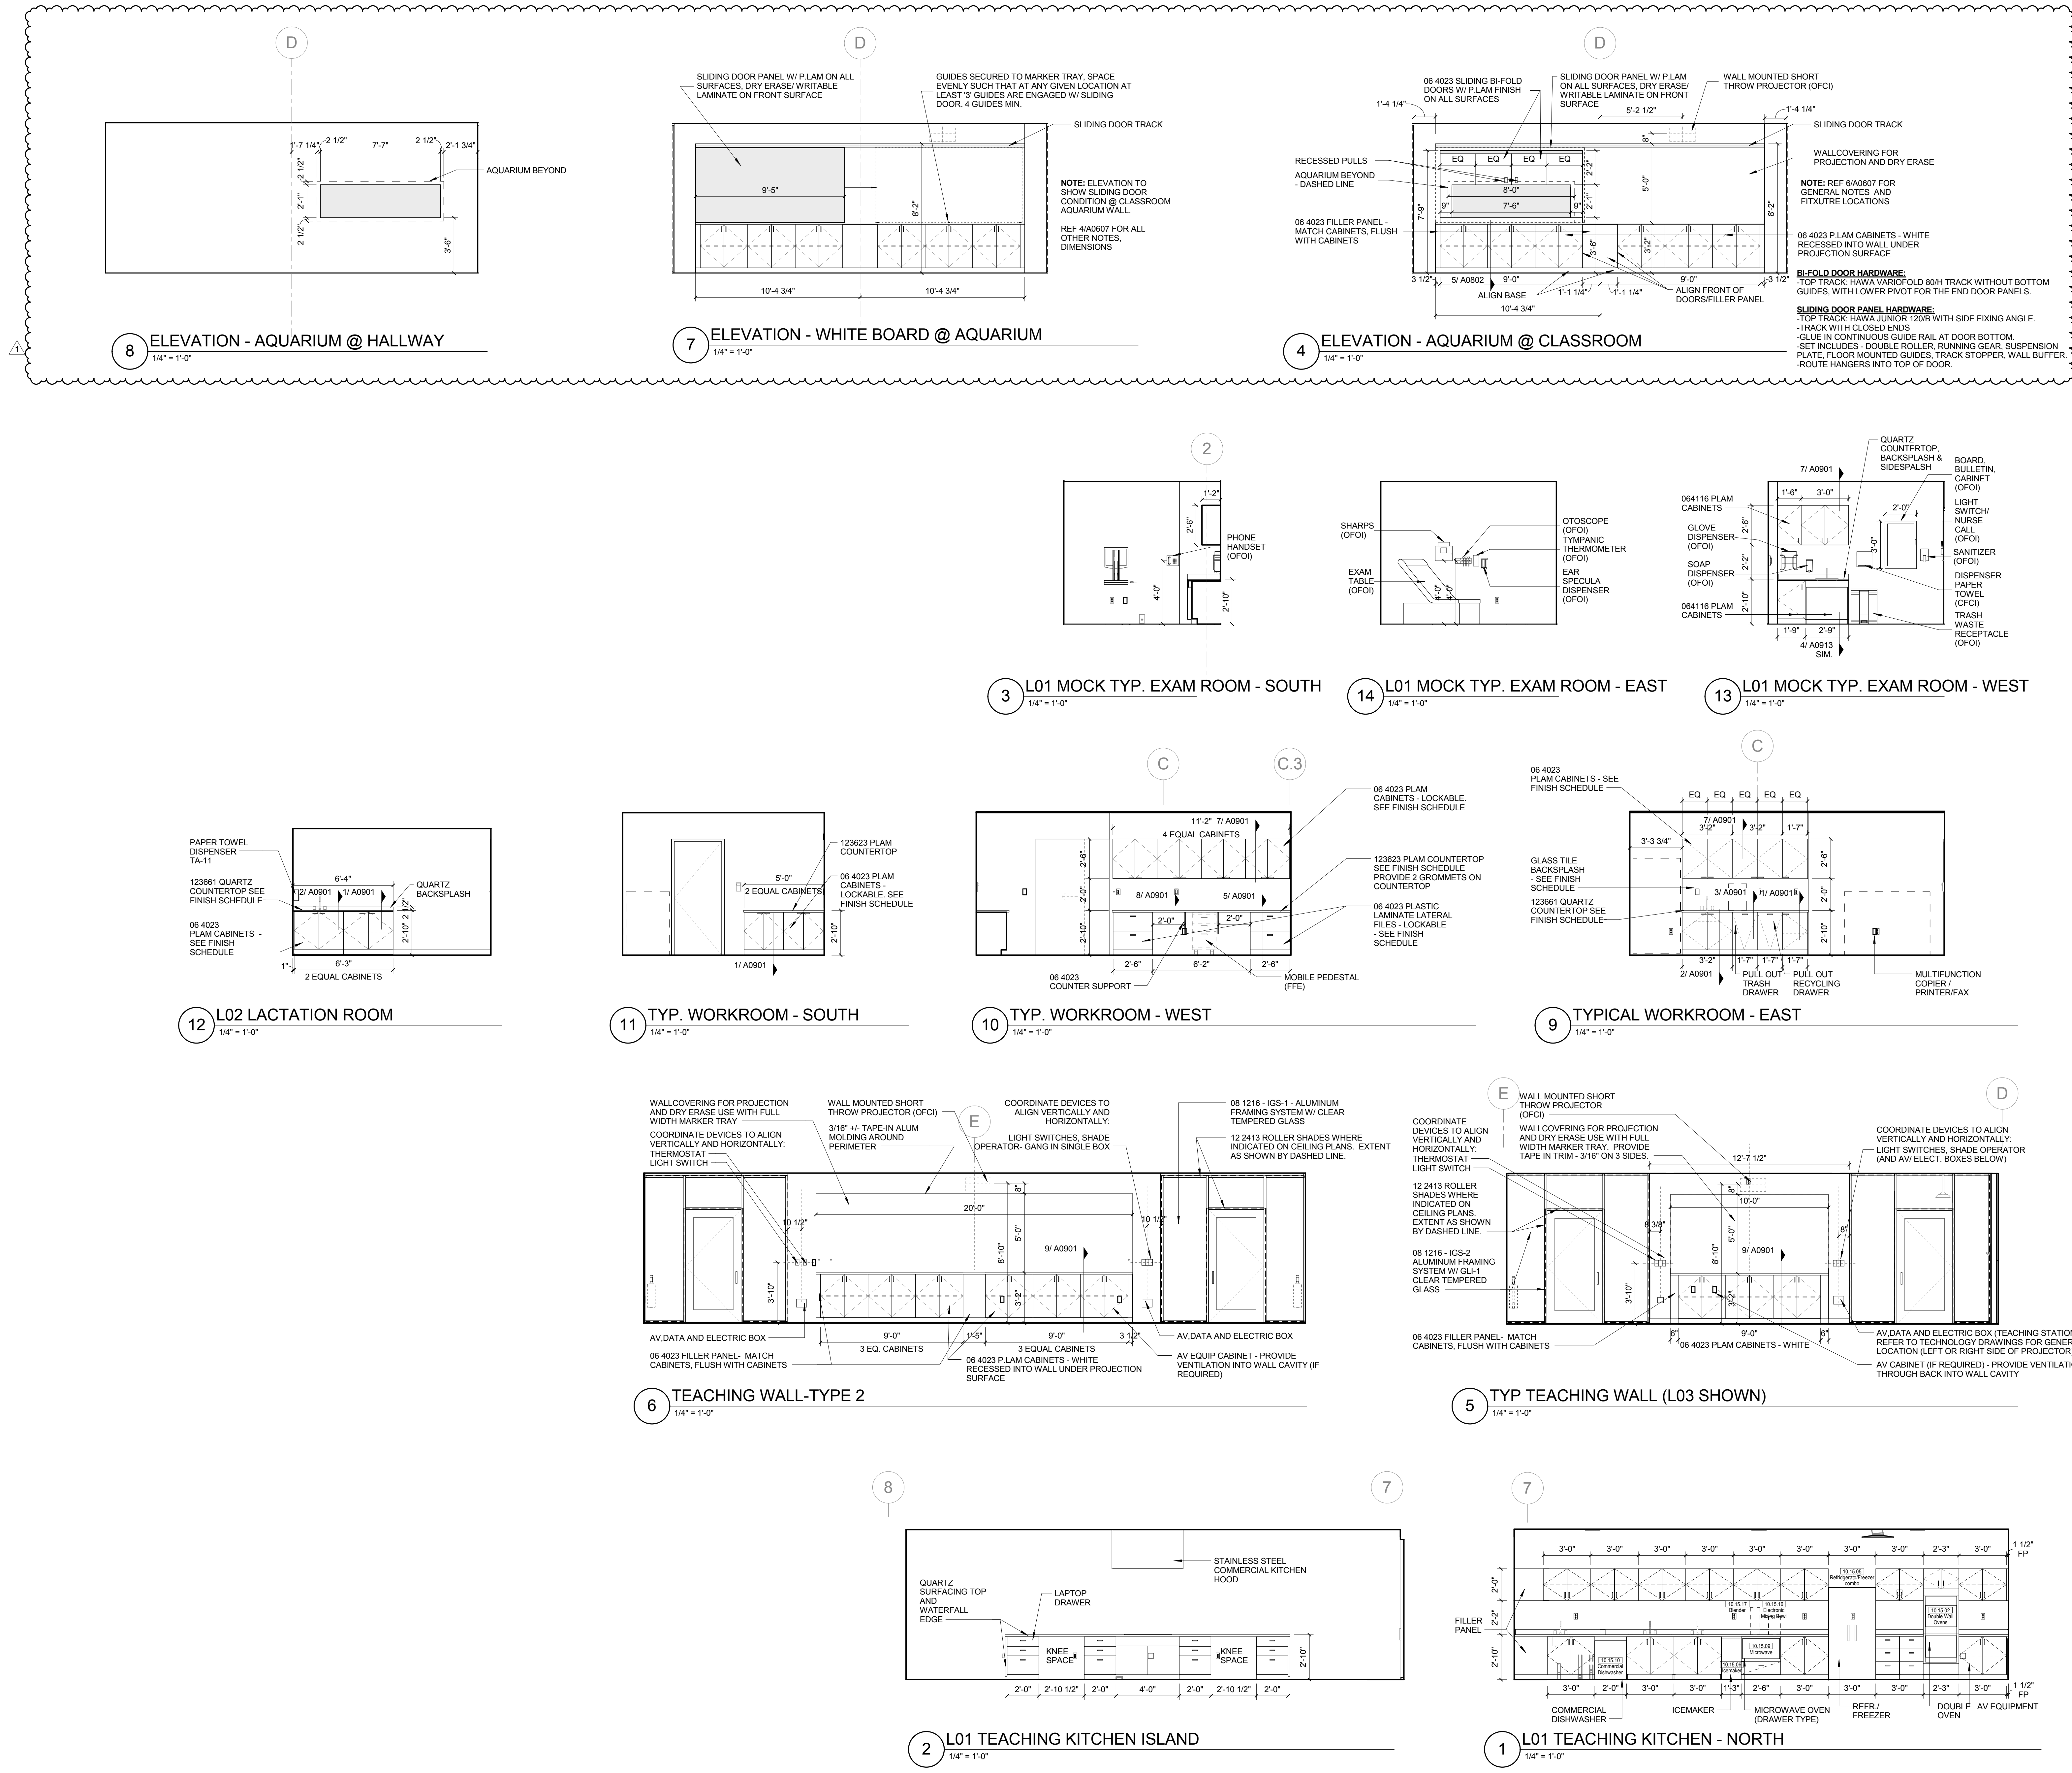

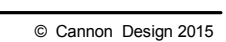


2	ASI-057	06 APR 2017
1	ADDENDUM 3-2	15 APR 2016
ISSUED FOR CONSTRUCTION (BP3)		15 MAR 2016
No.	Description	Date

Drawing Title:


INTERIOR DETAILS

Project No.: 04561.01 Checked by:


A0802

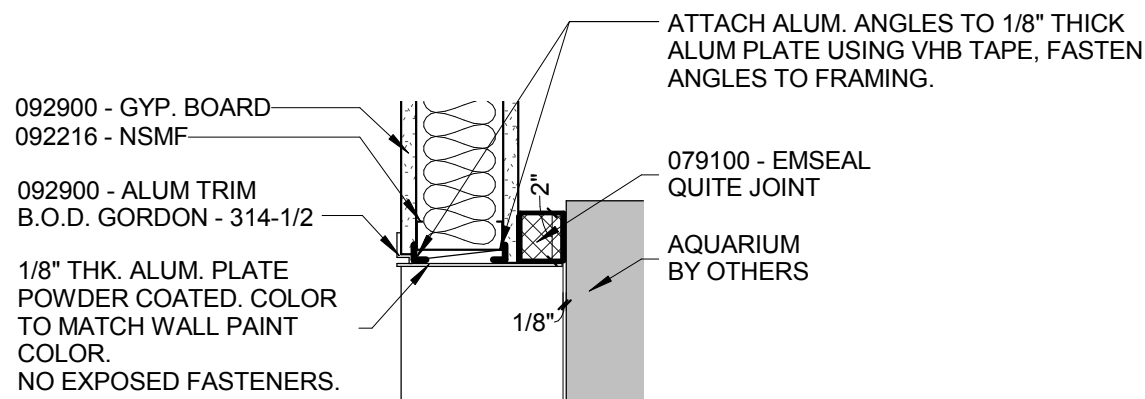


PLAN DETAIL @ AQUARIUM
VIEWING OPENING JAMB
1 1/2\"/>

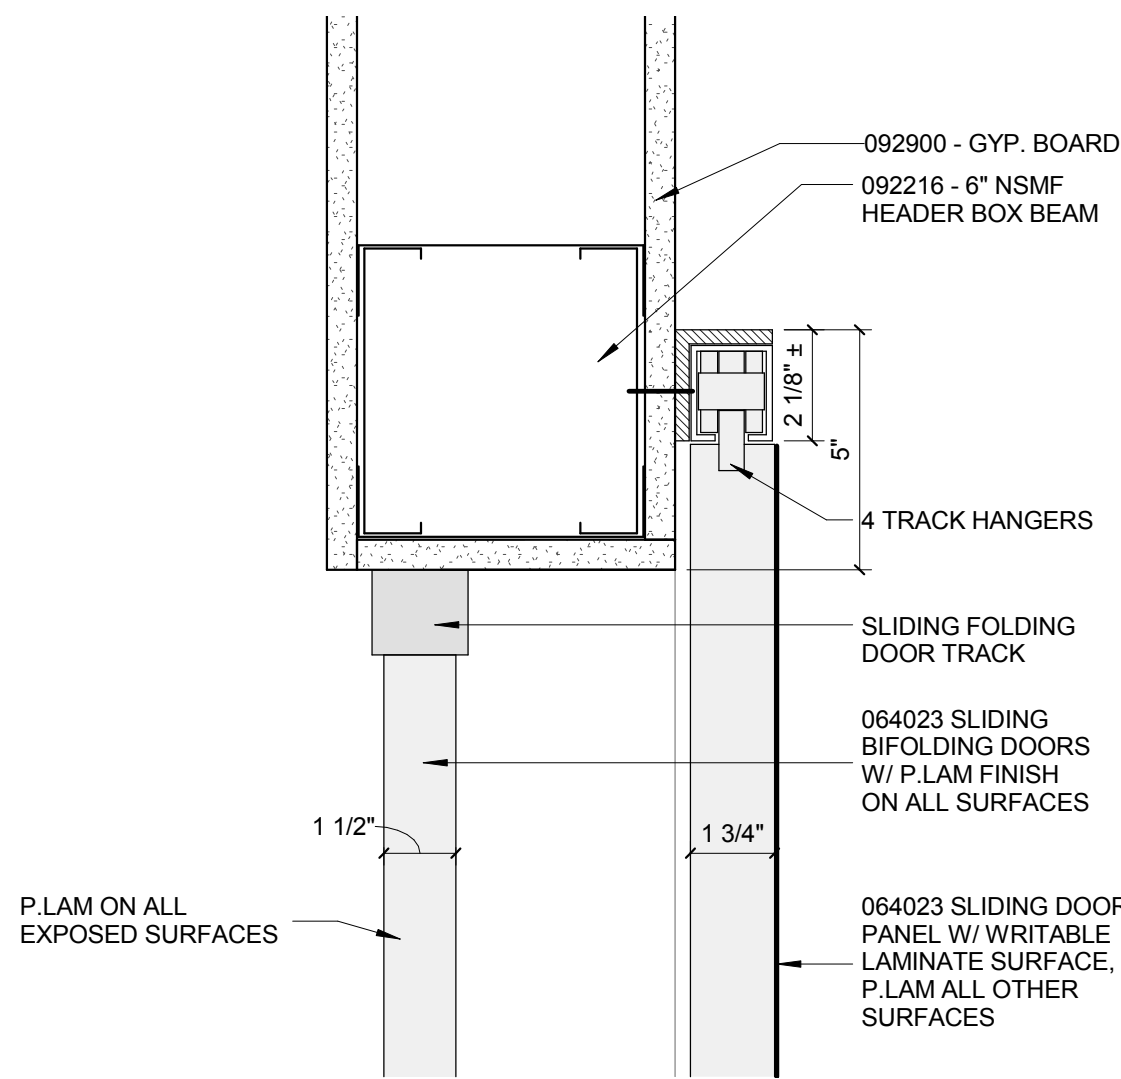


SECTION @ FISH TANK OPENING
AND WHITEBOARD HEAD
3\"/>

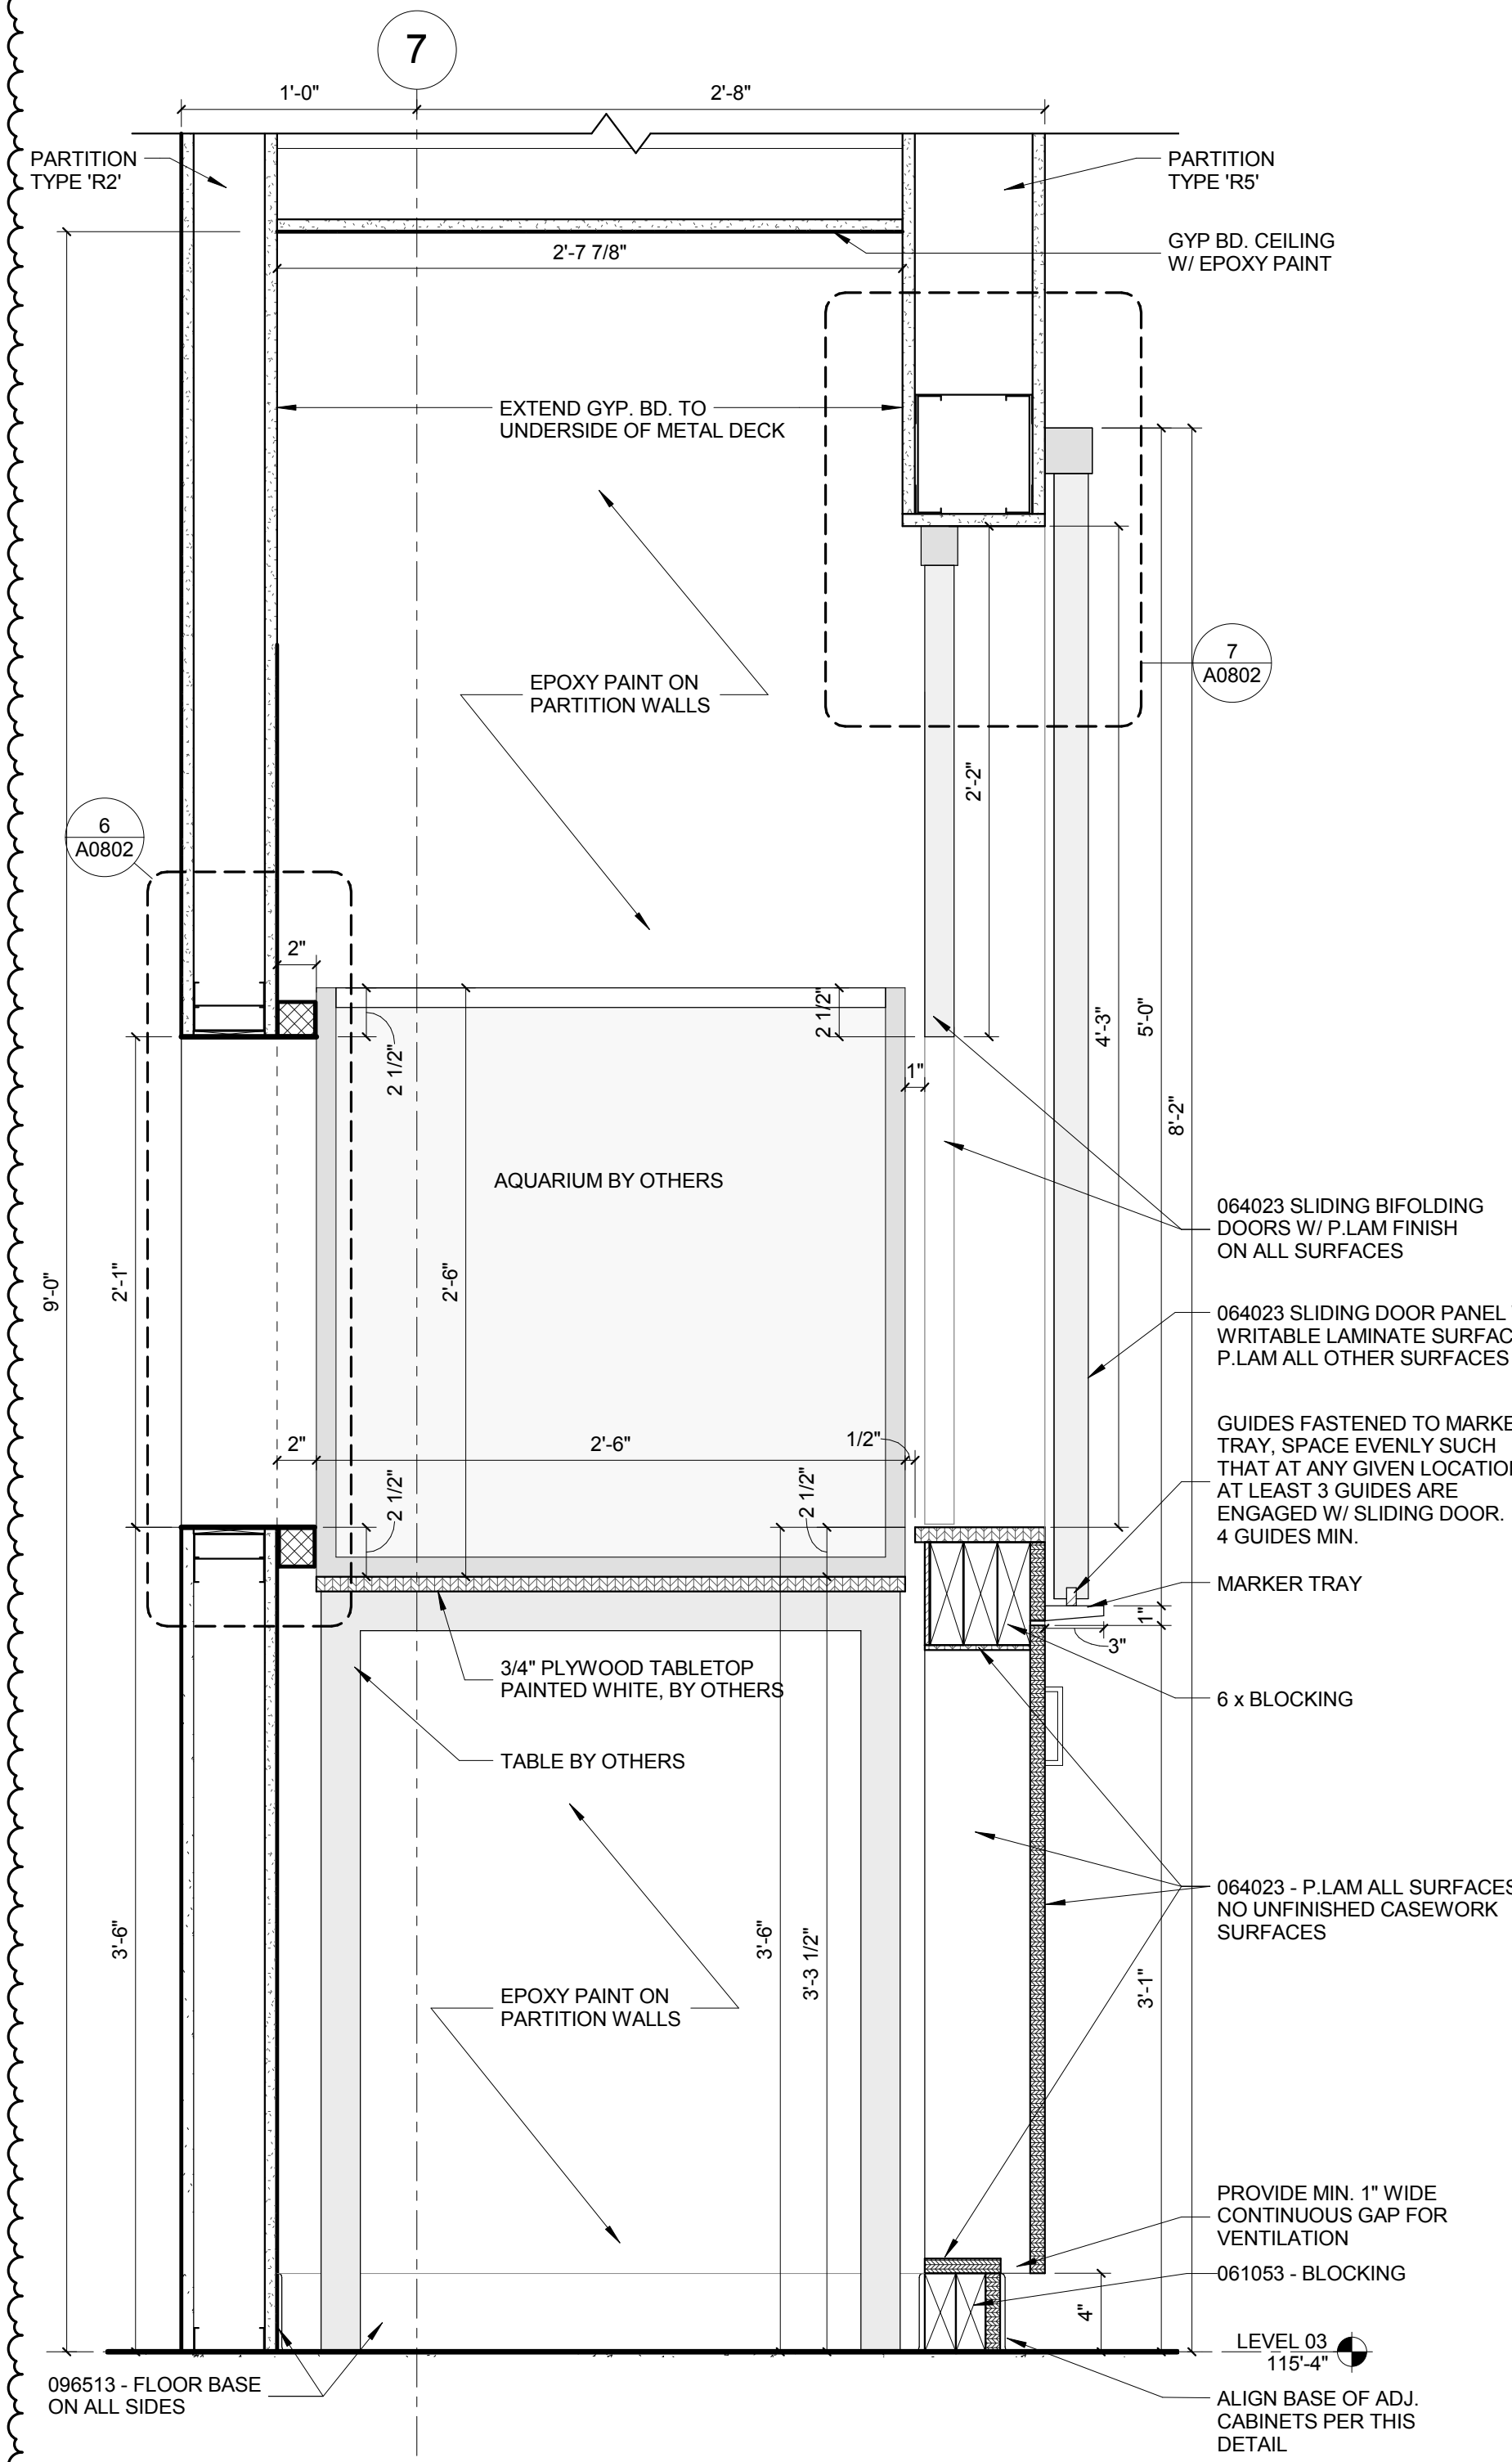


FISH TANK DETAIL SECTION
1 1/2\"/>

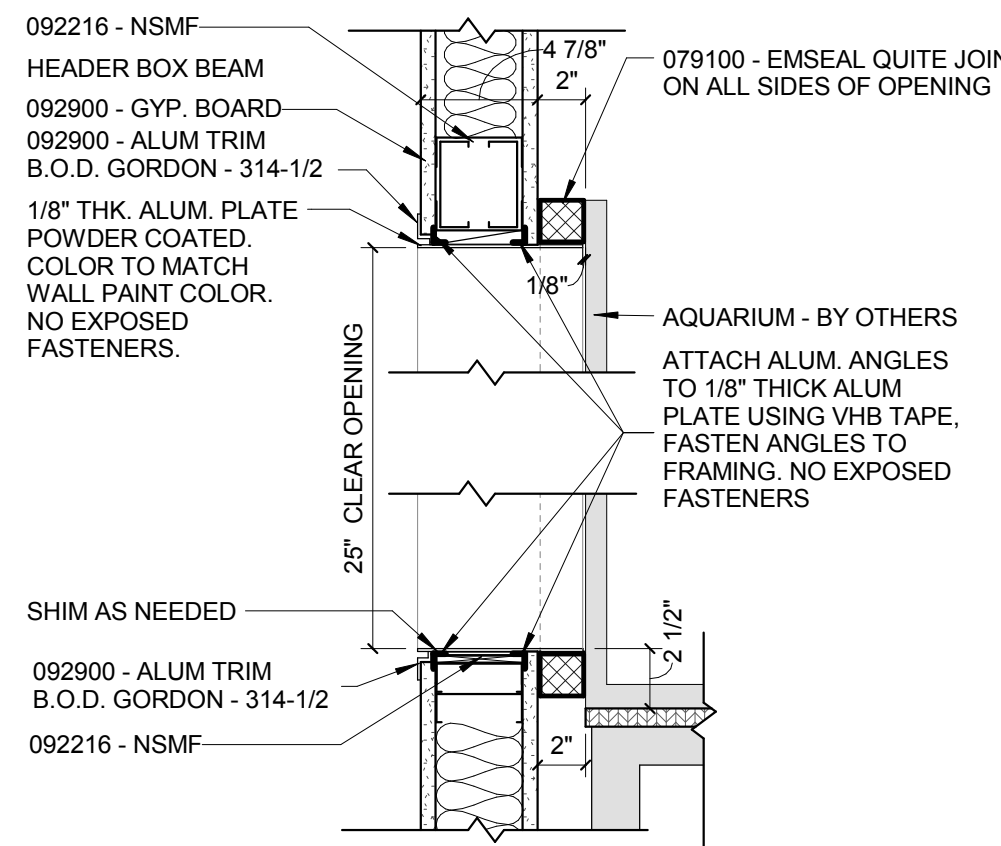


DETAIL OF FISH TANK @ CLEAR OPENING
1 1/2\"/>

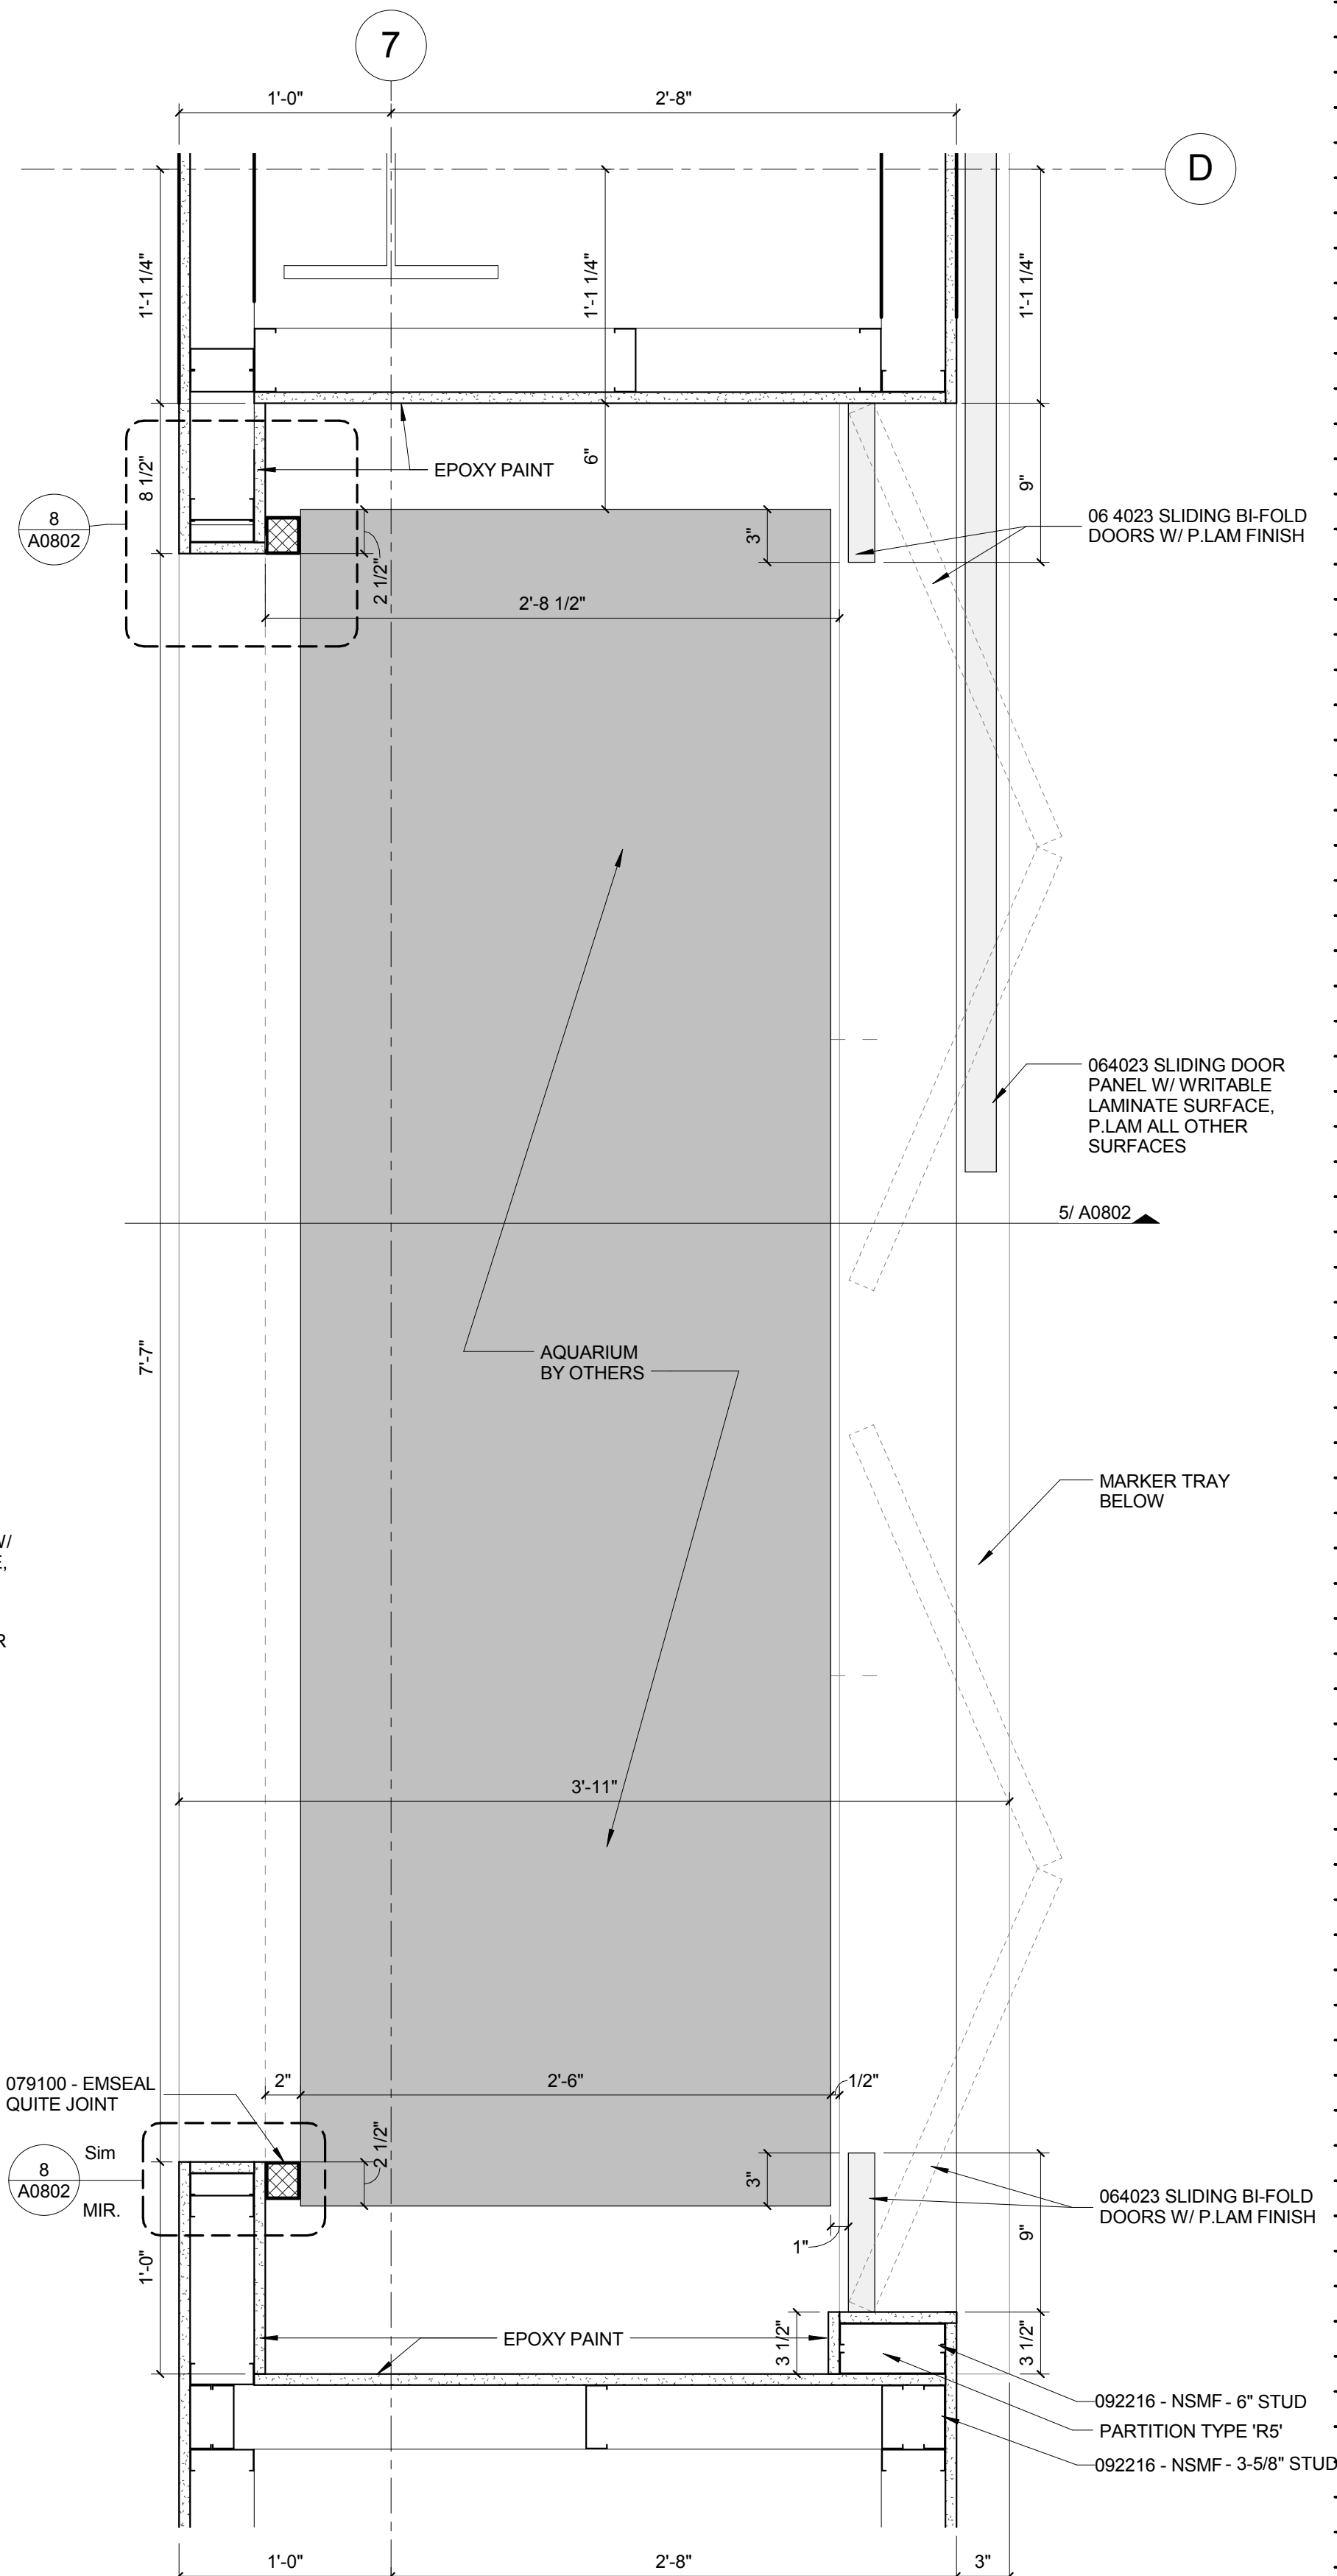


LEVEL 03 - FISH TANK PLAN DETAIL
1 1/2\"/>

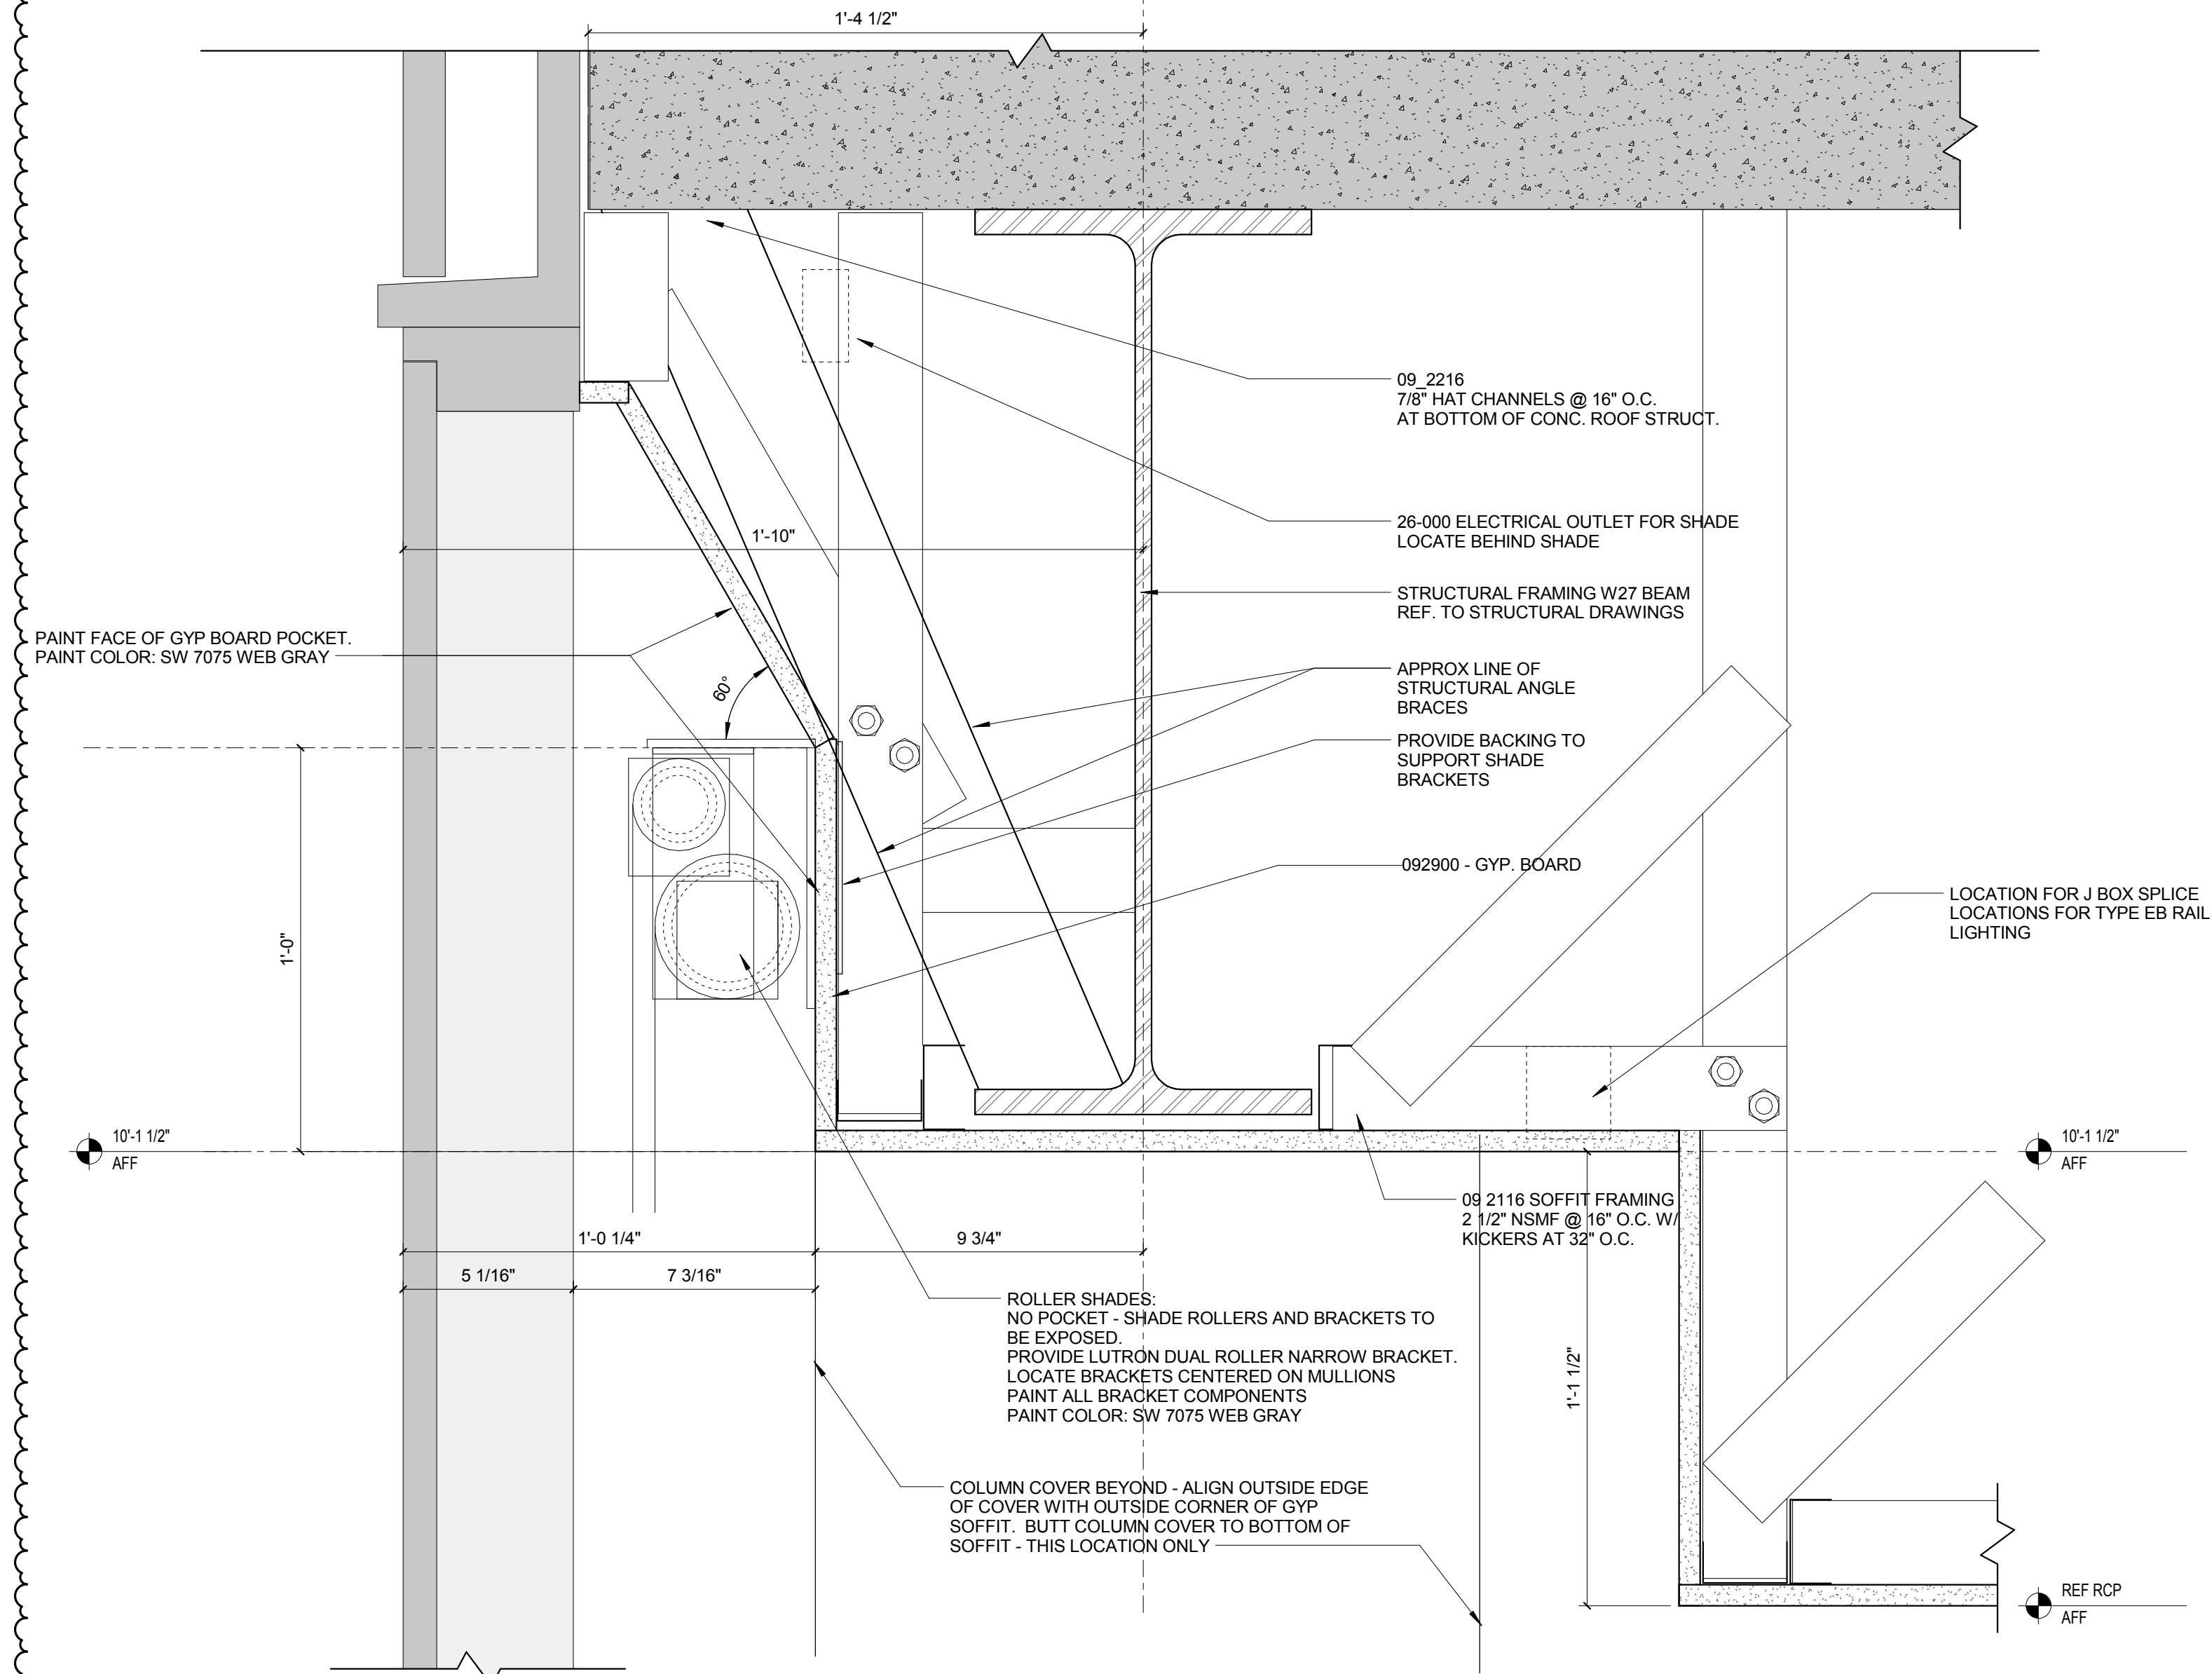

RECESSED MOTORIZED SHADES @ CONFERENCE ROOM
3\"/>

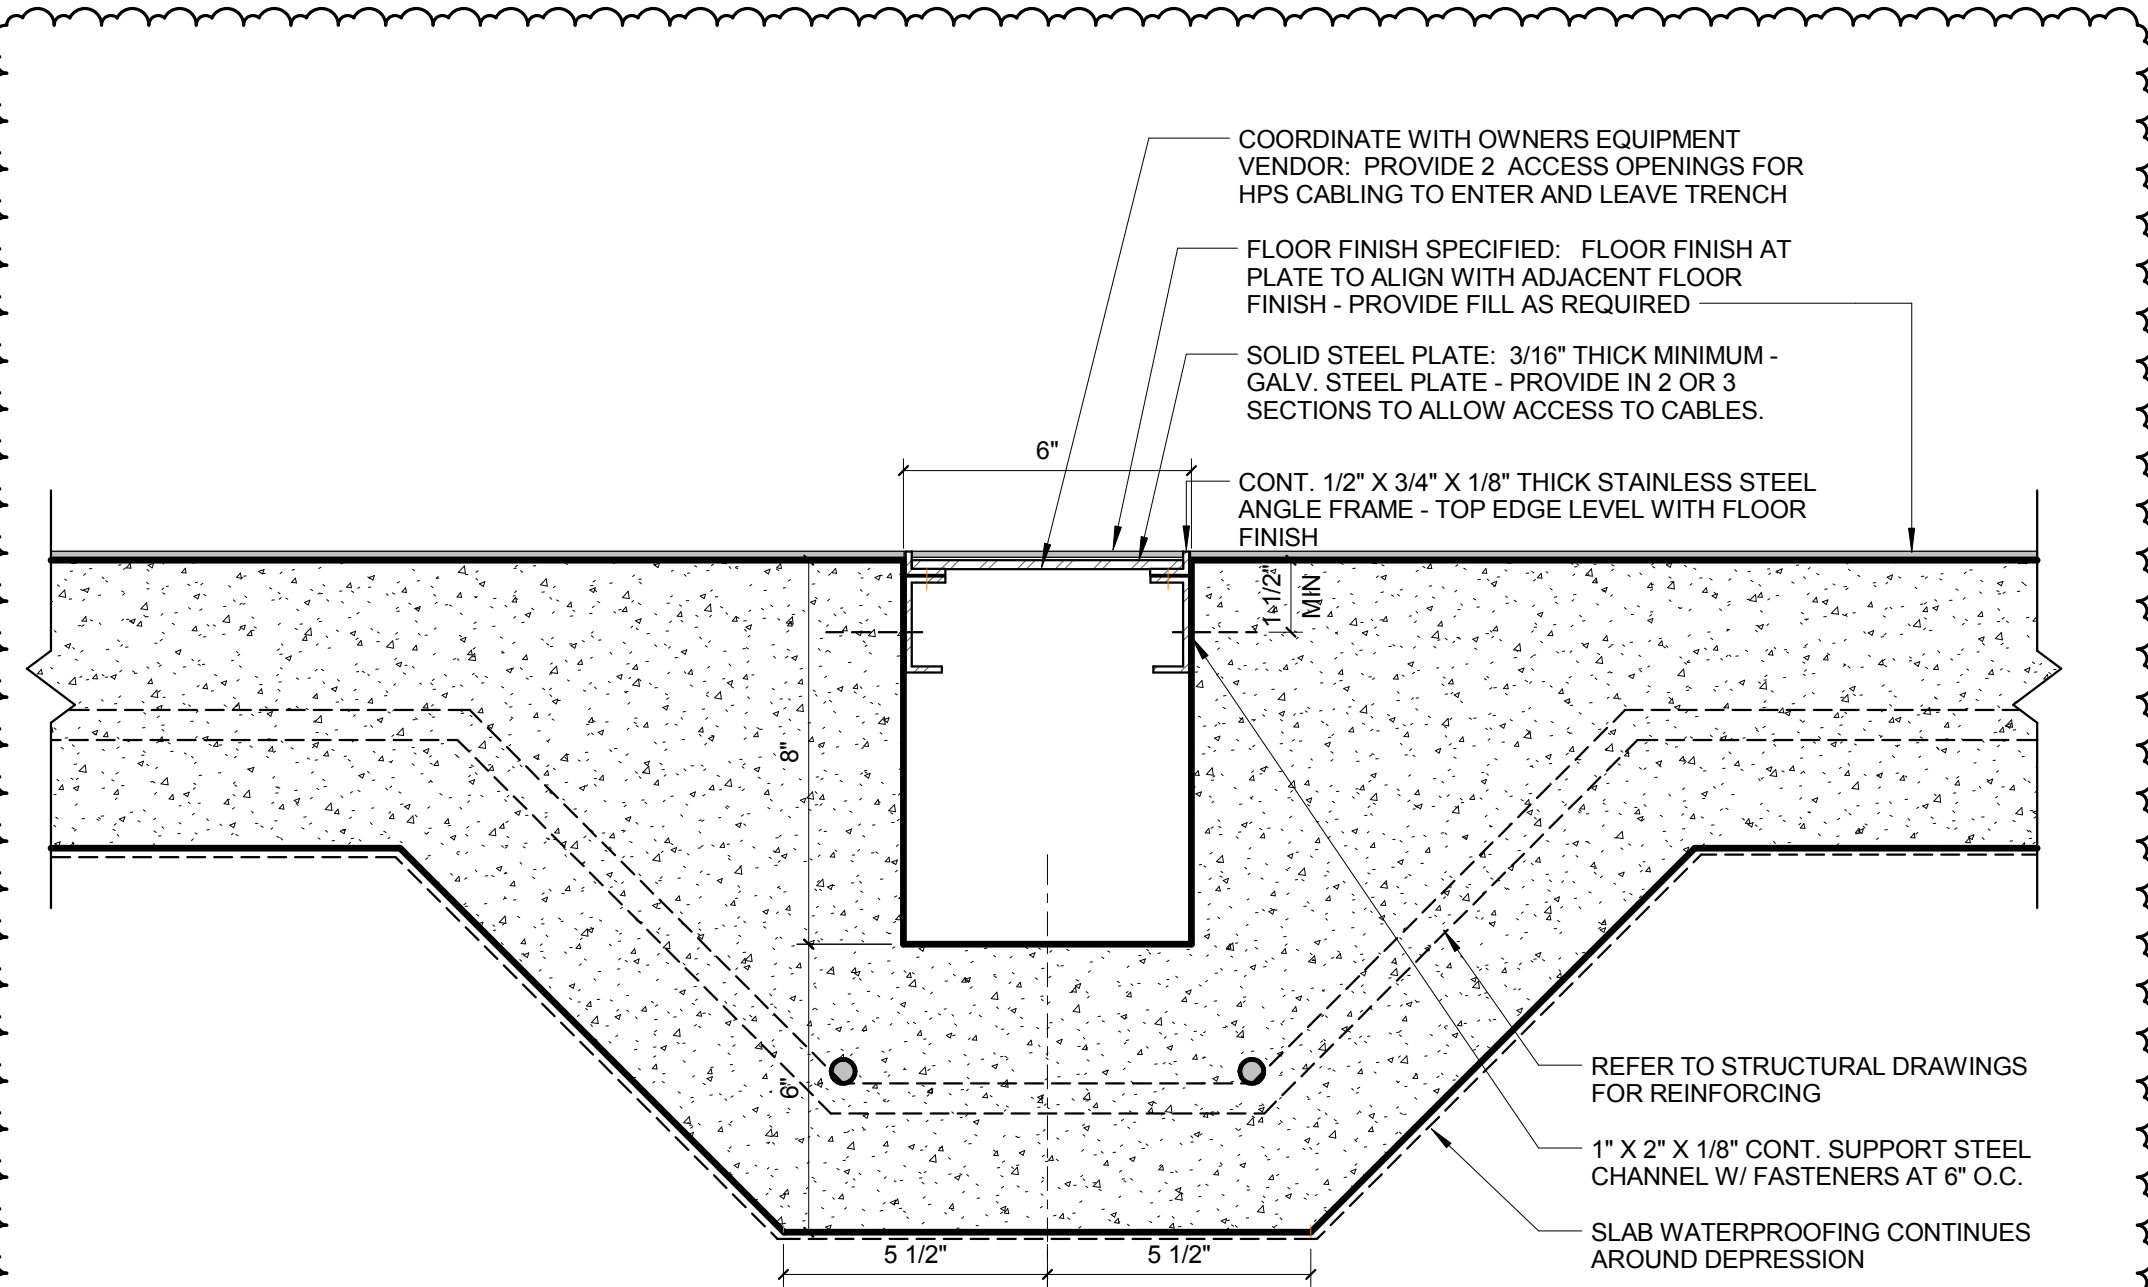

UMBILICAL TRENCH DETAIL
3\"/>

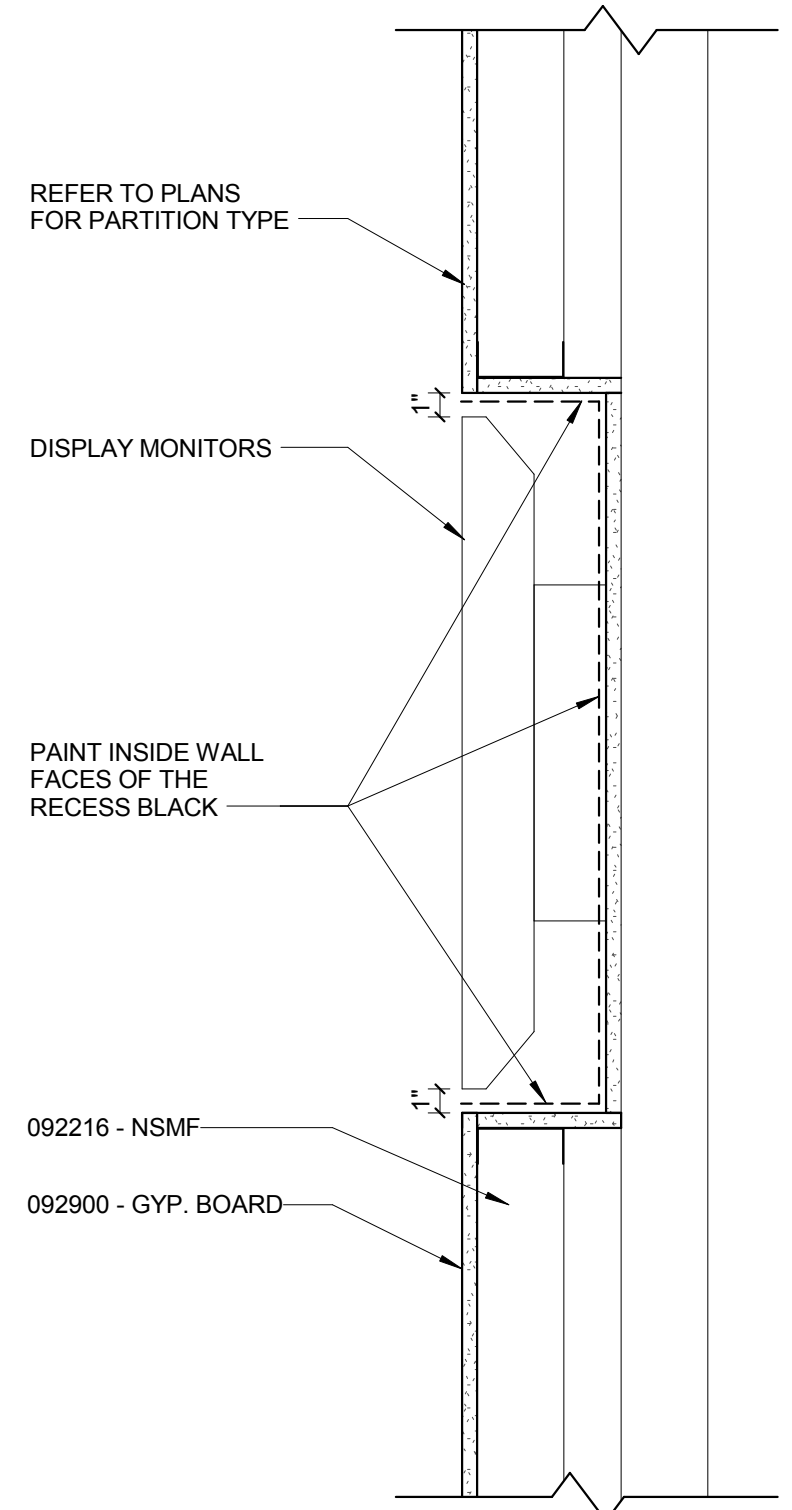

MONITOR SCREEN RECESS
1 1/2\"/>