

## Architect's Supplemental Instructions

**Architect's Project No:**  
04561.01

**Architect's ASI No:** 060

**Project:**  
Webster University  
Interdisciplinary Science  
Building

**Date Issued:** 04/13/2017

**Contract Date:**

**Reason Code:** 05 A/E Scope

**Discipline Code:** 07 General Construction  
(Architectural)

St. Louis  
Baltimore  
Boston  
Buffalo  
Calgary  
Chicago  
Houston  
Los Angeles  
Mumbai  
New York  
Phoenix  
San Francisco  
Shanghai  
Toronto  
Vancouver  
Victoria  
Washington DC

**Owner:**  
Webster University

**Architect:**  
Cannon Design  
1100 Clark Avenue  
St. Louis, MO 63102

**Contractor:**  
Paric Construction

**Contract For:** General construction

The Work shall be carried out in accordance with the following supplemental instructions issued in accordance with the Contract Documents without change in Contract Sum or Contract Time. Indicate your acceptance of these instructions for minor change to the Work as consistent with the Contract Documents and return a copy to the Architect within fourteen (14) business days of the date of issuance of these instructions. If you feel a change in Contract Sum or Contract Time is warranted, please submit an itemized quotation for the changes for approval within fourteen (14) business days of the date of issuance of these instructions prior to proceeding on the Work. Proceeding with the Work in accordance with these instructions indicates your acknowledgement that there will be no change.

### Attachments:

**Sheets:**  
A0102.A, A0459, A0702.A, A0811.

1100 Clark Avenue  
St. Louis, Missouri  
63102  
T: 314.241.6250  
F: 314.241.2570  
www.cannondesign.com

**Reason Codes:**  
#1. Jurisdictional Agency  
#2. Constructor Driven  
#3. Document Inconsistency  
#4. Fast Track Driven  
#5. A/E Scope  
#6. Owners Scope  
#7. Unforeseeable Conditions  
#8. Other

**Discipline Codes**  
#1. Demo-demolition  
#2. Div1-Division 1 items on the spec book  
(this item is not used)  
#3. Electrical  
#4. Elevator  
#5. Equipment (Changes in equipment,  
Owner Purchased)  
#6. Fire Protection

**Discipline Codes**  
#7. General Construction (Architectural)  
#8. General Conditions (Div. 1)  
#9. HVAC  
#10. Other  
#11. Plumbing  
#12. Site Work/Landscaping  
#13. Structural

## Architect's Supplemental Instructions

Page 2

**Description:**

---

EAB-ISB connection details at EAB CONNECTOR C270A.


**Please submit an itemized proposal for changes in contract Sum and Contract Time for proposed modifications to the Contract Documents described herein:**

**Issued by Architect:** Kelvin Patel, CannonDesign;

**Accepted by Contractor:**

---


---

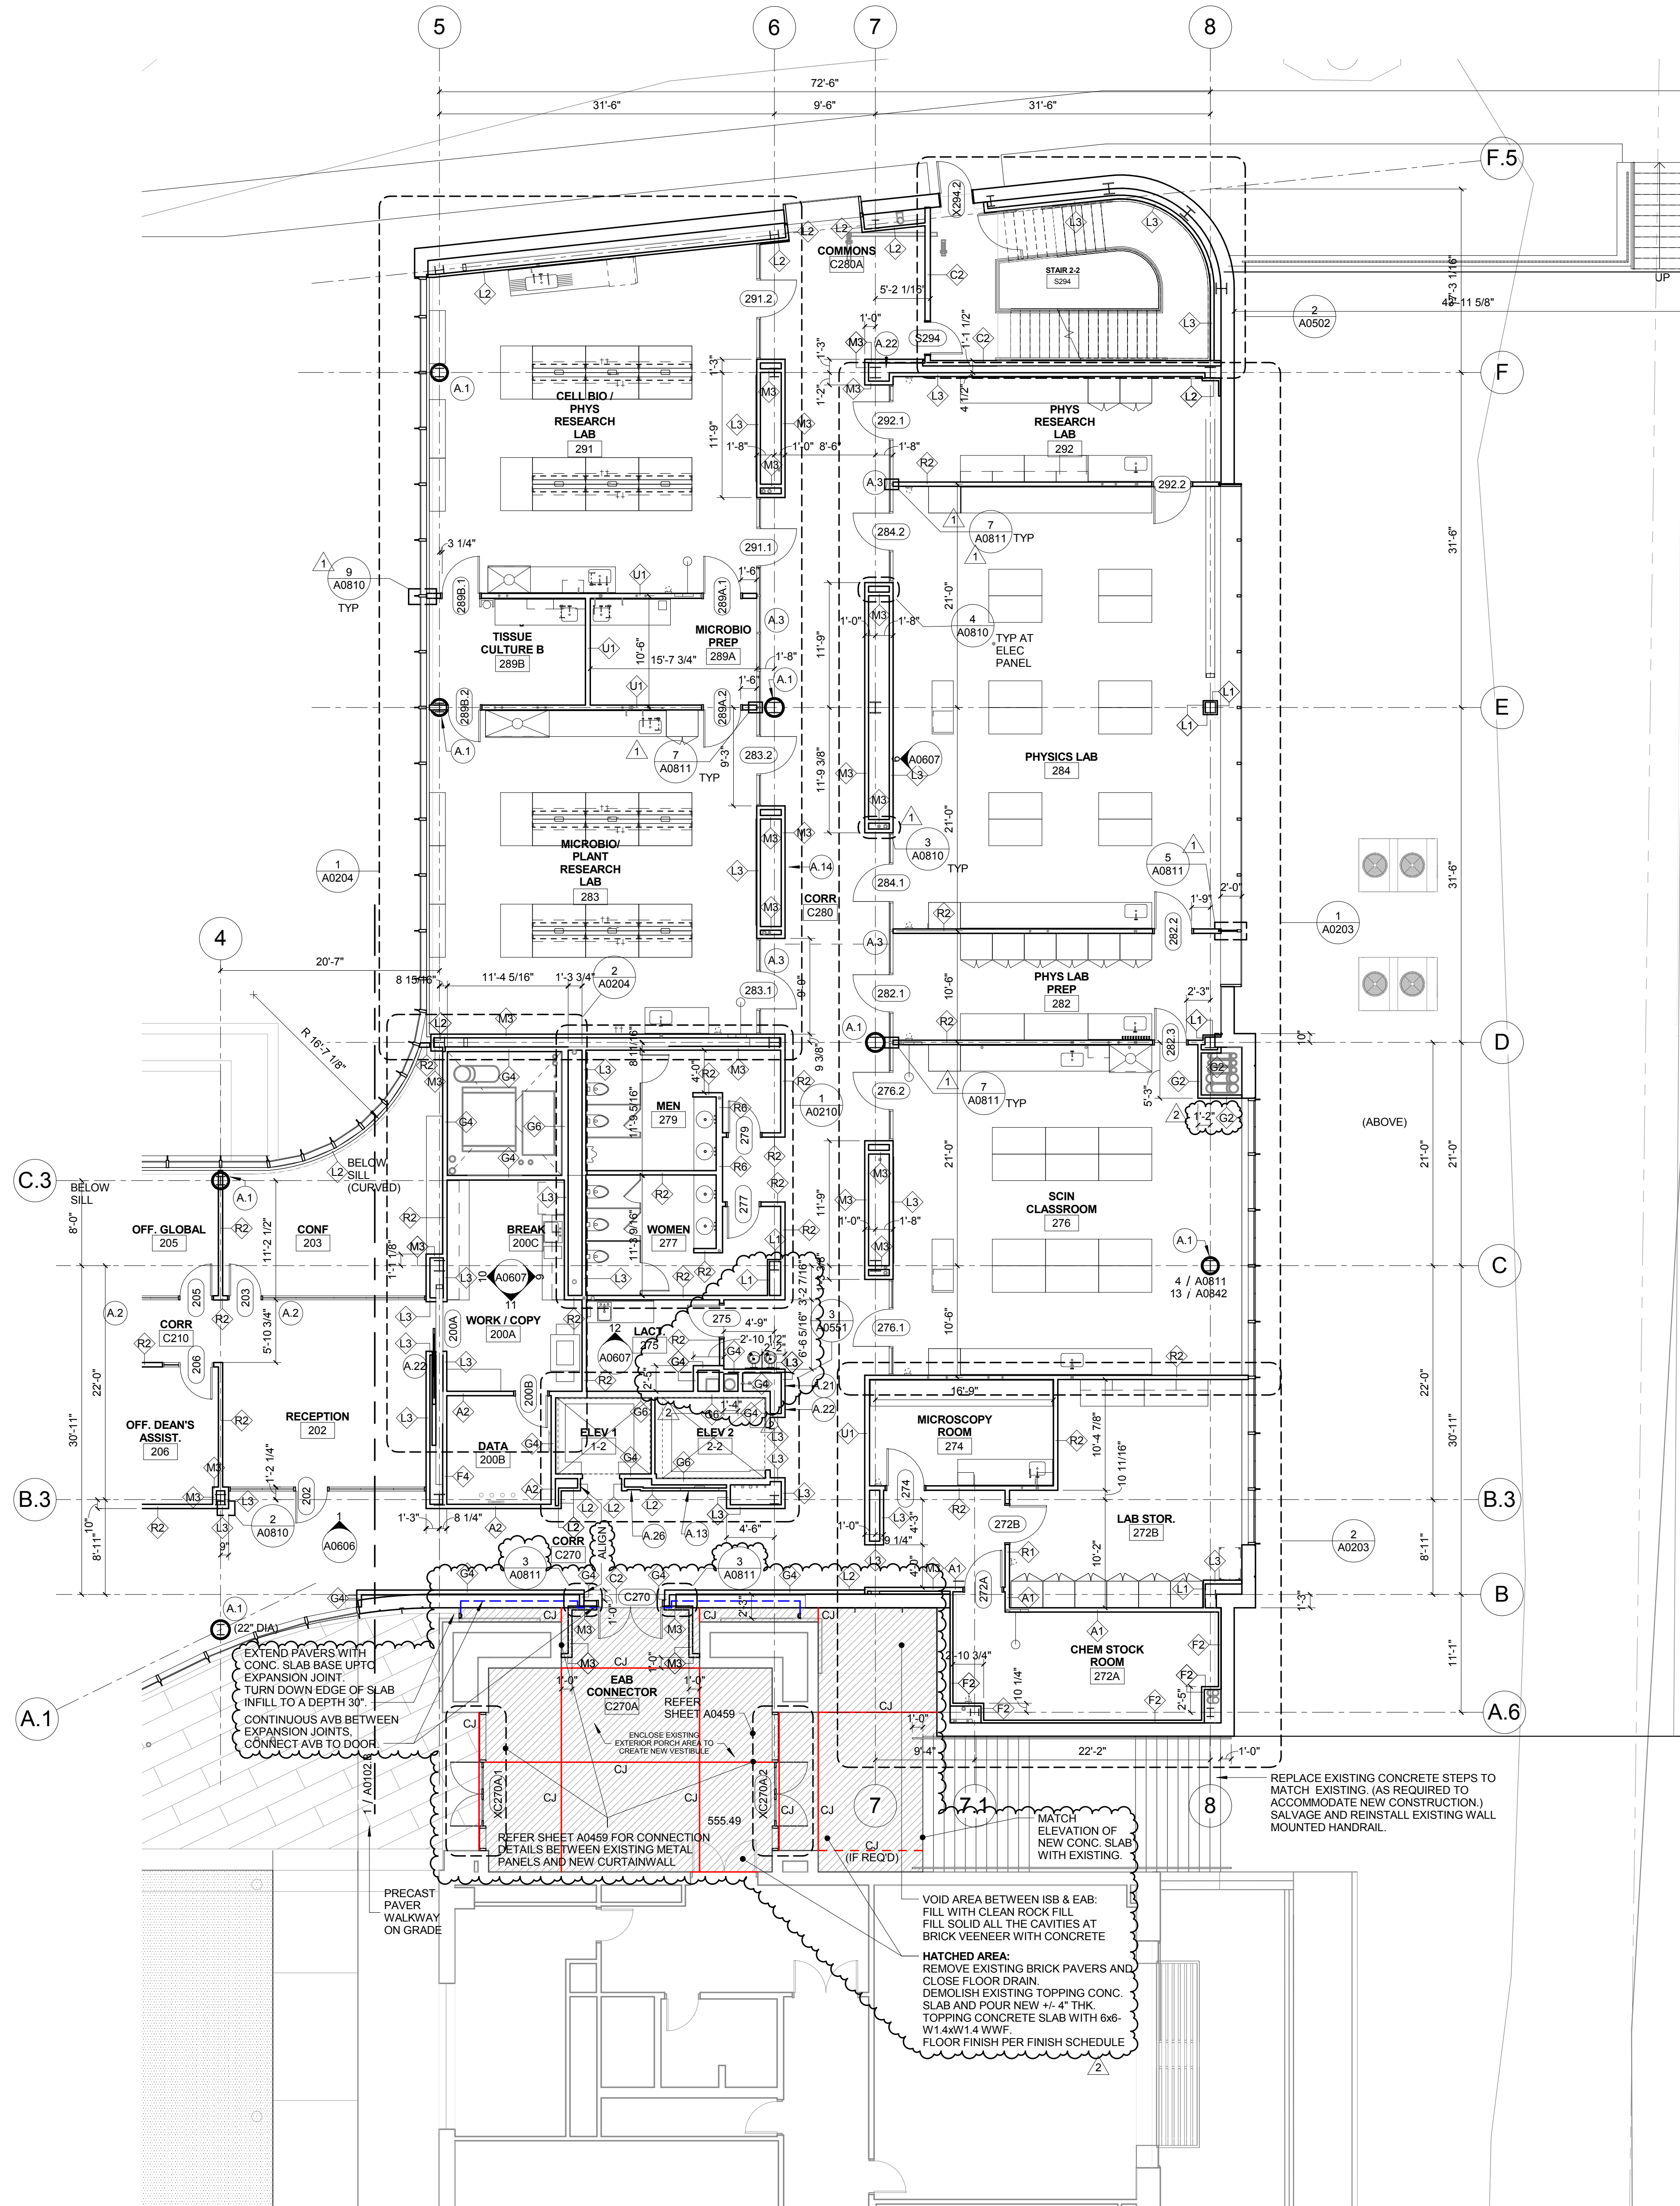

1 LEVEL 02- AREA A FLOOR PLAN  
1/8" = 1'-0"


- KEYED NOTE LEGEND - PLAN**
- A.1 092700 GRG COLUMN COVER TO 3" ABOVE CEILING - 20" DIA. TYP. SEE DETAIL 4/A0811 AND 13/A0842.
  - A.2 081216 INTERIOR GLAZING SYSTEM: IGS-1: REFER TO TYPICAL INT. ELEVATIONS 1 AND 2 ON SHEET A0803
  - A.3 081216 INTERIOR GLAZING SYSTEM IGS-2: SEE TYPICAL ELEVATION 5 AND 6 A0603
  - A.4 081216 INTERIOR GLAZING SYSTEM: IGS-3: REFER TO INTERIOR ELEVATIONS
  - A.5 088813 FIRE RATED GLAZING- 120 MIN. FIRE RATED GLAZING 10'-0" HIGH. BASIS OF DESIGN: VETROTECH CONTRAFILAMM STRUTTURA - WITH BUTT JOINTS AND PERIMETER FRAMING
  - A.6 088813 FIRE RATED GLAZING AND FRAME- 120 MIN. FIRE RATED GLAZING 1'-8" HIGH X 5'-0" WIDE. BASIS OF DESIGN: VETROTECH CONTRAFILAMM WITH PERIMETER FRAMING
  - A.7 111519 LOADING DOCK LIFT - STATIONARY - 6W X 8' DEEPW/ 14" PIT
  - A.8 ALTERNATING TREAD STAIRWAY UP TO ROOF HATCH
  - A.9 UNDERSLAB DRAINAGE SYSTEM PER OWNER'S GEOTECHNICAL CONSULTANT RECOMMENDATION TYPICAL ALL SLAB ON GRADE AREAS
  - A.11 NEW CONCRETE STEPS TO MATCH EXISTING REMOVED FOR CONSTRUCTION
  - A.12 553006 BRICK FACED CONCRETE DUMPSTER ENCLOSURE TOP OF WALL
  - A.13 LCD SIGNAGE SCREEN IN WALL RECESS (OFCI)
  - A.14 MARKERBOARD SURFACE
  - A.15 WOOD SCREEN W/ SOLID LUMBER
  - A.17 VIDEO WALL - 24 55" SCREENS
  - A.18 LCD SCREEN LOCATION (OFOI)
  - A.19 AIR PLENUM - INSULATED PLENUM CONSTRUCTION BY DIVISION 23
  - A.20 122200 CURTAIN LOCATION
  - A.21 104313 AED CABINET LOCATION
  - A.22 10 4413 FEC WITH FIRE EXTINGUISHER
  - A.23 08 4423 SULL SASH LOCATION: PROVIDE 1/4" TEMPERED CLEAR GLAZING AT INTERIOR FACE OF CURTAIN WALL MULLIONS FOR ACOUSTICAL SEPARATION.
  - A.24 6" X 8" FORMED CONCRETE TRENCH IN FLOOR W/ METAL PLATE COVER. PROVIDE BLIND SIDE WATERPROOFING
  - A.25 BUILT IN SALT WATER FISH TANK LOCATION. SIZE APPROX. 7'-6" X 2'-4" X 2'-6" HIGH. LOW IRON GLASS VIEW WINDOW ON CORRIDOR SIDE. SLIDING DOOR ON LAB SIDE. FISH TANK EQUIPMENT BELOW TANK W/ CABINET DOOR ACCESS ON LAB SIDE. FINISHED INTERIOR FACE OF WALLS AND CEILING INSIDE CAVITY W/ WATER RESISTANT GYP BOARD AND EPOXY PAINT
  - A.26 LCD SIGNAGE SCREEN IN WALL RECESS (OFCI)
  - A.27 CONSTRUCT 2 HOUR RATED SEPARATION BETWEEN BOTTOM OF STAIR AND UTILITY PIPING CROSSING THIS AREA. USE HORIZ. GYP BD. ENCLOSURE ON SHEET A1002

| 2   | ASI-060                       | 13 APR 2017 |
|-----|-------------------------------|-------------|
| 1   | ADDENDUM 3-2                  | 16 APR 2016 |
| -   | ISSUED FOR CONSTRUCTION (BP3) | 15 MAR 2016 |
| No. | Description                   | Date        |

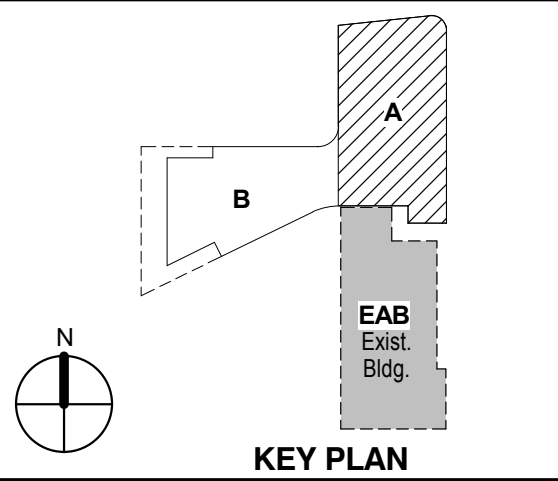


KEY PLAN


**LEVEL 02 AREA A FLOOR PLAN**

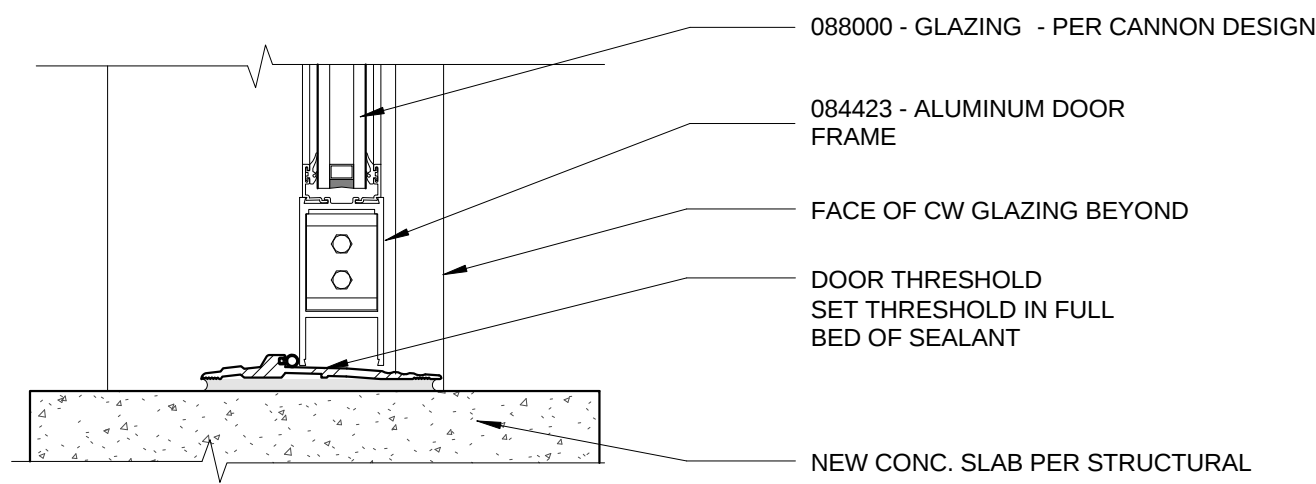

3 EAB ALUMINUM DOOR THRESHOLD AT EAB CONNECTOR  
3" = 1'-0"

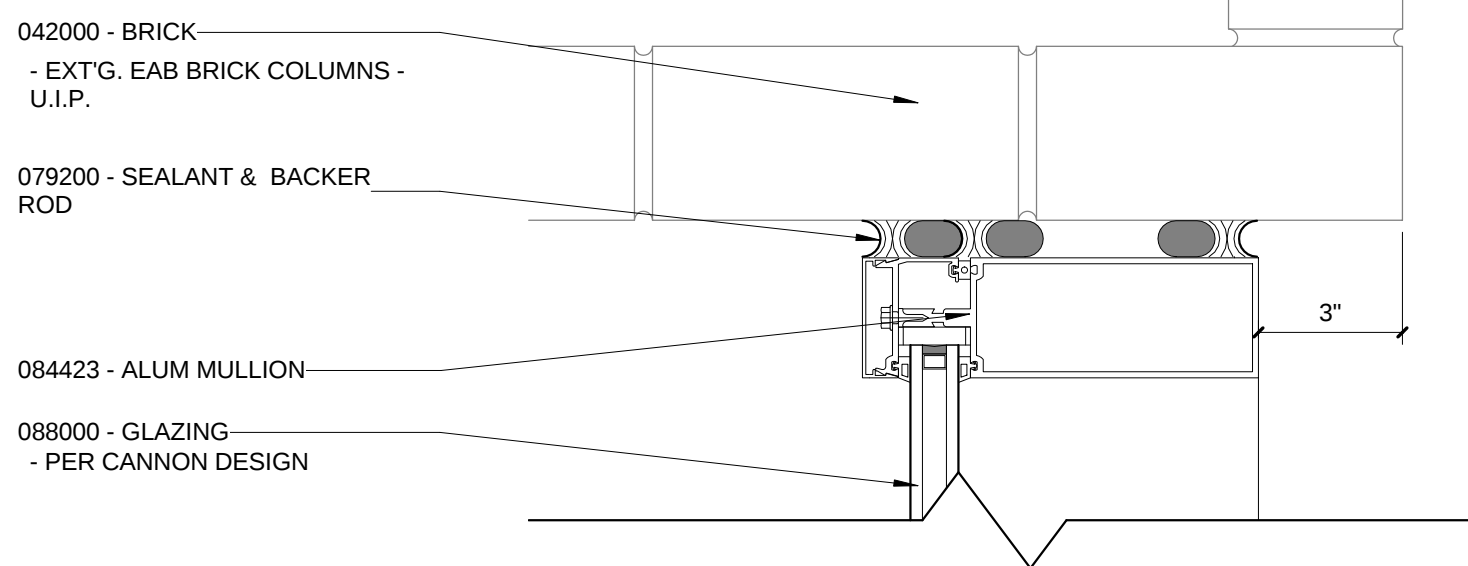

2 JAMB DETAIL AT EAB CONNECTOR  
3" = 1'-0"

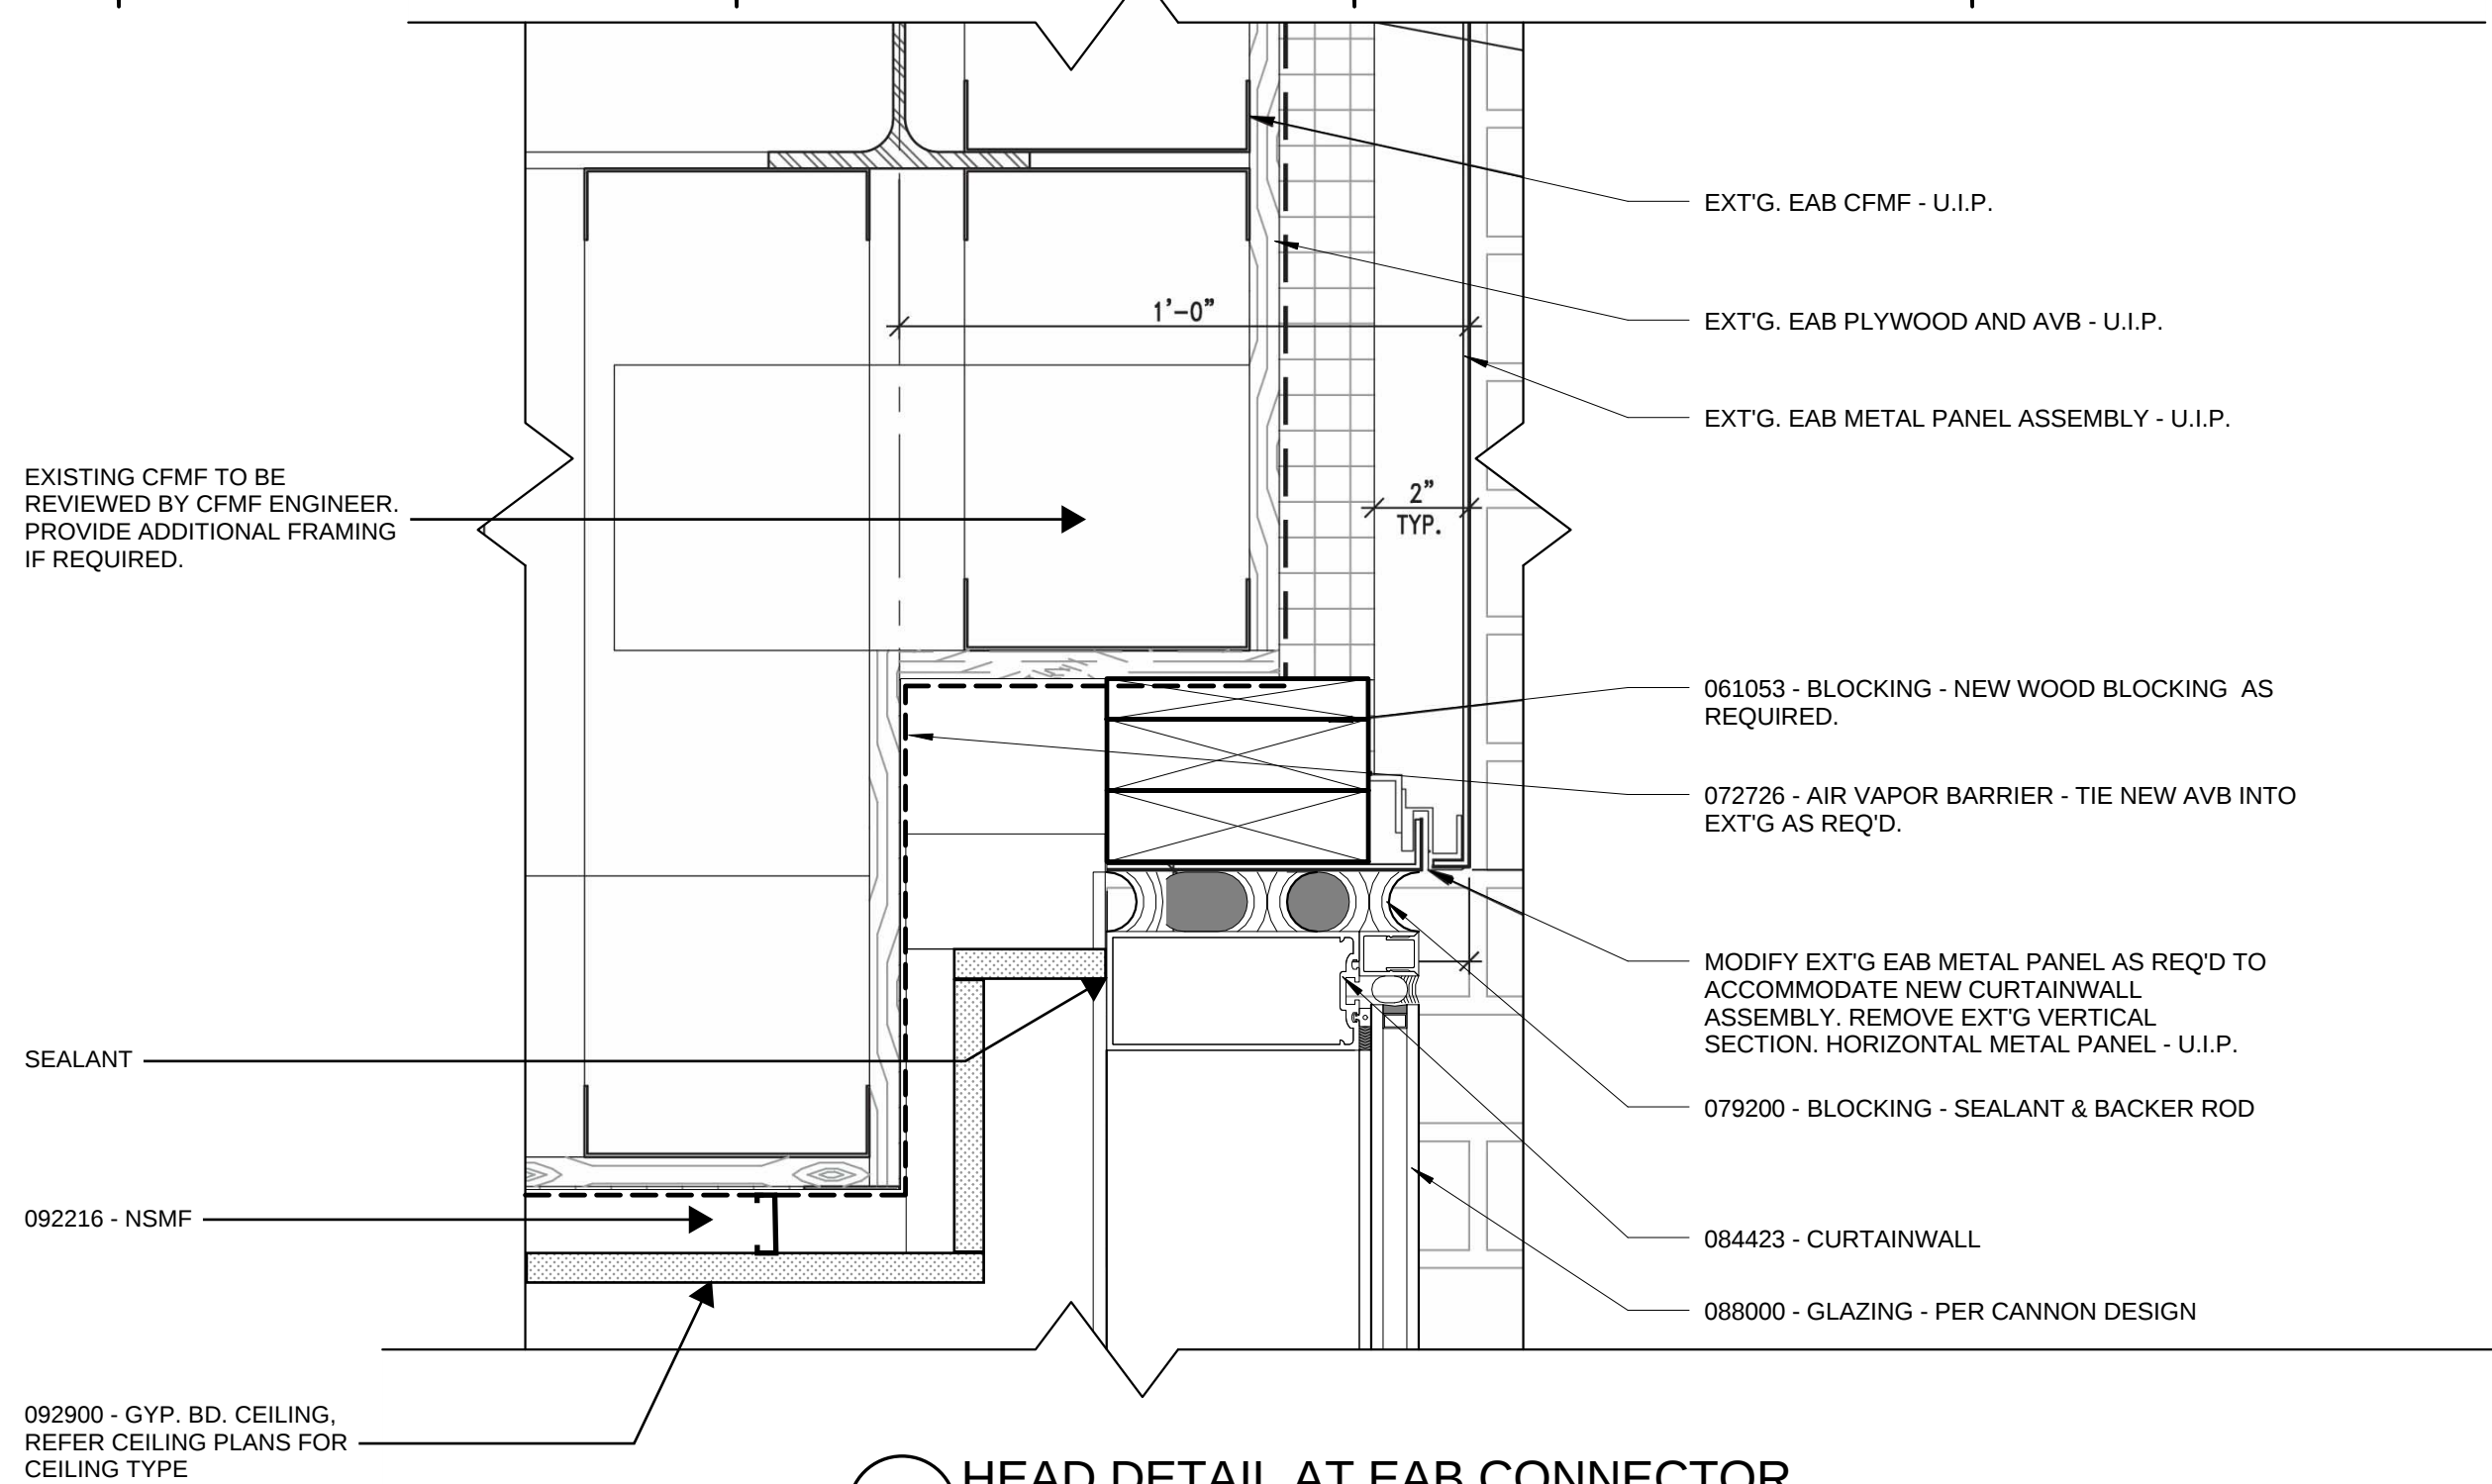

1 HEAD DETAIL AT EAB CONNECTOR  
3" = 1'-0"

1 ASI-060

13 APR 2017


| No. | Description | Date |
|-----|-------------|------|
|-----|-------------|------|

Drawing Title:

EAB CONNECTOR  
DETAILS

Project No.: 04561.01 Checked by:

A0459

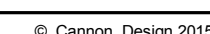


|     |                               |             |
|-----|-------------------------------|-------------|
| 2   | ASI-060                       | 13 APR 2017 |
| 1   | ADDENDUM 3-2                  | 16 APR 2016 |
| -   | ISSUED FOR CONSTRUCTION (BP3) | 15 MAR 2016 |
| No. | Description                   | Date        |

Drawing Title:


INTERIOR PLAN DETAILS

Project No.: 04561.01      Checked by:


A0811

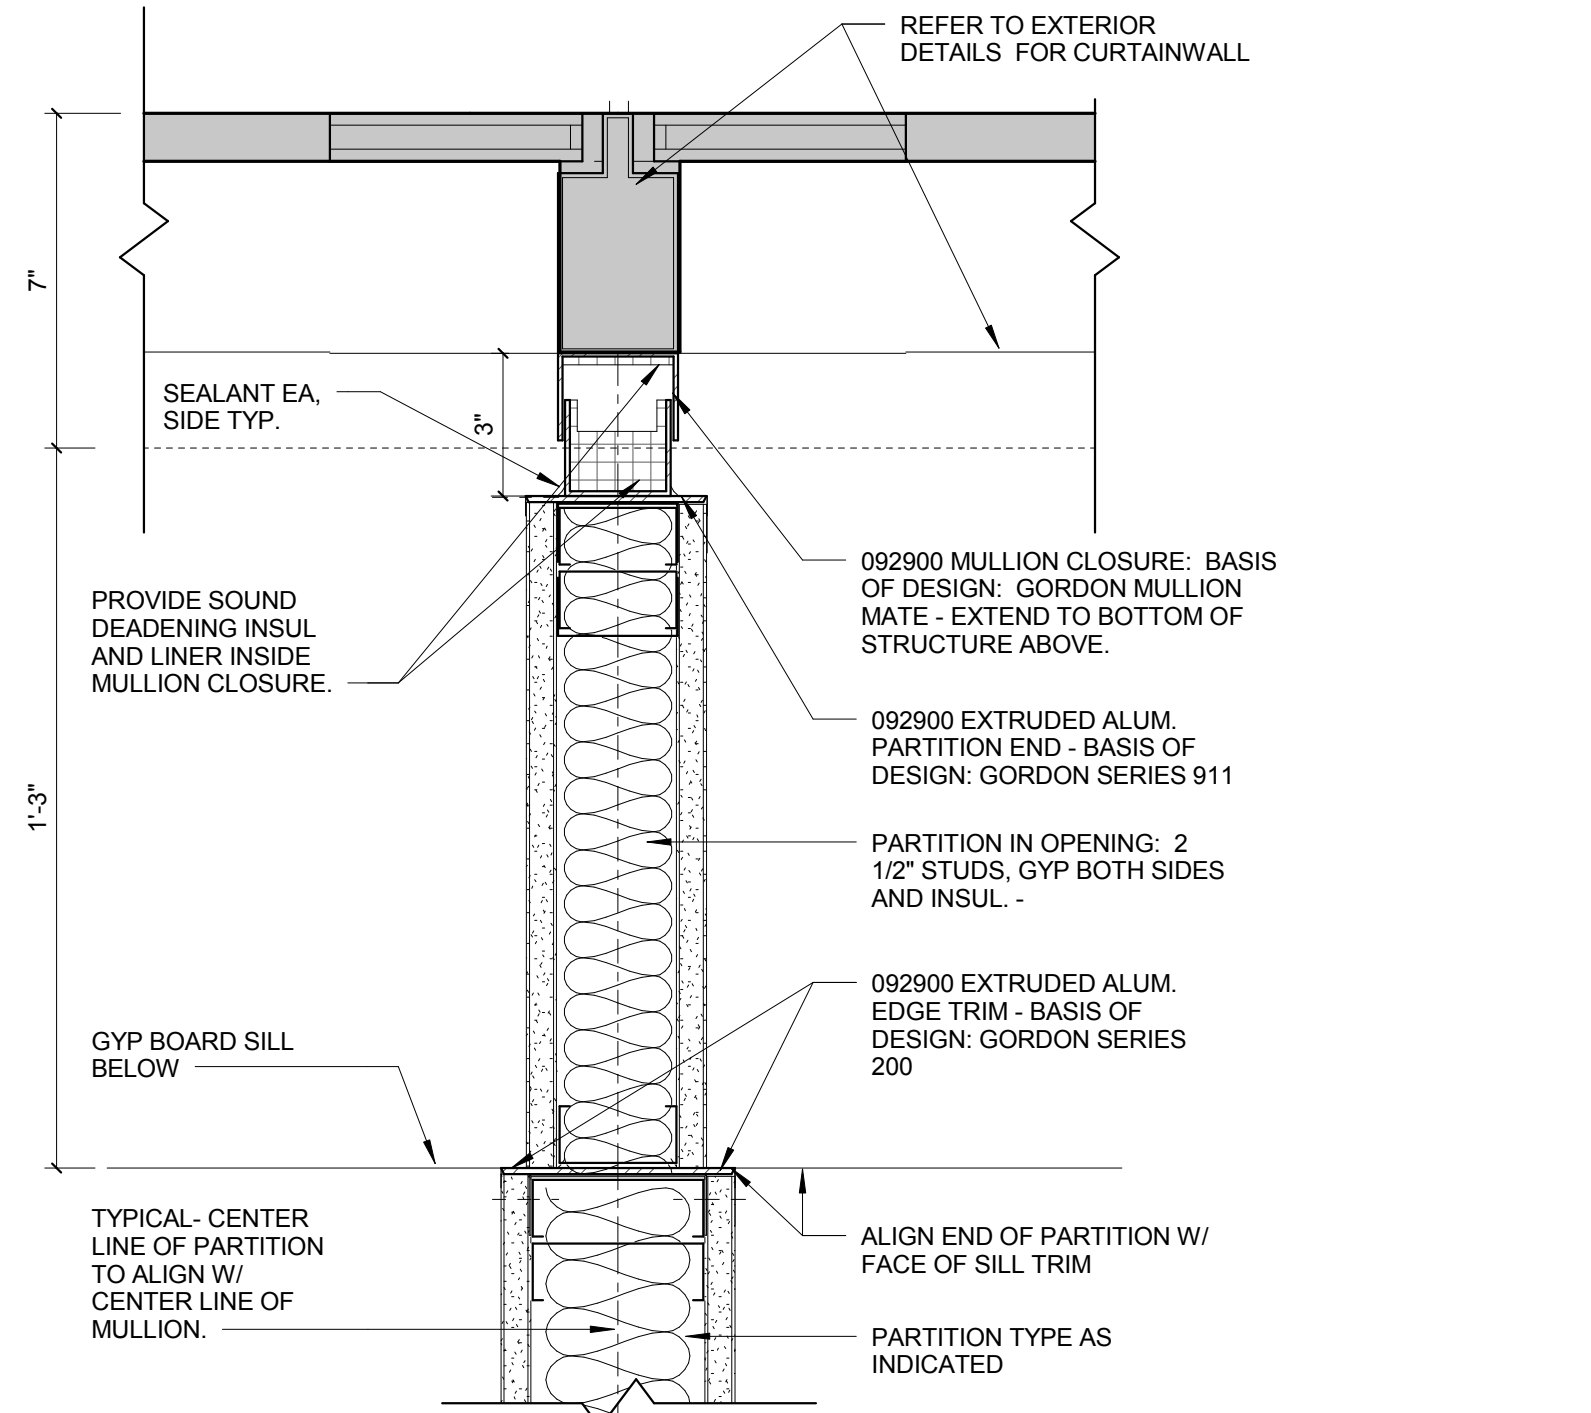


5 PLAN DETAIL AT PROJECTED WINDOW  
3" = 1'-0"

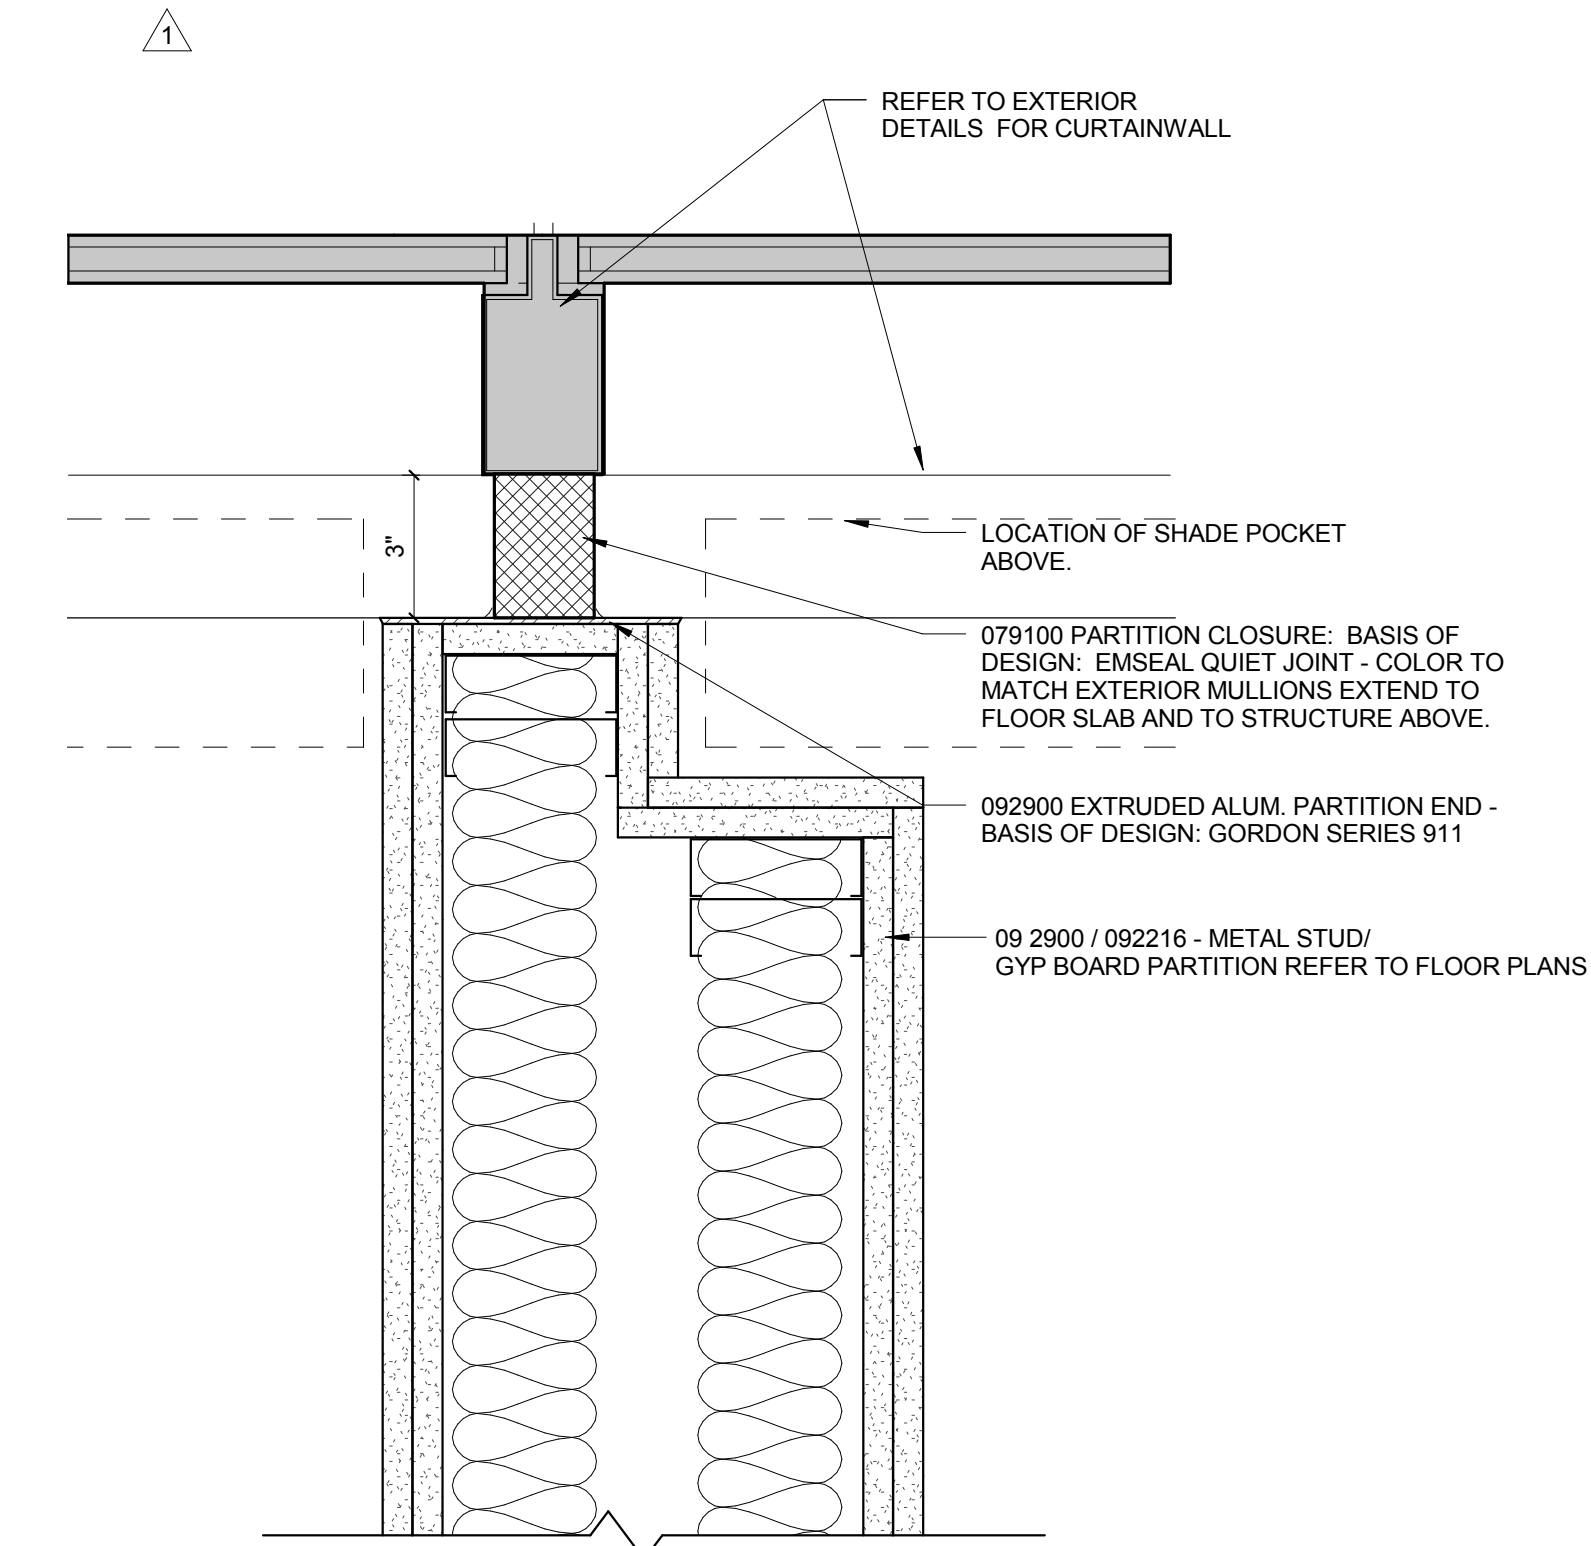


1 PLAN DETAIL - WEST WALL  
3" = 1'-0"

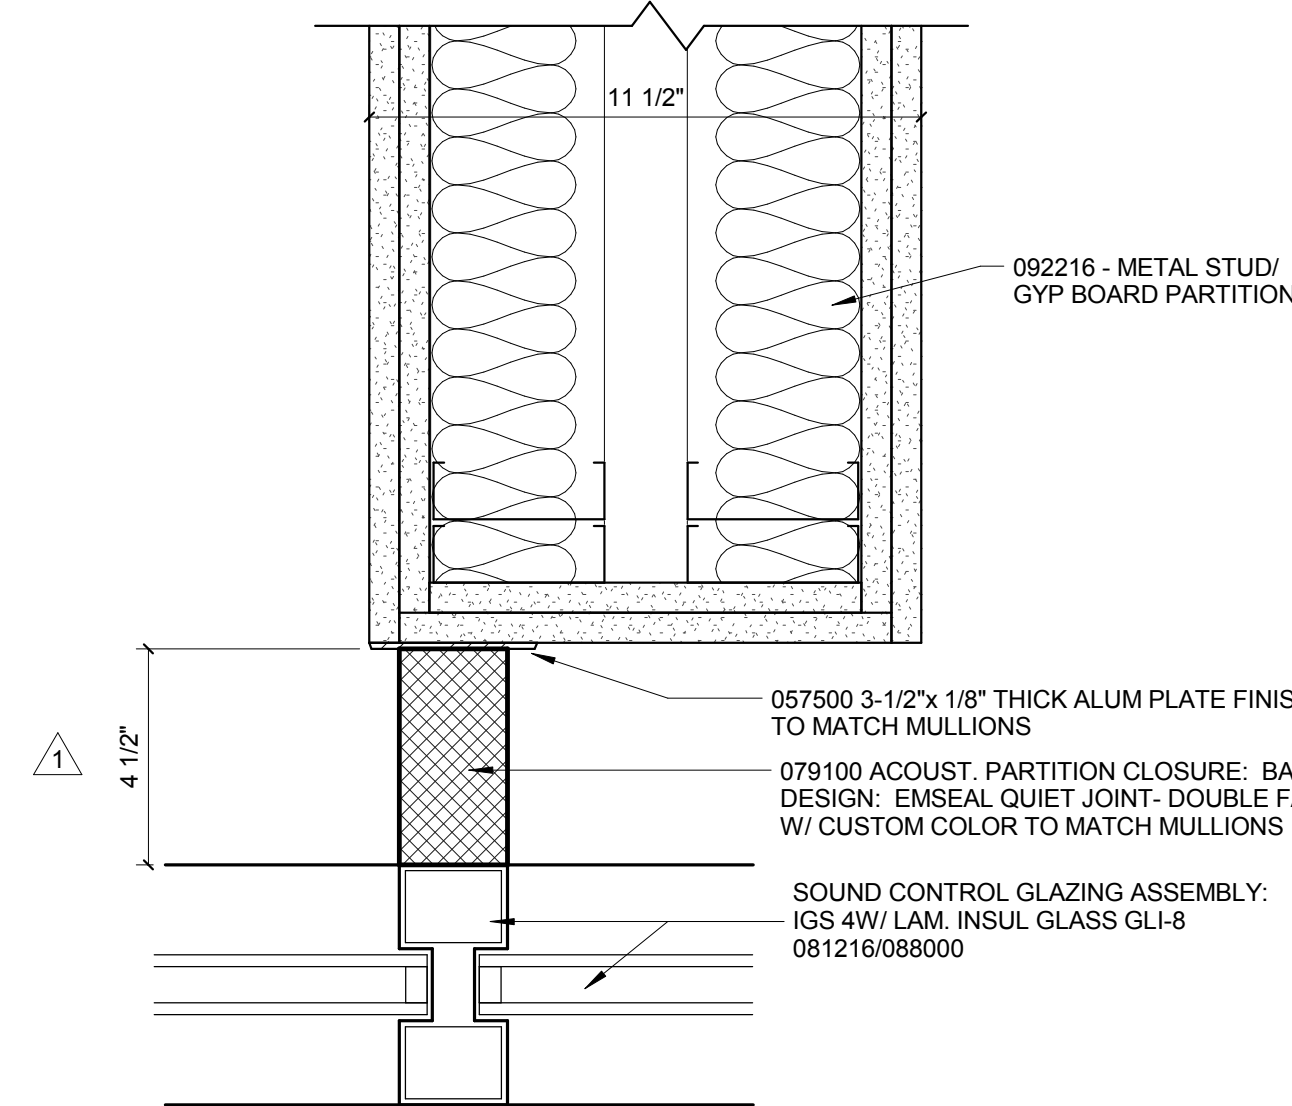


2 PLAN DETAIL - LEVEL 02 @ GLAZING  
3" = 1'-0"

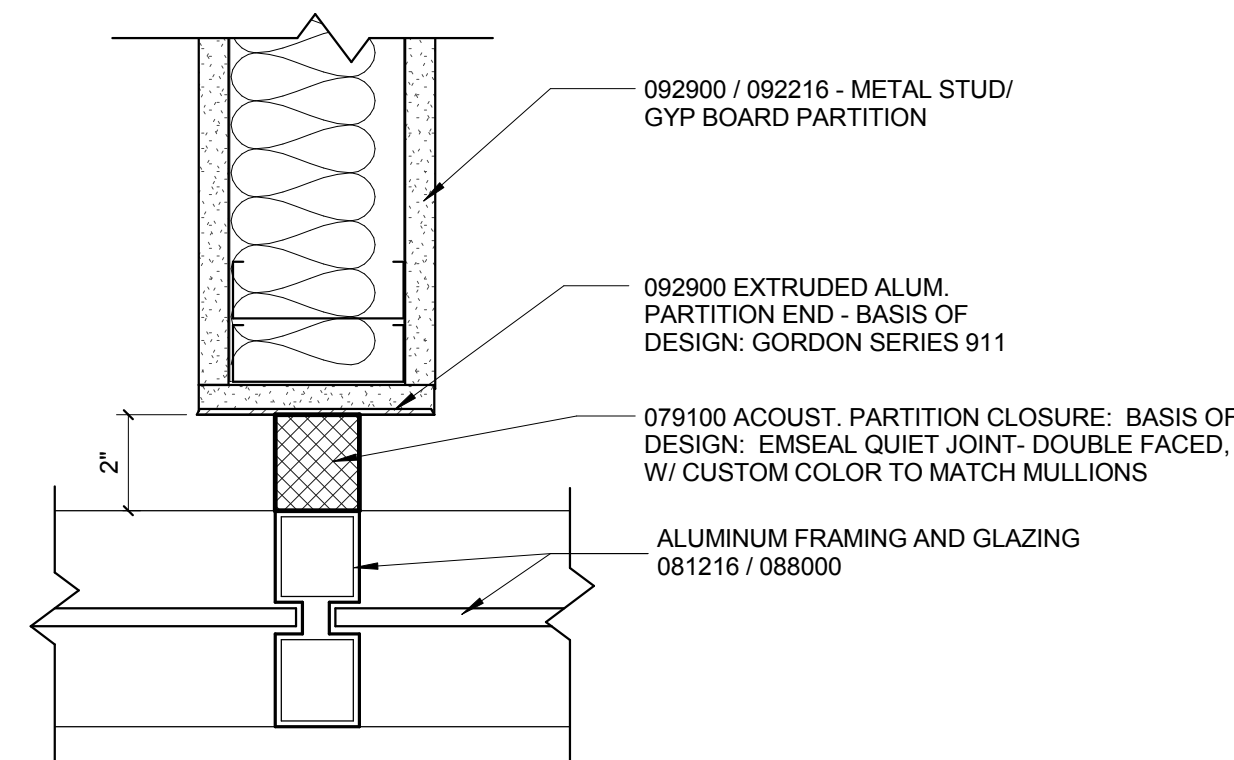


7 PLAN DETAIL - TYPICAL CLOSURE AT GLAZING  
3" = 1'-0"

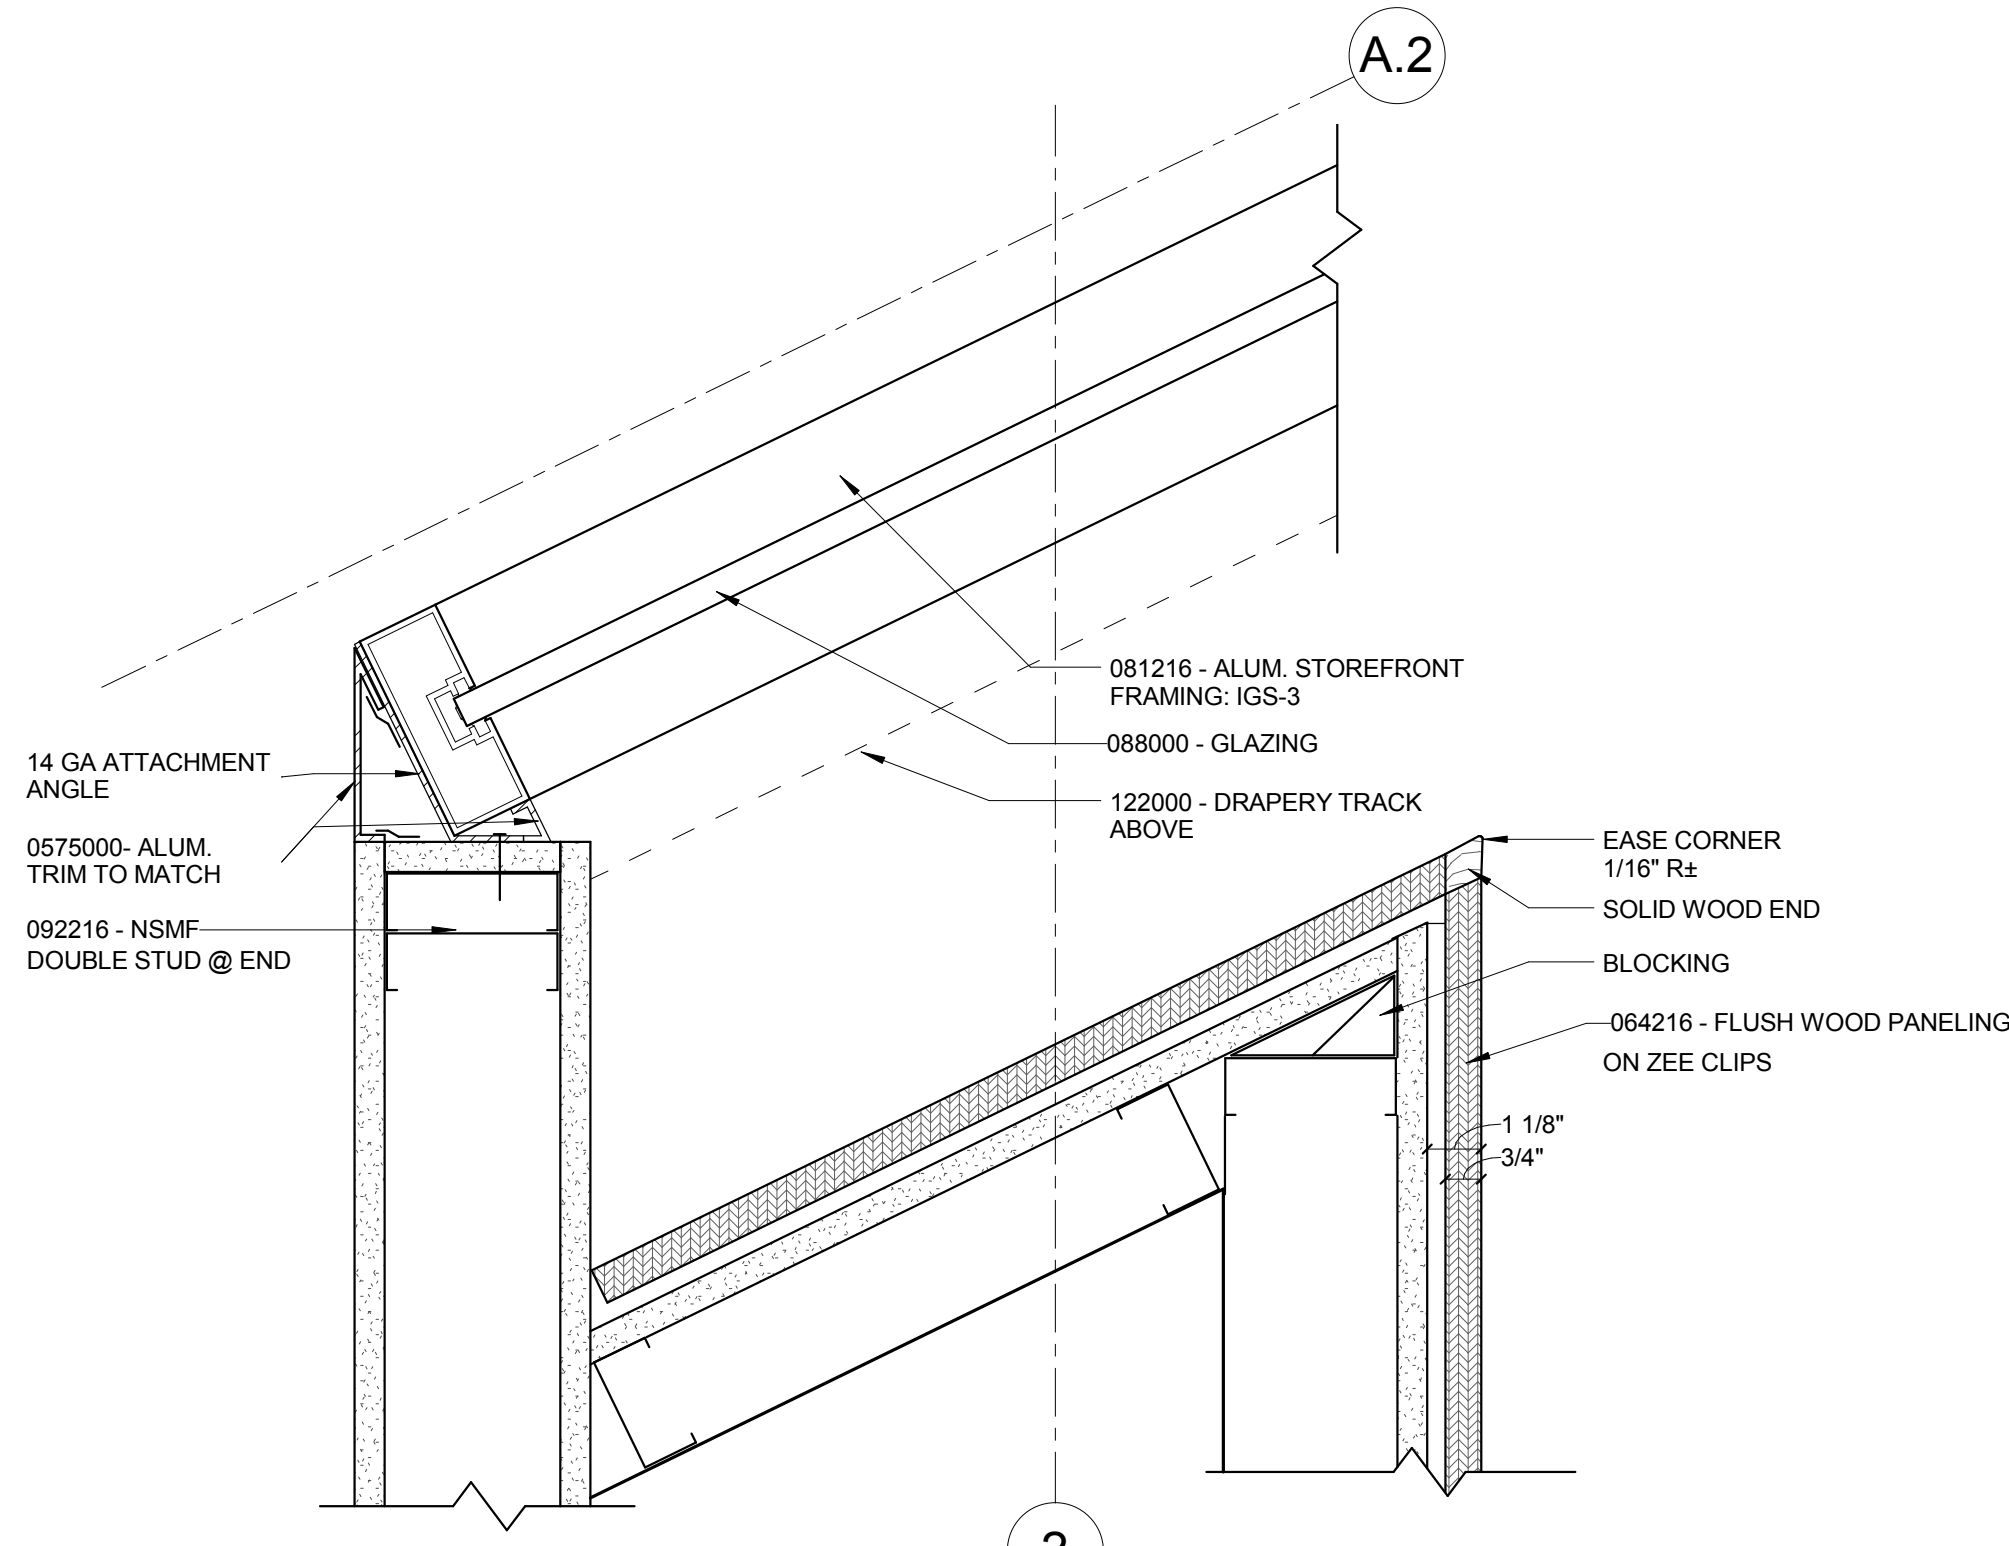

6 PLAN DETAIL AT CONF. ROOM  
3" = 1'-0"

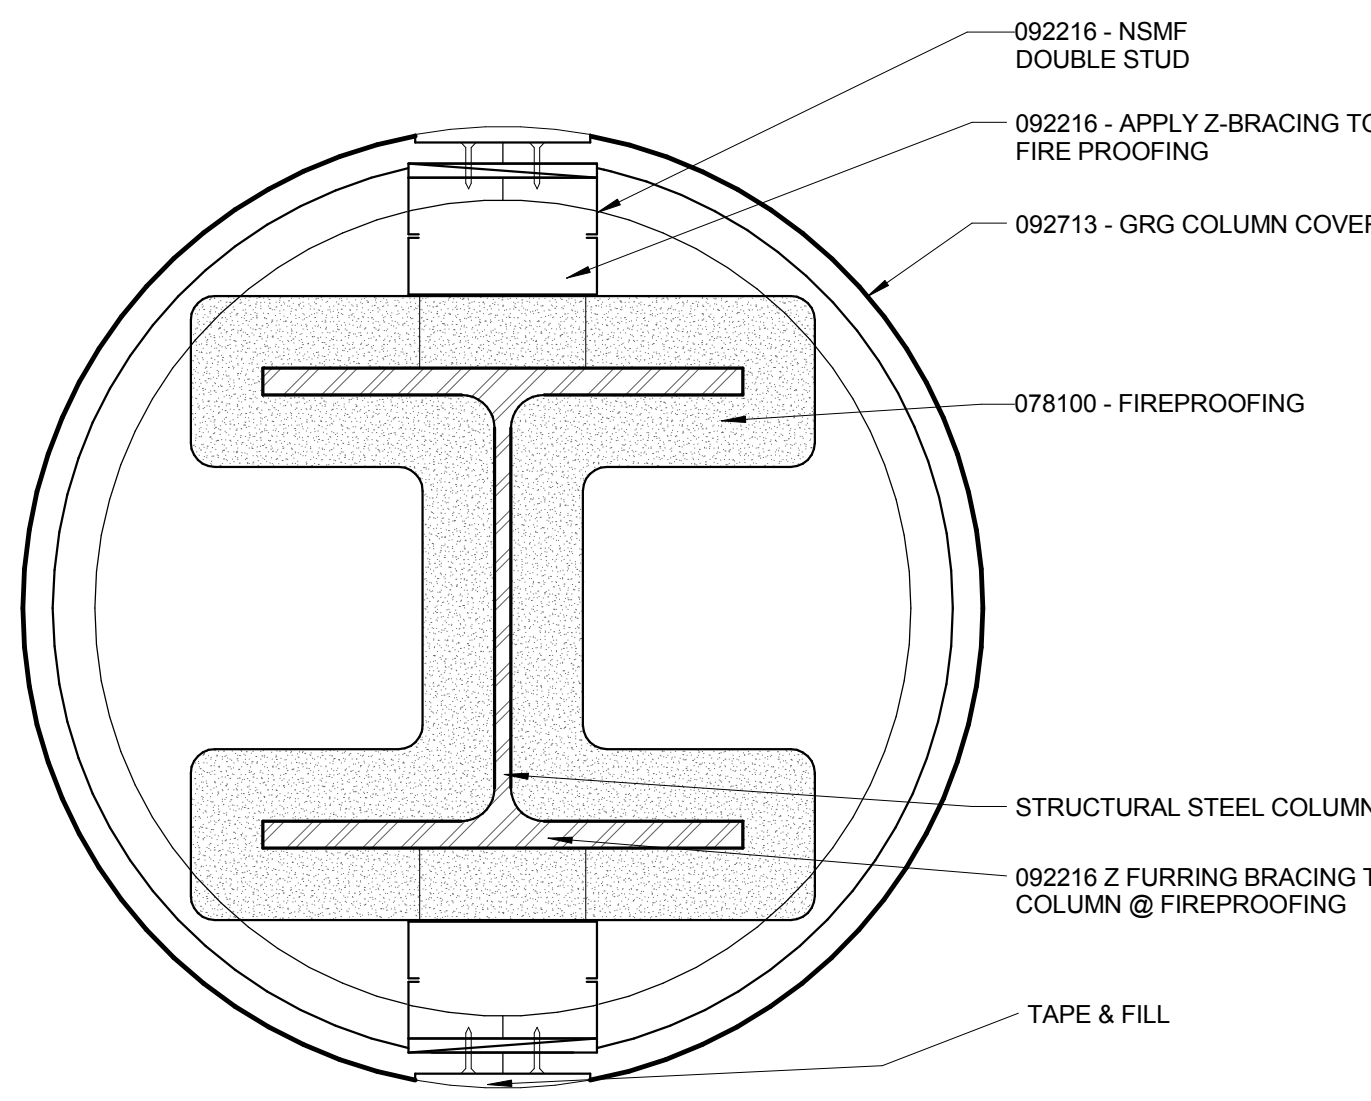


4 TYP. COLUMN  
3" = 1'-0"

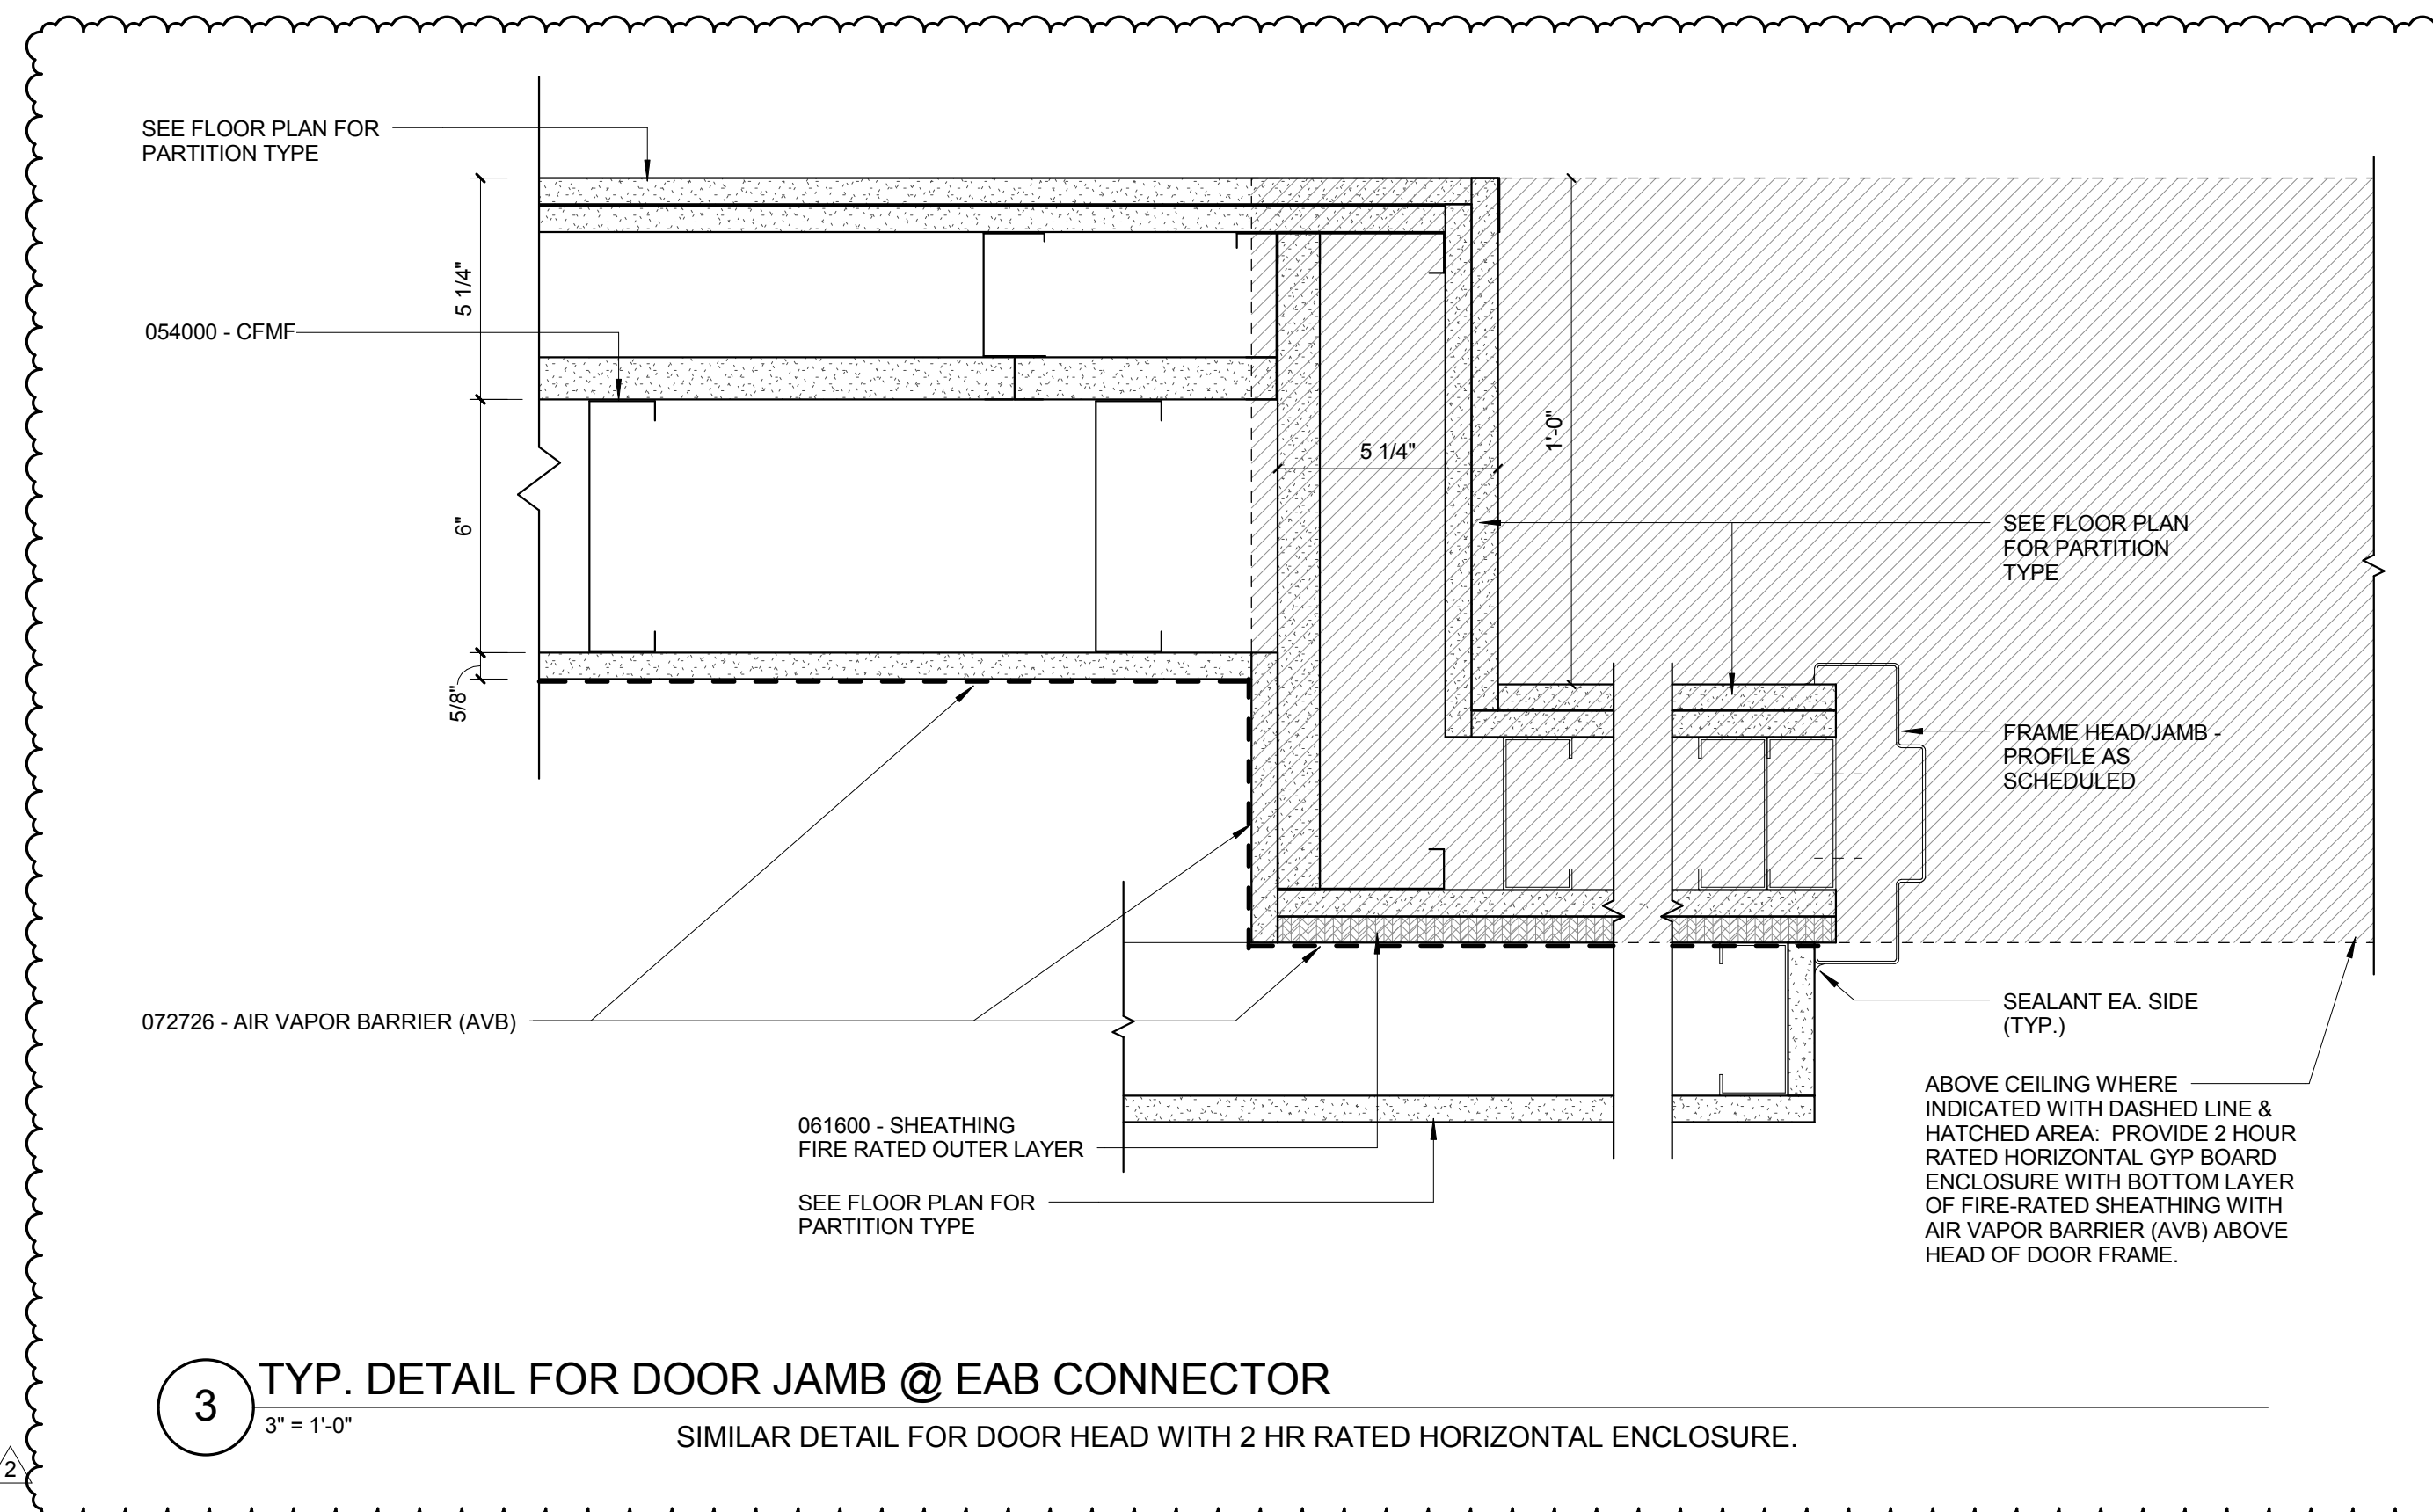

3 TYP. DETAIL FOR DOOR JAMB @ EAB CONNECTOR  
3" = 1'-0"

SIMILAR DETAIL FOR DOOR HEAD WITH 2 HR RATED HORIZONTAL ENCLOSURE.

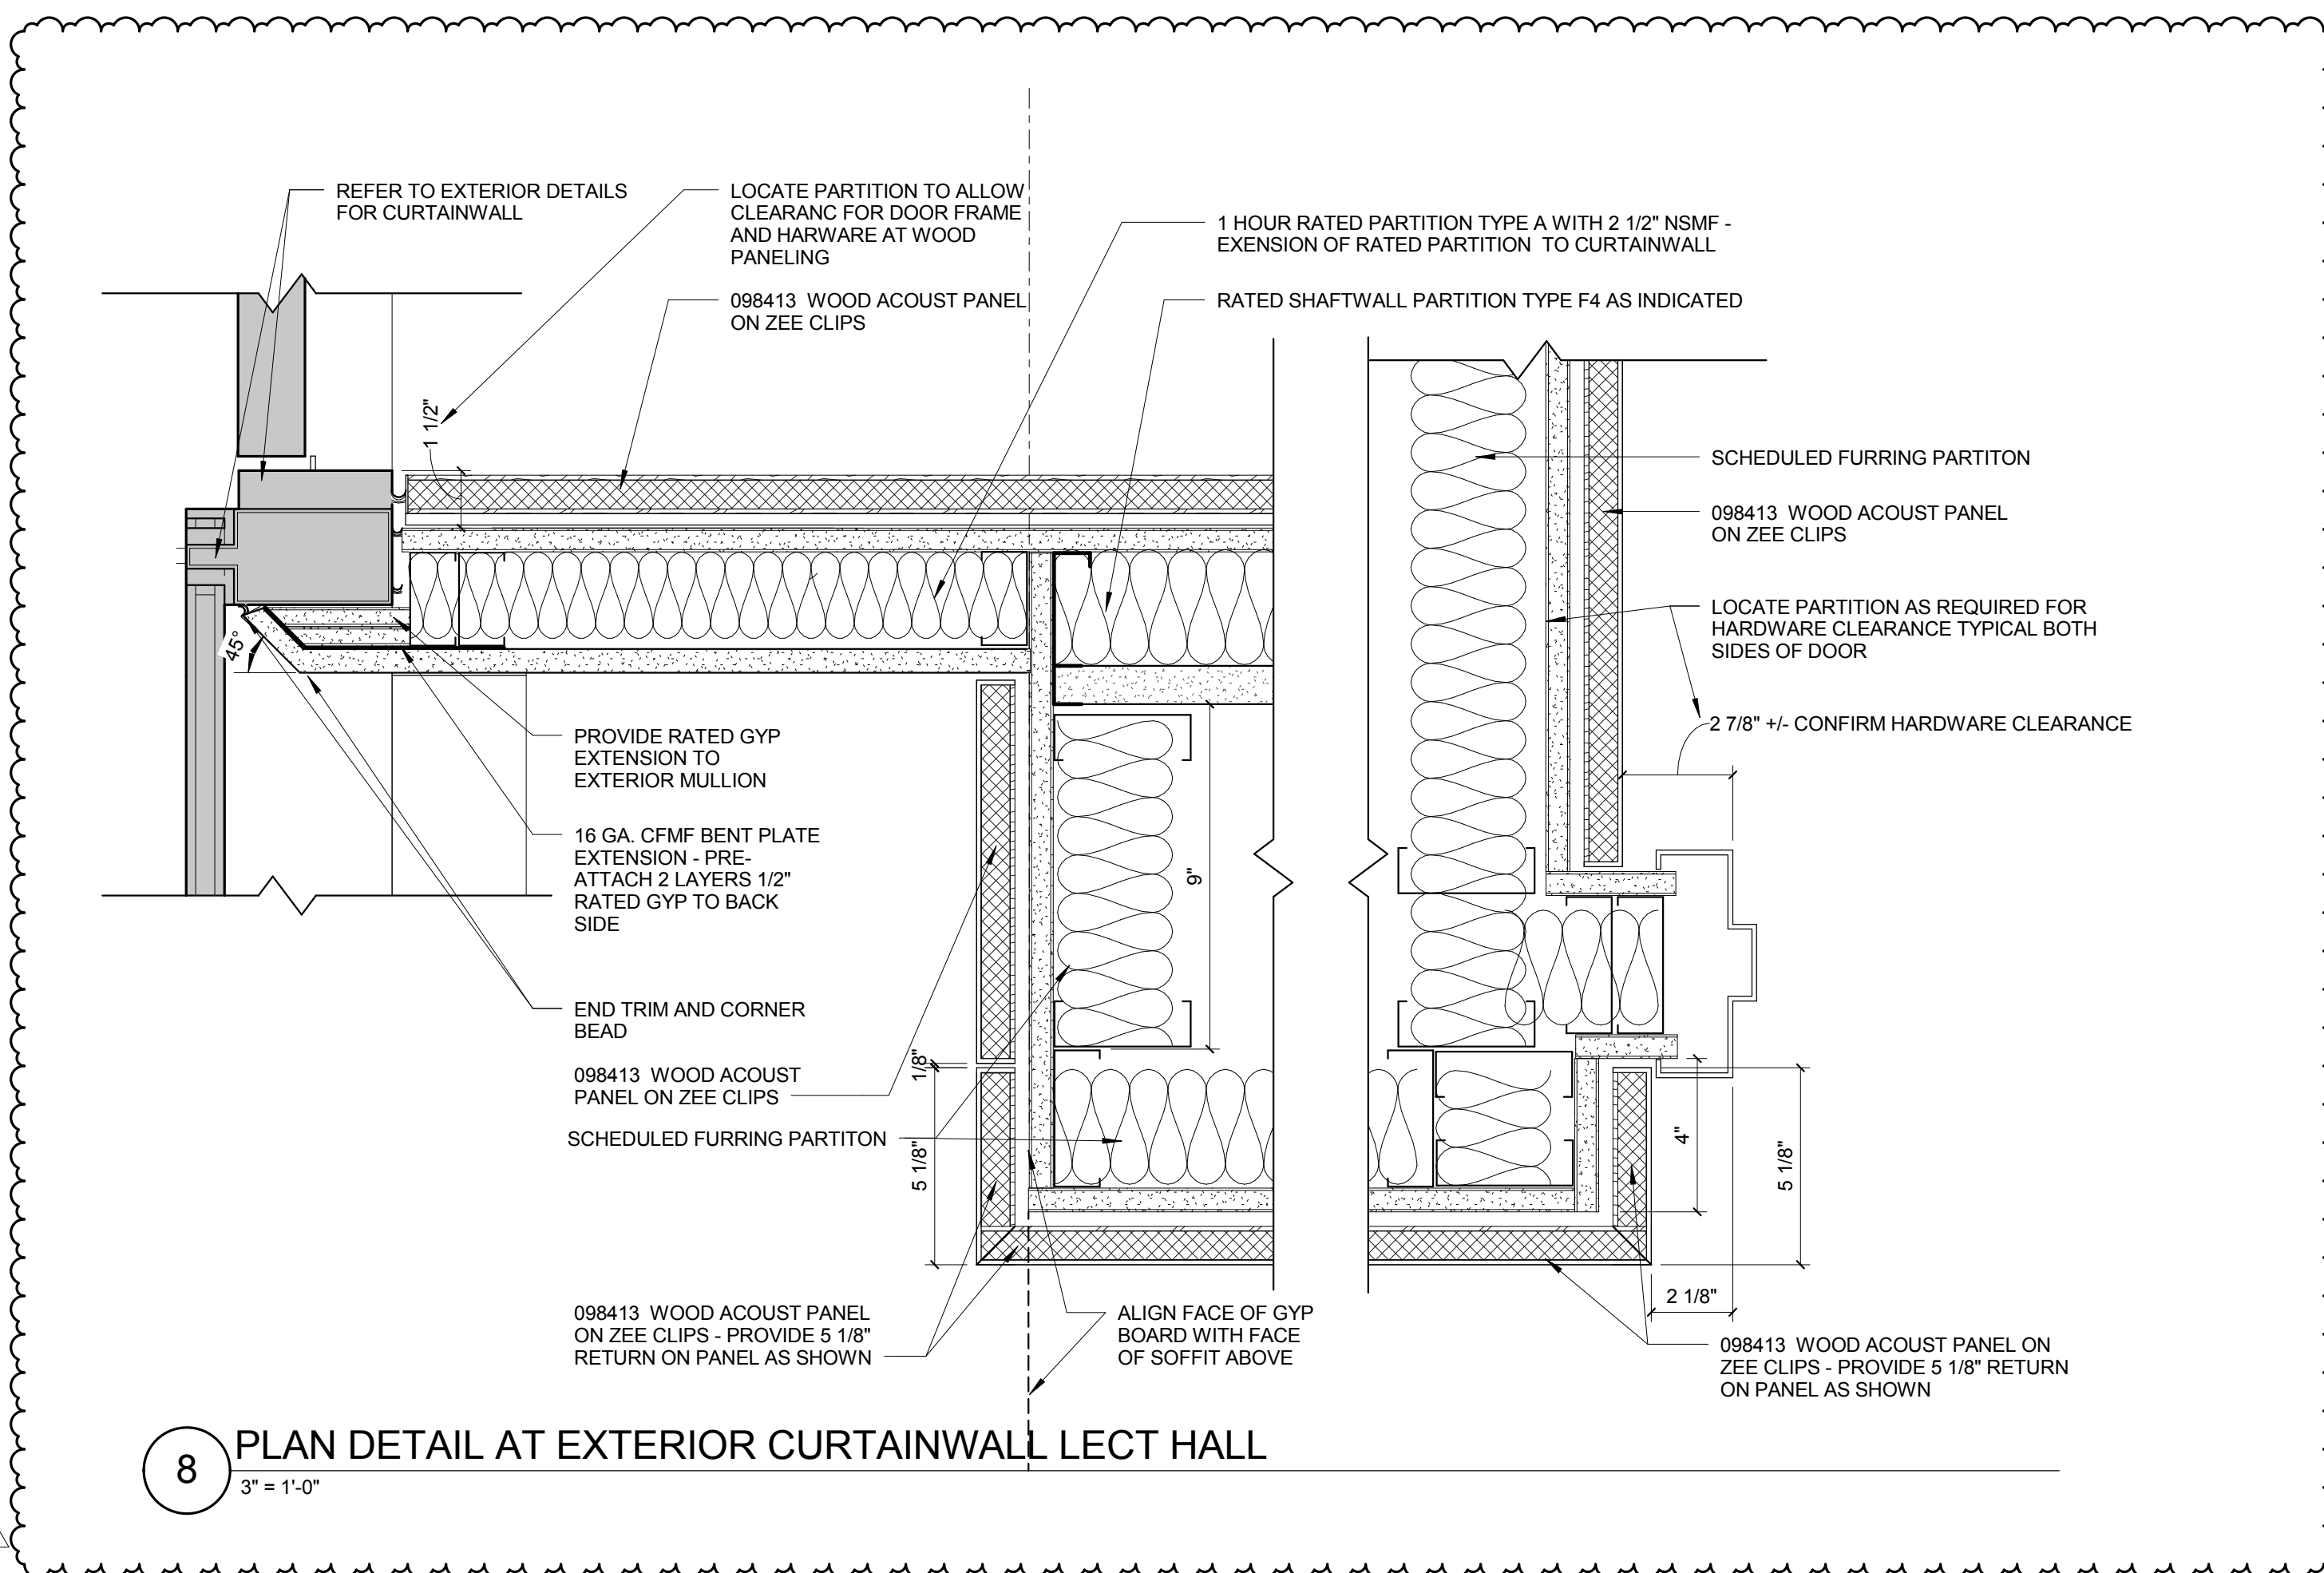

8 PLAN DETAIL AT EXTERIOR CURTAINWALL LECT HALL  
3" = 1'-0"