

Architect's Supplemental Instructions

Architect's Project No:
04561.01

Architect's ASI No: 061

Project:
Webster University
Interdisciplinary Science
Building

Date Issued: 04/11/2017

Contract Date:

Reason Code: 05 A/E Scope

Discipline Code: 11 (Plumbing)

Owner:
Webster University

Architect:
Cannon Design
1100 Clark Avenue
St. Louis, MO 63102

Contractor:
Paric Construction

Contract For: General construction

The Work shall be carried out in accordance with the following supplemental instructions issued in accordance with the Contract Documents without change in Contract Sum or Contract Time. Indicate your acceptance of these instructions for minor change to the Work as consistent with the Contract Documents and return a copy to the Architect within fourteen (14) business days of the date of issuance of these instructions. If you feel a change in Contract Sum or Contract Time is warranted, please submit an itemized quotation for the changes for approval within fourteen (14) business days of the date of issuance of these instructions prior to proceeding on the Work. Proceeding with the Work in accordance with these instructions indicates your acknowledgement that there will be no change.

Attachments:

Drawings:
P0402 – Risers – Plumbing

<End of Drawing List>

St. Louis
Baltimore
Boston
Buffalo
Calgary
Chicago
Houston
Los Angeles
Mumbai
New York
Phoenix
San Francisco
Shanghai
Toronto
Vancouver
Victoria
Washington DC

Architect's Supplemental Instructions

Page 2



Description: ASI – 061 (RFI-509)

ASI-061 is being issued for the purpose of replacing the water supply valve in DW-1 that serves the under-counter dishwasher in Teaching Kitchen 174. The new valve to provide ½" inlet and ¾" hose end connection outlet. Valve shall be Guy Grey model 88400 or approved equal.

Please submit an itemized proposal for changes in contract Sum and Contract Time for proposed modifications to the Contract Documents described herein:

Issued by Architect: **Michael R. Whitworth**
Webb engineering Services, Inc.

Accepted by Contractor:

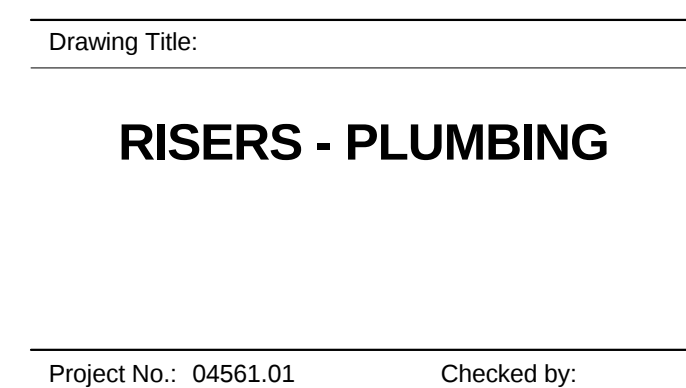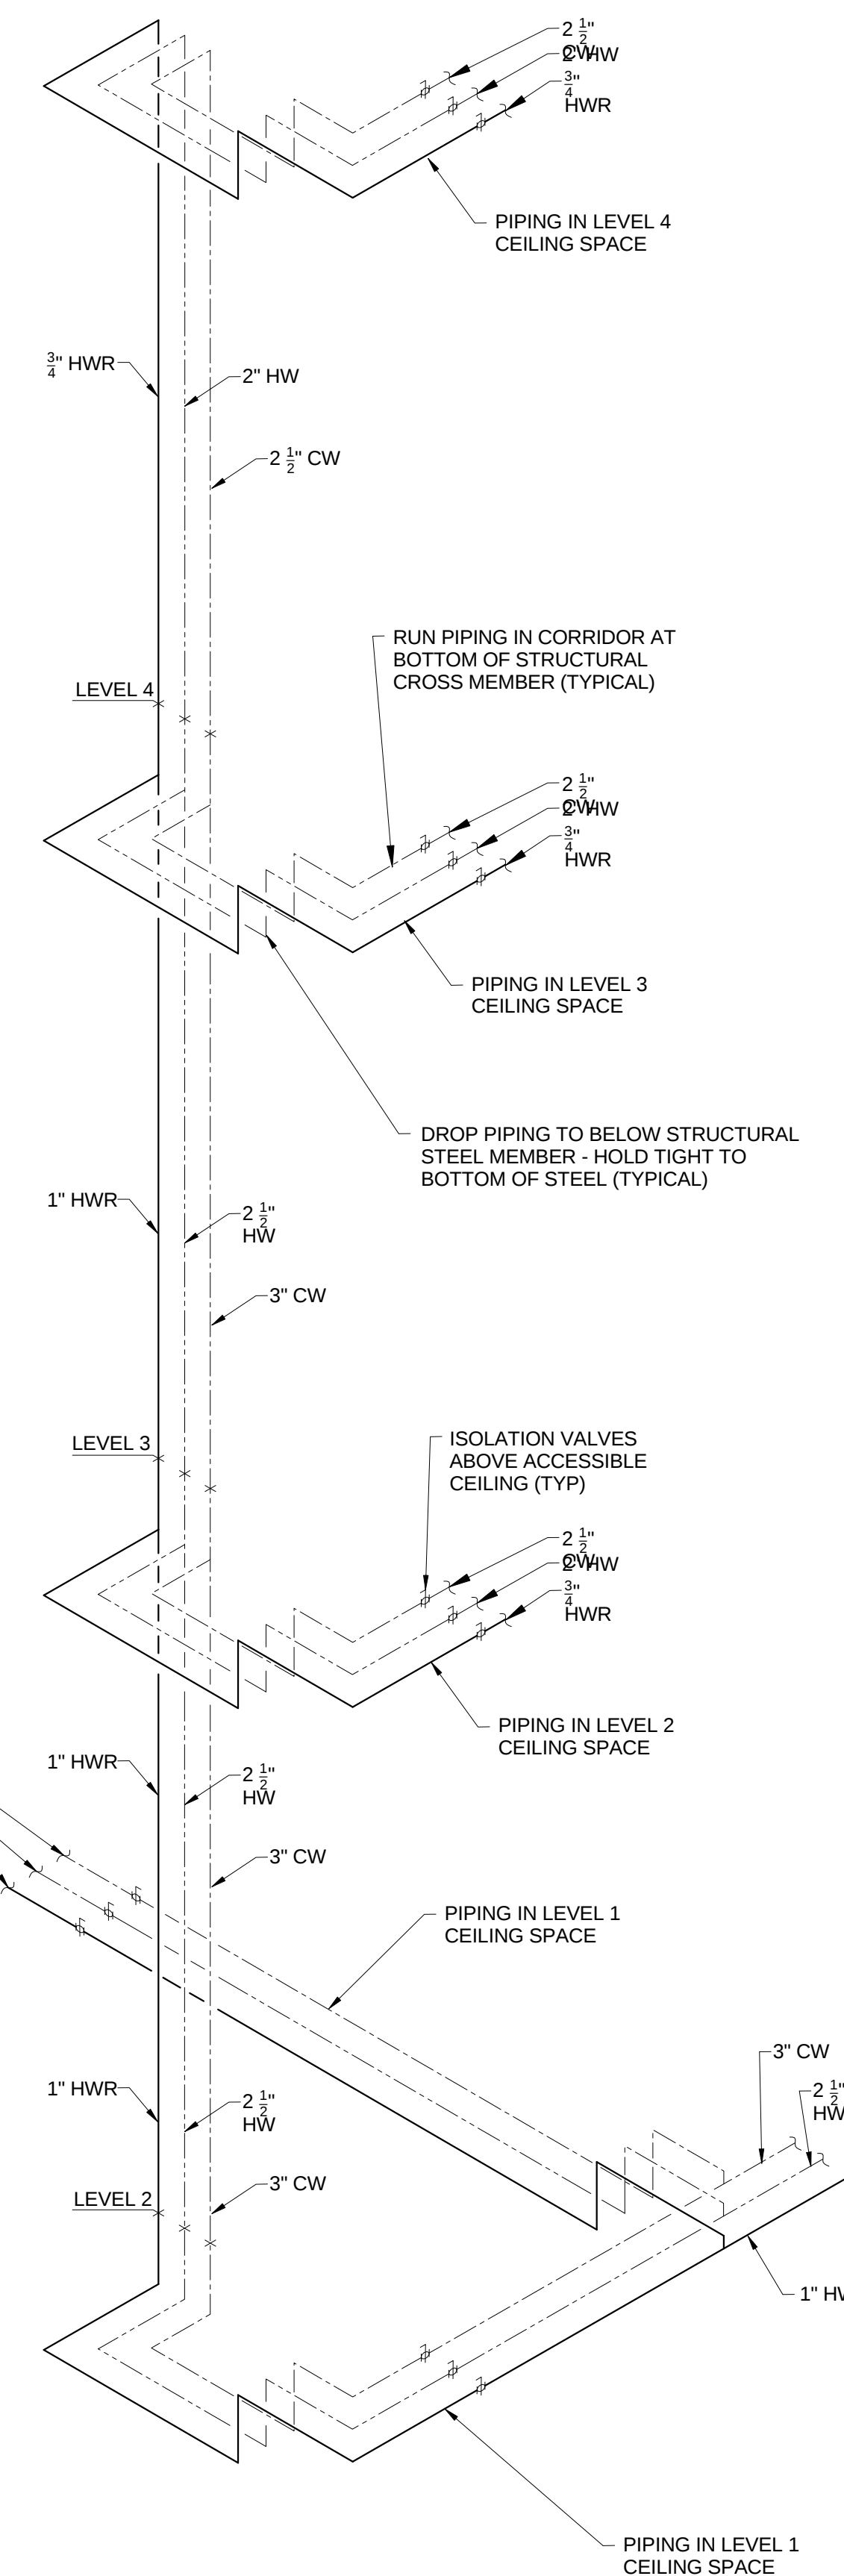

5	ASI - 061 (RFI - 502)	11 APR 2017
4	ASI - 033 (RFI 261,286,309 & 310)	03 NOV 2016
3	ADDENDUM 2-4	24 MAY 2016
2	ADDENDUM 2-2	19 APR 2016
1	ADDENDUM 2-1	17 MAR 2016
-	ISSUED FOR CONSTRUCTION (BP2)	01 MAR 2016
No.	Description	Date