

Architect's Supplemental Instructions

Architect's Project No:
04561.01

Architect's ASI No: 064

Project:
Webster University
Interdisciplinary Science
Building

Date Issued: 04/26/17

Contract Date:

Reason Code: 05 A/E scope

Discipline Code: 07 General Construction
(Architectural)

Owner:
Webster University

Architect:
Cannon Design
1100 Clark Avenue
St. Louis, MO 63102

Contractor:
Paric Construction

Contract For: General Construction

The Work shall be carried out in accordance with the following supplemental instructions issued in accordance with the Contract Documents without change in Contract Sum or Contract Time. Indicate your acceptance of these instructions for minor change to the Work as consistent with the Contract Documents and return a copy to the Architect within fourteen (14) business days of the date of issuance of these instructions. If you feel a change in Contract Sum or Contract Time is warranted, please submit an itemized quotation for the changes for approval within fourteen (14) business days of the date of issuance of these instructions prior to proceeding on the Work. Proceeding with the Work in accordance with these instructions indicates your acknowledgement that there will be no change.

Attachments:

Drawings:

ID0101, ID0102, ID0103, ID0104, ID0201, ID0202.

Architect's Supplemental Instructions

Page 2

Description:

Please submit an itemized proposal for changes in contract Sum and Contract Time for proposed modifications to the Contract Documents described herein:

- Keyed note 12 was deleted from every private offices, eliminating dry erase paint from the offices.
- Keyed note 6 was removed from the labs which will receive walltalker product per Architectural elevations in lieu of dry erase paint.
- Dry erase paint was added in Conference 154.
- Dry erase paint was added in Commons 303.
- Dry erase paint was eliminated from Commons C450A.
- Dry erase paint was eliminated in the corridor outside the General Chem Lab 472; per new keyed note 12, this wall will receive cork wall treatment only.

Issued by Architect: Kelvin Patel, CannonDesign;
Amanda Renshaw, Spellman Brady & Assoc.

Accepted by Contractor:

INTERIORS SYMBOLS LEGEND
1/8" = 1'-0"

- 1 WVP-2 OPAQUE, WHITE (LAQUER FINISH) PANELS TO BE LOCATED FLOOR TO CEILING AT DESIGNATED LOCATIONS. SEE ELEVATIONS AND ENVIRONMENTAL GRAPHICS DRAWINGS FOR LAYOUT AND GRAPHIC INLAY.
- 2 WVP-1 TO BE USED ON FACES OF WALLS AND SOFFITS AT DESIGNATED LAB ENTRANCE RECESSES.
- 3 OPAQUE FINISH WOOD PERFORATED PANELS FOR ACOUSTICS WITH 1 1/2" FIBERGLASS ACOUSTICS WHITE BATTS BEHIND. TO BE PAINTED SCHEDULED WALL COLOR.
- 4 AP-1 FABRIC WRAPPED ACOUSTIC PANELS - FULL HEIGHT.
- 5 VERTICAL WOOD GRILLE SCREEN - REFER TO INTERIOR ELEVATIONS.
- 6 AWC-1 MARKER BOARD PAINT TO BE USED FULL HEIGHT.
- 7 CWC-1 CORK WALLCOVERING TO BE APPLIED 3'0" AFF TO CEILING.
- 8 EXTENTS OF WALL TILE. SEE SHEET ID0202 FOR FLOOR AND WALL PATTERN.
- 9 EXTENTS OF FAP-1 PANELS TO BE MOUNTED ABOVE WALL BASE.
- 10 WALL TO HAVE 3/16" SOUND COUSTIC PADS. PADS TO BE PAINTED SCHEDULED WALL COLOR.
- 11 COMBINATION AWC-1 MARKER BOARD PAINT AND CWC-1 CORK WALLCOVERING WALL TREATMENT. CWC-1 TO BE 4'0" WIDE SECTION ON NORTH SIDE OF WALL / REMAINDER OF WALL TO BE AWC-1. SEE ELEVATIONS ON ID0202 FOR TYPICAL.



© Cannon Design 2015


INTERIOR SYMBOLS LEGEND

- SHADDED AREAS ARE NOT INCLUDED IN SCOPE OF WORK FOR INTERIOR RENOVATION
- KEYED NOTE
- LVT-1 INSTALLATION DIRECTION. INSTALL PARALLEL WITH DIRECTION OF SYMBOL
- XX-# LOCATION OF FLOORING MATERIAL TRANSITION
- XX-# SPECIFIED FINISH, REFERENCE FINISH SCHEDULE IF NOT NOTED.

INTERIORS SYMBOLS LEGEND
1/8" = 1'-0"

PLAN KEY NOTES

- WVP-2 OPAQUE, WHITE (LAQUER FINISH) PANELS TO BE LOCATED FLOOR TO CEILING AT DESIGNATED LOCATIONS. SEE ELEVATIONS AND ENVIRONMENTAL GRAPHICS DRAWINGS FOR LAYOUT AND GRAPHIC INLAY.
- WVP-1 TO BE USED ON FACES OF WALLS AND SOFFITS AT DESIGNATED LAB ENTRANCE RECESSES.
- OPAQUE FINISH WOOD PERFORATED PANELS FOR ACOUSTICS WITH 1 1/2" FIBERGLASS ACOUSTICS WHITE BATTS BEHIND. TO BE PAINTED SCHEDULED WALL COLOR.
- AP-1 FABRIC WRAPPED ACOUSTIC PANELS - FULL HEIGHT.
- VERTICAL WOOD GRILLE SCREEN - REFER TO INTERIOR ELEVATIONS.
- AWC-1 MARKER BOARD PAINT TO BE USED FULL HEIGHT.
- CWC-1 CORK WALLCOVERING TO BE APPLIED 30" AFF TO CEILING.
- EXTENTS OF WALL TILE. SEE SHEET ID0202 FOR FLOOR AND WALL PATTERN.
- EXTENTS OF FAP-1 PANELS TO BE MOUNTED ABOVE WALL BASE.
- WALL TO HAVE 3/16" SOUND COUSTIC PADS. PADS TO BE PAINTED SCHEDULED WALL COLOR.
- COMBINATION AWC-1 MARKER BOARD PAINT AND CWC-1 CORK WALLCOVERING WALL TREATMENT. CWC-1 TO BE 40" WIDE SECTION ON NORTH SIDE OF WALL / REMAINDER OF WALL TO BE AWC-1. SEE ELEVATIONS ON ID0202 FOR TYPICAL.

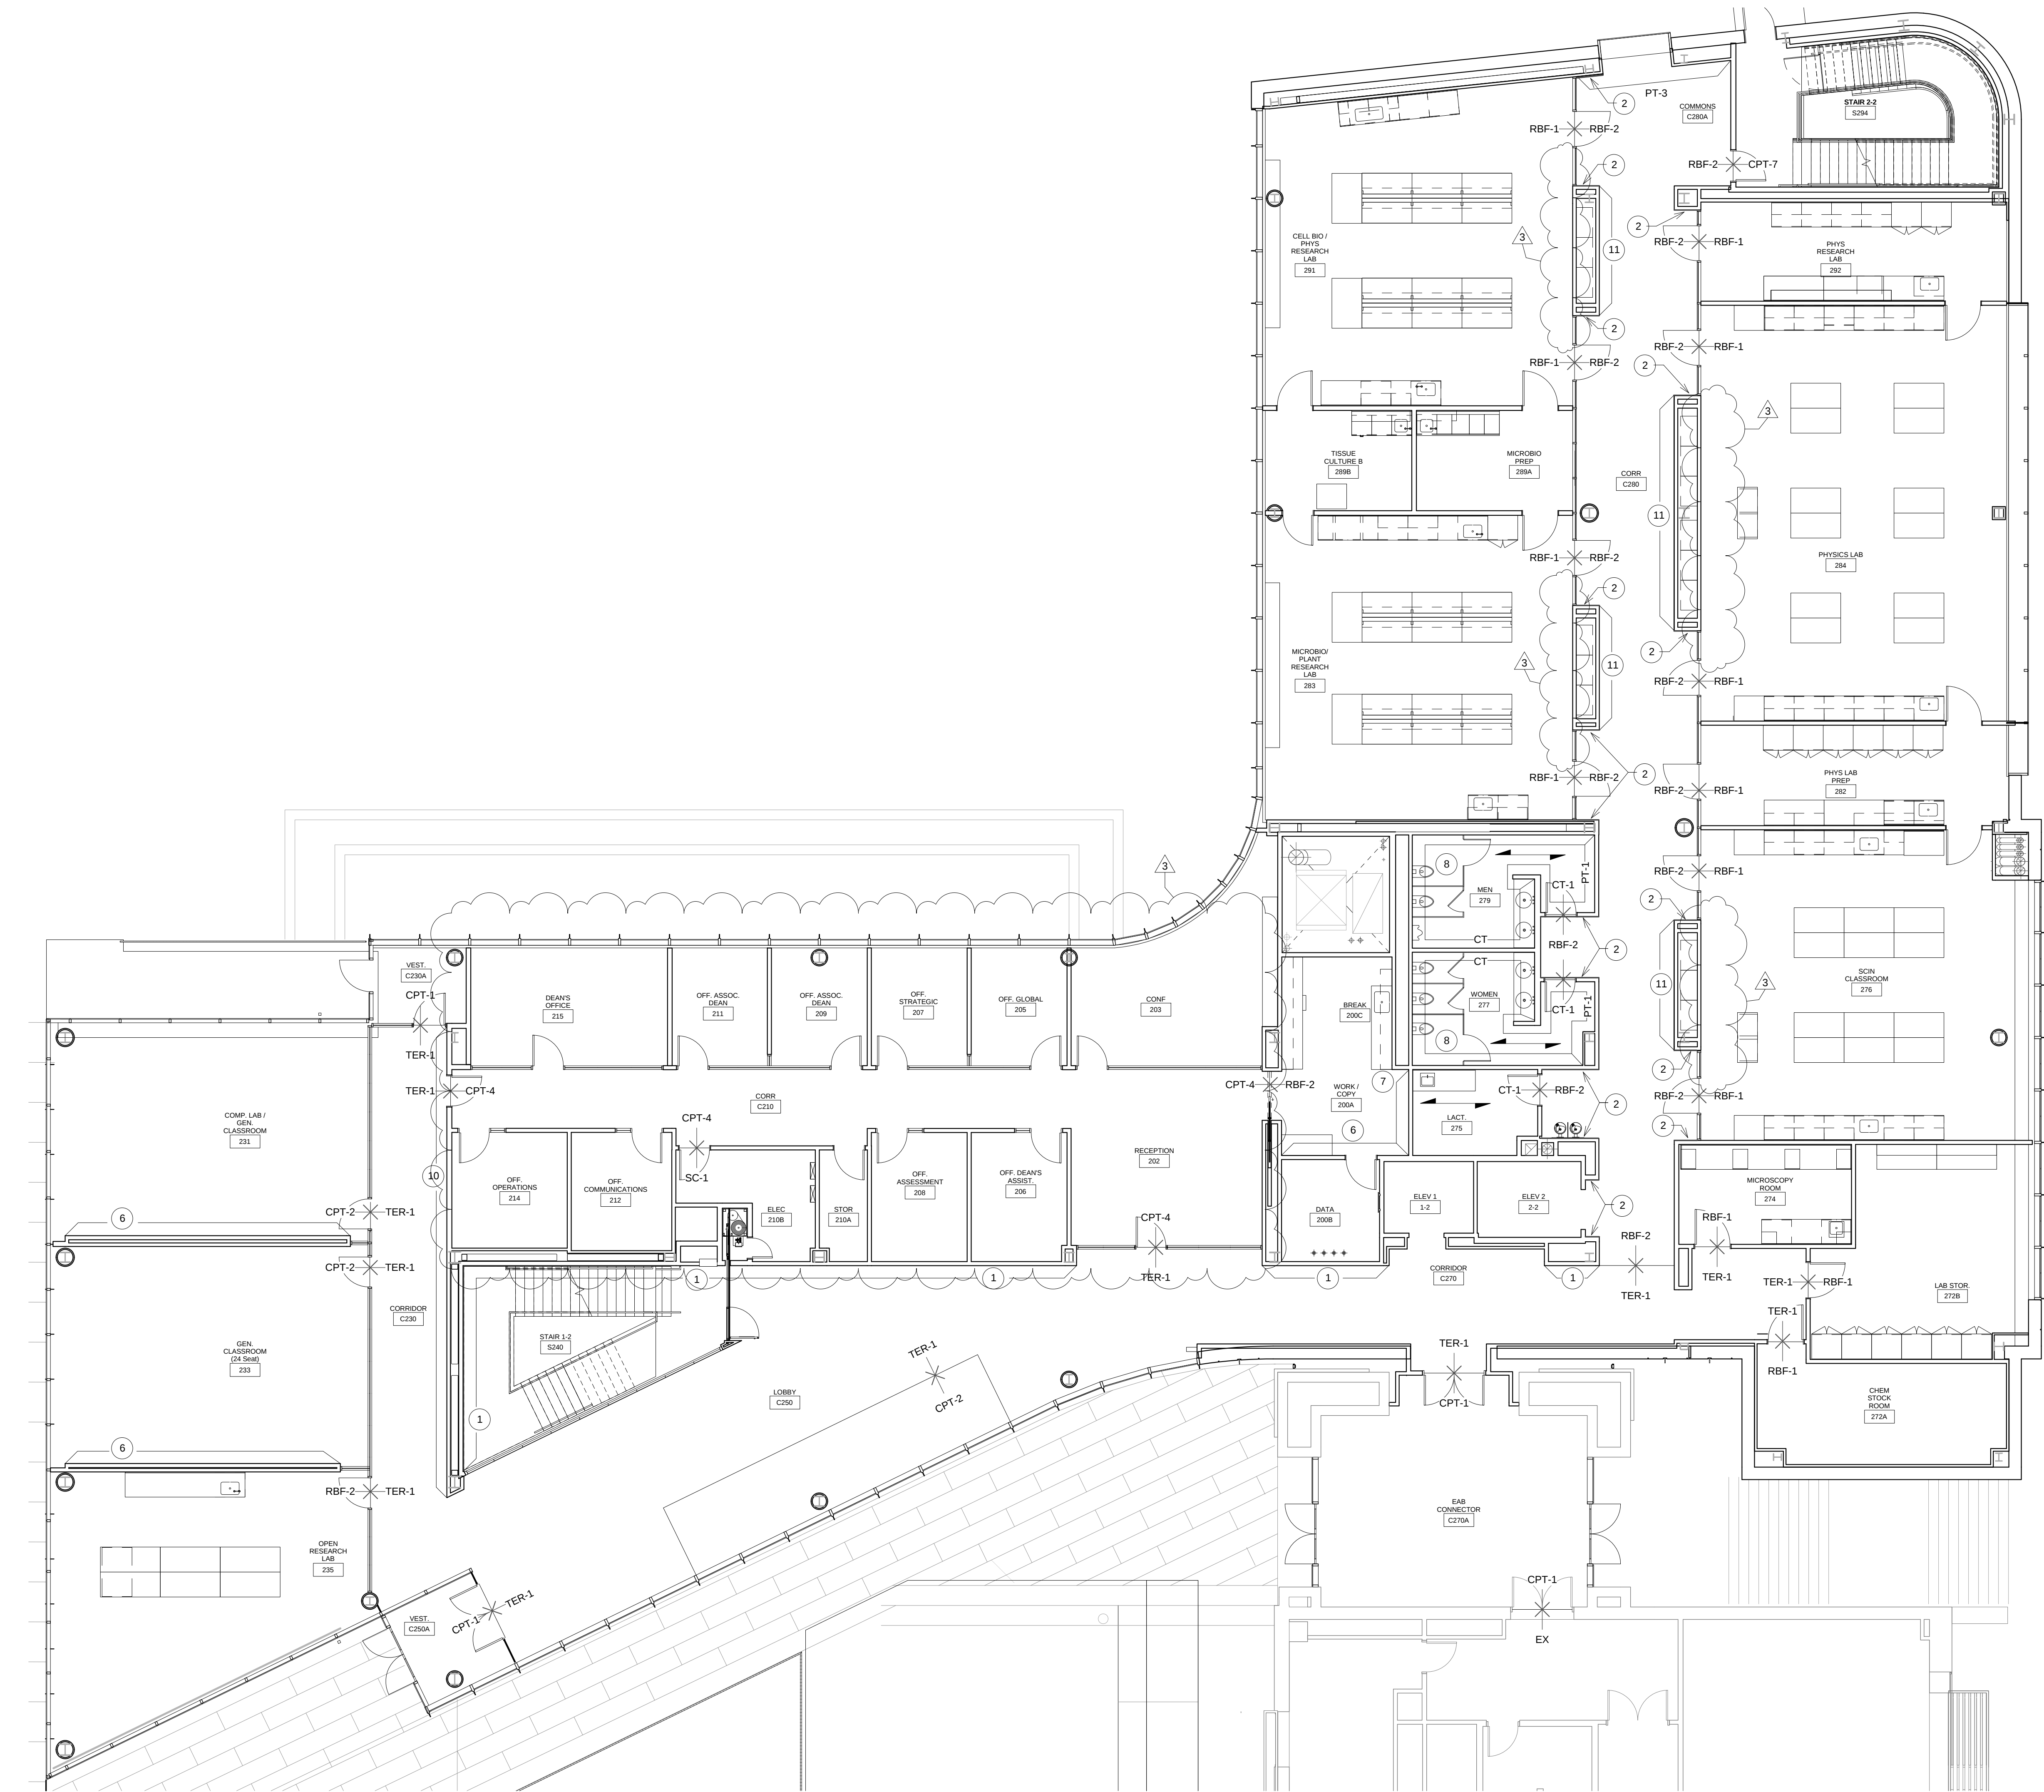

1 SECOND FLOOR TRANSITION PLAN
1/8" = 1'-0"

William Tao & Associates, Inc.
MEP/FP Engineer
7955 Manchester Road, Suite 125
St. Louis, MO 63143
314-884-7600

David Mason & Associates, Inc.
Structural & Civil Engineer
800 South Vandeventer Avenue
St. Louis, MO 63110
314-534-1053

Faith Group
Technology
3101 S. Hanley Rd. Suite 100
St. Louis, MO 63143
314-991-2229

Kuhmann Leavitt, Inc.
Environmental Graphics & Signage
7400 Pershing Ave
St. Louis, MO 63130
314-725-6616

KWA Architects
Architecture
9721 Litzinger Road
St. Louis, MO 63124
314-962-2560

Spellman Brady & Company
Interior Designer
8251 Maryland Avenue, Suite 300
St. Louis, MO 63105
314.862.0070

SWT Design
Landscape Architect
7722 Big Bend Blvd
St. Louis, MO 63119
314.644.5700

Webb Engineering Services, Inc.
Planning & Fire Protection
1400 S. 3rd Street, Suite 201
St. Louis, MO 63104
314.588.0600

3	ASI-064	26 APR 2017
2	ASI-015	25 JUL 2016
1	ADDENDUM 3-2	15 APR 2016
-	ISSUED FOR CONSTRUCTION (BP3)	15 MAR 2016
No.	Description	Date

Drawing Title:

SECOND FLOOR
TRANSITION PLAN

Project No.: 04561.01 Checked by:

ID0102

INTERIOR SYMBOLS LEGEND

- SHADED AREAS ARE NOT INCLUDED IN SCOPE OF WORK FOR INTERIOR RENOVATION
- KEYED NOTE
- LVT-1 INSTALLATION DIRECTION. INSTALL PARALLEL WITH DIRECTION OF SYMBOL
- XX-# LOCATION OF FLOORING MATERIAL TRANSITION
- XX-# SPECIFIED FINISH REFERENCE FINISH SCHEDULE IF NOT NOTED.

INTERIORS SYMBOLS LEGEND
1/8" = 1'-0"

PLAN KEY NOTES

- 1 WVP-2 OPAQUE, WHITE (LAQUER FINISH) PANELS TO BE LOCATED FLOOR TO CEILING AT DESIGNATED LOCATIONS. SEE ELEVATIONS AND ENVIRONMENTAL GRAPHICS DRAWINGS FOR LAYOUT AND GRAPHIC INLAY.
- 2 WVP-1 TO BE USED ON FACES OF WALLS AND SOFFITS AT DESIGNATED LAB ENTRANCE RECESSES.
- 3 OPAQUE FINISH WOOD PERFORATED PANELS FOR ACOUSTICS WITH 1 1/2" FIBERGLASS ACOUSTICS WHITE BATTS BEHIND. TO BE PAINTED SCHEDULED WALL COLOR.
- 4 AP-1 FABRIC WRAPPED ACOUSTIC PANELS - FULL HEIGHT.
- 5 VERTICAL WOOD GRILLE SCREEN - REFER TO INTERIOR ELEVATIONS.
- 6 AWC-1 MARKER BOARD PAINT TO BE USED FULL HEIGHT.
- 7 CWC-1 CORK WALLCOVERING TO BE APPLIED 30" AFF TO CEILING.
- 8 EXTENTS OF WALL TILE. SEE SHEET ID0202 FOR FLOOR AND WALL PATTERN.
- 9 EXTENTS OF FAP-1 PANELS TO BE MOUNTED ABOVE WALL BASE.
- 10 WALL TO HAVE 3/16" SOUND COUSTIC PADS. PADS TO BE PAINTED SCHEDULED WALL COLOR.
- 11 COMBINATION AWC-1 MARKER BOARD PAINT AND CWC-1 CORK WALLCOVERING WALL TREATMENT. CWC-1 TO BE 40" WIDE SECTION ON NORTH SIDE OF WALL / REMAINDER OF WALL TO BE AWC-1. SEE ELEVATIONS ON ID0202 FOR TYPICAL.



1 THIRD FLOOR TRANSITION PLAN
1/8" = 1'-0"

- William Tao & Associates, Inc.
MEP/FP Engineer
7955 Manchester Road, Suite 125
St. Louis, MO 63143
314-884-7600
- David Mason & Associates, Inc.
Structural & Civil Engineer
800 South Vandeventer Avenue
St. Louis, MO 63110
314-534-1053
- Faith Group
Technology
3101 S. Hanley Rd. Suite 100
St. Louis, MO 63143
314-991-2229
- Kuhmann Leavitt, Inc.
Environmental Graphics & Signage
7400 Pershing Ave.
St. Louis, MO 63130
314-725-6616
- KWA Architects
Architecture
9721 Litzinger Road
St. Louis, MO 63124
314-962-2560
- Spellman Brady & Company
Interior Designer
8251 Maryland Avenue, Suite 300
St. Louis, MO 63105
314-862-0070
- SWT Design
Landscape Architect
7722 Big Bend Blvd
St. Louis, MO 63119
314-644-5700
- Webb Engineering Services, Inc.
Planning & Fire Protection
1400 S. 3rd Street, Suite 201
St. Louis, MO 63104
314-588-0600

2	ASI-064	26 APR 2017
1	ADDENDUM 3-2	15 APR 2016
1	ISSUED FOR CONSTRUCTION (BP3)	15 MAR 2016
No.	Description	Date

Drawing Title:

THIRD FLOOR
TRANSITION PLAN

Project No.: 04561.01 Checked by:

ID0103

SHADED AREAS ARE NOT INCLUDED IN SCOPE OF WORK FOR INTERIOR RENOVATION

1 KEYED NOTE

LVT-1 INSTALLATION DIRECTION.
INSTALL PARALLEL WITH DIRECTION OF SYMBOL

XX-#


LOCATION OF FLOORING MATERIAL TRANSITION

XX-#

SPECIFIED FINISH, REFERENCE FINISH SCHEDULE IF NOT NOTED.

INTERIORS SYMBOLS LEGEND
1/8" = 1'-0"

- 1 WVP-2 OPAQUE, WHITE (LAQUER FINISH) PANELS TO BE LOCATED FLOOR TO CEILING AT DESIGNATED LOCATIONS. SEE ELEVATIONS AND ENVIRONMENTAL GRAPHICS DRAWINGS FOR LAYOUT AND GRAPHIC INLAY.
- 2 WVP-1 TO BE USED ON FACES OF WALLS AND SOFFITS AT DESIGNATED LAB ENTRANCE RECESSES.
- 3 OPAQUE FINISH WOOD PERFORATED PANELS FOR ACOUSTICS WITH 1 1/2" FIBERGLASS ACOUSTICS WHITE BATTS BEHIND. TO BE PAINTED SCHEDULED WALL COLOR.
- 4 AP-1 FABRIC WRAPPED ACOUSTIC PANELS - FULL HEIGHT.
- 5 VERTICAL WOOD GRILLE SCREEN - REFER TO INTERIOR ELEVATIONS.
- 6 AWC-1 MARKER BOARD PAINT TO BE USED FULL HEIGHT.
- 7 CWC-1 CORK WALLCOVERING TO BE APPLIED 30" AFF TO CEILING.
- 8 EXTENTS OF WALL TILE. SEE SHEET ID0202 FOR FLOOR AND WALL PATTERN.
- 9 EXTENTS OF FAP-1 PANELS TO BE MOUNTED ABOVE WALL BASE.
- 10 WALL TO HAVE 3/16" SOUND COUSTIC PADS. PADS TO BE PAINTED SCHEDULED WALL COLOR.
- 11 COMBINATION AWC-1 MARKER BOARD PAINT AND CWC-1 CORK WALLCOVERING WALL TREATMENT. CWC-1 TO BE 40" WIDE SECTION ON NORTH SIDE OF WALL / REMAINDER OF WALL TO BE AWC-1. SEE ELEVATIONS ON ID0202 FOR TYPICAL.
- 12 CWC-1 CORK WALLCOVERING WALL TREATMENT.

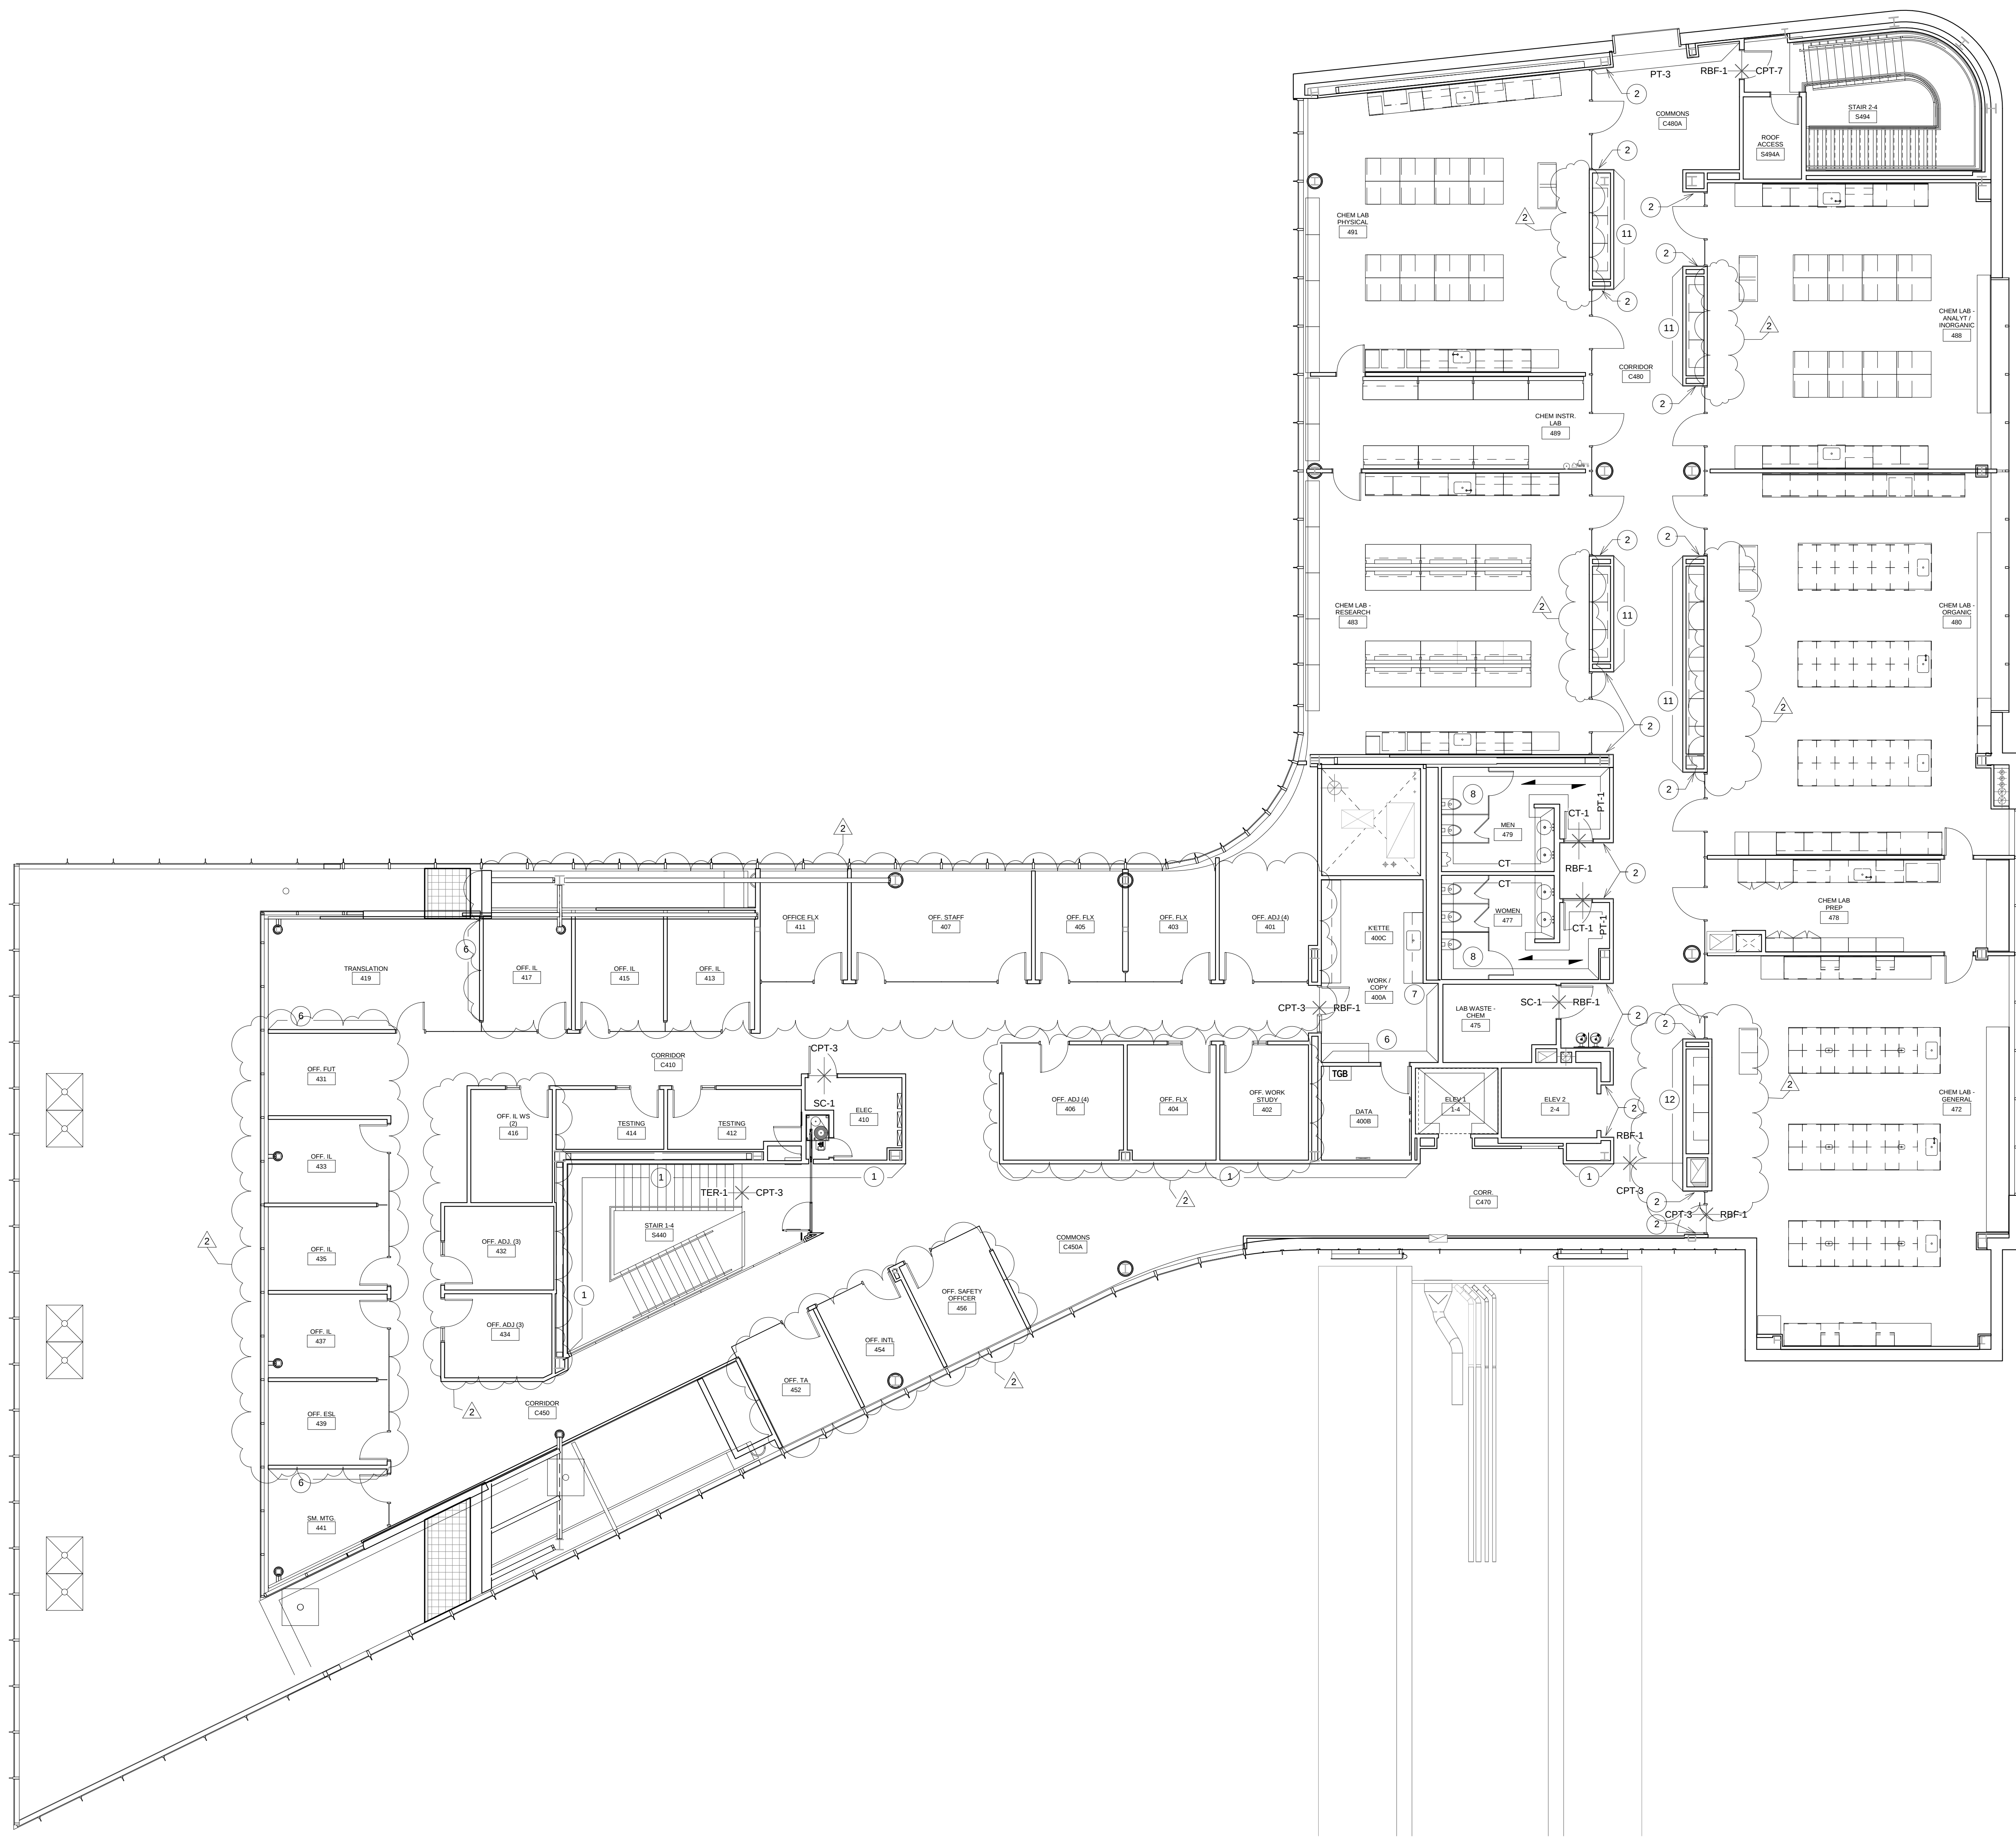

① FOURTH FLOOR TRANSITION PLAN
1/8" = 1'-0"



CANNONDESIGN

Webb Engineering Services, Inc.
Plumbing & Fire Protection
1400 S. 3rd Street, Suite 201
St. Louis, MO 63104
314.588.0600

2	ASI-064	26 APR 2017
1	ADDENDUM 3-2	15 APR 2016
-	ISSUED FOR CONSTRUCTION (BP3)	15 MAR 2016
No.	Description	Date

Checked by:

ID0104

© Cannon Design 2015

© Cannon Design 2015
All rights reserved. No part of this document may be reproduced or utilized in any form without prior written authorization by The Cannon Corporation.
4/26/2017 1:25:12 PM

FINISH SCHEDULE FLOORS 00-02															Floor
Number	Name	Floor Finish	Base Finish	North / Northwest Wall Finish	South / Southeast Wall Finish	East / Northeast Wall Finish	West / Southwest Wall Finish	Base Cabinet	Countertop	Upper Wall Cabinet	Millwork	Comments			
078	MECH. ROOM - CENTRAL	SC-1	RB-1	PT-4	PT-4	PT-4	PT-4						00		
5076	STAIR 3-0	SC-1	RB-1	PT-4	PT-4	PT-4	PT-4					4	00		
1-1	ELEV 1	TER-1	PREFINISHED	PLAM-1	PLAM-1	PLAM-1	PLAM-1					2	01		
2-1	ELEV 2	RBF-1	PREFINISHED	STAINLESS	STAINLESS	STAINLESS	STAINLESS					17	01		
100A	WORK / COPY	RBF-2	RB-2	PT-1	AWC-1 / PT-1	CWC-1 / PT-1	PT-1	PLAM-1	PL-1	PLAM-1		3	01		
100B	DATA	RBF-2	RB-1	PT-4	PT-4	PT-4	PT-4						01		
100C	K'ETTE	RBF-2	RB-2	PT-1	PT-1	CT-5 / PT-1	PT-1	PLAM-1	QTZ-1	PLAM-1		7,10	01		
101	OFF. STAFF (2)	CPT-3	RB-2	CWC-1 / PT-1	PT-1	PT-1	PT-1					9	01		
102	CORRIDOR	TER-1	TER-1	PT-1	PT-1	PT-1	PT-1						01		
104	OFF. FUT	CPT-3	RB-2	PT-1	PT-1	PT-1	PT-1						01		
105	OFF. NA	CPT-3	RB-2	PT-1	PT-1	PT-1	PT-1						01		
106	OFF. NA	CPT-3	RB-2	PT-1	PT-1	PT-1	PT-1						01		
107	OFF. NU	CPT-3	RB-2	PT-1	PT-1	PT-1	PT-1						01		
108	OFF. NU	CPT-3	RB-2	PT-1	PT-1	PT-1	PT-1						01		
109	OFF. NU	CPT-3	RB-2	PT-1	PT-1	PT-1	PT-1						01		
110A	STOR	CPT-3	RB-1	PT-1	PT-1	PT-1	PT-1						01		
110B	ELEC		RB-1	PT-4	PT-4	PT-4	PT-4						01		
111	OFF. NU	CPT-3	RB-2	PT-1	PT-1	PT-1	PT-1						01		
112	STORAGE	CPT-3	RB-1	PT-1	PT-1	PT-1	PT-1						01		
113	OFF. NU	CPT-3	RB-2	PT-1	PT-1	PT-1	PT-1						01		
114	MOCK EXAM	RBF-2	RB-1	PT-1	PT-1	PT-1	PT-1	PLAM-1	QTZ-2	PLAM-1			01		
115	OFF. NU	CPT-3	RB-2	PT-1	PT-1	PT-1	PT-1						01		
116	MOCK EXAM	RBF-2	RB-1	PT-1	PT-1	PT-1	PT-1	PLAM-1	QTZ-2	PLAM-1			01		
117	OFF. FUT	CPT-3	RB-2	PT-1	PT-1	PT-1	PT-1						01		
131	HEALTH ASSESSMENT LAB	RBF-2	RB-1	PT-1	PT-1	PT-1	PT-1	CSW-1	EP-1	CSW-1			01		
133A	CONTROL ROOM / TECH OFF / PREP LAB	RBF-2	RB-1	PT-1	PT-1	PT-1	PT-1	PLAM-1	PL-1	PLAM-1			01		
133B	SIM LAB	RBF-2	RB-1	PT-1	PT-1	PT-1	PT-1	CSW-1	EP-1	CSW-1			01		
135	DRY SKILLS LAB / COHORT CLASSROOM	RBF-2	RB-1	PT-1	PT-1	PT-1	PT-1	CSW-1	EP-1	CSW-1			01		
137	MODELS/ ASSESSMENT STORAGE/RESEARCH	RBF-2	RB-1	PT-1	PT-1	PT-1	PT-1	CSW-1	EP-1	CSW-1			01		
140	CONF. ROOM (24 SEATS)	CPT-4	WDB-1	PT-1	PT-1	PT-1	PT-1 / WVP-1	CSW-3	QTZ-1				01		
144	OFF. NU / NA. ADJ. (4+2=6)	CPT-3	RB-2	PT-1	PT-1	PT-1	PT-1						01		
150	EAB CONNECTOR	TER-1,2	TER-1 / WDB-2	PT-1	PT-1	PT-1	PT-1					22	01		
151	EAB STORAGE	RBF-1	RB-2	PT-4	PT-4	PT-4	PT-4						01		
152	VENDING	TER-1	TER-1	PT-1	PT-1	PT-1	PT-1						01		
154	CONF ROOM (10)	CPT-4	WDB-1	PT-1	PT-1	PT-1	PT-1	PLAM-1	QTZ-1				01		
156	SM MTG/ GREEN RM	CPT-4	WDB-1	PT-1	PT-1	PT-1	PT-1						01		
158	COAT	TER-1	TER-1	PT-1	PT-1	PT-1	PT-1						01		
160	LECTURE HALL	CPT-7 / WDF-1	WDB-1	PT-1 / ACOUSTIC PANELS	PT-1	AP-1 / PT-1	PT-1					8,19,20	01		
160A	CORR.	CPT-7	RB-1	PT-1	PT-1	PT-1	PT-1						01		
160B	CONTROL	CPT-7	RB-1	FAP-1 / PT-6	PT-6	FAP-1 / PT-6	FAP-1 / PT-6						01		
160C	LECT. ENTRY	CPT-7	WDB-1	PT-1	PT-1	PT-1	PT-1					8	01		
160D	AV EQUIP	SC-1	PT-4	PT-4	PT-4	PT-4	PT-4						01		
172	LOADING DOCK	SC-1	RB-1	PT-4	PT-4	PT-4	PT-4						01		
172A	RECYCLING	SC-1	RB-1	FRP-1	FRP-1	FRP-1	FRP-1	PLAM-1	QTZ-1	PLAM-1		11	01		
174	TEACHING KITCHEN	SV-1	RB-2	CT-5 / PT-1	PT-1	AWC-1 / PT-1	PT-1					7,10	01		
175	JC	SC-1	RB-1	FRP-1	FRP-1	FRP-1	FRP-1					11	01		
176	ELEV. CONTROL	SC-1	RB-1	PT-4	PT-4	PT-4	PT-4						01		
177	WOMEN	CT-1,2	CT-1,3,4 / MT-1	CT-1 / PT-1	CT-1	CT-1,4 / PT-1	CT-1,4	PLAM-1	QTZ-1			14,16	01		
178	MECHANICAL ROOM	SC-1	RB-1	PT-4	PT-4	PT-4	PT-4						01		
179	MEN	CT-1,2	CT-1,3,4 / MT-1	CT-1	CT-1 / PT-1	CT-1,4 / PT-1	CT-1,4	PLAM-1	QTZ-1			14,16	01		
180	TOILET	CT-1	CT-1,3 / MT-1	CT-1,4	PT-1	PT-1	PT-1					12	01		
182	TOILET	CT-1	CT-1,3 / MT-1	PT-1	CT-1,4	PT-1	PT-1					12	01		
183A	ENTRY CORRIDOR	RBF-2	RB-2	PT-1	AWC-1 / CWC-1 / PT-1	PT-1	PT-1					18	01		
183B	CADAVER LAB WORKROOM	ERF-1	ERF-1	PT-4	PT-4	PT-4	PT-4	CSW-2	SS-1	CSW-2		21	01		
183C	BIO VESTIBULE	ERF-1	ERF-1	PT-1	PT-1	PT-1	PT-1	CSW-2	SS-1	CSW-2			01		
184	BLDG. STOR.	SC-1	RB-1	PT-4	PT-4	PT-4	PT-4						01		
185	SPILL CLOSET	SC-1	RB-1	PT-4	PT-4	PT-4	PT-4						01		
186	CUST. STOR.	SC-1	RB-1	FRP-1	FRP-1	FRP-1	FRP-1					11	01		
187	CYLINDER ROOM	SC-1	RB-1	PT-4	PT-4	PT-4	PT-4						01		
188	FIRE PUMP	SC-1	RB-1	PT-4	PT-4	PT-4	PT-4						01		
191	CADAVER LAB	ERF-1	ERF-1	PT-4	PT-4	PT-4	PT-4	CSW-2	SS-1	CSW-2		21	01		
192	MAIN ELECTRICAL	SC-1	RB-1	PT-4	PT-4	PT-4	PT-4						01		
195	MDF / IT WORK ROOM	SC-1	RB-1	PT-4	PT-4	PT-4	PT-4						01		
C110	CORRIDOR	TER-1	TER-1	PT-1	PT-1	PT-1	PT-1						01		
C130	CORRIDOR	TER-1	TER-1	PT-1	PT-1	PT-1	PT-1						01		
C140	CORRIDOR	TER-1	TER-1	PT-1 / WVP-2	PT-1 / ACOUSTIC PANELS	PT-1 / ACOUSTIC PANELS	PT-1						01		
C150	LOBBY	TER-1	TER-1	PT-1	PT-1 / ACOUSTIC PANELS	PT-1 / ACOUSTIC PANELS	PT-1						01		
C151	COMMONS	CPT-5 / TER-1	TER-1	PT-1	PT-1	PT-1 / ACOUSTIC PANELS	PT-1					13	01		
C153	VEST.	CPT-1	WDB-1	PT-1	PT-1 / ACOUSTIC PANELS	PT-1 / ACOUSTIC PANELS	PT-1						01		
C170	CORRIDOR	TER-1	TER-1	PT-1 / WVP-2	PT-1	PT-1	PT-1						01		
C180	CORRIDOR	RBF-2 / TER-1	RB-2 / TER-1	PT-2	PT-1	PT-1	PT-1 / WVP-1						01		
S140	STAIR 1-1	TER-1	PREFINISHED	WVP-2	PT-1	PT-1	WVP-2					6,8	01		
S176	STAIR 3-1	SC-1	RB-1	PT-4	PT-4	PT-4	PT-4					4	01		
S194	STAIR 2-1	CPT-7	RB-1	PT-1	PT-1	PT-1	PT-1					5	01		
200A	WORK / COPY	RBF-2	RB-2	PT-1	AWC-1 / PT-1	CWC-1 / PT-1	PT-1	PLAM-1	PL-1	PLAM-1		3	02		
200B	DATA	RBF-2	RB-1	PT-4	PT-4	PT-4	PT-4						02		
200C	BREAK	RBF-2	RB-2	PT-1	PT-1	CT-5 / PT-1	PT-1	PLAM-1	QTZ-1	PLAM-1		7,10	02		
202	RECEPTION	CPT-4	WDB-1	PT-1	PT-1	PT-1	PT-1						02		
203	CONF	CPT-4	WDB-1	PT-1	PT-1	PT-1	PT-1	PLAM-1	QTZ-1				02		
205	OFF. GLOBAL	CPT-4	WDB-1	PT-1	PT-1	PT-1	PT-1						02		
206	OFF. DEAN'S ASSIST.	CPT-4	WDB-1	PT-1	PT-1	PT-1	PT-1						02		
207	OFF. STRATEGIC	CPT-4	WDB-1	PT-1	PT-1	PT-1	PT-1						02		
208	OFF. ASSESSMENT	CPT-4	WDB-1	PT-1	PT-1	PT-1	PT-1						02		
209	OFF. ASSOC. DEAN	CPT-4	WDB-1	PT-1	PT-1	PT-1	PT-1						02		
210A	STOR	CPT-4	RB-1	PT-1	PT-1	PT-1	PT-1						02		
210B	ELEC	SC-1	RB-1	PT-4	PT-4	PT-4	PT-4						02		
211	OFF. ASSOC. DEAN	CPT-4	WDB-1	PT-1	PT-1	PT-1	PT-1						02		
212	OFF. COMMUNICATIONS	CPT-4	WDB-1	PT-1	PT-1	PT-1	PT-1						02		
214	OFF. OPERATIONS	CPT-4	WDB-1	PT-1	PT-1	PT-1	PT-1						02		
215	DEAN'S OFFICE	CPT-4	WDB-1	PT-1	PT-1	PT-1	PT-1						02		
231	COMP. LAB / GEN. CLASSROOM	CPT-2	RB-1	PT-1	AWC-1 / PT-1	PT-1	PT-1						02		
233	GEN. CLASSROOM (24 Seat)	CPT-2	RB-1	PT-1	AWC-1 / PT-1	PT-1	PT-1						02		
235	OPEN RESEARCH LAB	RBF-2	RB-1	PT-1	PT-1	PT-1	PT-1	CSW-1	EP-1	CSW-1			02		
272A	CHEM. STOCK ROOM	RBF-1	RB-1	PT-4	PT-4	PT-4	PT-4						02		
272B	LAB STORAGE	RBF-1	RB-1	PT-4	PT-4	PT-4	PT-4	CSW-1	EP-1	CSW-1			02		
274	MICROSCOPY ROOM	RBF-1	RB-1	PT-1	PT-1	PT-1	PT-1	CSW-1	QTZ-1	CSW-1			02		
275	LACT.	CT-1	CT-3 / MT-1	PT-1	PT-1	PT-1	PT-1						02		
276	SCIN CLASSROOM	RBF-1	RB-1	PT-1	PT-1	PT-1	PT-1	PLAM-1	QTZ-1				02		
277	WOMEN	CT-1,2	CT-1,3,4 / MT-1	CT-1 / PT-1	CT-1	CT-1,4 / PT-1	CT-1,4	PLAM-1	QTZ-1			14,16	02		
279	MEN	CT-1,2	CT-1,3,4 / MT-1	CT-1	CT-1 / PT-1	CT-1,4 / PT-1	CT-1,4	PLAM-1	QTZ-1			14,16	02		
282	PHYS LAB PREP	RBF-1	RB-1	PT-1	PT-1	PT-1	PT-1	CSW-1	EP-1	CSW-1			02		
283	MICROBIO / PLANT RESEARCH LAB	RBF-1	RB-1	PT-1	PT-1	PT-1	PT-1	CSW-1	EP-1	CSW-1			02		
284	PHYSICS LAB	RBF-1	RB-1	PT-1	PT-1	PT-1	PT-1	CSW-1	EP-1	CSW-1			02		
289A	MICROBIO PREP	RBF-1	RB-1	PT-1	PT-1	PT-1	PT-1	CSW-1	EP-1	CSW-1			02		
289B	TISSUE CULTURE B	RBF-1	RB-1	PT-1	PT-1	PT-1	PT-1	CSW-1	EP-1	CSW-1			02		
291	CELL BIO / PHYS. RESEARCH LAB	RBF-1	RB-1	PT-1	PT-1	PT-1	PT-1	CSW-1	EP-1	CSW-1			02		
292	PHYS RESEARCH LAB	RBF-1	RB-1	PT-1	PT-1	PT-1	PT-1	CSW-1	EP-1	CSW-1			02		
C210	CORR	CPT-4	WDB-1	PT-1	PT-1	PT-1	PT-1						02		
C230	CORRIDOR	TER-1	TER-1	PT-1	PT-1	PT-1	PT-1						02		
C230A	VEST.	CPT-1	WDB-1	PT-1	PT-1	PT-1	PT-1						02		
C250	LOBBY	CPT-2 / TER-1	TER-1	PT-1 / WVP-2	PT-1	PT-1	PT-1								

© Cannon Design 2015
All rights reserved. No part of this document may be reproduced without prior written authorization by The Cannon Corporation.
4/26/2017 1:25:18 PM

FINISH SCHEDULE FLOORS 03-04													
Number	Name	Floor Finish	Base Finish	North / Northwest Wall Finish	South / Southeast Wall Finish	East / Northeast Wall Finish	West / Southwest Wall Finish	Base Cabinet	Countertop	Upper Wall Cabinet	Millwork	Comments	Floor
300A	WORK / COPY	RBF-1	RB-2	PT-1	AWC-1 / PT-1	CWC-1 / PT-1	PT-1					3	03
300B	DATA	RBF-1	RB-1	PT-4	PT-4	PT-4							03
300C	K'ETTE	RBF-1	RB-2	PT-1	PT-1	CT-5 / PT-1	PT-1	PLAM-1	QTZ-1	PLAM-1		7,10	03
302	COMMONS	CPT-3	RB-2	PT-1	PT-1	PT-1	PT-1						03
303	COMMONS	CPT-3	RB-2	PT-1	PT-1	PT-1	PT-1						03
304	HR WS OFF.	CPT-3	RB-2	PT-1	PT-1	PT-1	PT-1						03
305	OFF. STAFF (3)	CPT-3	RB-2	PT-1	PT-1	PT-1	PT-1						03
306	OFF. SCI	CPT-3	RB-2	PT-1	PT-1	PT-1	PT-1						03
310A	ELEC	SC-1	RB-1	PT-4	PT-4	PT-4	PT-4						03
310B	STOR	CPT-3	RB-1	PT-1	PT-1	PT-1	PT-1						03
311	OFF. SCI	CPT-3	RB-2	PT-1	PT-1	PT-1	PT-1						03
312	STOR.	CPT-3	RB-1	PT-1	PT-1	PT-1	PT-1						03
313	OFF. SCI	CPT-3	RB-2	PT-1	PT-1	PT-1	PT-1						03
314	OFF. SCI	CPT-3	RB-2	PT-1	PT-1	PT-1	PT-1						03
315	OFF. SCI	CPT-3	RB-2	PT-1	PT-1	PT-1	PT-1						03
316	OFF. ASP	CPT-3	RB-2	PT-1	PT-1	PT-1	PT-1						03
317	OFF. SCI	CPT-3	RB-2	PT-1	PT-1	PT-1	PT-1						03
318	OFF. ASP	CPT-3	RB-2	PT-1	PT-1	PT-1	PT-1						03
319	OFF. SCI	CPT-3	RB-2	PT-1	PT-1	PT-1	PT-1						03
348	OFF. ASP	CPT-3	RB-2	PT-1	PT-1	PT-1	PT-1						03
352	CONF ROOM (10)	CPT-3	RB-2	PT-1	PT-1	PT-1	PT-1						03
353	QUAN. LAB / INTERVIEW LAB	CPT-2	RB-1	PT-1	PT-1	PT-1	PT-1						03
354	COMMONS / (OFF FUT)	CPT-3	RB-2		PT-1	PT-1	PT-2						03
356	COMMONS / (OFF FUT)	CPT-3	RB-2		PT-1	PT-2							03
360	OFF. ASP	CPT-3	RB-2	PT-1	PT-1	PT-1	PT-1						03
362	OFF. HR DIR	CPT-3	RB-2	PT-1	PT-1	PT-1	PT-1						03
364	SM. MTG.	CPT-3	RB-2		PT-1	PT-1	AWC-1 / PT-1						03
372B	LAB WASTE - BIO	RBF-1	RB-1	PT-4	PT-4	PT-4	PT-4	CSW-1	EP-1	CSW-1			03
372C	LAB STOR.	RBF-1	RB-1	PT-4	PT-4	PT-4	PT-4						03
372D	OFF. LAB MGR	RBF-1	RB-2	PT-1	PT-1	PT-1	PT-1						03
374A	BIO FAC. RESEARCH	RBF-1	RB-1	PT-1	PT-1	PT-1	PT-1	CSW-1	EP-1	CSW-1			03
374B	TISSUE CULTURE A	RBF-1	RB-1	PT-1	PT-1	PT-1	PT-1	CSW-1	EP-1	CSW-1			03
375	JC	SC-1	RB-1	FRP-1	FRP-1	FRP-1	FRP-1					11	03
376	COLD ROOM	SC-1	RB-1	PT-4	PT-4	PT-4	PT-4	CSW-1	EP-1	CSW-1			03
377	WOMEN	CT-1,2	CT-1,3,4 / MT-1	CT-1 / PT-1	CT-1	CT-1,4 / PT-1	CT-1,4	PLAM-1	QTZ-1			14,16	03
378	ORGANIS. BIO LAB	RBF-1	RB-1	PT-1	PT-1	PT-1	PT-1	CSW-1	EP-1	CSW-1			03
379	MEN	CT-1,2	CT-1,3,4 / MT-1	CT-1	CT-1 / PT-1	CT-1,4 / PT-1	CT-1,4	PLAM-1	QTZ-1			14,16	03
383	CELL BIO / BIOCHEM LAB	RBF-1	RB-1	PT-1	PT-1	PT-1	PT-1	CSW-1	EP-1	CSW-1			03
386	BIO LAB PREP ROOM B	RBF-1	RB-1	PT-1	PT-1	PT-1	PT-1	CSW-1	EP-1	CSW-1			03
388	MOLECULAR BIO LAB	RBF-1	RB-1	PT-1	PT-1	PT-1	PT-1	CSW-1	EP-1	CSW-1			03
389	BIO LAB PREP ROOM A	RBF-1	RB-1	PT-1	PT-1	PT-1	PT-1	CSW-1	EP-1	CSW-1			03
391	ANATOMY / PHYSIO LAB	RBF-1	RB-1	PT-1	PT-1	PT-1	PT-1	CSW-1	EP-1	CSW-1			03
C310	CORRIDOR	CPT-3	RB-2	PT-1	PT-1	PT-1	PT-1						03
C330	CORRIDOR	CPT-3	RB-2	PT-1	PT-1	PT-1	PT-1						03
C350	CORRIDOR	CPT-3	RB-2	PT-1 / WVP-2	PT-1	PT-1	PT-1						03
C350A	COMMONS	CPT-3	RB-2	PT-1	PT-1	PT-1	PT-1						03
C370	CORRIDOR	CPT-3	RB-2	PT-1 / WVP-2	PT-1	PT-1	PT-1						03
C370B	COMMONS	RBF-1	RB-2	CWC-1 / PT-1	PT-1	PT-1	PT-1		QTZ-1			15	03
C380	CORRIDOR	RBF-1	RB-2	PT-1	PT-1	AWC-1 / CWC-1 / PT-1 / WVP-1	AWC-1 / CWC-1 / PT-1 / WVP-1					18	03
C380A	COMMONS	RBF-1	RB-2	PT-2	PT-1	PT-1	PT-1						03
S301	STAIR 1-3	TER-1	PREFINISHED	WVP-2	PT-1	PT-1	WVP-2					6,8	03
S394	STAIR 2-3	CPT-7	RB-1	PT-1	PT-1	PT-1	PT-1					5	03
400A	WORK / COPY	RBF-1	RB-2	PT-1	AWC-1 / PT-1	CWC-1 / PT-1	PT-1	PLAM-1	PL-1	PLAM-1		3	04
400B	DATA	RBF-1	RB-1	PT-4	PT-4	PT-4	PT-4						04
400C	K'ETTE	RBF-1	RB-2	PT-1	PT-1	CT-5 / PT-1	PT-1	PLAM-1	QTZ-1	PLAM-1		7,10	04
401	OFF. ADJ (4)	CPT-3	RB-2	PT-1	PT-1	PT-1	PT-1						04
402	OFF. WORK STUDY	CPT-3	RB-2	PT-1	PT-1	PT-1	PT-1						04
403	OFF. FLX	CPT-3	RB-2	PT-1	PT-1	PT-1	PT-1						04
404	OFF. FLX	CPT-3	RB-2	PT-1	PT-1	PT-1	PT-1						04
405	OFF. FLX	CPT-3	RB-2	PT-1	PT-1	PT-1	PT-1						04
406	OFF. ADJ (4)	CPT-3	RB-2	PT-1	PT-1	PT-1	PT-1						04
407	OFF. STAFF	CPT-3	RB-2	PT-1	PT-1	PT-1	PT-1						04
410	ELEC	SC-1	RB-1	PT-4	PT-4	PT-4	PT-4						04
411	OFFICE FLX	CPT-3	RB-2	PT-1	PT-1	PT-1	PT-1						04
412	TESTING	CPT-3	RB-2	PT-1	PT-1	PT-1	PT-1						04
413	OFF. IL	CPT-3	RB-2	PT-1	PT-1	PT-1	PT-1						04
414	TESTING	CPT-3	RB-2	PT-1	PT-1	PT-1	PT-1						04
415	OFF. IL	CPT-3	RB-2	PT-1	PT-1	PT-1	PT-1						04
416	OFF. IL WS (2)	CPT-3	RB-2	PT-1	PT-1	PT-1	PT-1						04
417	OFF. IL	CPT-3	RB-2	PT-1	PT-1	PT-1	PT-1						04
419	TRANSLATION	CPT-3	RB-2	PT-1	AWC-1 / PT-1	AWC-1 / PT-1	PT-1						04
431	OFF. FUT	CPT-3	RB-2	PT-1	PT-1	PT-1	PT-1						04
432	OFF. ADJ. (3)	CPT-3	RB-2	PT-1	PT-1	PT-1	PT-1						04
433	OFF. IL	CPT-3	RB-2	PT-1	PT-1	PT-1	PT-1						04
434	OFF. ADJ (3)	CPT-3	RB-2	PT-1	PT-1	PT-1	PT-1						04
435	OFF. IL	CPT-3	RB-2	PT-1	PT-1	PT-1	PT-1						04
437	OFF. IL	CPT-3	RB-2	PT-1	PT-1	PT-1	PT-1						04
439	OFF. ESL	CPT-3	RB-2	PT-1	PT-1	PT-1	PT-1						04
441	SM. MTG.	CPT-3	RB-2	PT-1	AWC-1 / PT-1	PT-1	PT-1						04
452	OFF. TA	CPT-3	RB-2	PT-1	PT-1	PT-1	PT-1						04
454	OFF. INTL	CPT-3	RB-2	PT-1	PT-1	PT-1	PT-1						04
456	OFF. SAFETY OFFICER	CPT-3	RB-2	PT-1	PT-1	PT-1	PT-1						04
472	CHEM LAB - GENERAL	RBF-1	RB-1	PT-1	PT-1	PT-1	PT-1	CSW-1	EP-1	CSW-1			04
475	LAB WASTE - CHEM	SC-1	RB-1	FRP-1	FRP-1	FRP-1	FRP-1					11	04
477	WOMEN	CT-1,2	CT-1,3,4 / MT-1	CT-1 / PT-1	CT-1	CT-1,4 / PT-1	CT-1,4	PLAM-1	QTZ-1			14,16	04
478	CHEM LAB PREP	RBF-1	RB-1	PT-1	PT-1	PT-1	PT-1	CSW-1	EP-1	CSW-1			04
479	MEN	CT-1,2	CT-1,3,4 / MT-1	CT-1	CT-1 / PT-1	CT-1,4 / PT-1	CT-1,4	PLAM-1	QTZ-1			14,16	04
480	CHEM LAB - ORGANIC	RBF-1	RB-1	PT-1	PT-1	PT-1	PT-1	CSW-1	EP-1	CSW-1			04
483	CHEM LAB - RESEARCH	RBF-1	RB-1	PT-1	PT-1	AWC-1 / PT-1	PT-1	CSW-1	EP-1	CSW-1			04
488	CHEM LAB - ANALYT / INORGANIC	RBF-1	RB-1	PT-1	PT-1	PT-1	PT-1	CSW-1	EP-1	CSW-1			04
489	CHEM INSTR. LAB	RBF-1	RB-1	PT-1	PT-1	PT-1	PT-1	CSW-1	EP-1	CSW-1			04
491	CHEM LAB PHYSICAL	RBF-1	RB-1	PT-1	PT-1	PT-1	PT-1	CSW-1	EP-1	CSW-1			04
C410	CORRIDOR	CPT-3	RB-2	PT-1	PT-1	PT-1	PT-1						04
C450	CORRIDOR	CPT-3	RB-2	PT-1 / WVP-2	PT-1	PT-1	PT-1						04
C450A	COMMONS	CPT-3	RB-2		PT-3								04
C470	CORR.	CPT-3	RB-2	PT-1 / WVP-2	PT-1	PT-1	PT-1						04
C480	CORRIDOR	RBF-1	RB-2	PT-1	PT-1	AWC-1 / CWC-1 / PT-1 / WVP-1	PT-1					18	04
C480A	COMMONS	RBF-1	RB-2	PT-3	PT-1	PT-1	PT-1						04
S440	STAIR 1-4	TER-1	PREFINISHED	WVP-2	PT-1	PT-1	WVP-2					6,8	04
S494	STAIR 2-4	CPT-7	RB-1	PT-1	PT-1	PT-1	PT-1					5	04
S494A	ROOF ACCESS	SC-1	RB-1	PT-4	PT-4	PT-4	PT-4						04

GENERAL NOTES	
1	FLOORING CHANGES TO TRANSITION AT THE CENTER OF THE DOOR FRAME UNLESS OTHERWISE NOTED ON THE FINISH PLAN.
2	REFERENCE FLOORING TRANSITION PLAN AND FINISH LEGEND FOR ALL TRANSITIONS. DESIGNER TO SELECT AND APPROVE ALL COLORS. TRANSITIONS TO MEET ADA REQUIREMENTS.
3	PAINTED SURFACES SHALL BE SANDED, FILLED OR PATCHED AS REQUIRED. ALL PAINTED SURFACES SHALL BE PRIMED AND RECEIVE TWO COATS OF PAINT. PAINT BEING APPLIED TO WALL SURFACES SHALL BE AN EGGSHELL FINISH. ALL PAINT