



The design information and data contained on this electronic media is provided to you as an instrument of service, protected by copyright law, and intended for use and reference relative only to the specific project they describe. J. F. Ahern Co. explicitly assumes no responsibility or liability for any other use of these electronic files whatsoever. The electronic files may not be copied, modified or released to a third party without the direct written permission of J. F. Ahern Co. Further, because transmission errors and read/write errors can occur and because electronic media stored can be modified by other parties intentionally or otherwise without notice of said modification, J. F. Ahern Co. cannot guarantee the accuracy of these files.




J. F. AHERN CO.
FIRE PROTECTION
CONTRACTORS
2675 Scott Ave., Suite C
St. Louis, MO 63103-3047
(314) 535-4544 p (314) 535-0144 f
www.jfahern.com

**WEBSTER UNIV - INTER
SCIENCE BUILDING
8274 BIG BEND BLVD.
WEBSTER GROVES, MO**

PRE-ACTION DETECTION AND CONTROL DETAILS

IF DRAWING IS PLOTTED CORRECTLY
THIS BAR SHOULD MEASURE 2"

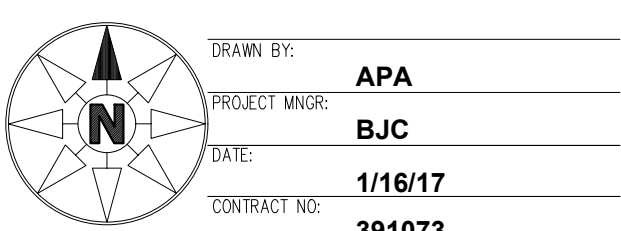

CONSTRUCTION DOCUMENTS

FX-1

PARENT JOB #461259