



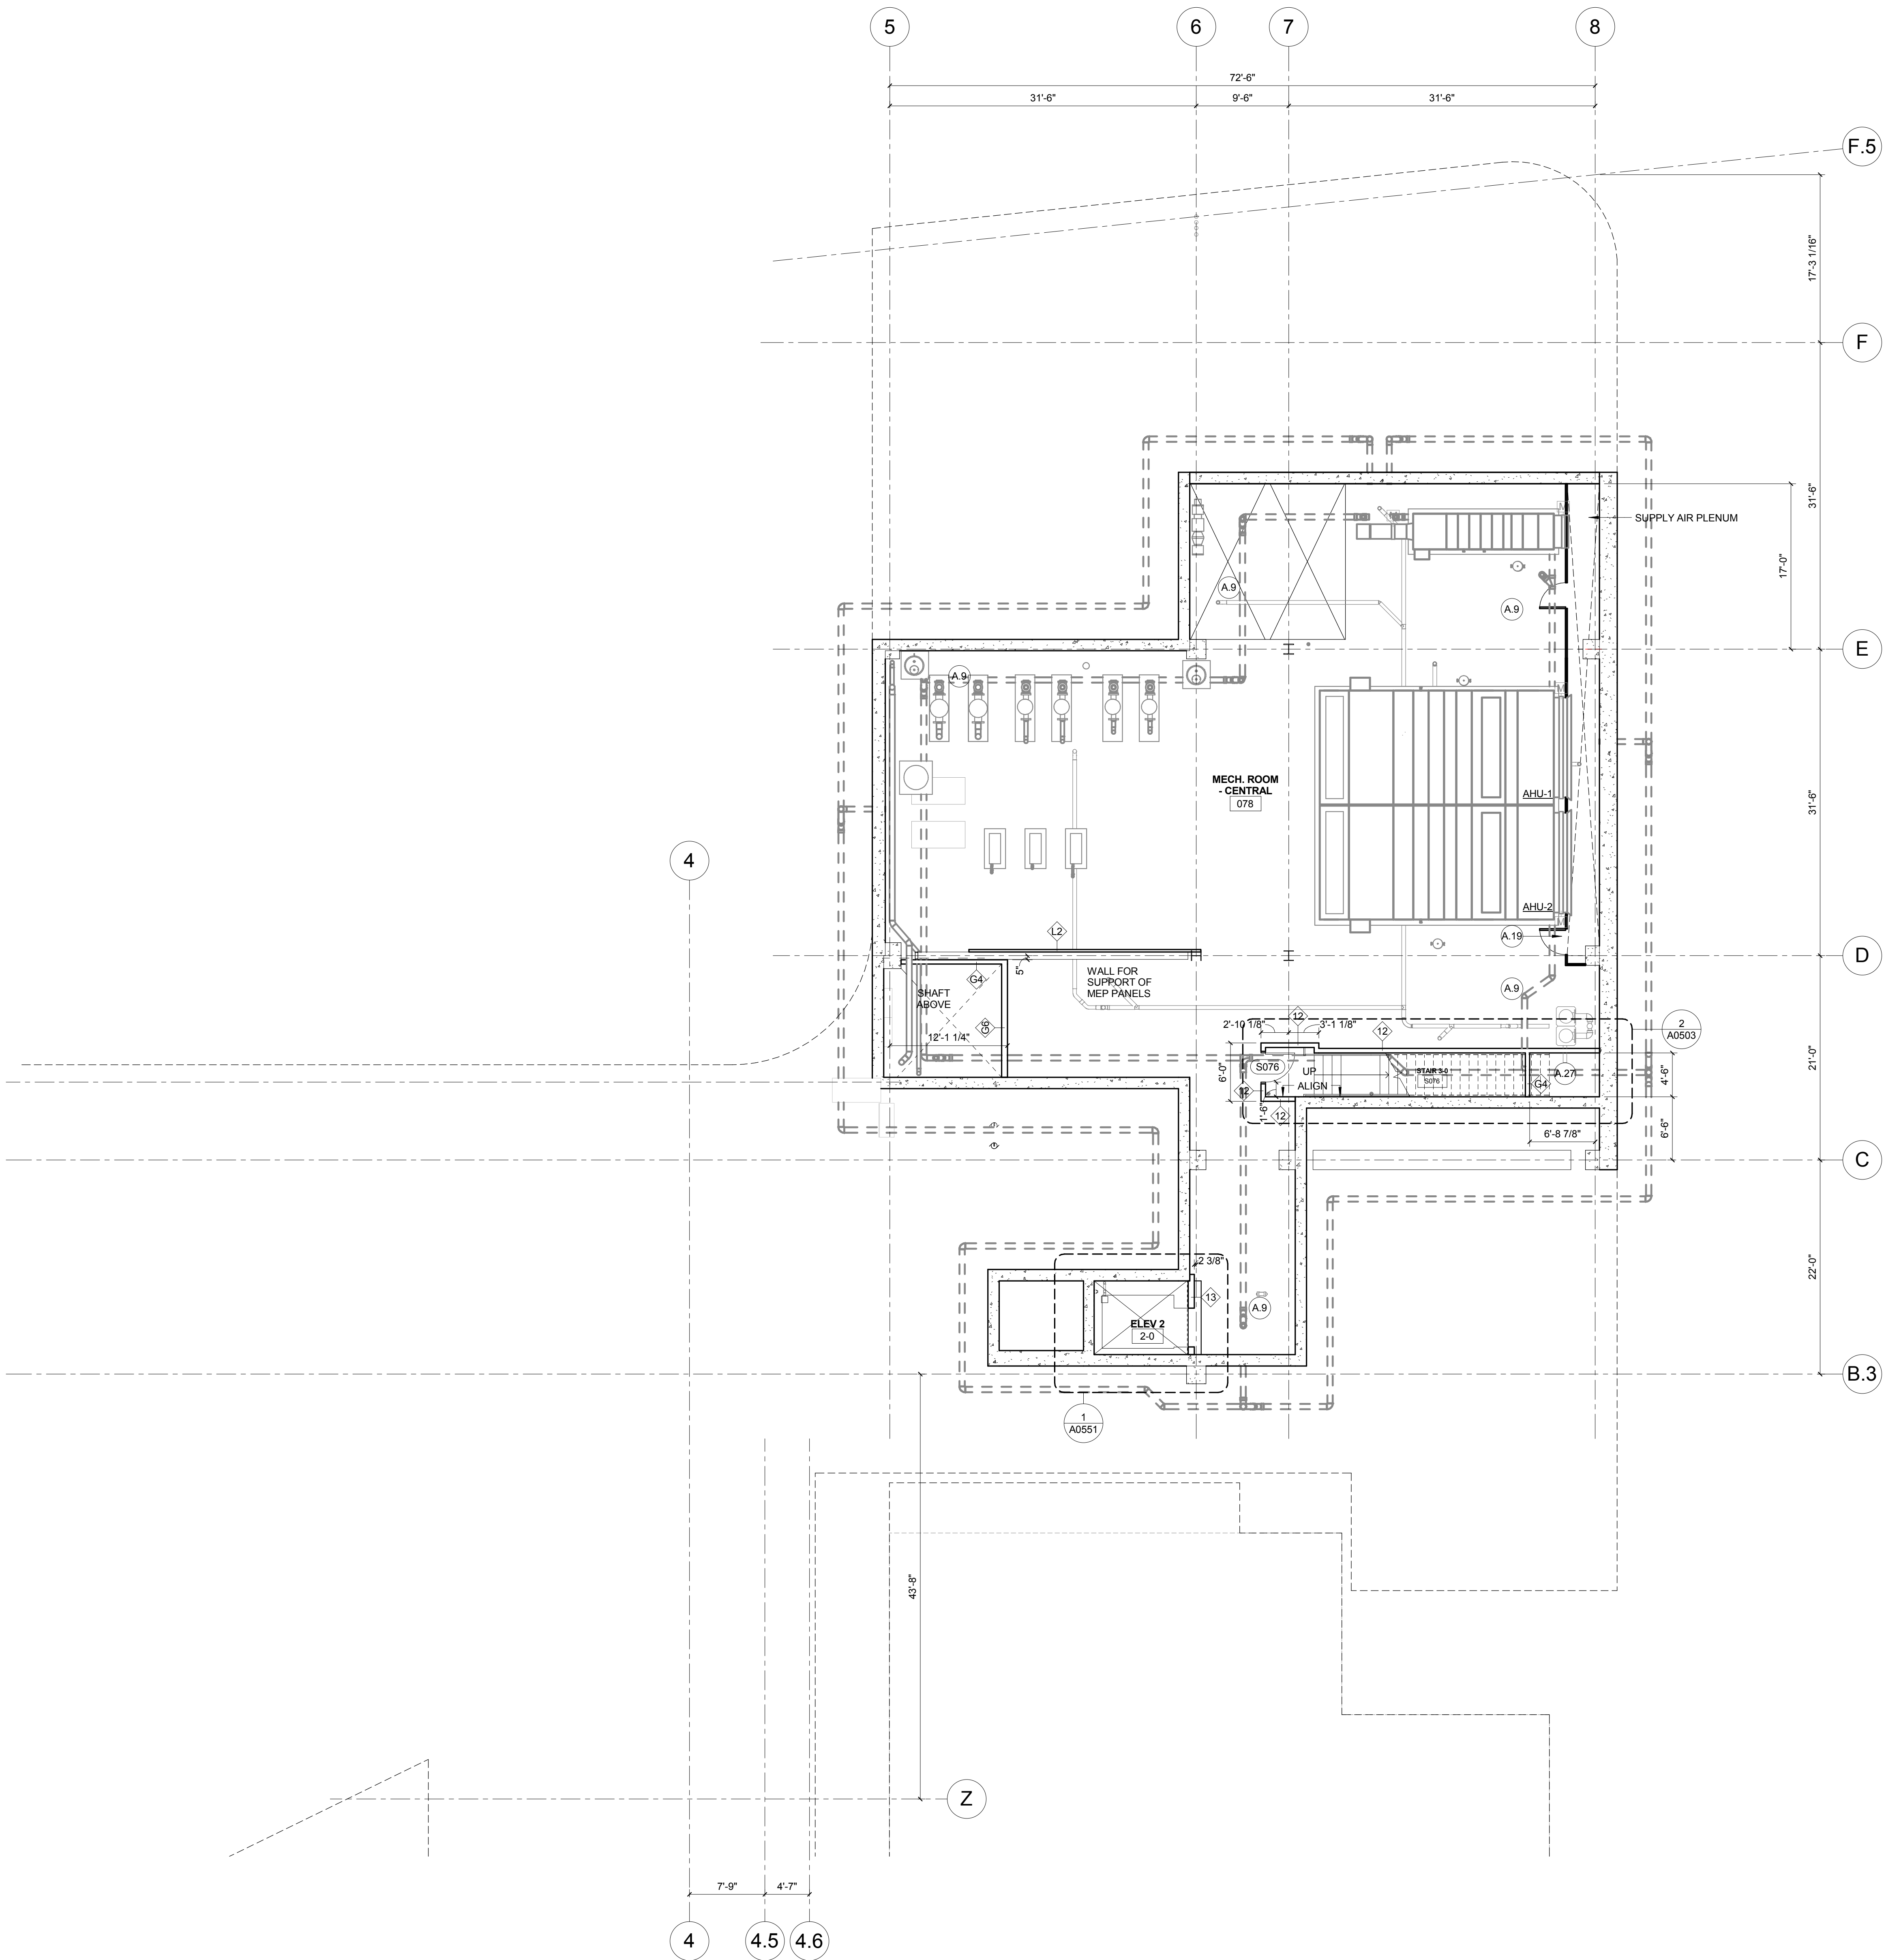

1 LEVEL 00 FLOOR PLAN
1/8" = 1'-0"

KEYED NOTE LEGEND - PLAN

- A.1 092709 GRG COLUMN COVER TO 3" ABOVE CEILING - 20" DIA. TYP. SEE DETAIL 4/A0811 AND 13/A0842.
A.2 081216 INTERIOR GLAZING SYSTEM: IGS-1: REFER TO TYPICAL INT. ELEVATIONS 1 AND 2 ON SHEET A0603
A.3 081216 INTERIOR GLAZING SYSTEM IGS-2: SEE TYPICAL ELEVATION 5 AND 6 A0603
A.4 081216 INTERIOR GLAZING SYSTEM: IGS-3: REFER TO INTERIOR ELEVATIONS
A.5 088813 FIRE RATED GLAZING- 120 MIN. FIRE RATED GLAZING 10'-0" HIGH. BASIS OF DESIGN: VETROTECH CONTRAFILAMM STRUTTURA - WITH BUTT JOINTS AND PERIMETER FRAMING.
A.6 088813 FIRE RATED GLAZING AND FRAME- 120 MIN. FIRE RATED GLAZING 1'-8" HIGH X 5'-0" WIDE. BASIS OF DESIGN: VETROTECH CONTRAFILAMM WITH PERIMETER FRAMING.
A.7 111519 LOADING DOCK LIFT - STATIONARY - 6W X 8' DEEPW/ 14" PIT
A.8 ALTERNATING TREAD STAIRWAY UP TO ROOF HATCH
A.9 UNDERSLAB DRAINAGE SYSTEM PER OWNER'S GEOTECHNICAL CONSULTANT RECOMMENDATION TYPICAL ALL SLAB ON GRADE AREAS
A.11 NEW CONCRETE STEPS TO MATCH EXISTING REMOVED FOR CONSTRUCTION
A.12 553006 BRICK FACED CONCRETE DUMPSTER ENCLOSURE TOP OF WALL
A.13 LCD SIGNAGE SCREEN IN WALL RECESS (OFCI)
A.14 MARKERBOARD SURFACE
A.15 WOOD SCREEN W/ SOLID LUMBER
A.17 VIDEO WALL - 24 55" SCREENS
A.18 LCD SCREEN LOCATION (OFOI)
A.19 AIR PLENUM - INSULATED PLENUM CONSTRUCTION BY DIVISION 23
A.20 122200 CURTAIN LOCATION
A.21 104313 AED CABINET LOCATION
A.22 10 4413 FEC WITH FIRE EXTINGUISHER
A.23 08 4423 SULL SASH LOCATION: PROVIDE 1/4" TEMPERED CLEAR GLAZING AT INTERIOR FACE OF CURTAIN WALL MULLIONS FOR ACOUSTICAL SEPARATION.
A.24 6" X 8" FORMED CONCRETE TRENCH IN FLOOR W/ METAL PLATE COVER. PROVIDE BLIND SIDE WATERPROOFING
A.25 BUILT IN SALT WATER FISH TANK LOCATION. SIZE APPROX. 7'-6" X 2'-4" X 2'-6" HIGH. LOW IRON GLASS VIEW WINDOW ON CORRIDOR SIDE. SLIDING DOOR ON LAB SIDE. FISH TANK EQUIPMENT BELOW TANK W/ CABINET DOOR ACCESS ON LAB SIDE. FINISHED INTERIOR FACE OF WALLS AND CEILING INSIDE CAVITY W/ WATER RESISTANT GYP BOARD AND EPOXY PAINT.
A.26 LCD SIGNAGE SCREEN IN WALL RECESS (OFCI)
A.27 CONSTRUCT 2 HOUR RATED SEPARATION BETWEEN BOTTOM OF STAIR AND UTILITY PIPING CROSSING THIS AREA. USE HORIZ. GYP BD. ENCLOSURE ON SHEET A1002

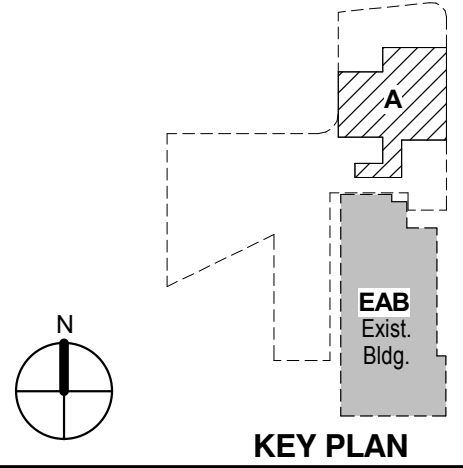

KEY PLAN

LEVEL 00 FLOOR PLAN