

Webb Engineering Services, Inc.
Plumbing & Fire Protection
1400 S. 3rd Street, Suite 201
St. Louis, MO 63104
314.588.0600

A.1 092700 GRC COLUMN COVER TO 3' ABOVE CEILING - 20" DIA. TYP. SEE
A.2 DETAIL 4/08/81 AND 1/30/82/62.

A.3 081216 INTERIOR GLAZING SYSTEM - IGS-1: REFER TO TYPICAL INT.
ELEVATIONS 1 AND 2 ON SHEET A0603

A.4 081216 INTERIOR GLAZING SYSTEM - IGS-2: SEE TYPICAL ELEVATION 5,
AND 6/08/81

A.5 081216 INTERIOR GLAZING SYSTEM - IGS-3: REFER TO INTERIOR
ELEVATIONS

A.6 088813 FIRE RATED GLAZING - 120 MIN. FIRE RATED GLAZING 10'-0"
HIGH (BASED ON DESIGN BASIS OF INTERIOR CONTRAFLAMM. STRUCTURA
WITH BUTT JOINTS AND PERIMETER FRAMING.

A.7 088813 FIRE RATED GLAZING AND FRAME - 120 MIN. FIRE RATED
GLAZING 1'-6" HIGH (ON DESIGN BASIS OF DESIGN VETROTECH
CONTRAFLAMM. WITH PERIMETER FRAMING.

A.8 111319 LOADING DOCK LIFT - STATIONARY - 6'-w x 8'-D DEEPM 14" PIT
ALTERNATING TREAD STAIRWAY UP TO ROOF HATCH.

A.9 UNDETAILED LAB FRAME SYSTEM PER OWNER'S GEOTECHNICAL
CONSULTANT RECOMMENDATION TYPICAL ALL SLAB ON GRADE AREAS
NEW CONCRETE STEPS TO MATCH EXISTING REMOVED FOR
CONSTRUCTION.

A.10 553006 BRICK FACED CONCRETE DUMPSITER ENCLOSURE TOP OF WALL
A.11 LDC SIGNAGE SCREEN IN WALL RECESS (OFCI)

A.12 MARKERBOARD SURFACE

A.13 WOOD SCREEN SOLID SLAB LUMBER

A.14 VIDEO WALL - 24" 56" SCREENS

A.15 LDC SCREEN LOCATION (OFOI)

A.16 AIR PLenum - INSULATED PLenum CONTRAFLAMM BY DIVISION 23

A.17 222200 CURTAIN WALL

A.18 104313 RD CABINET LOCATION

A.19 10 4413 FEC WITH FIRE EXTINGUISHER

A.20 08 4423 SLASH LOCATION: PROVIDE 1/4" TEMPERED CLEAR
GLAZING AT INTERIOR FACE OF CURTAIN WALL MULLIONS FOR
ACOUSICAL SEPARATION.


A.21 6" x 8" FORMED CONCRETE TRENCH IN FLOOR W/ METAL PLATE
COVER PROVIDE BLIND SIDE WATER RESISTANT

A.22 BUILT IN SAT WATER FISH TANK LOCATION. SIZE APPROX. 7'-6" X 2'-4"
X 2'-8" HIGH. LOW IRON GLASS VIEW WINDOW ON CORRIDOR SIDE.
SLIDE DOOR ON LAB SIDE. FISH TANK EQUIPMENT BELOW TANK W/
CABINET DOOR ACCESS TO TANK. INSULATED INSIDE INTERIOR FACE OF
WALLS AND CEILING INSIDE CAVITY W/ WATER RESISTANT GYP BOARD
AND JOINT PAINT.

A.23 LDC SIGNAGE SCREEN IN WALL RECESS (OFCI)

A.24 CONSTRUCT 2 HOUR RATED SEPARATION BETWEEN BOTTOM OF STAIR
AND UTILITY PIPES CROSSING THIS AREA. USE HORIZ. GYP BD.
ENCLOSURE ON SIDE OF STAIR.

2	ASI-054	06 MAR 2017
1	ADDENDUM 3-1	05 APR 2016
-	ISSUED FOR CONSTRUCTION (BP3)	15 MAR 2016
No.	Description	Date

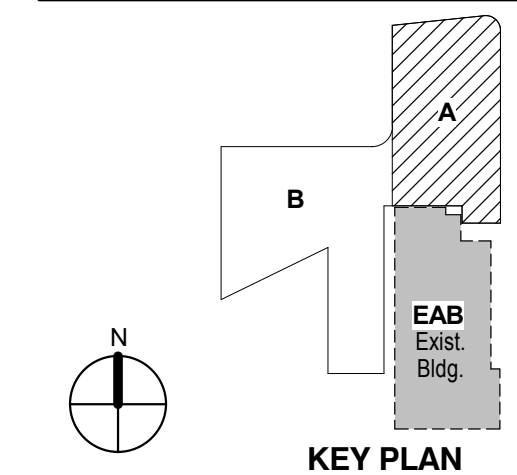

Drawing Title:


**LEVEL 01 AREA A FLOOR
PLAN**

Project No.: 04561.01

Checked by:

A0101.A

© Cannon Design 2015

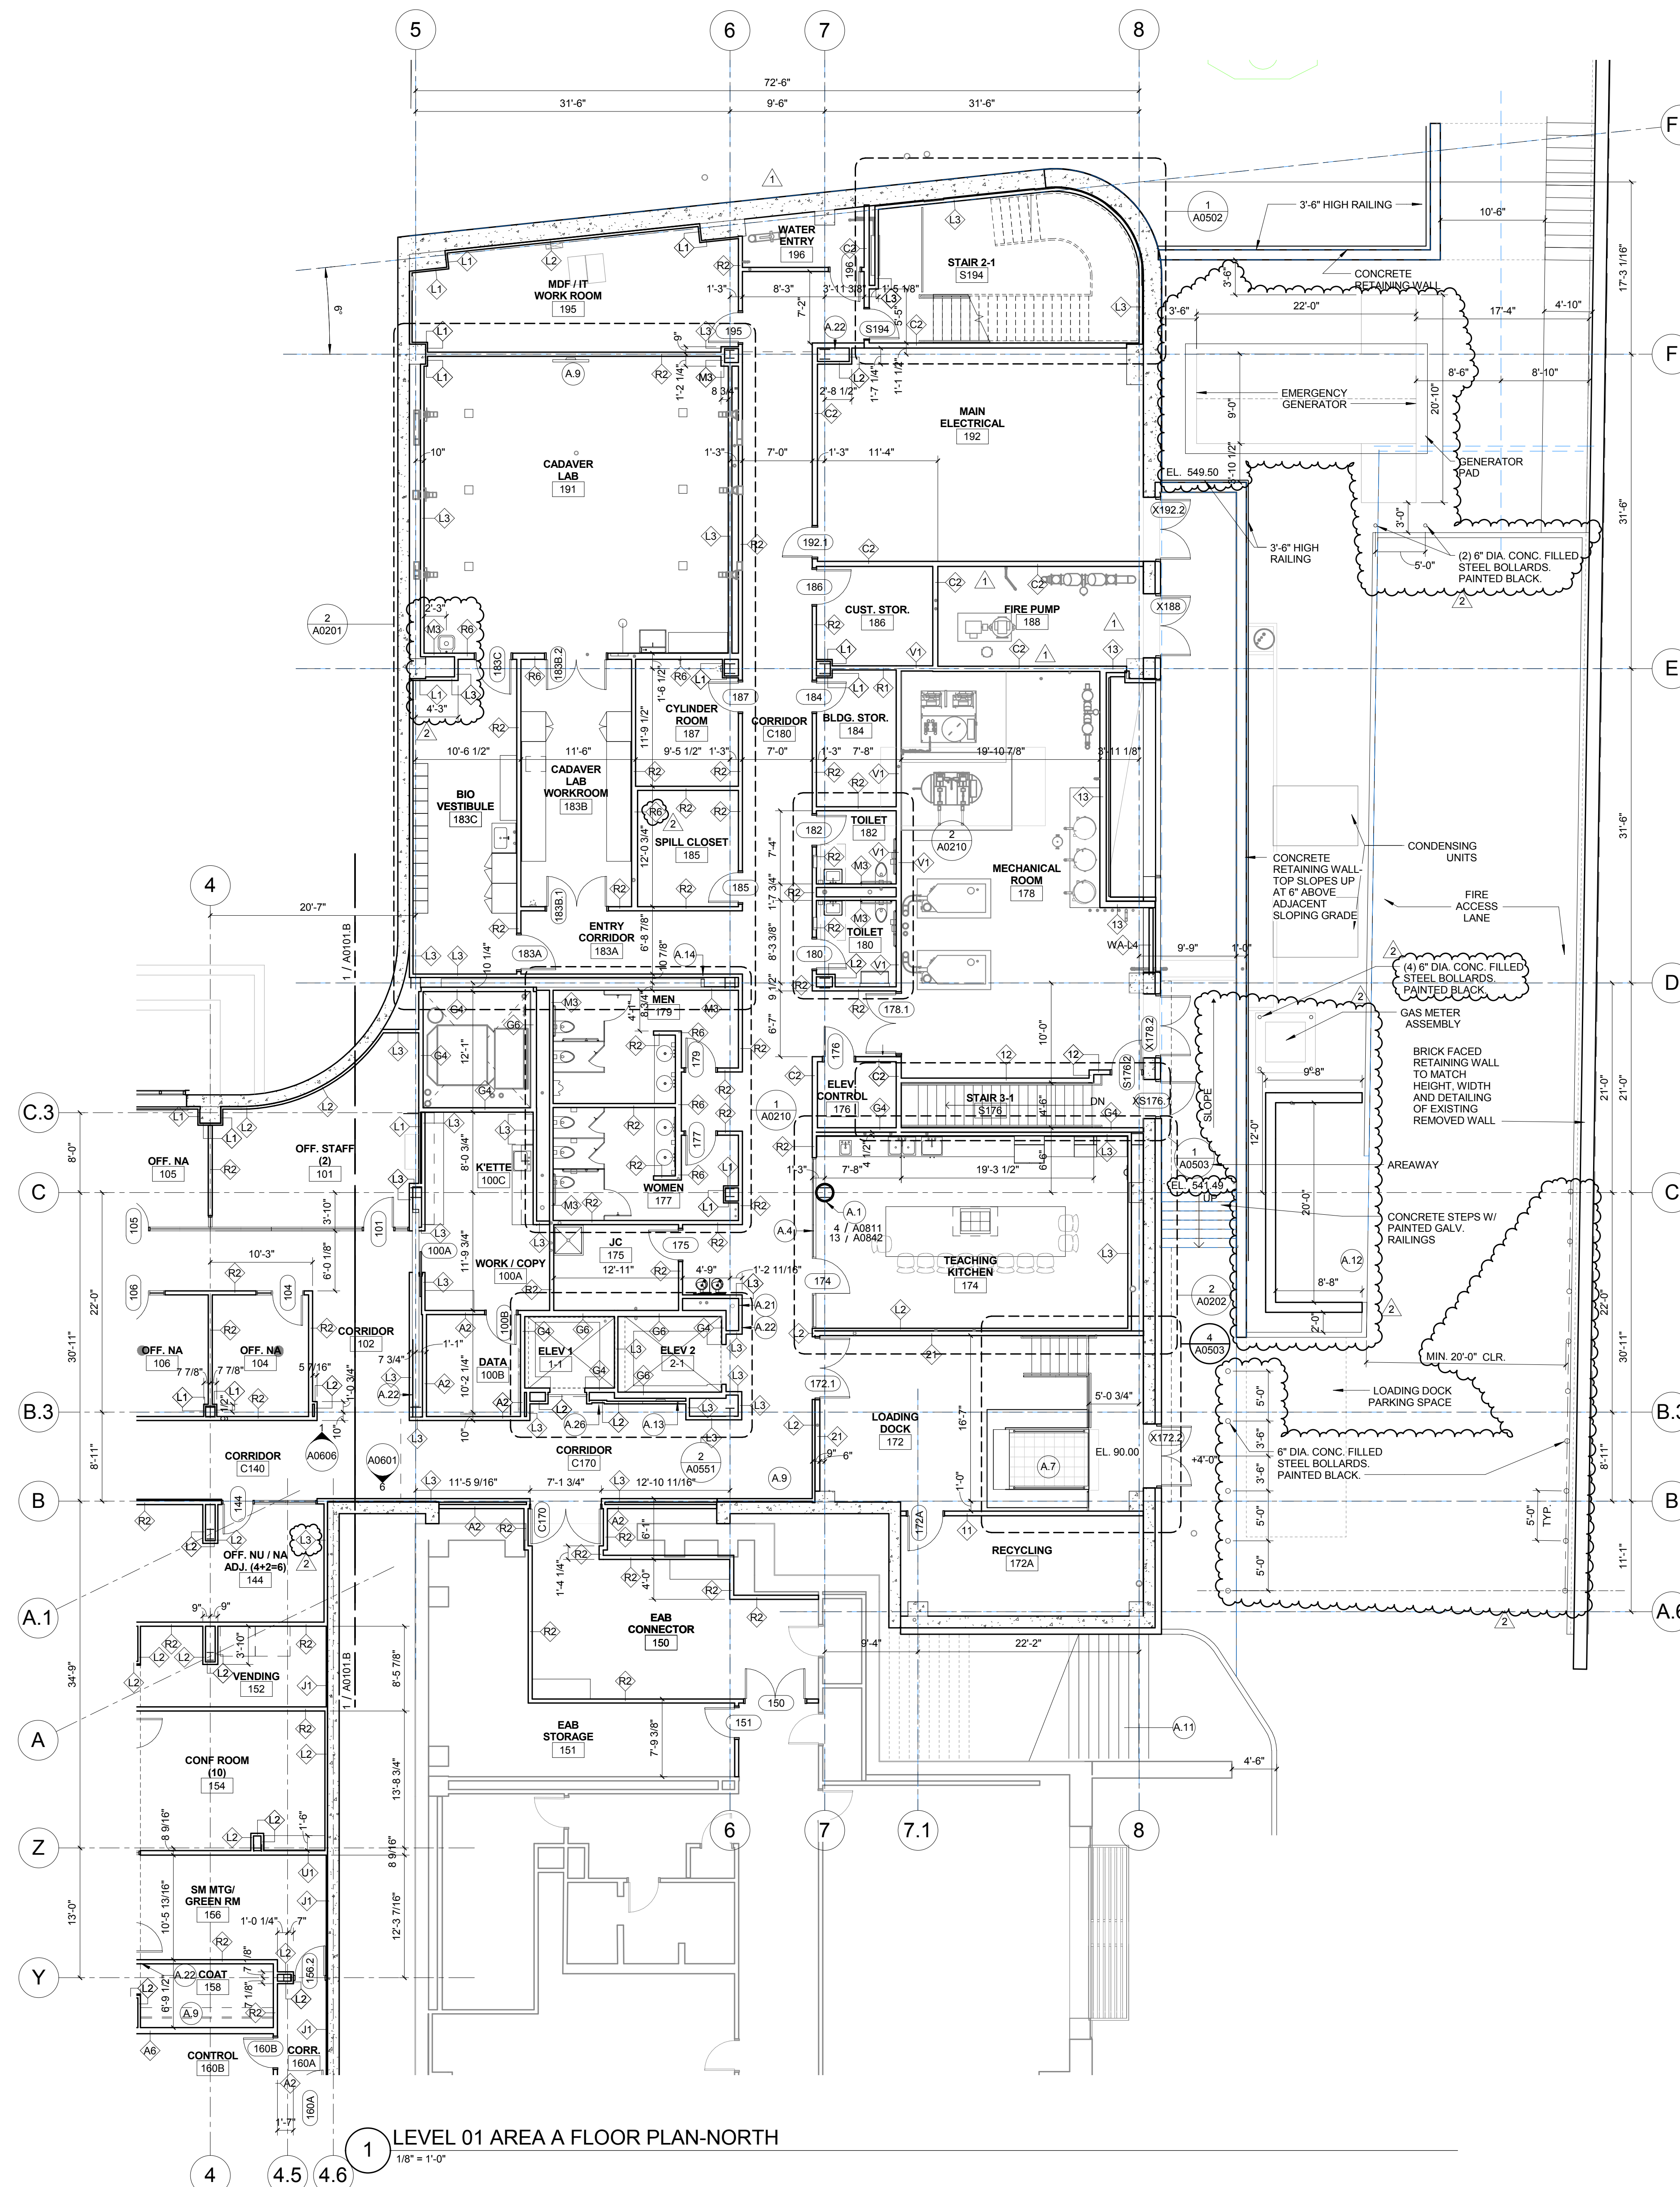

© Cannon Design 2015
All rights reserved. No part of this document may be reproduced or utilized in any form, without prior written authorization by The Cannon Corporation.
3/06/2017 3:11:56 PM