



1100 Clark Avenue
Louis, Missouri 63102
T: 314.241.6250
F: 314.241.2570

William Tao & Associates, Inc
MEP/FP Engineer
55 Manchester Road, Suite 125
St. Louis, MO 63143
314-884-7600

David Mason & Associates, Inc.
Structural & Civil Engineer
100 South Vandeventer Avenue
St. Louis, MO 63110
314.534.1053

**Faith Group
Technology**
3101 S. Hanley Rd, Suite 100
St. Louis, MO 63143
314.991.2228


Kuhlmann Leavitt, Inc.
Environmental Graphics & Signage
7400 Pershing Ave
St. Louis, MO 63130
314.725.6616

KWA Architects
Architecture
9721 Litzinger Road
St. Louis, MO 63124
314.962.2560

Spellman Brady & Company
Interior Designer
51 Maryland Avenue, Suite 300
St. Louis, MO 63105
314.862.0070

SWT Design
Landscape Architect
7722 Big Bend Blvd
St. Louis, MO 63119
314.644.5700

ebb Engineering Services, Inc.
Plumbing & Fire Protection
1400 S. 3rd Street, Suite 201
St. Louis, MO 63104
314.588.0600

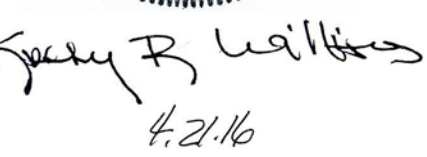

The site plan shows a rectangular lot with a street (B) on the left. A proposed building (A) is shown as a hatched rectangle on the right side of the lot. An existing building (EAB) is shown as a solid grey rectangle on the right side of the lot, adjacent to the street. A north arrow is located in the bottom left corner of the plan.


KEY PLAN

**EXTERIOR - LEVEL 01
AREA A FLOOR PLAN**

Project No.: 04561.01 Checked by:

A0101.EA

Cannon Design 2015

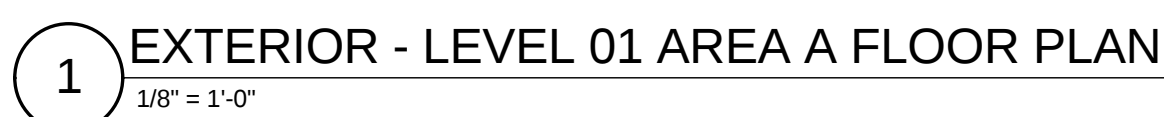

© Cannon Design 2015
All rights reserved. No part of this document may be reproduced or utilized in any form, without prior written authorization by The Cannon Corporation.
4/21/2016 8:42:10 AM