




1 LEVEL 02
1/16" = 1'-0"

ISSUED FOR CONSTRUCTION (BP3) 15 MAR 2016

No. Description Date

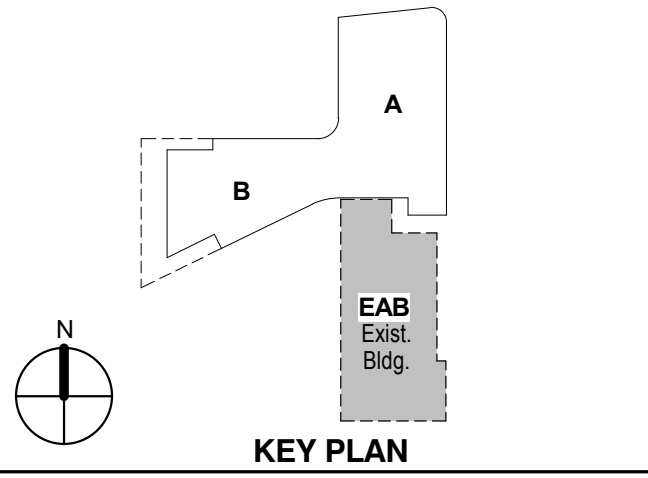

KEY PLAN

LEVEL 02 FLOOR PLAN

Project No.: 04561.01 Checked by:

A0102