

William Tao & Associates, Inc.
MEP/FP Engineer
7955 Manchester Road, Suite 125
St. Louis, MO 63143
314-884-7600

David Mason & Associates, Inc.
Structural & Civil Engineer
800 South Vandeventer Avenue
St. Louis, MO 63110
314-534-1053

Faith Group
Technology
3101 S. Hanley Rd. Suite 100
St. Louis, MO 63143
314-991-2229


Kuhnmann Leavitt, Inc.
Environmental Graphics & Signage
7400 Pershing Ave.
St. Louis, MO 63130
314-725-6616

KWA Architects
Architecture
9721 Litzinger Road
St. Louis, MO 63124
314-962-2560

Spellman Brady & Company
Interior Designer
8251 Maryland Avenue, Suite 300
St. Louis, MO 63105
314-862-0070

SWT Design
Landscape Architect
7722 Big Bend Blvd.
St. Louis, MO 63119
314-644-5700


Webb Engineering Services, Inc.
Planning & Fire Protection
1400 S. 3rd Street, Suite 201
St. Louis, MO 63104
314-588-0600

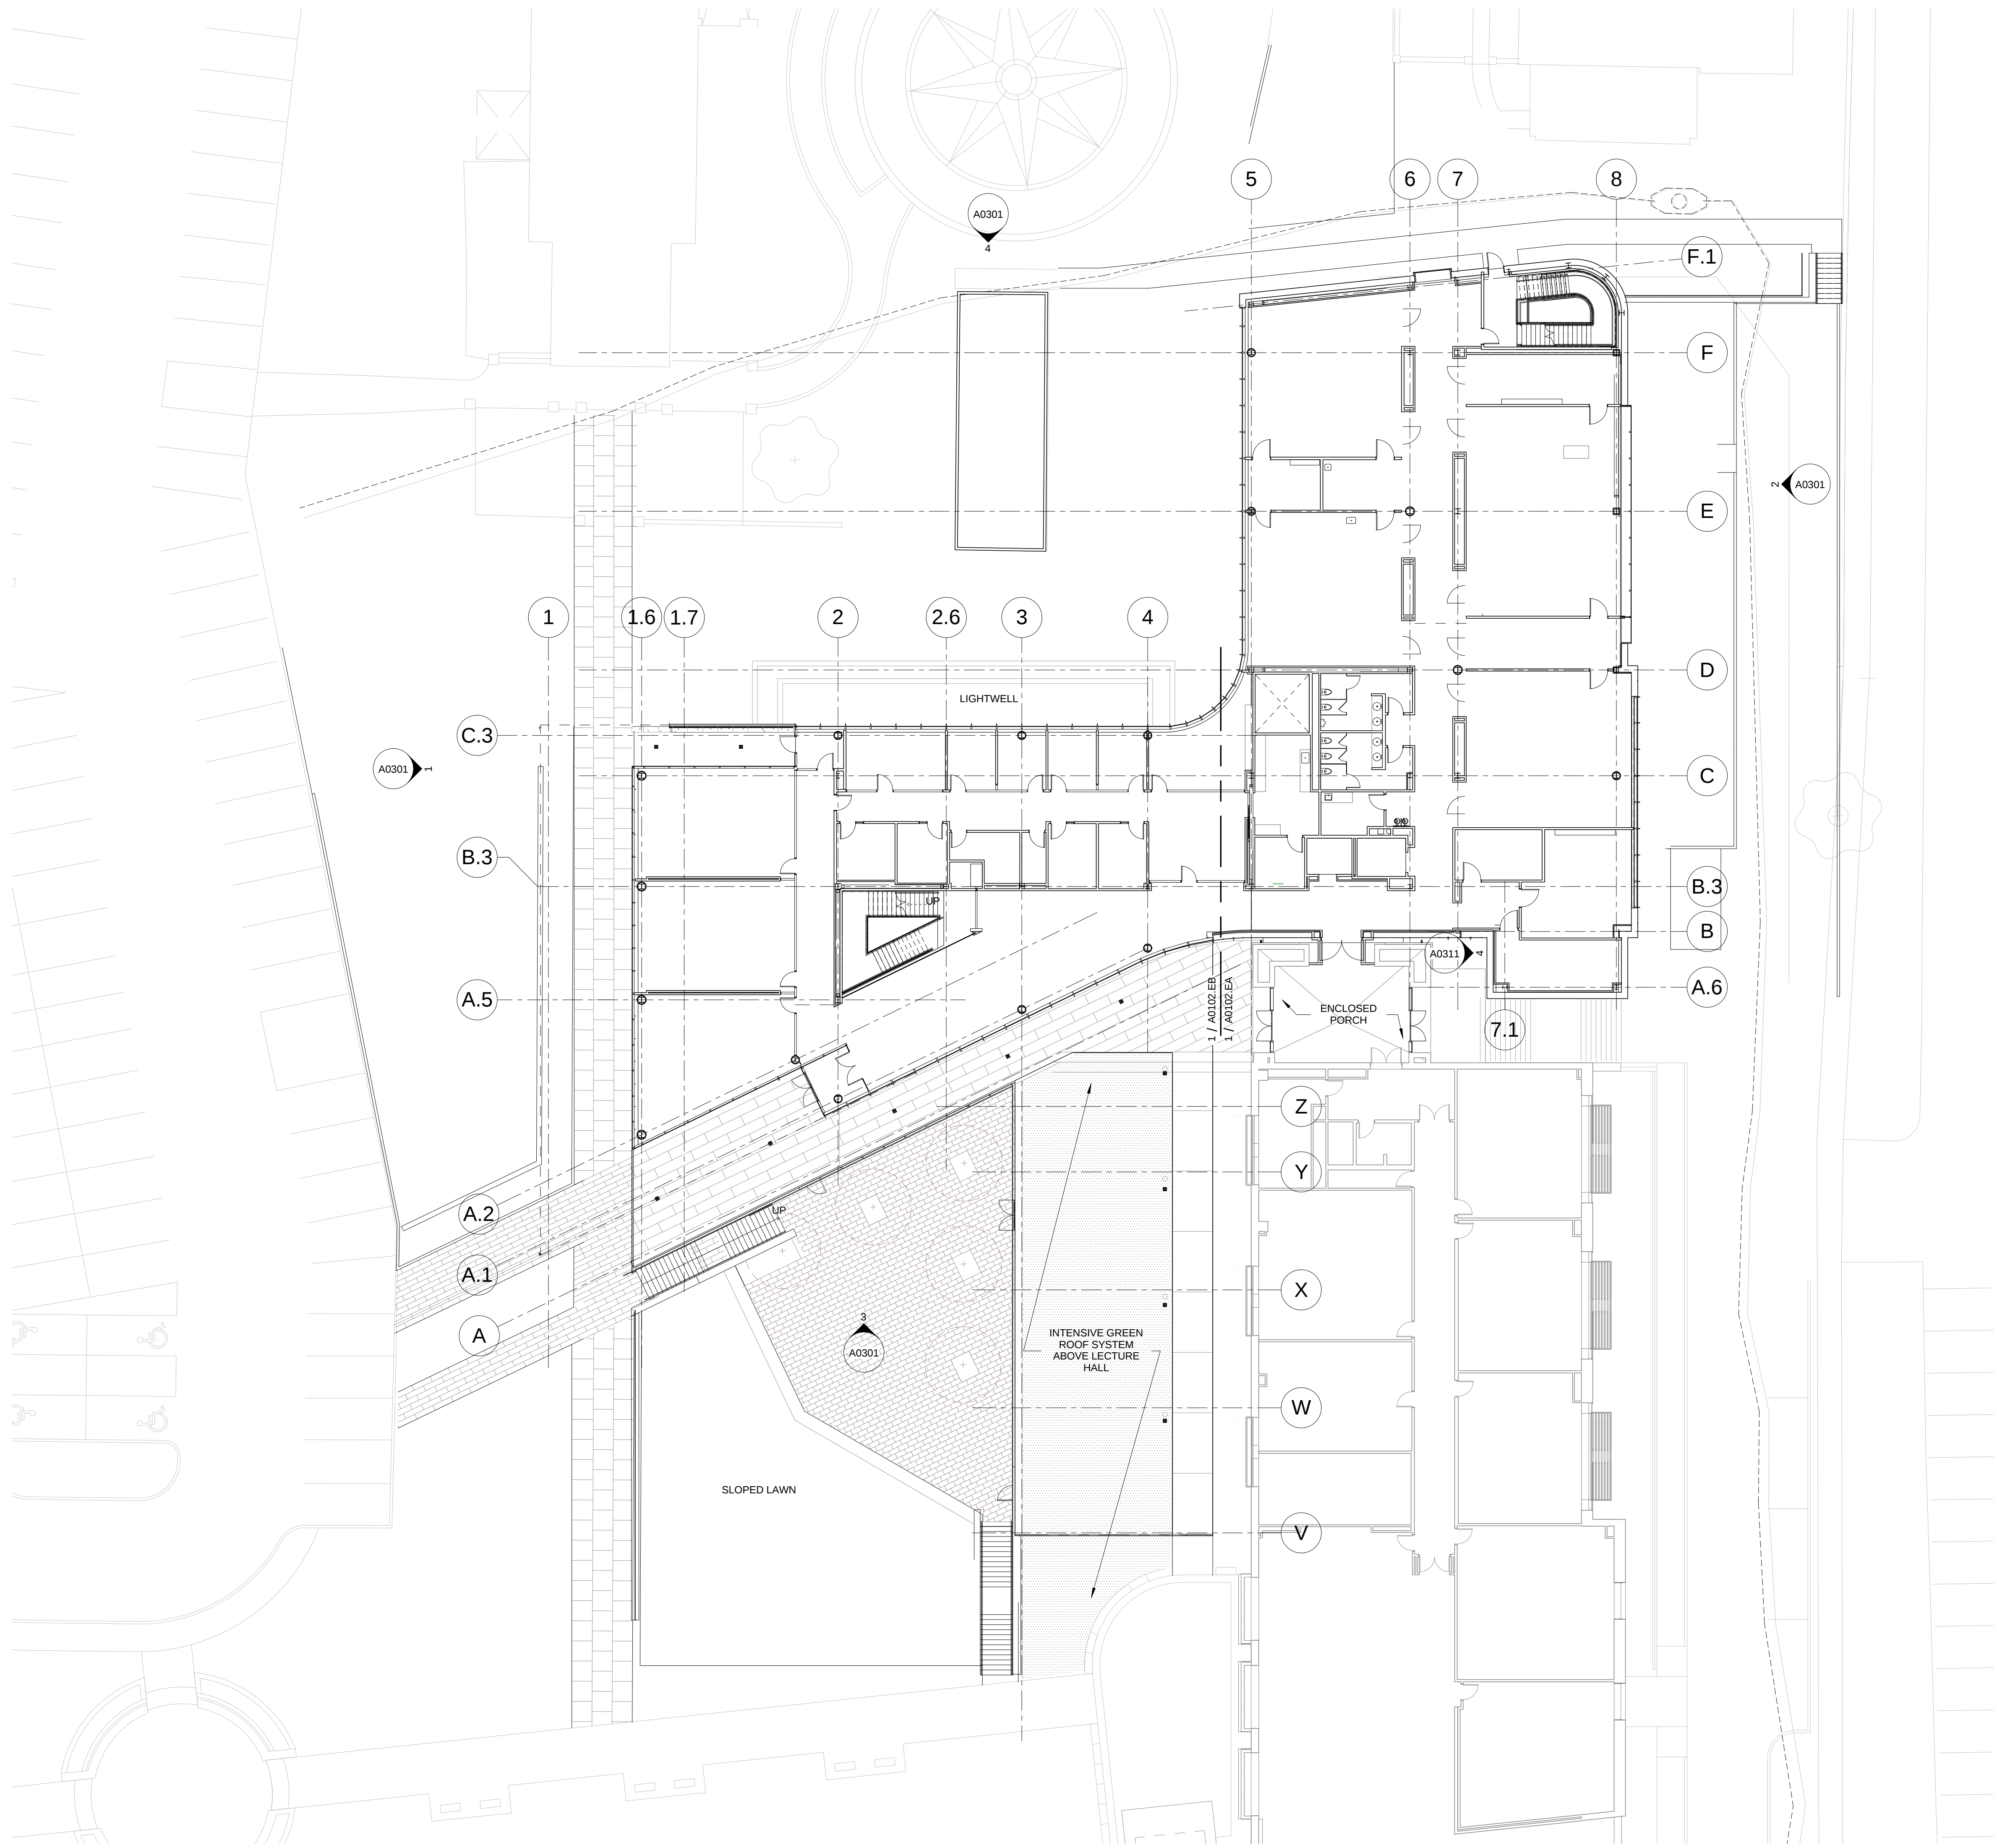

1 EXTERIOR - LEVEL 02
1/16" = 1'-0"



ISSUED FOR CONSTRUCTION (BP1) 15 JAN 2016
No. Description Date

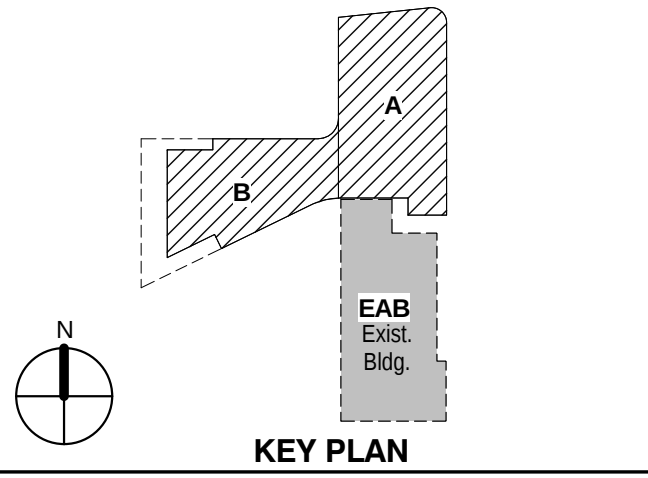

KEY PLAN

EXTERIOR - LEVEL 02
FLOOR PLAN

Project No.: 04561.01 Checked by:

A0102.E