




Kathy R. Williams
3.16.16

1	ADDENDUM 1-7	16 MAR 2016
1	ISSUED FOR CONSTRUCTION (BP1)	15 JAN 2016
No.	Description	Date

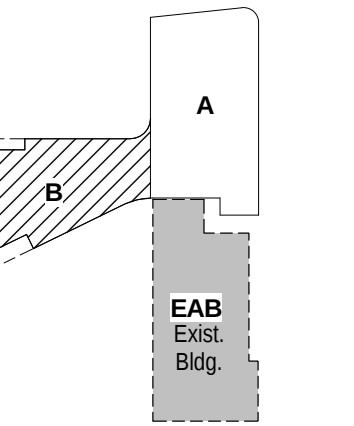

KEY PLAN

EXTERIOR - LEVEL 02
AREA B FLOOR PLAN

Project No.: 04561.01 Checked by:

A0102.EB

