



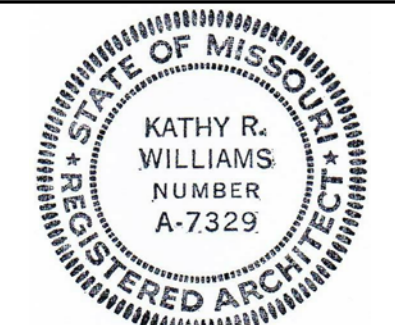

Kathy R. Williams
3.16.16

1	ADDENDUM 1-7	16 MAR 2016
1	ISSUED FOR CONSTRUCTION (BP1)	15 JAN 2016
No.	Description	Date

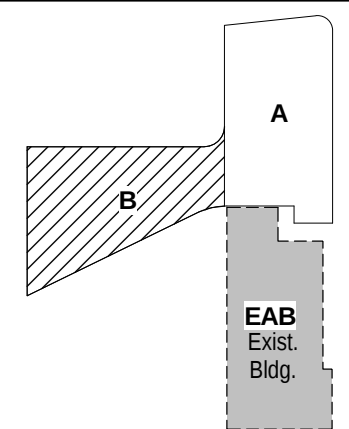

KEY PLAN


Drawing Title:

EXTERIOR - LEVEL 03
AREA B FLOOR PLAN

Project No.: 04561.01

Checked by:

A0103.EB

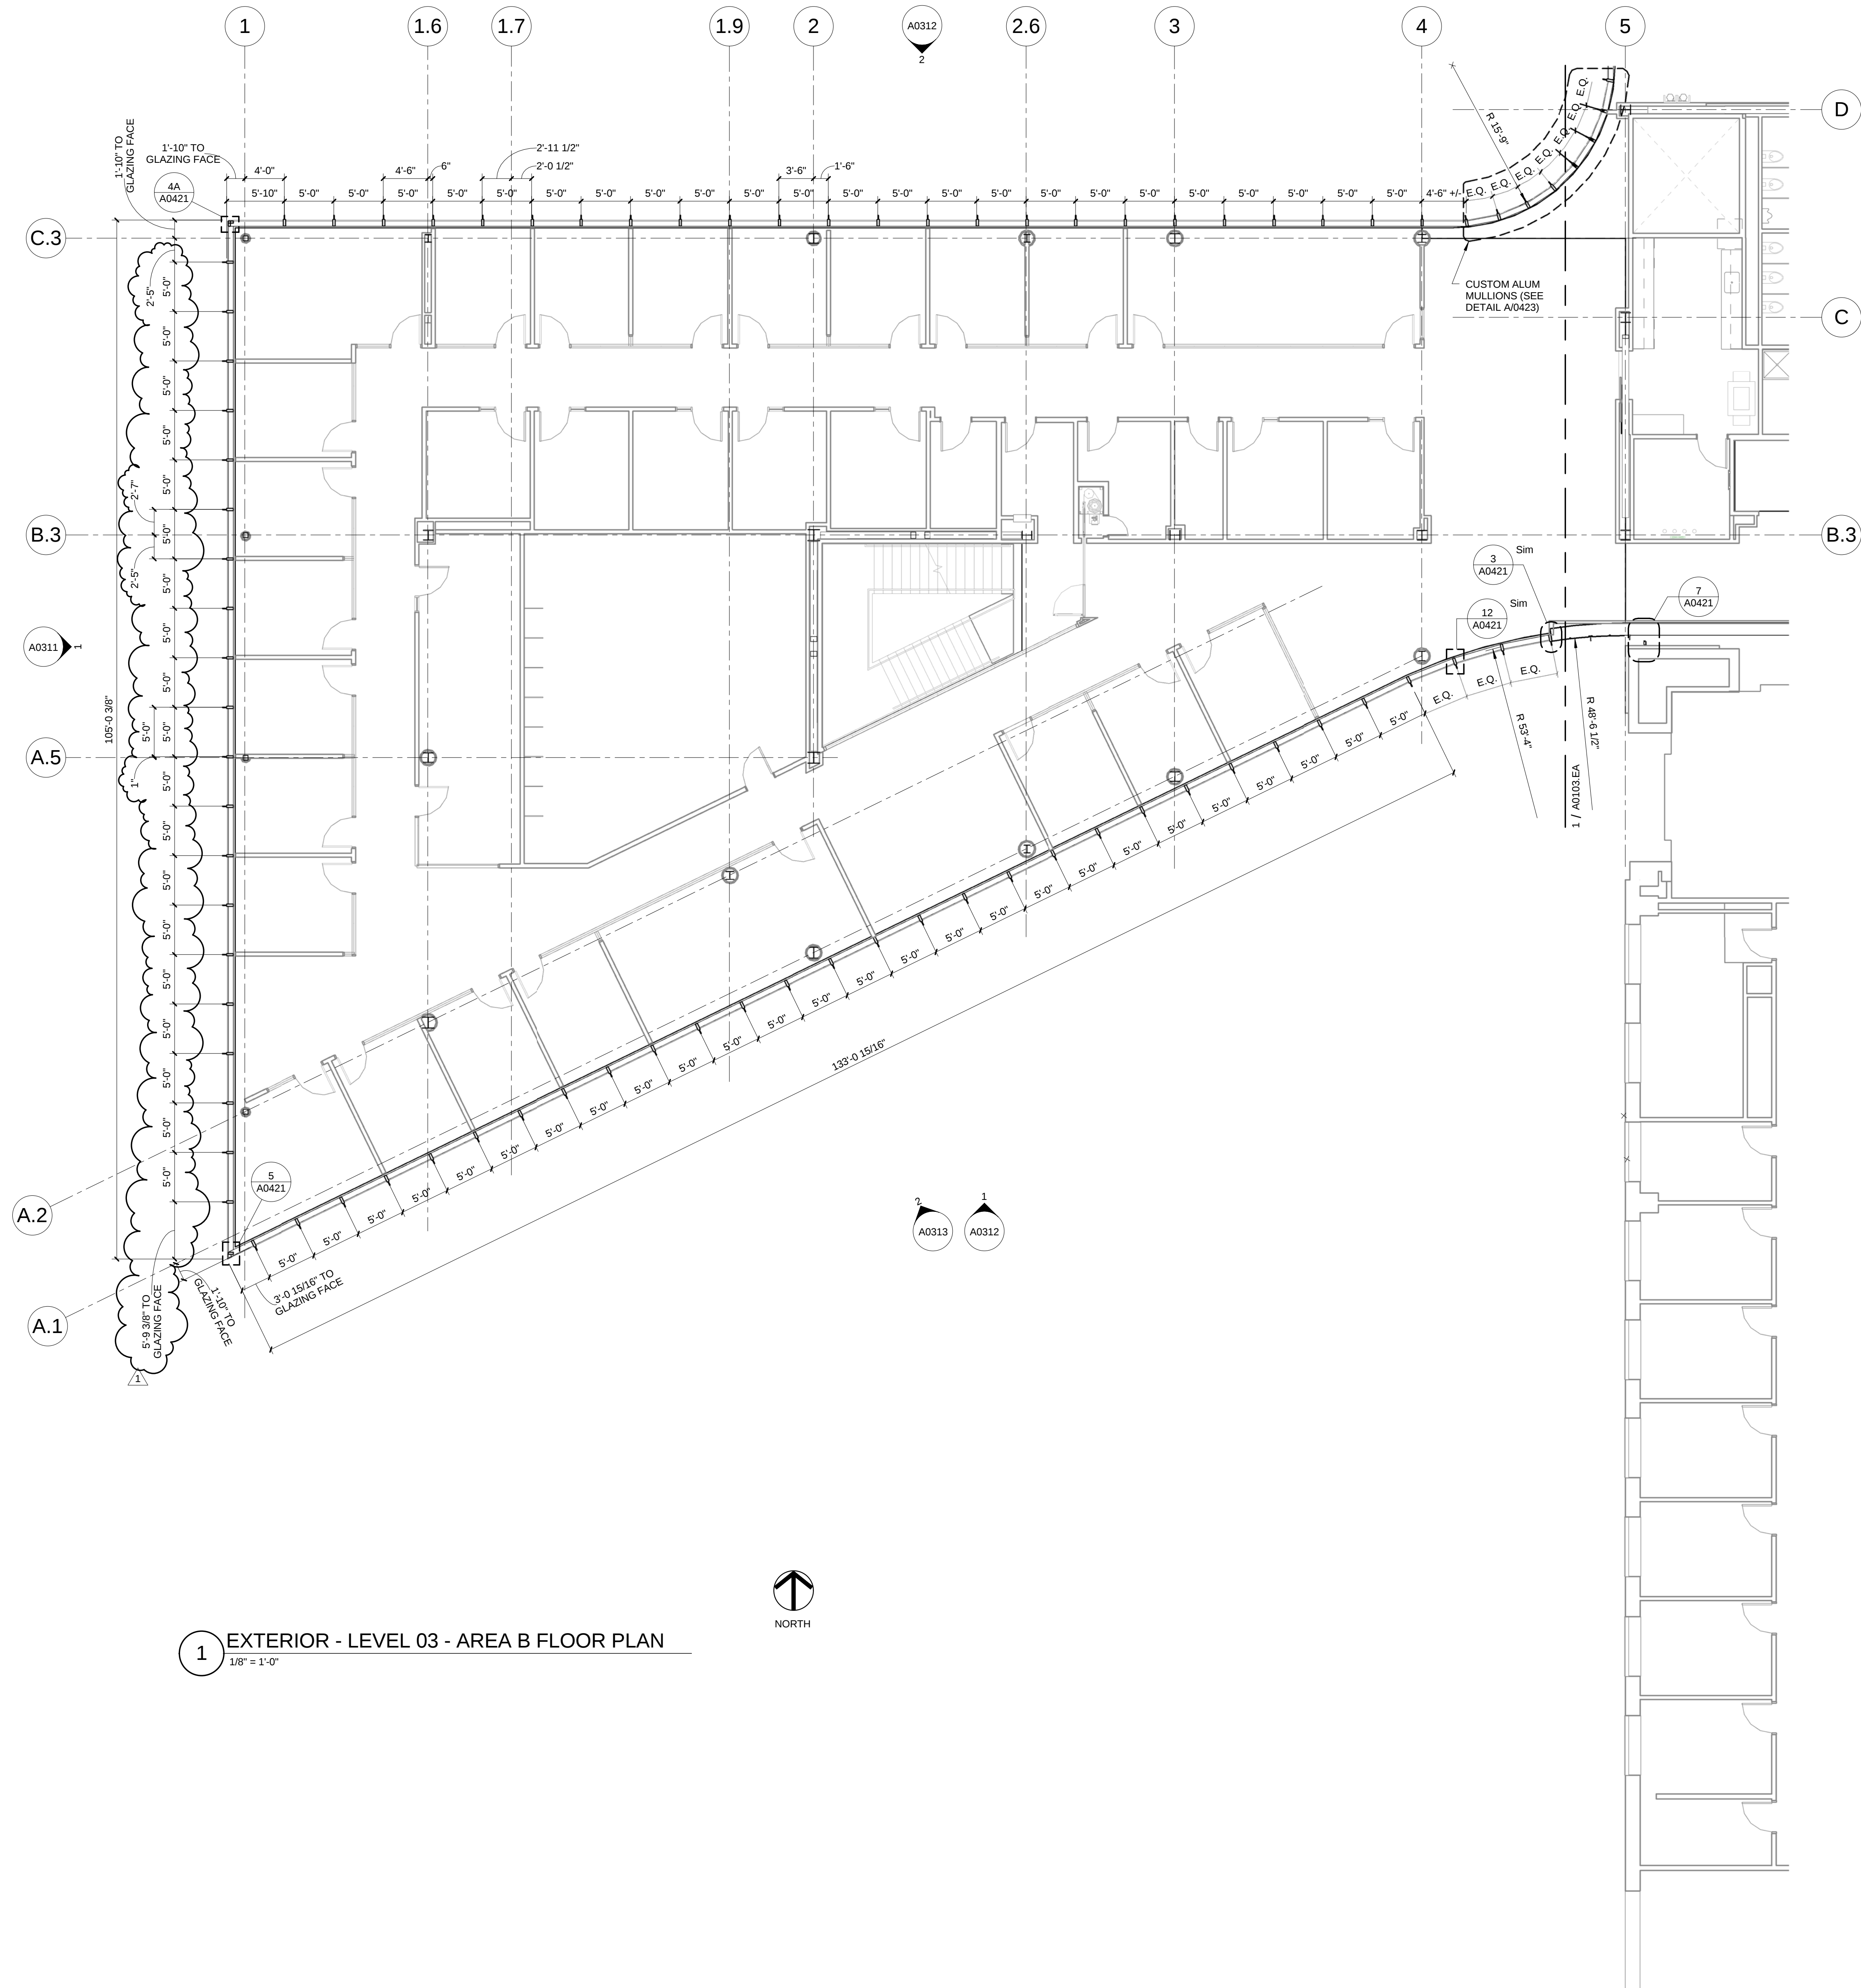

1 EXTERIOR - LEVEL 03 - AREA B FLOOR PLAN
1/8" = 1'-0"

