



CANNONDESIGN

1100 Clark Avenue
St. Louis, Missouri 63102
T: 314.241.6250
F: 314.241.2570

William Tao & Associates, Inc.
MEP/FP Engineer
7955 Manchester Road, Suite 12
St. Louis, MO 63143
314-884-7600

David Mason & Associates, Inc.
Structural & Civil Engineer
800 South Vandeventer Avenue
St. Louis, MO 63110
314.534.1053

**Faith Group
Technology**

St. Louis, MO 63143
314.991.2228

Kuhlmann Leavitt, Inc.
Environmental Graphics & Signage
7400 Pershing Ave
St. Louis, MO 63130
314.725.6616

KWA Architects
Architecture
9721 Litzinger Road
St. Louis, MO 63124
314.962.2580

Spellman Brady & Company
Interior Designer
3251 Maryland Avenue, Suite 300
St. Louis, MO 63105
314.862.0070

SWT Design
Landscape Architect
7722 Big Bend Blvd
St. Louis, MO 63119
314.644.5700

Webb Engineering Services, Inc.
Plumbing & Fire Protection
1400 S. 3rd Street, Suite 201
St. Louis, MO 63104
314.588.0600

KEYED NOTE LEGEND - PLAN

A.1 062705 GRC COLUMN COVER TO 3" ABOVE CEILING - 20" DIA. TYP. SEE DETAIL 4A0611D AND 15A0612

A.2 081216 INTERIOR GLAZING SYSTEM: IGS-1: REFER TO INTERIOR ELEVATIONS 1 AND 2 ON SHEET A6003

A.3 081216 INTERIOR GLAZING SYSTEM: IGS-2: SEE TYPICAL ELEVATION 5 AND A6003

A.4 081216 INTERIOR GLAZING SYSTEM: IGS-3: REFER TO INTERIOR ELEVATION 6

A.5 088813 FIRE RATED GLAZING - 120 MIN. FIRE RATED GLAZING 10" HIGH. BASIS OF DESIGN: VETROTECH CONTRAFRAMMAM STRUTTURA - WITH BUTT JOINTS AND PERIMETER FRAMING

A.6 088813 FIRE RATED GLAZING - 120 MIN. FIRE RATED GLAZING 1"8" HIGH X 5"9" HIGH. BASIS OF DESIGN: VETROTECH CONTRAFRAMMAM WITH PERIMETER FRAMING

A.7 111313 L.O.C. LAMP HOODS - 12" DIA. X 8" DEEP/14" PIT

A.8 ALTERNATING TREAD STAIRWAY UP TO ROOF HATCH

A.9 UNDERSLAB DRAINAGE SYSTEM PER OWNER'S GEOTECHNICAL CONSULTANT RECOMMENDATION TYPICAL ALL SLAB ON GRADE AREAS

A.11 NEW CONCRETE STEPS TO MATCH EXISTING REMOVED FOR CONSTRUCTION

A.12 553006 BRIDGE FACED CONCRETE DUMPTER ENCLOSURE TOP OF WALL

A.13 LCD SIGNAGE SCREEN IN WALL RECESS (OFCI)

A.14 MARKERBUOY SIGNAGE

A.15 WOOD SCREEN W/ SOLID LUMBER

A.16 VIDEO WALL - 24 "65" SCREENS

A.17 LCD SCREEN LOCATION (OFOI)

A.19 AIR PLENUM - INSULATED PLENUM CONSTRUCTION BY DIVISION 23

A.20 122200 CURTAIN LOCATION

A.21 104314 AED CABINET LOCATION

A.22 104413 FEC WITH FIRE EXTINGUISHER


A.23 064233 SLUSH SASH LOCATION: PROVIDE 1/4" TEMPERED CLEAR GLAZING AT INTERIOR FACE OF CURTAIN WALL MULLIONS FOR ACoustICAL SEPARATION.

A.24 6" x 8" FORMED CONCRETE TRENCH IN FLOOR W/ METAL PLATE CLOSURE PROVIDING 12" AIR GAP FOR TEMPERING


A.25 BUILT IN SLAT WATER FIRE FIGHT LOCATION. SIZE APPROX. 7'-6" X 2'-4" X 2'-8" HIGH. LOW IRON GLASS VIEW WINDOW ON CORRIDOR SIDE. GLASS DOOR ON SLAT SIDE. GLASS DOOR OPENING BELOW WINDOW W/ CABINET DOOR ACCESS ON LAB SIDE. FINISHED INTERIOR FACE OF WALLS AND CEILING INSIDE CAVITY W/ WATER RESISTANT GYP BOARD AND JOINT PAINT

A.26 LCD SIGNAGE SCREEN IN WALL RECESS (OFCI)

A.27 CONSTRUCT 2 HOUR RATED SEPARATION BETWEEN BOTTOM OF STAIR AND UTILITY PIPING CROSSING THIS AREA. USE HORIZ. GYP BD.

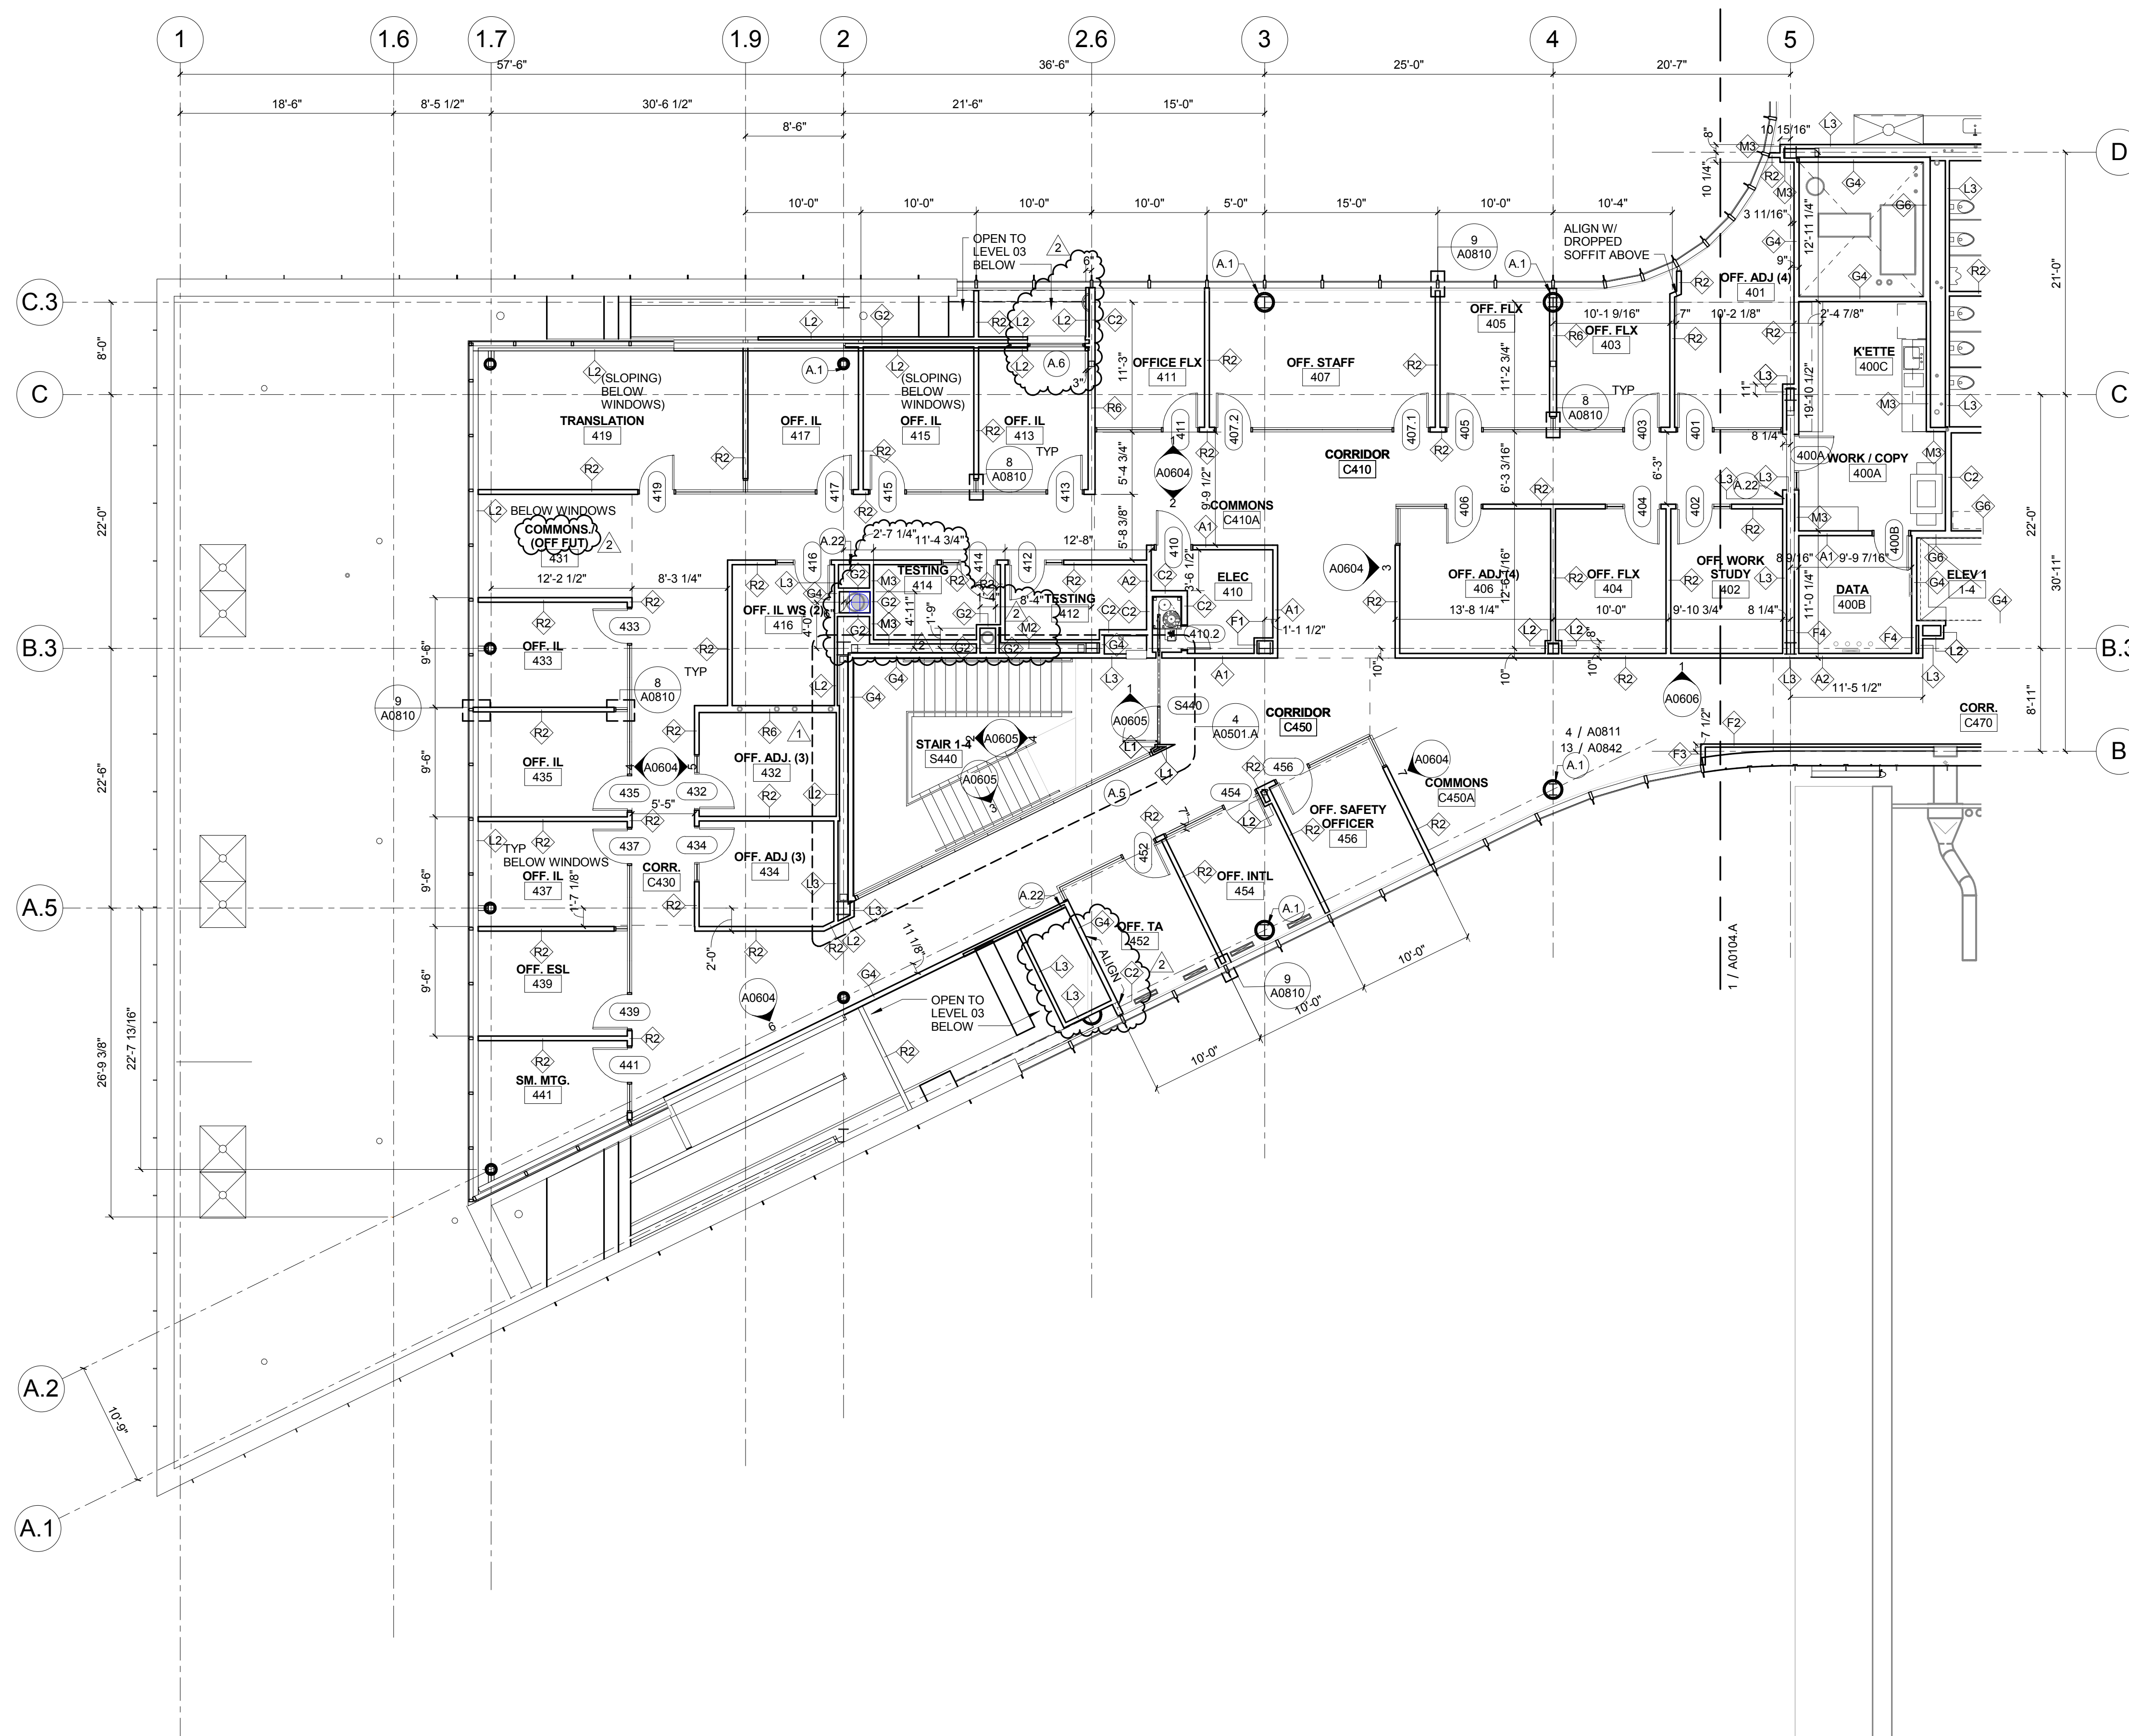

1 LEVEL 04- AREA B - WEST FLOOR PLAN
1/8" = 1'-0"

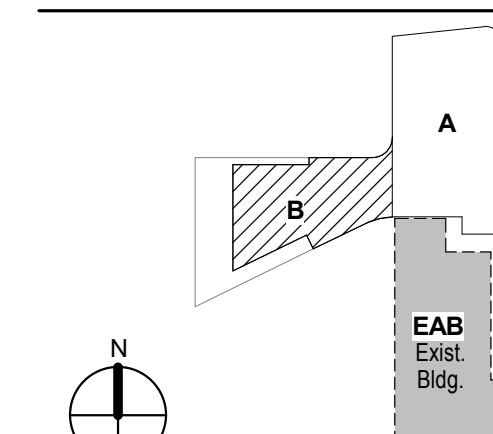

KEY PLAN

**LEVEL 04 AREA B FLOOR
PLAN**

Project No.: 04561.01
Checked by

A0104.B