



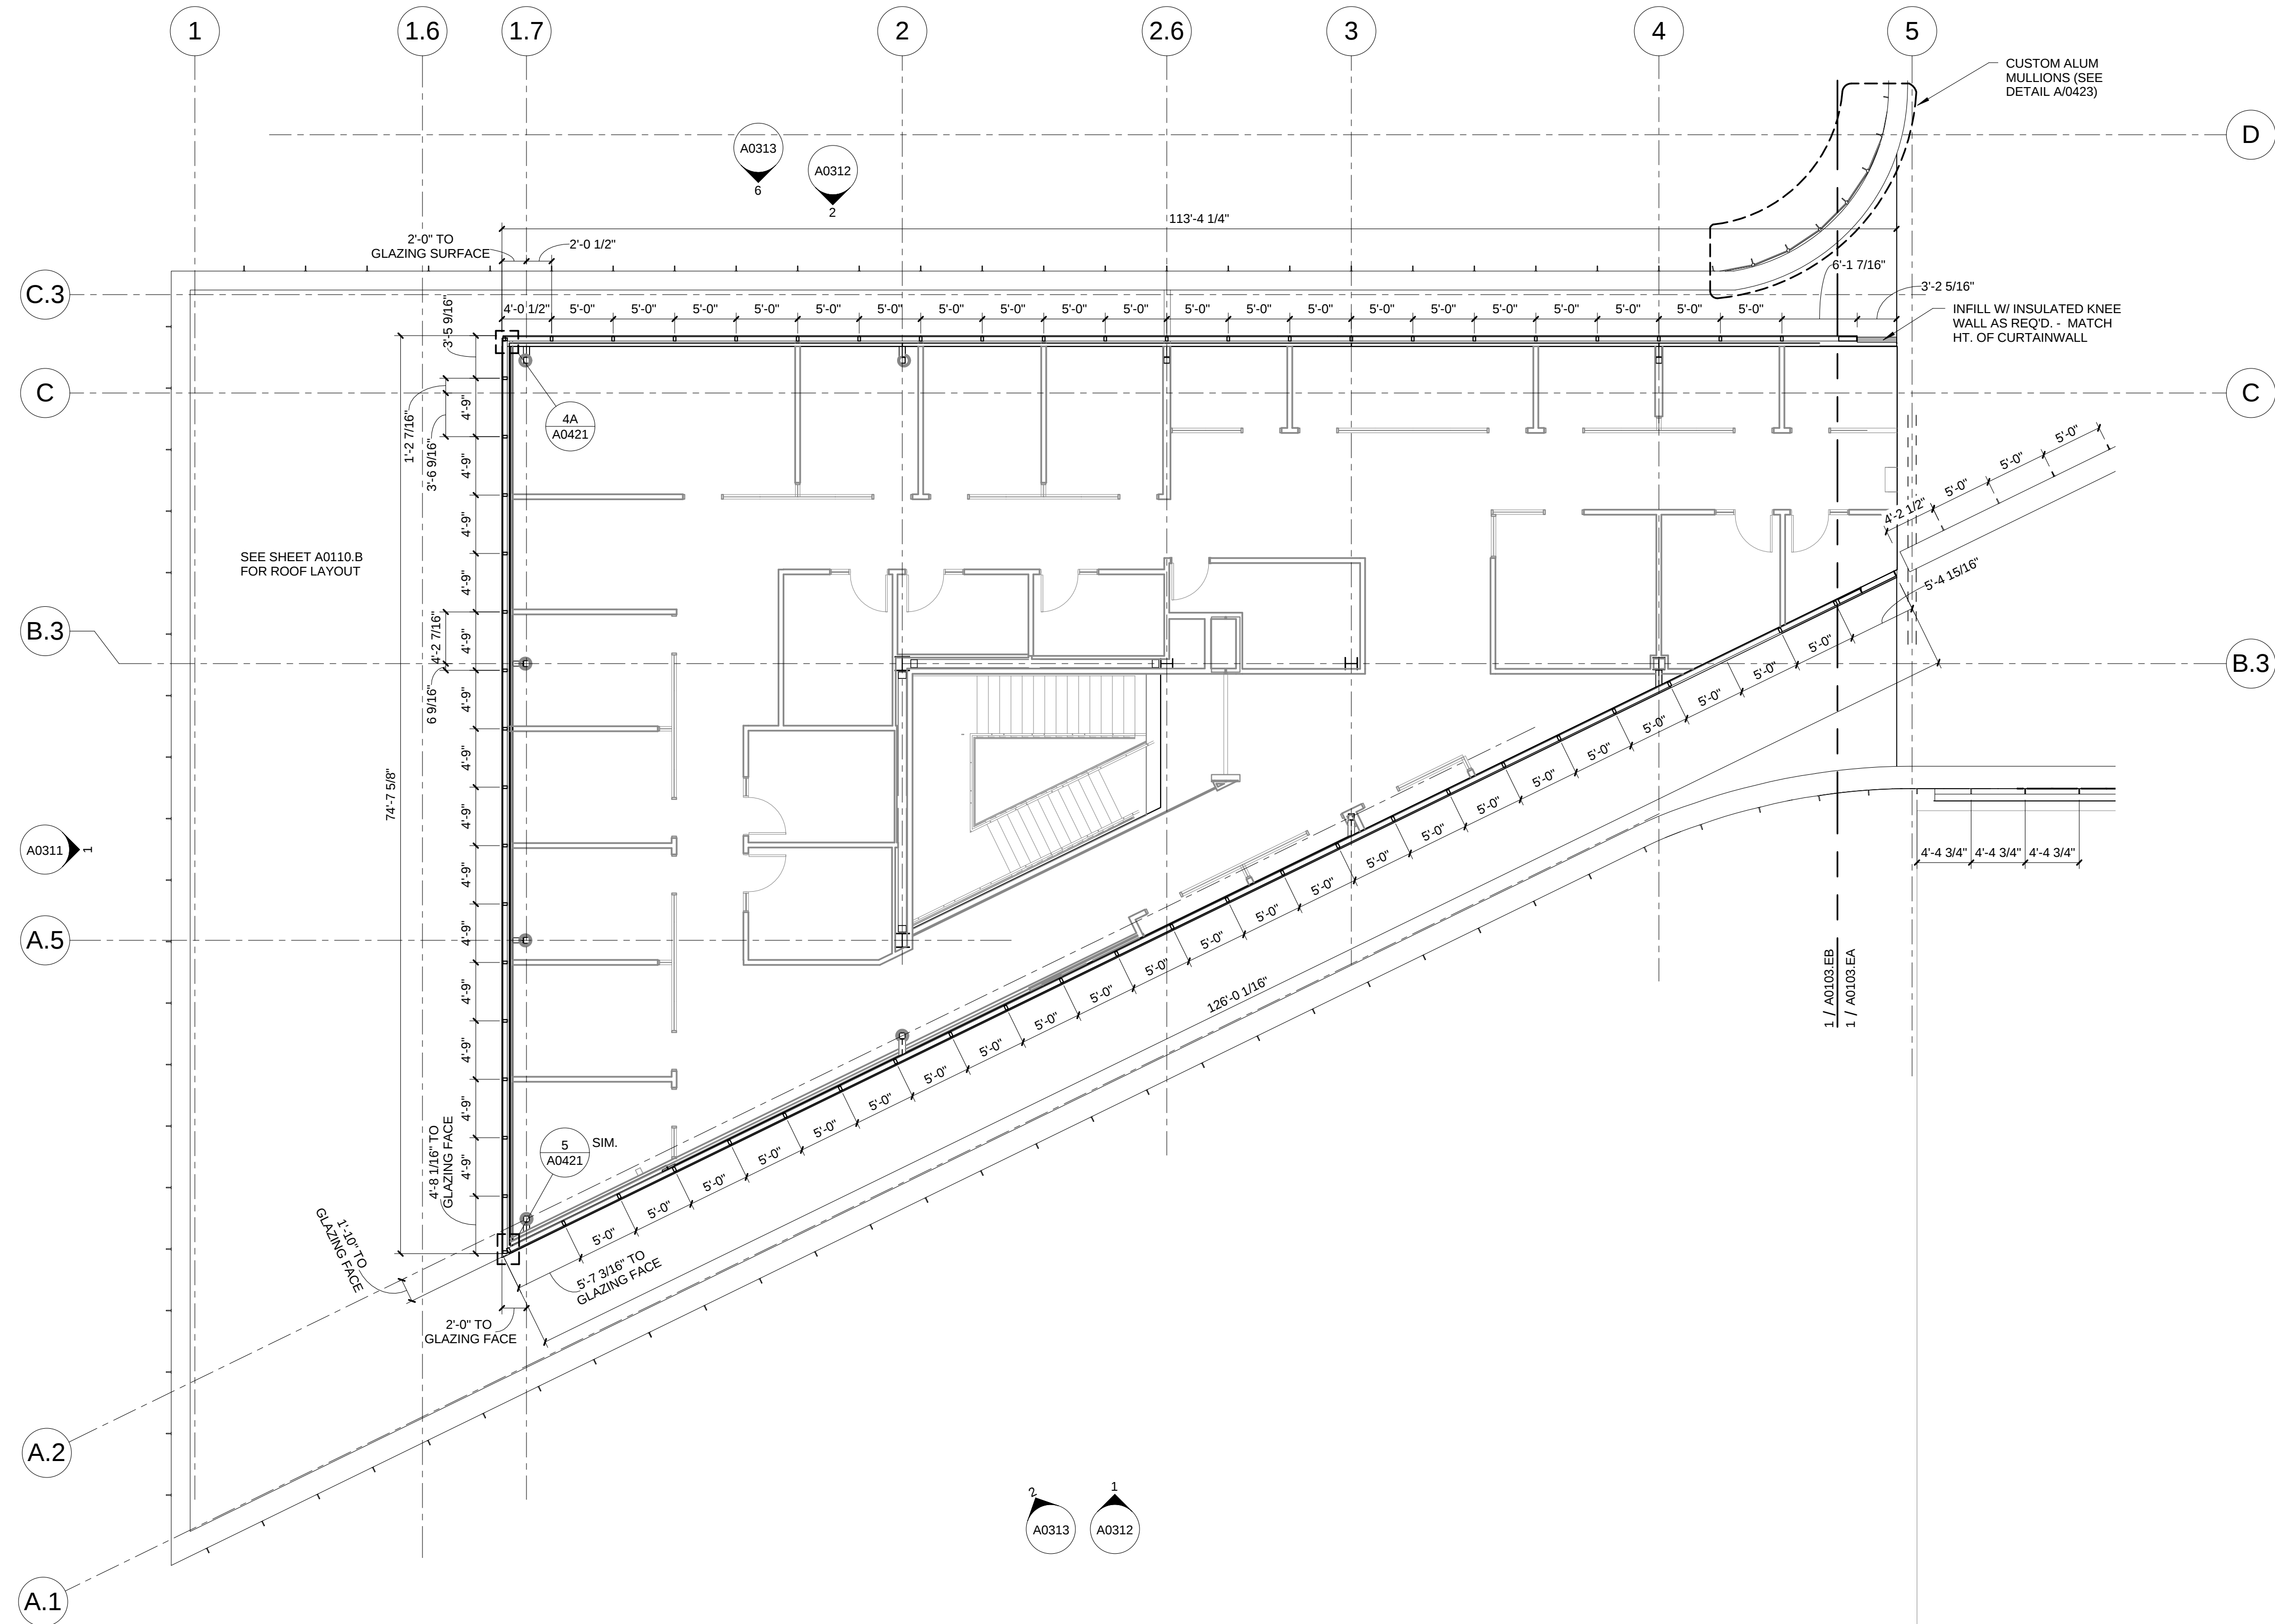

1 EXTERIOR - LEVEL 04 AREA B FLOOR PLAN
1/8" = 1'-0"

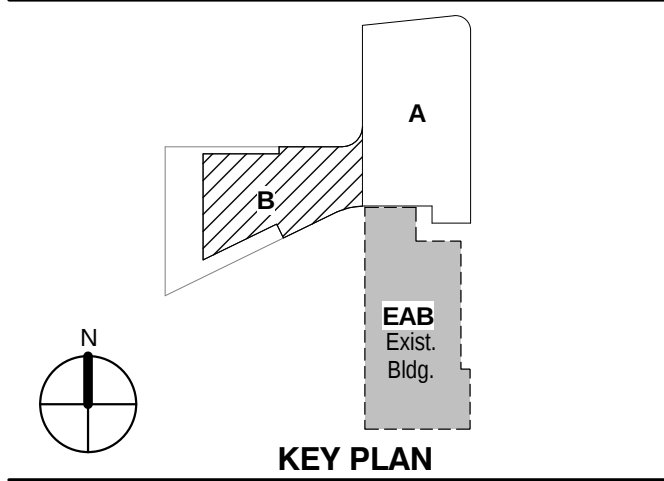