



- William Tao & Associates, Inc.**
MEP/FP Engineer
7955 Manchester Road, Suite 125
St. Louis, MO 63143
314-884-7600
- David Mason & Associates, Inc.**
Structural & Civil Engineer
800 South Vandeventer Avenue
St. Louis, MO 63110
314-534-1053
- Faith Group**
Technology
3101 S. Hanley Rd. Suite 100
St. Louis, MO 63143
314-991-2229
- Kuhnmann Leavitt, Inc.**
Environmental Graphics & Signage
7400 Pershing Ave.
St. Louis, MO 63130
314-725-6616
- KWA Architects**
Architecture
9721 Litzinger Road
St. Louis, MO 63124
314-962-2560
- Spellman Brady & Company**
Interior Designer
8251 Maryland Avenue, Suite 300
St. Louis, MO 63105
314-862-0070
- SWT Design**
Landscape Architect
7722 Big Bend Blvd
St. Louis, MO 63119
314-644-5700
- Webb Engineering Services, Inc.**
Planning & Fire Protection
1400 S. 3rd Street, Suite 201
St. Louis, MO 63104
314-588-0600

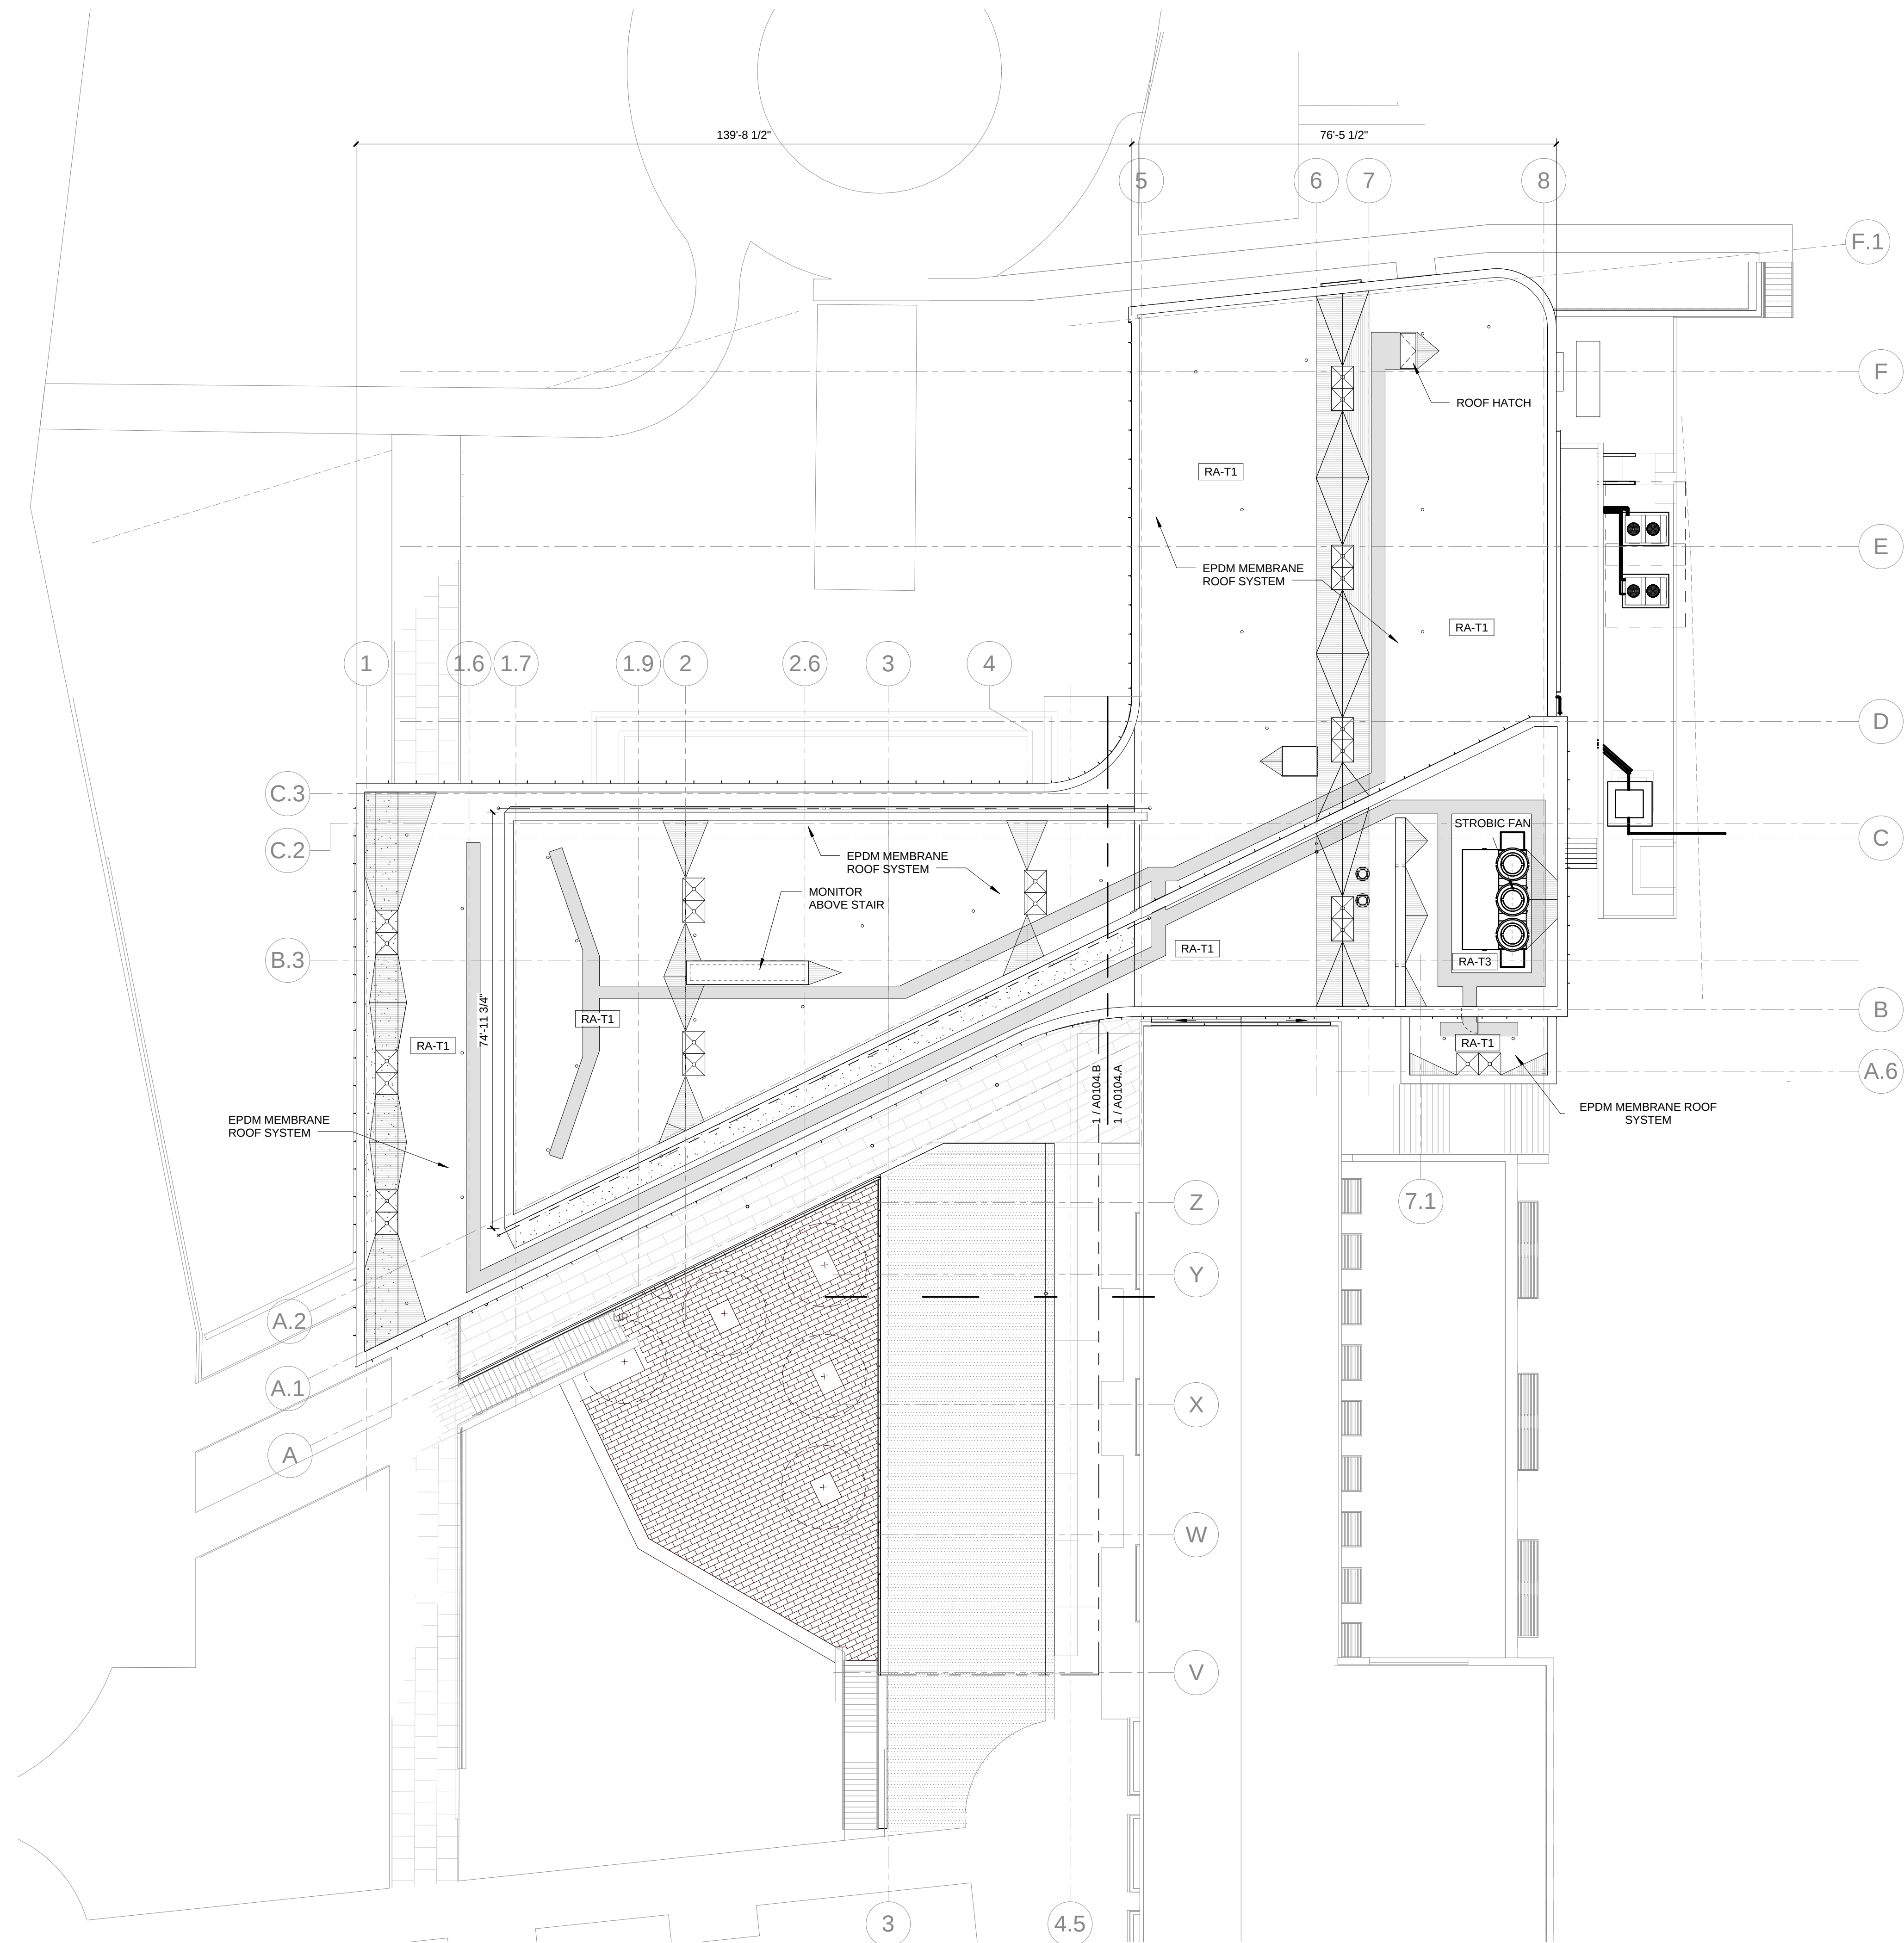

1 ROOF PLAN
1/16" = 1'-0"



ISSUED FOR CONSTRUCTION (BP1) 15 JAN 2016
No. Description Date

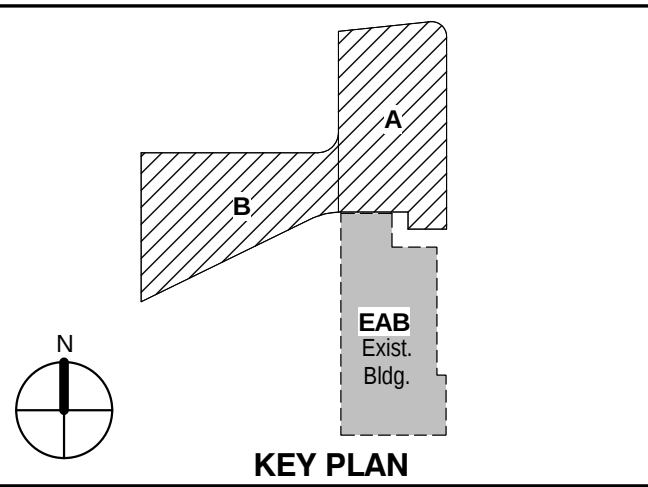

Drawing Title:

ROOF PLAN

Project No.: 04561.01 Checked by:

A0110