


1 ROOF- AREA A
1/8" = 1'-0"

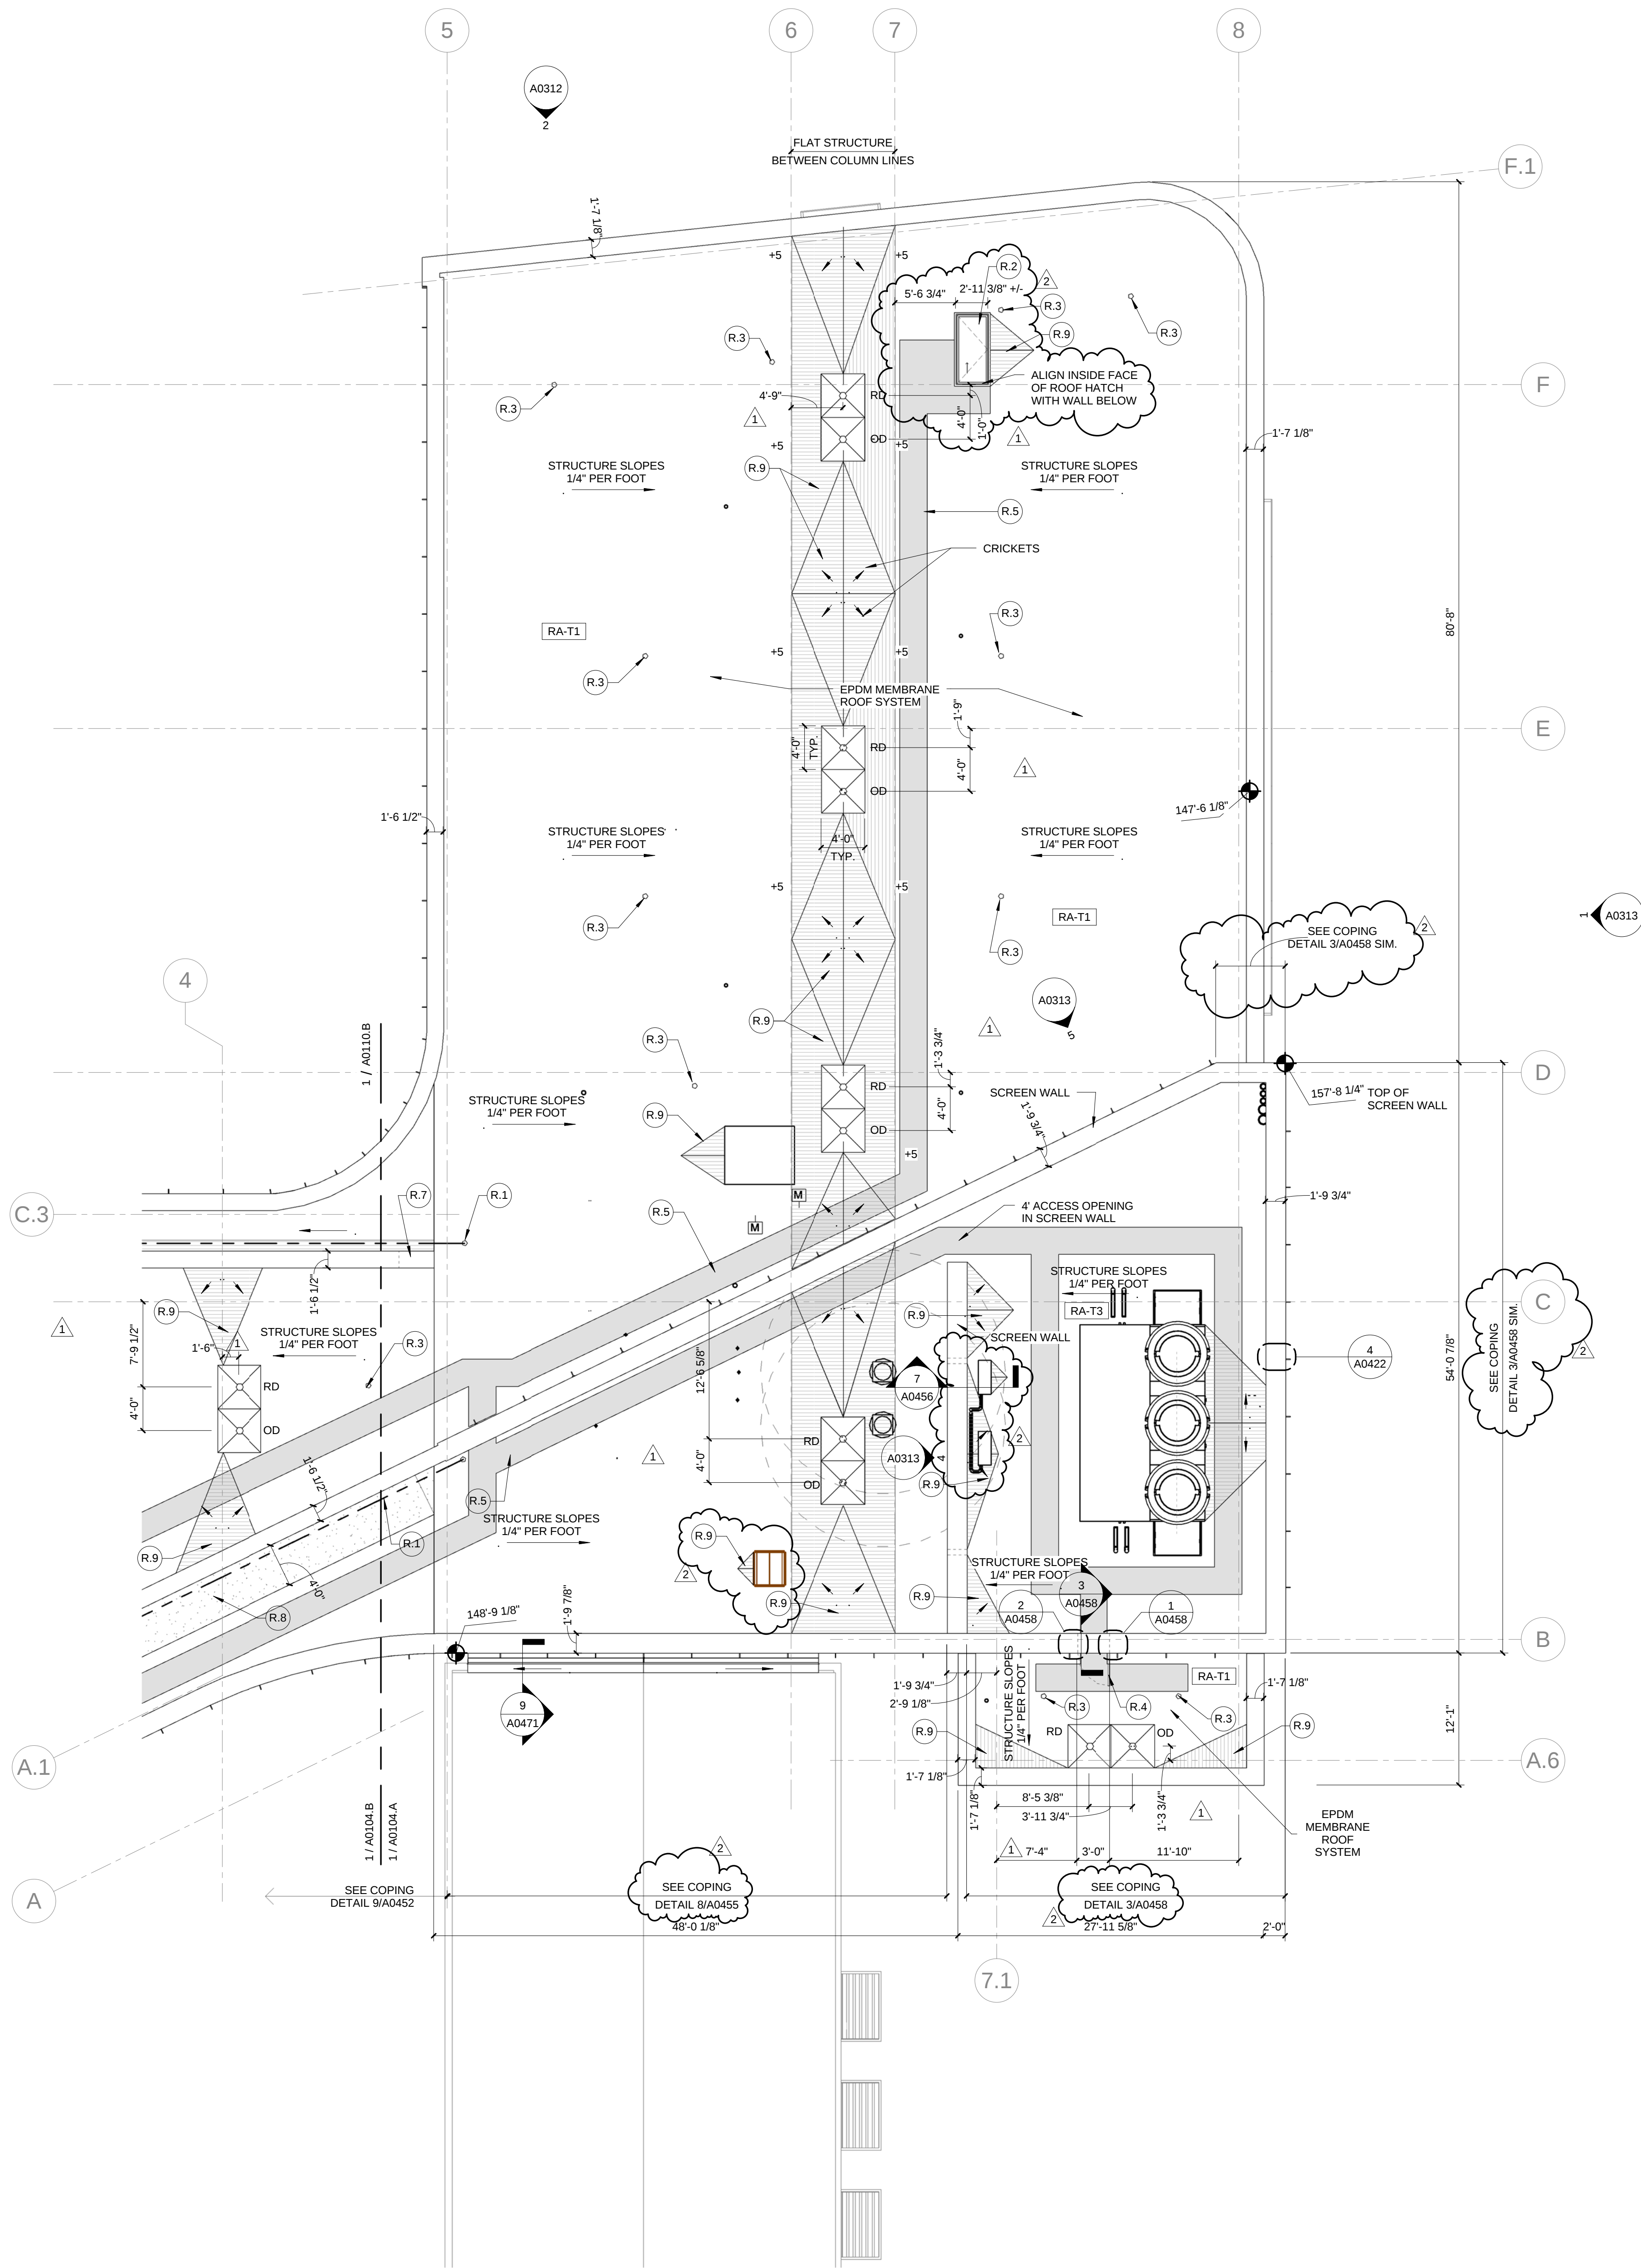

KEYED NOTE LEGEND - ROOF PLAN	
R.1	077200 LIFE SAFETY CABLE SYSTEM
R.2	077200 ROOF HATCH
R.3	077200 LIFE SAFETY TIE OFF
R.4	HINGED ACCESS PANEL/DOOR
R.5	WALK PADS
R.7	PROVIDE INSULATED KNEE WALL TO MATCH HEIGHT OF ESG-2 AS REQ'D.
R.8	CPMF FRAMED STICK-BUILT CRICKETS WITH PLYWOOD SHEATHING
R.9	075323 TAPERED INSULATION

- NOTES:
- SEE SHEET A0471 - FOR MISCELLANEOUS ROOFING DETAILS AS REQUIRED.
 - M.E.P. PENETRATIONS NOT SHOWN - COORDINATE WITH M.E.P. DOCUMENTS FOR LOCATIONS.
 - ROOF VAPOR BARRIER EXISTS ONLY ABOVE CONC. DECK AT RA-T3. SEE ROOF PLANS FOR LOCATION. TERMINATE VAPOR BARRIER WITH FLUID APPLIED AVB PER MANUFACTURER'S DETAILS.
 - ALL CRICKETS SHALL BE SLOPED 1/2\"/>

1100 Clark Avenue
St. Louis, Missouri 63102
T: 314.241.6250
F: 314.241.2570

William Tao & Associates, Inc.
MEP/FP Engineer
7955 Manchester Road, Suite 125
St. Louis, MO 63143
314-884-7600

David Mason & Associates, Inc.
Structural & Civil Engineer
800 South Vandeventer Avenue
St. Louis, MO 63110
314.534.1053

Faith Group
Technology
3101 S. Hanley Rd. Suite 100
St. Louis, MO 63143
314.991.2229

Kuhnmann Leavitt, Inc.
Environmental Graphics & Signage
7400 Pershing Ave.
St. Louis, MO 63130
314.725.6616

KWA Architects
Architecture
9721 Litzinger Road
St. Louis, MO 63124
314.962.2560

Spellman Brady & Company
Interior Designer
8251 Maryland Avenue, Suite 300
St. Louis, MO 63105
314.862.0070

SWT Design
Landscape Architect
7722 Big Bend Blvd
St. Louis, MO 63119
314.644.5700


Webb Engineering Services, Inc.
Plumbing & Fire Protection
1400 S. 3rd Street, Suite 201
St. Louis, MO 63104
314.588.0600



Kathy R. Williams
3.16.16

2	ADDENDUM 1-7	16 MAR 2016
1	ADDENDUM 1-1	29 JAN 2016
1	ISSUED FOR CONSTRUCTION (BP1)	15 JAN 2016

No.	Description	Date
-----	-------------	------

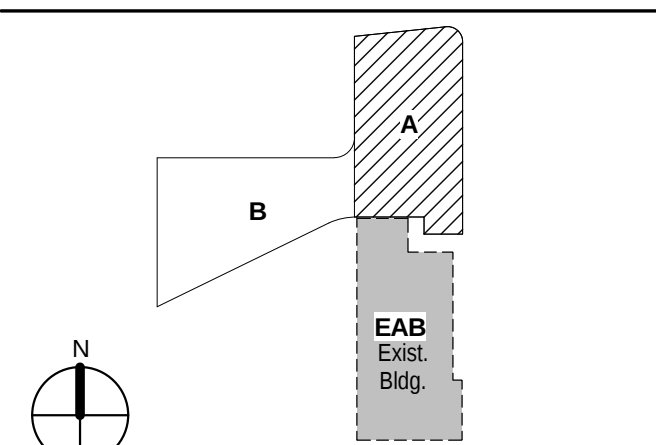

KEY PLAN

Drawing Title:

ROOF PLAN-AREA A

Project No.: 04561.01 Checked by:

A0110.A