



KEYED NOTE LEGEND - PLAN


- A.1 002700 GRG COLUMN COVER TO 3" ABOVE CEILING - 20" DIA. TYP. SEE DETAIL 4A0811 AND 13A0842
- A.2 081216 INTERIOR GLAZING SYSTEM: IGS-1: REFER TO TYPICAL INT. ELEVATIONS 1 AND 2 ON SHEET A0603
- A.3 081216 INTERIOR GLAZING SYSTEM IGS-2: SEE TYPICAL ELEVATION 5 AND 6 A0603
- A.4 081216 INTERIOR GLAZING SYSTEM: IGS-3: REFER TO INTERIOR ELEVATIONS
- A.5 088813 FIRE RATED GLAZING- 120 MIN. FIRE RATED GLAZING 10'-0" HIGH. BASIS OF DESIGN: VETROTECH CONTRAFILAMM STRUTTURA - WITH BUTT JOINTS AND PERIMETER FRAMING.
- A.6 088813 FIRE RATED GLAZING AND FRAME- 120 MIN. FIRE RATED GLAZING 1'-8" HIGH X 5'-0" WIDE. BASIS OF DESIGN: VETROTECH CONTRAFILAMM WITH PERIMETER FRAMING.
- A.7 111519 LOADING DOCK LIFT - STATIONARY - 6W X 8' DEEP/W/ 14" PIT
- A.8 ALTERNATING TREAD STAIRWAY UP TO ROOF HATCH
- A.9 UNDERSLAB DRAINAGE SYSTEM PER OWNER'S GEOTECHNICAL CONSULTANT RECOMMENDATION TYPICAL ALL SLAB ON GRADE AREAS
- A.11 NEW CONCRETE STEPS TO MATCH EXISTING REMOVED FOR CONSTRUCTION
- A.12 553006 BRICK FACED CONCRETE DUMPSTER ENCLOSURE TOP OF WALL
- A.13 LCD SIGNAGE SCREEN IN WALL RECESS (OFCI)
- A.14 MARKERSBOARD SURFACE
- A.15 WOOD SCREEN W/ SOLID LUMBER
- A.17 VIDEO WALL - 24 55" SCREENS
- A.18 LCD SCREEN LOCATION (OFCI)
- A.19 AIR PLENUM - INSULATED PLENUM CONSTRUCTION BY DIVISION 23
- A.20 122200 CURTAIN LOCATION
- A.21 104313 AED CABINET LOCATION
- A.22 10 4413 FEC WITH FIRE EXTINGUISHER
- A.23 08 4423 SULL. SASH LOCATION: PROVIDE 1/4" TEMPERED CLEAR GLAZING AT INTERIOR FACE OF CURTAIN WALL MULLIONS FOR ACOUSTICAL SEPARATION.
- A.24 6" X 8" FORMED CONCRETE TRENCH IN FLOOR W/ METAL PLATE COVER. PROVIDE BLIND SIDE WATERPROOFING
- A.25 BUILT IN SALT WATER FISH TANK LOCATION. SIZE APPROX. 7'-6" X 2'-4" X 2'-6" HIGH. LOW IRON GLASS VIEW WINDOW ON CORRIDOR SIDE. SLIDING DOOR ON LAB SIDE. FISH TANK EQUIPMENT BELOW TANK W/ CABINET DOOR ACCESS ON LAB SIDE. FINISHED INTERIOR FACE OF WALLS AND CEILING INSIDE CAVITY W/ WATER RESISTANT GYP BOARD AND EPOXY PAINT
- A.26 LCD SIGNAGE SCREEN IN WALL RECESS (OFCI)
- A.27 CONSTRUCT 2 HOUR RATED SEPARATION BETWEEN BOTTOM OF STAIR AND UTILITY PIPING CROSSING THIS AREA. USE HORIZ. GYP BD. ENCLOSURE ON SHEET A1002

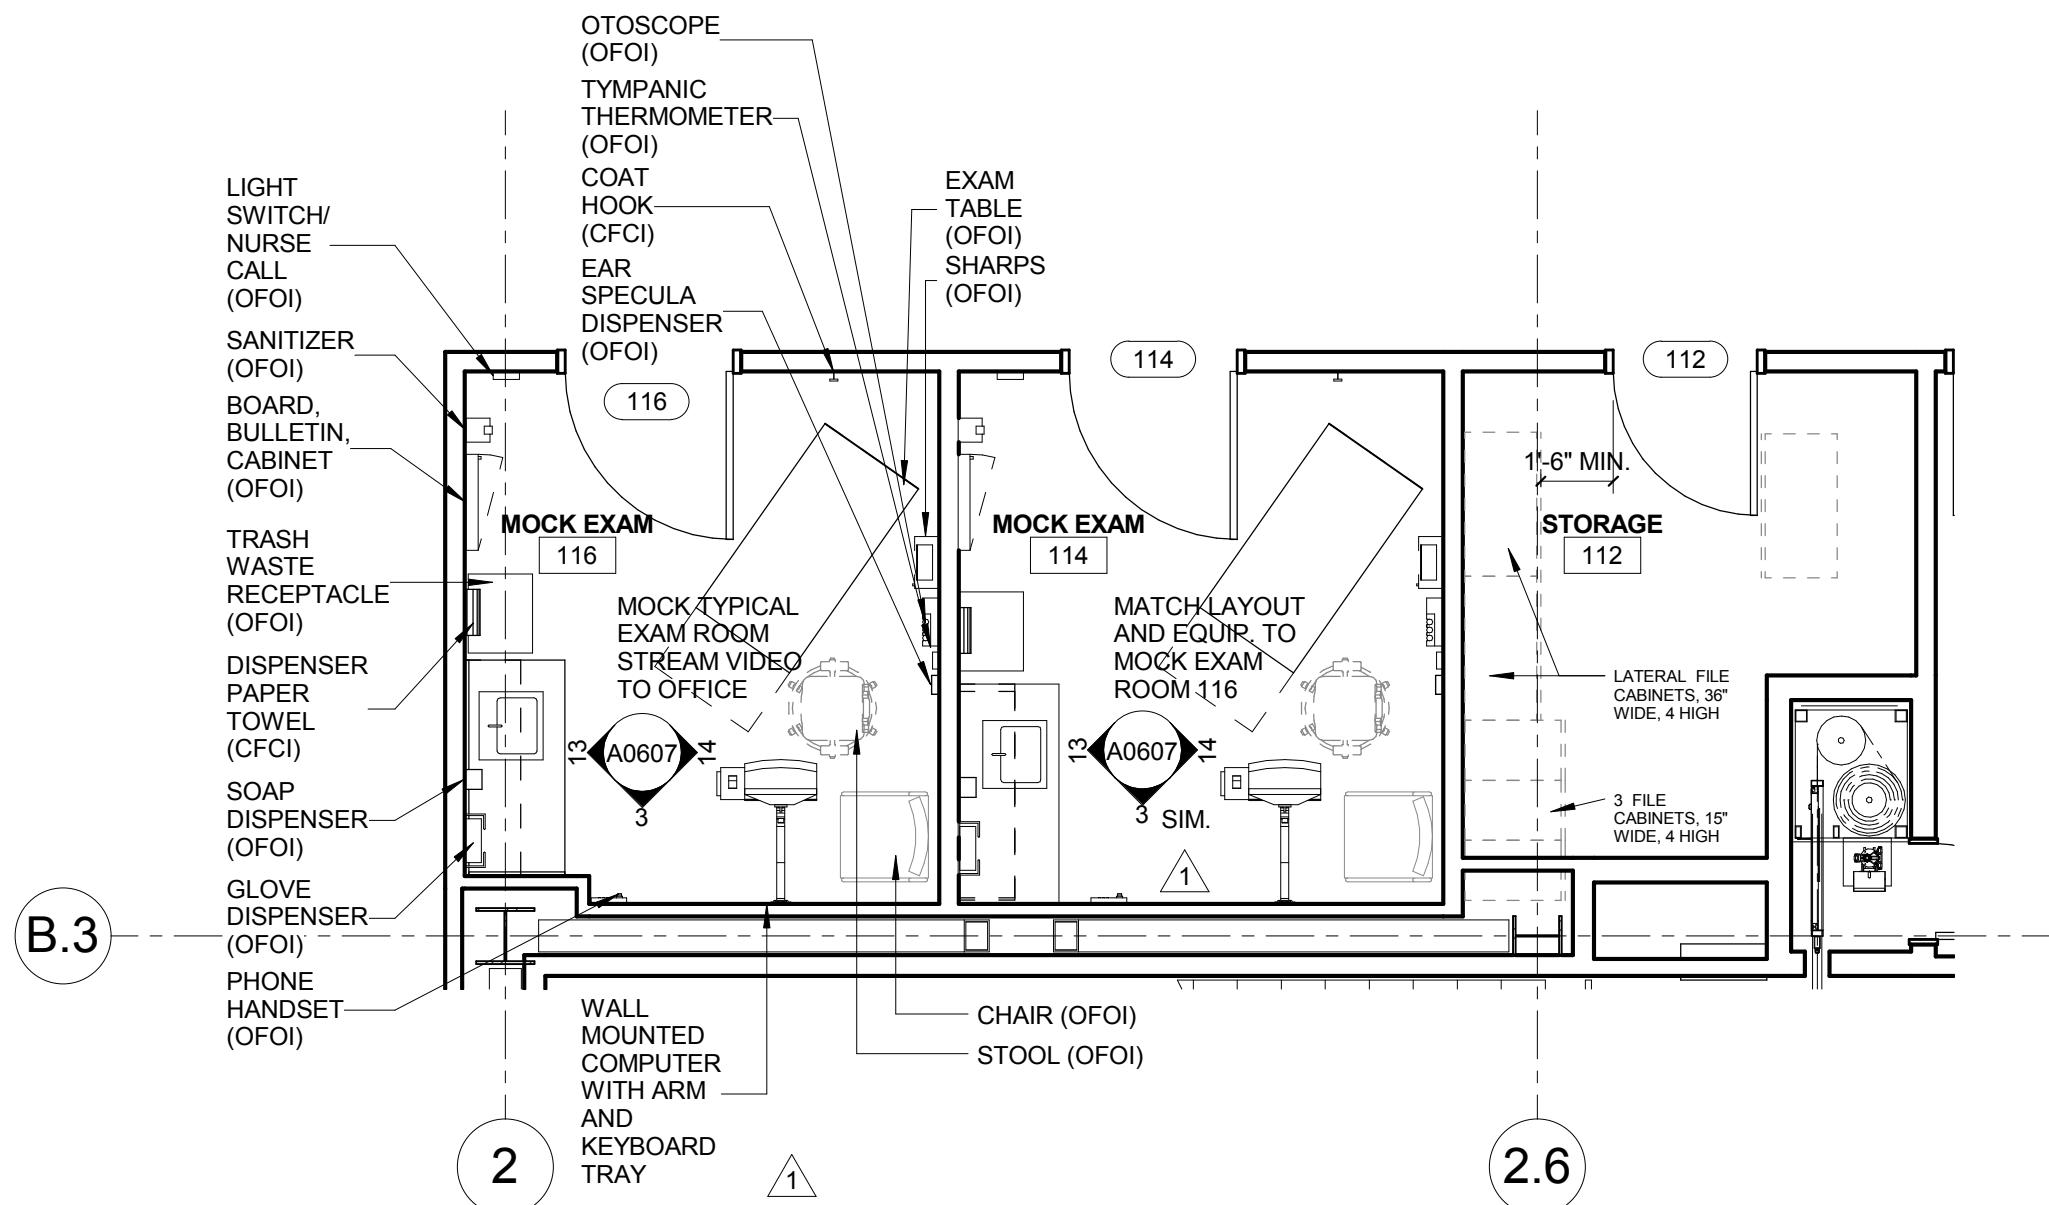

3 LEVEL 01 - AREA B-WEST - MOCK EXAM ROOMS
1/4" = 1'-0"

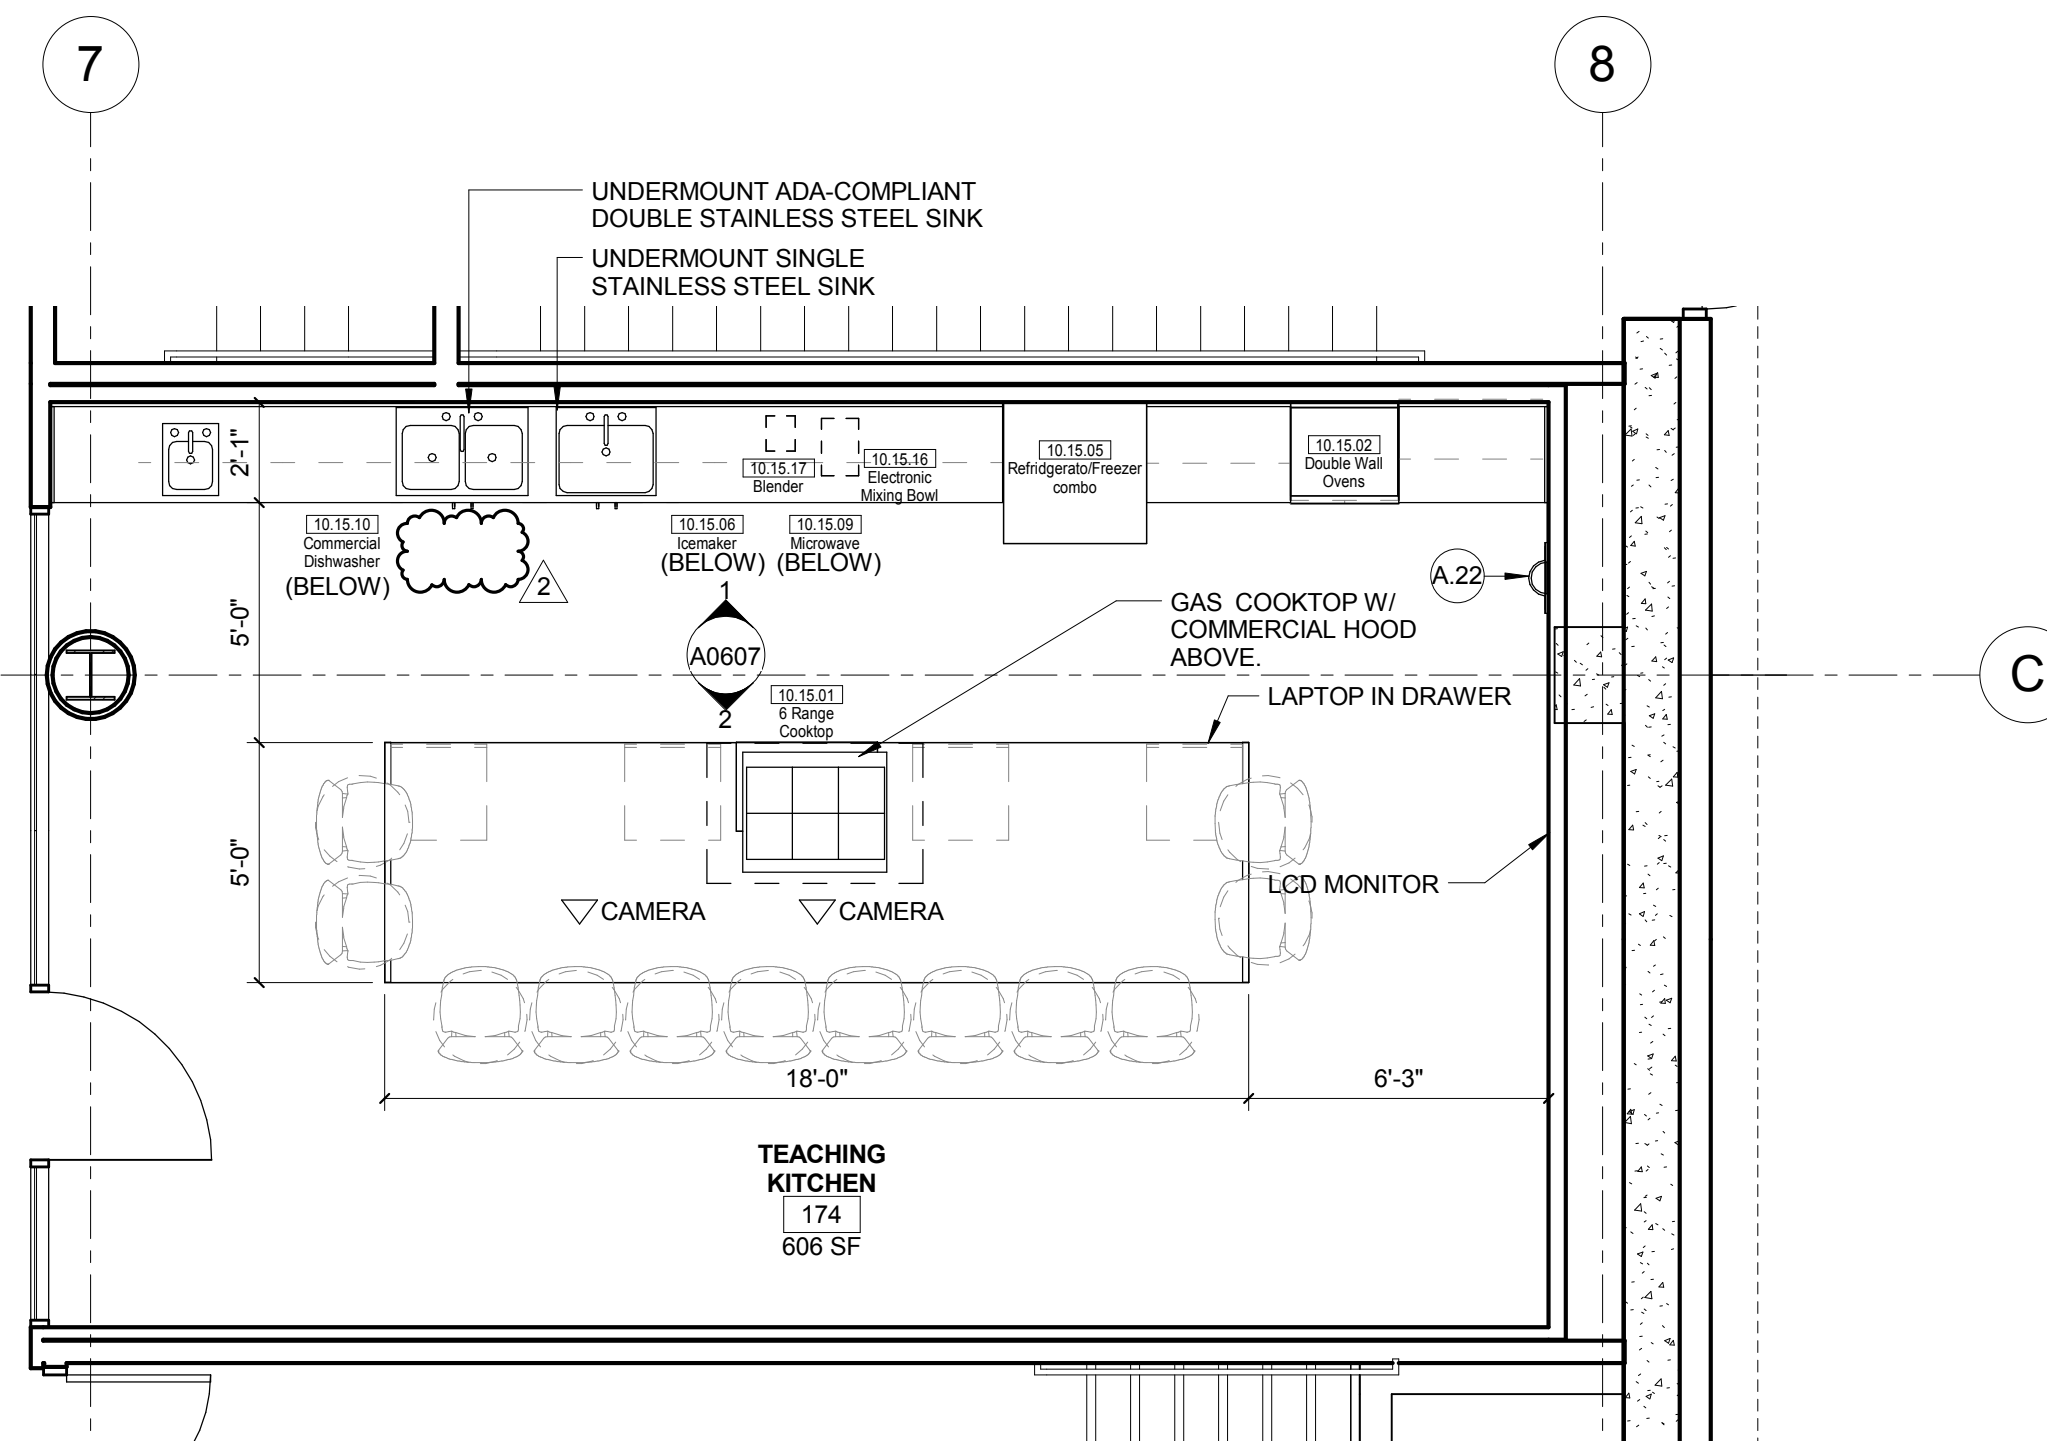

2 LEVEL 01 AREA A FLOOR PLAN-NORTH - TEACHING KITCHEN
1/4" = 1'-0"

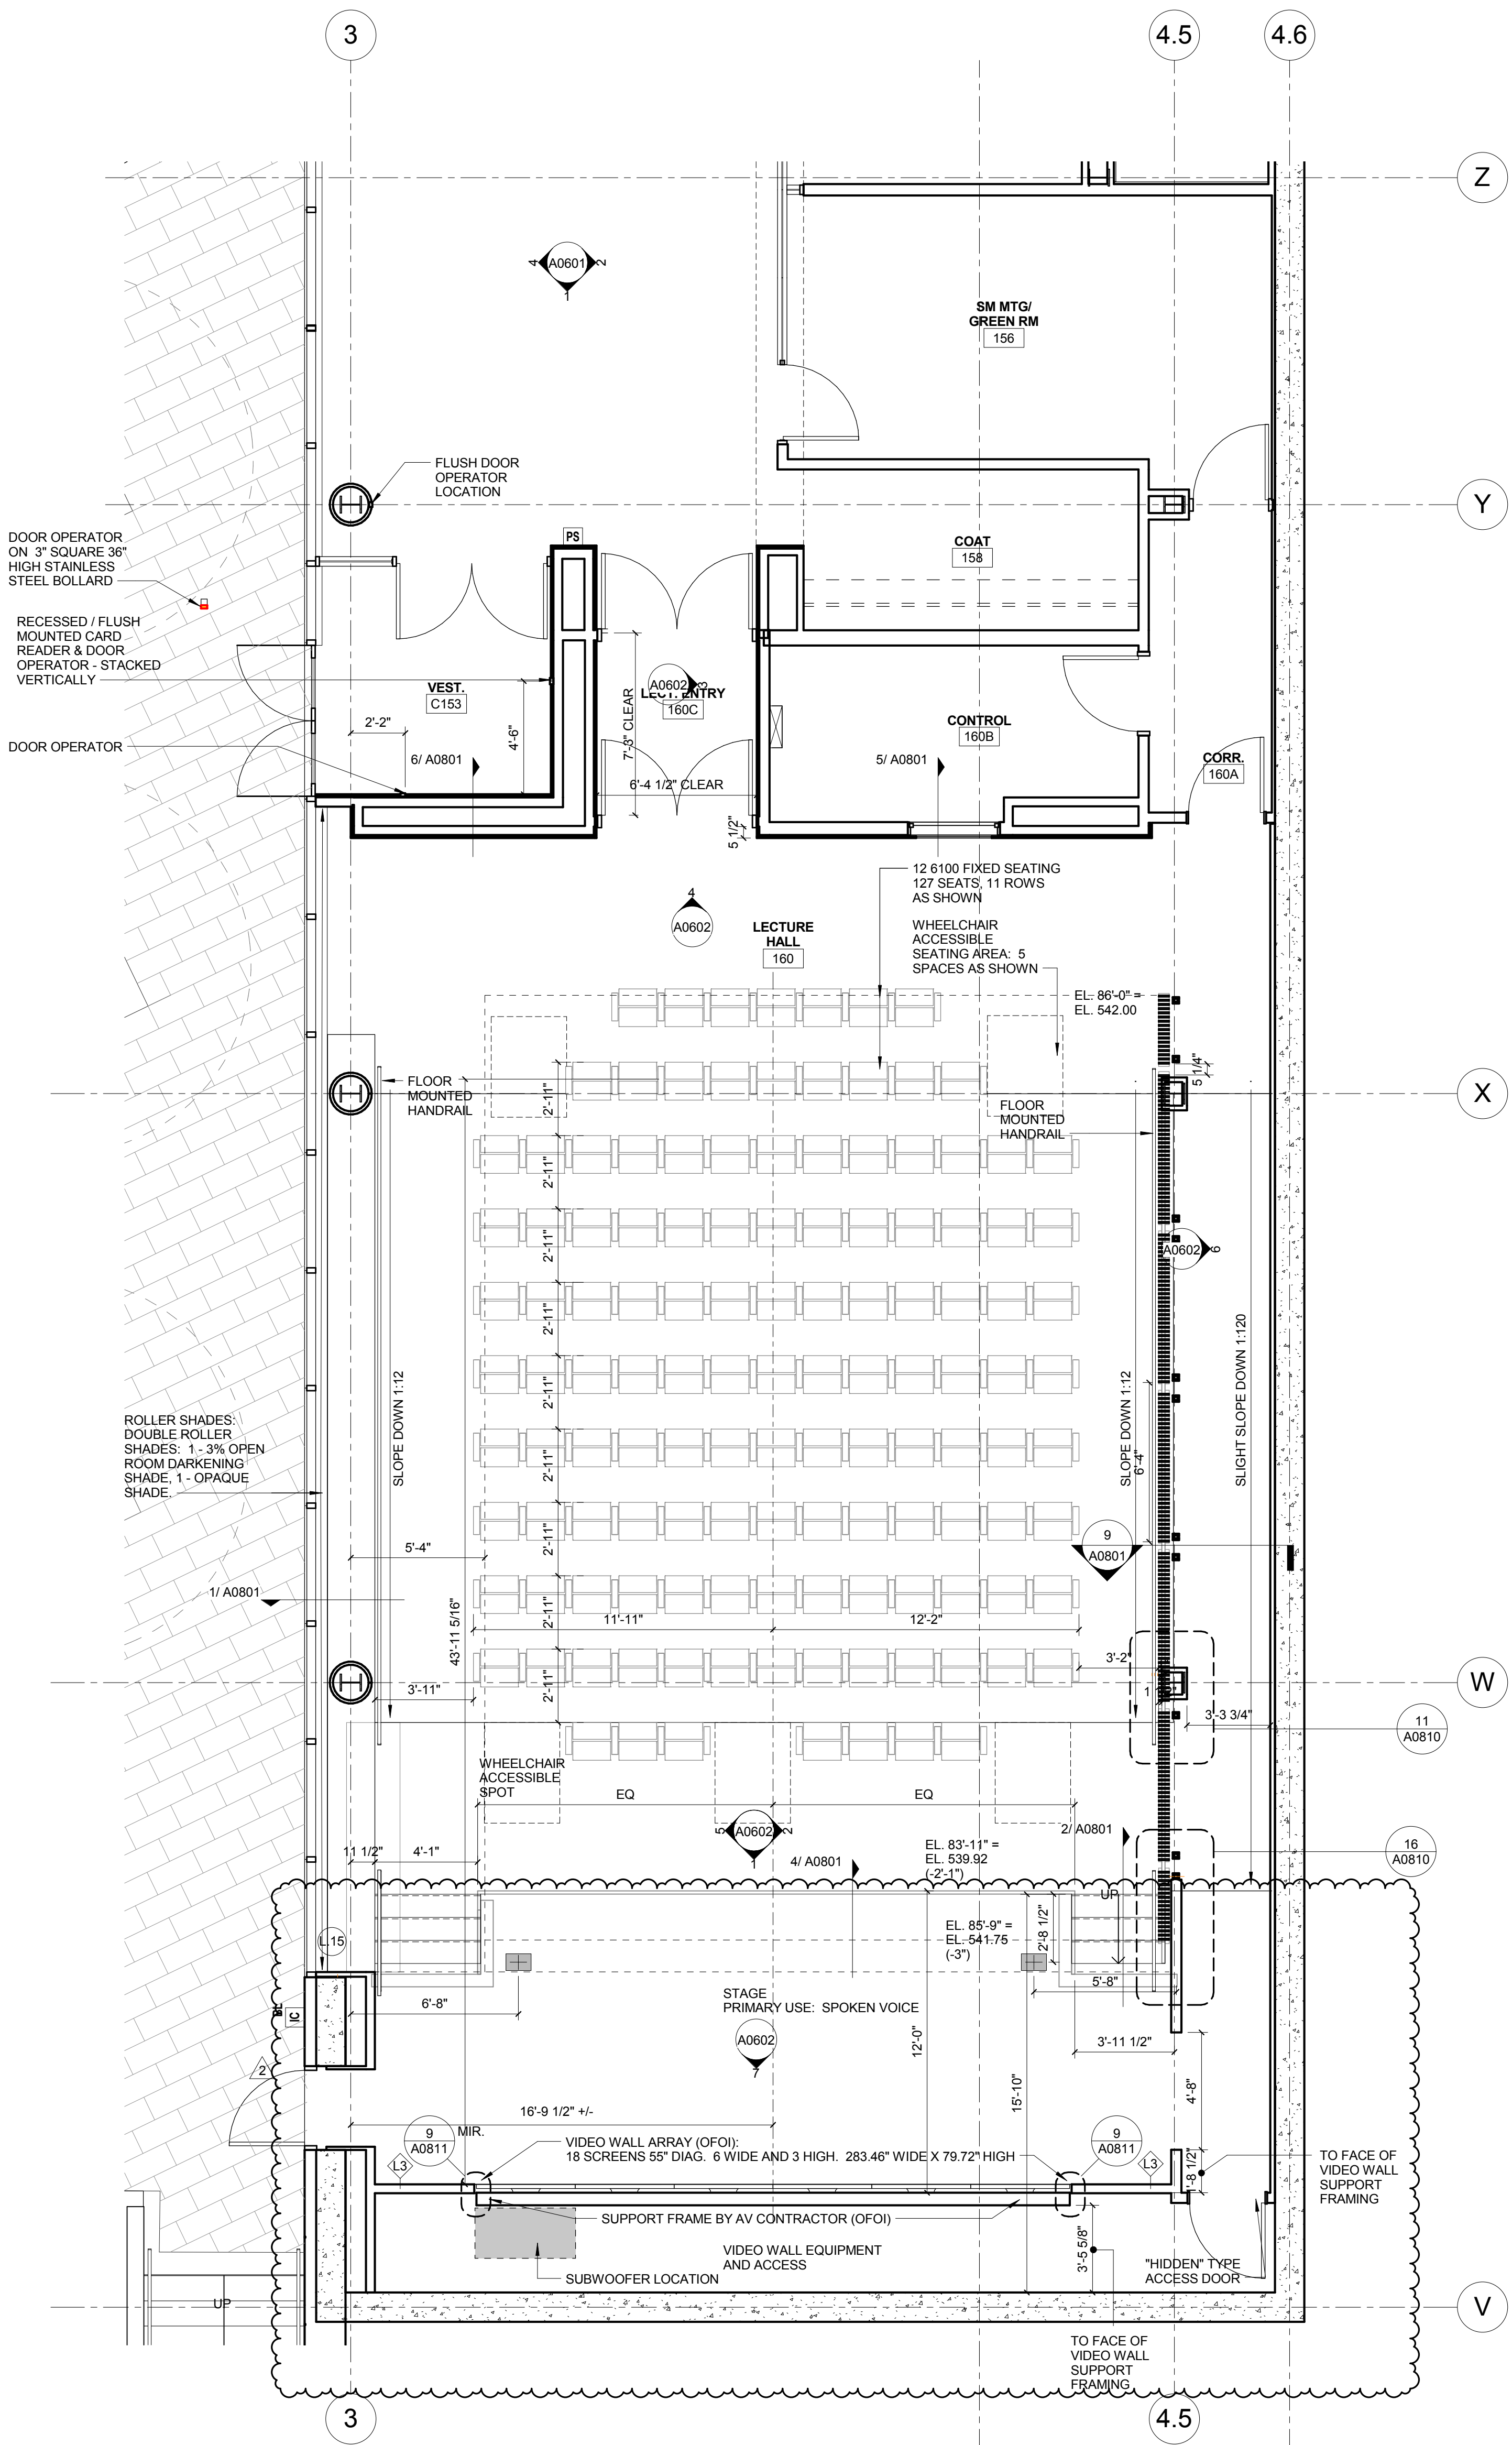

1 LEVEL 01 - AREA B - LECTURE HALL
1/4" = 1'-0"

2	ASI-063	21 APR 2017
1	ADDENDUM 3-2	15 APR 2016
-	ISSUED FOR CONSTRUCTION (BP3)	15 MAR 2016
No.	Description	Date

Drawing Title:

ENLARGED PLANS-LEVEL
01

Project No.: 04561.01

Checked by:

A0202