


TOILET ACCESSORIES LEGEND	
Type Mark	Description
TA-01	GRAB BAR
TA-02	TOILET PAPER DISPENSER
TA-03	NAPKIN DISPOSAL
TA-04	COAT HOOK
TA-05	SURFACE-MOUNTED HAND DRYER
TA-06	SOAP DISPENSER (OFOI)
TA-07	WASTE DISPENSER
TA-08	MOP RACK & SHELF
TA-10	DIAPER CHANGING STATION
TA-11	SMALL PAPER TOWEL DISPENSER

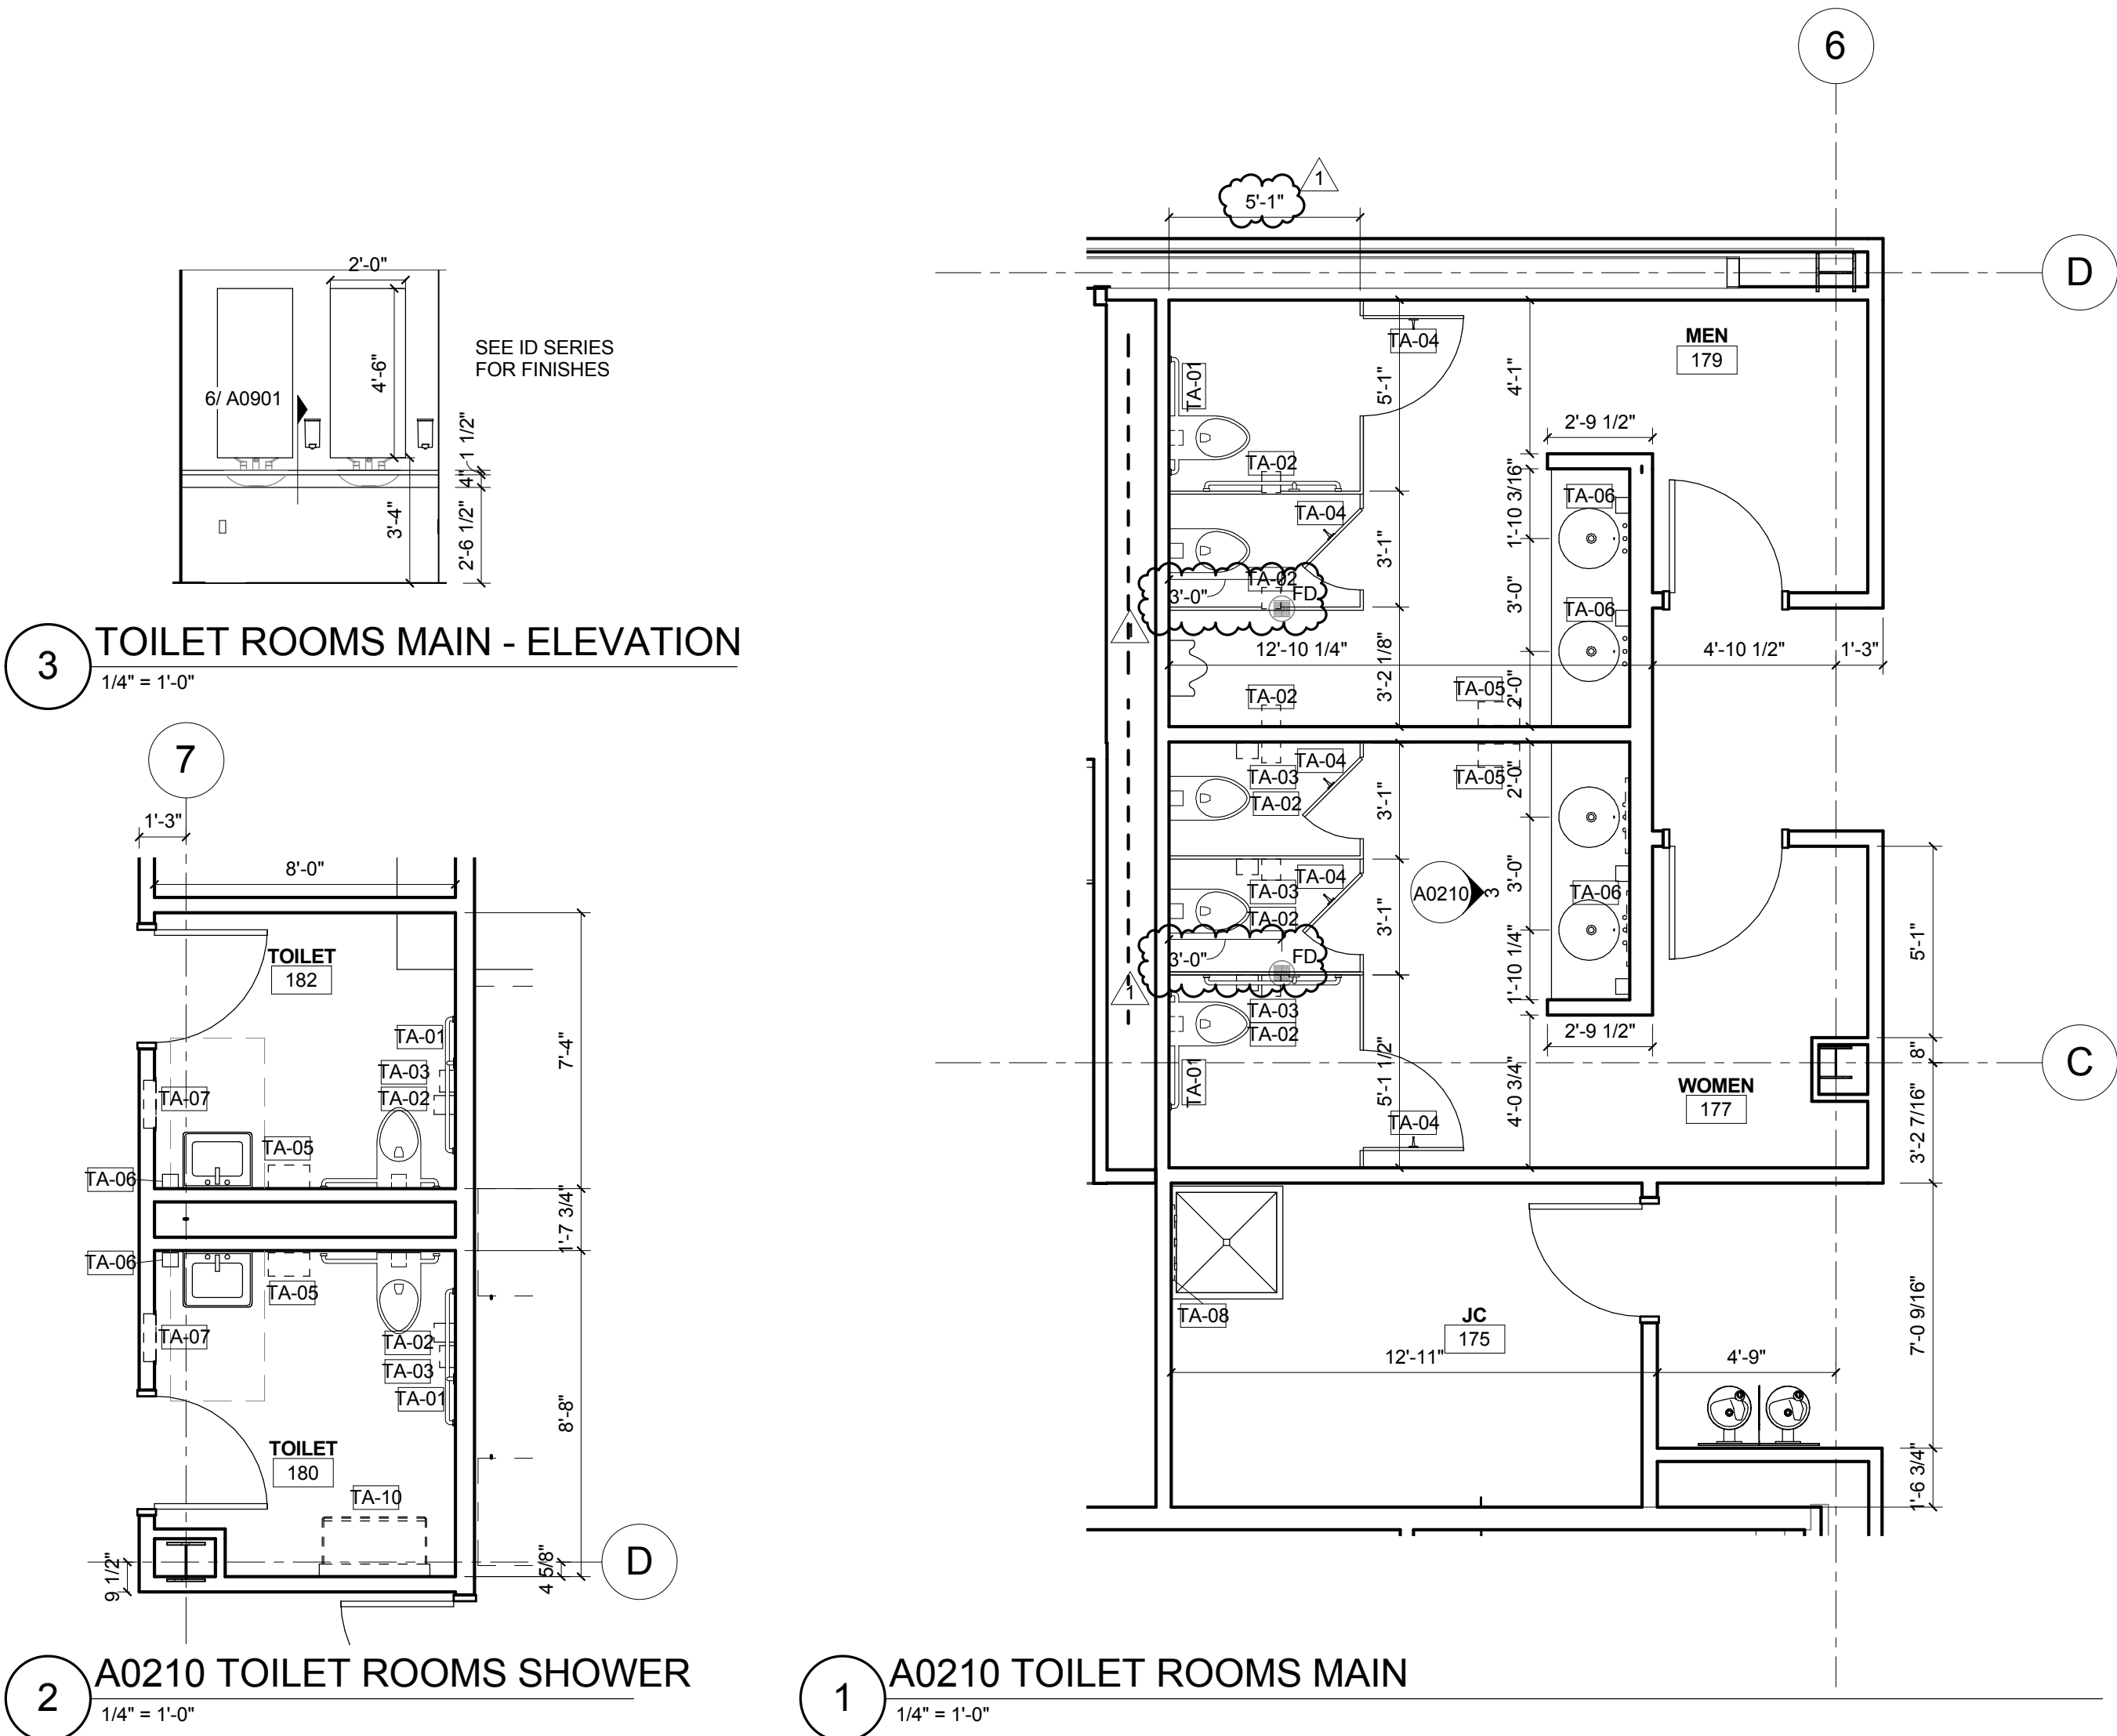

1	RFI 339	09 NOV 2016
2	ISSUED FOR CONSTRUCTION (BP3)	15 MAR 2016
No.	Description	Date

Drawing Title:

TOILET PLANS

Project No.: 04561.01 Checked by:

A0210