



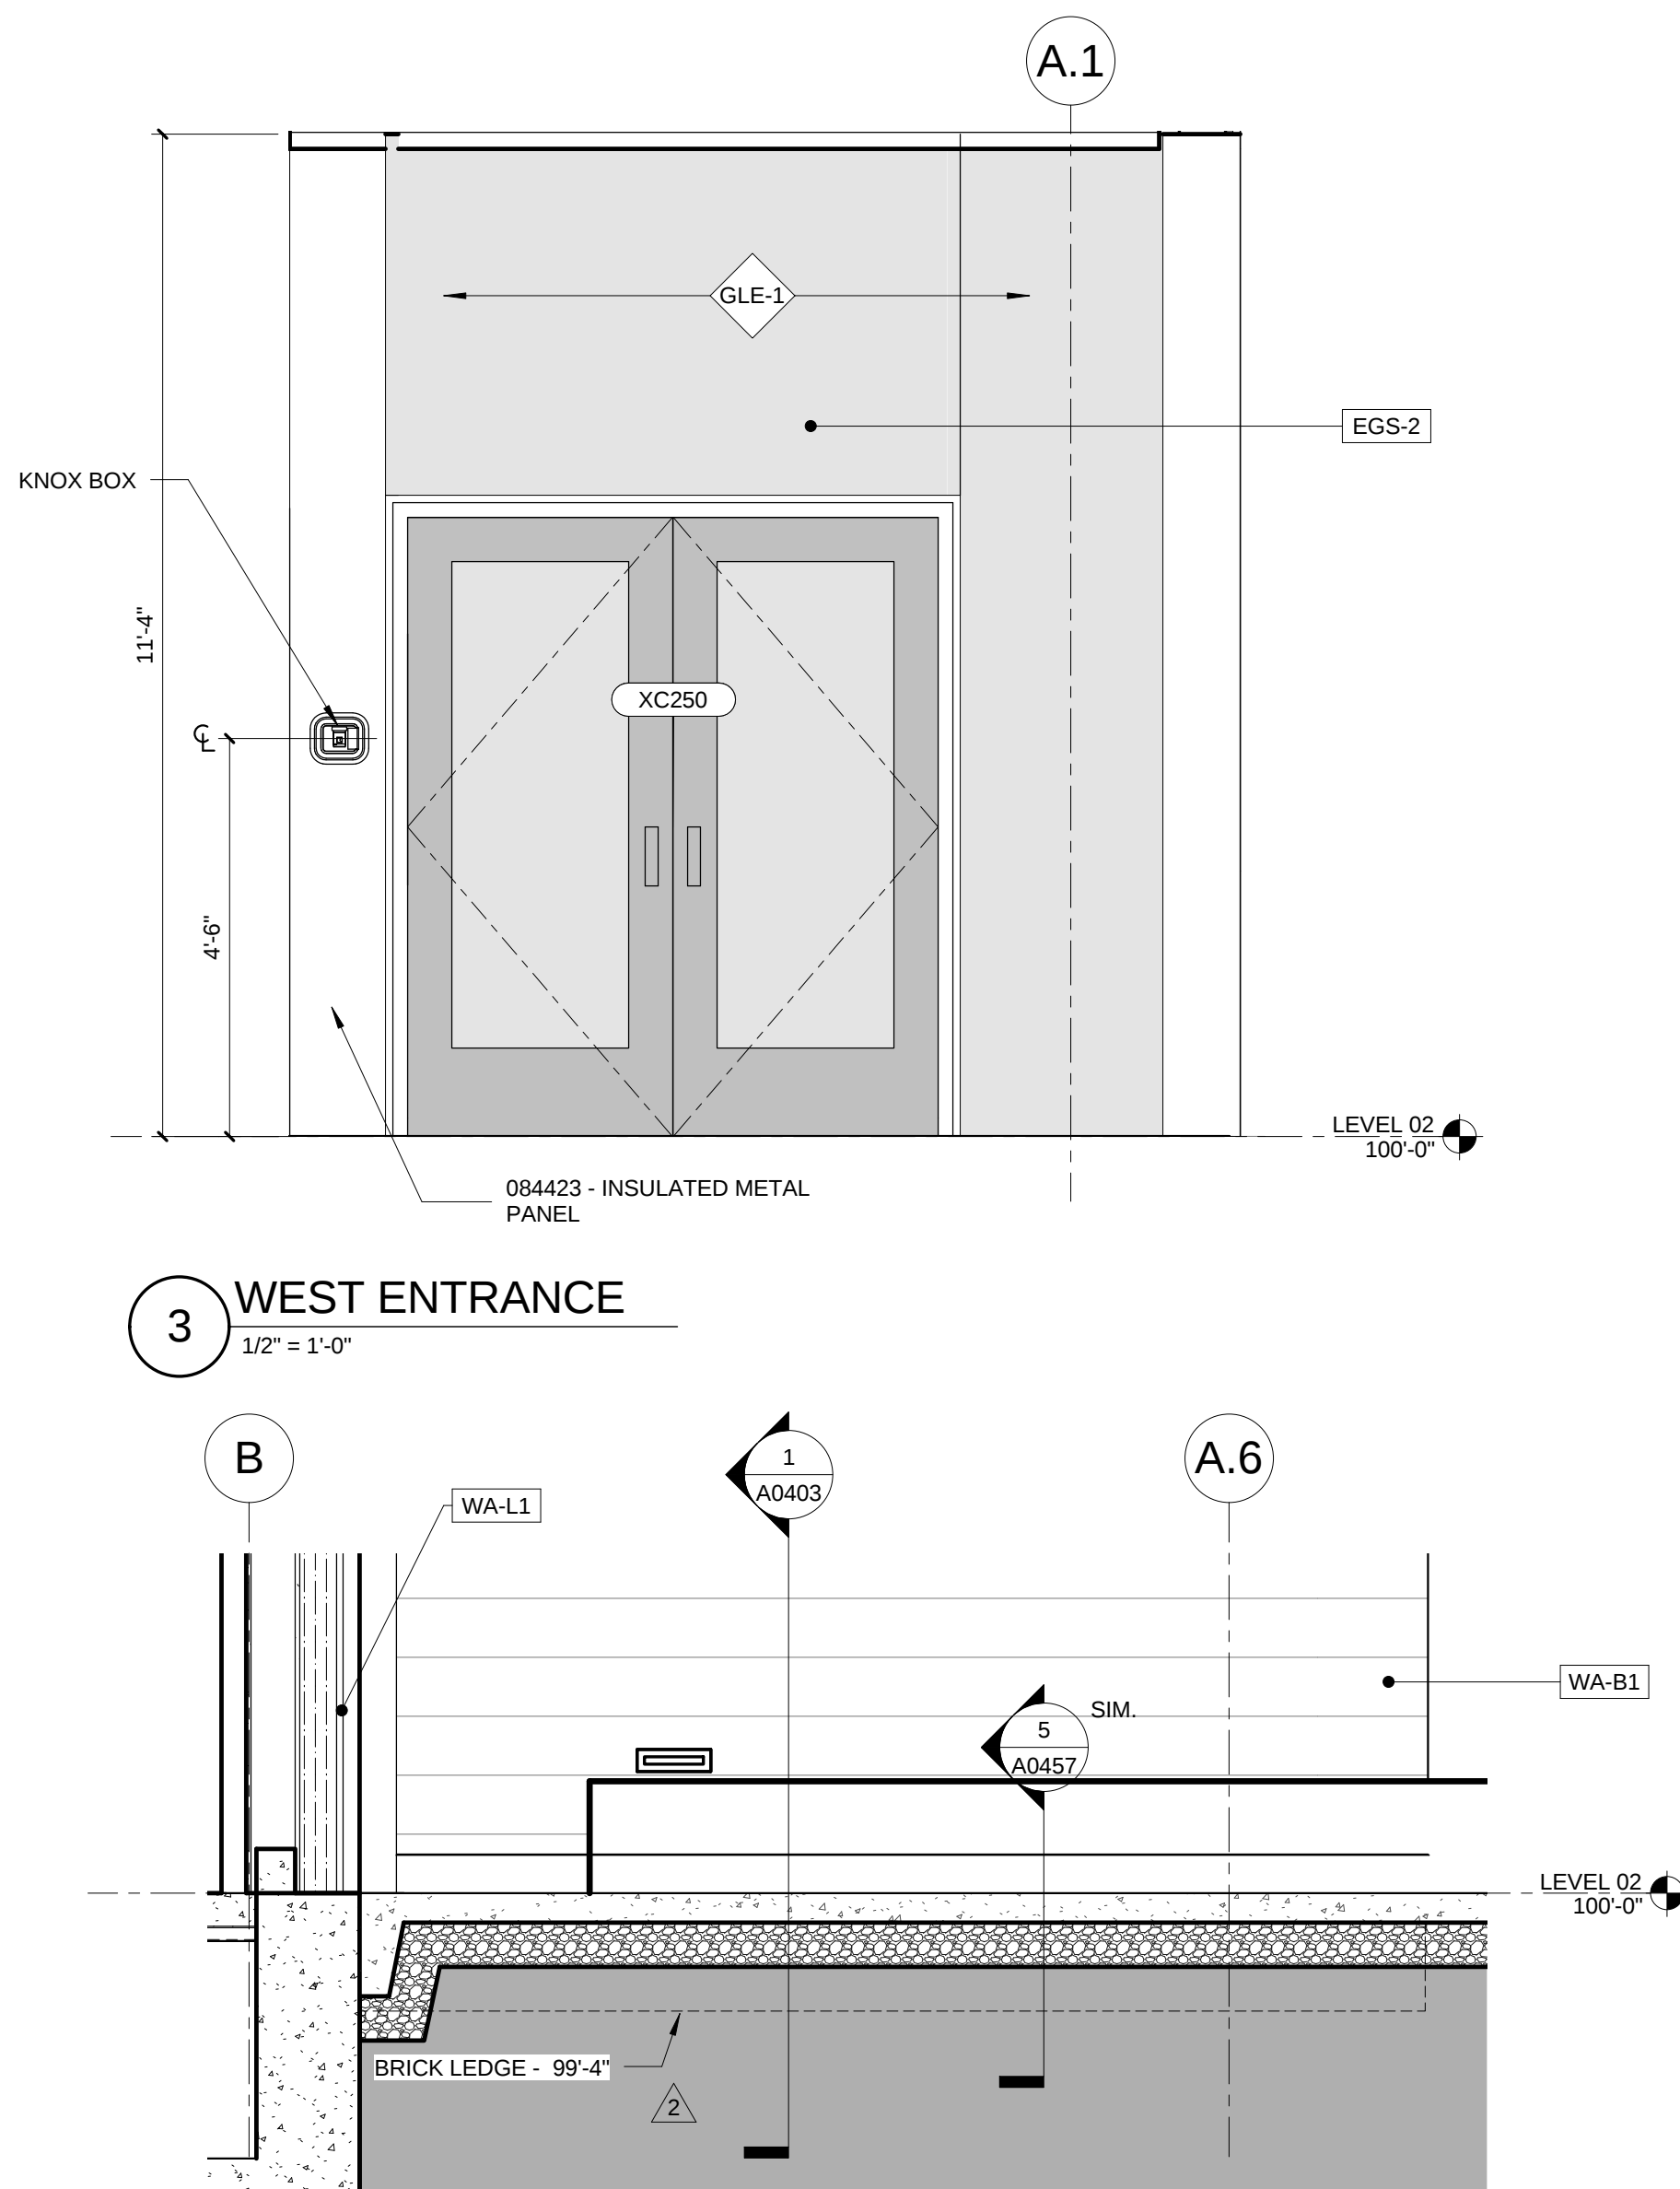


3 WEST ENTRANCE
1/2" = 1'-0"


4 PARTIAL WEST ELEVATION AT COLUMN LINE "B"
1/2" = 1'-0"

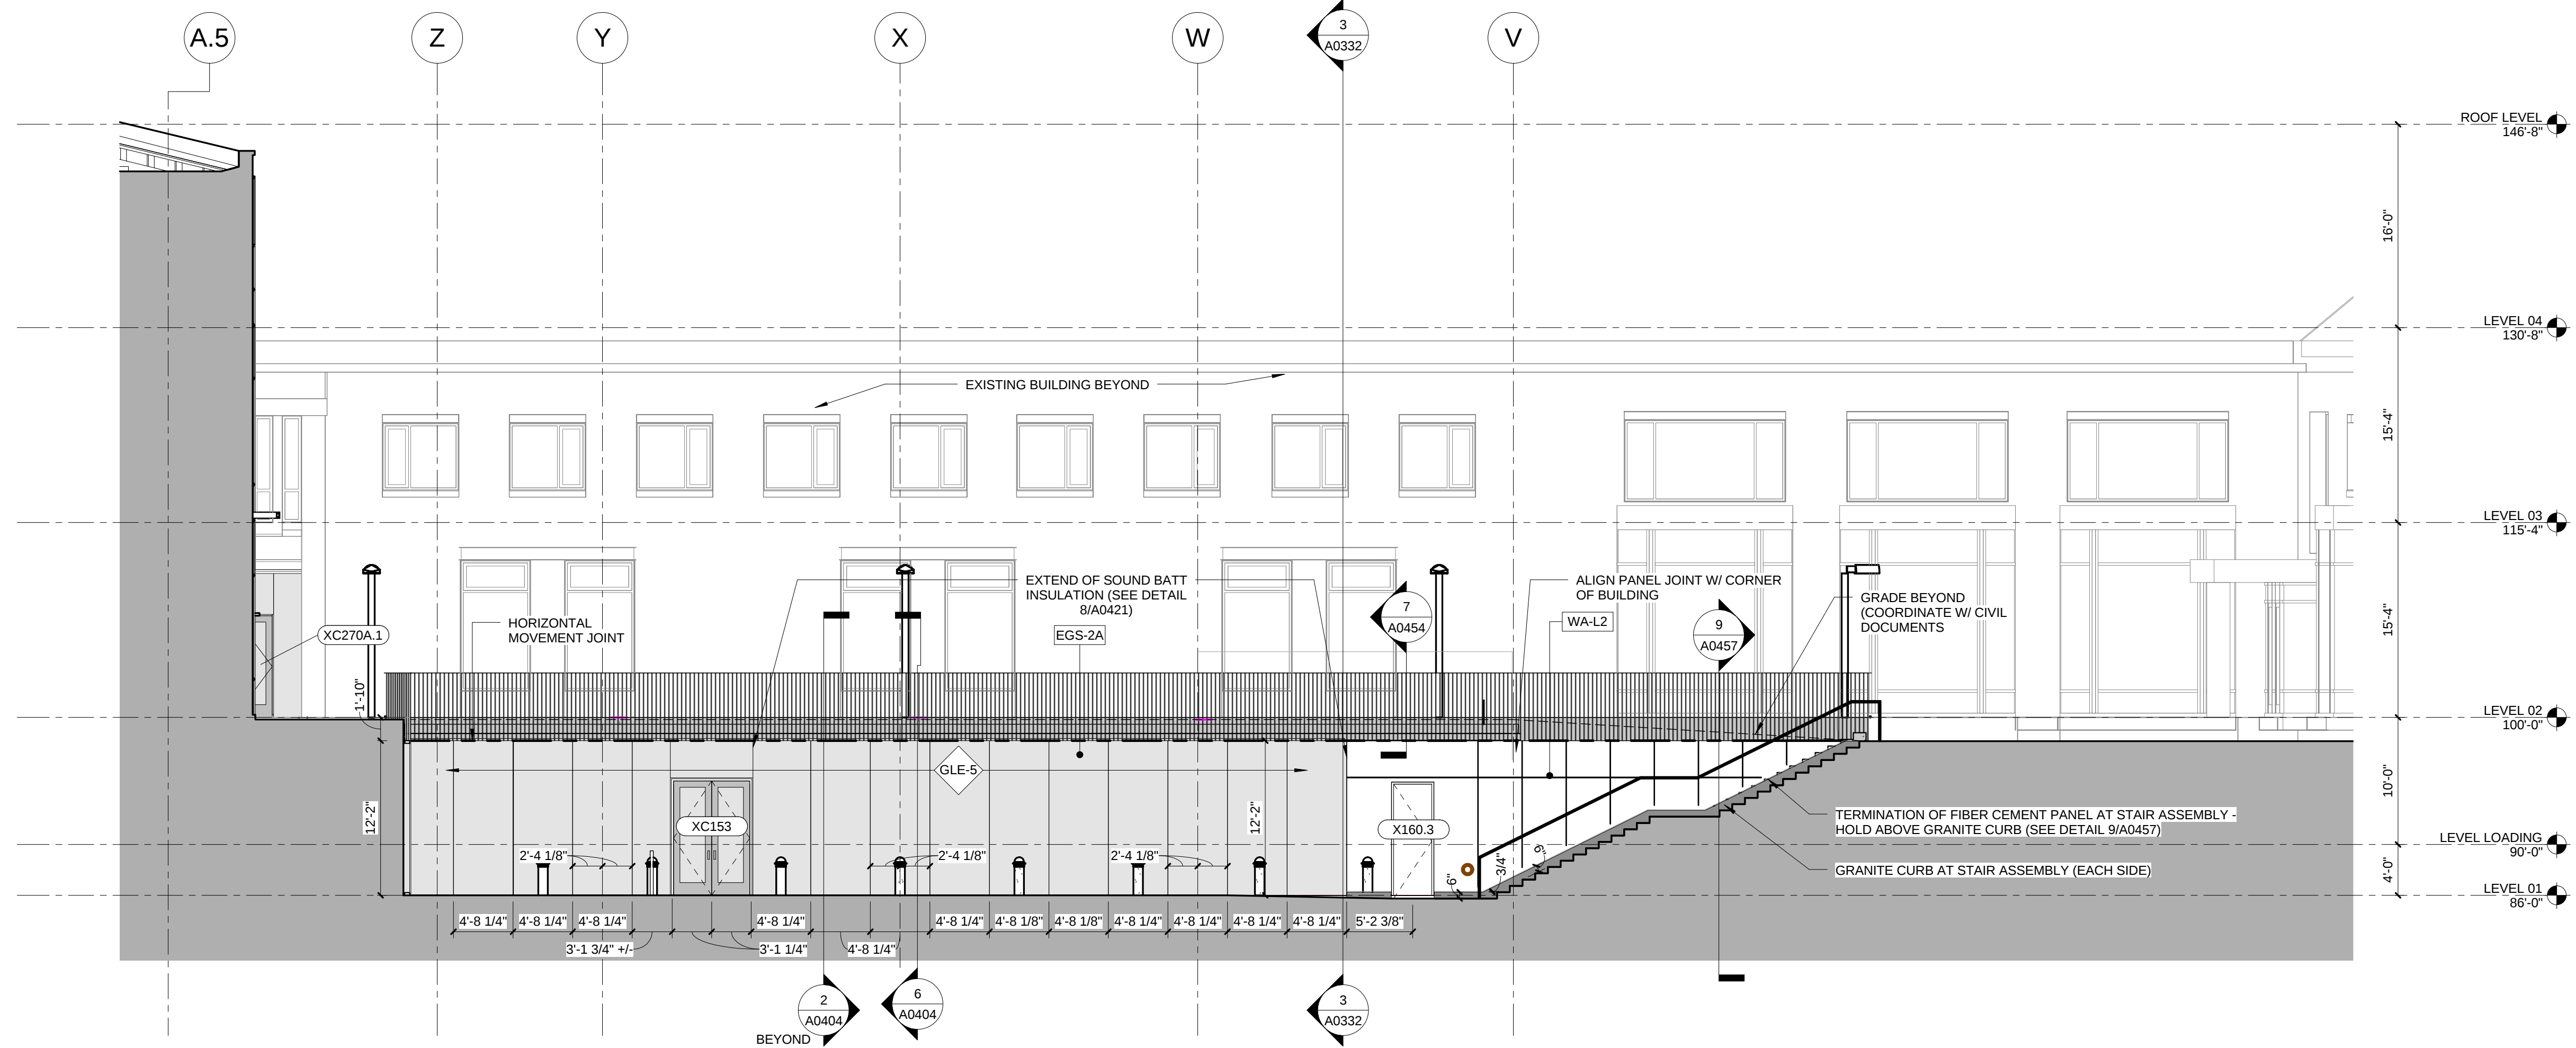

2 WEST ELEVATION AT SOUTH WING
1/8" = 1'-0"

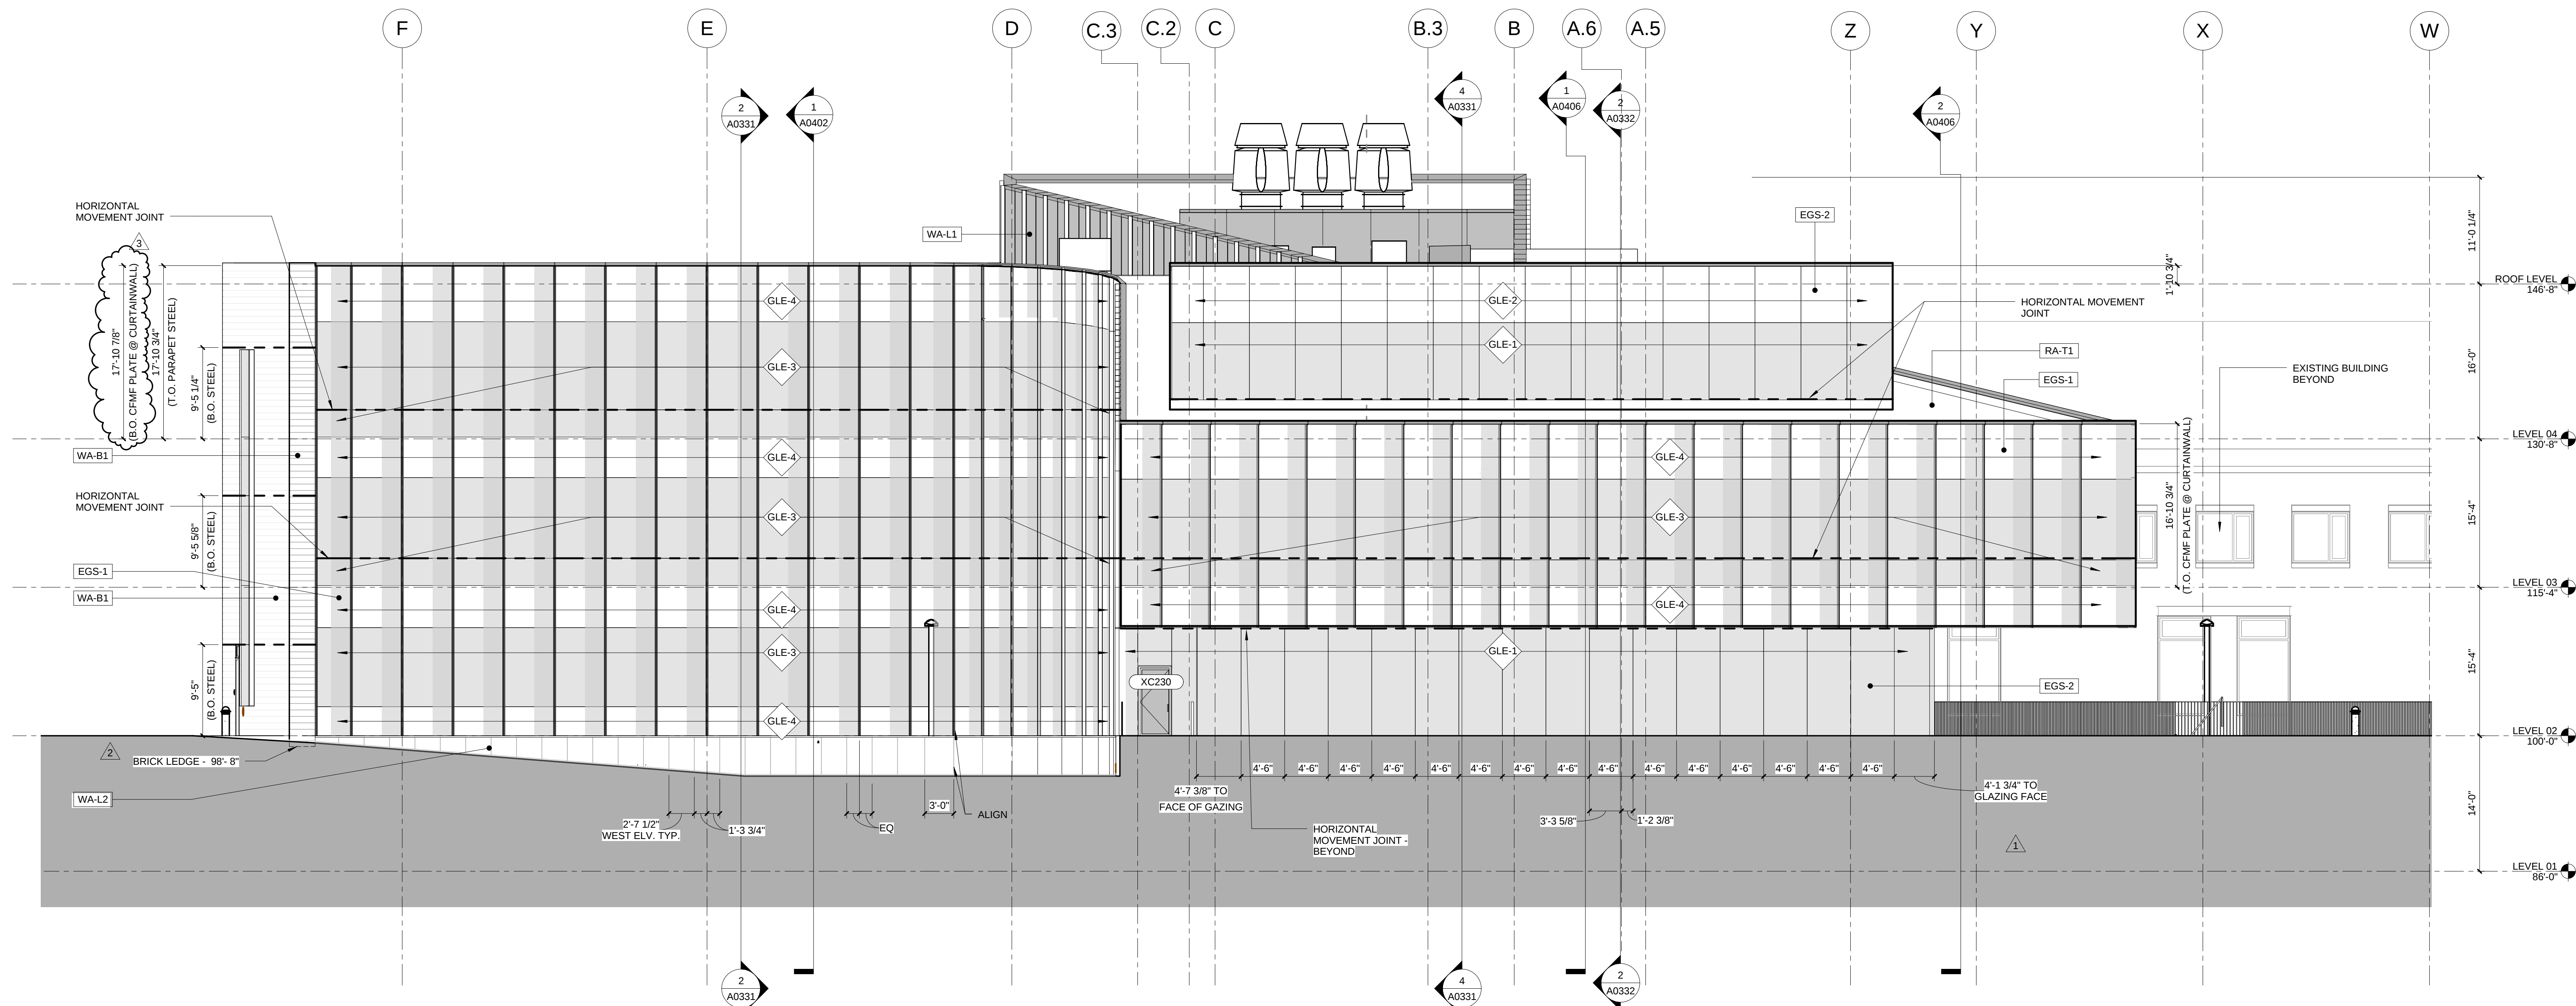

1 WEST ELEVATION
1/8" = 1'-0"

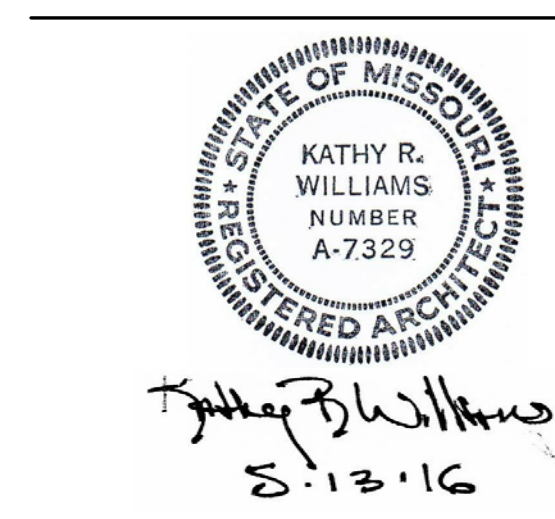

3	ASH-026	30 AUG 2016
2	ADDENDUM 1-11	13 MAY 2016
1	ADDENDUM 1-7	16 MAR 2016
	ISSUED FOR CONSTRUCTION (BP1)	15 JAN 2016

