


5	ASI-026	30 AUG 2016
4	ASI-022	23 AUG 2016
3	ADDENDUM 1-11	13 MAY 2016
2	ADDENDUM 1-7	16 MAR 2016
1	ADDENDUM 1-1	29 JAN 2016
ISSUED FOR CONSTRUCTION (BP1)		15 JAN 2016

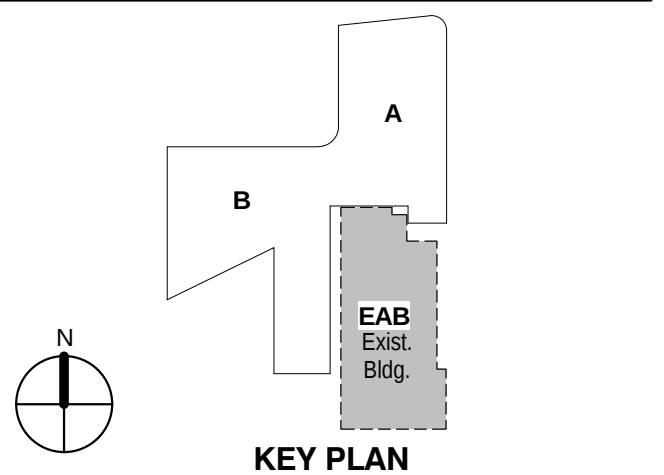

Drawing Title:

EXTERIOR ELEVATIONS

Project No.: 04561.01 Checked by:

A0312

