



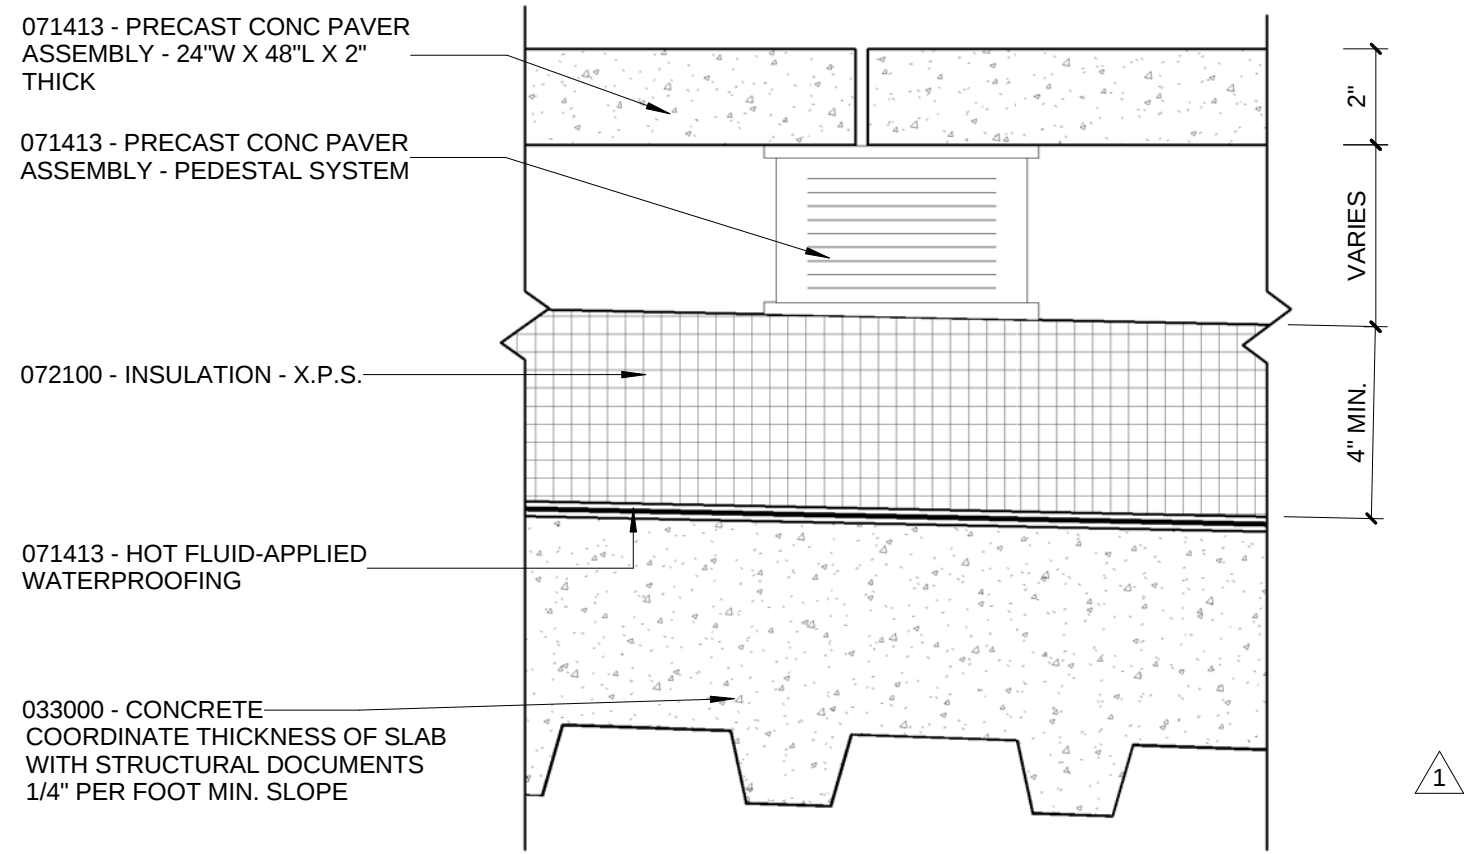

ROOF ASSEMBLY - FLUID APPLIED MEMBRANE SYSTEM
CONCRETE DECK WITH PAVER ROOF

RA-T4


3" = 1'-0"

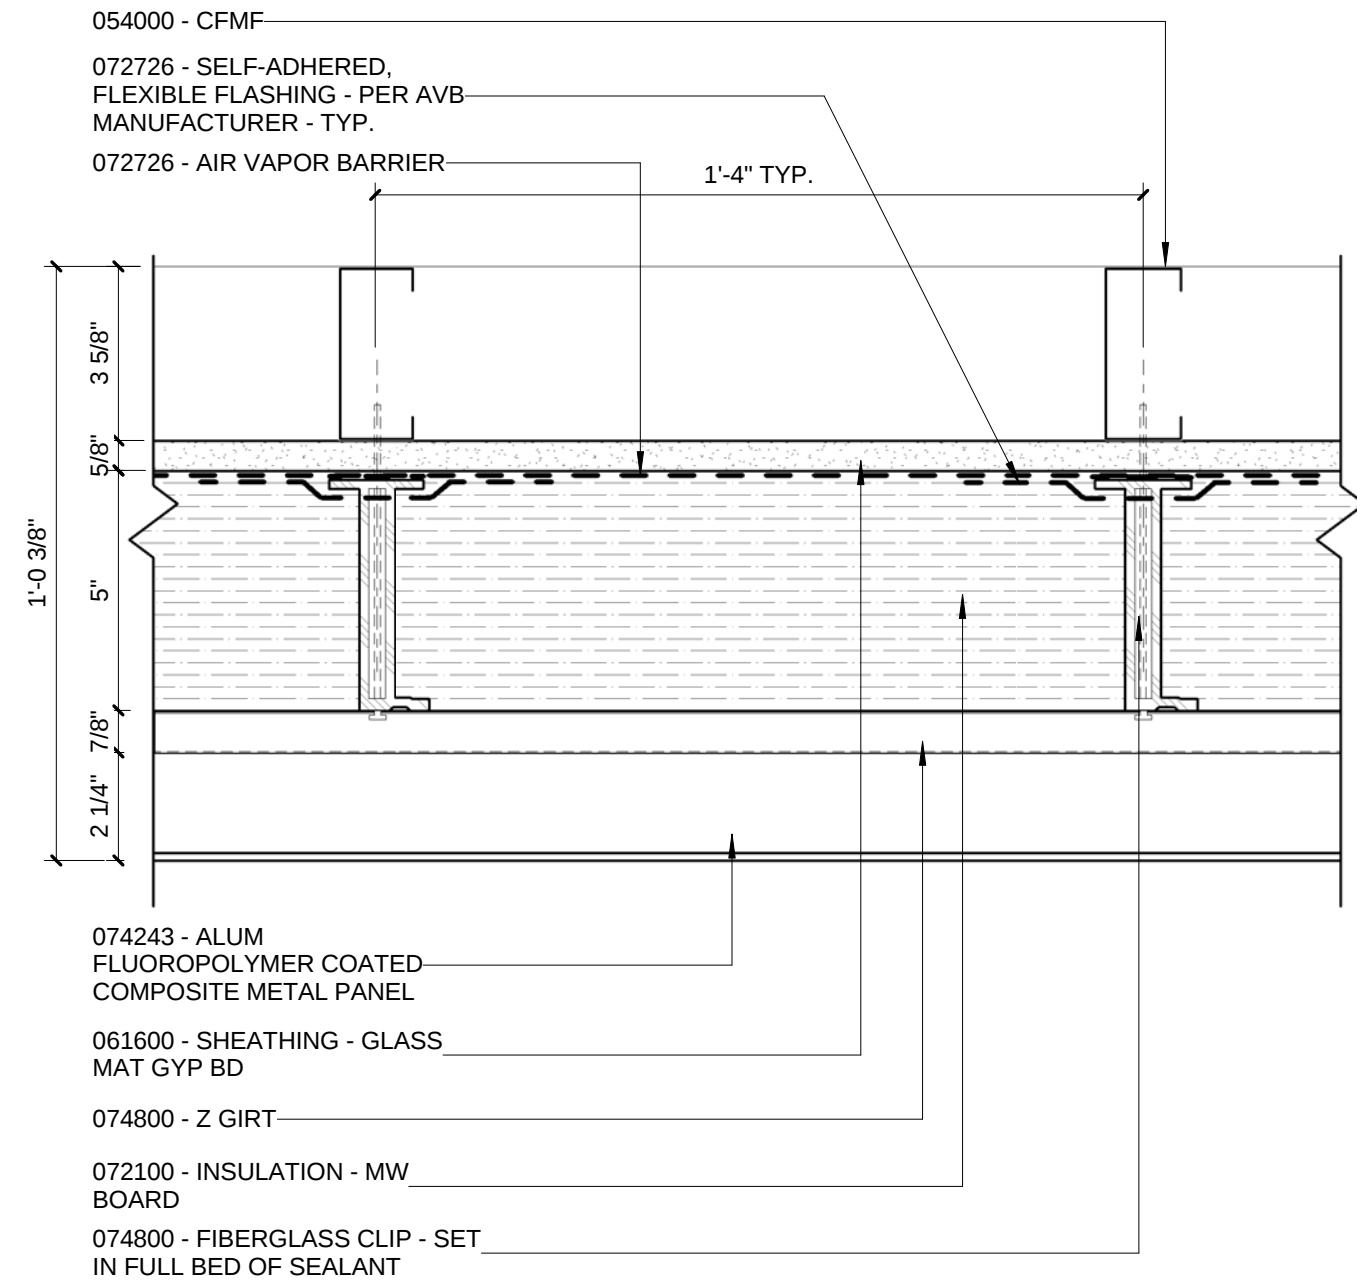

SOFFIT ASSEMBLY - LIGHT CLADDING
CFMF WITH FIBROUS INSULATION WITH FIBERGLASS CLIPS

SA-L1


3" = 1'-0"

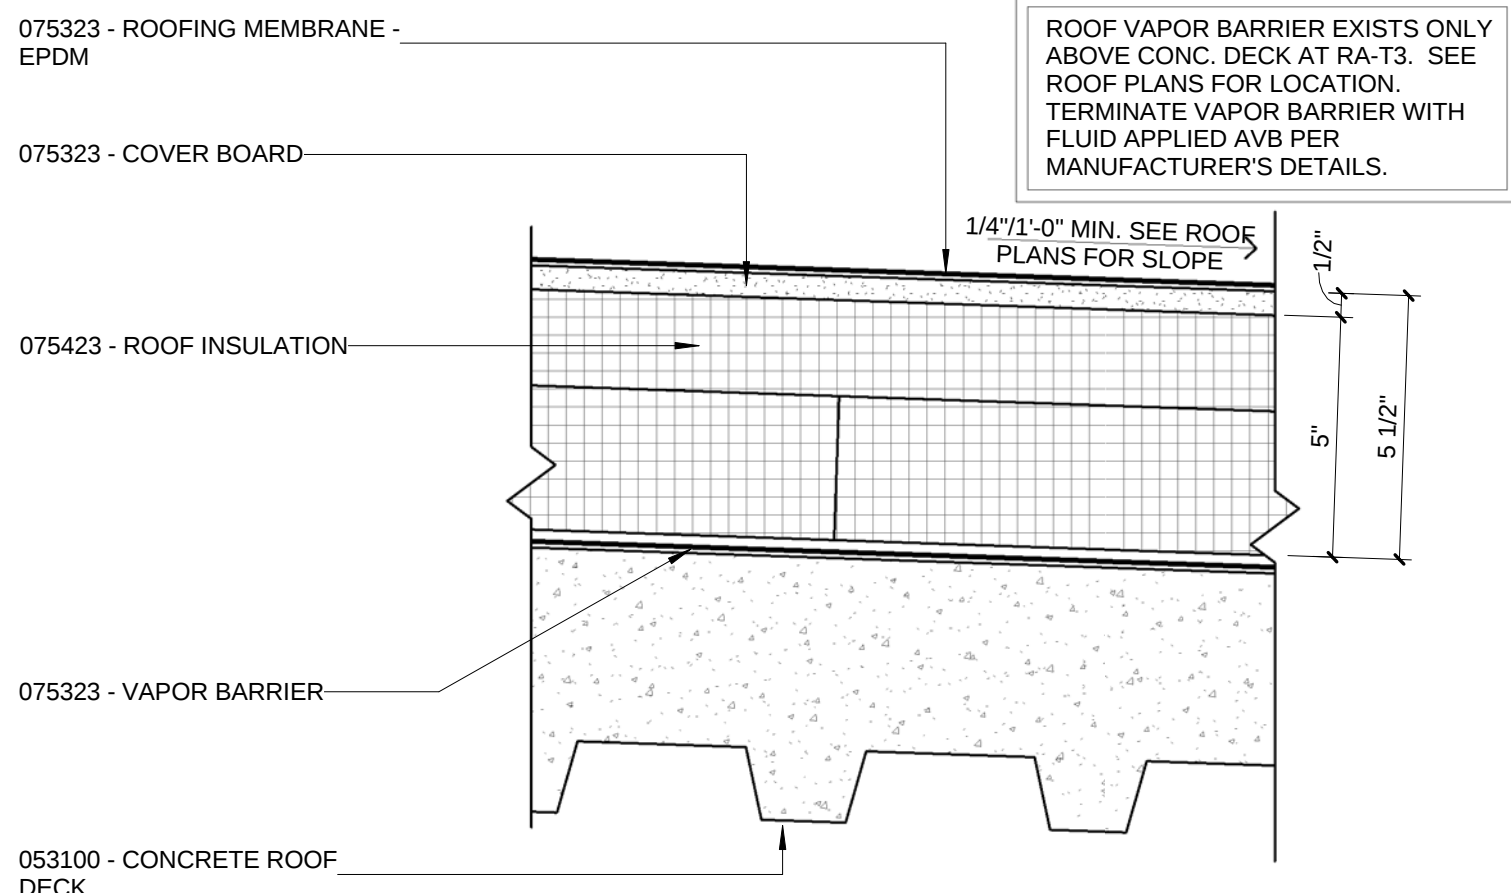

ROOF ASSEMBLY - EPDM
SLOPING CONCRETE DECK WITH INSULATION/VAPOR BARRIER

RA-T3


3" = 1'-0"

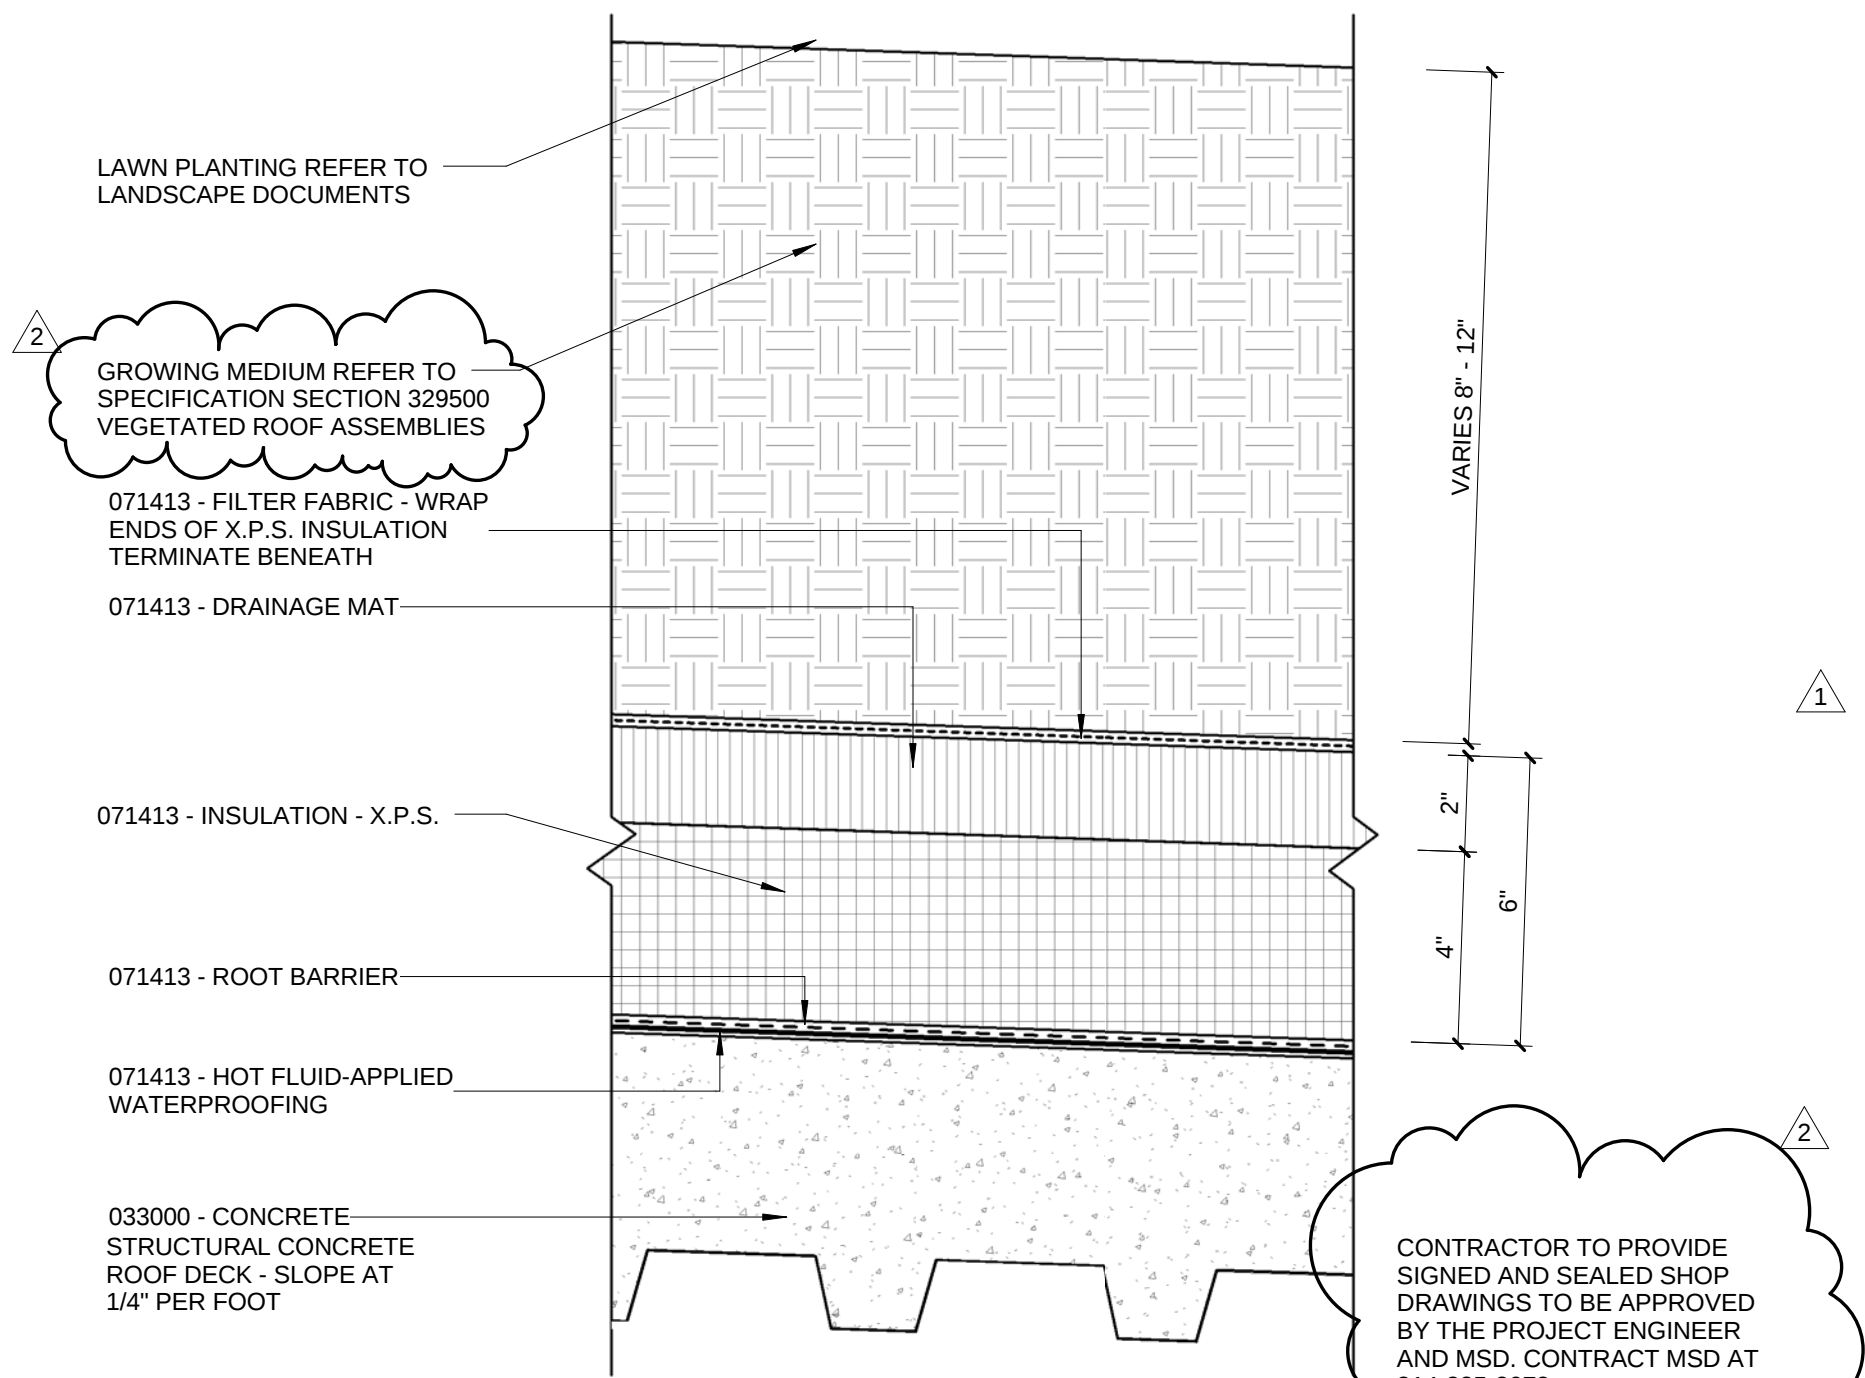

ROOF ASSEMBLY - FLUID APPLIED MEMBRANE SYSTEM
CONCRETE DECK WITH "INTENSIVE" VEGETATIVE ROOF

RA-T2


3" = 1'-0"

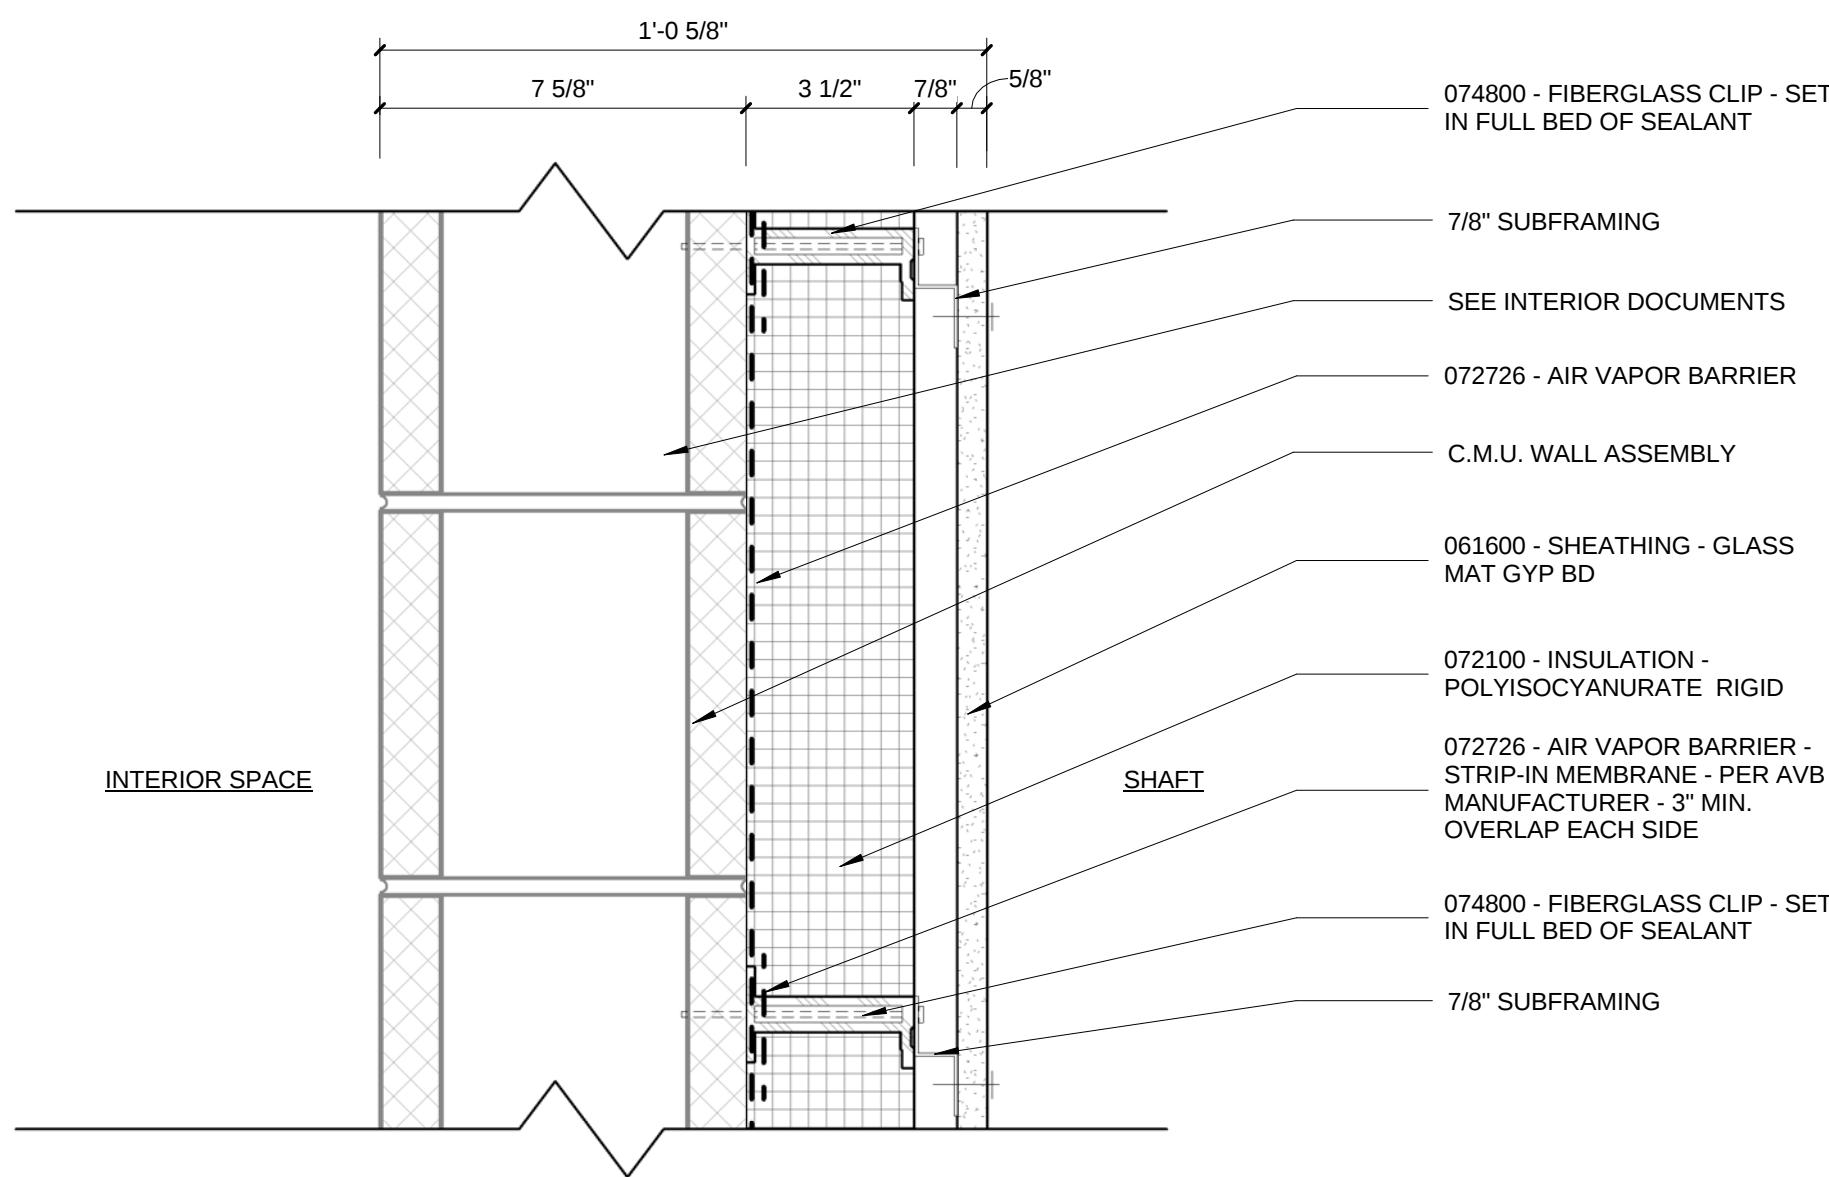

WALL ASSEMBLY - EXTERIOR GYP. OVER CMU

WA-L5


3" = 1'-0"

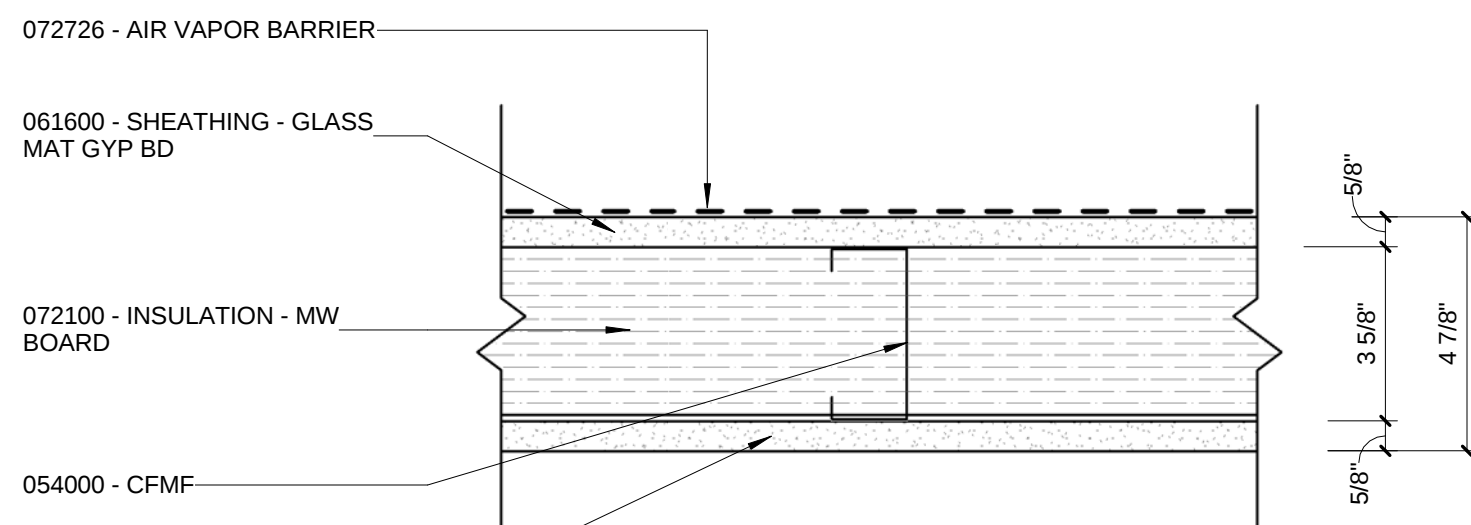

WALL ASSEMBLY - EXTERIOR GLASS MAT GYP.

WA-L4


3" = 1'-0"

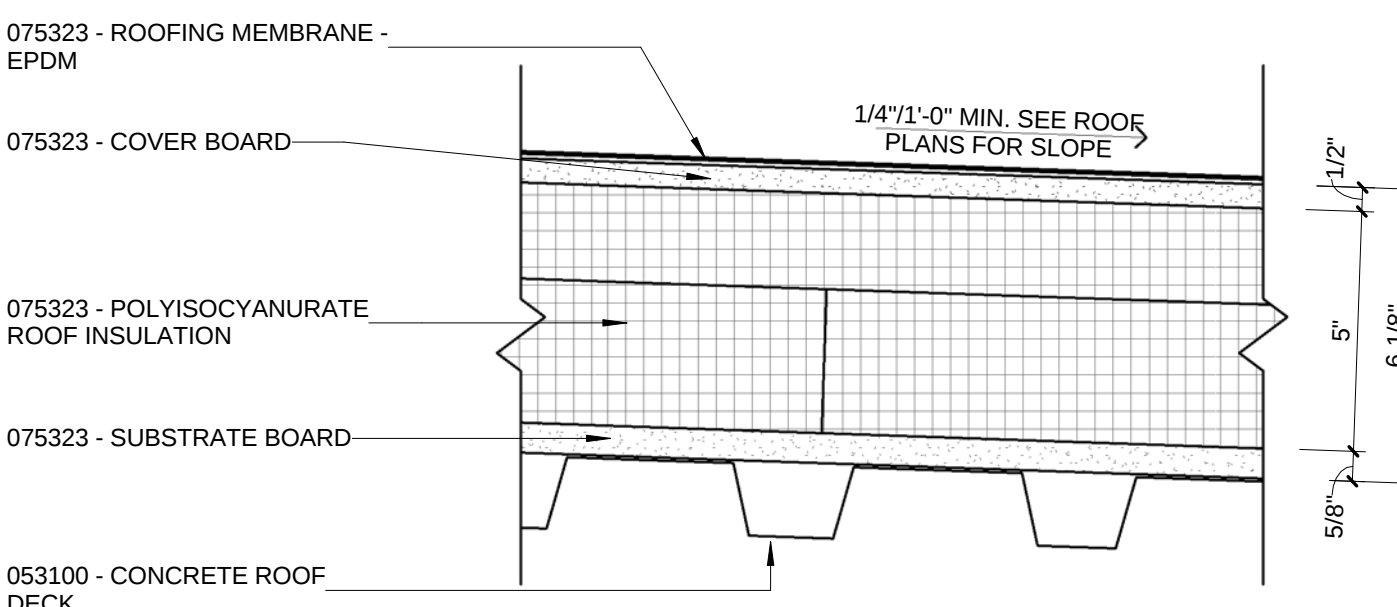

ROOF ASSEMBLY - EPDM
SLOPING STEEL DECK WITH INSULATION

RA-T1


3" = 1'-0"

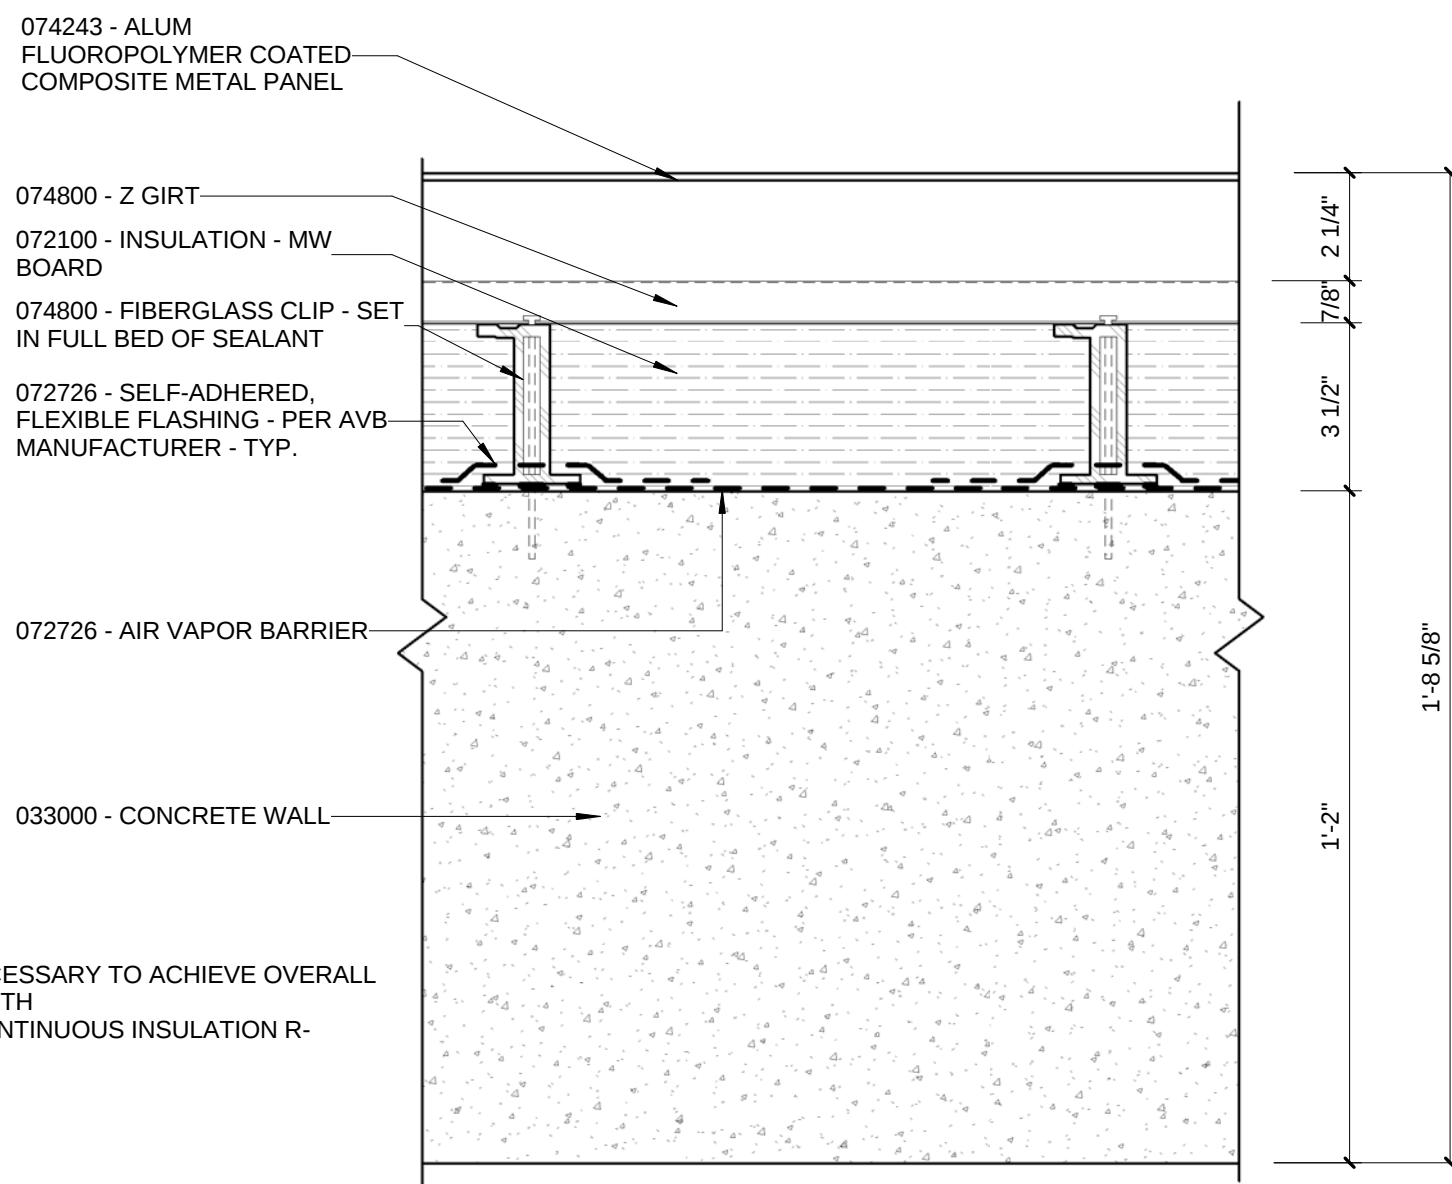

WALL ASSEMBLY - METAL PANELS WITH THERMAL BREAK
CONC WITH INSULATION - HORIZONTAL SUBGIRTS

WA-L3


3" = 1'-0"

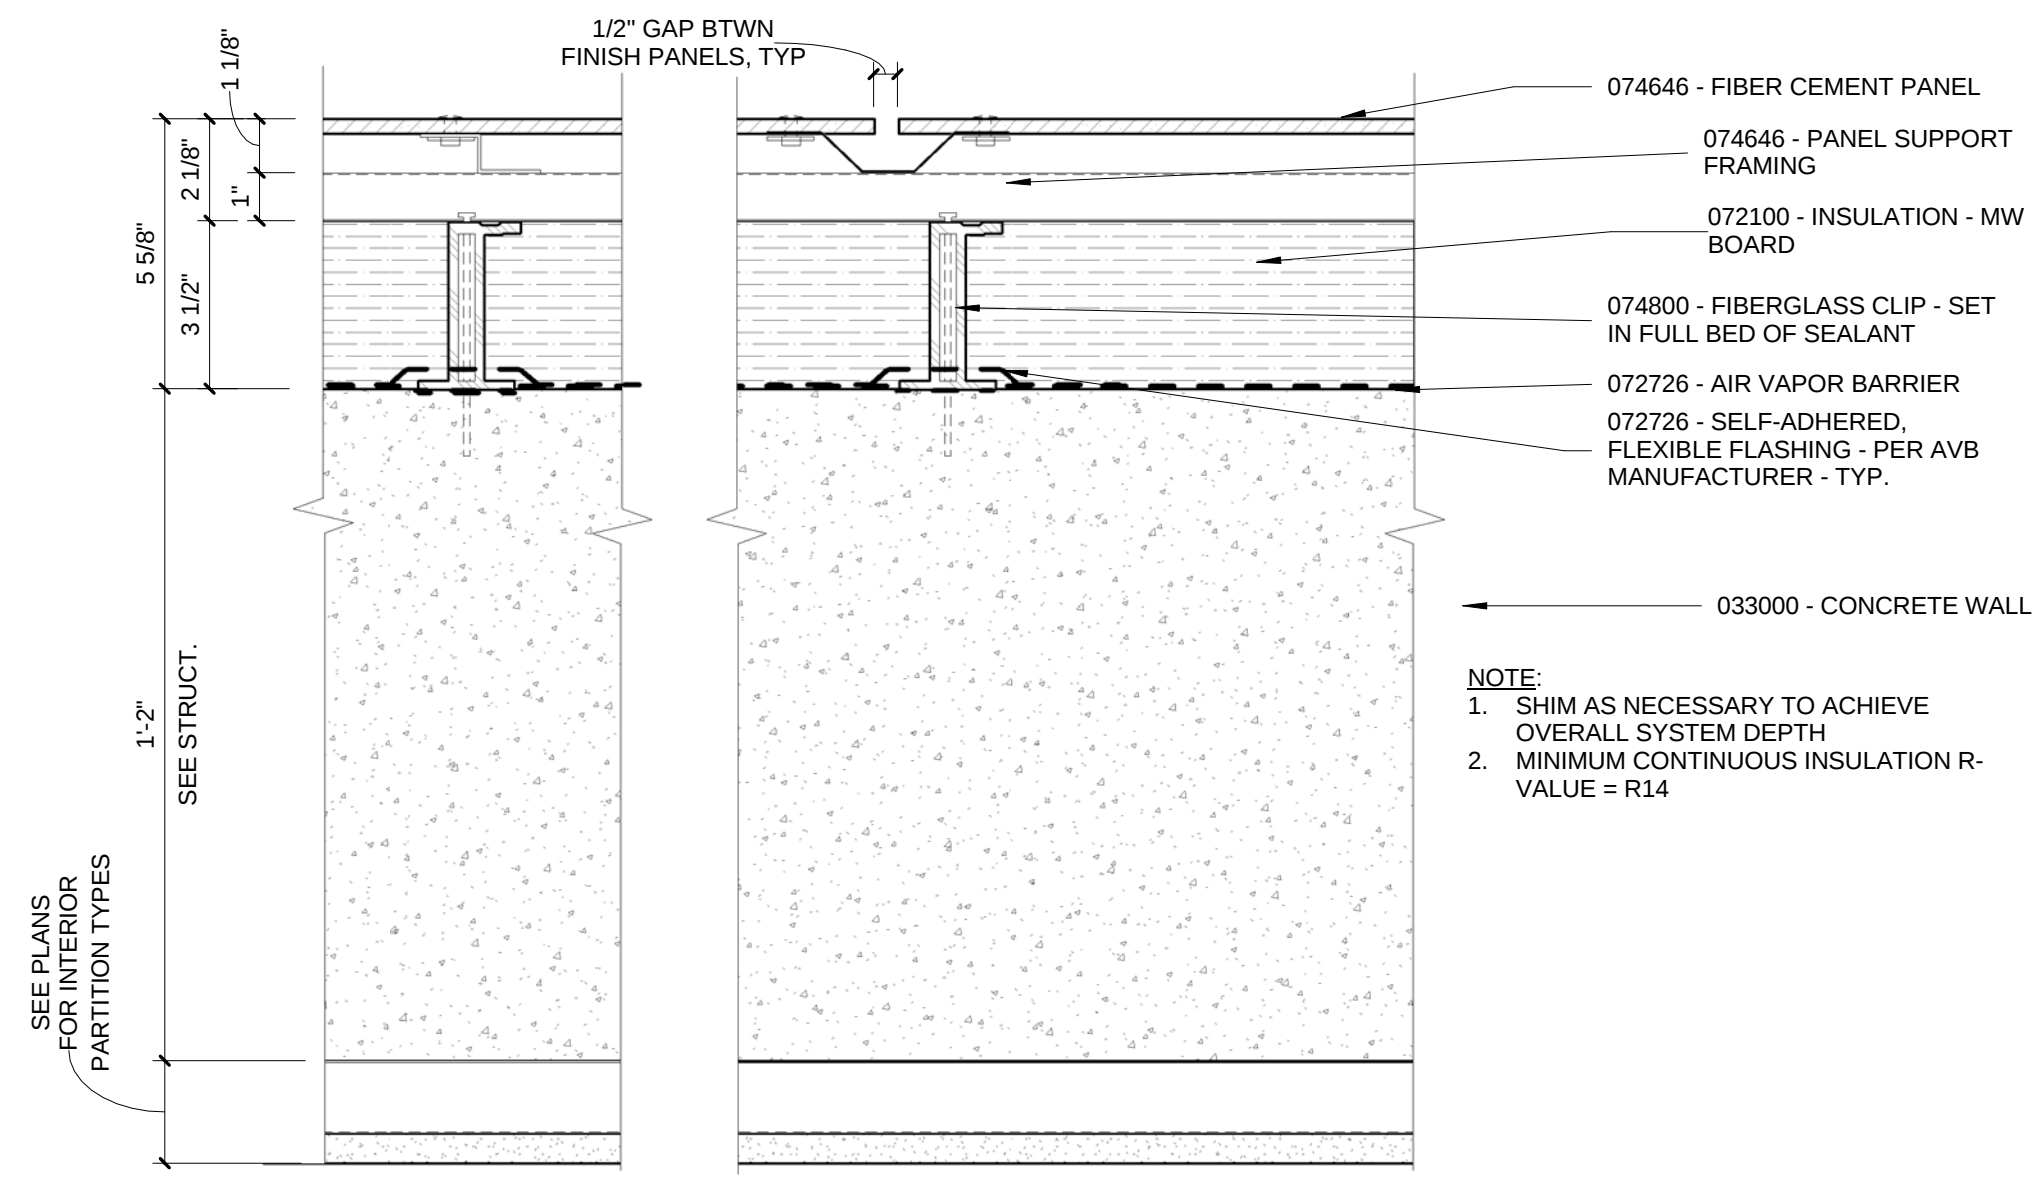

WALL ASSEMBLY - FIBER CEMENT PANELS W/ THERMAL BREAK
OVER CONC. WITH INSULATION - VERTICAL SUBGIRTS

WA-L2


3" = 1'-0"

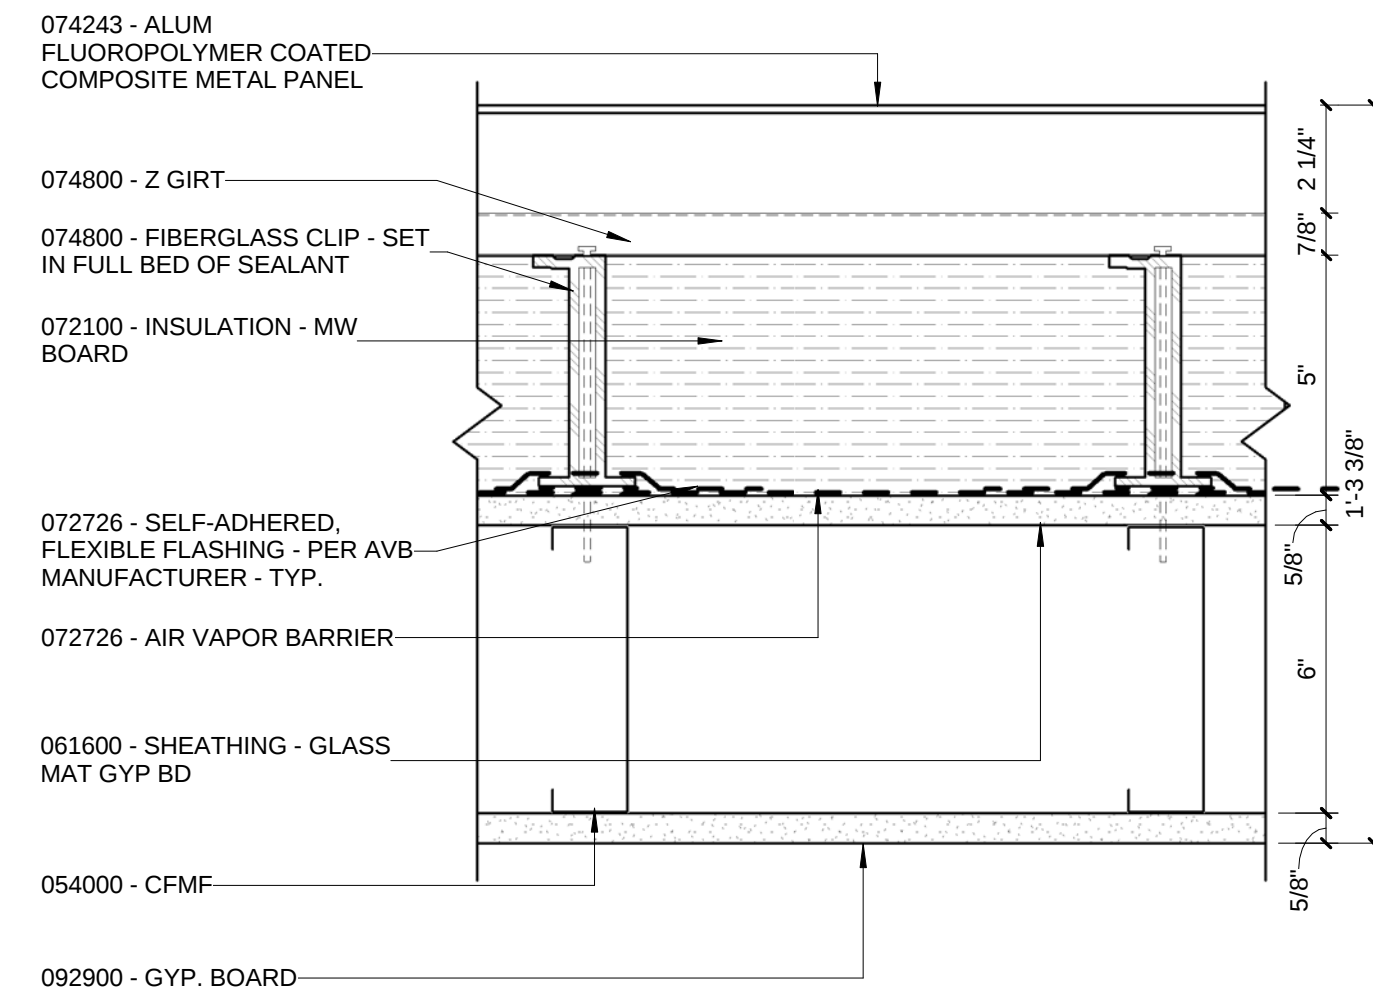

WALL ASSEMBLY - METAL PANELS WITH THERMAL BREAK
OVER CFMF WITH INSULATION - HORIZONTAL SUBGIRTS

WA-L1


3" = 1'-0"

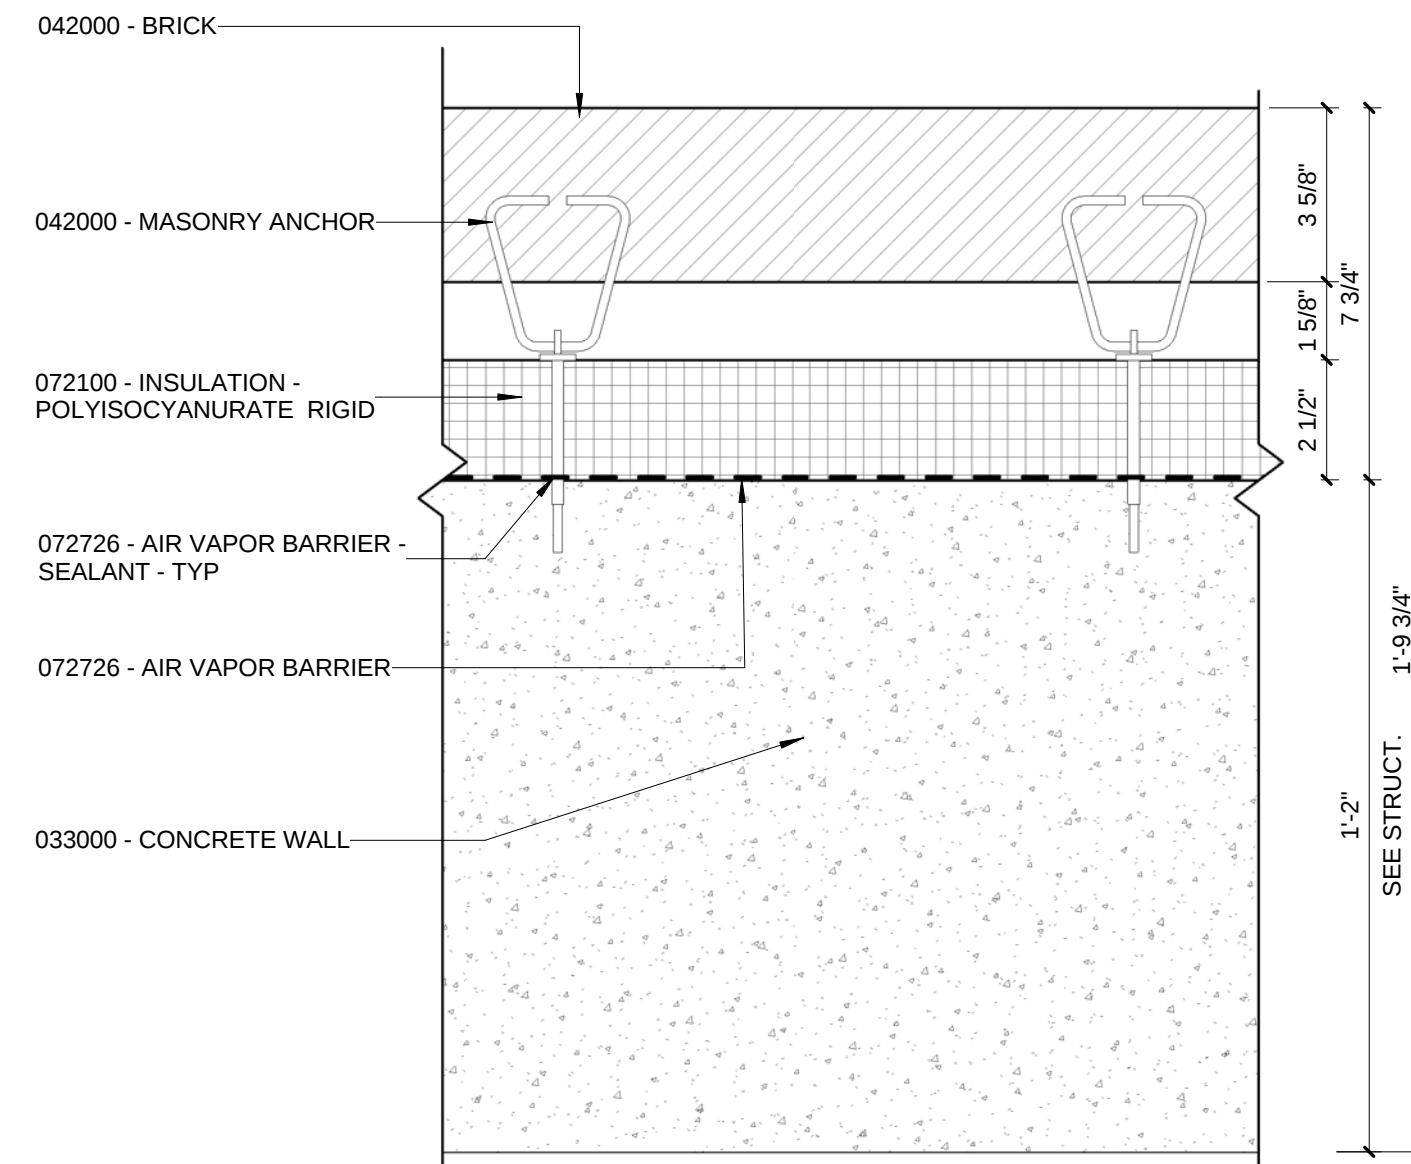

WALL ASSEMBLY - FACE BRICK
OVER CONC WITH INSULATION

WA-B2

3" = 1'-0"

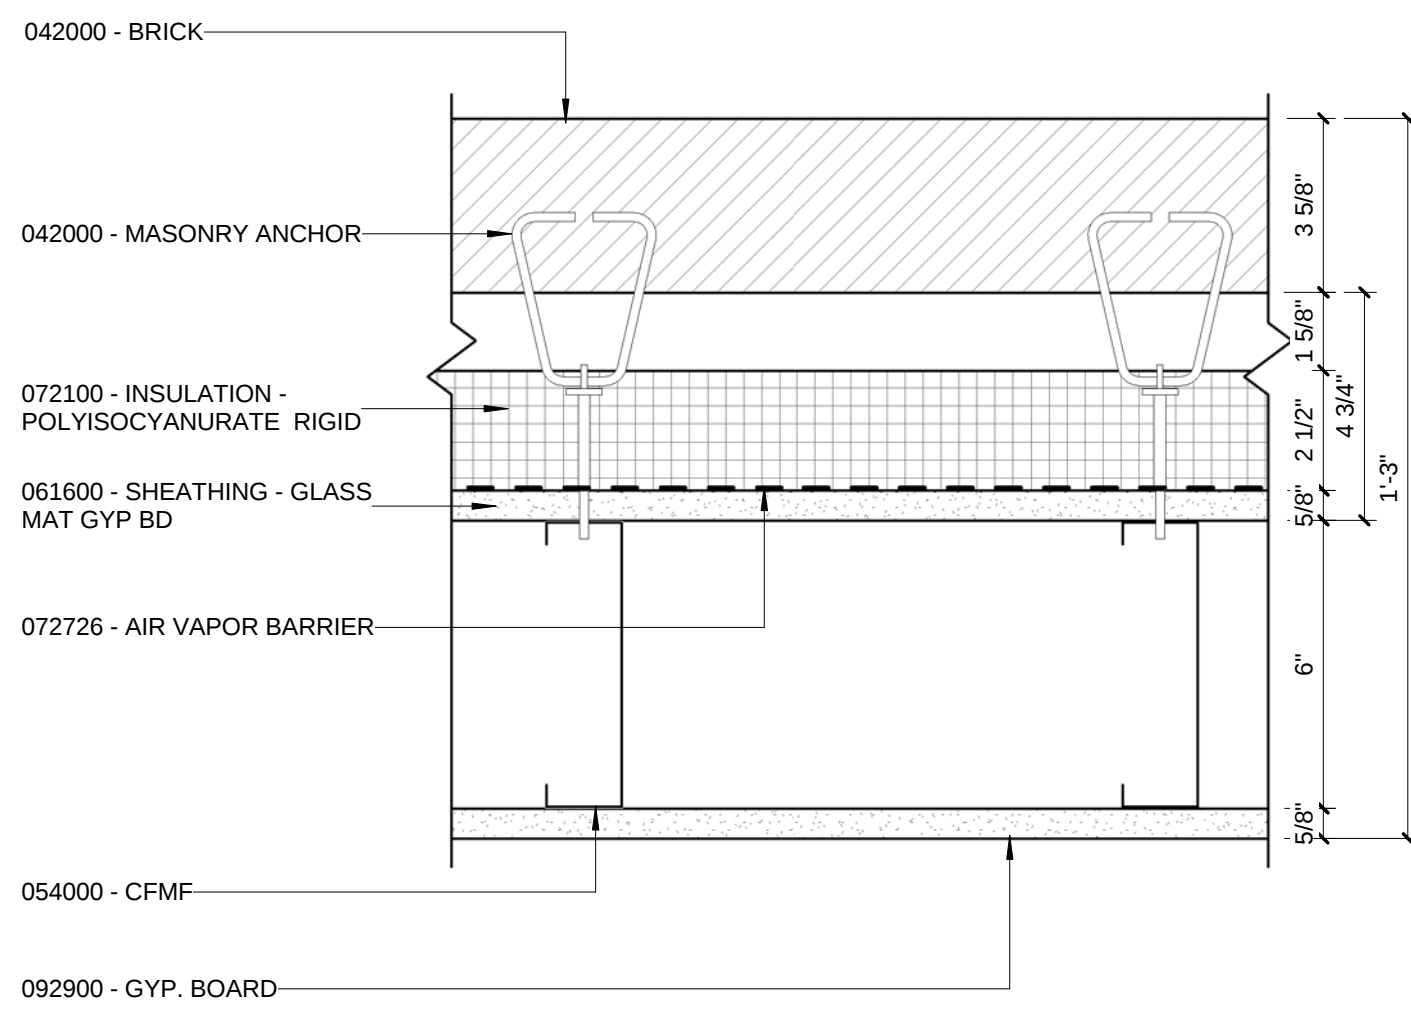

WALL ASSEMBLY - FACE BRICK OVER CFMF WITH INSULATION
(WA-B2 SIMILAR)

WA-B1

3" = 1'-0"