




© Cannon Design 2015
All rights reserved. No part of this document may be reproduced, stored in a retrieval system, or transmitted, in any form or by any means, without written authorization by The Cannon Corporation.
3/11/2016 12:42:53 PM

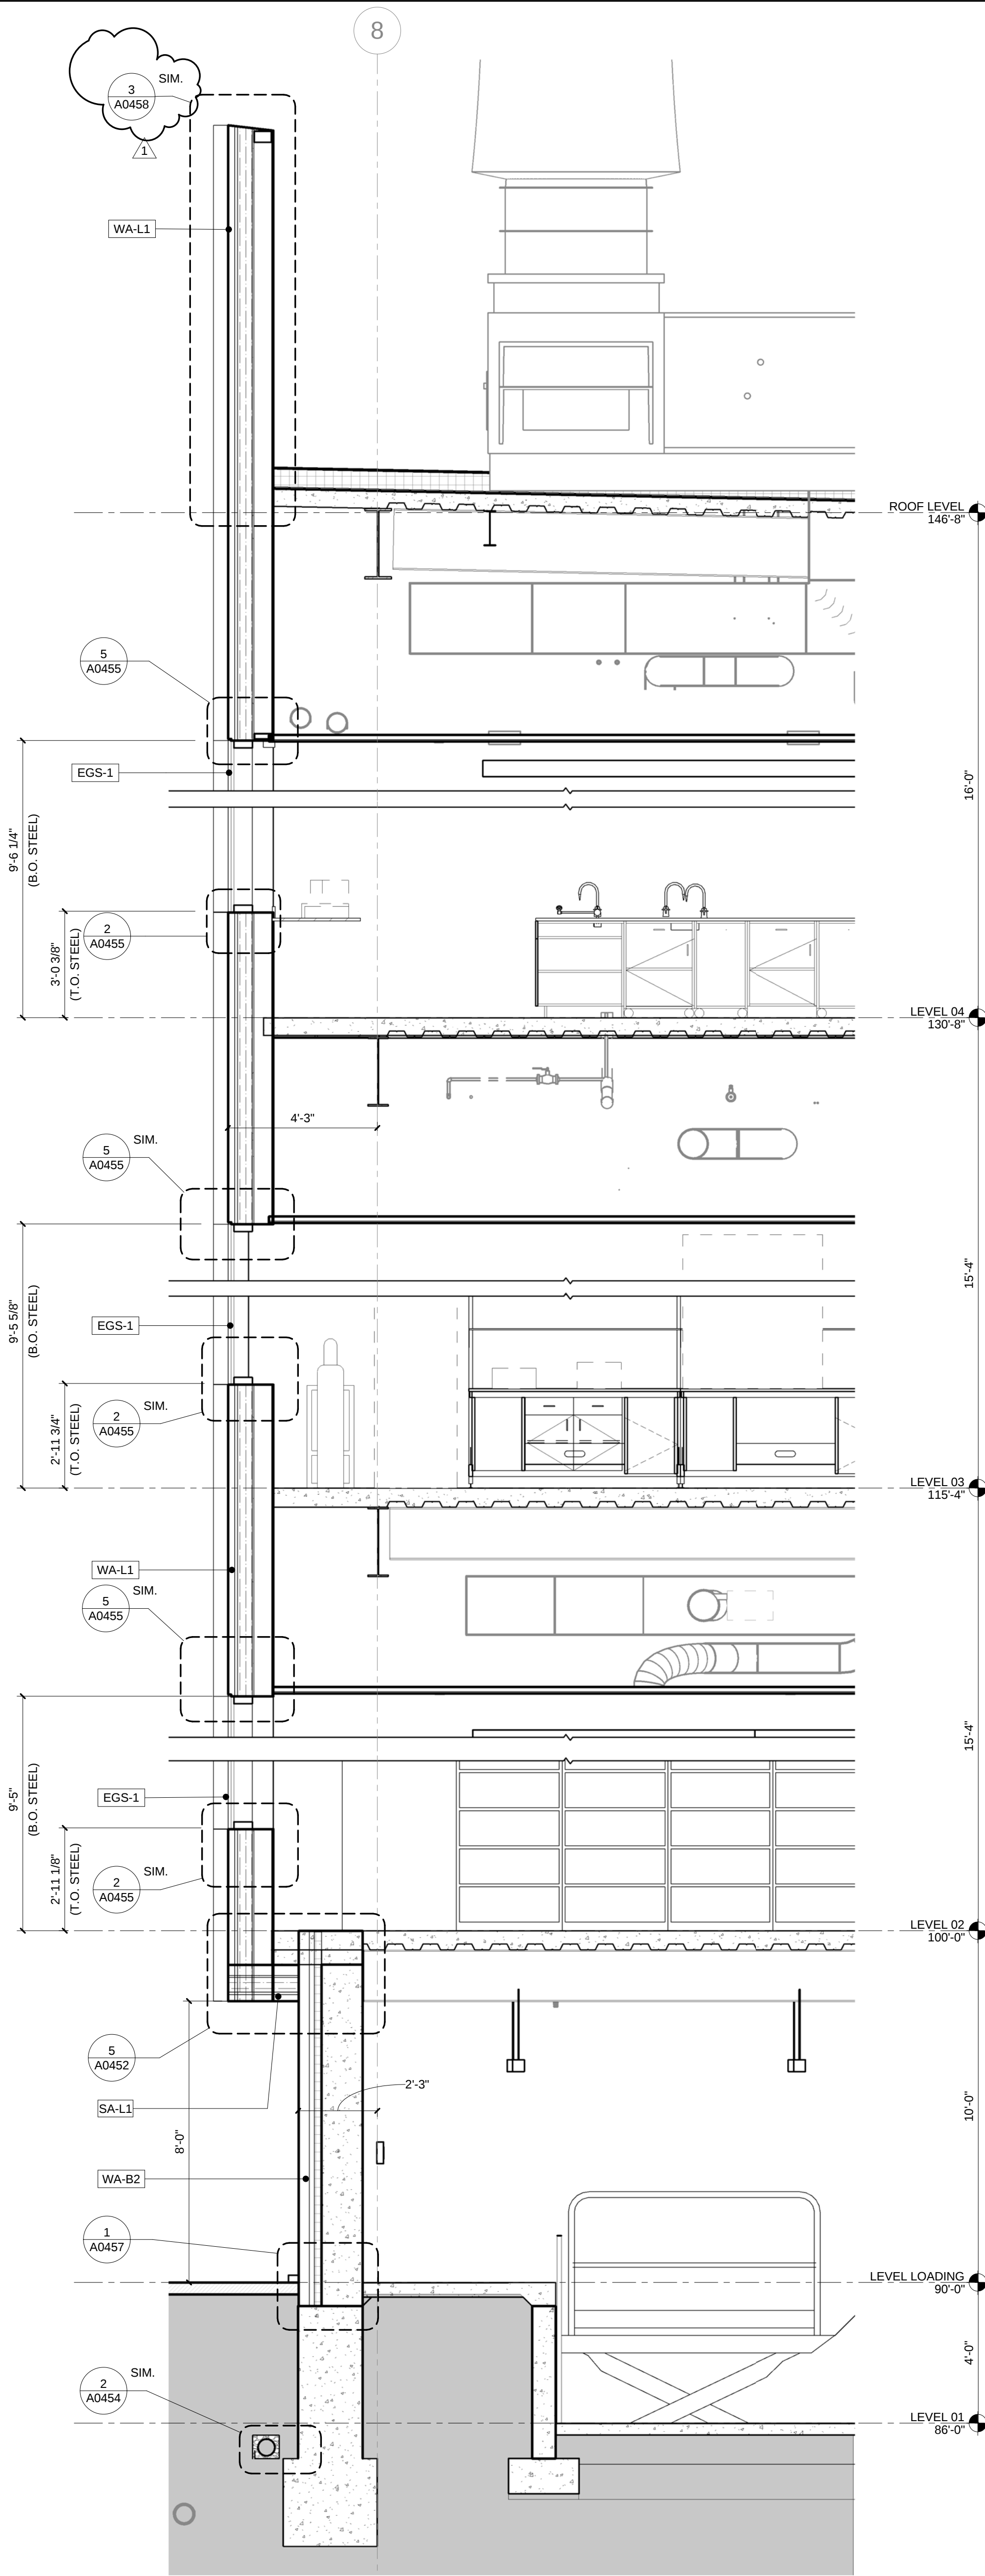


4 EAST WALL SECTION - METAL PANEL
3/8" = 1'-0"

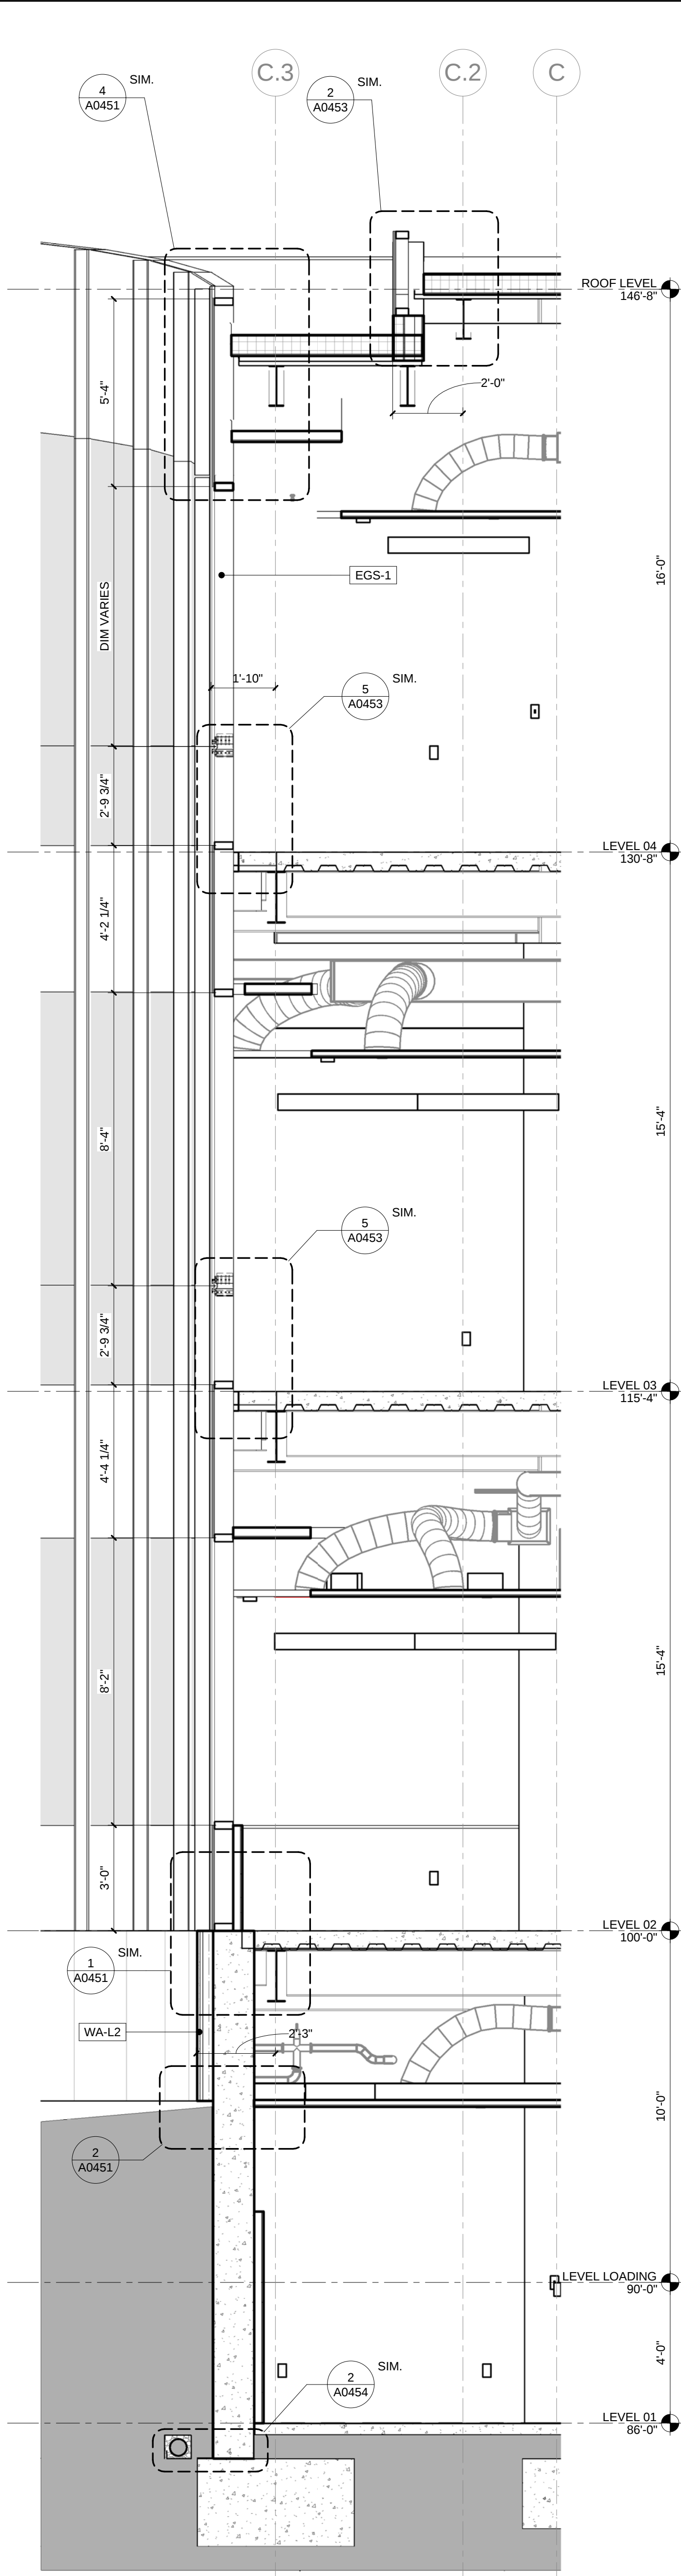

3 NORTH WALL SECTION C - SSG CURTAINWALL & WA-L2
3/8" = 1'-0"

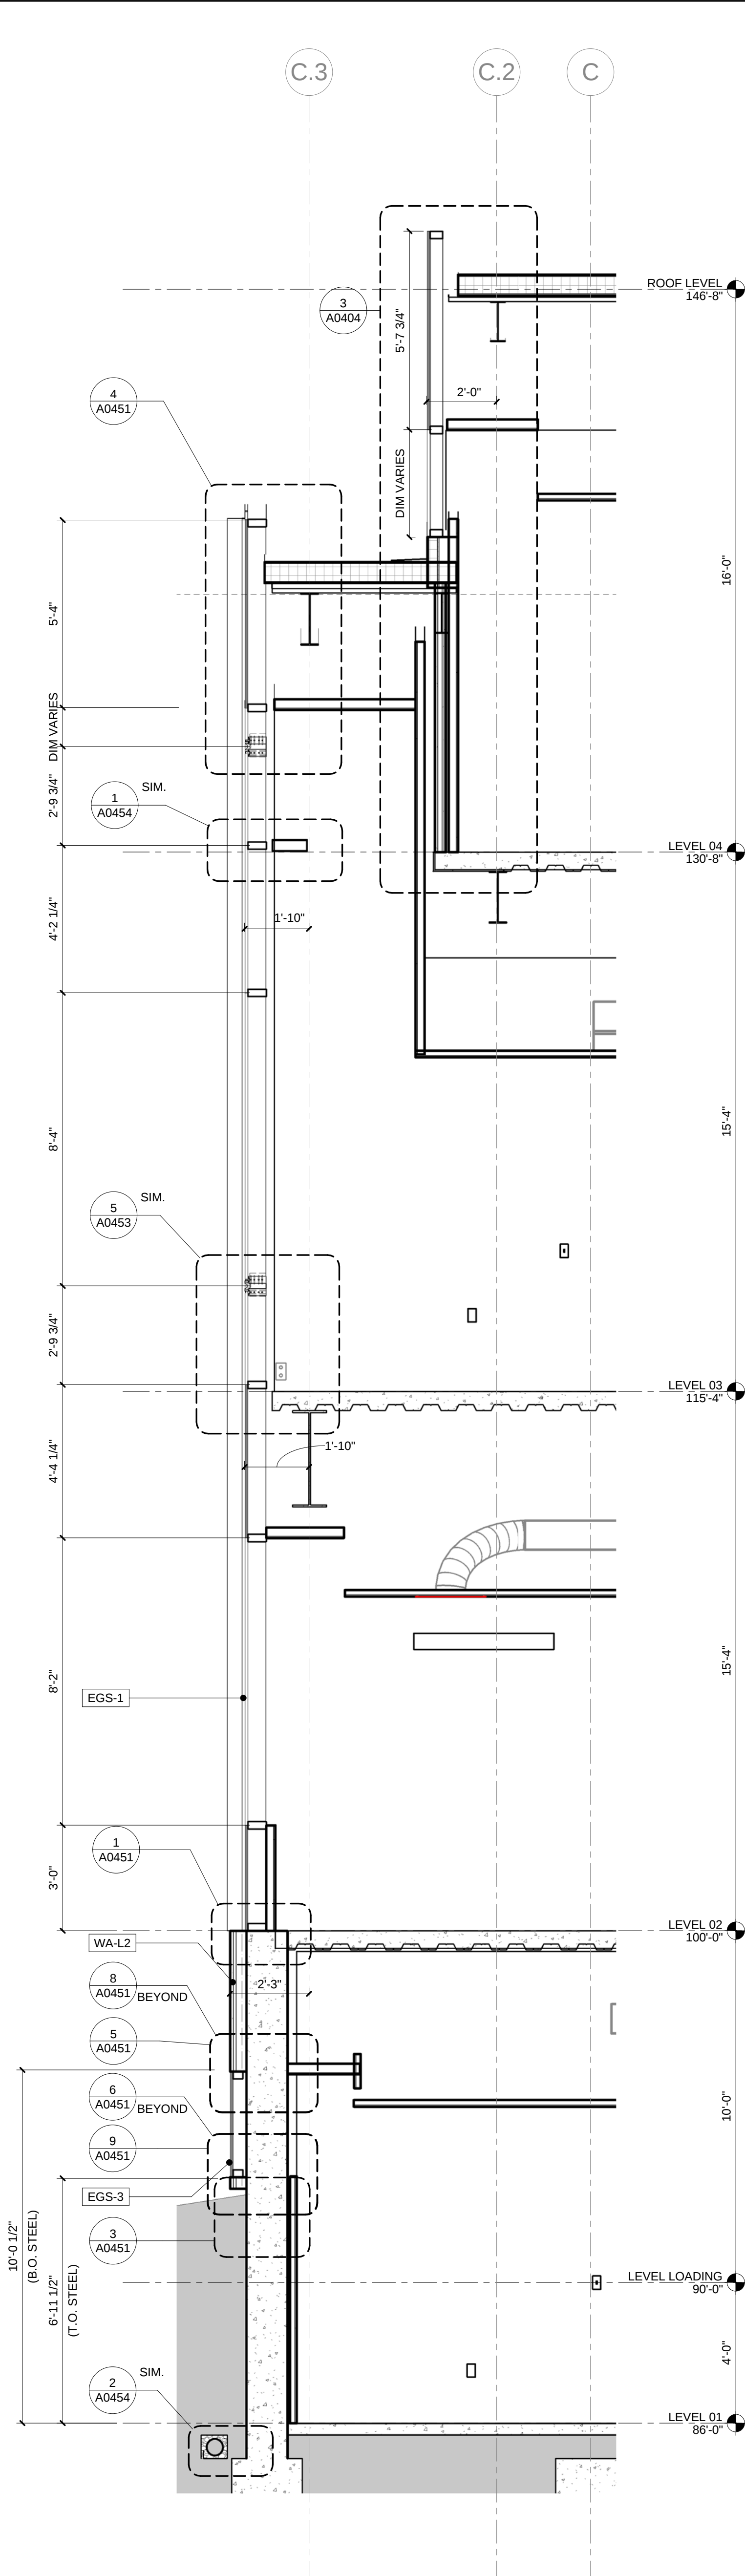

2 NORTH WALL SECTION B - SSG CURTAINWALL
3/8" = 1'-0"

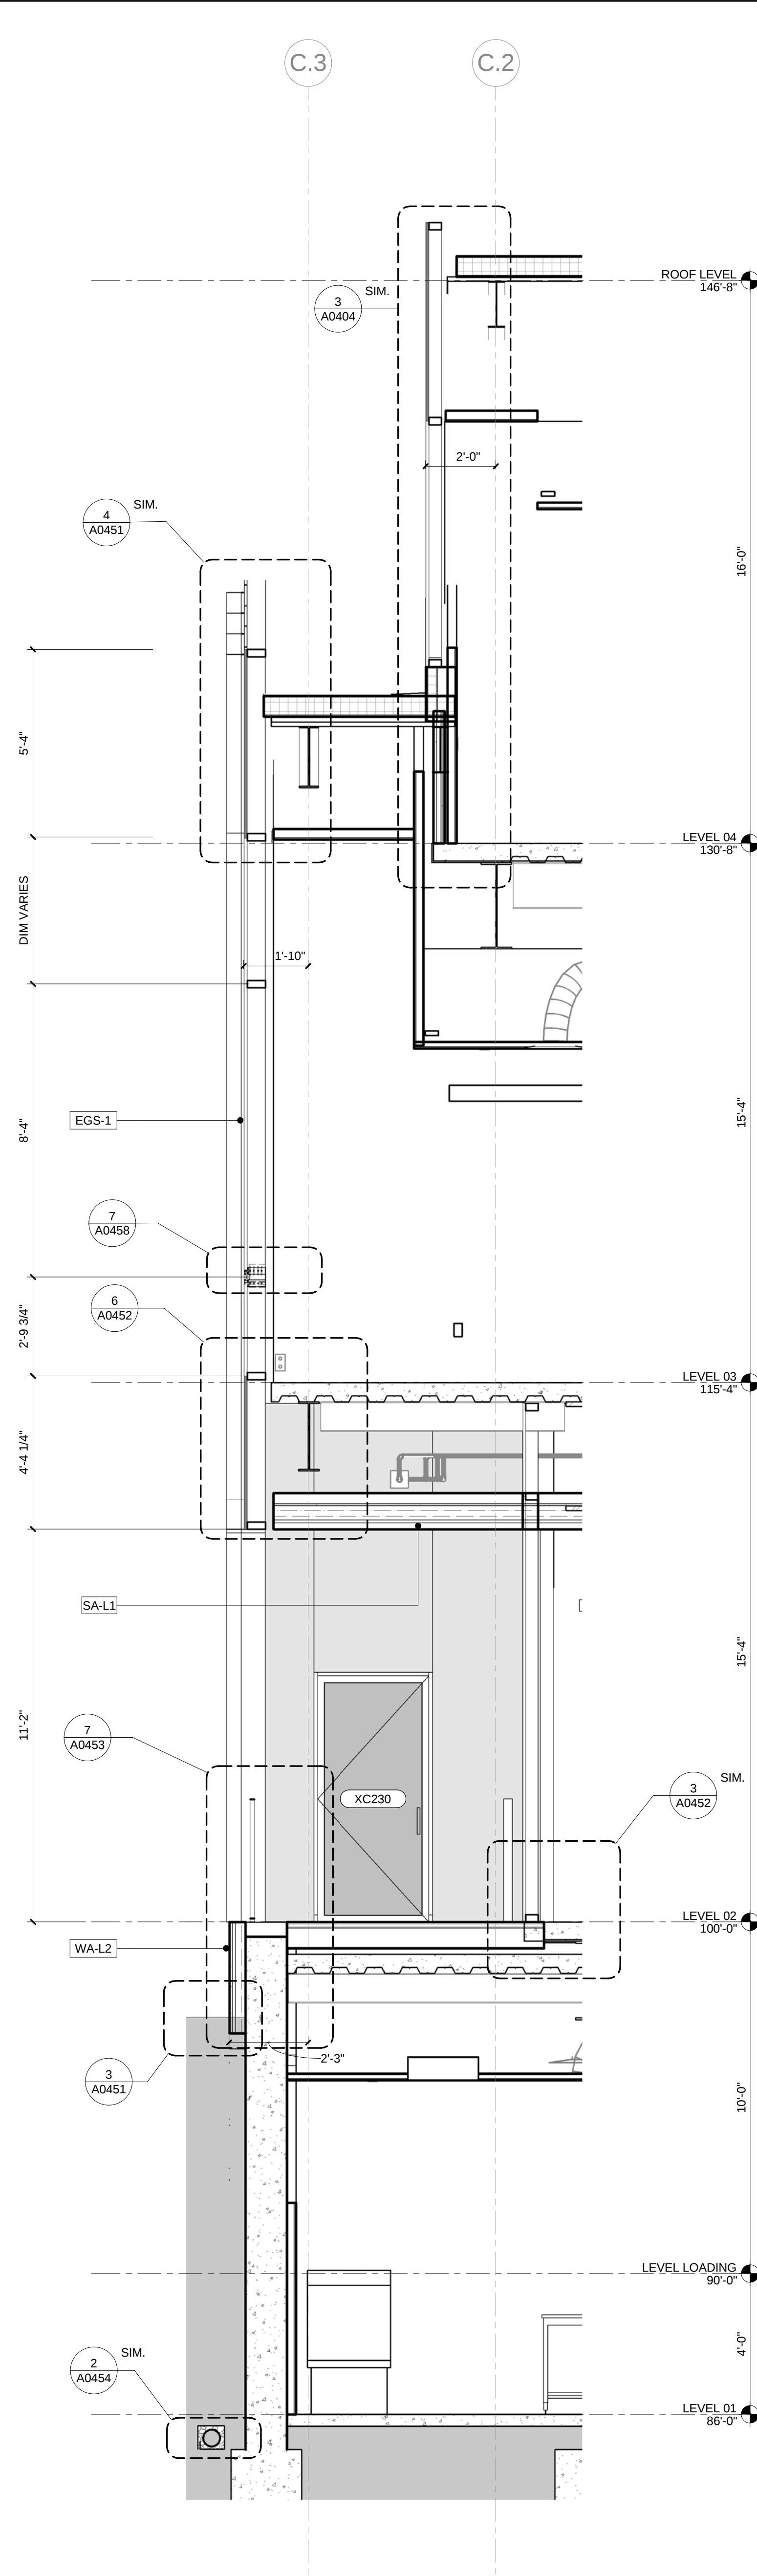

1 NORTH WALL SECTION A - OVERHANG
3/8" = 1'-0"