



© Cannon Design 2015
All rights reserved. No part of this document may be reproduced or transmitted in any form without written authorization by The Cannon Corporation.
1/28/2016 12:54:05 PM

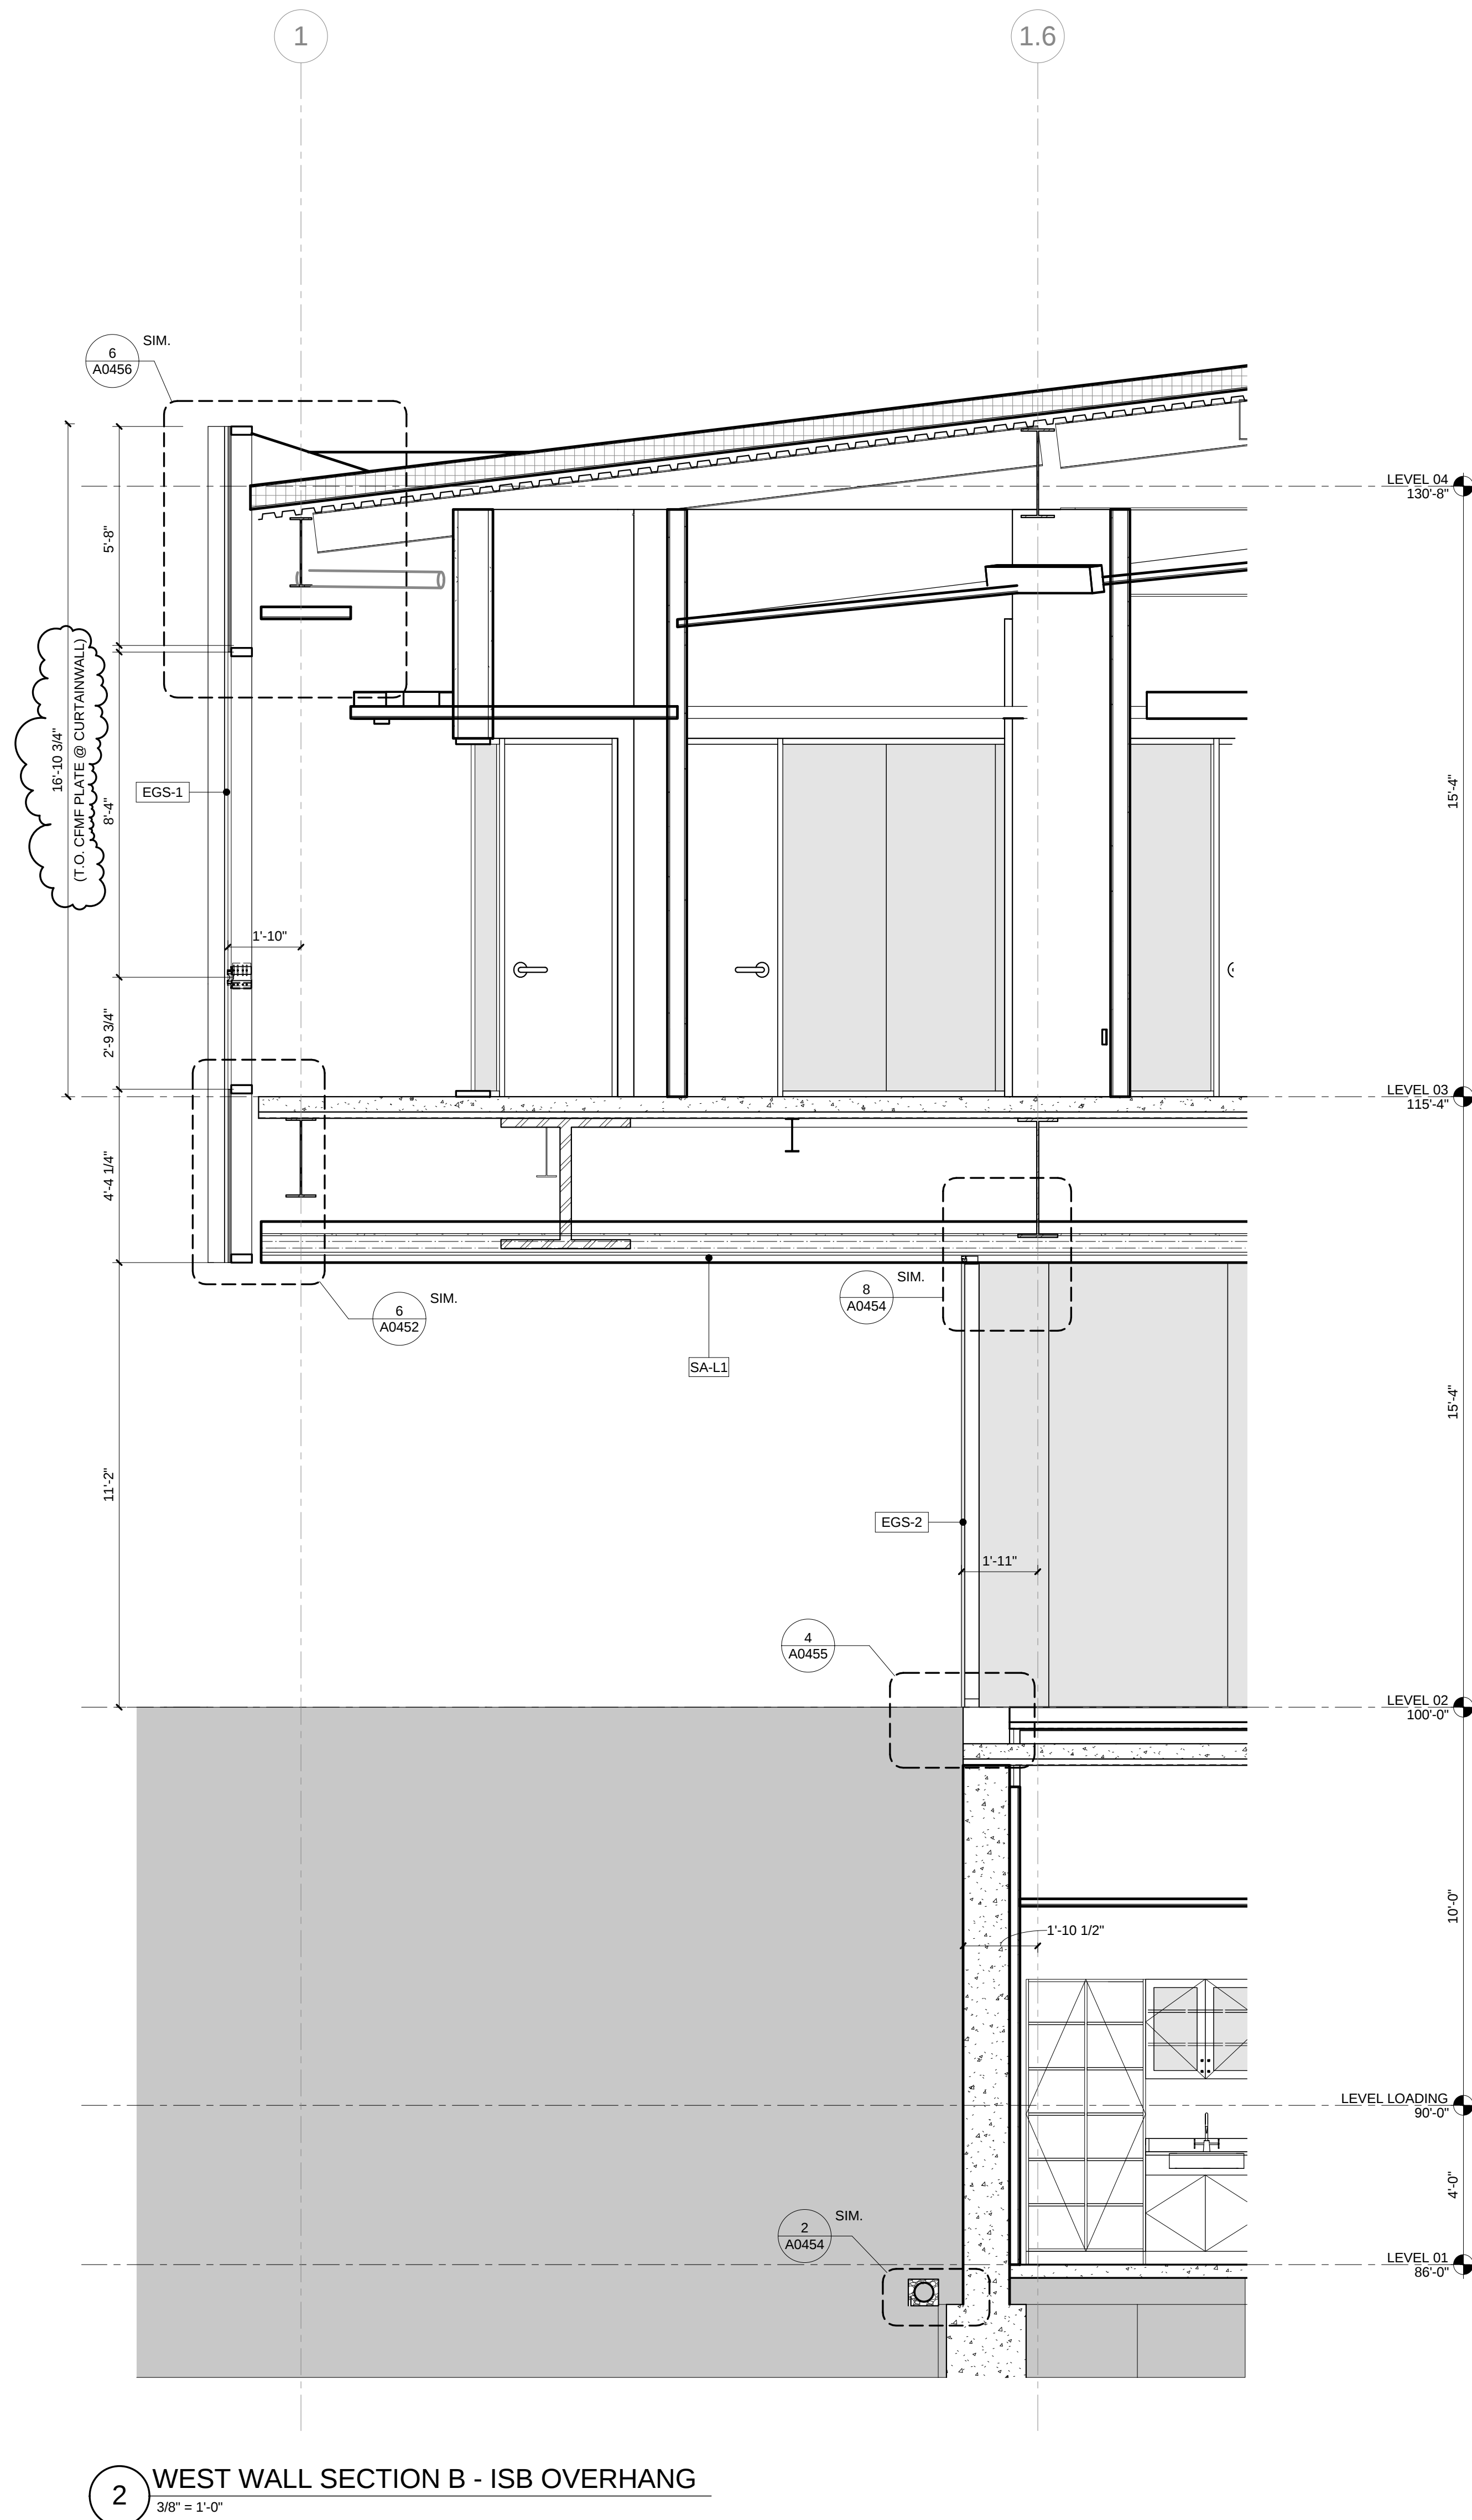

2 WEST WALL SECTION B - ISB OVERHANG
3/8" = 1'-0"

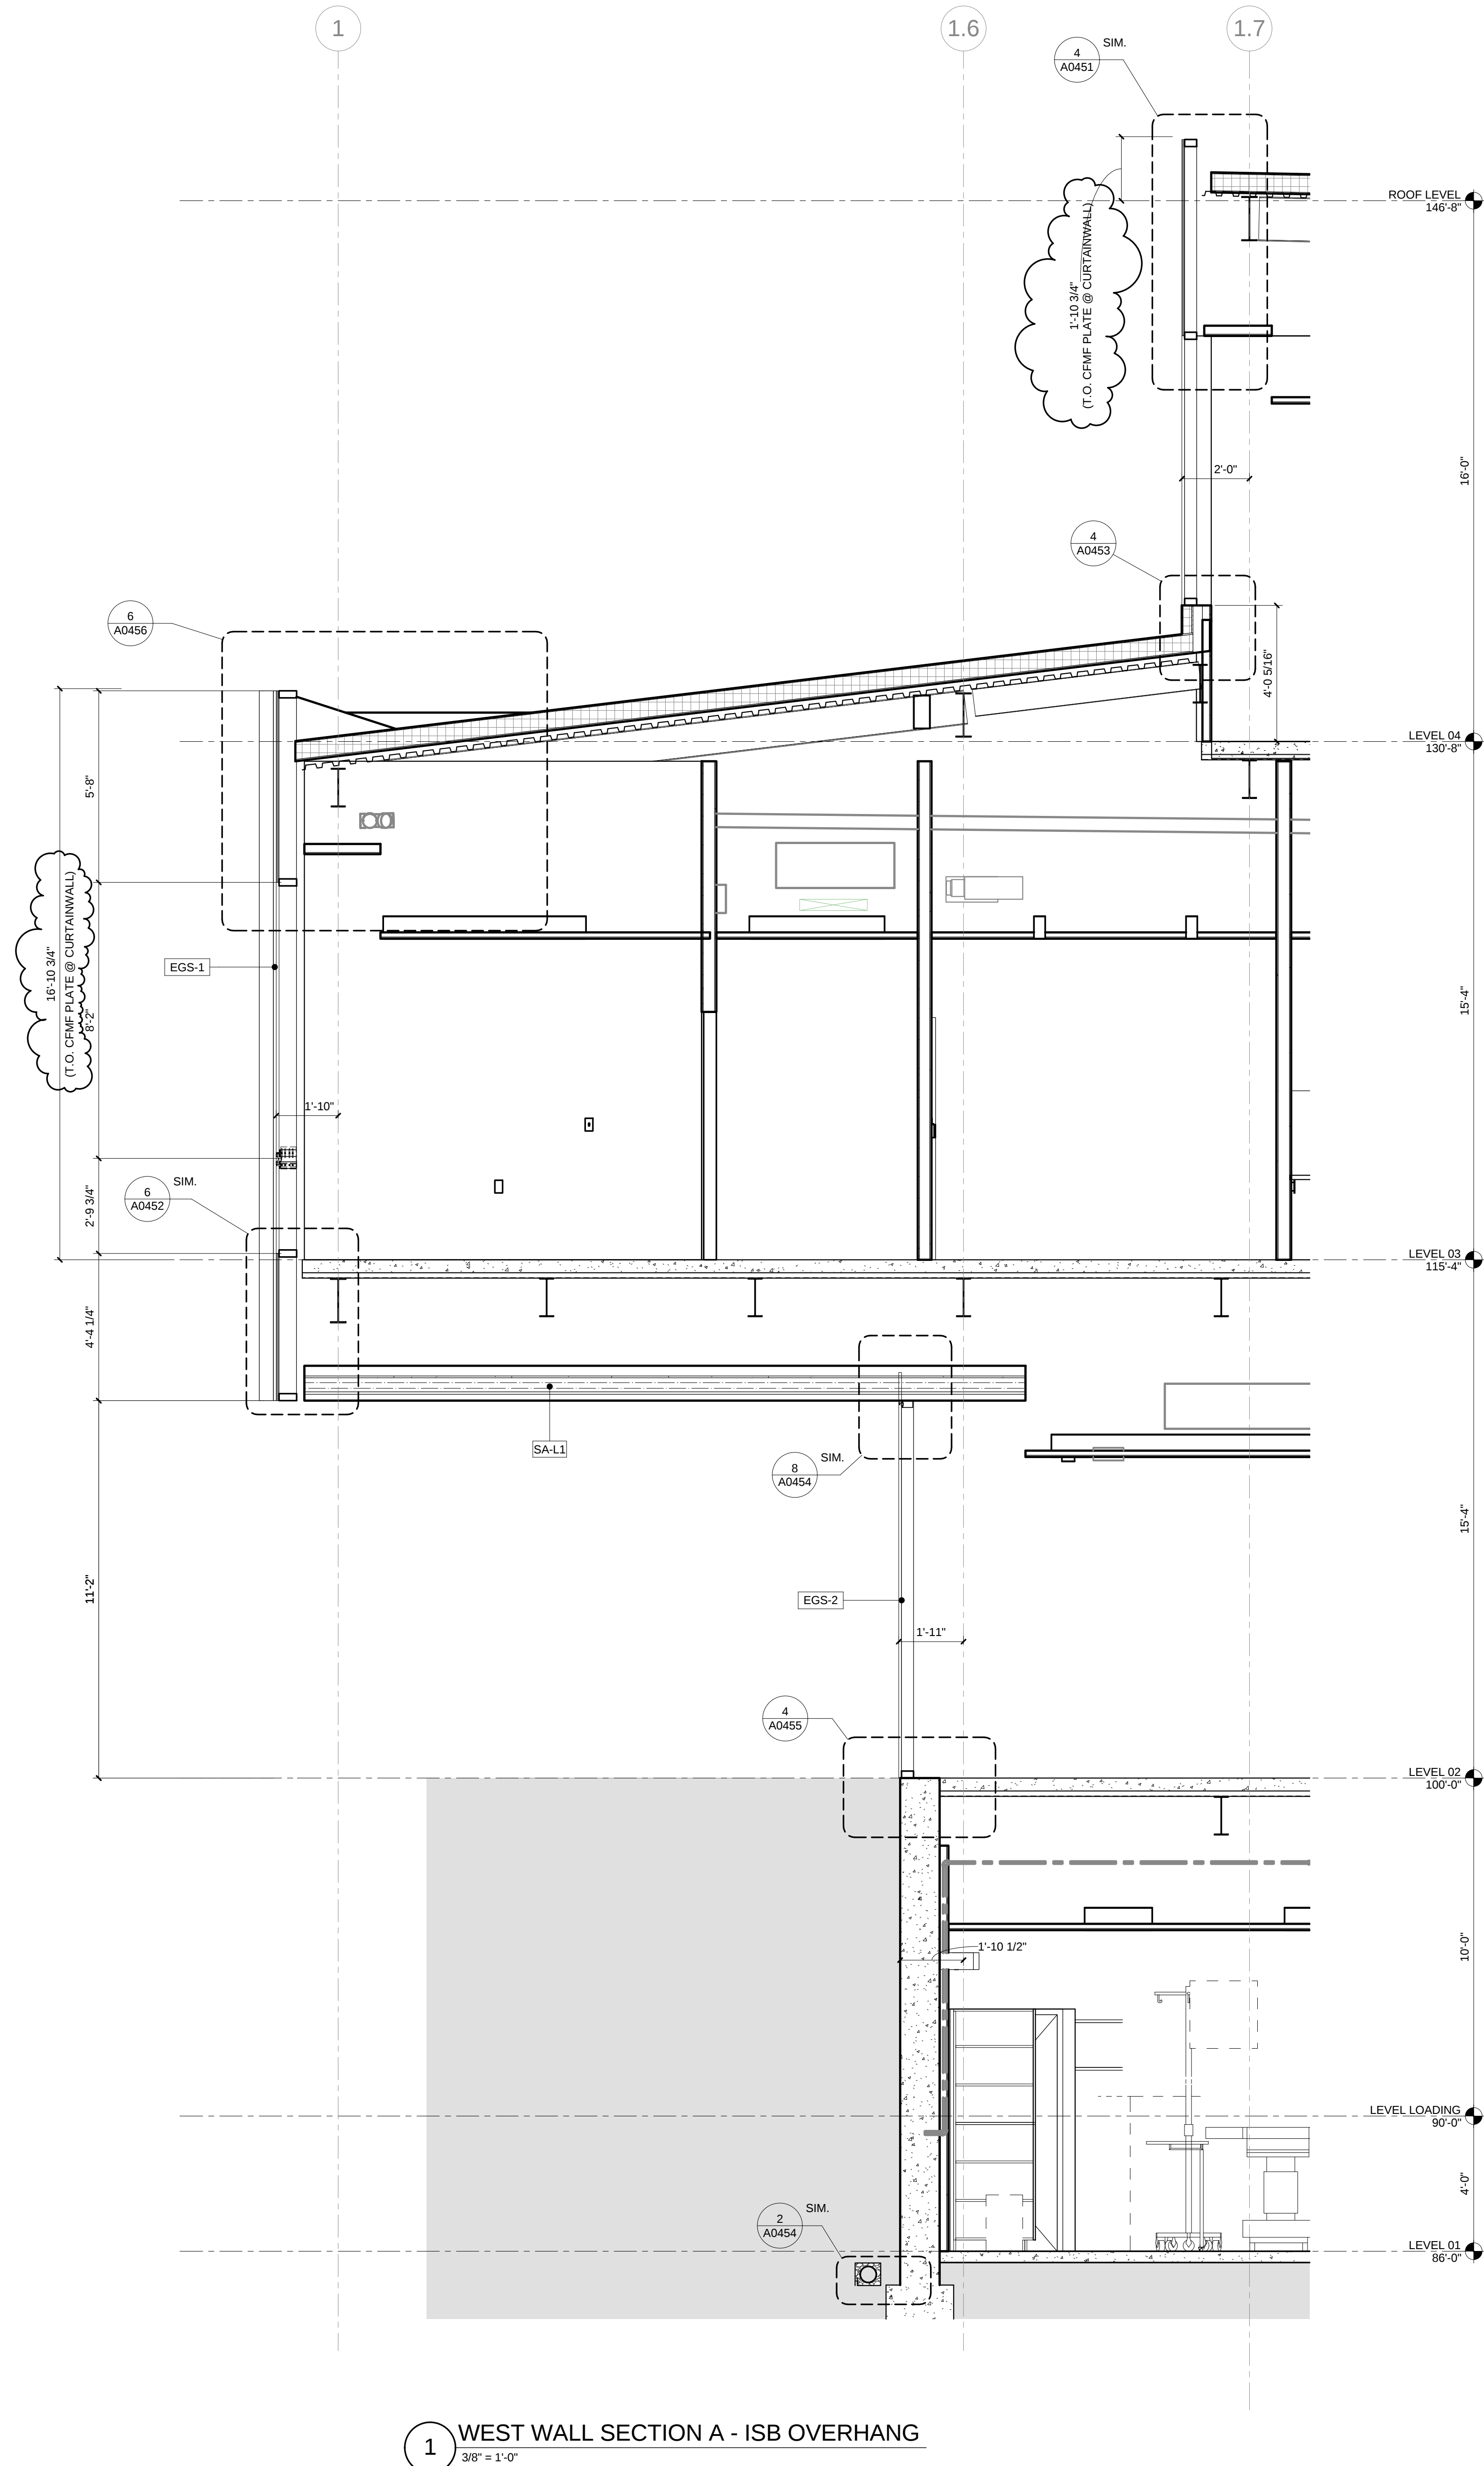

1 WEST WALL SECTION A - ISB OVERHANG
3/8" = 1'-0"

1	ADDENDUM 1-1	29 JAN 2016
	ISSUED FOR CONSTRUCTION (BP1)	15 JAN 2016
No.	Description	Date

Drawing Title:

WALL SECTIONS

Project No.: 04561.01 Checked by:

A0406