



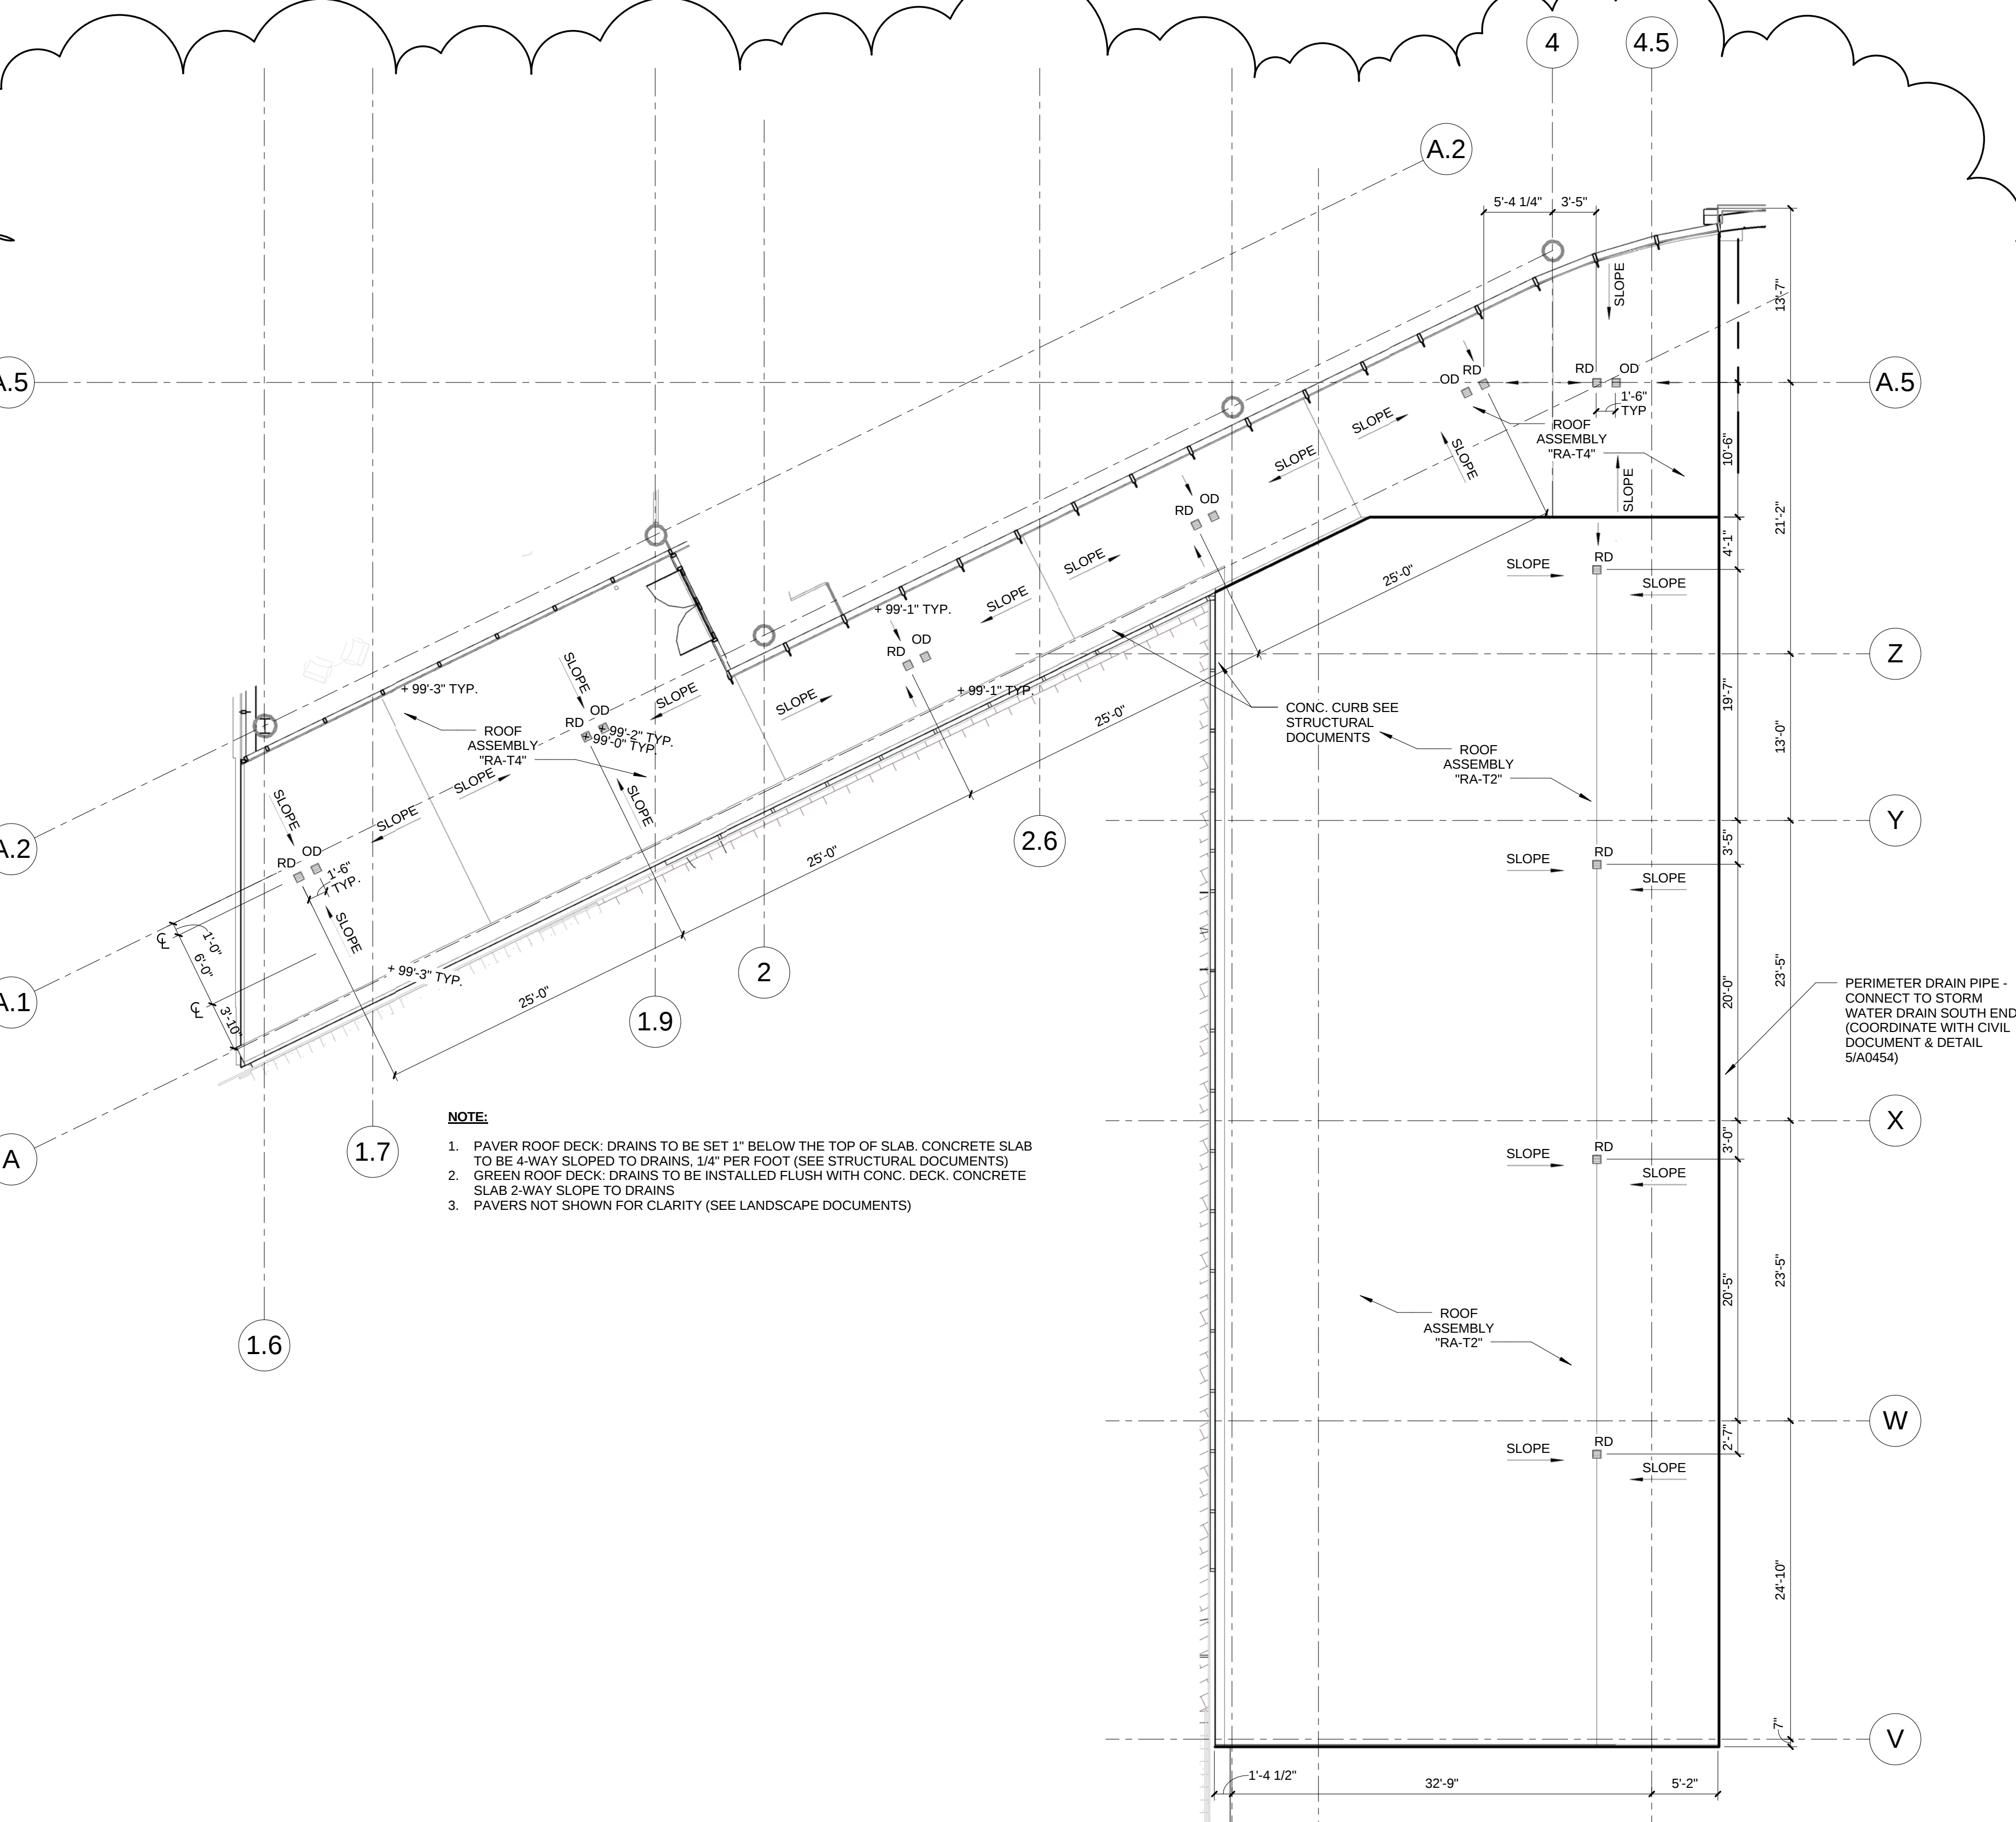

3 PLAN DETAIL - GREEN ROOF & SOUTH PAVER ROOF
1/8" = 1'-0"

4 PLAN DETAIL - NORTH PAVER ROOF PLAN
1/8" = 1'-0"

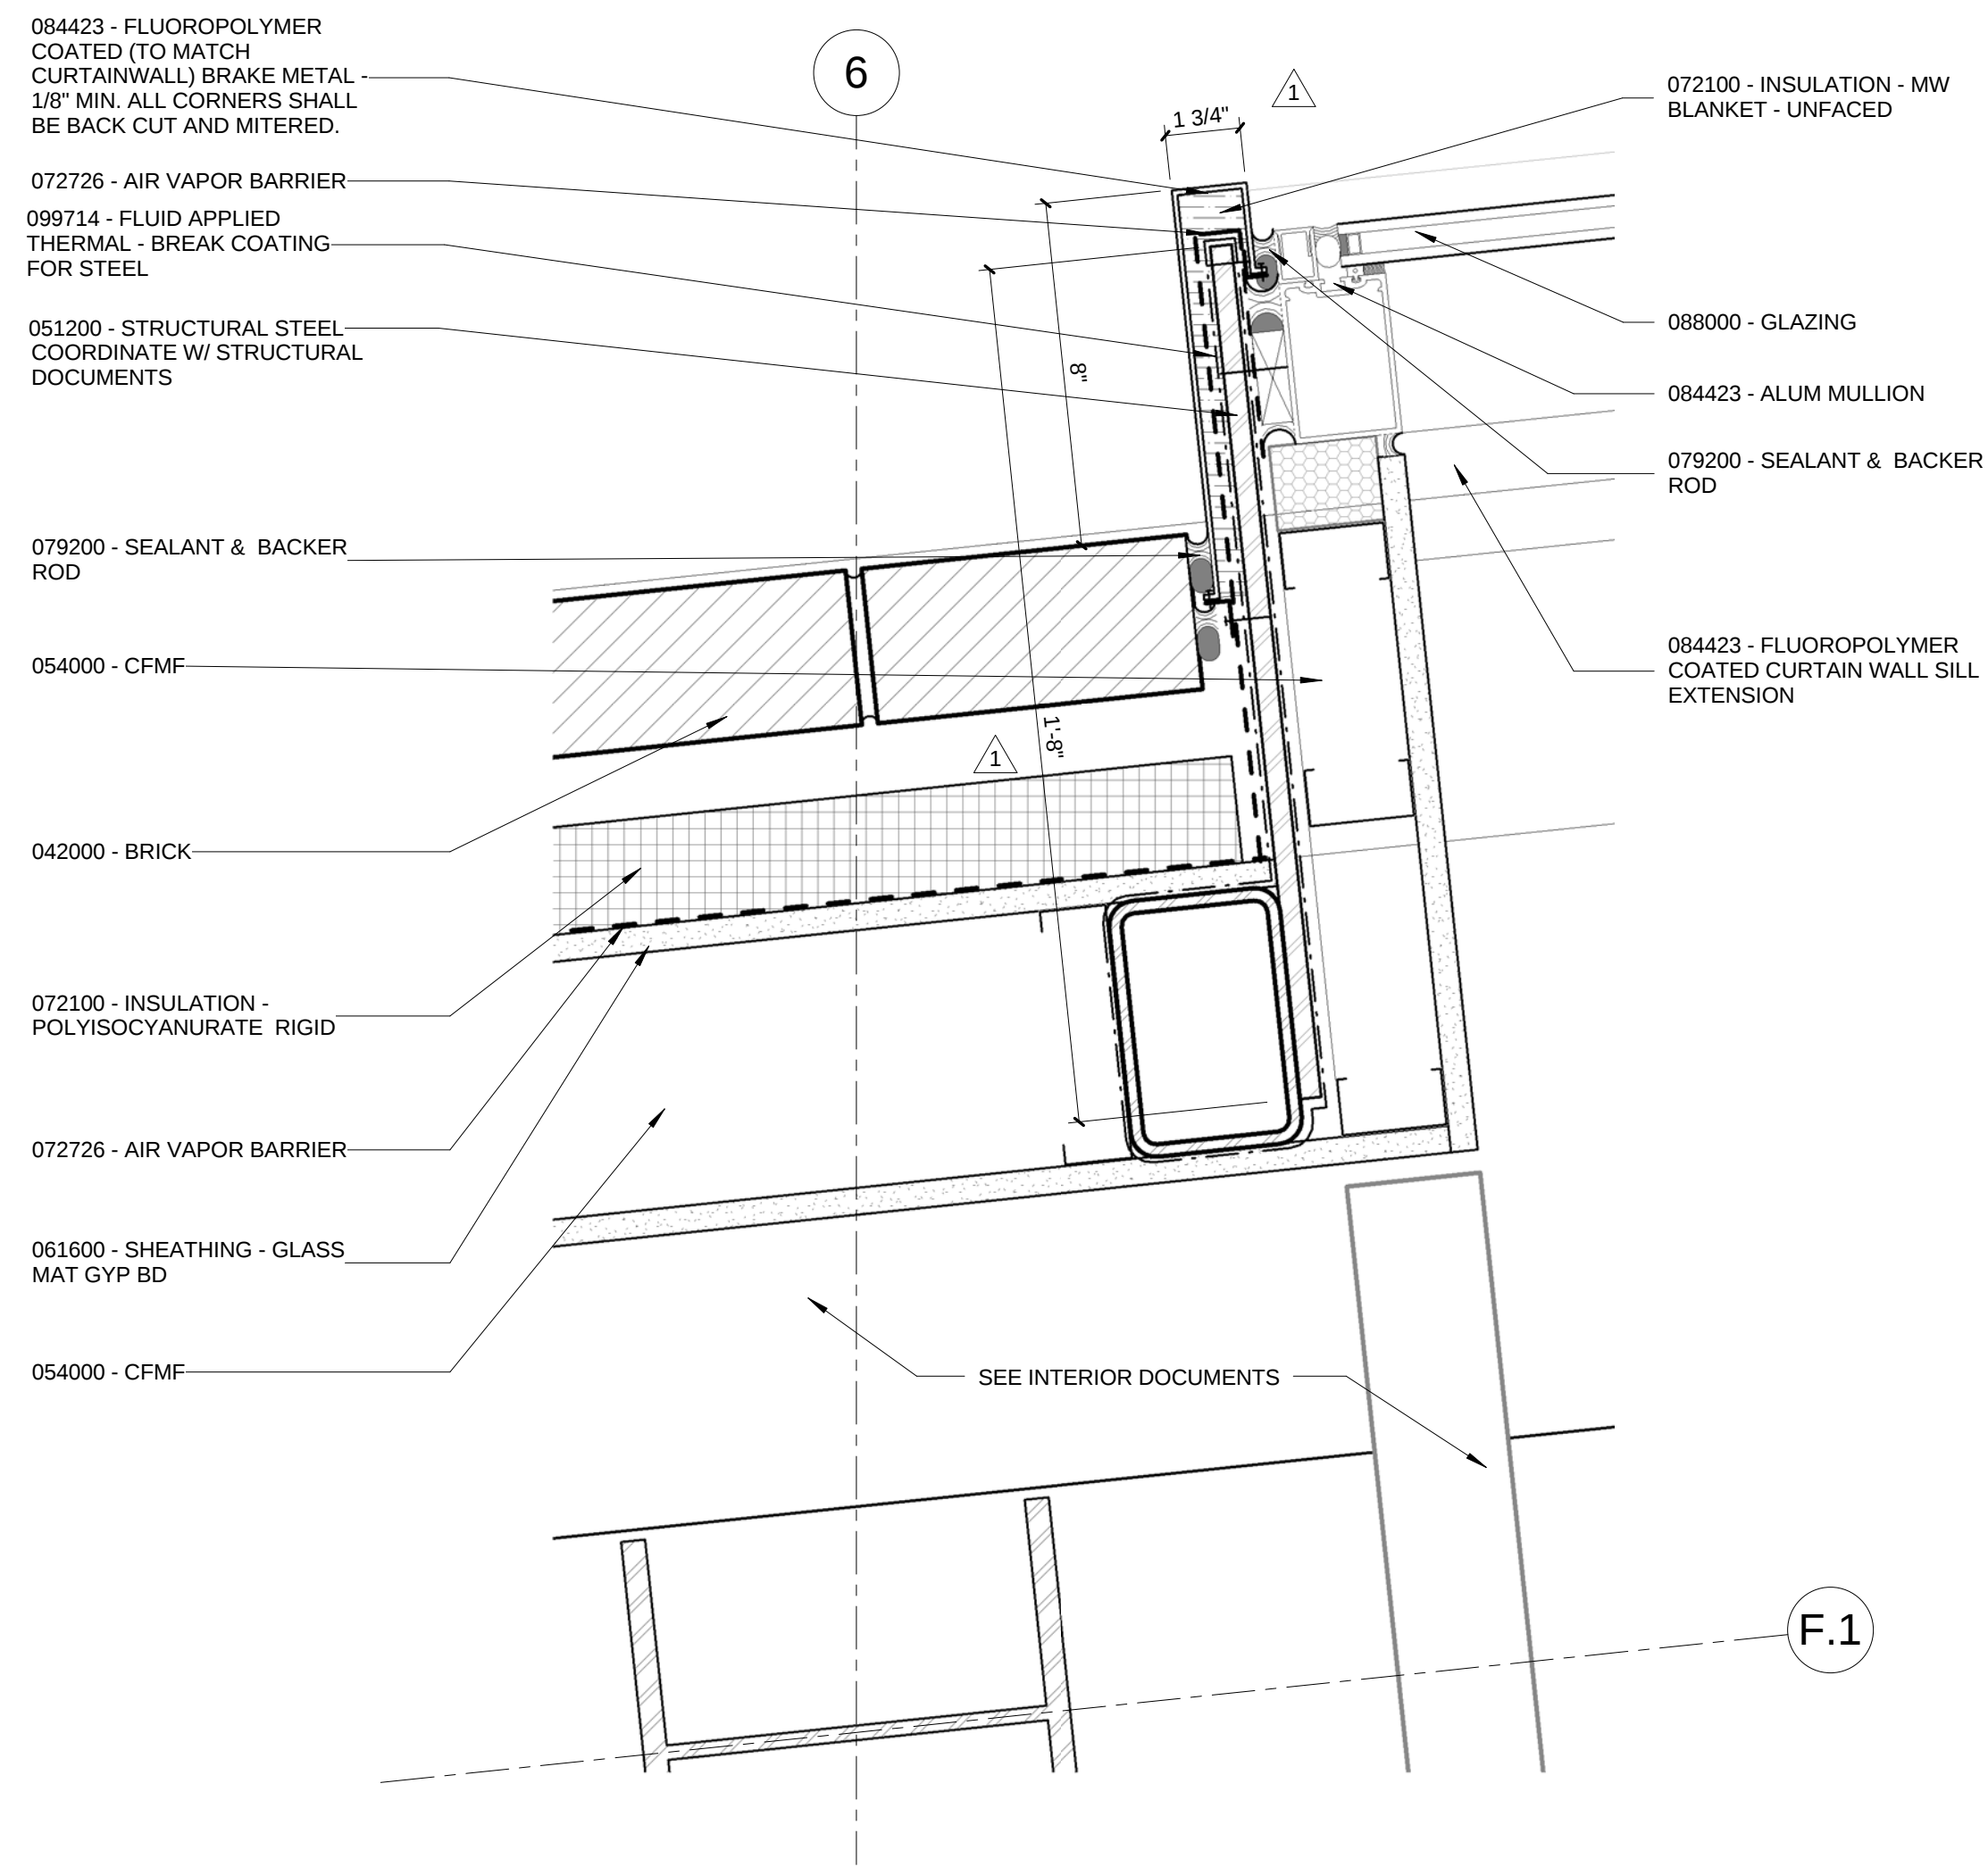

1 PLAN DETAIL - NORTH PROJECTED CURTAINWALL
3" = 1'-0"

2 PLAN DETAIL - CUSTOM MULLION @ CURVED CURTAINWALL
3" = 1'-0"