




© Cannon Design 2015
All rights reserved. No part of this document may be reproduced or transmitted in any form or by any means, electronic or mechanical, including photocopying, recording, or by any information storage and retrieval system, without written authorization by The Cannon Corporation.
1/28/2016 12:54:17 PM

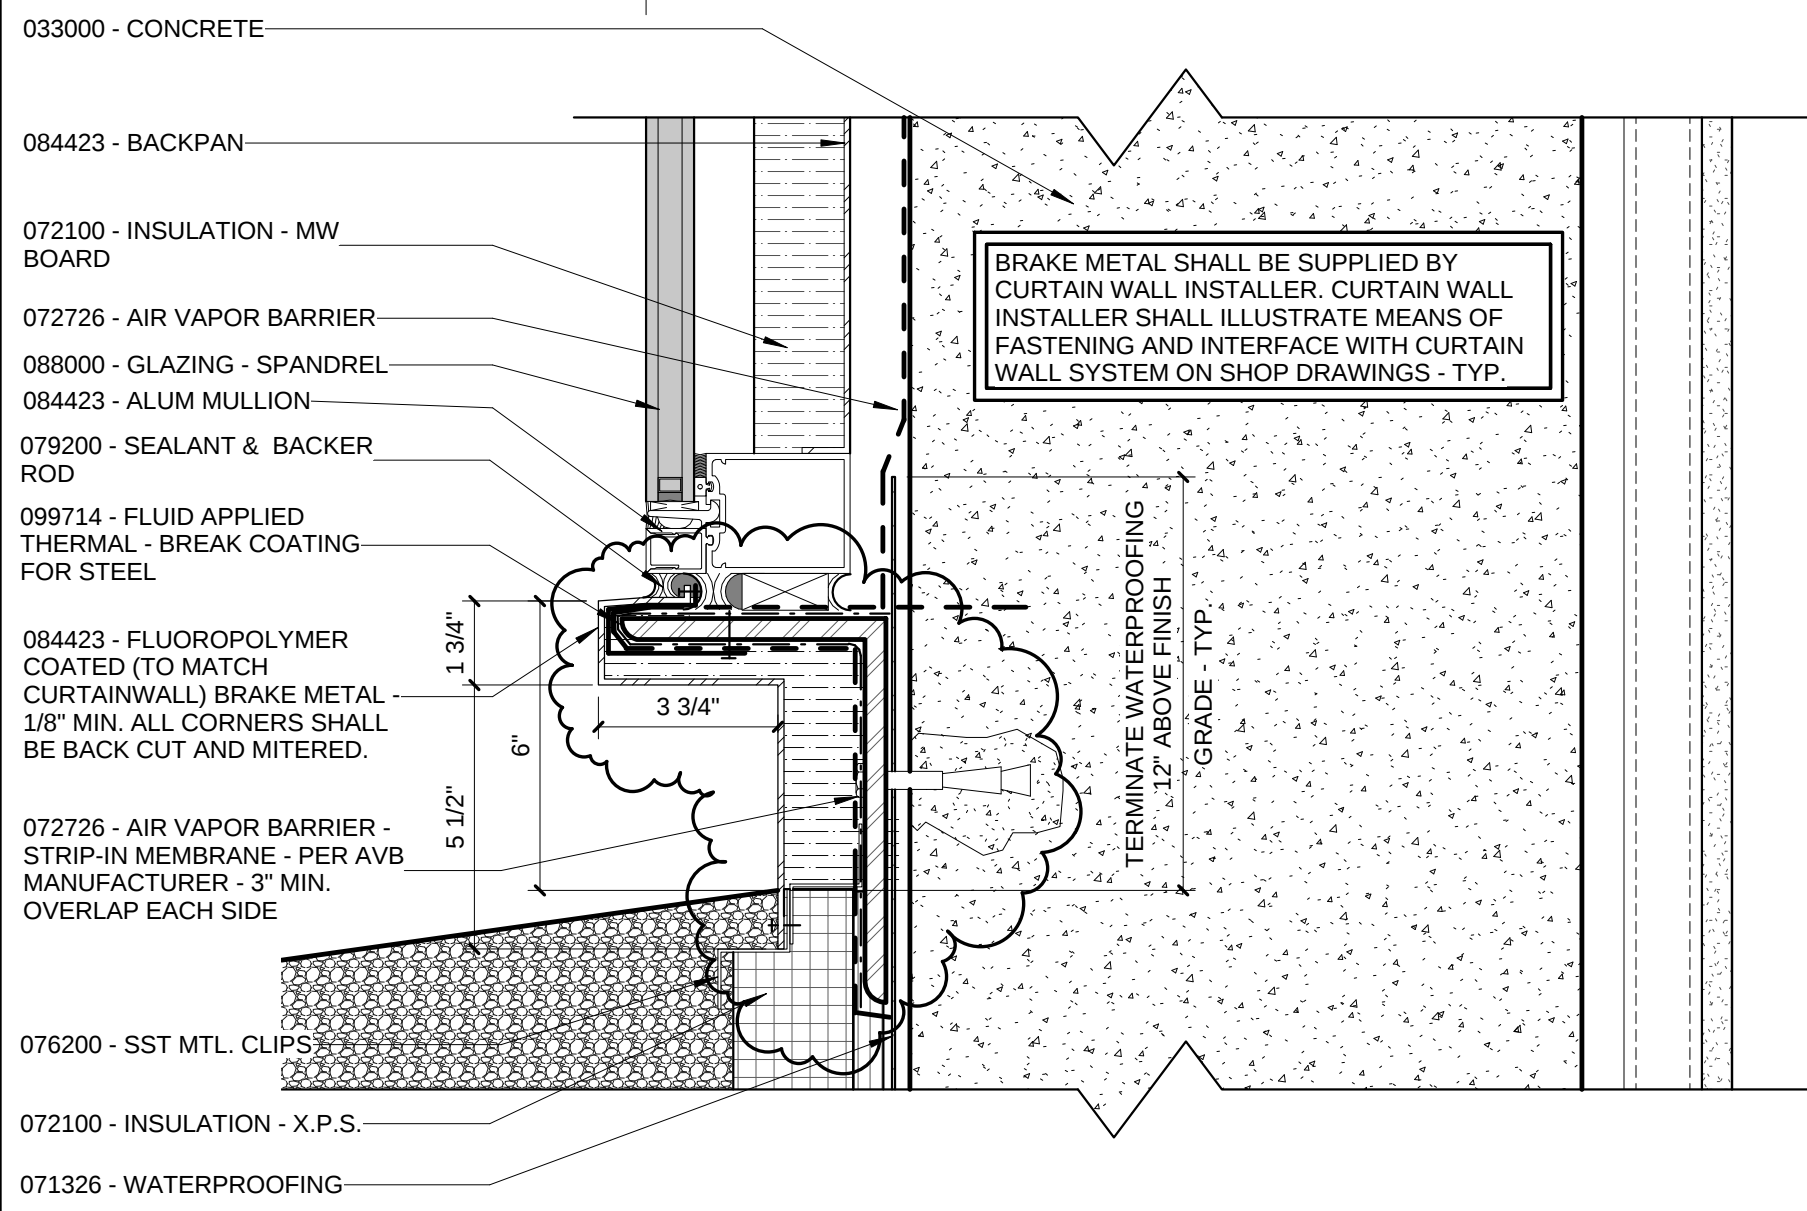


9 ENLARGED DETAIL - WA-L2 SILL @ SPANDREL GLAZING
3" = 1'-0"

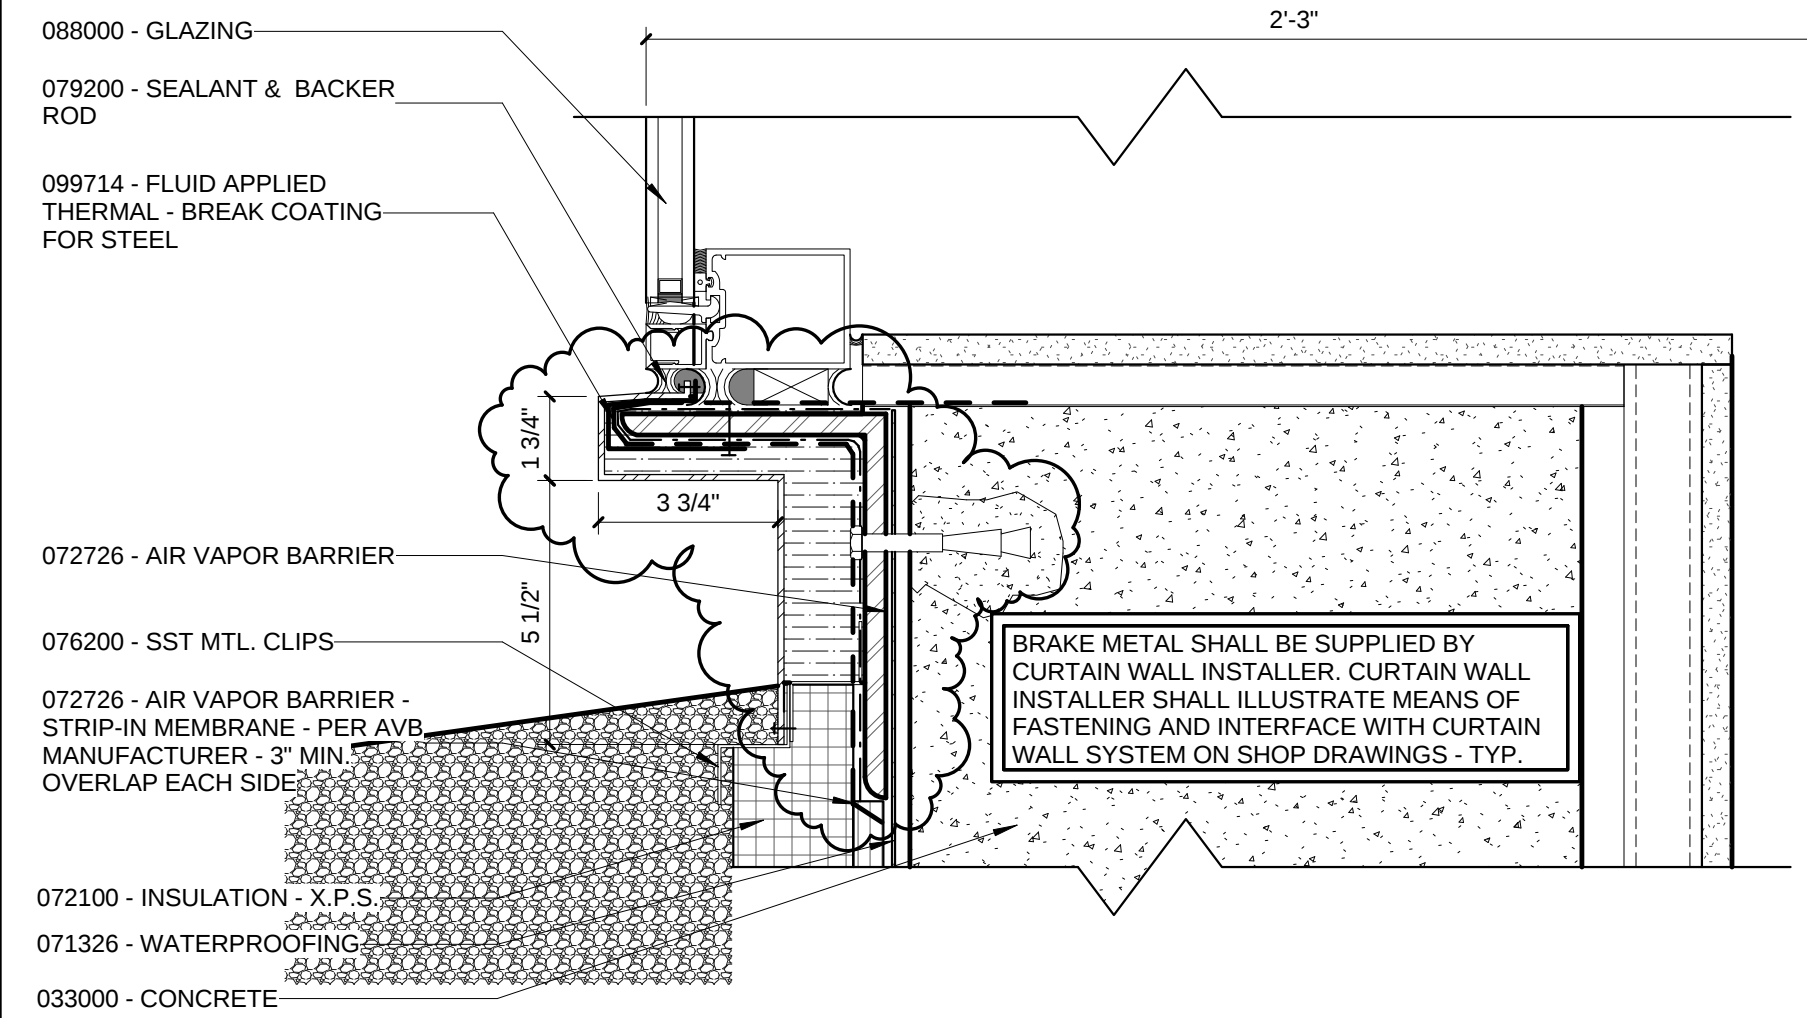


6 ENLARGED DETAIL - WA-L2 SILL @ VISION GLAZING
3" = 1'-0"

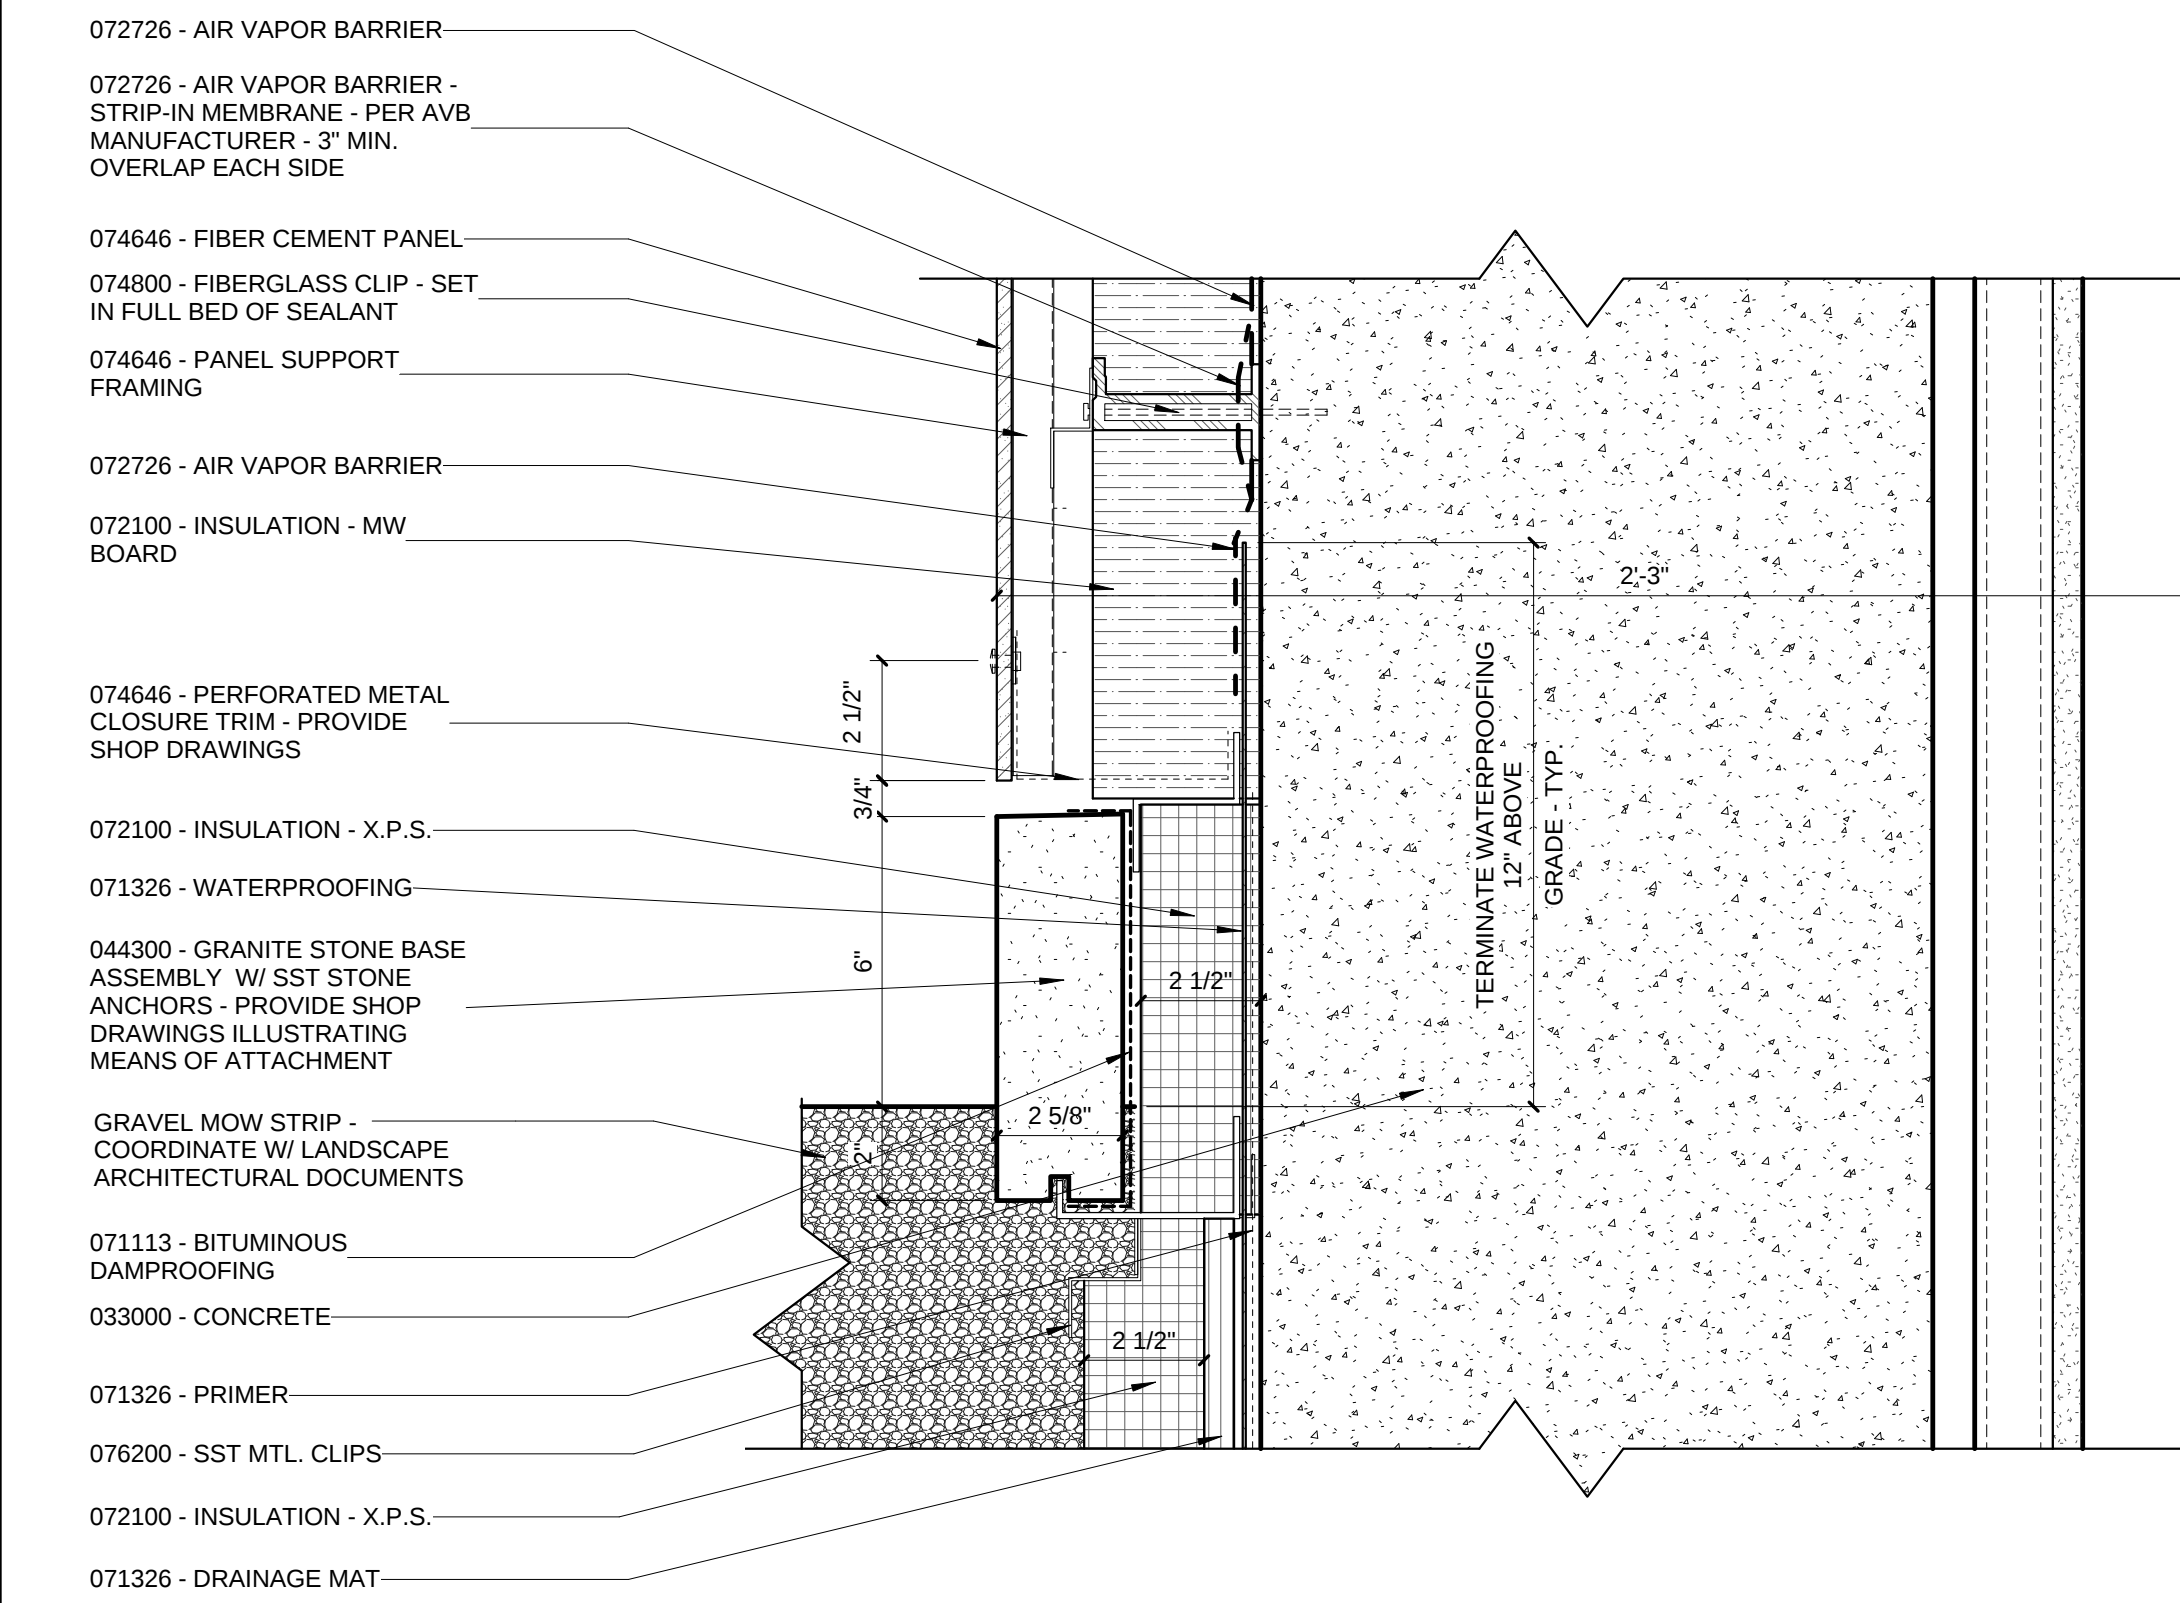


3 ENLARGED DETAIL - WA-L2 GRADE TERMINATION W/ GRANITE BASE
3" = 1'-0"

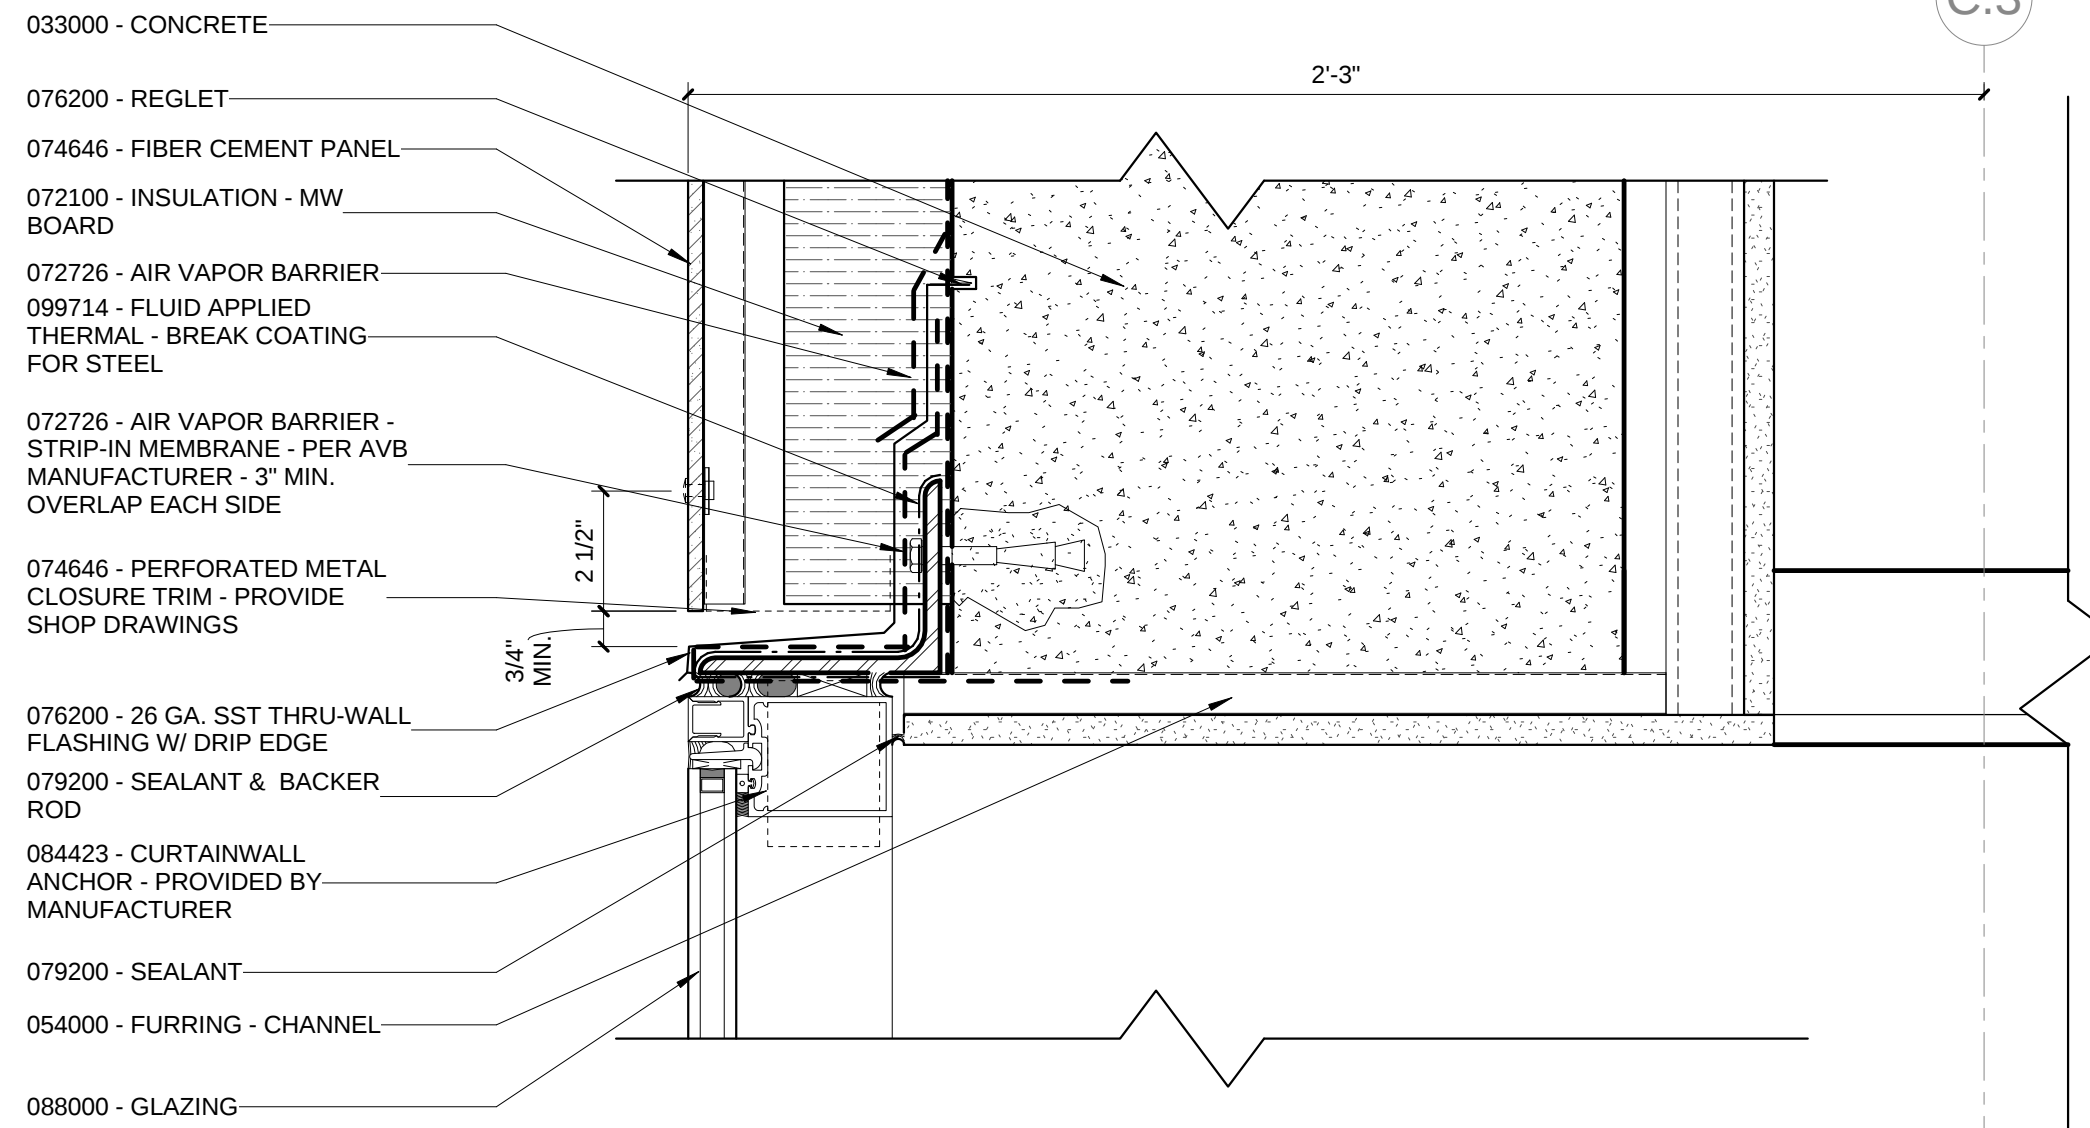


8 ENLARGED DETAIL - WA-L2 @ HEAD OF VISION GLAZING
3" = 1'-0"

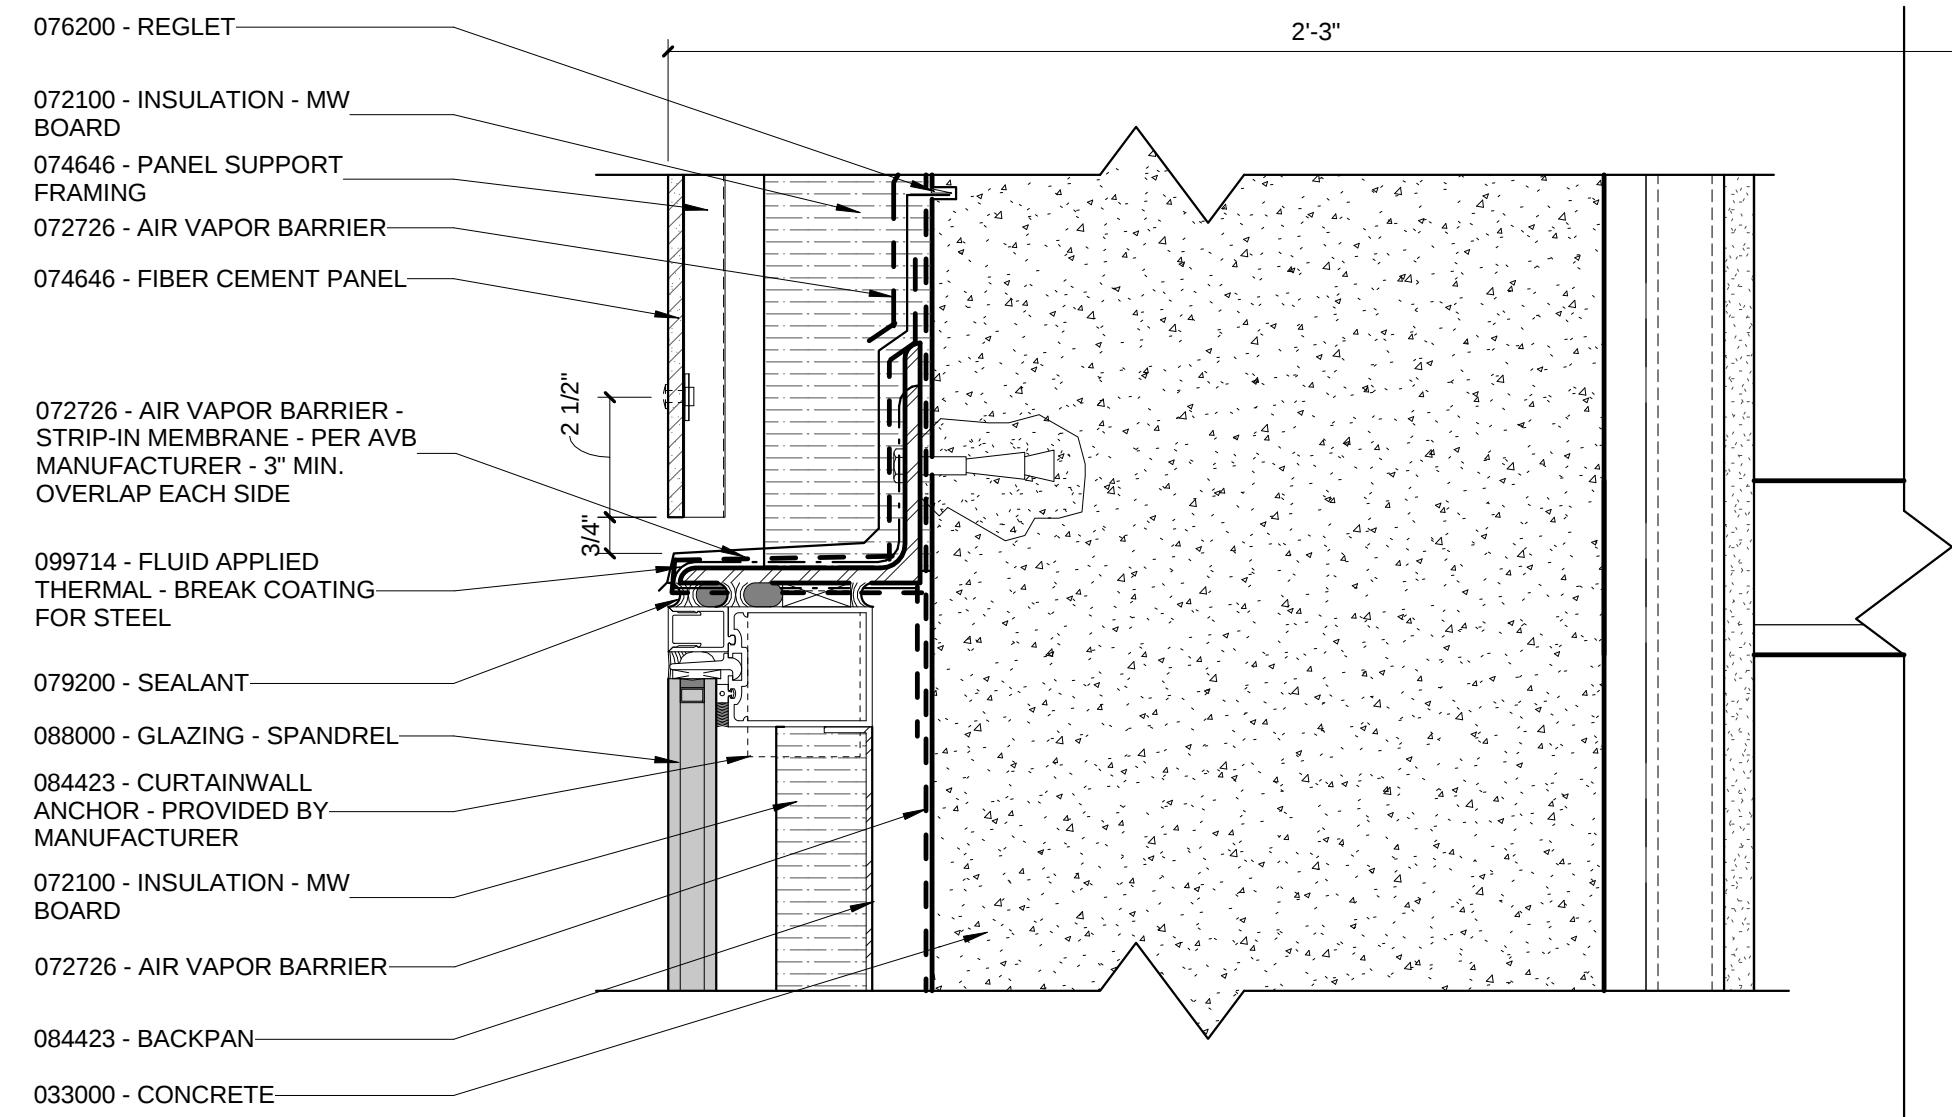


5 ENLARGED DETAIL - WA-L2 @ HEAD OF SPANDREL GLAZING
3" = 1'-0"

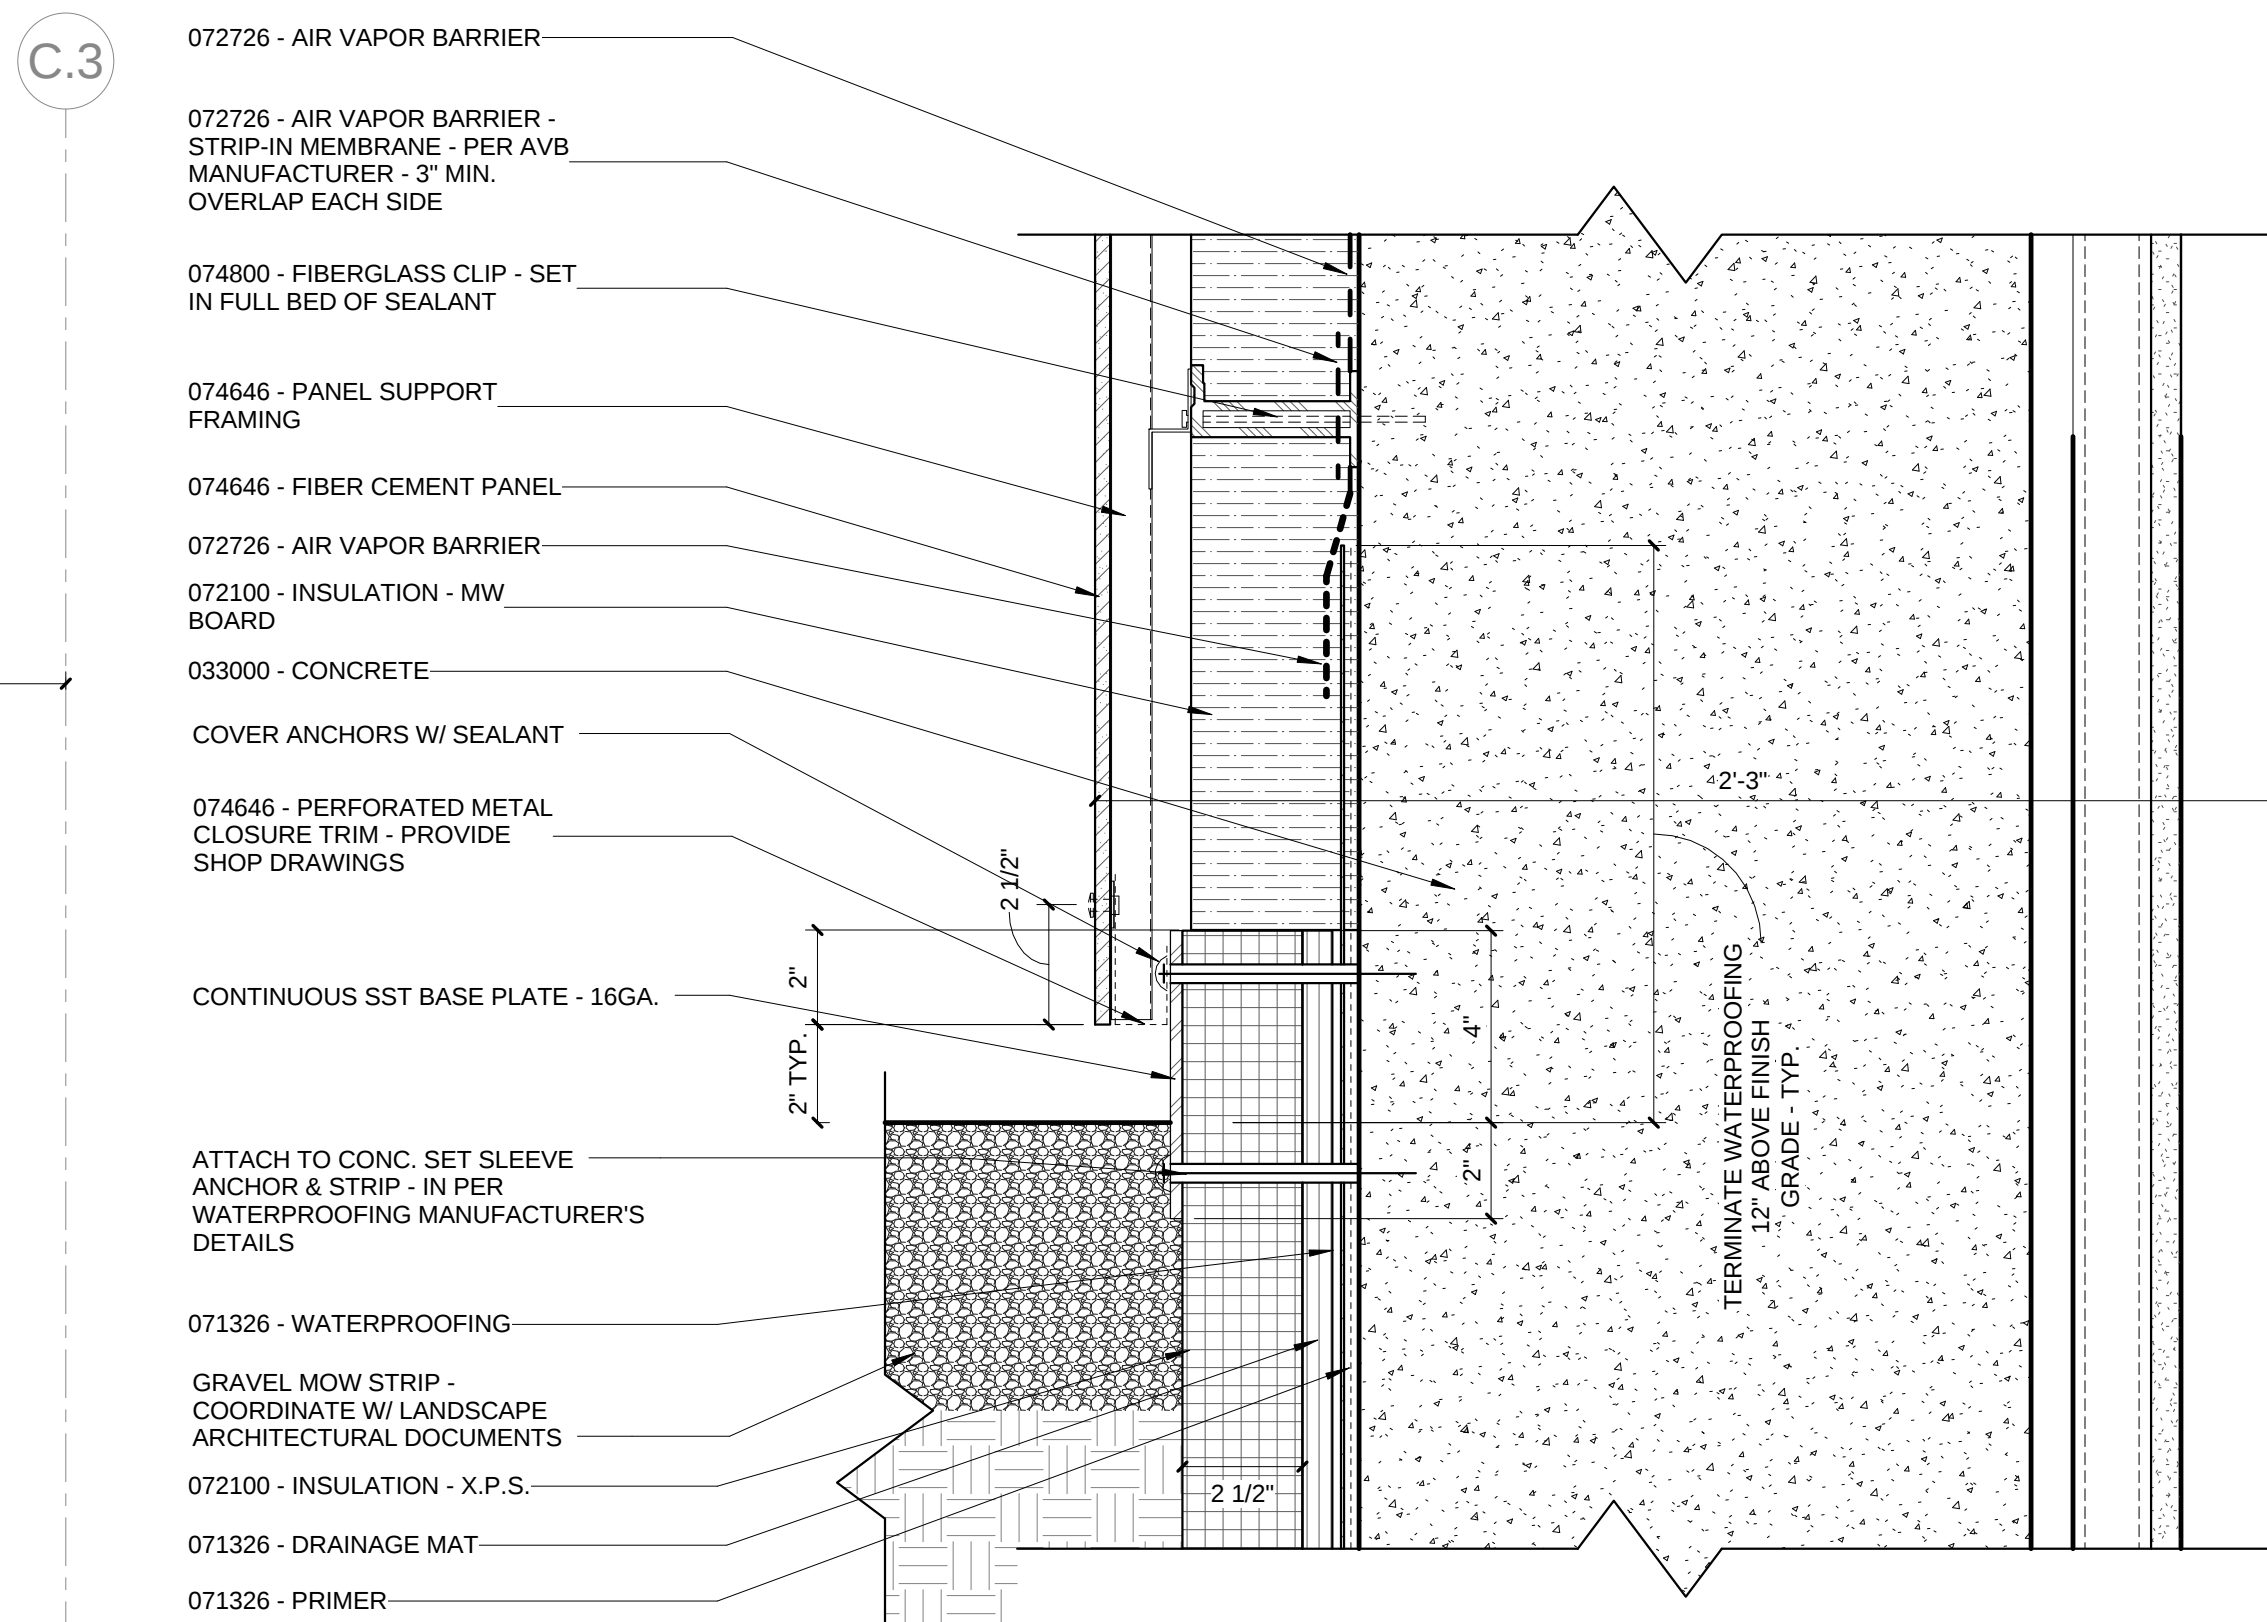


2 ENLARGED DETAIL - WA-L2 GRADE TERMINATION
3" = 1'-0"

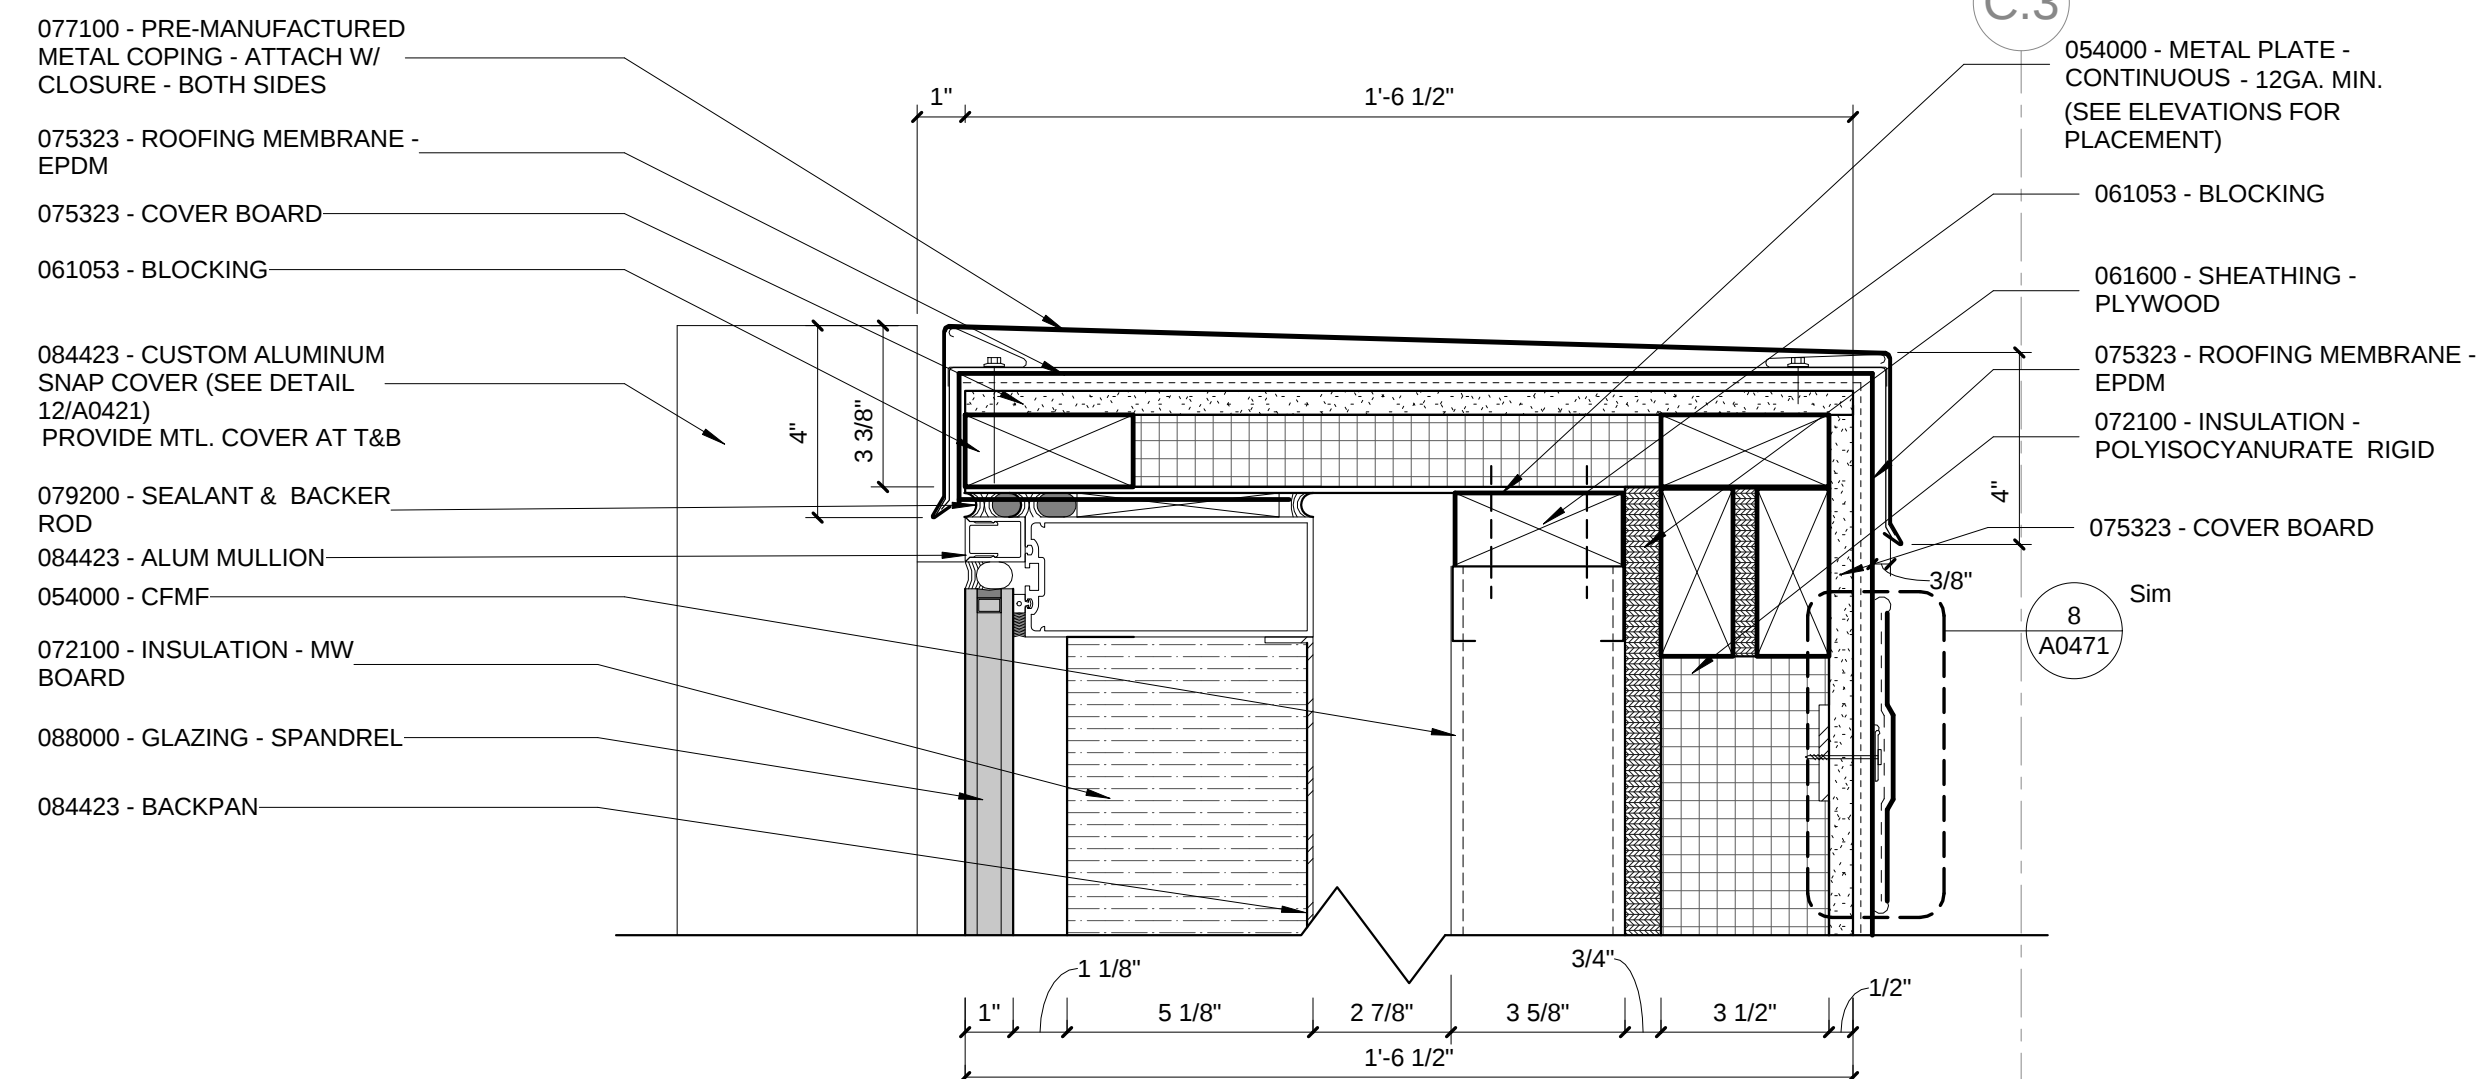

7 ENLARGED DETAIL @ ROOF COPING
3" = 1'-0"

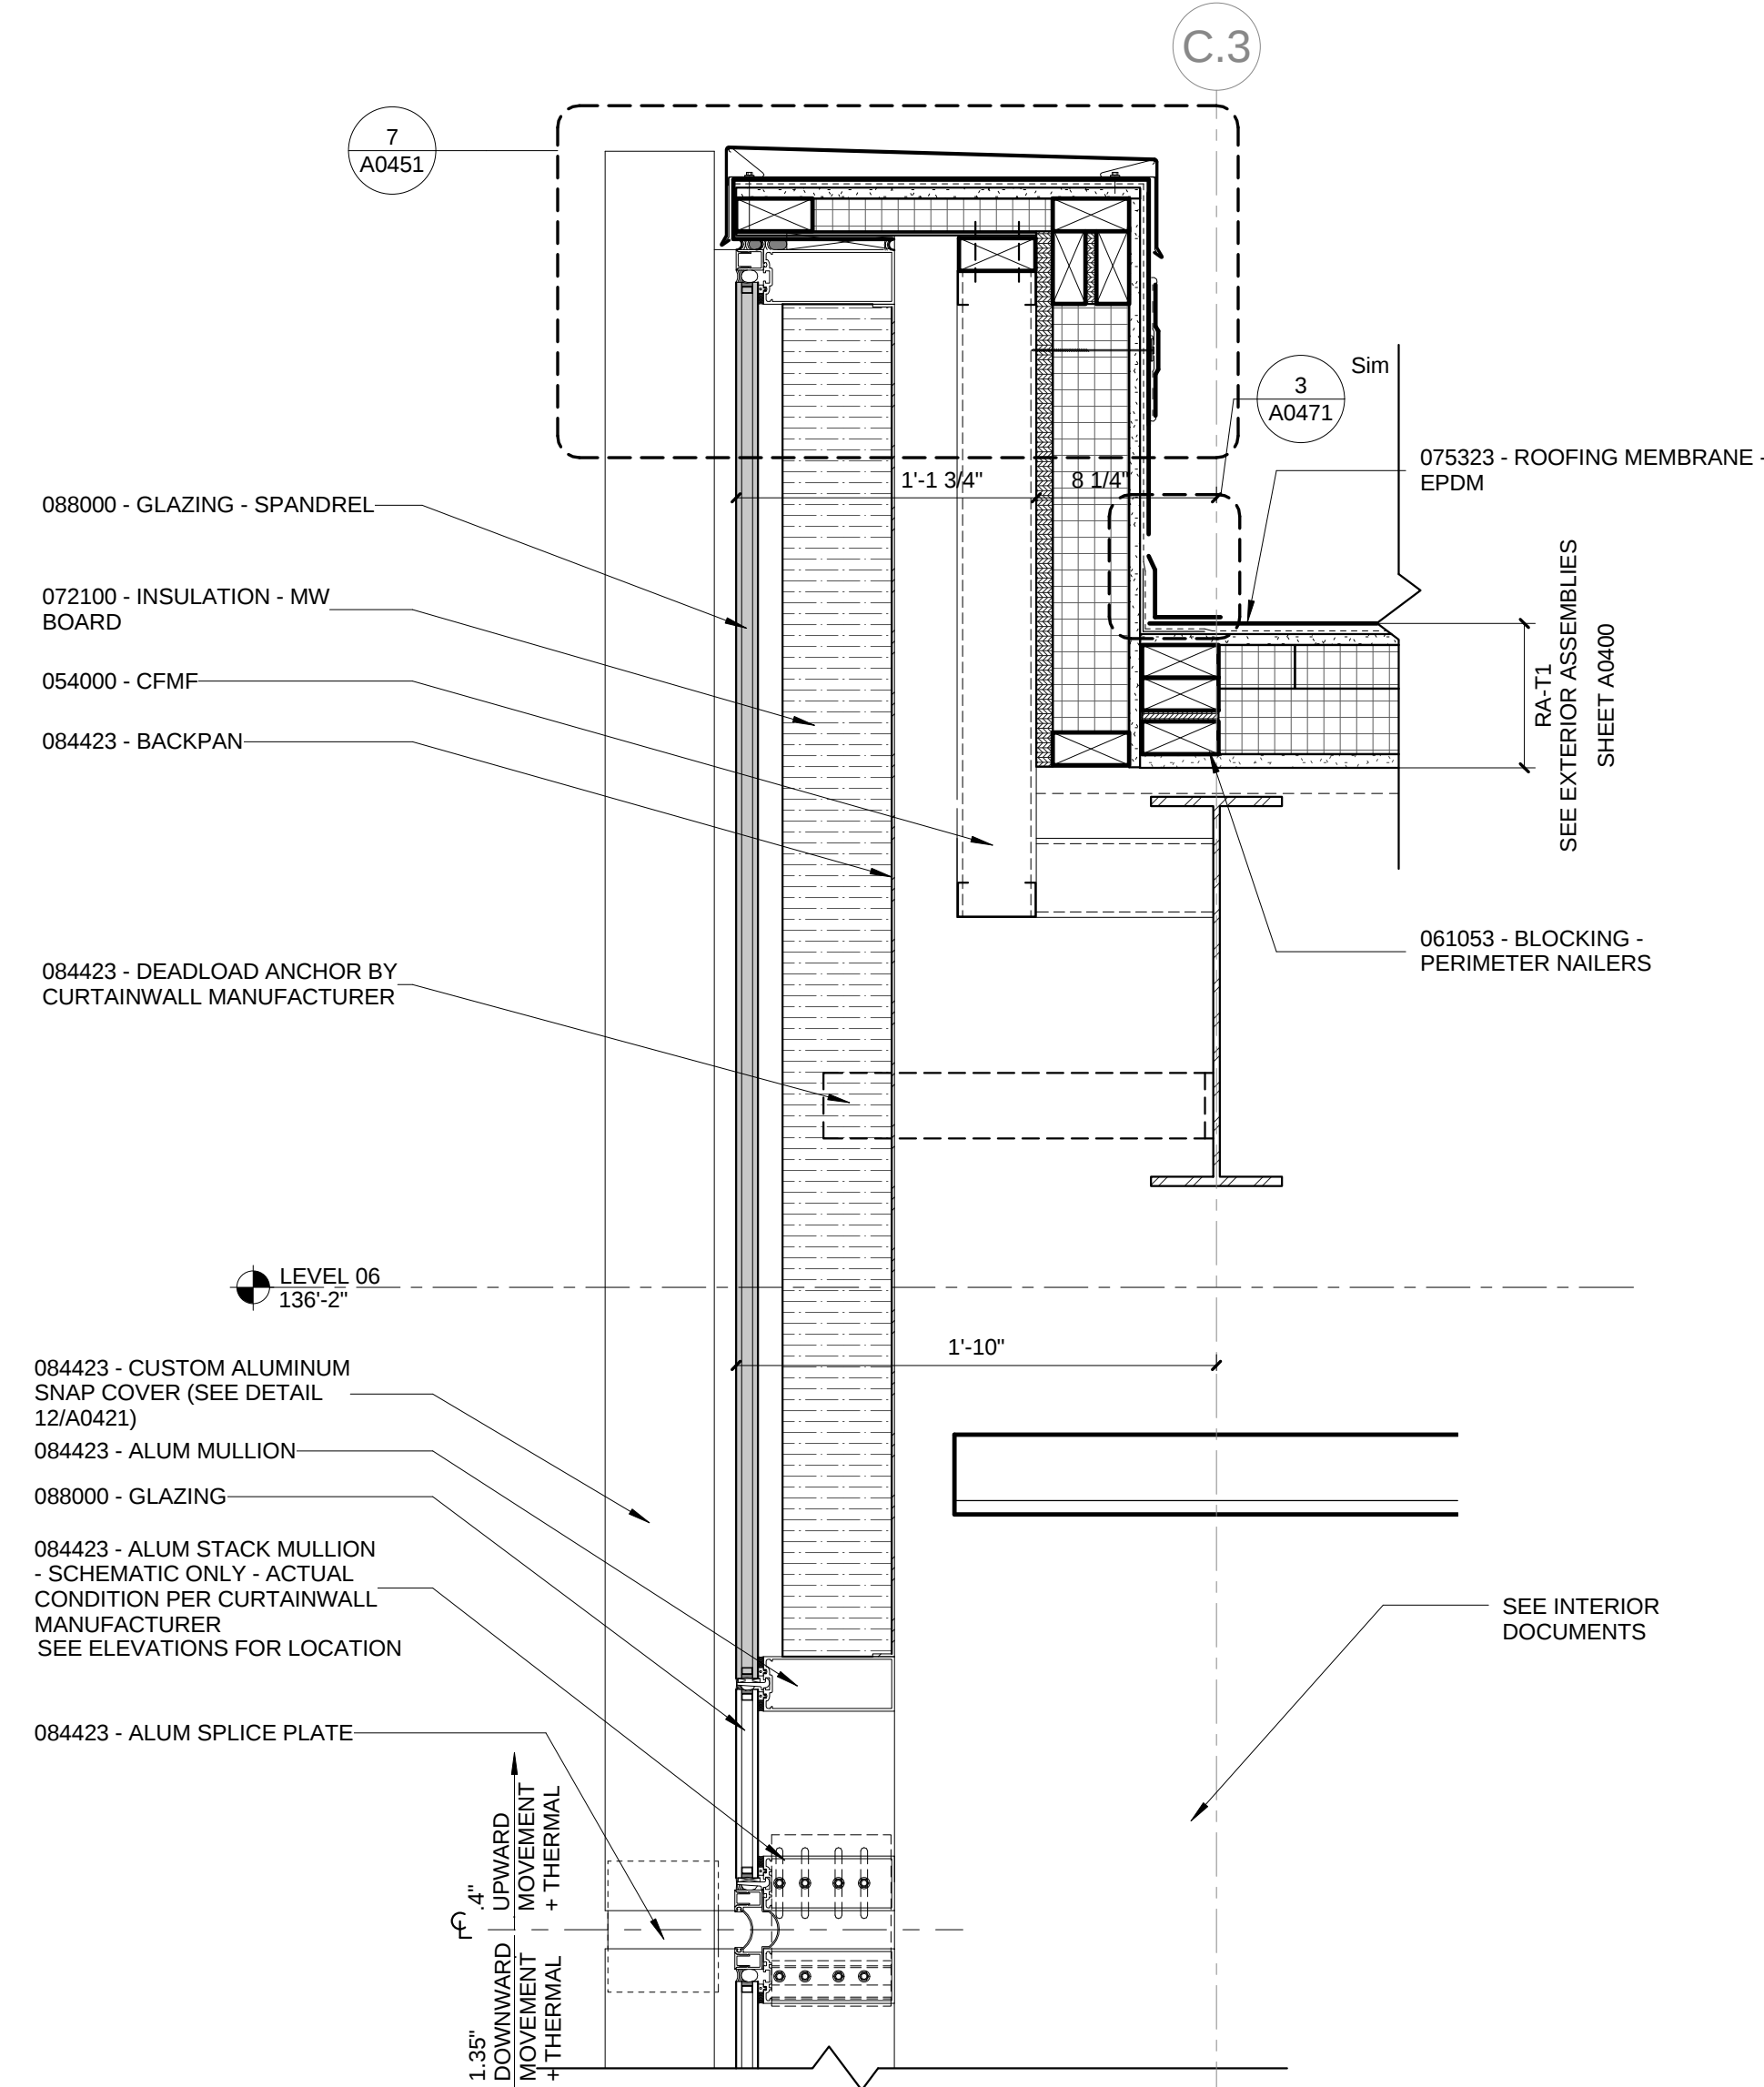

4 ENLARGED DETAIL @ CURTAINWALL PARAPET
1 1/2" = 1'-0"

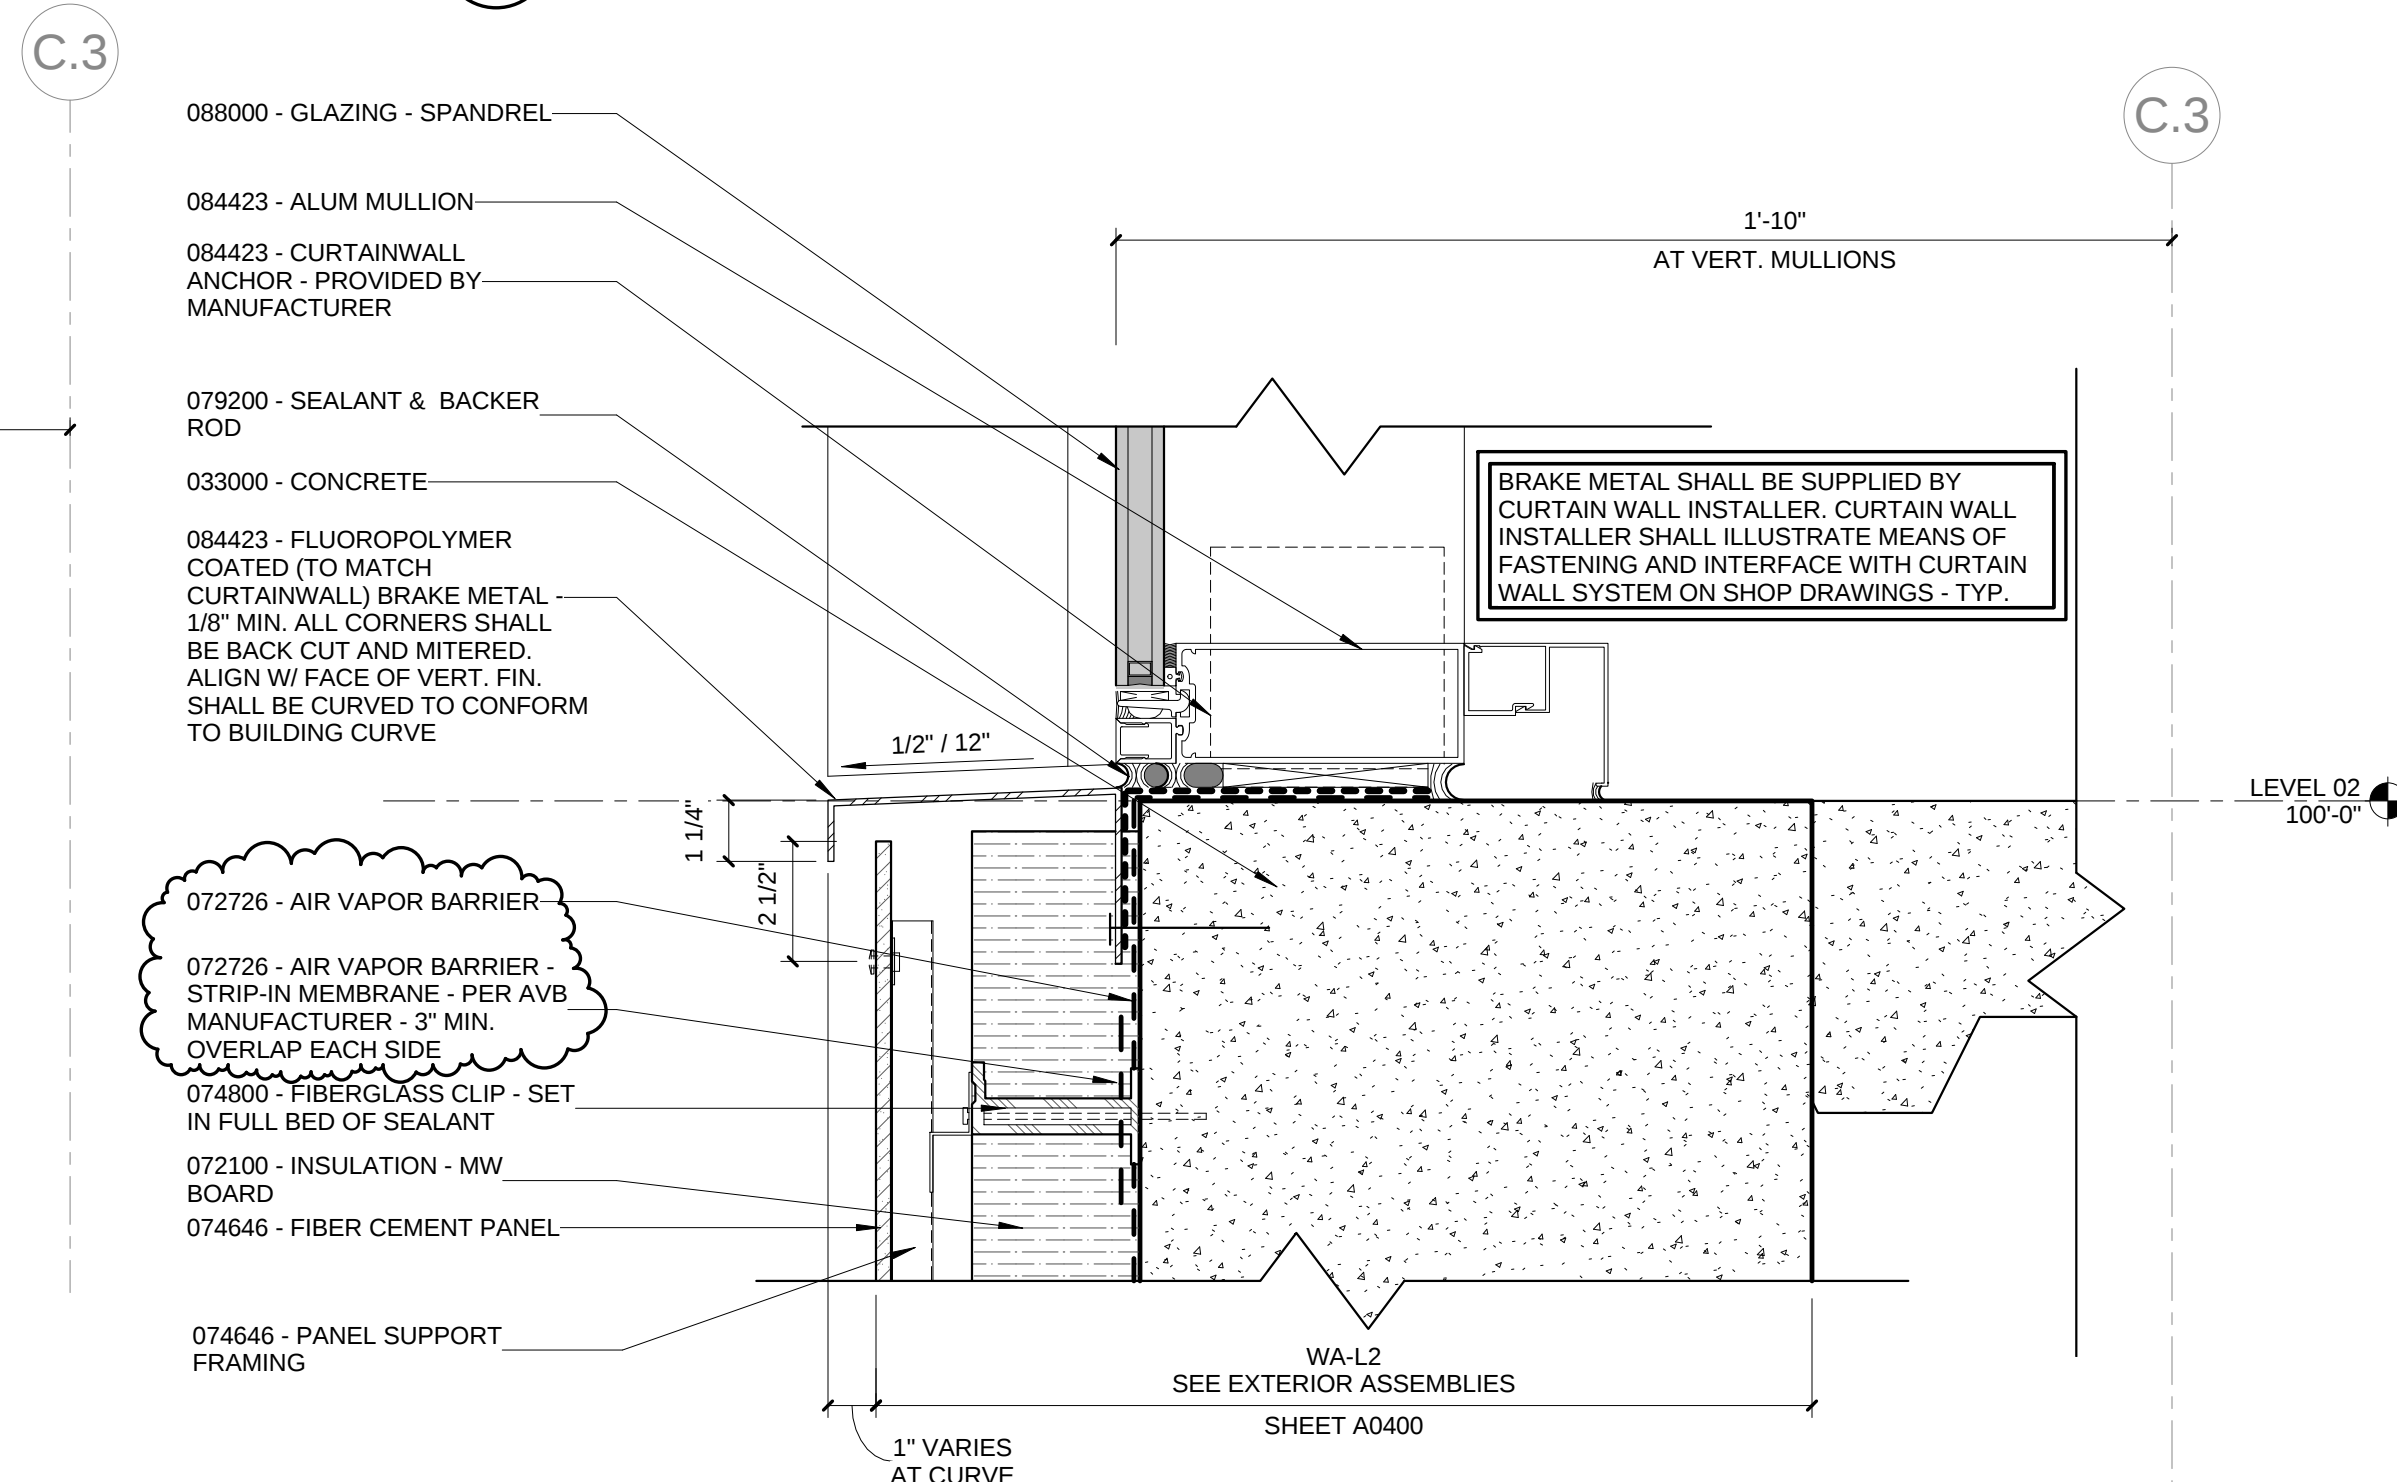

1 ENLARGED DETAIL @ SSG CURTAINWALL SILL & WA-L2
3" = 1'-0"