




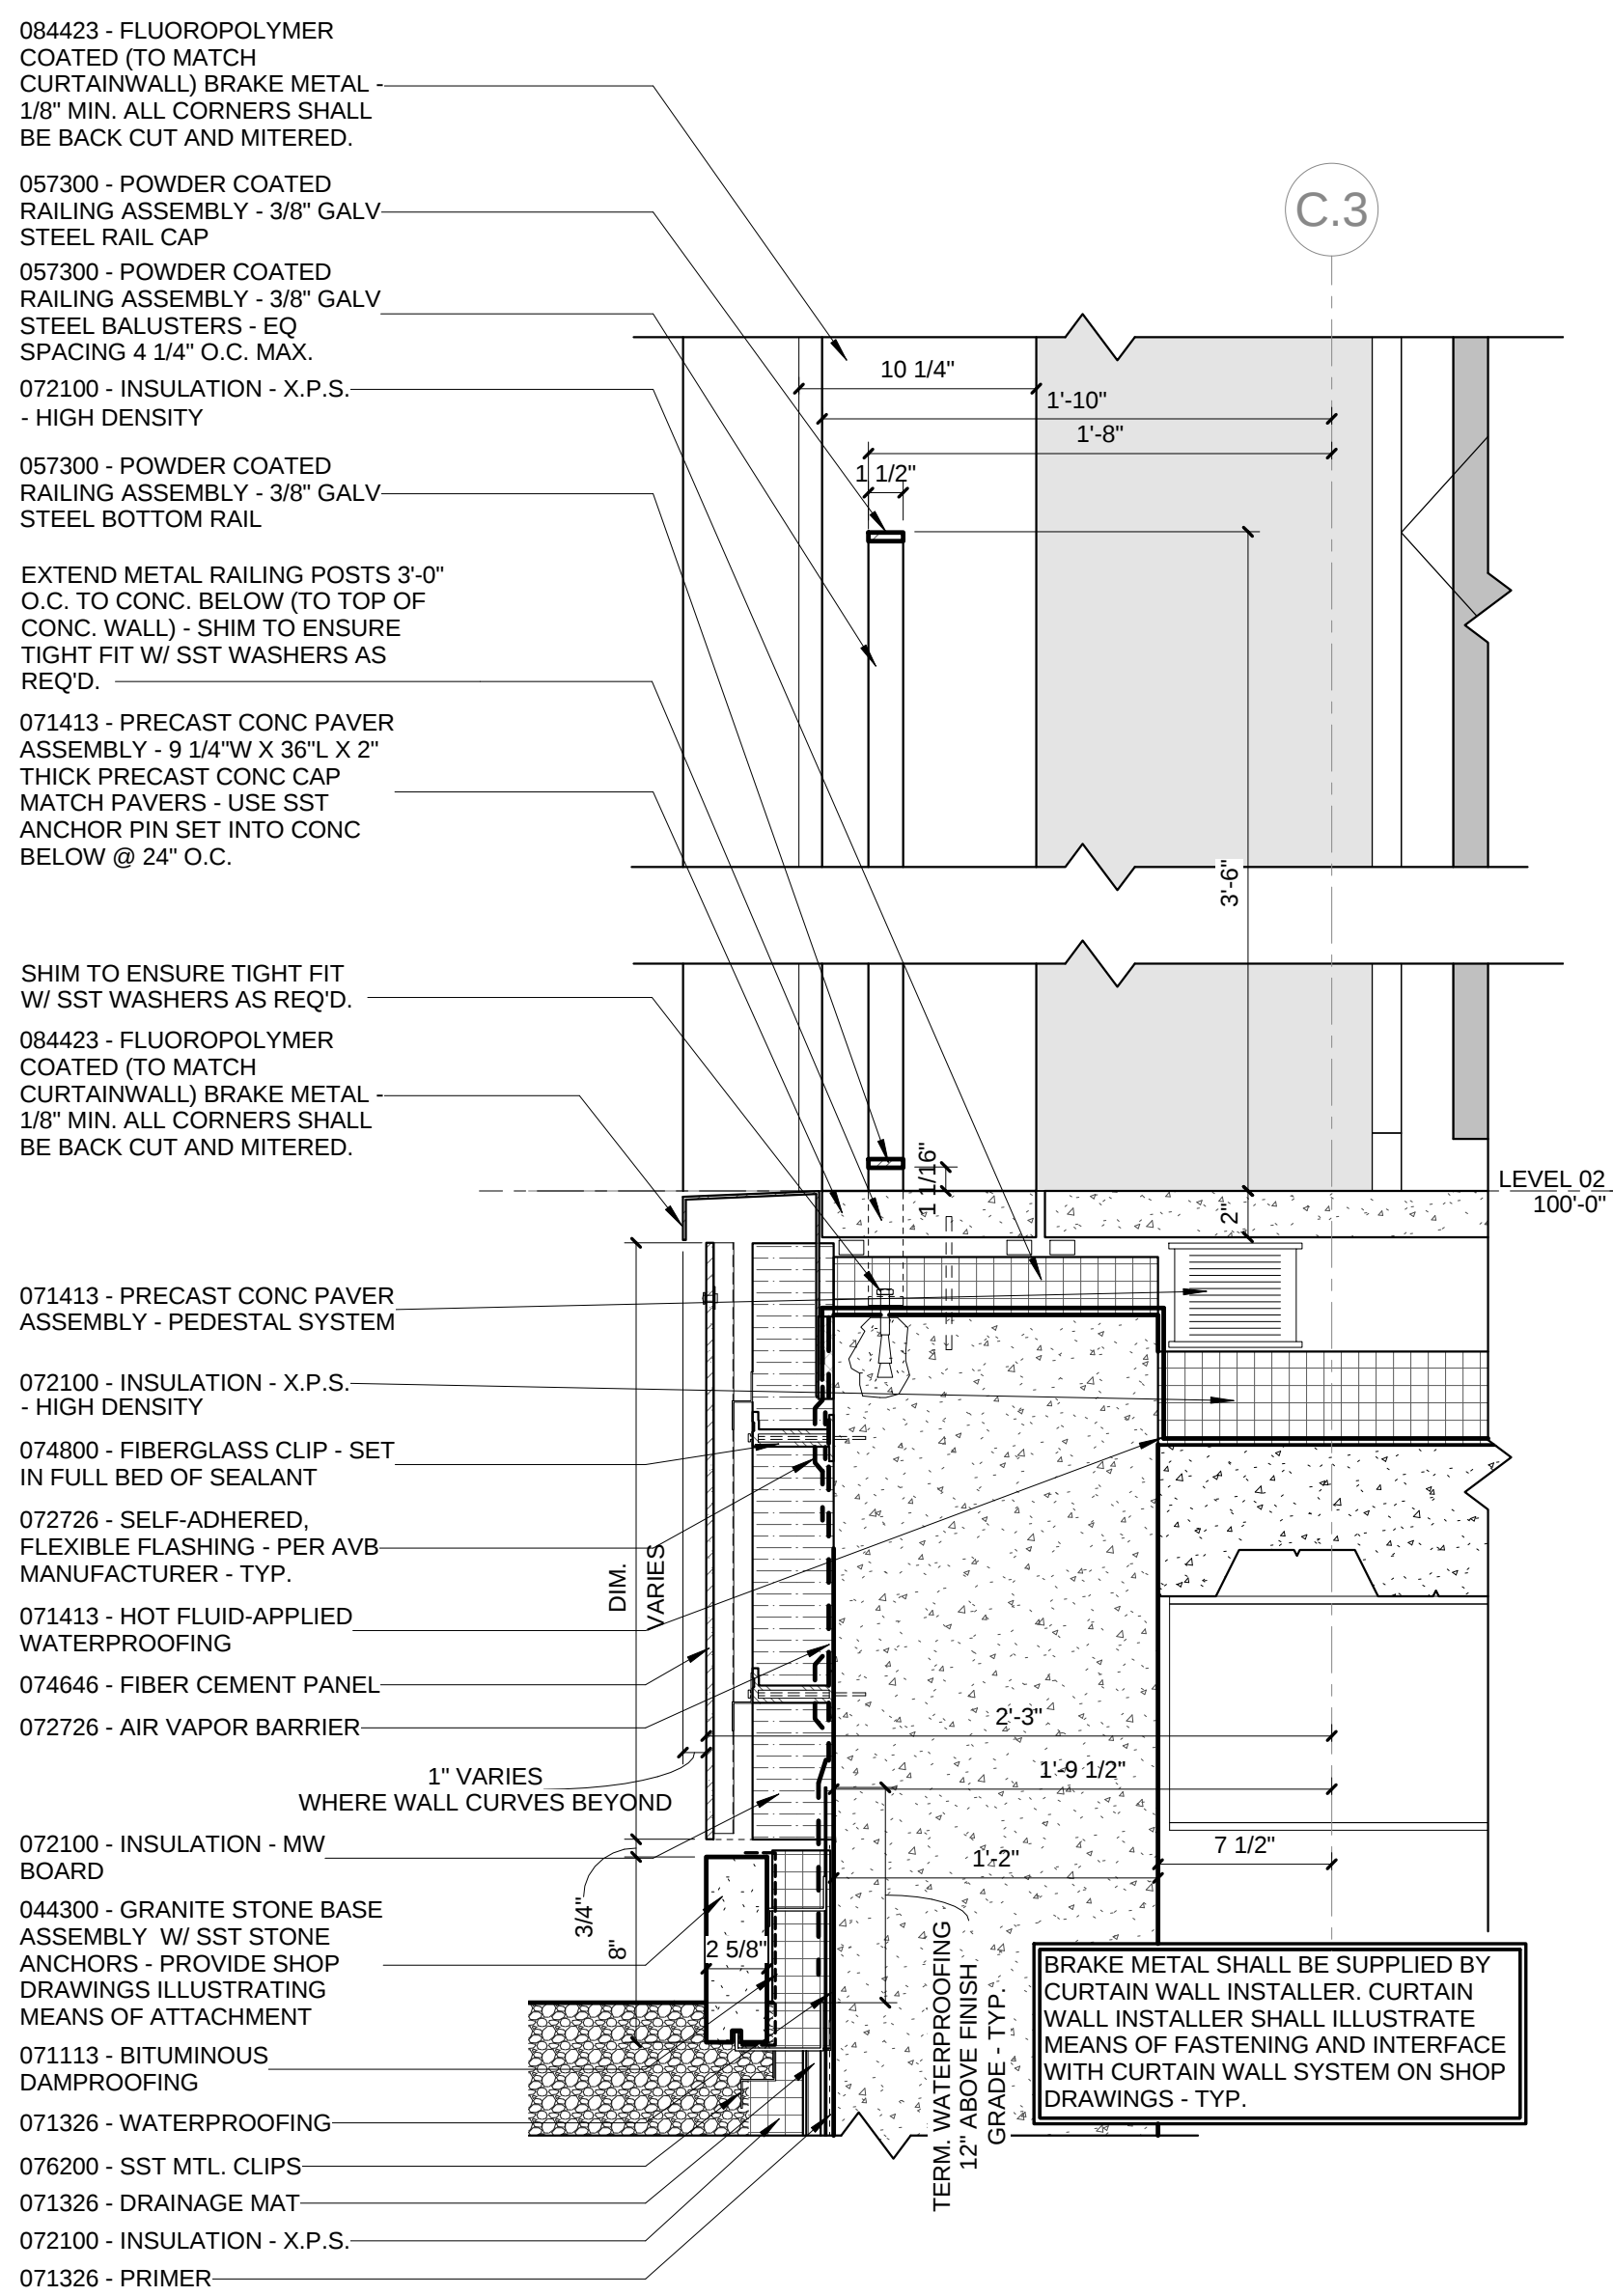


7 ENLARGED DETAIL - WALKING SURFACE @ NORTH AREAWAY
1 1/2" = 1'-0"

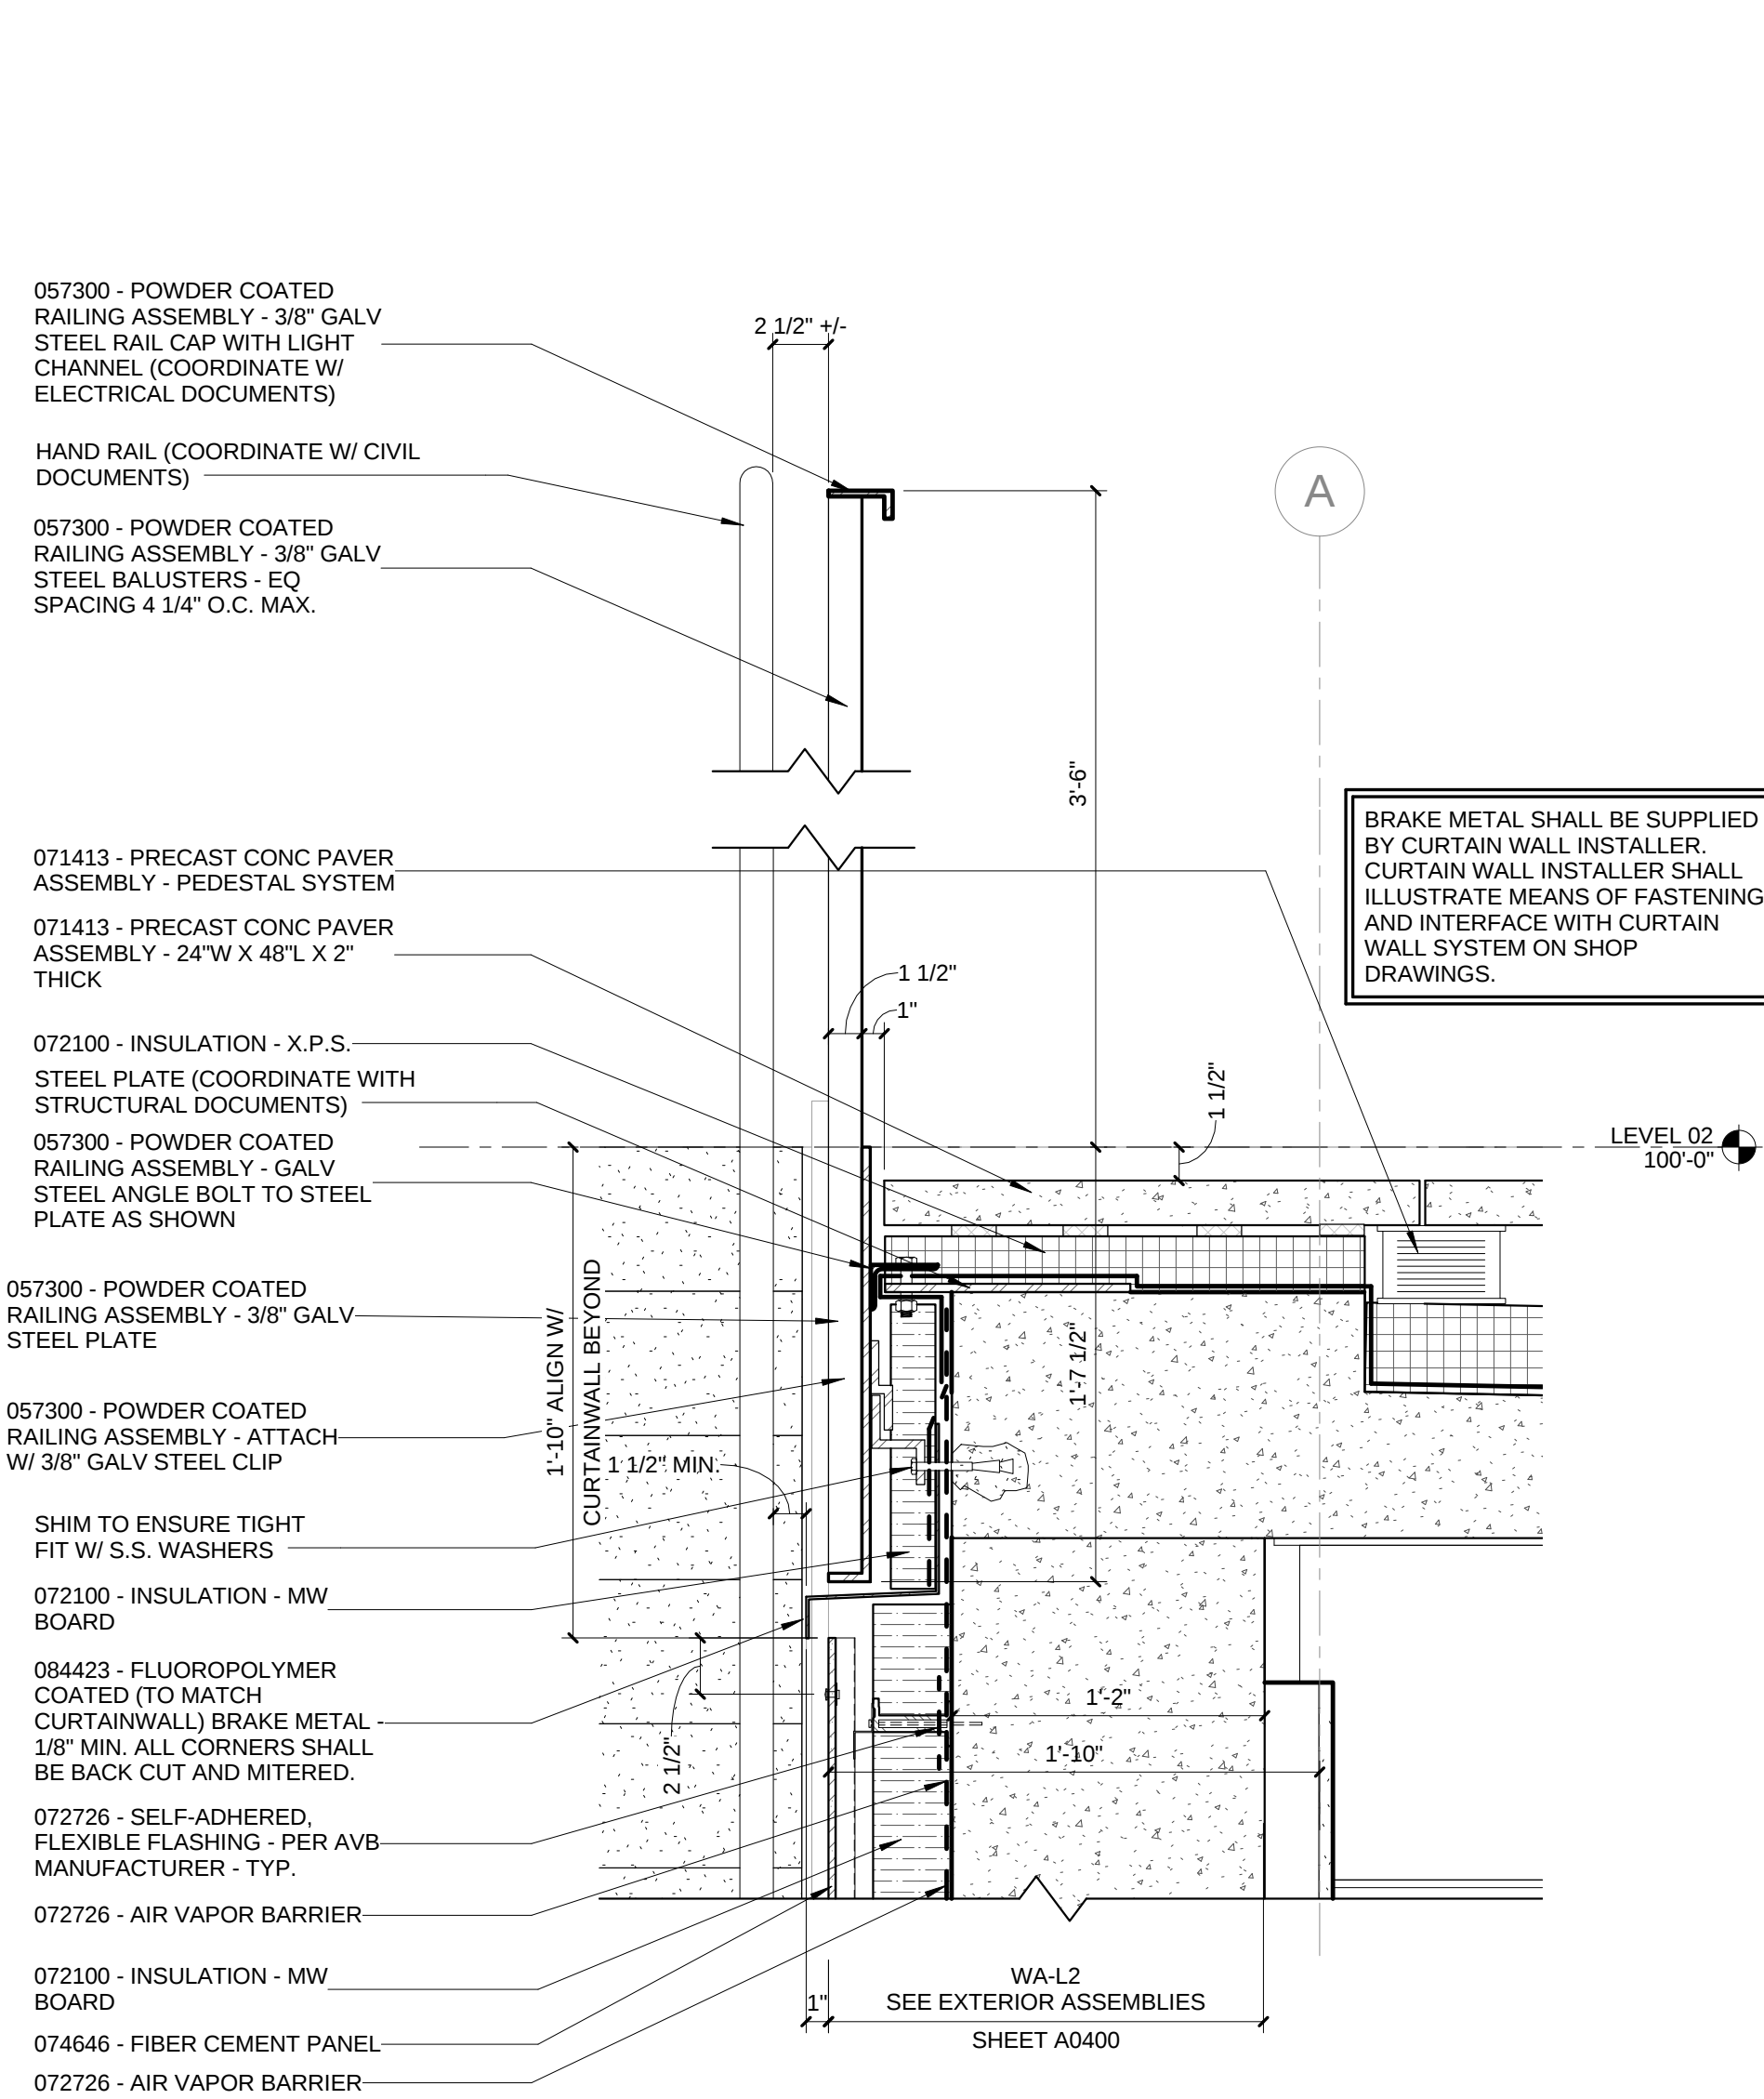


6 ENLARGED DETAIL - WALKING SURFACE @ WA-L2
1 1/2" = 1'-0"

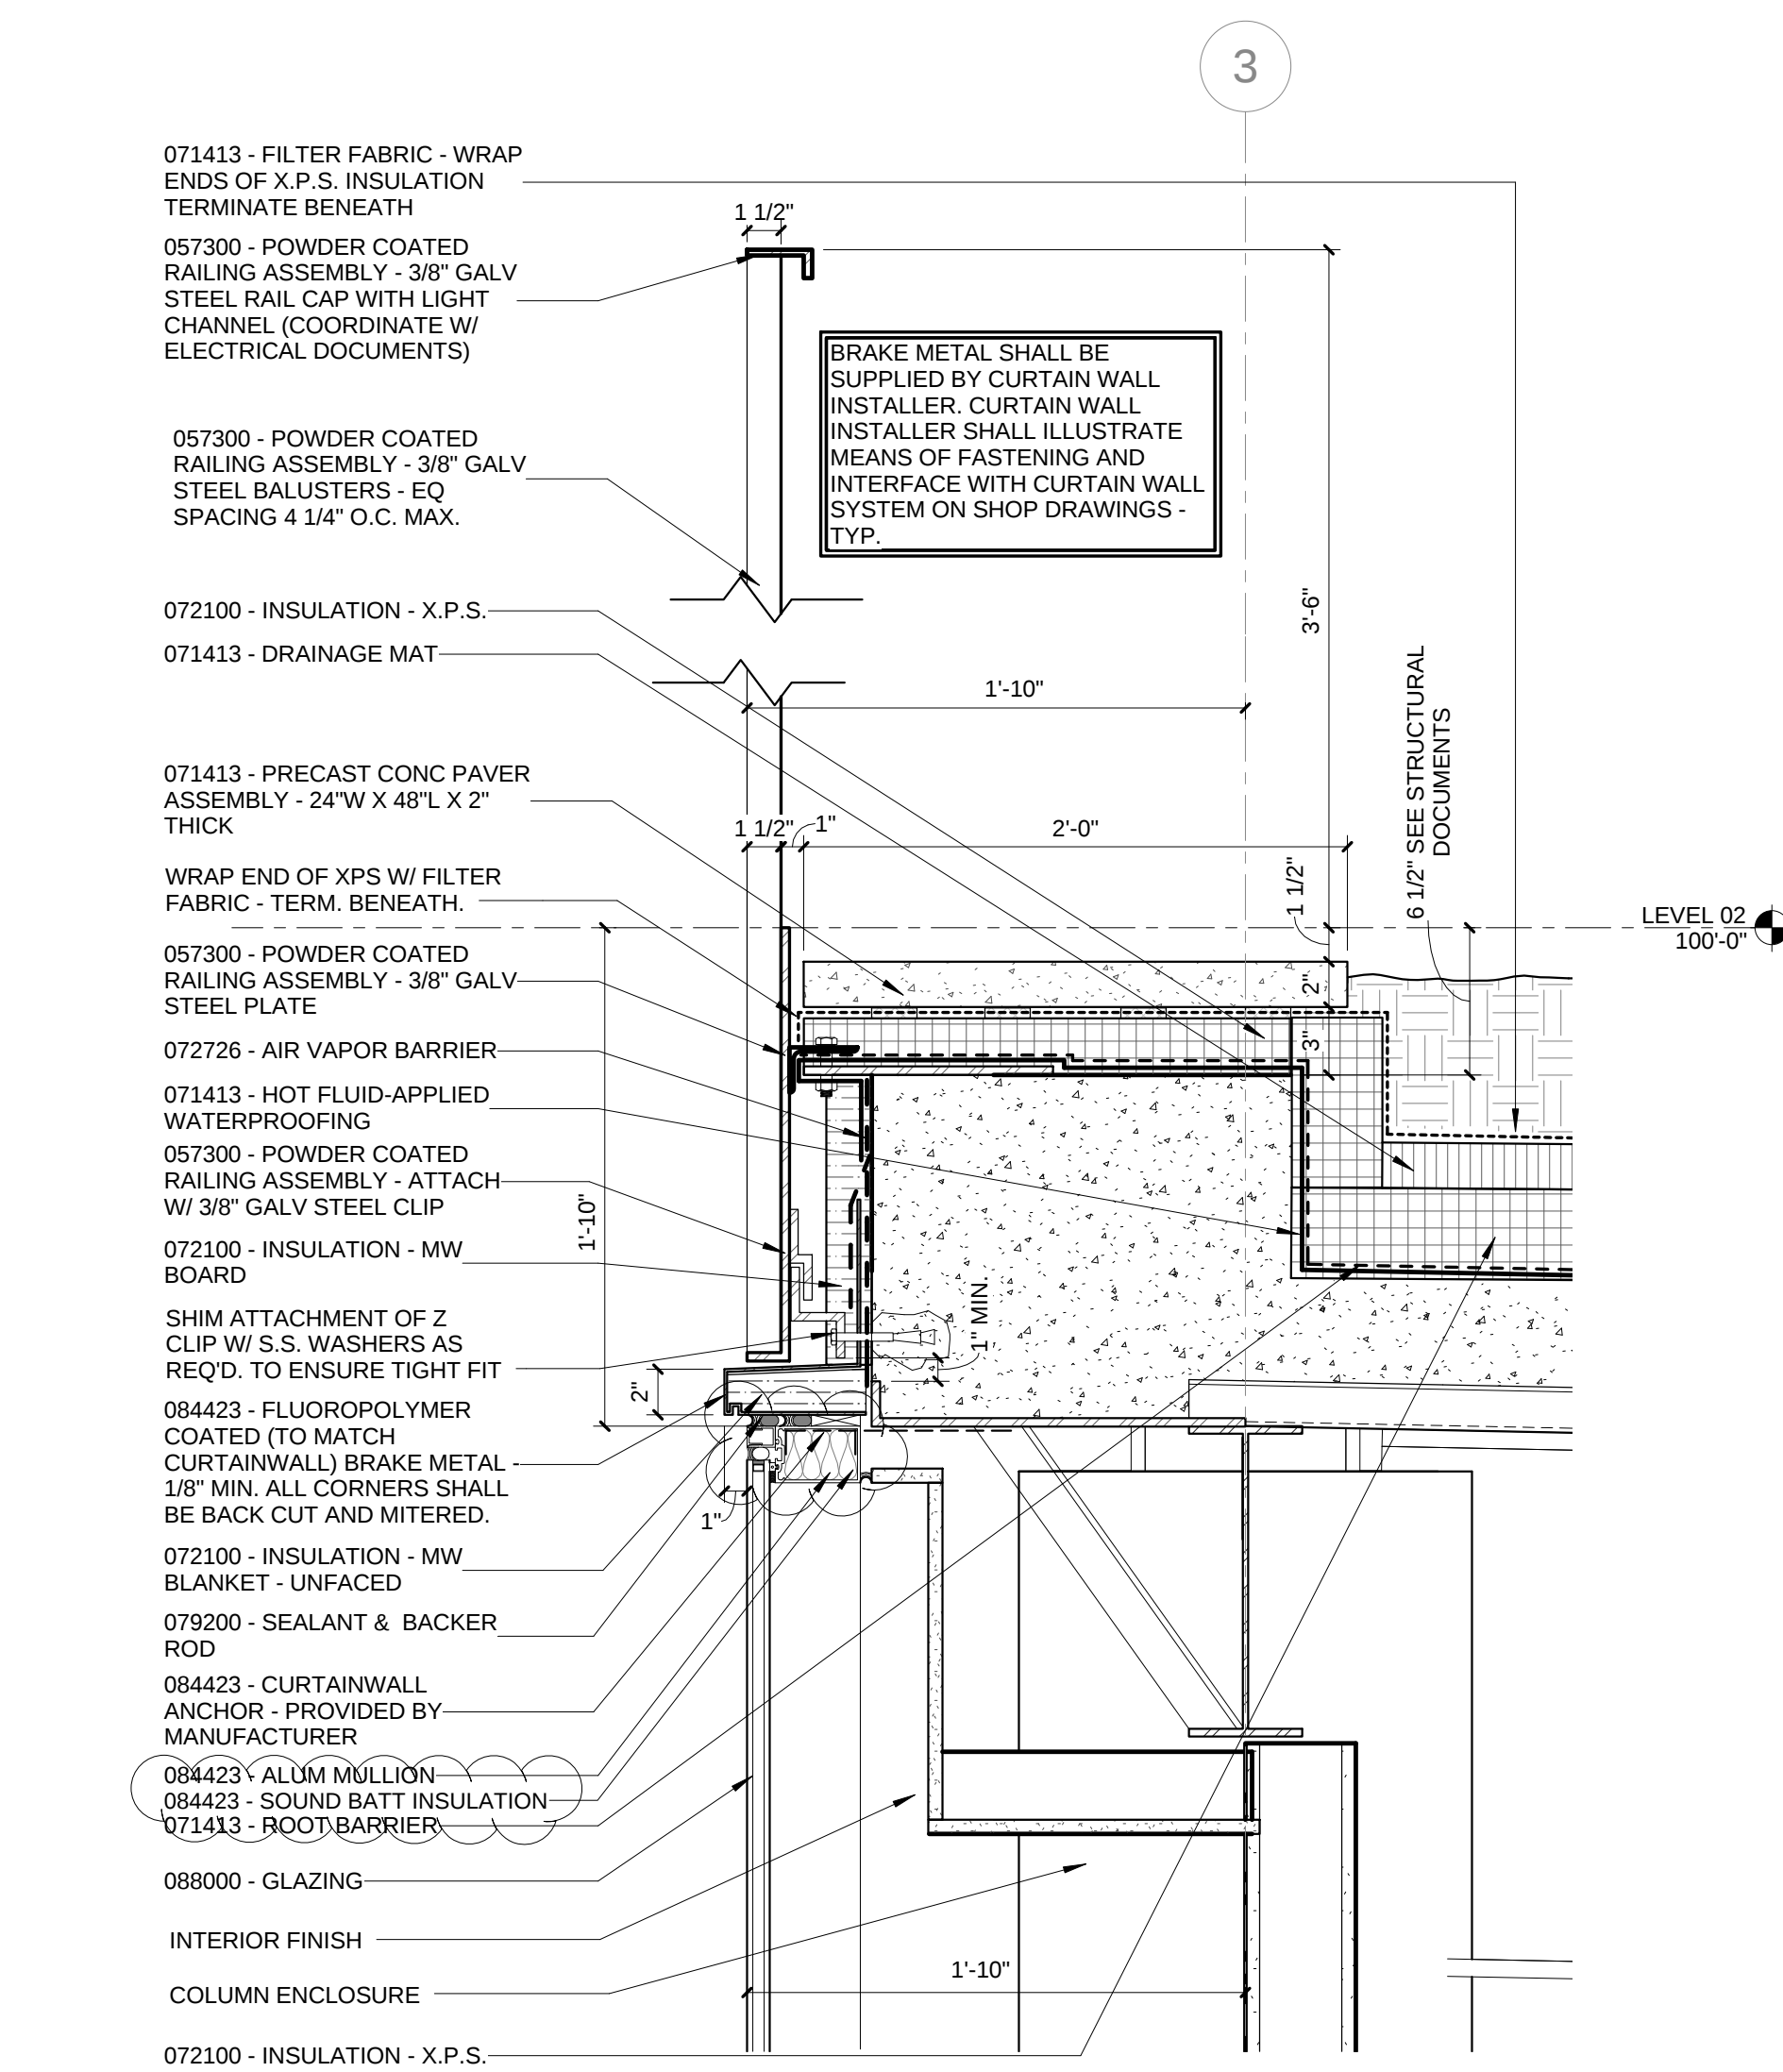

3 ENLARGED DETAIL - GREEN ROOF @ WEST CURTAINWALL
1 1/2" = 1'-0"

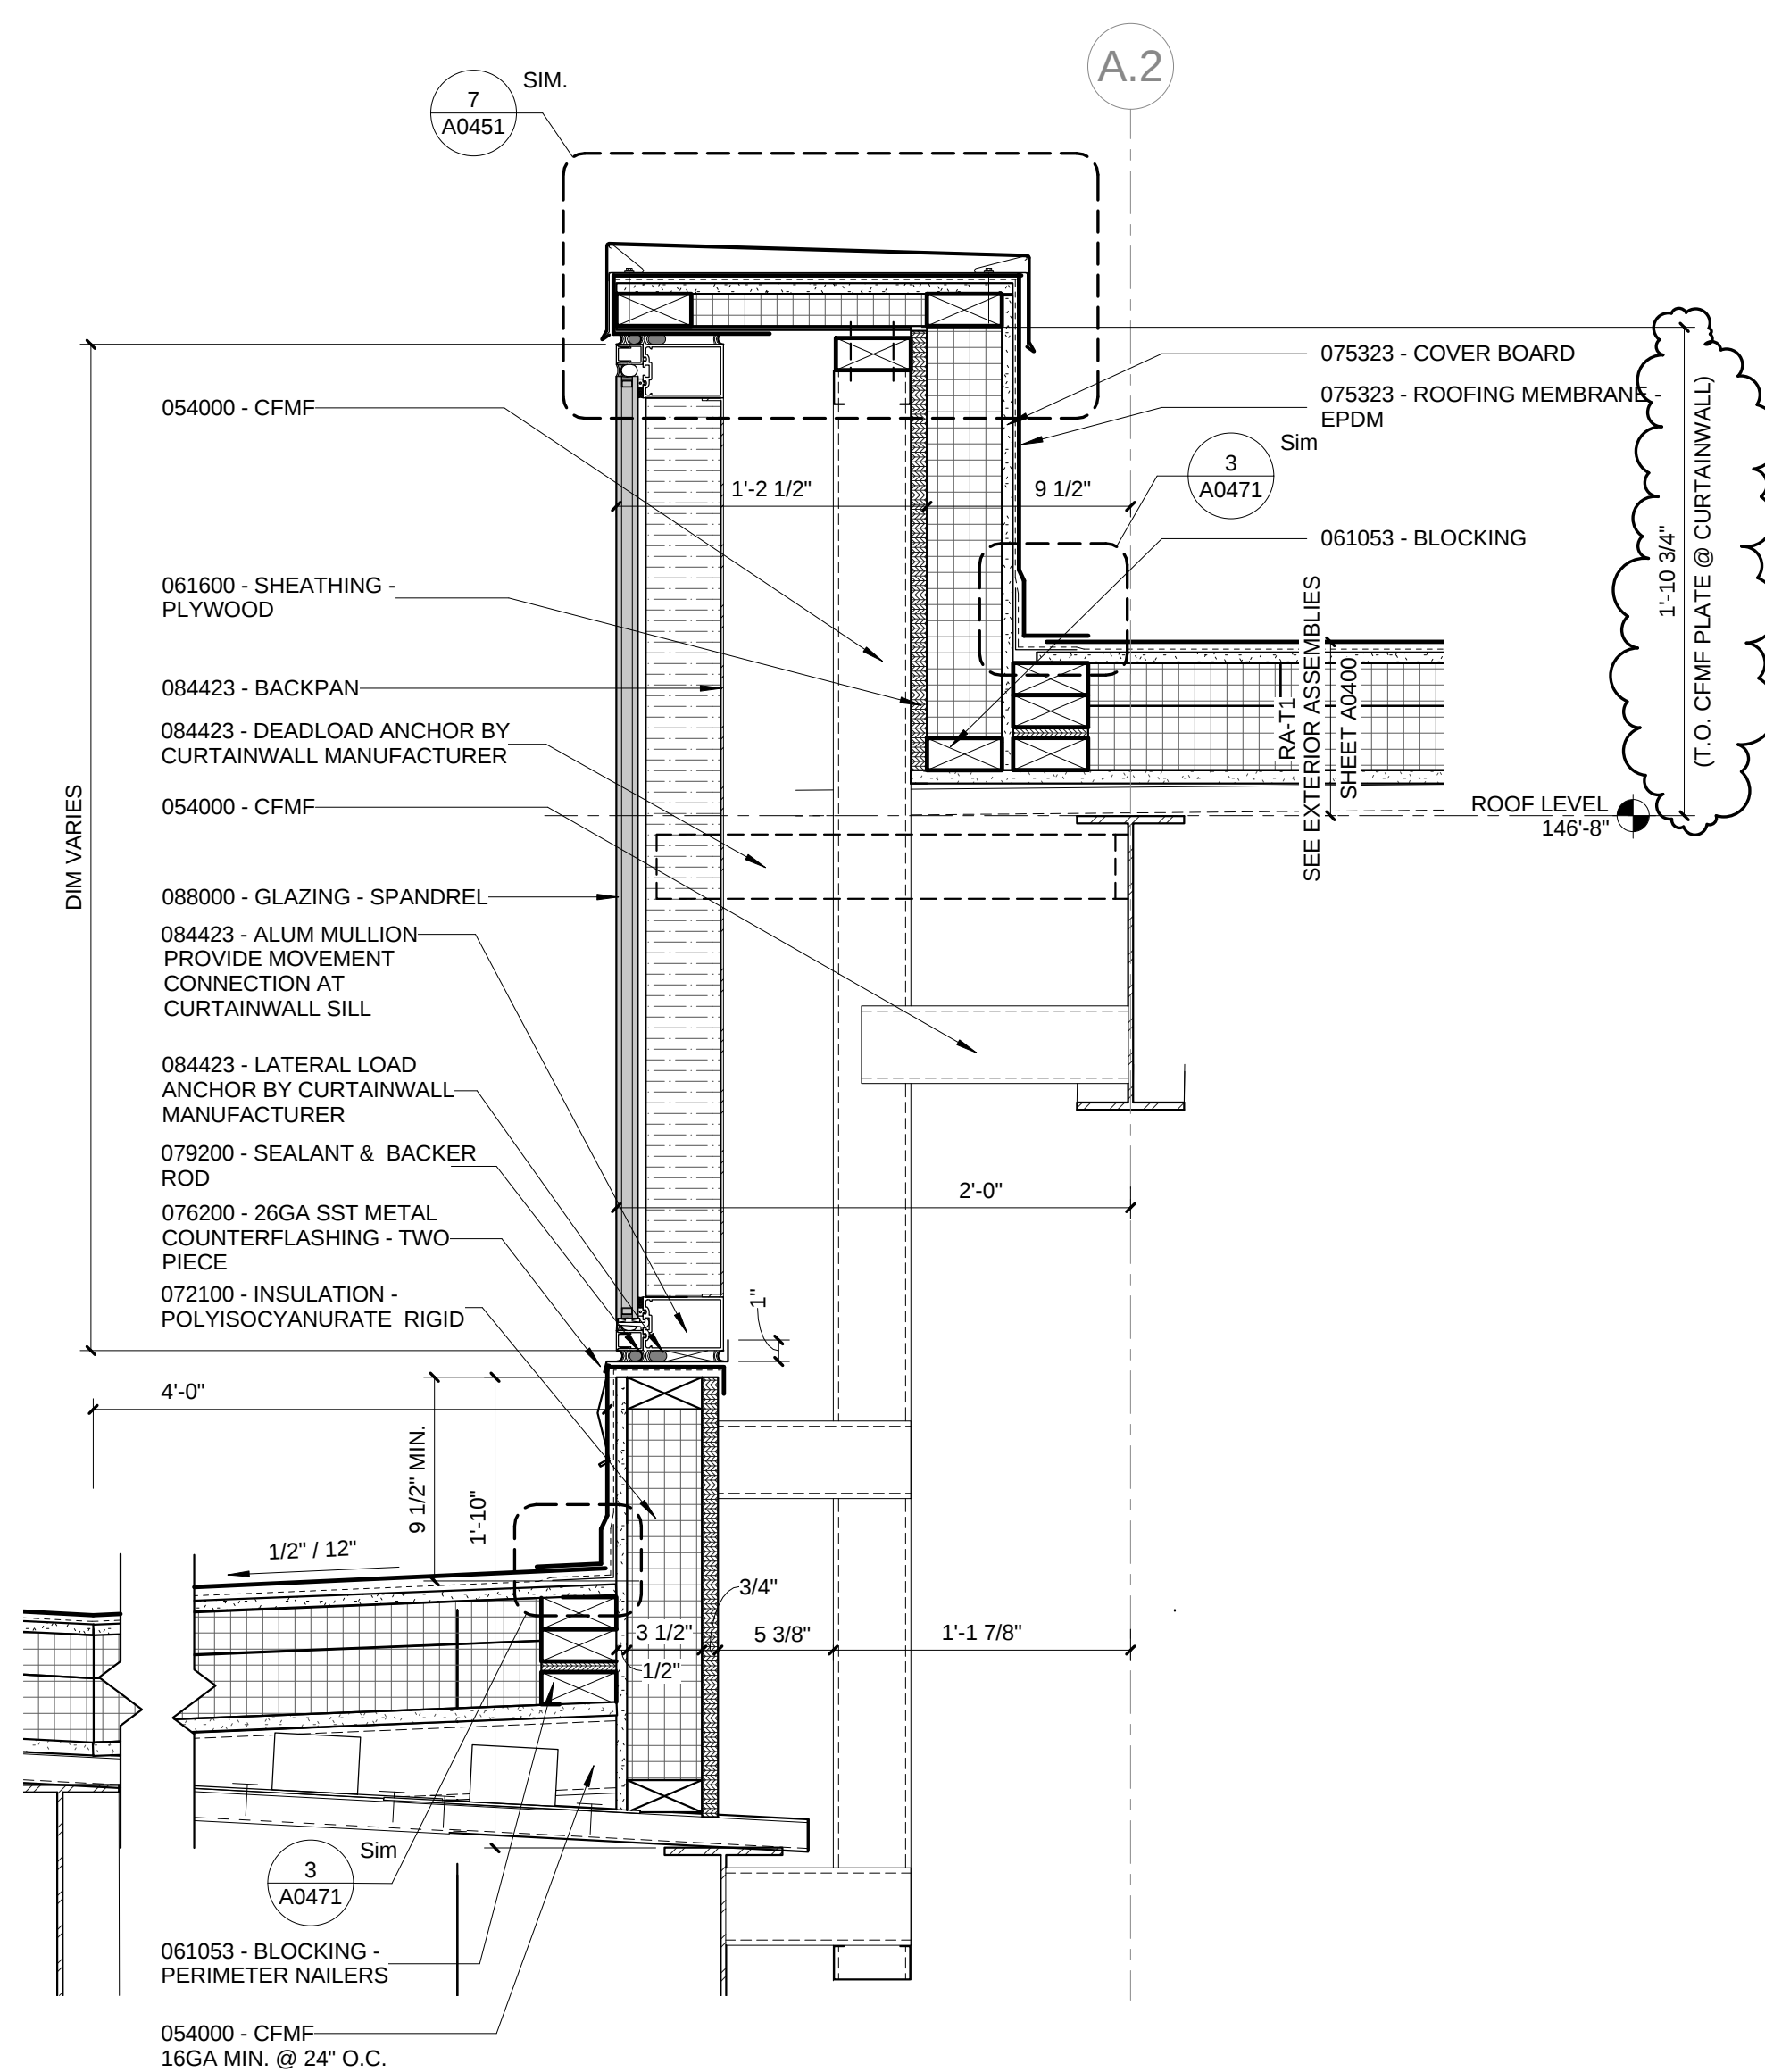


2 ENLARGED DETAIL - CURTAINWALL PARAPET
1 1/2" = 1'-0"

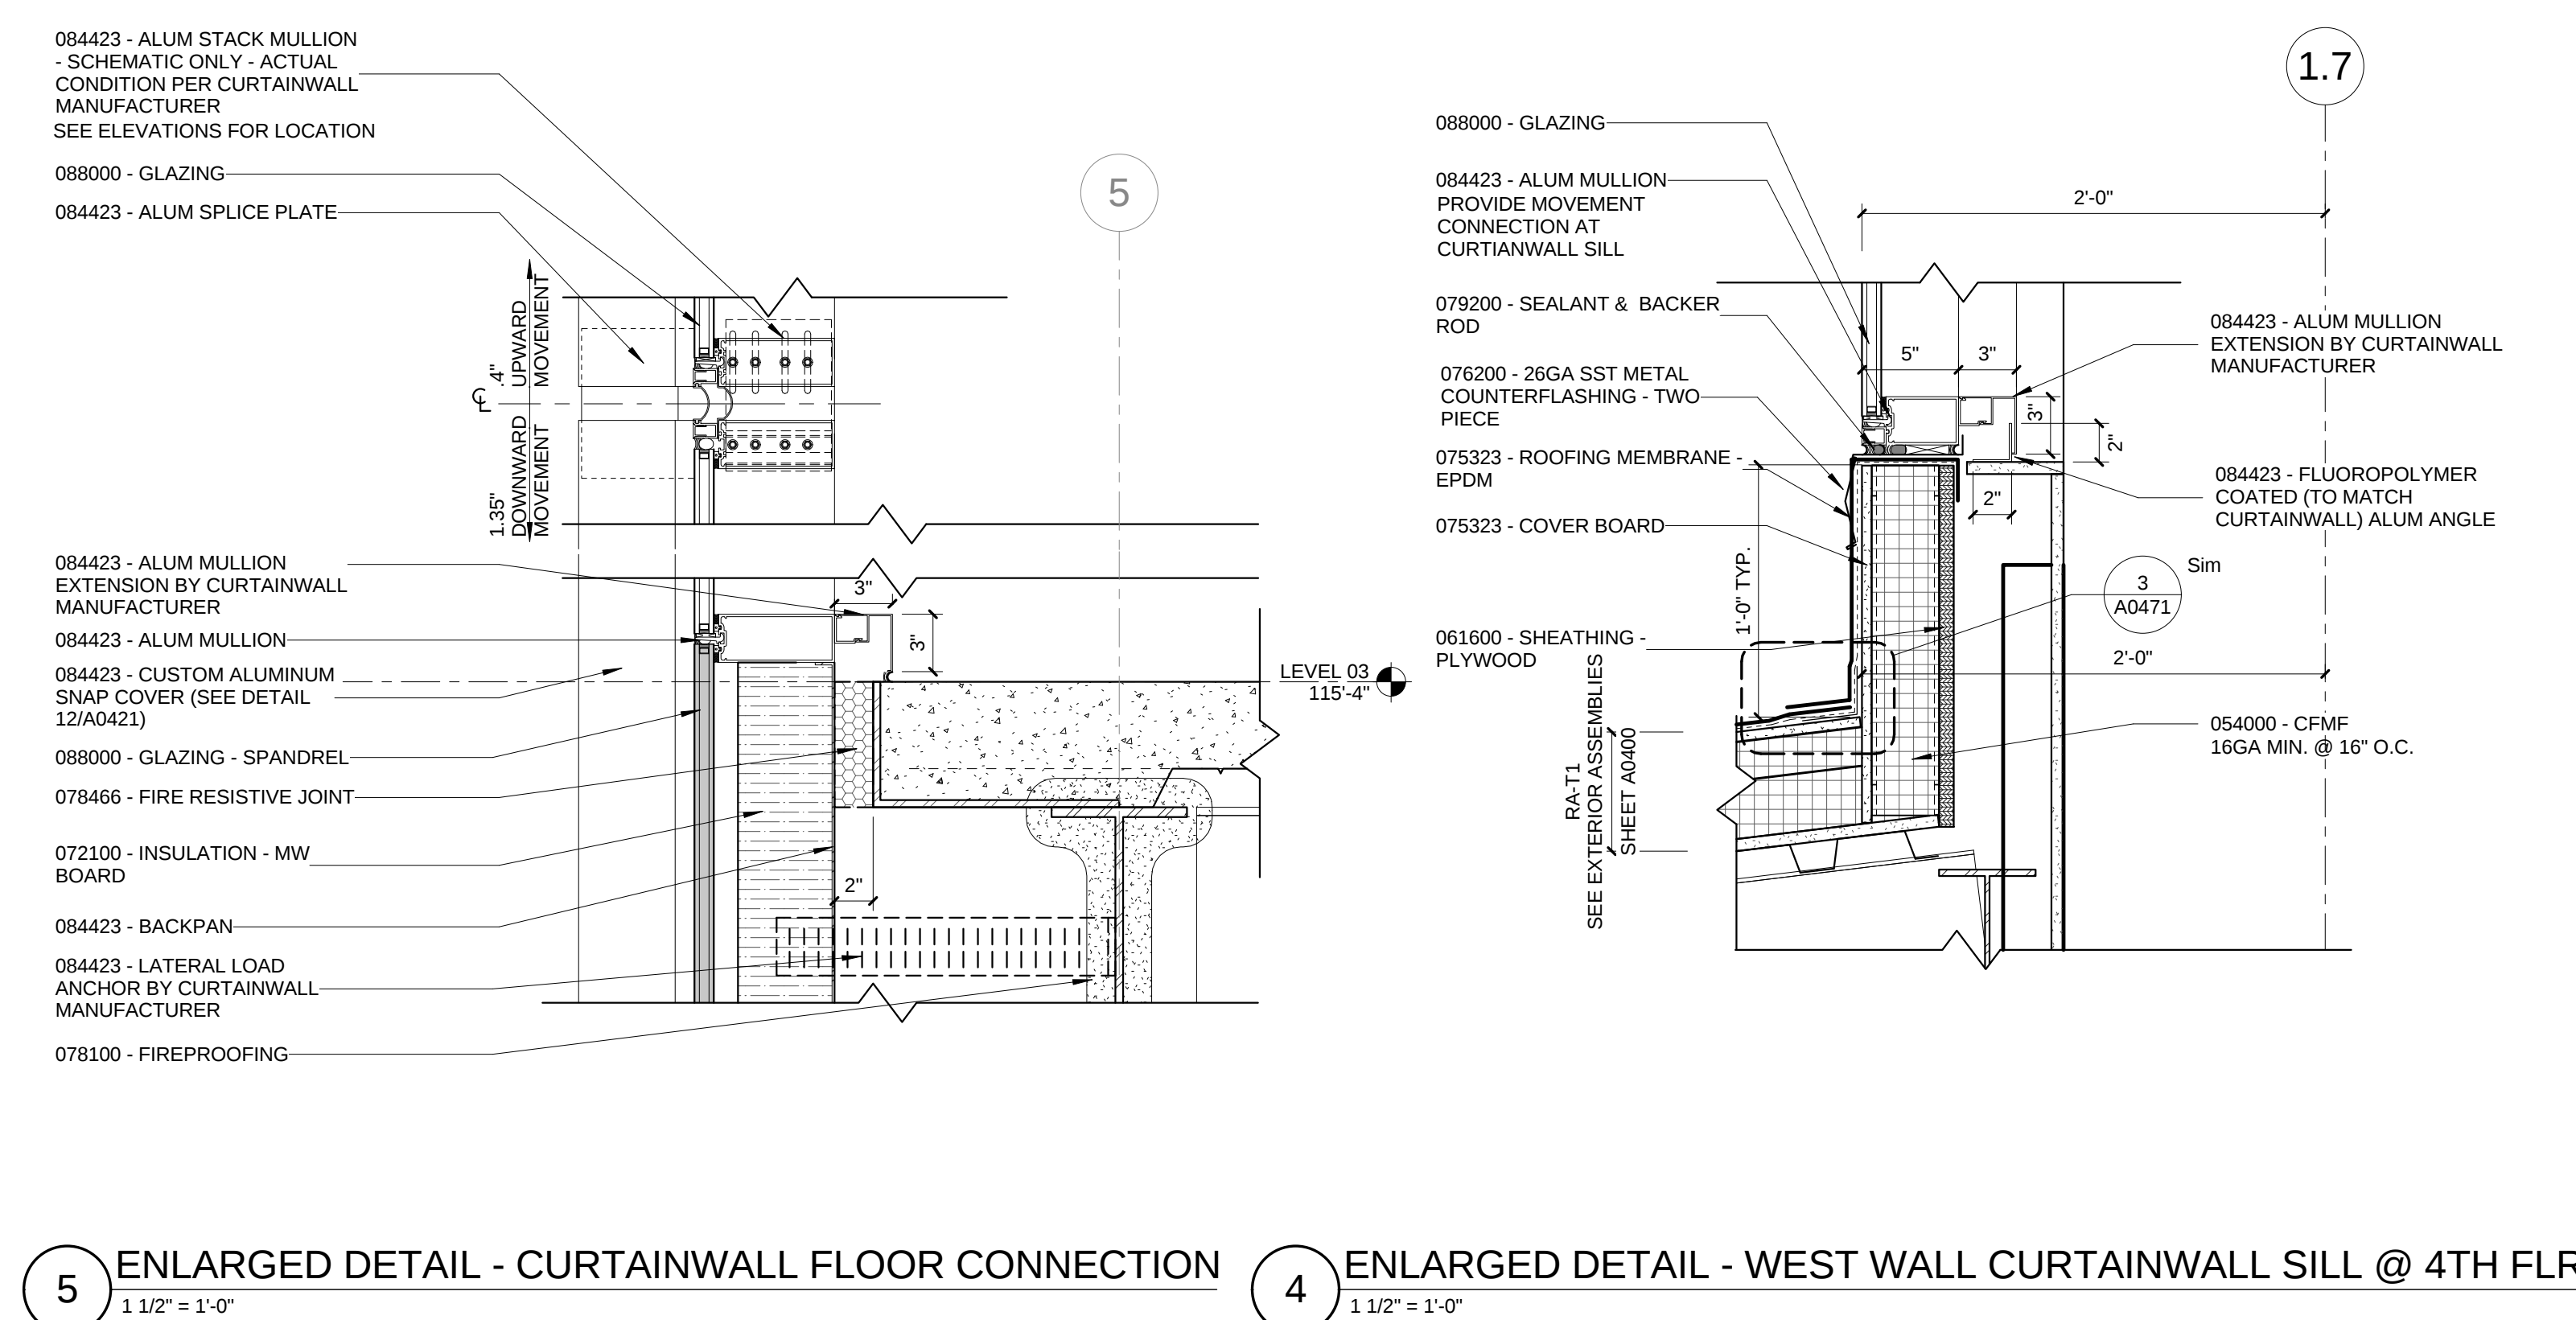

5 ENLARGED DETAIL - CURTAINWALL FLOOR CONNECTION
1 1/2" = 1'-0"

4 ENLARGED DETAIL - WEST WALL CURTAINWALL SILL @ 4TH FLR
1 1/2" = 1'-0"

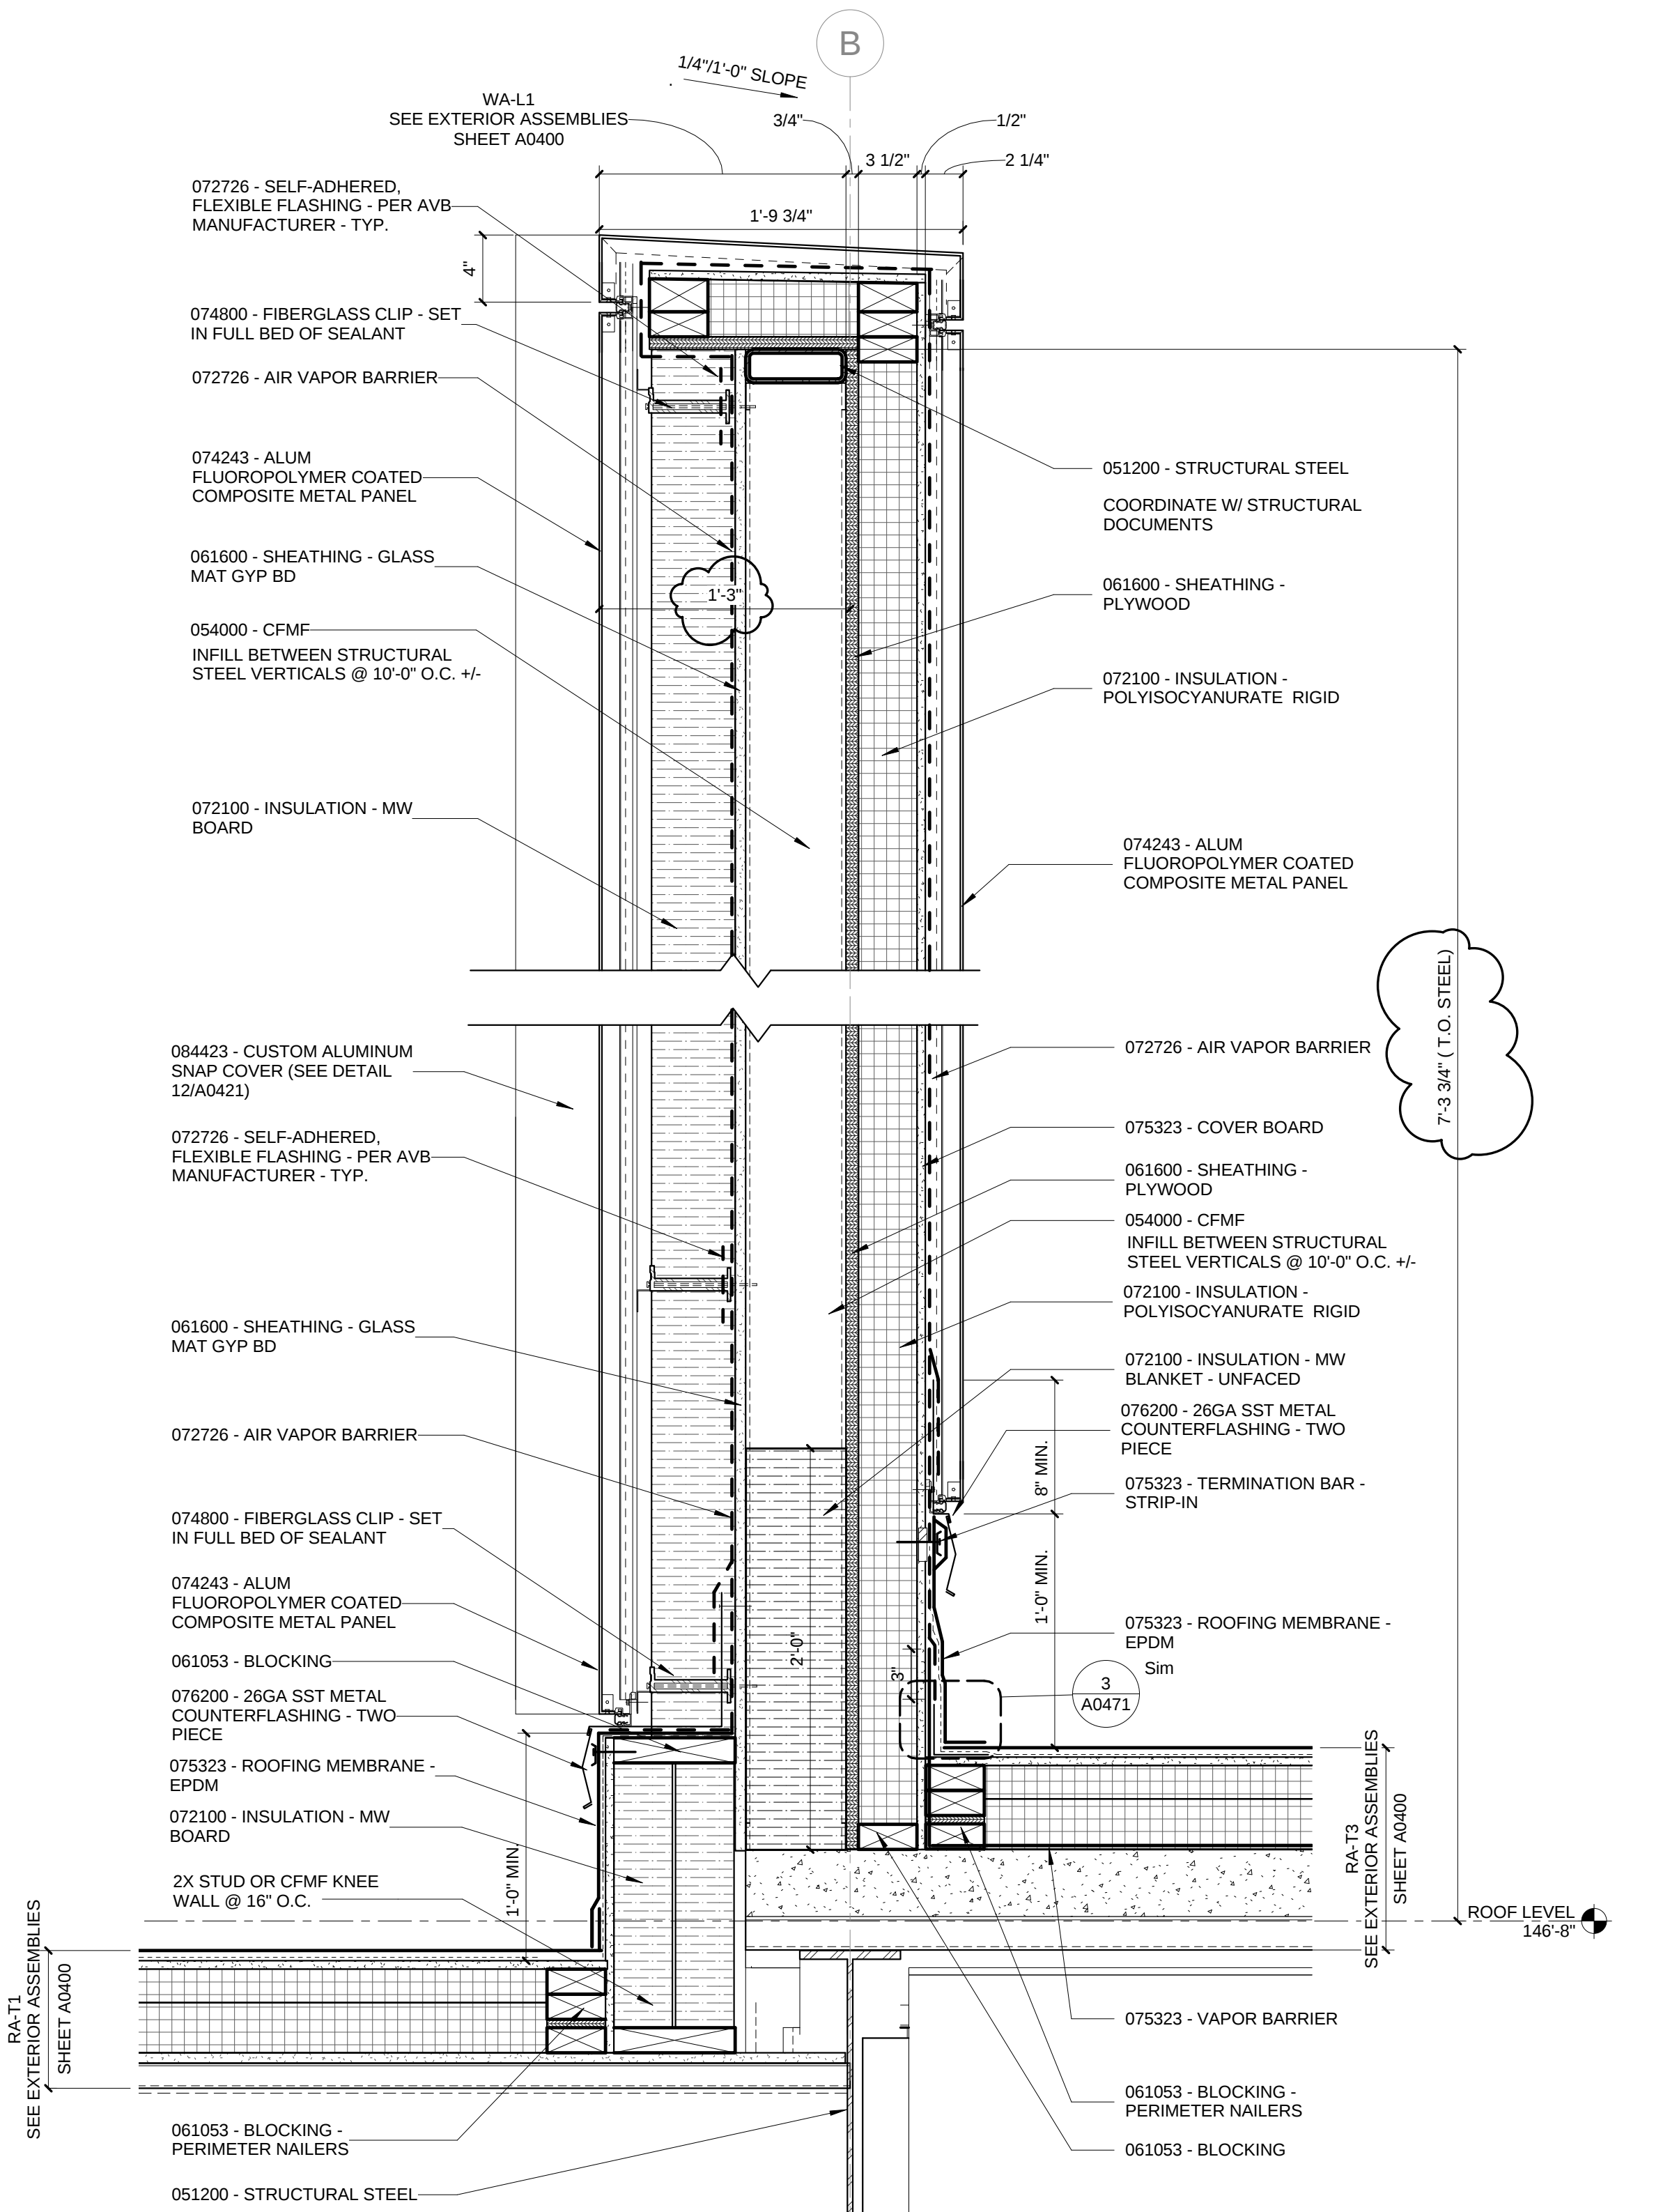

1 ENLARGED DETAIL - MECHANICAL SCREEN
1 1/2" = 1'-0"