




NOTES:
VALLEY FLASHING SHALL BE USED IN ALL
AREAS WHERE SLOPE EXCEEDS 1 1/2" PER
FOOT

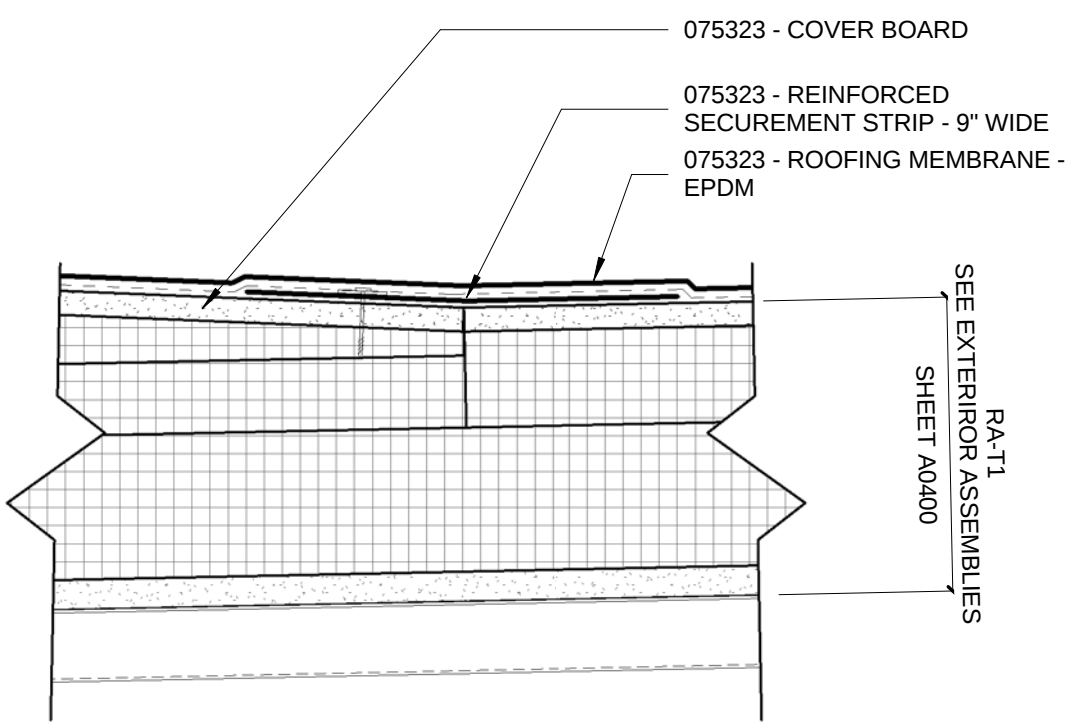


11 ENLARGED DETAIL - EPDM VALLEY - TYP
3" = 1'-0"

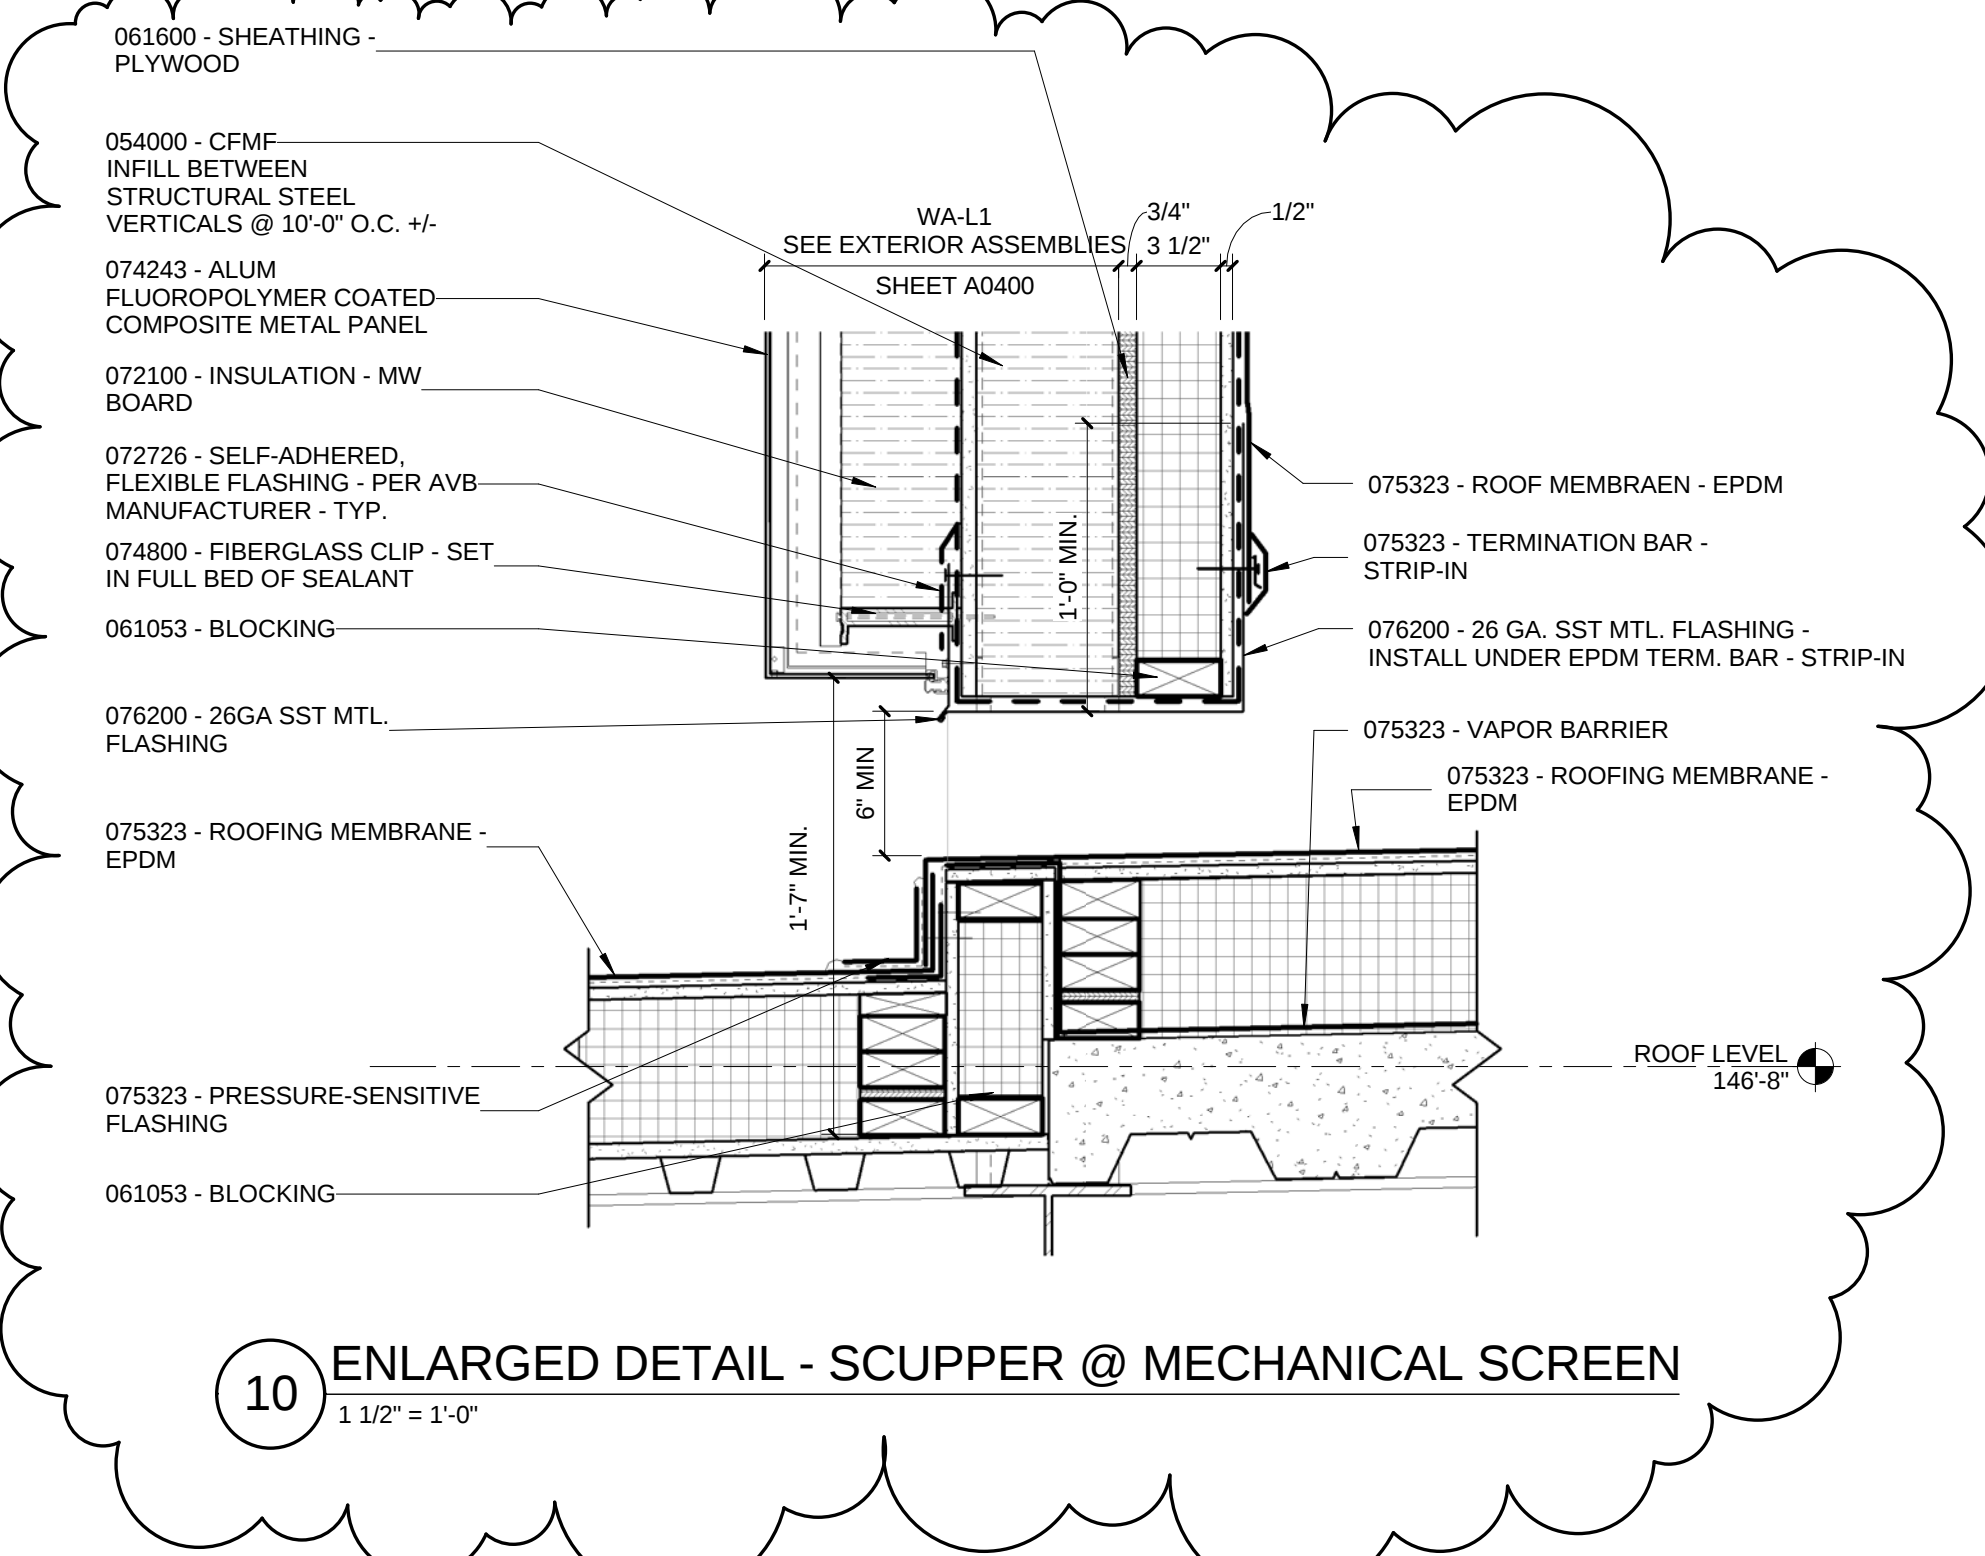


10 ENLARGED DETAIL - SCUPPER @ MECHANICAL SCREEN
1 1/2" = 1'-0"

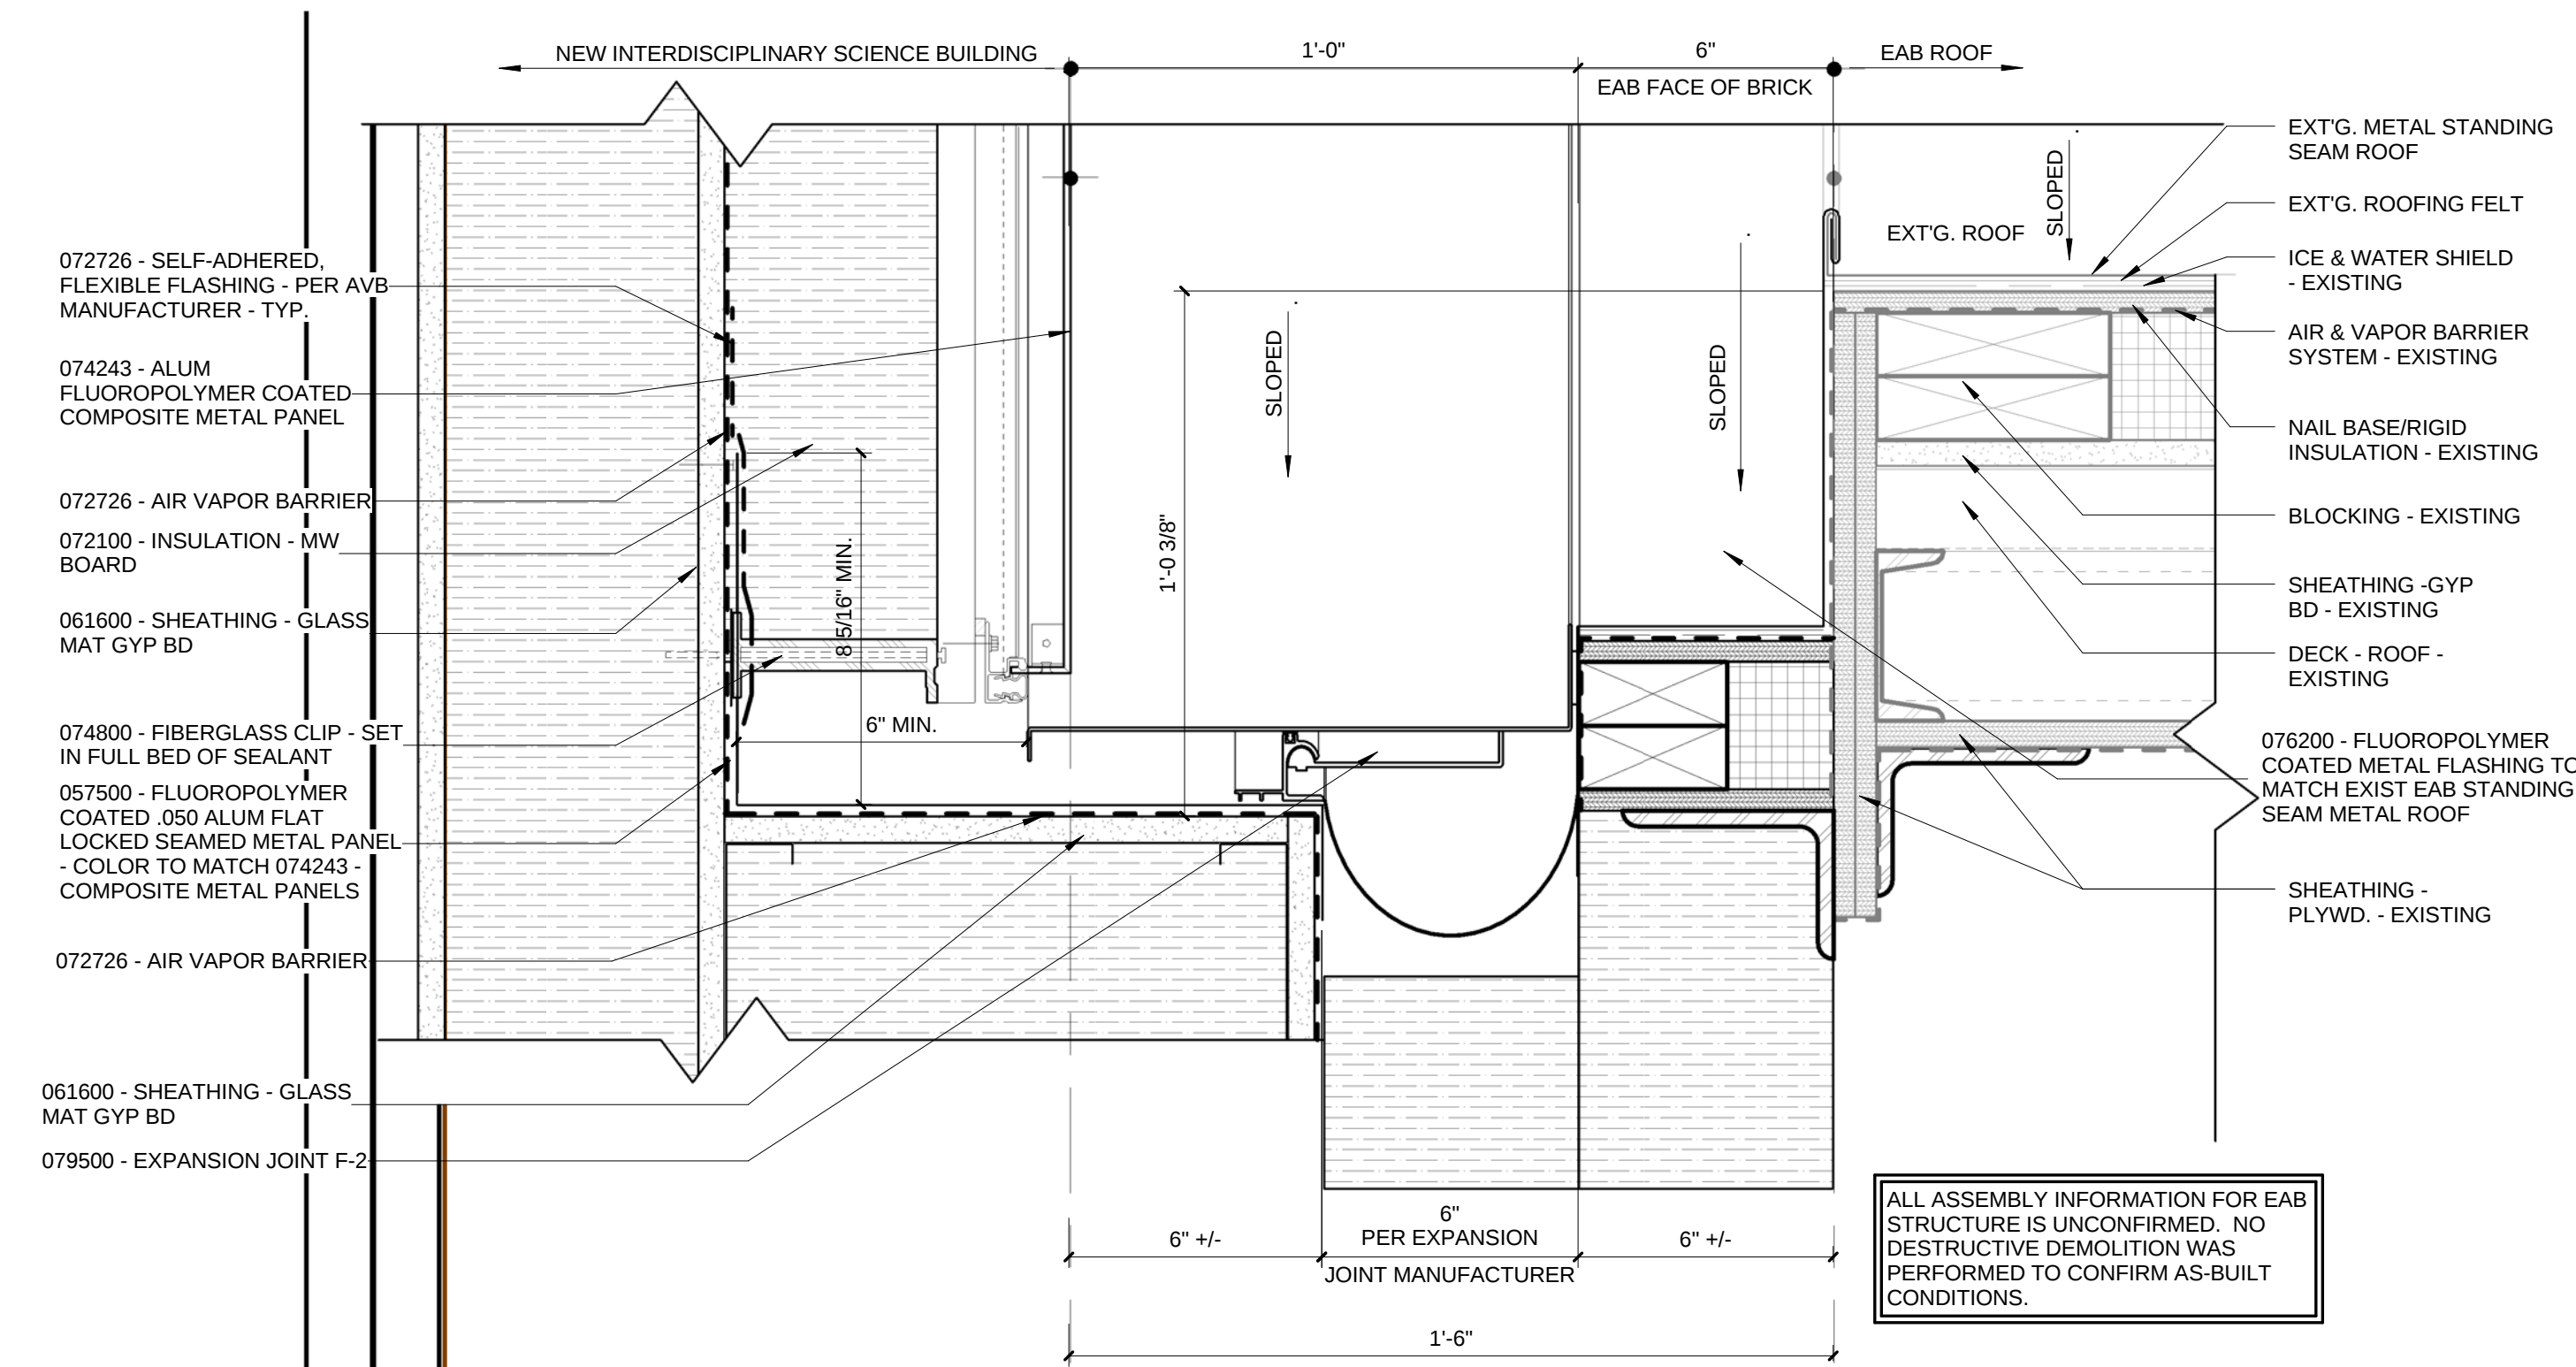


9 ISB TO EAB ROOF TO WALL EXPANSION JOINT DETAIL
3" = 1'-0"

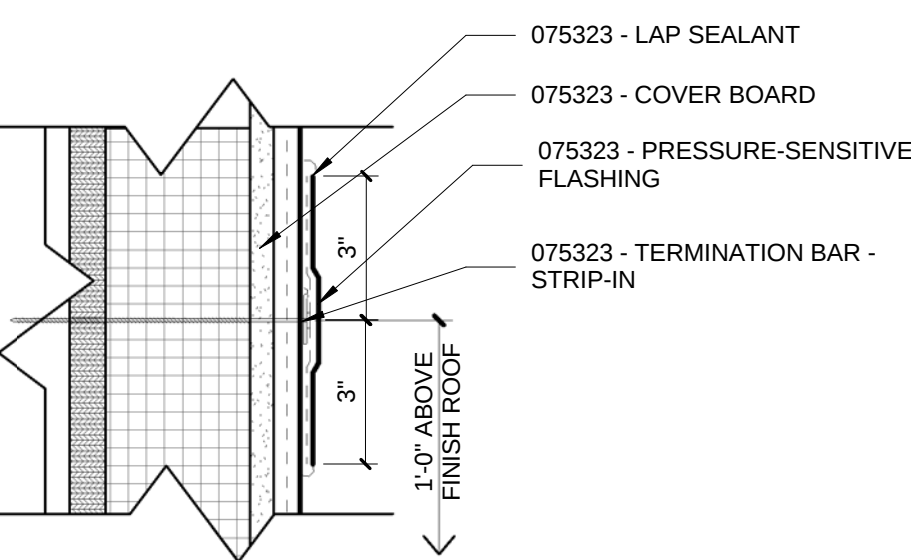


8 ENLARGED DETAIL - TERM. BAR FLASHING - TYP
3" = 1'-0"

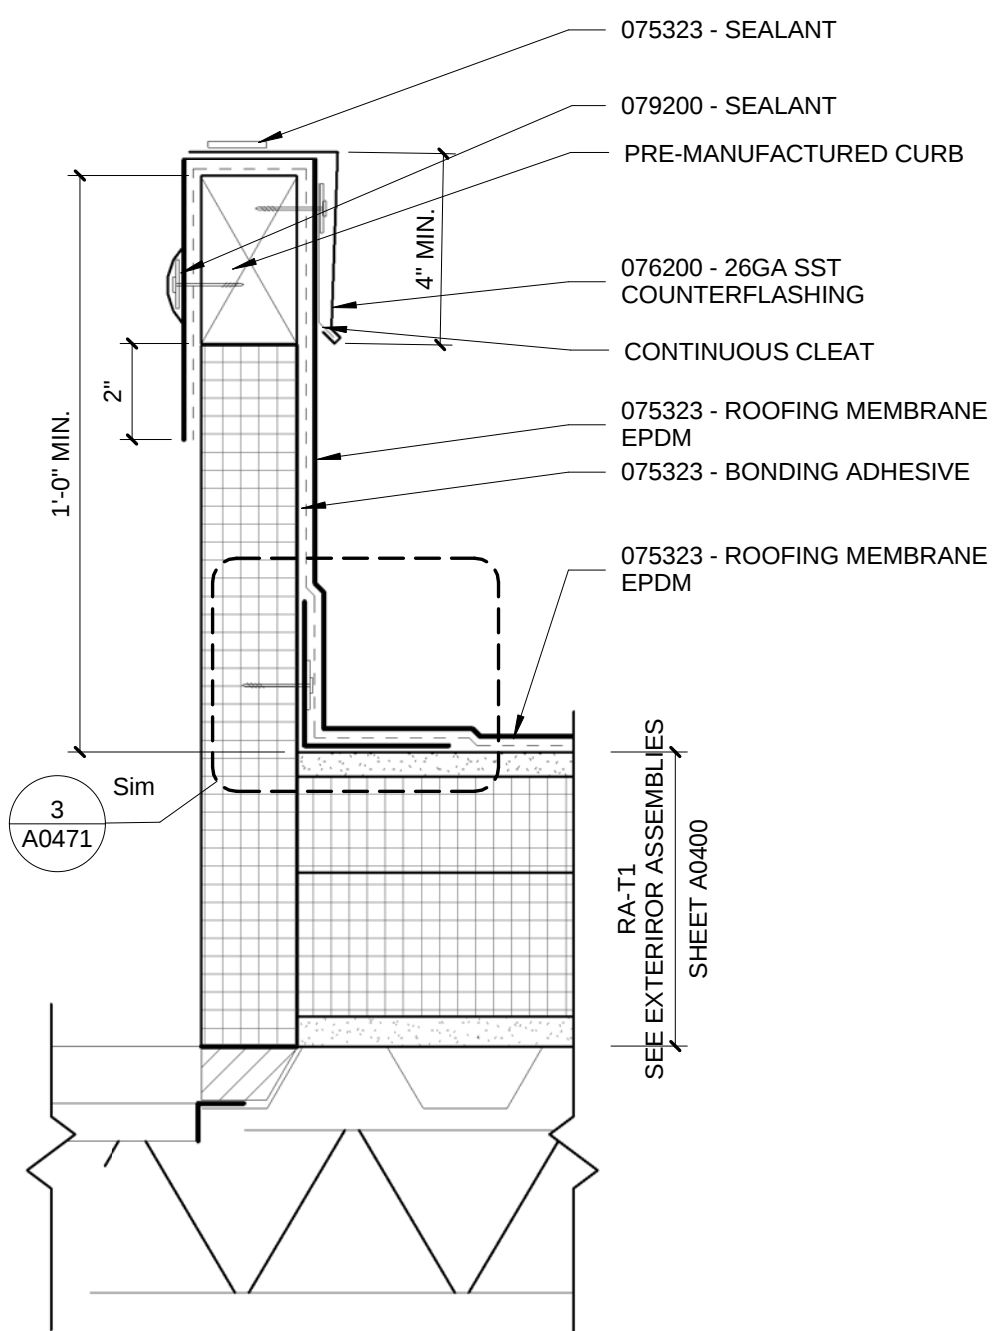


7 ENLARGED DETAIL - PRE-MANUFACTURED ROOF CURB
3" = 1'-0"

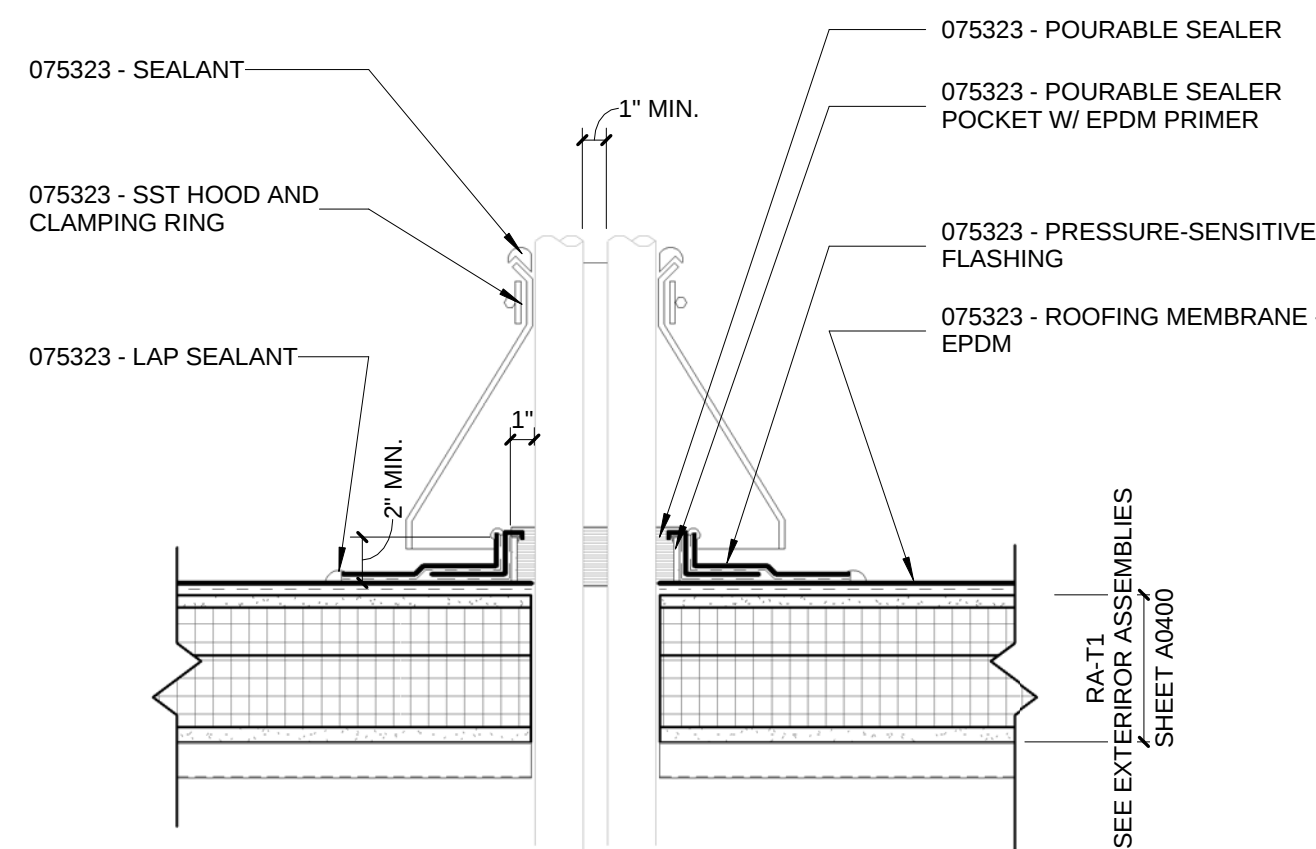


6 ENLARGED DETAIL - PITCH POCKET
1 1/2" = 1'-0"

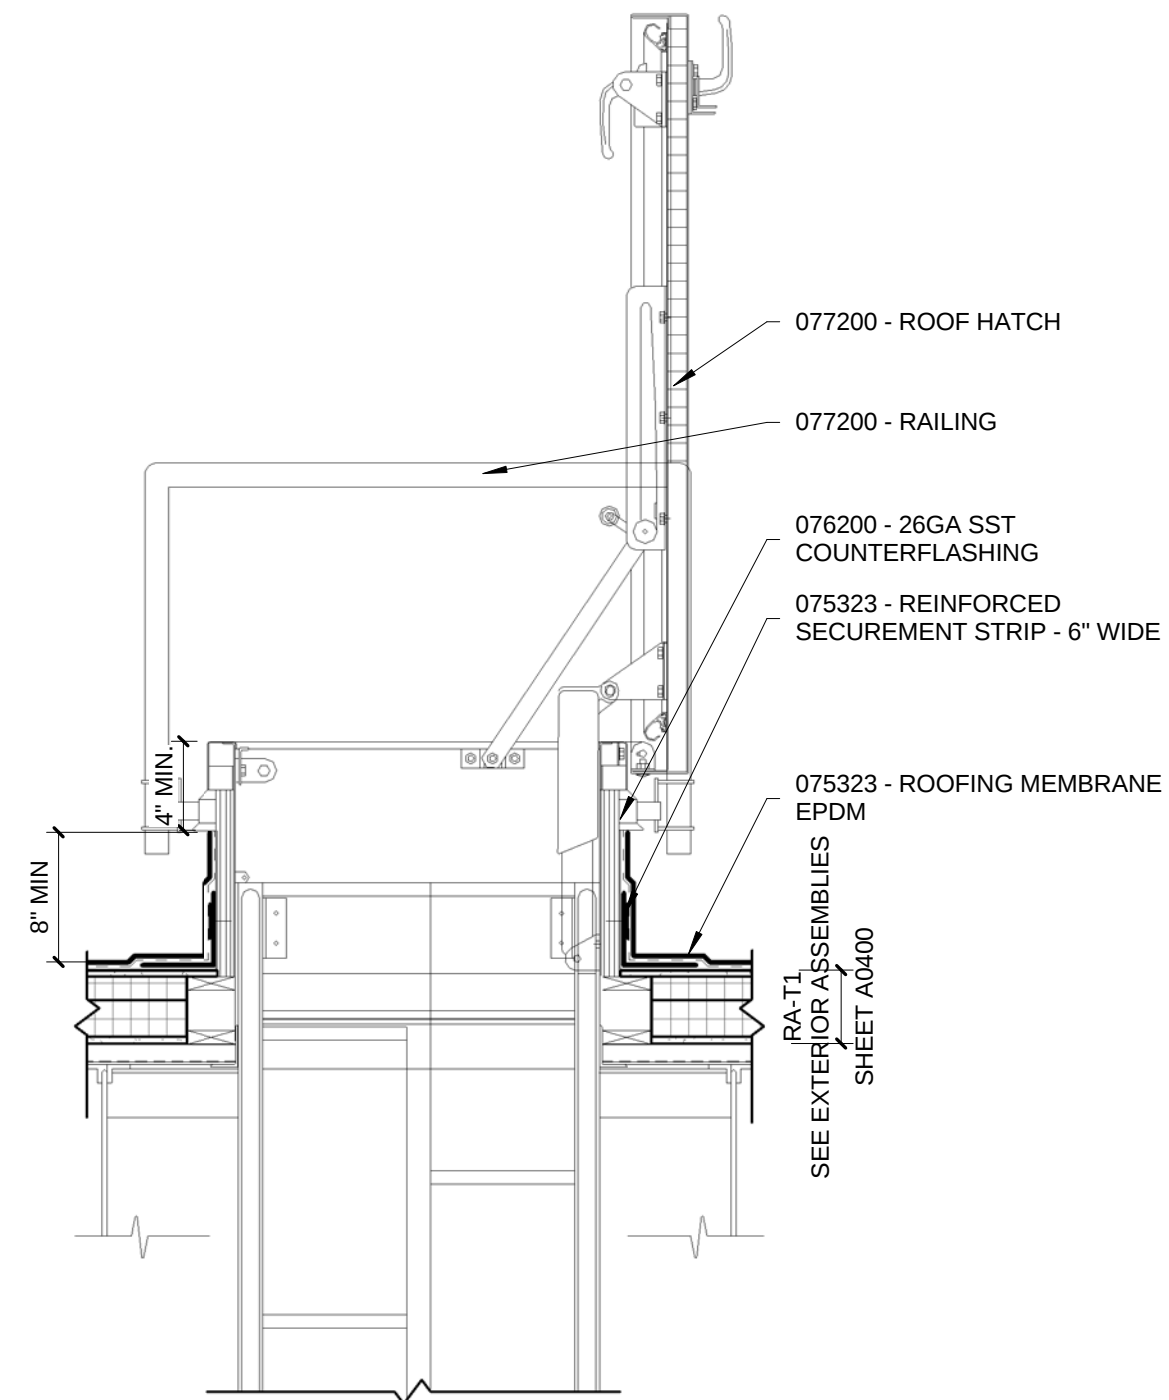


5 ENLARGED DETAIL - PRE-MANUFACTURED ROOF HATCH
3/4" = 1'-0"

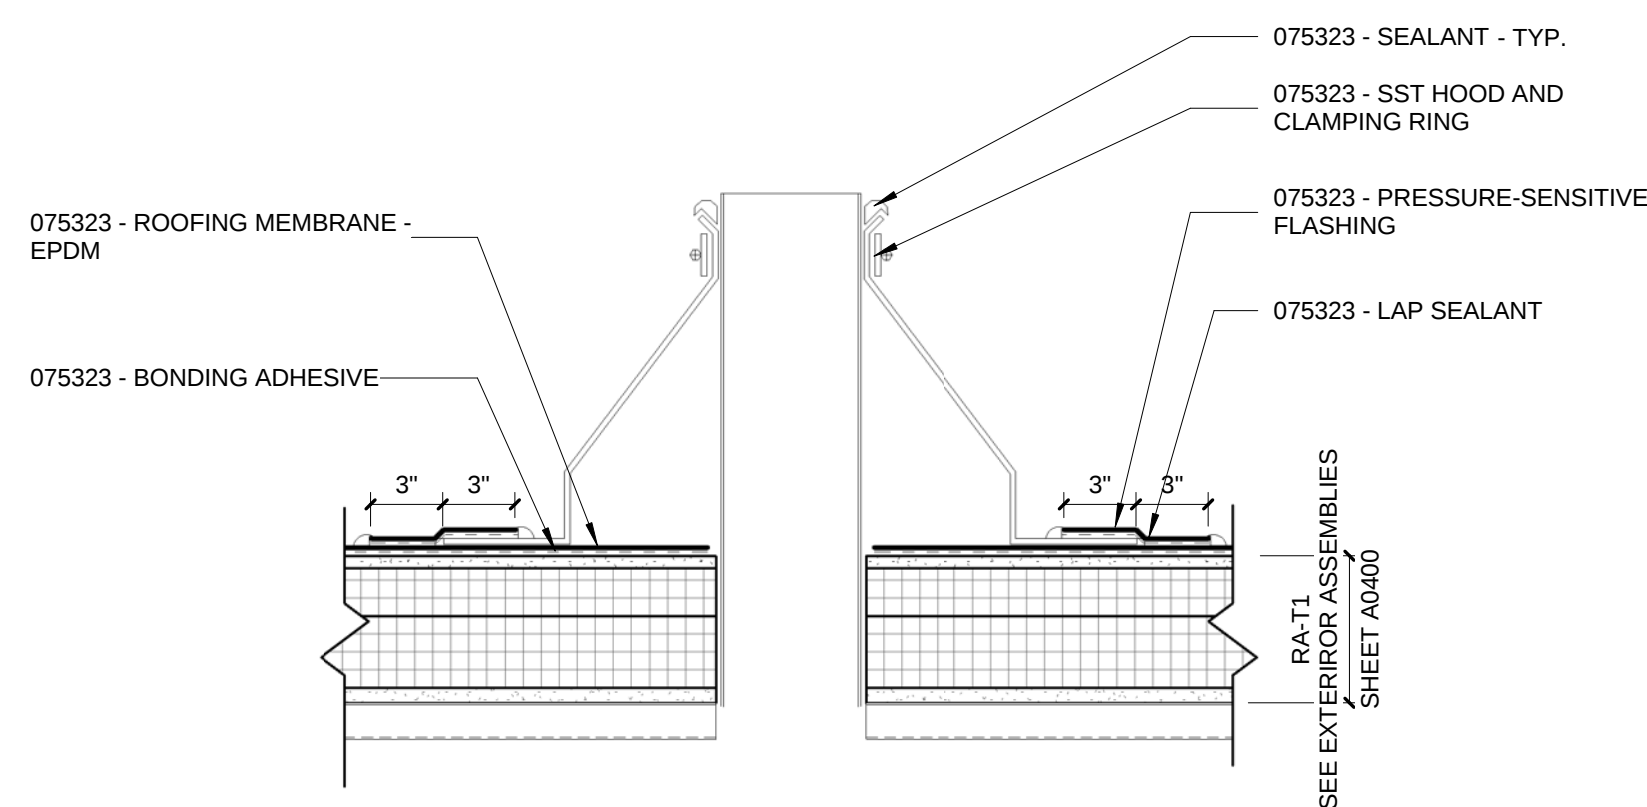


4 ENLARGED DETAIL - PRE-MOLDED PIPE BOOT DETAIL
1 1/2" = 1'-0"

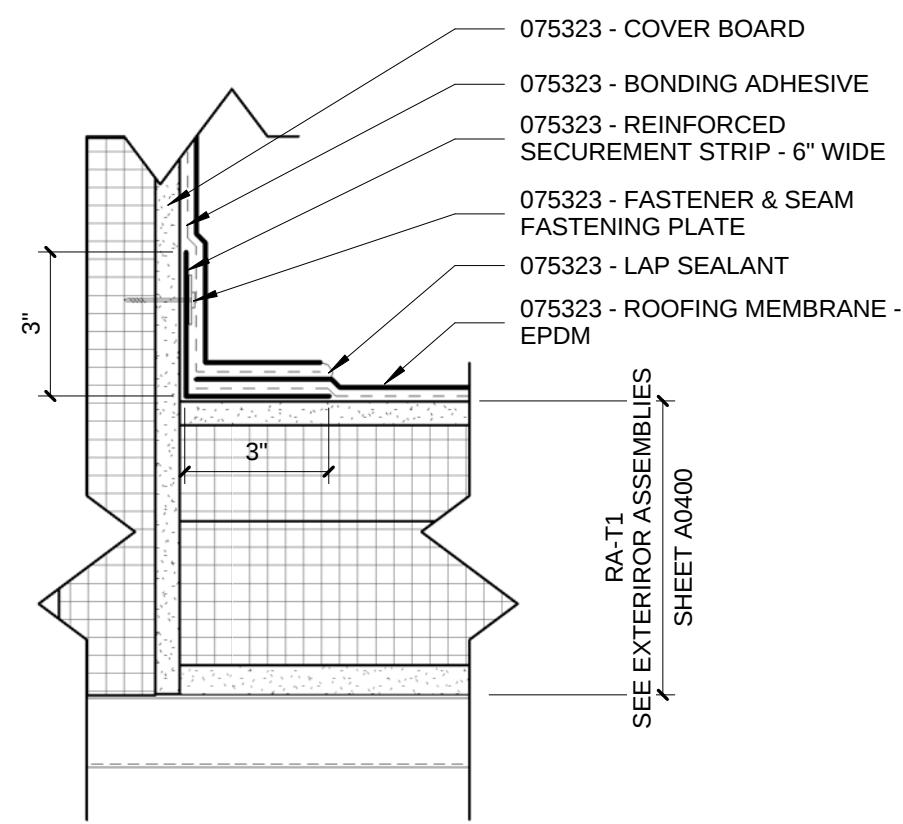

3 ENLARGED DETAIL - ROOF TO WALL FLASHING - TYP
3" = 1'-0"

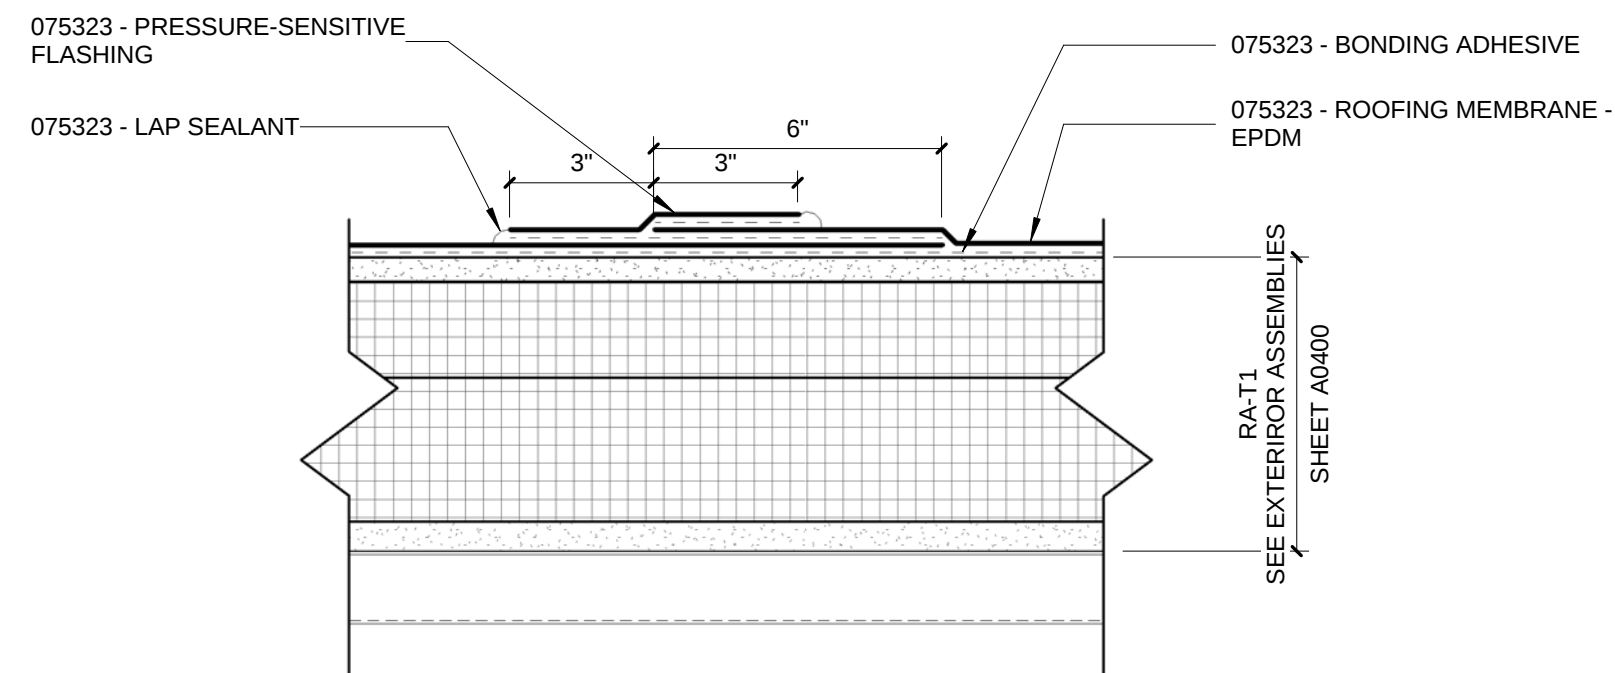

2 ENLARGED DETAIL - EPDM STRIP-IN - TYP
3" = 1'-0"

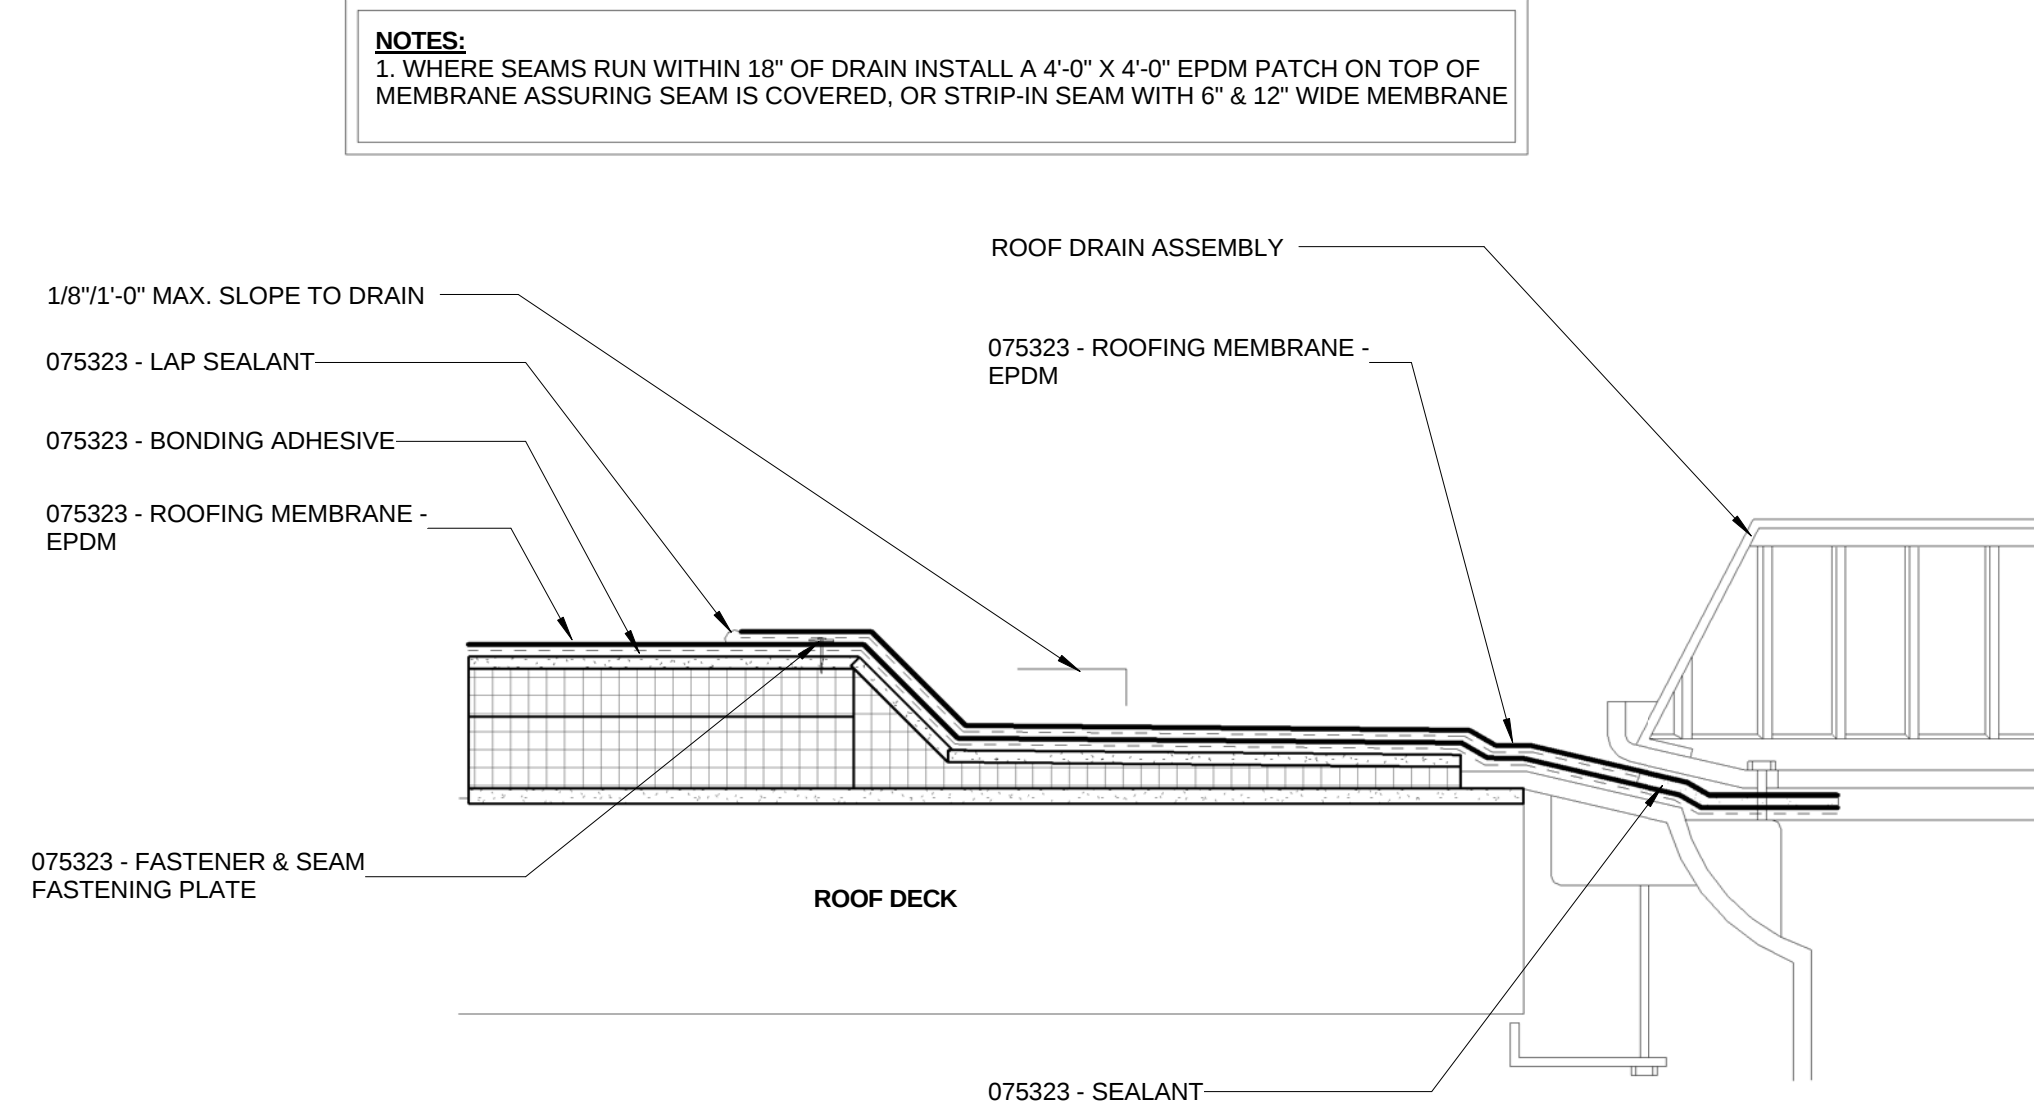

1 ENLARGED DETAIL - ROOF DRAIN
1 1/2" = 1'-0"