




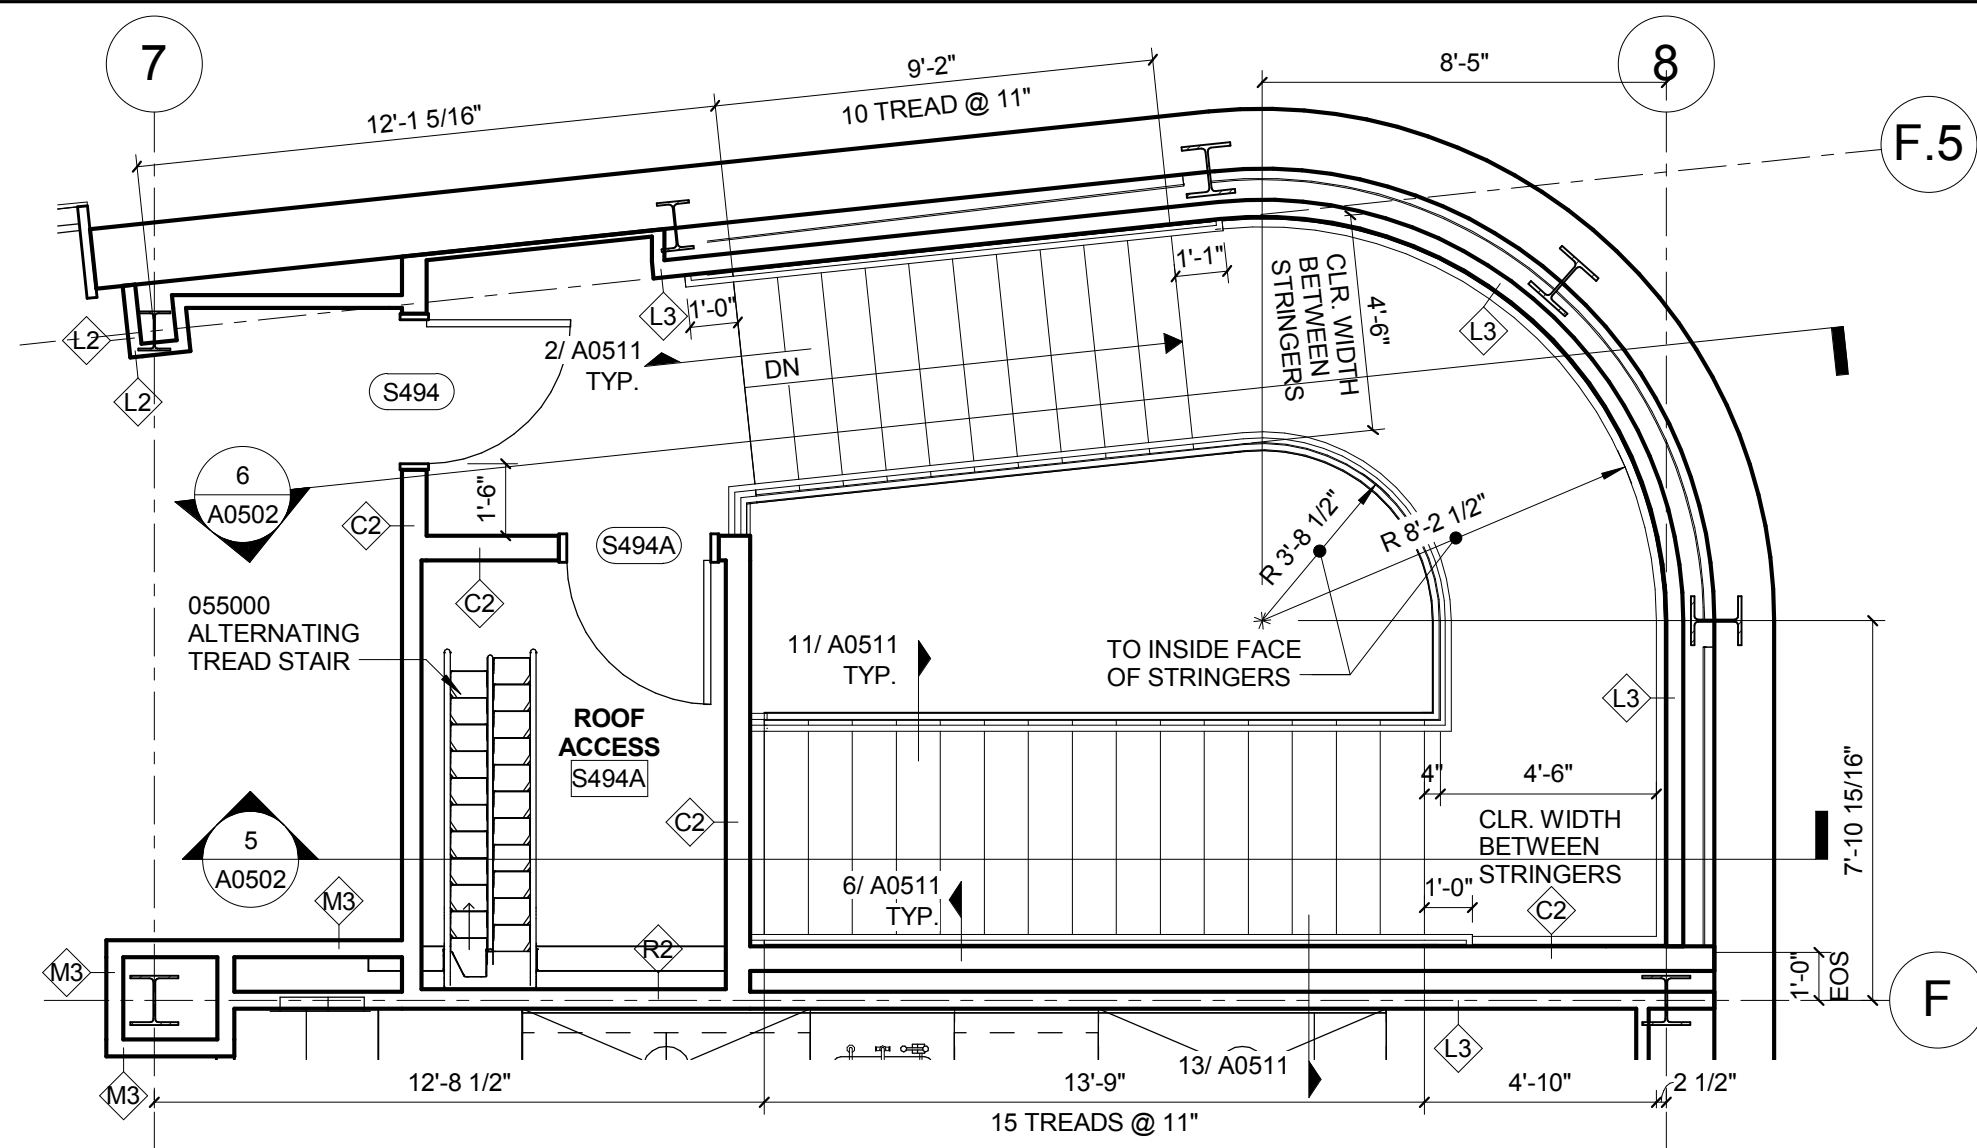


4 STAIR 2 PLAN - LEVEL 04
1/4" = 1'-0"

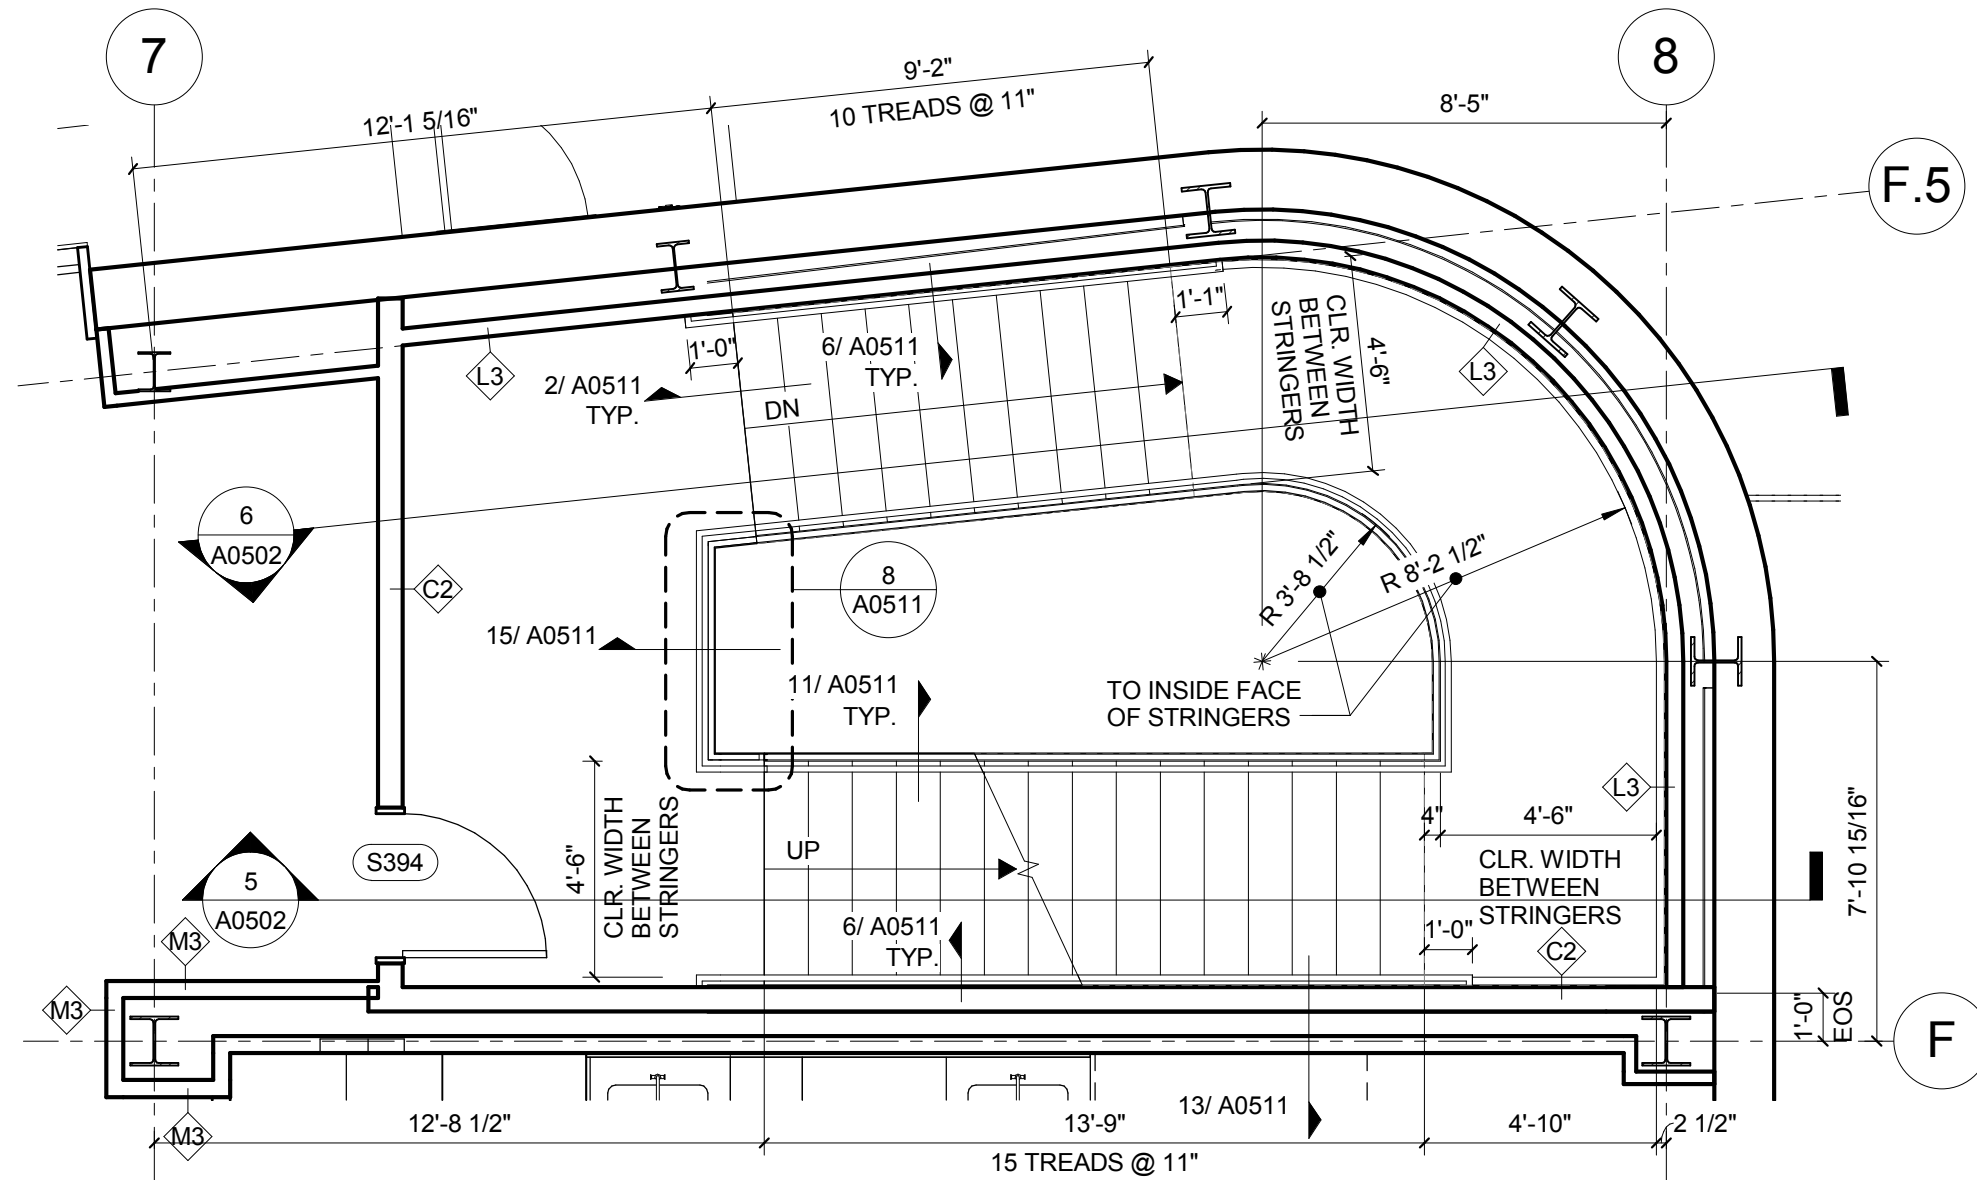


3 STAIR 2 PLAN - LEVEL 03
1/4" = 1'-0"

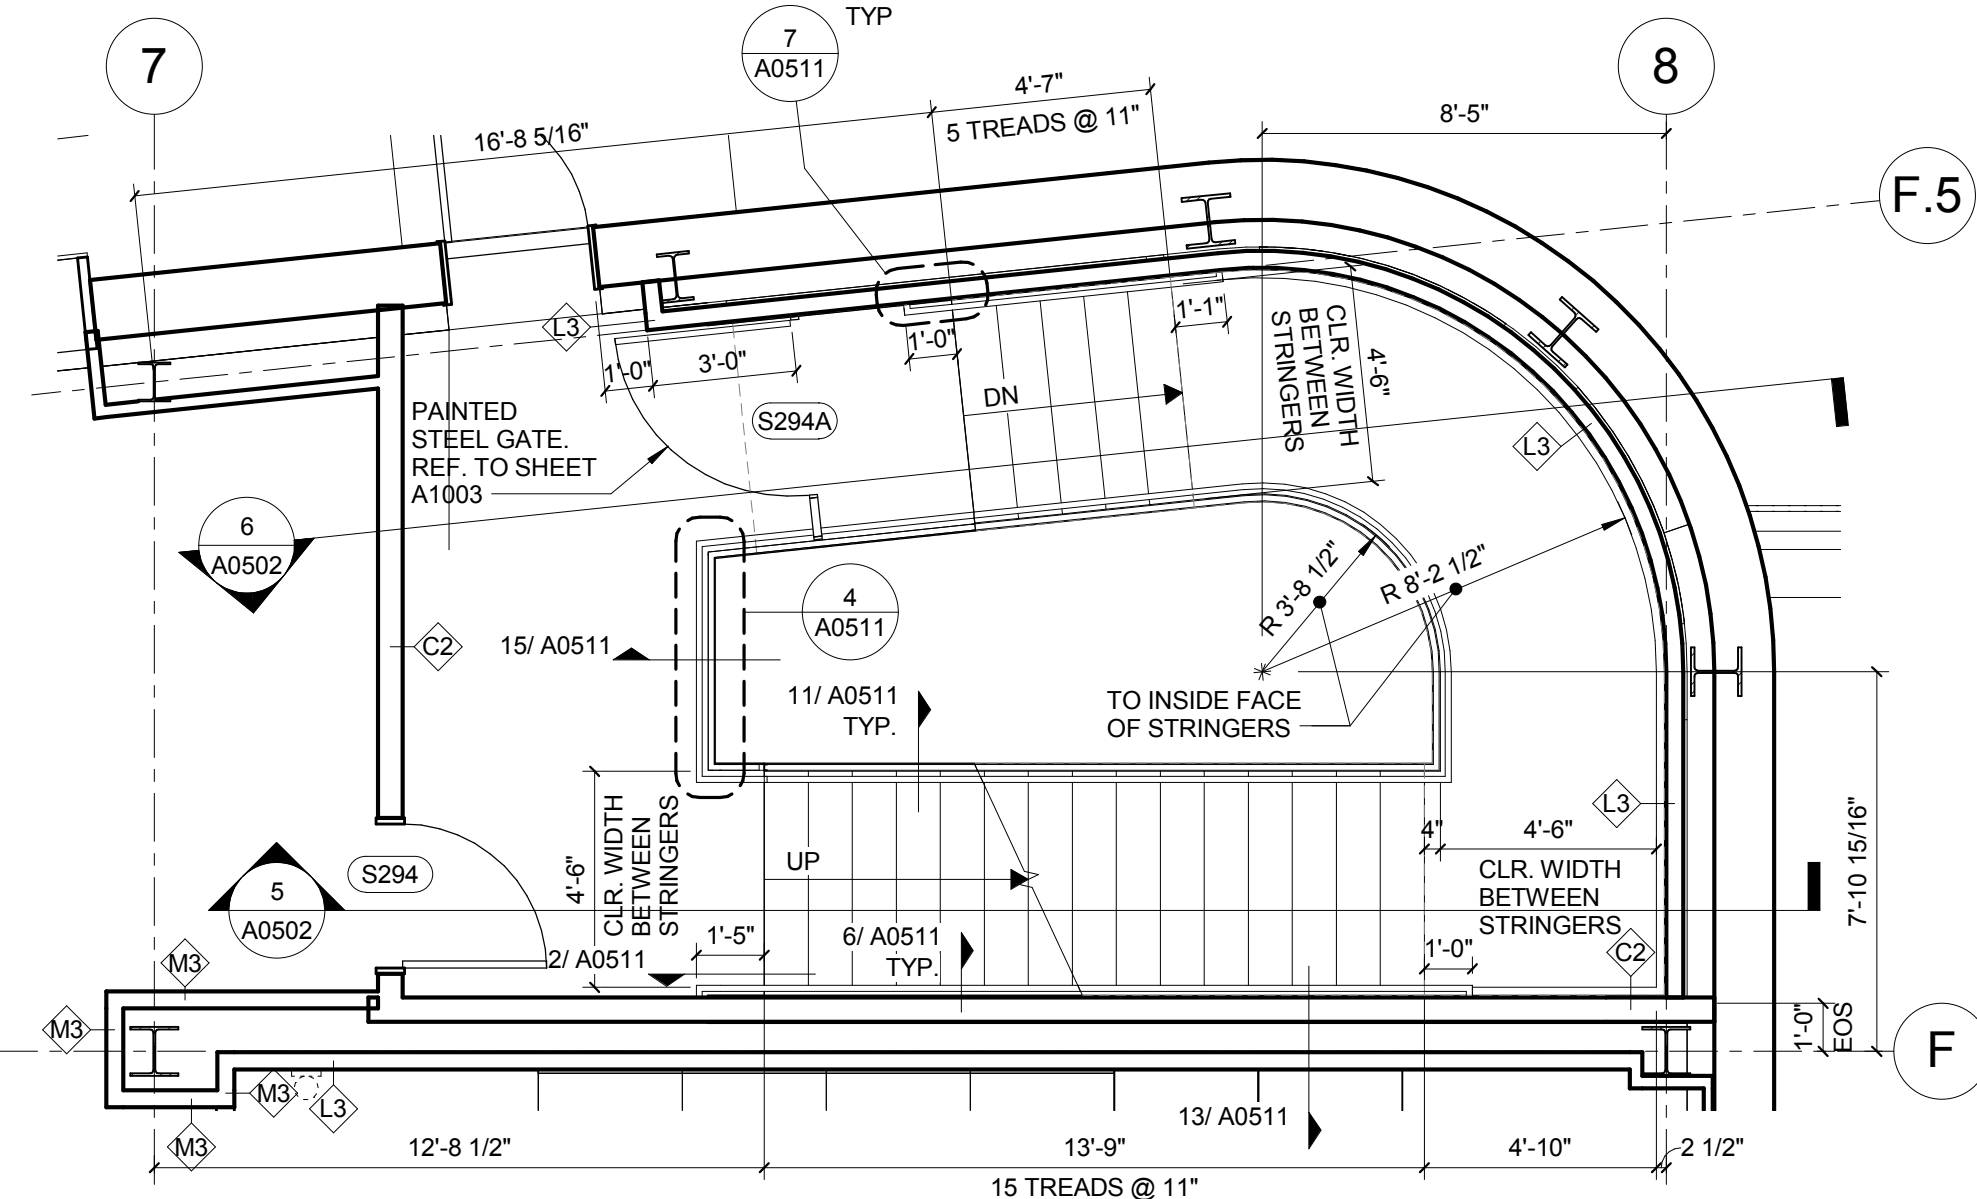


2 STAIR 2 PLAN - LEVEL 02
1/4" = 1'-0"

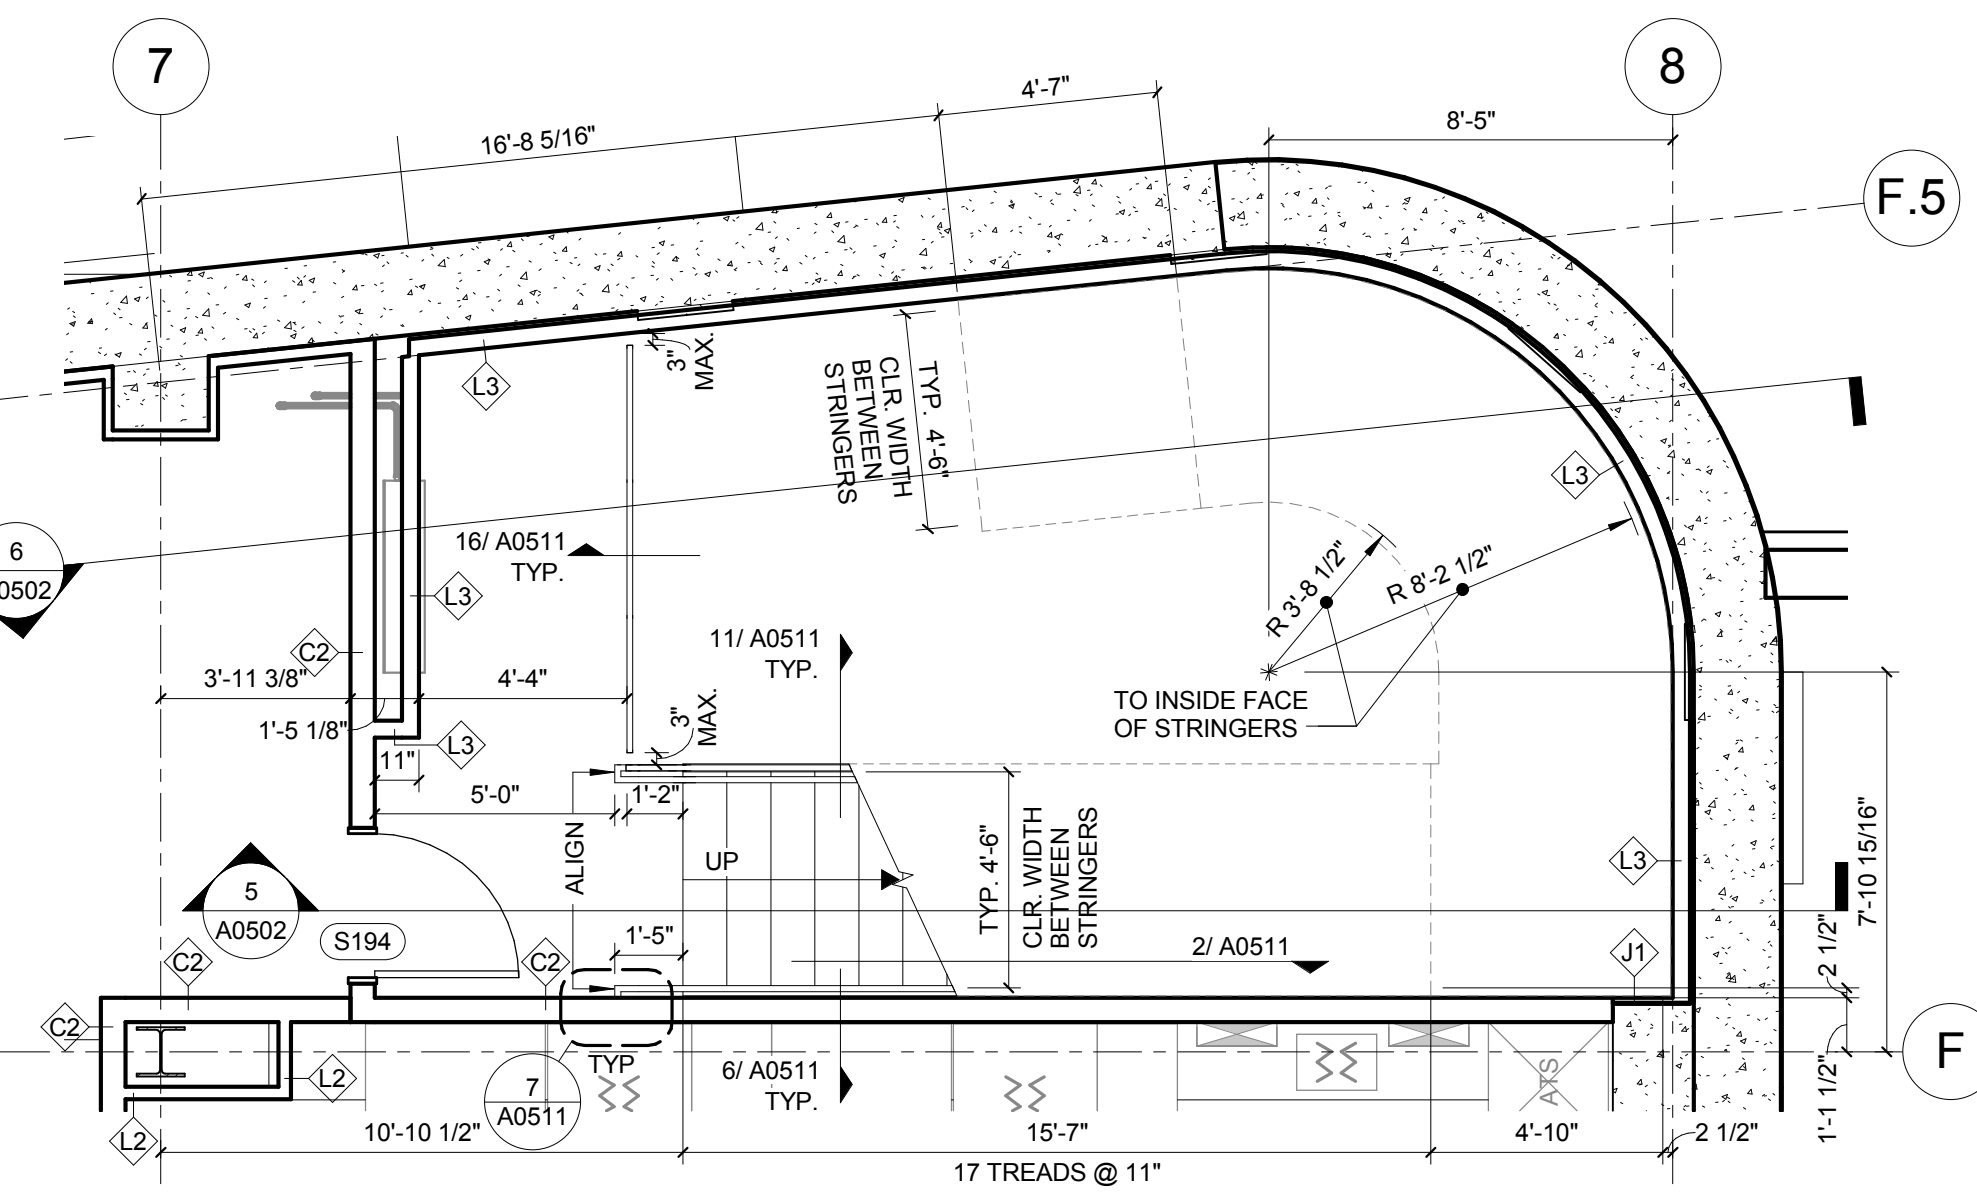

1 STAIR 2 PLAN - LEVEL 01
1/4" = 1'-0"

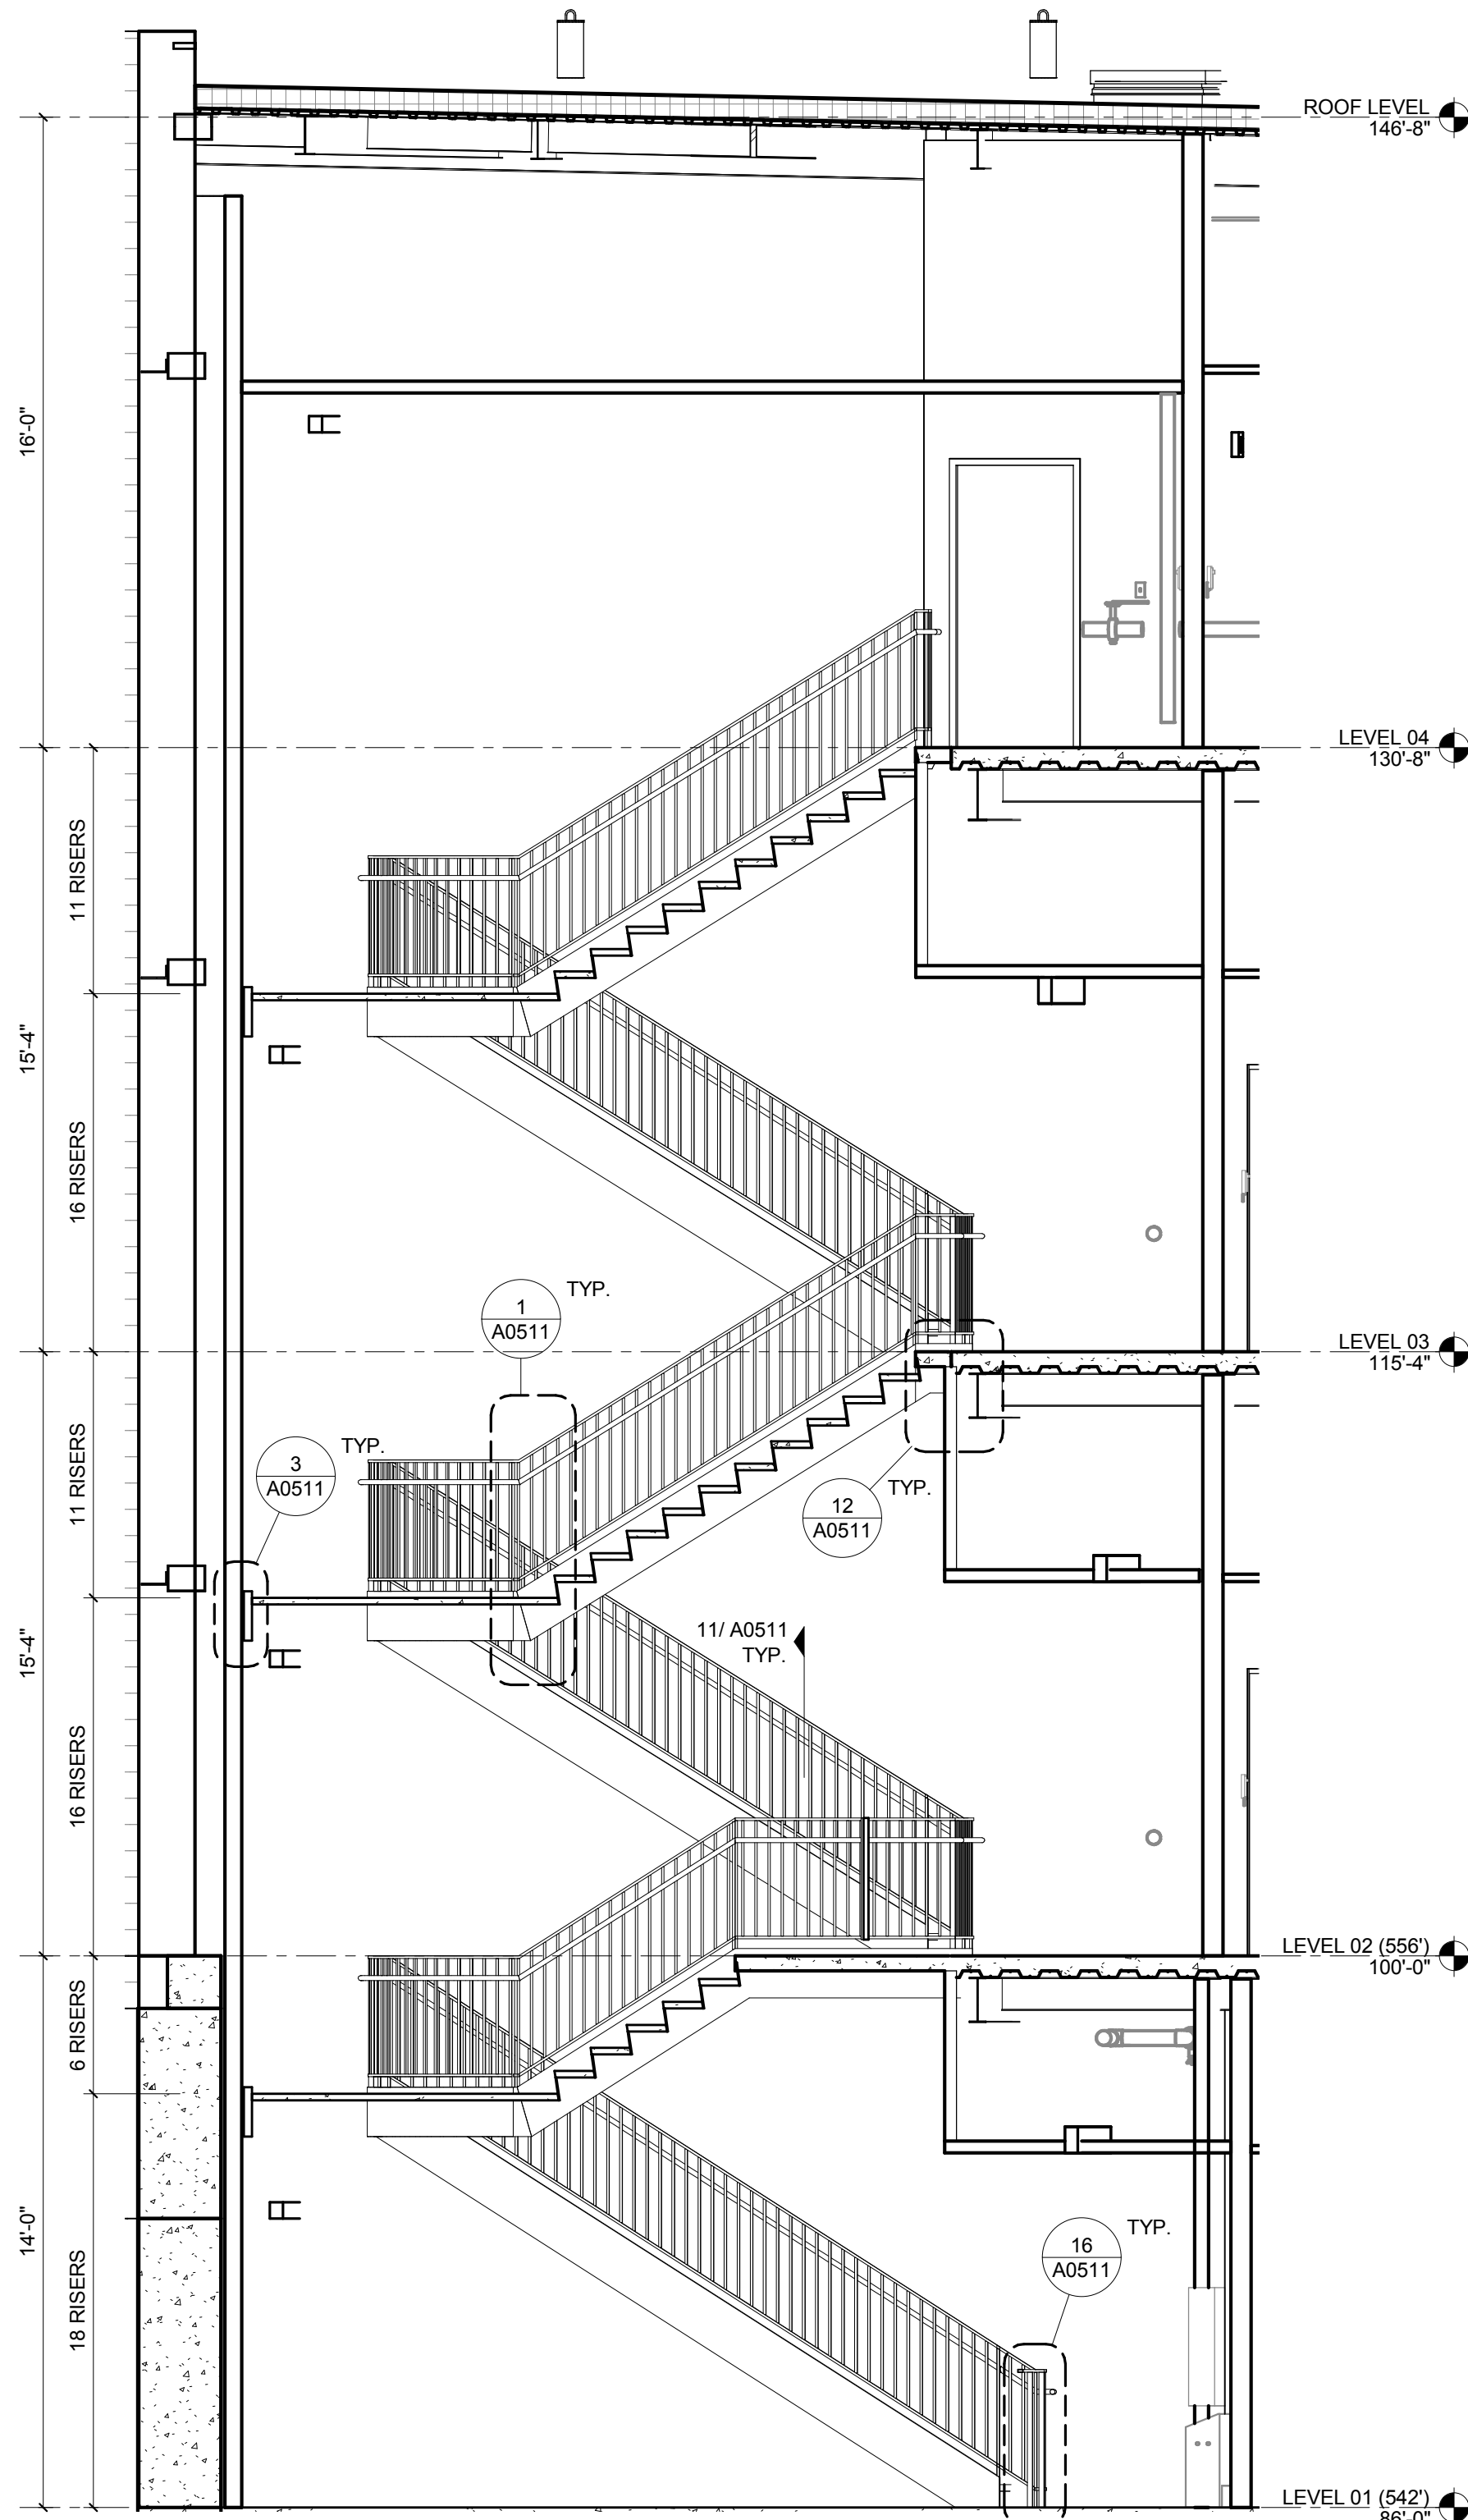

6 STAIR 2 SECTION - 2
1/4" = 1'-0"

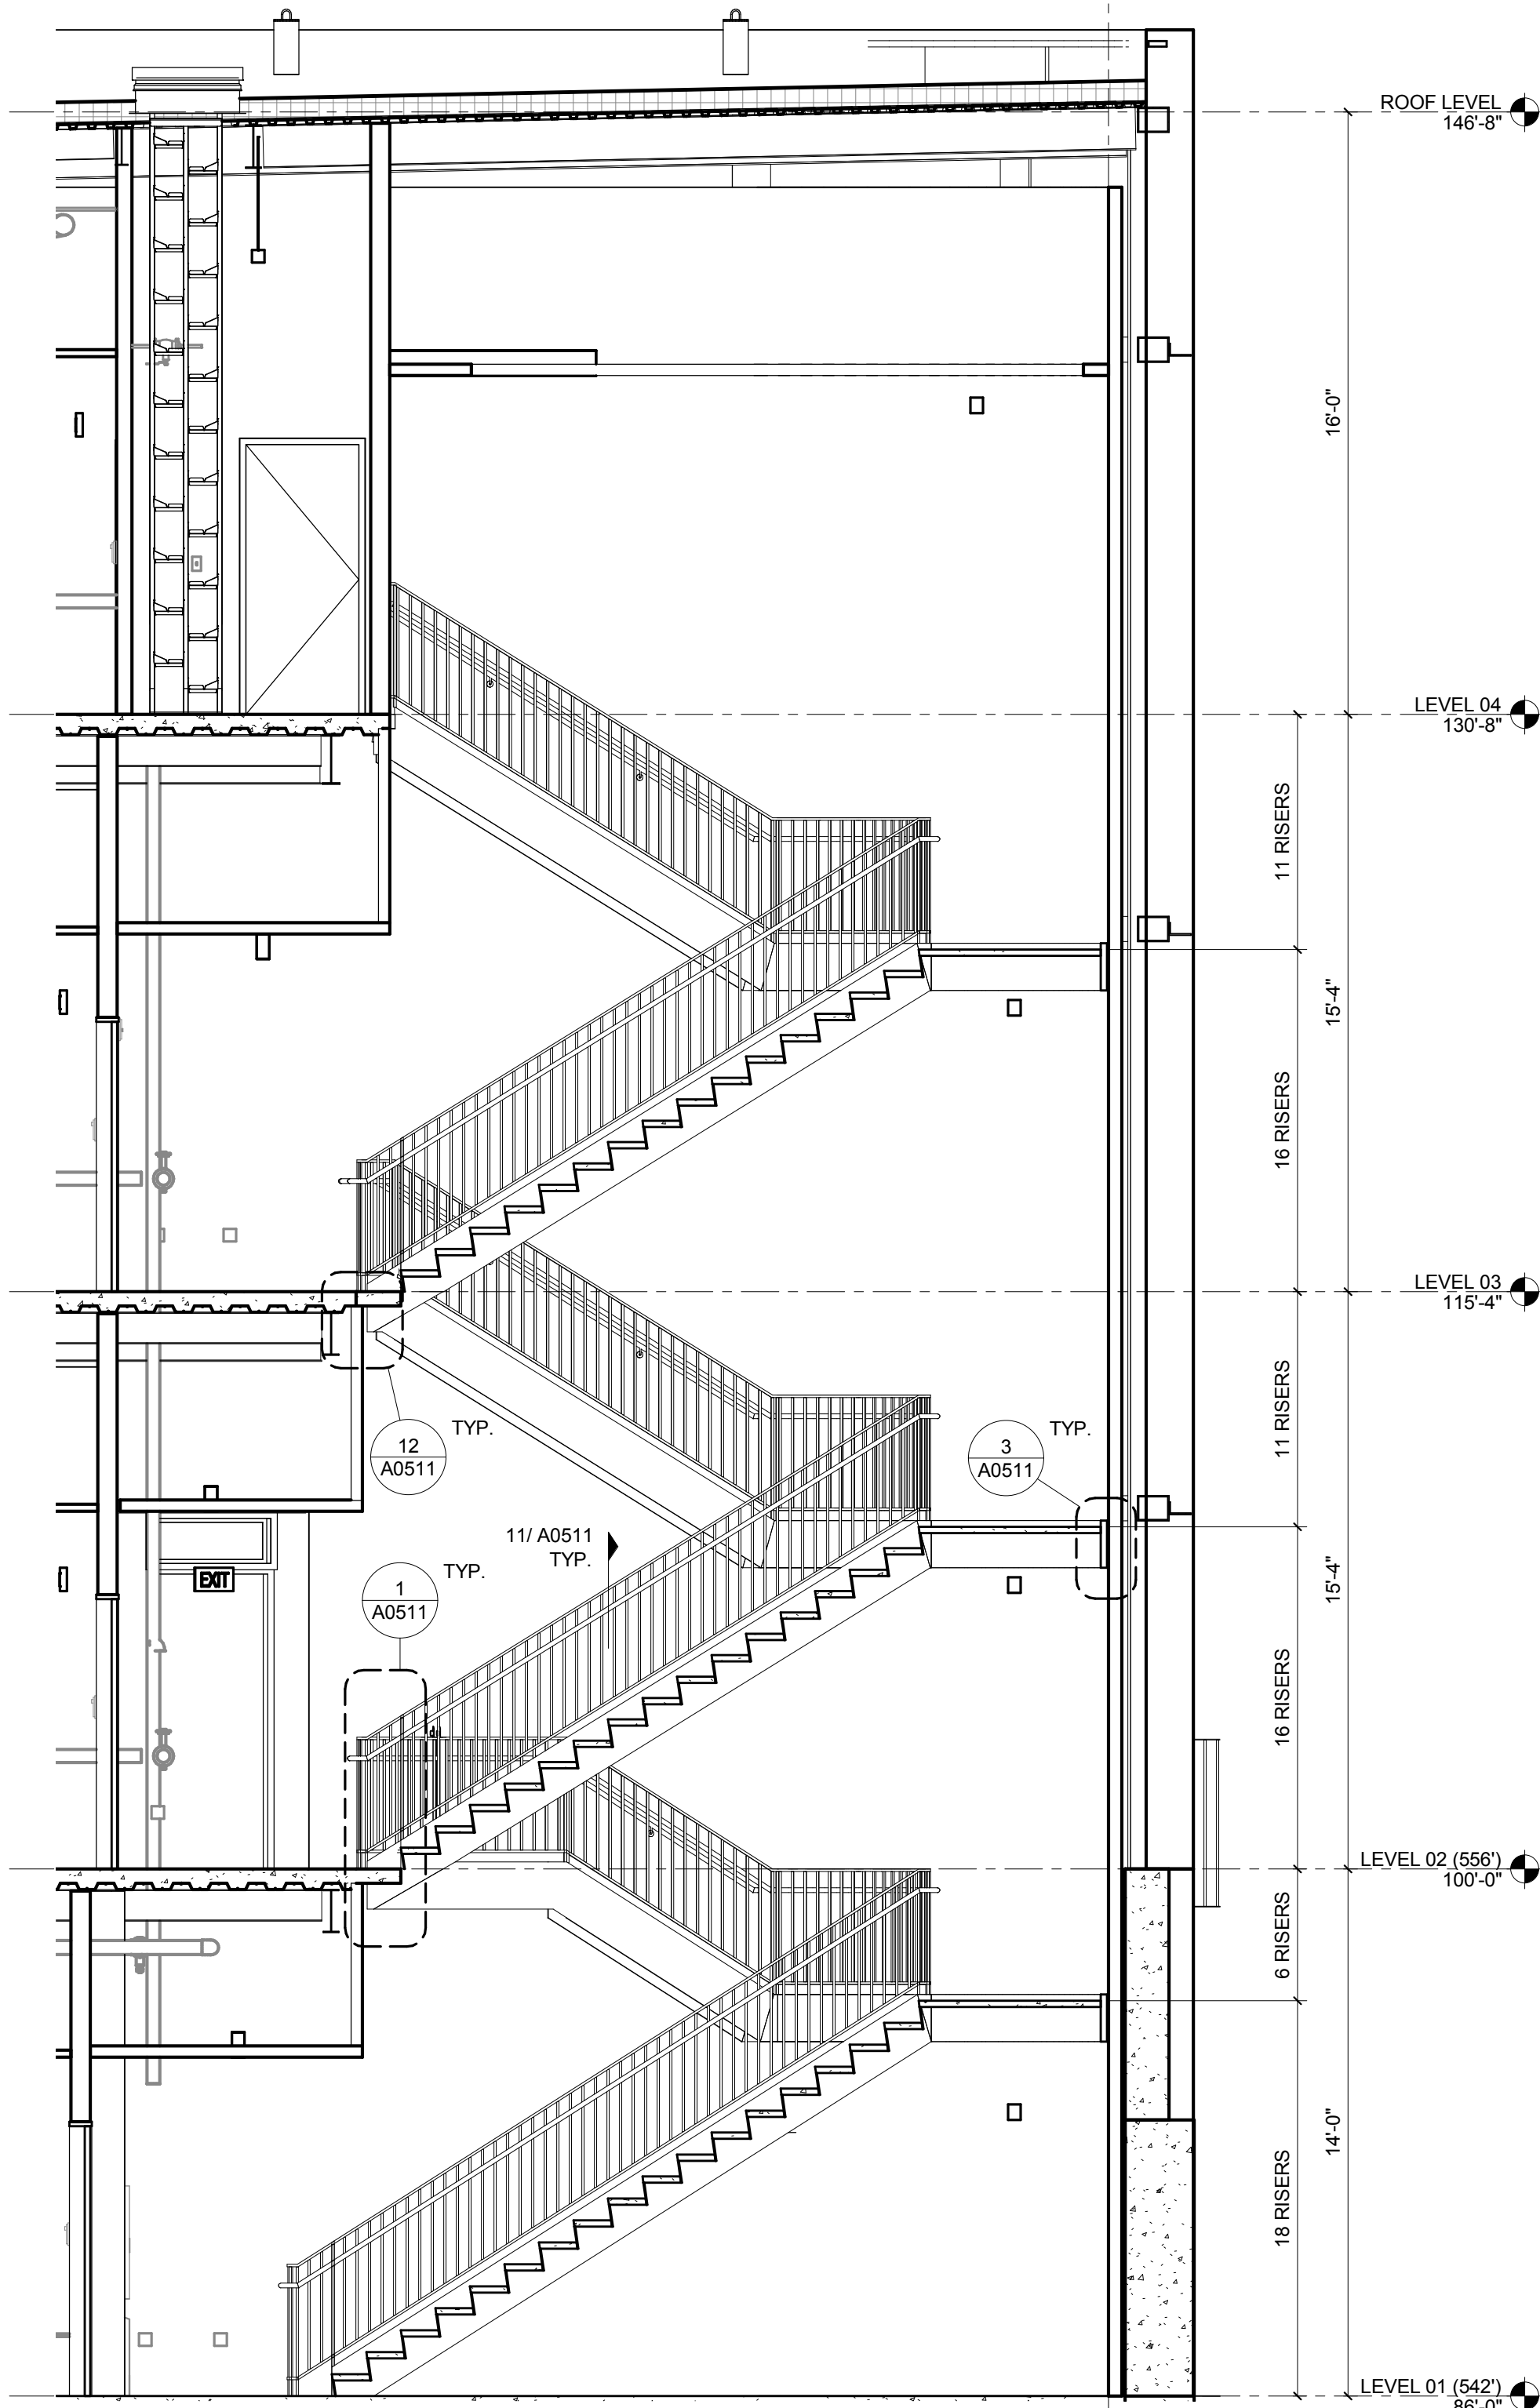

5 STAIR 2 SECTION - 1
1/4" = 1'-0"