


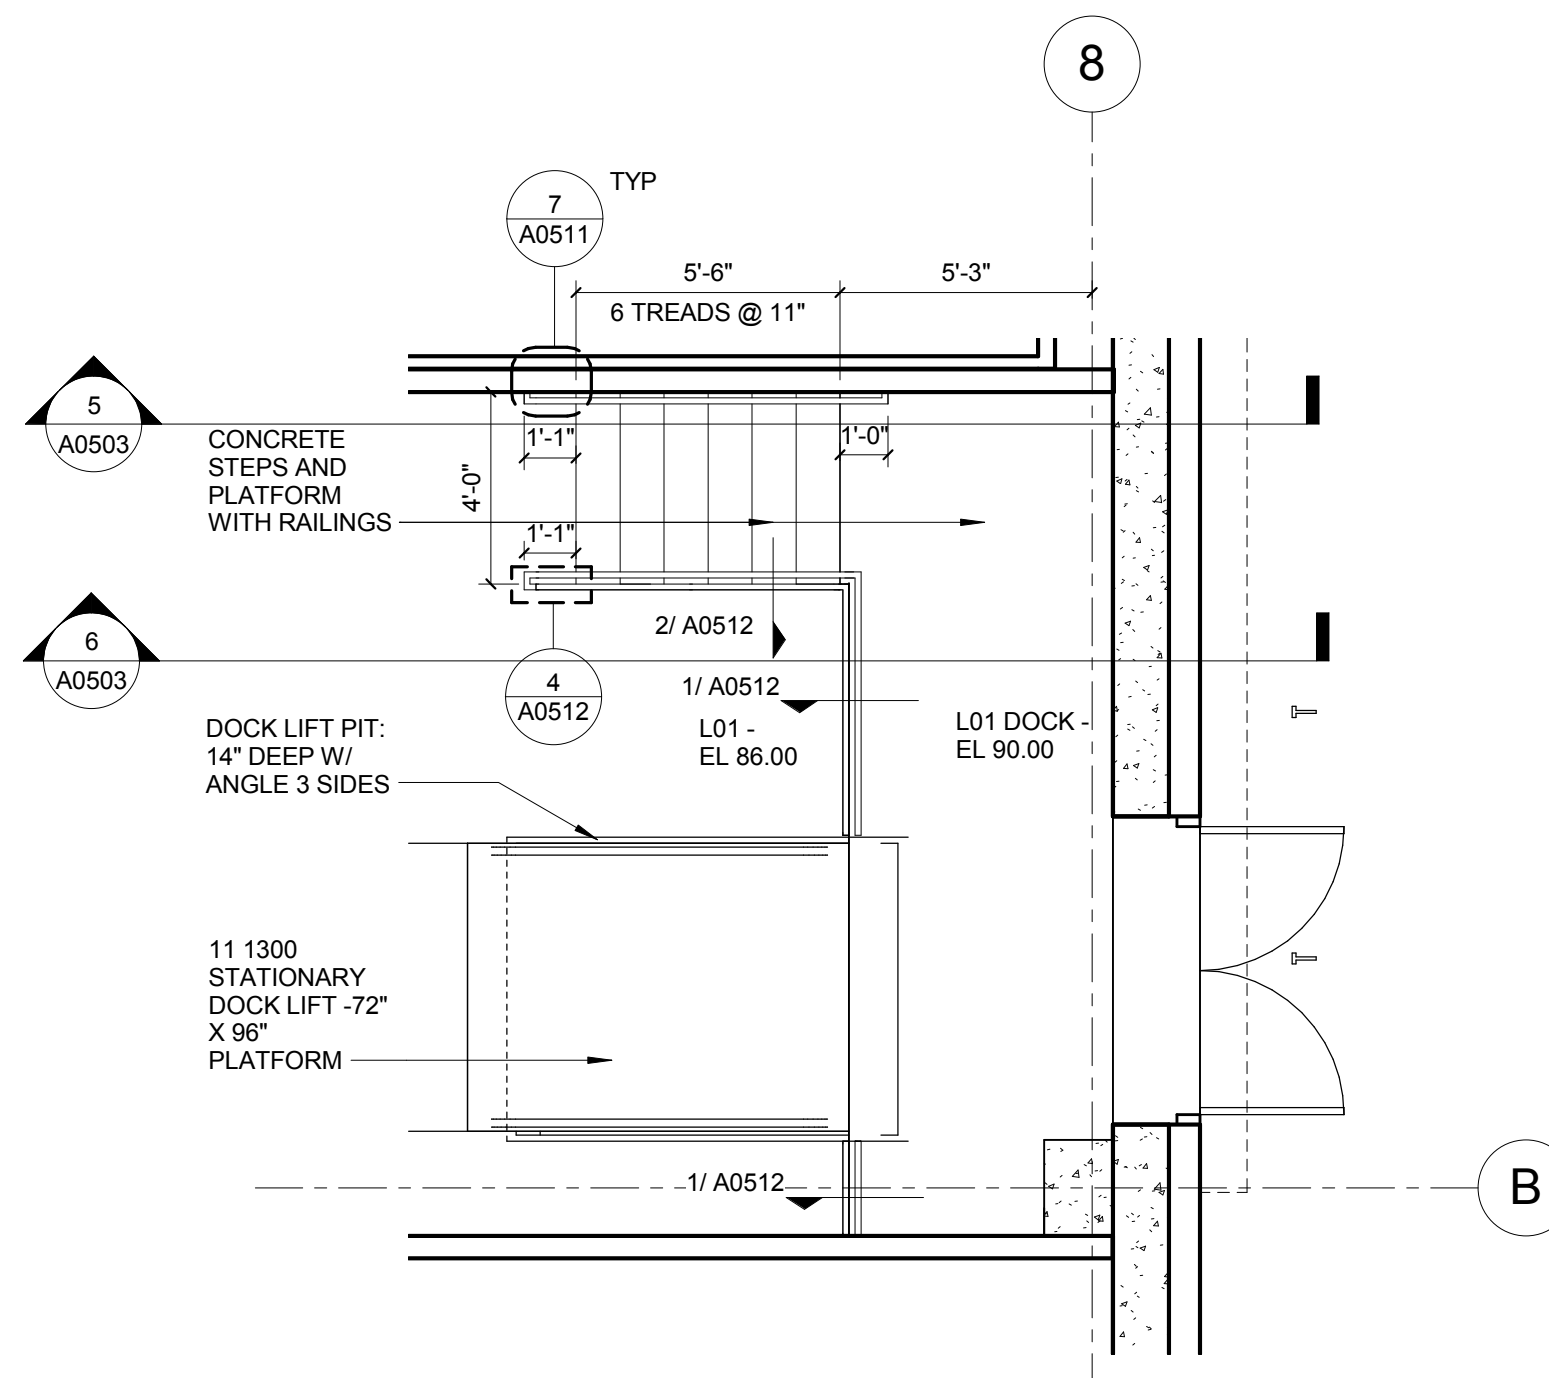
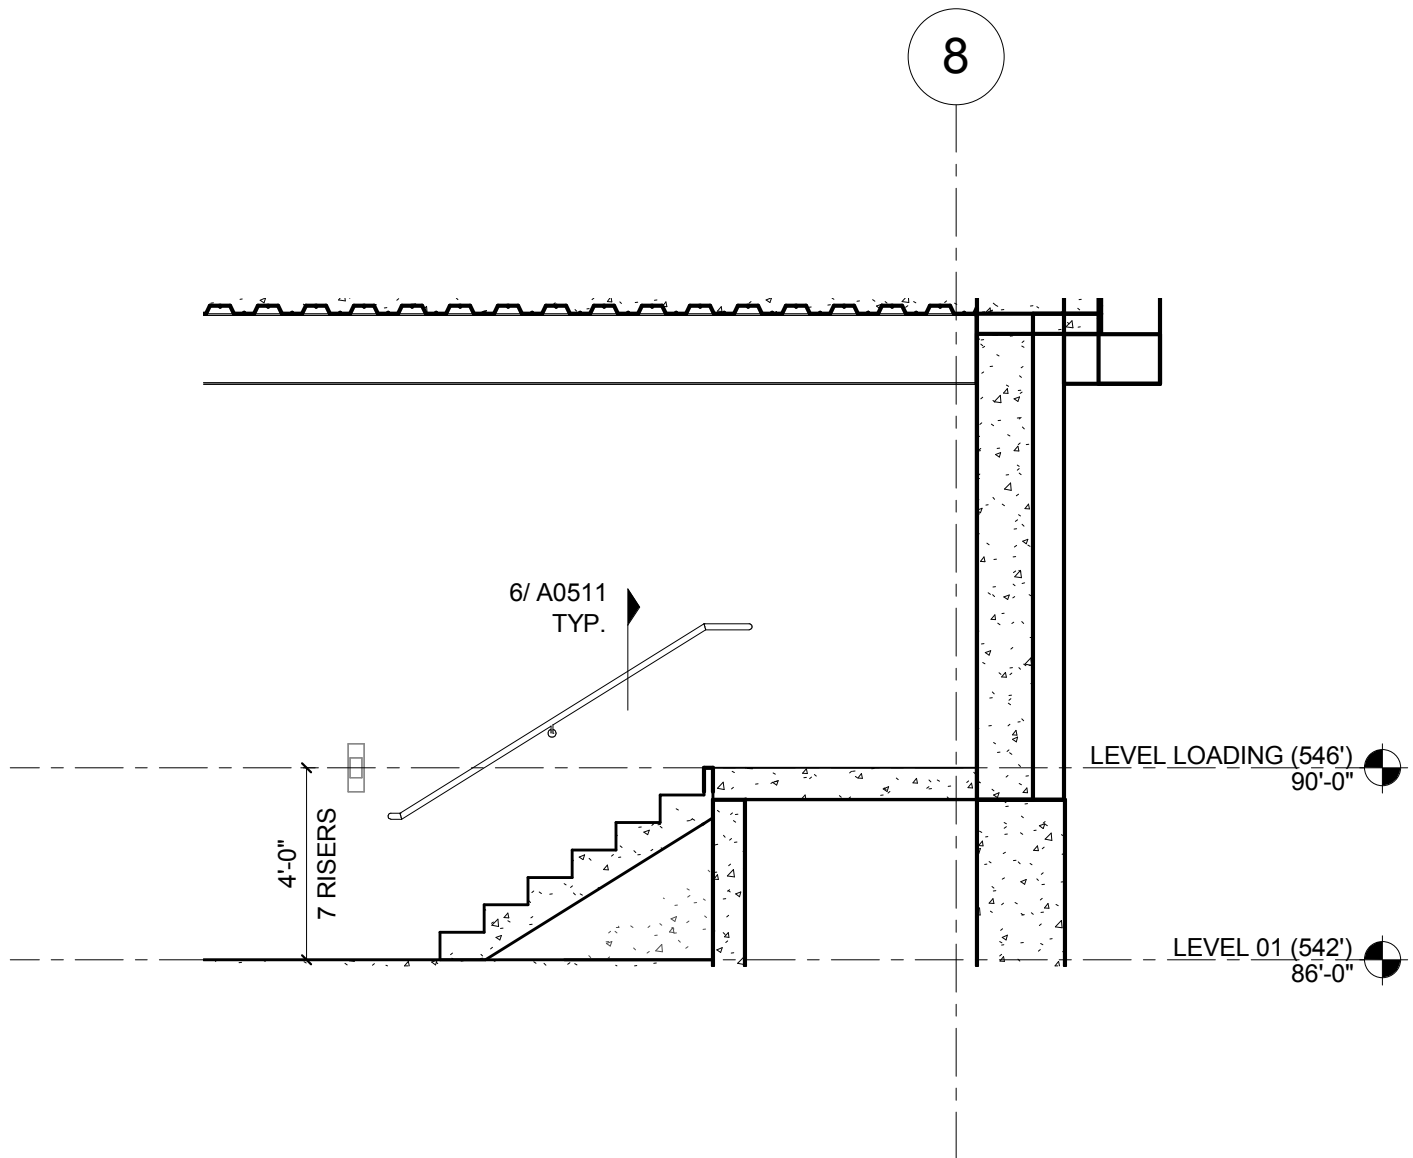


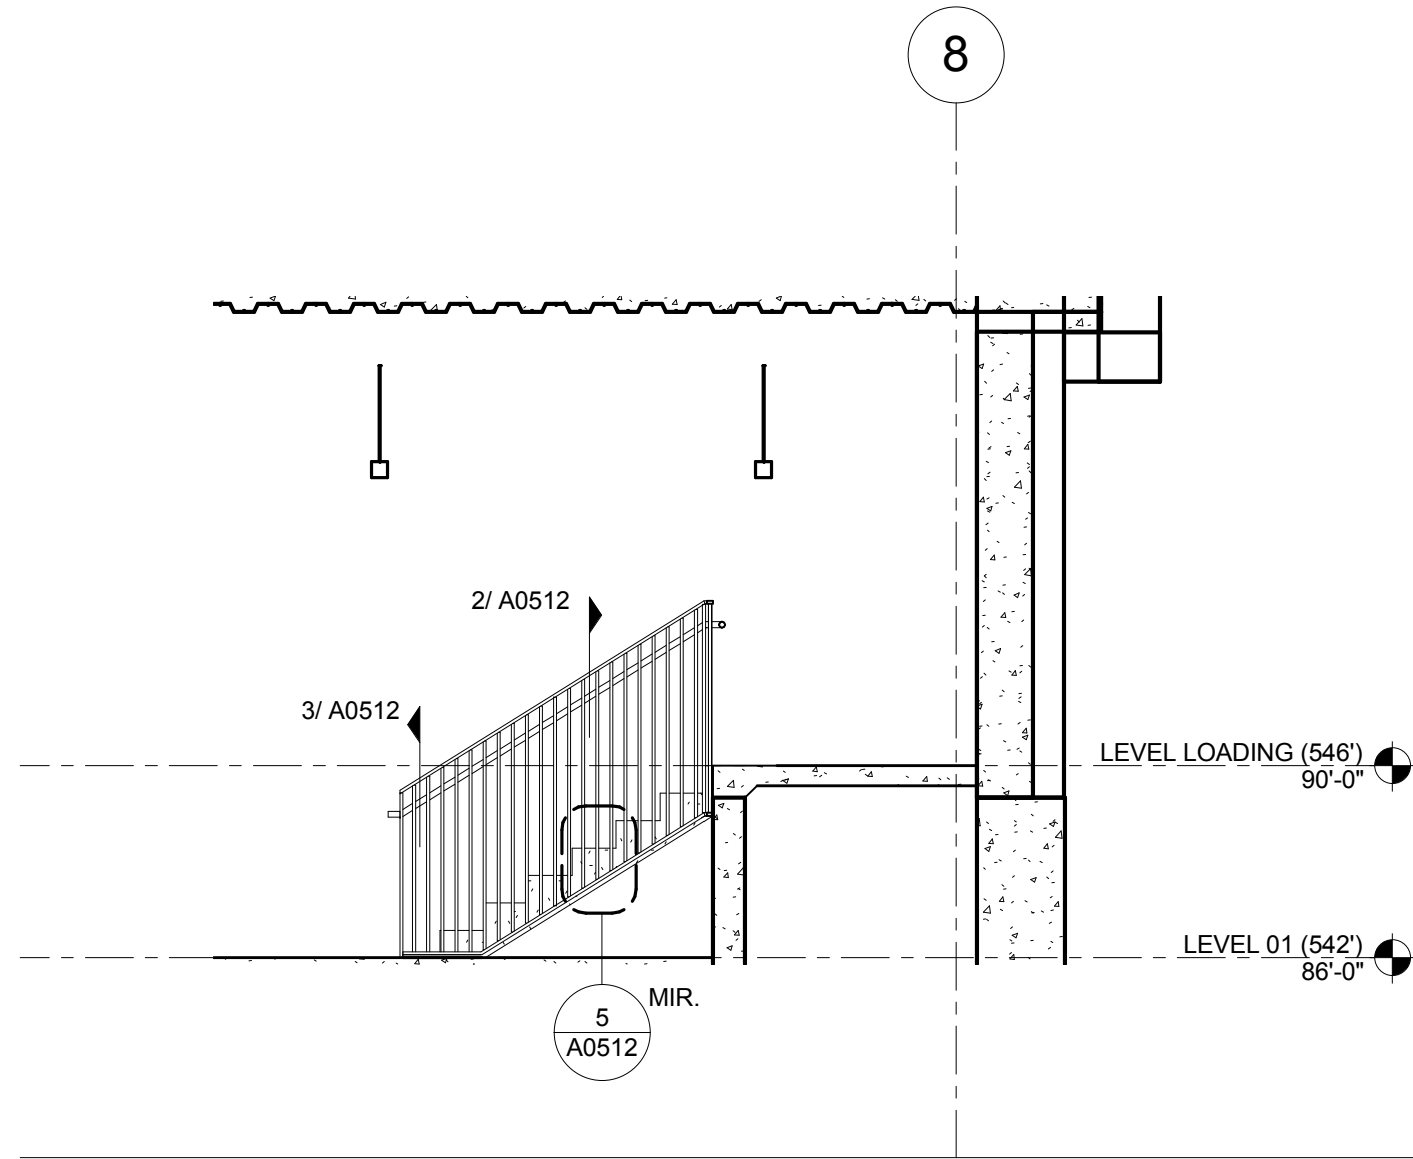


4 STAIR 4 PLAN - LEVEL 01
1/4" = 1'-0"

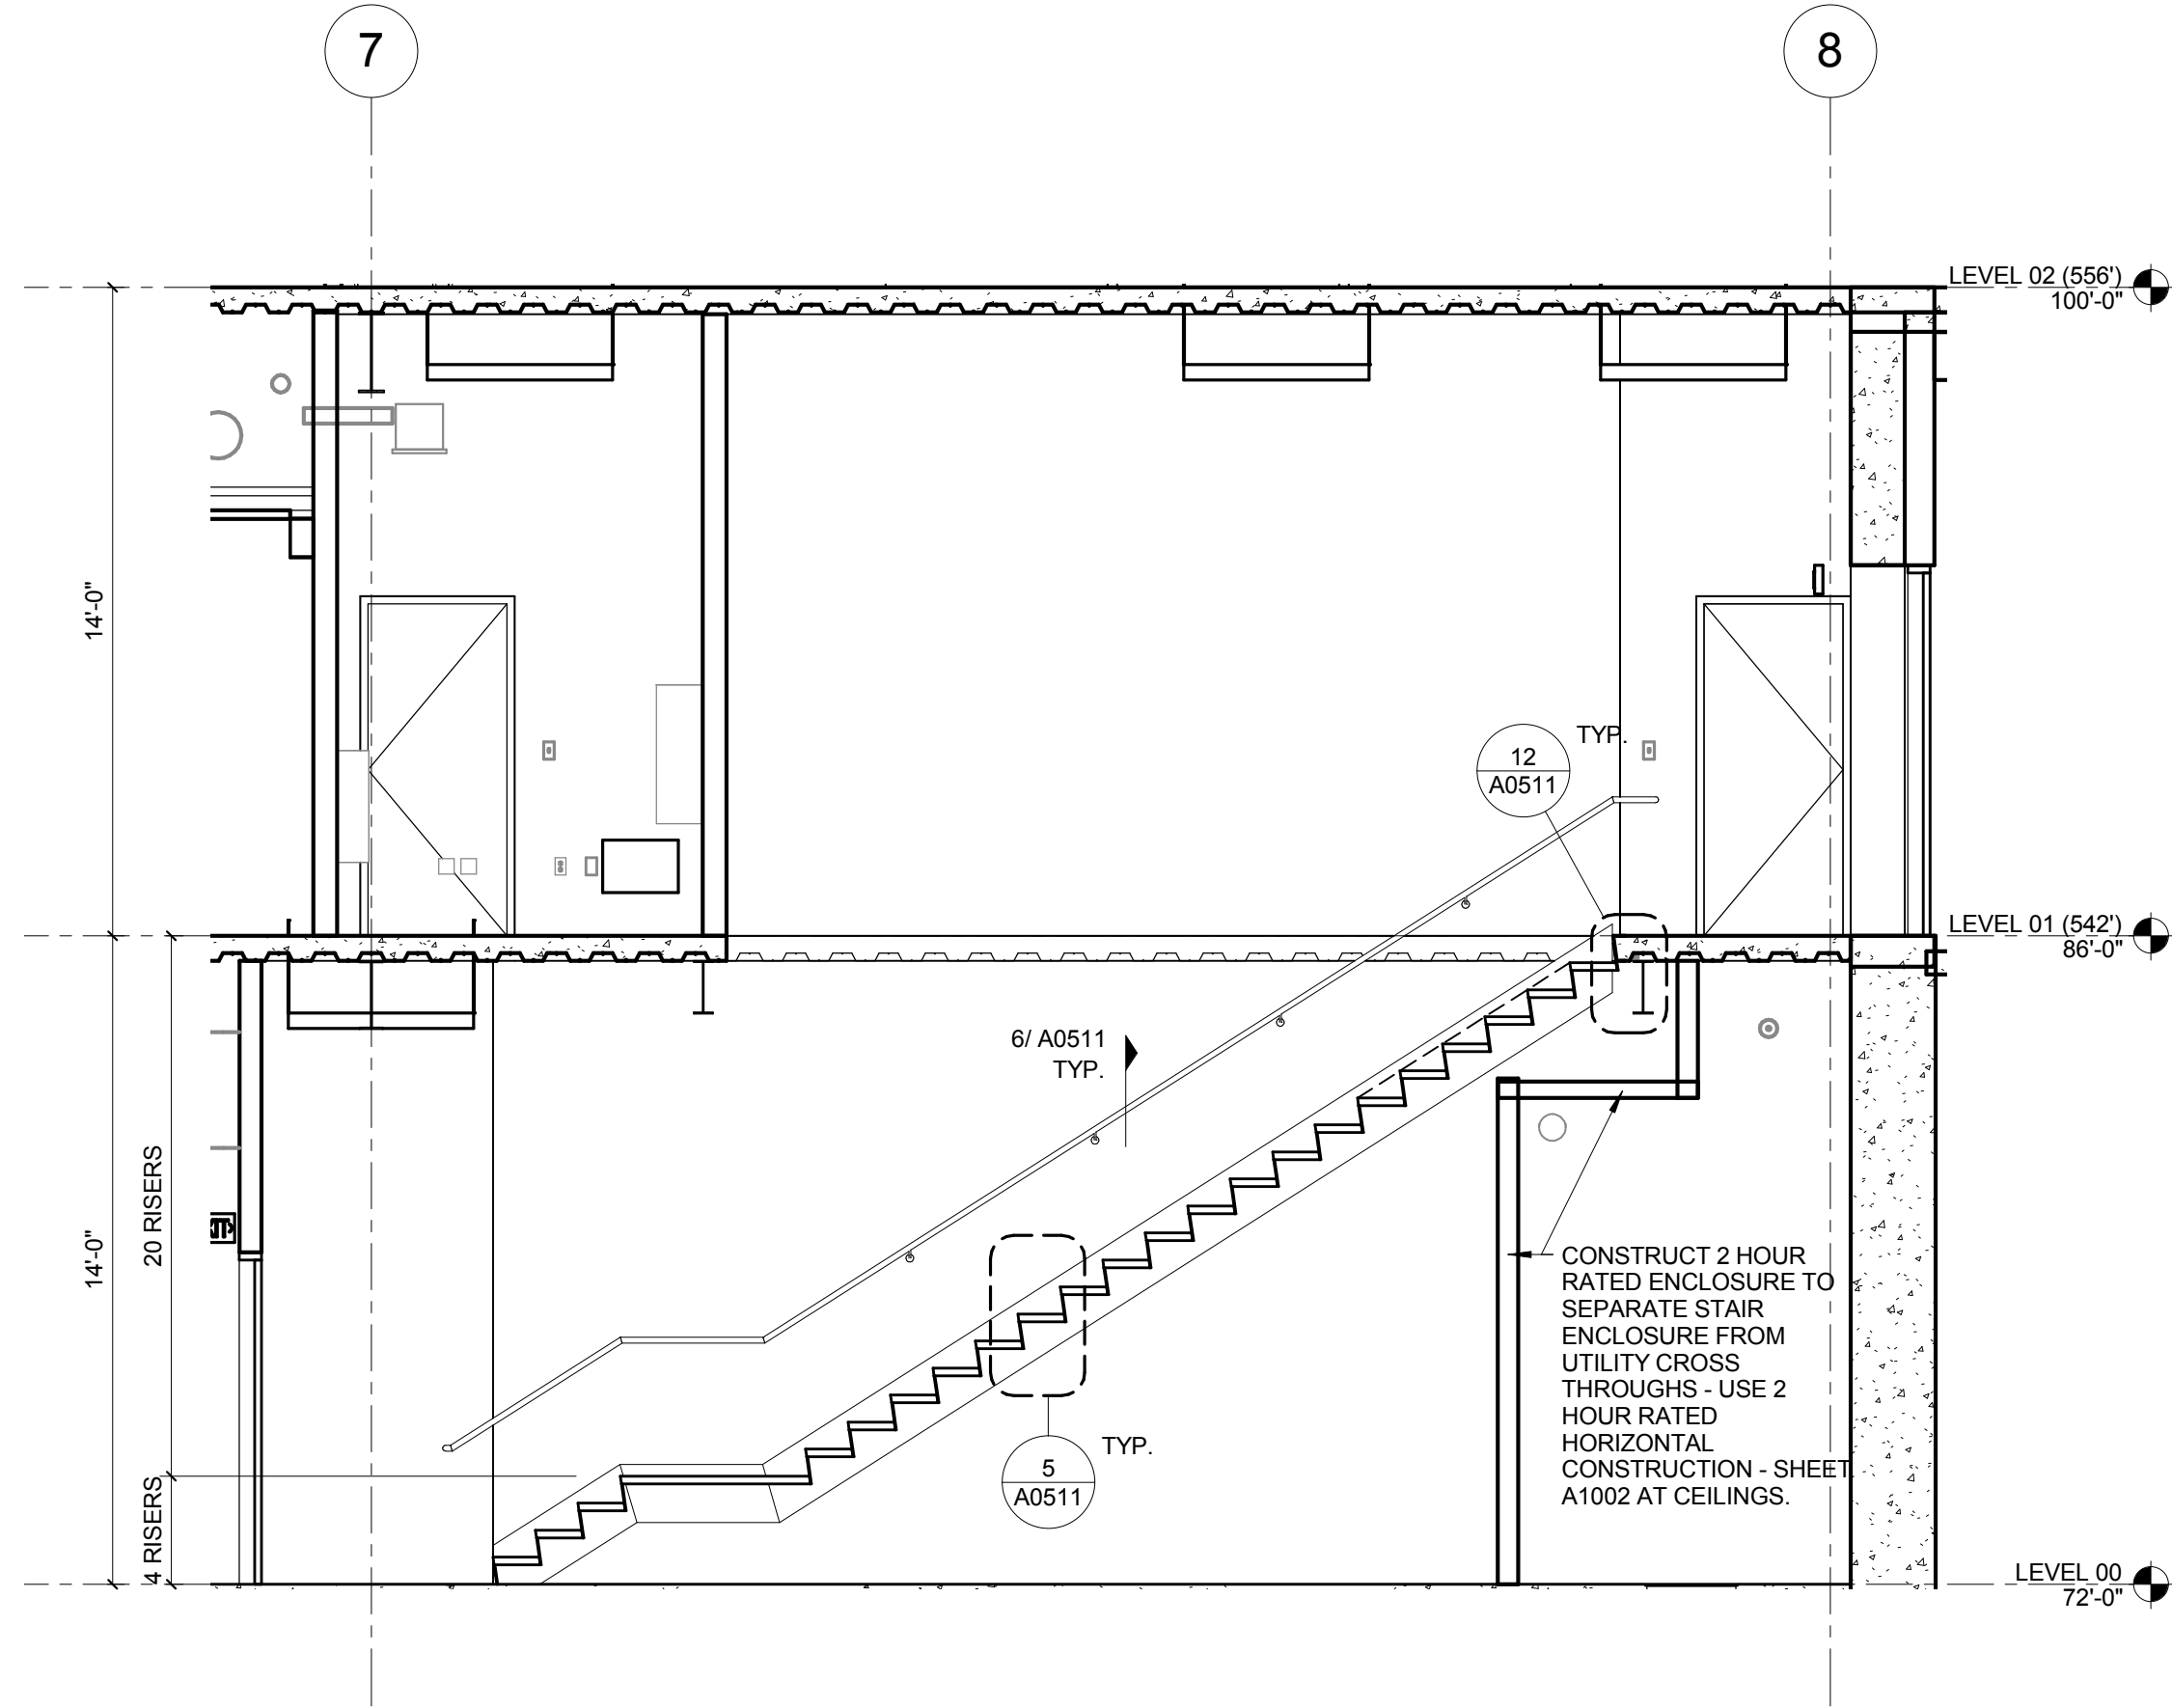

3 STAIR 3 SECTION
1/4" = 1'-0"

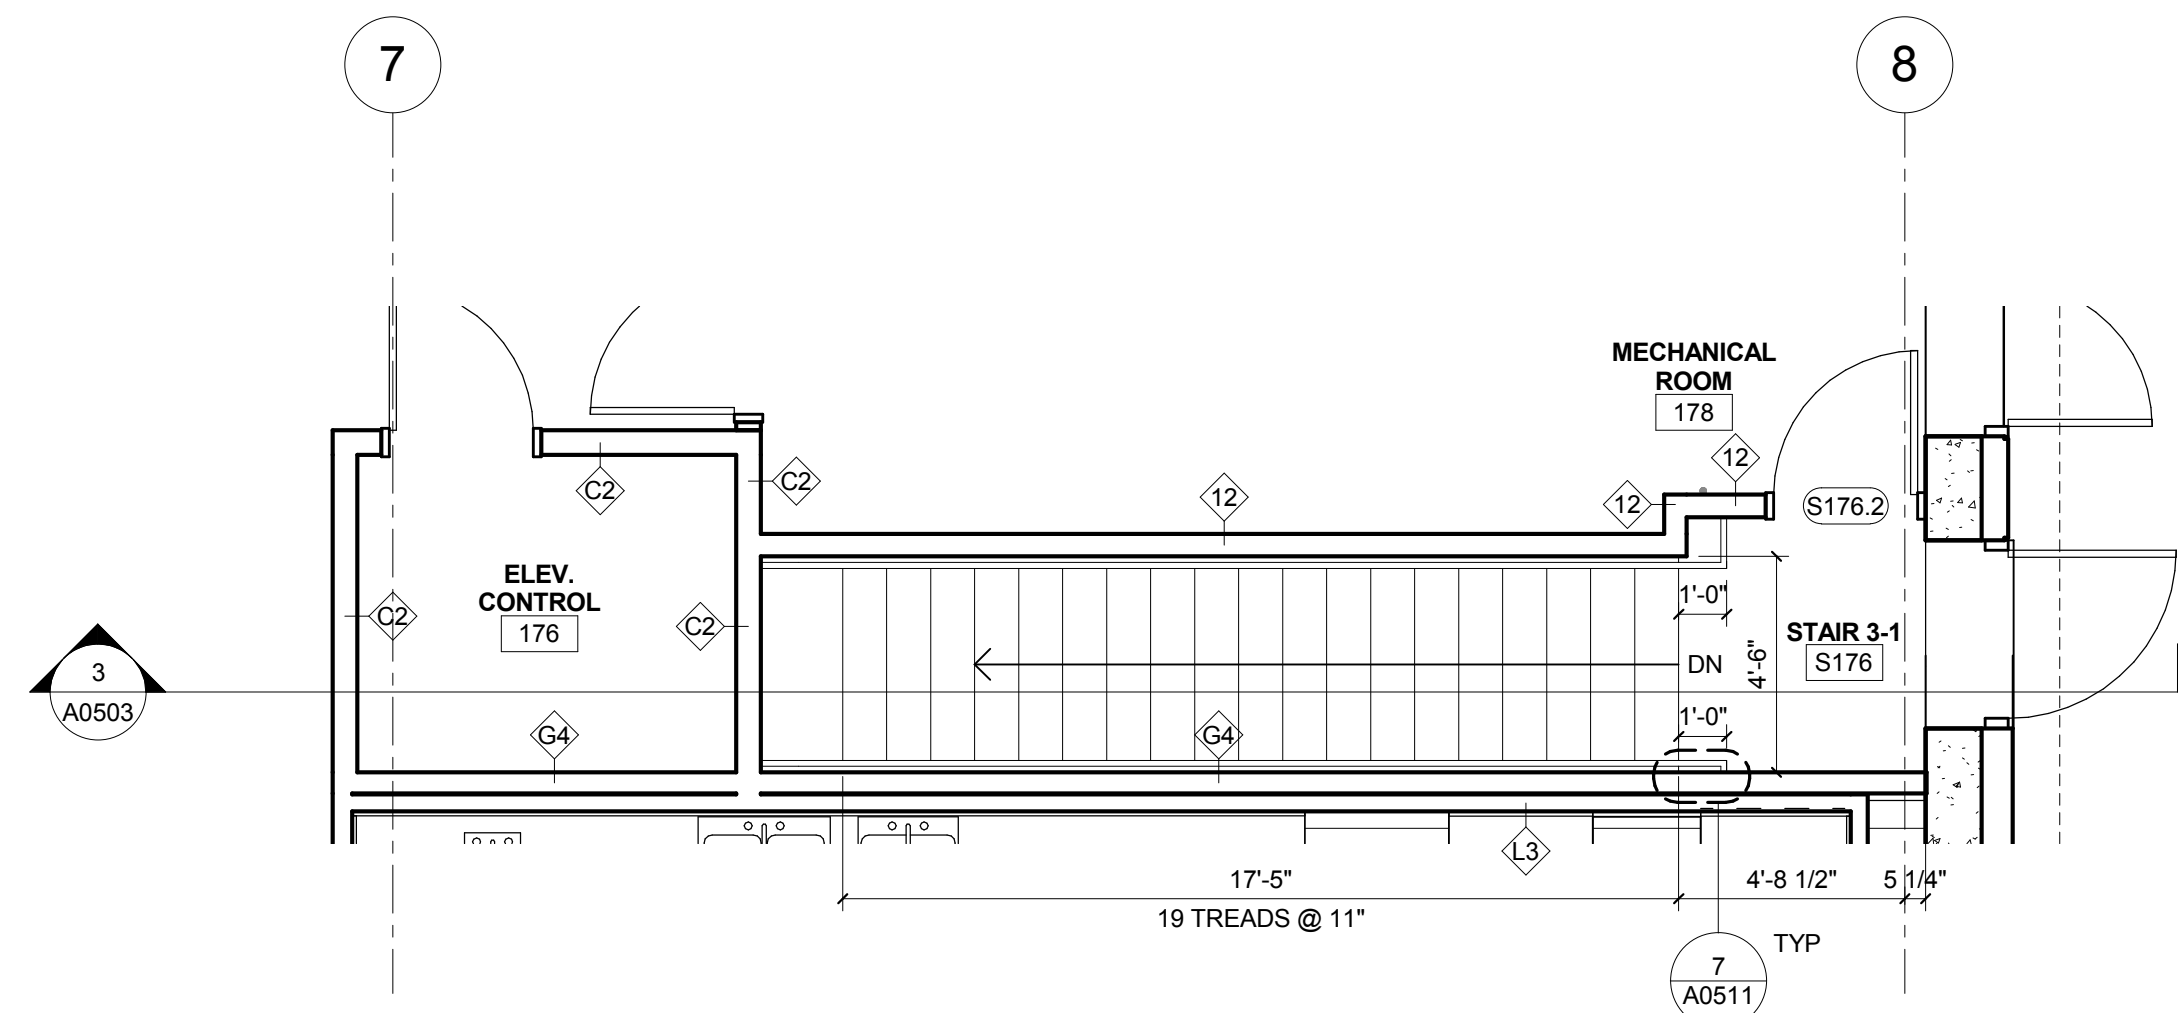

1 STAIR 3 PLAN - LEVEL 01
1/4" = 1'-0"

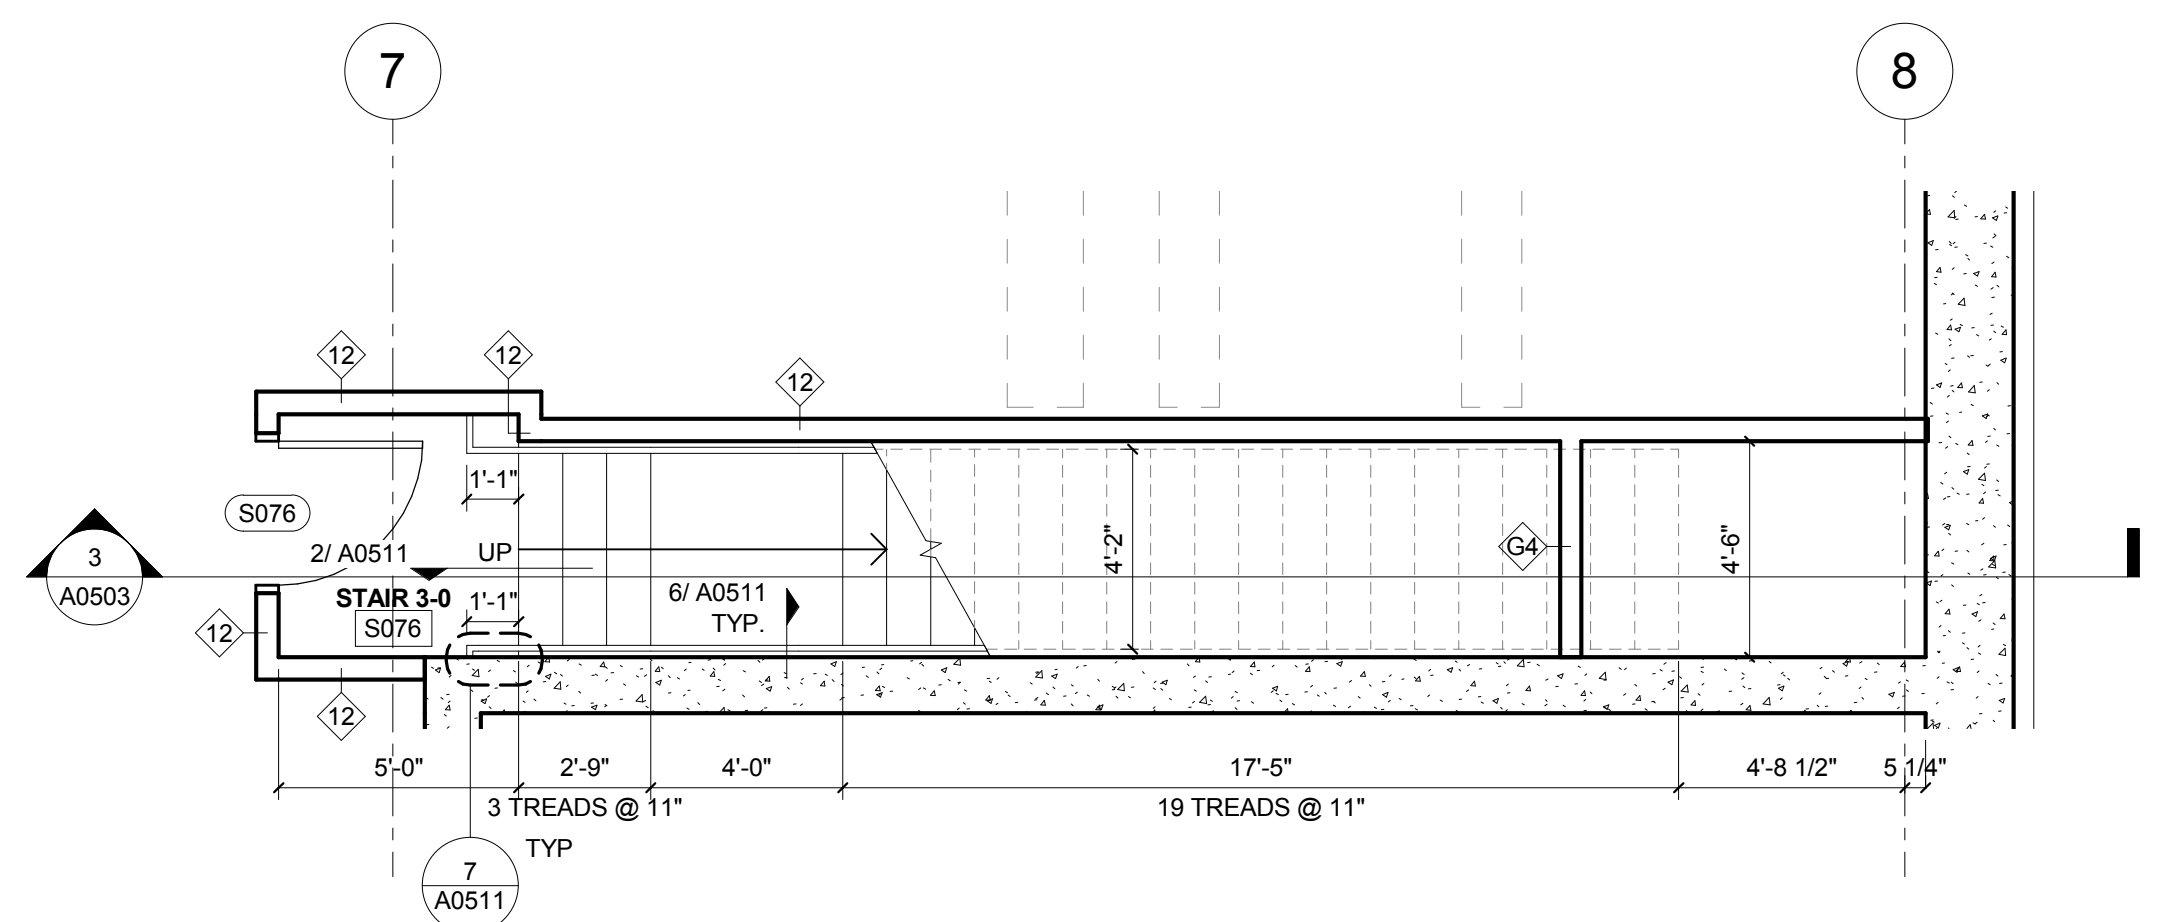

2 STAIR 3 PLAN - LEVEL 00
1/4" = 1'-0"