

1	ASI-003	01 AUG 2016
	ISSUED FOR CONSTRUCTION (BP1)	15 JAN 2016
No.	Description	Date


Drawing Title:

COURTYARD WALLS &
STAIRS - SOUTH


Project No.: 04561.01

Checked by:


A0507.A

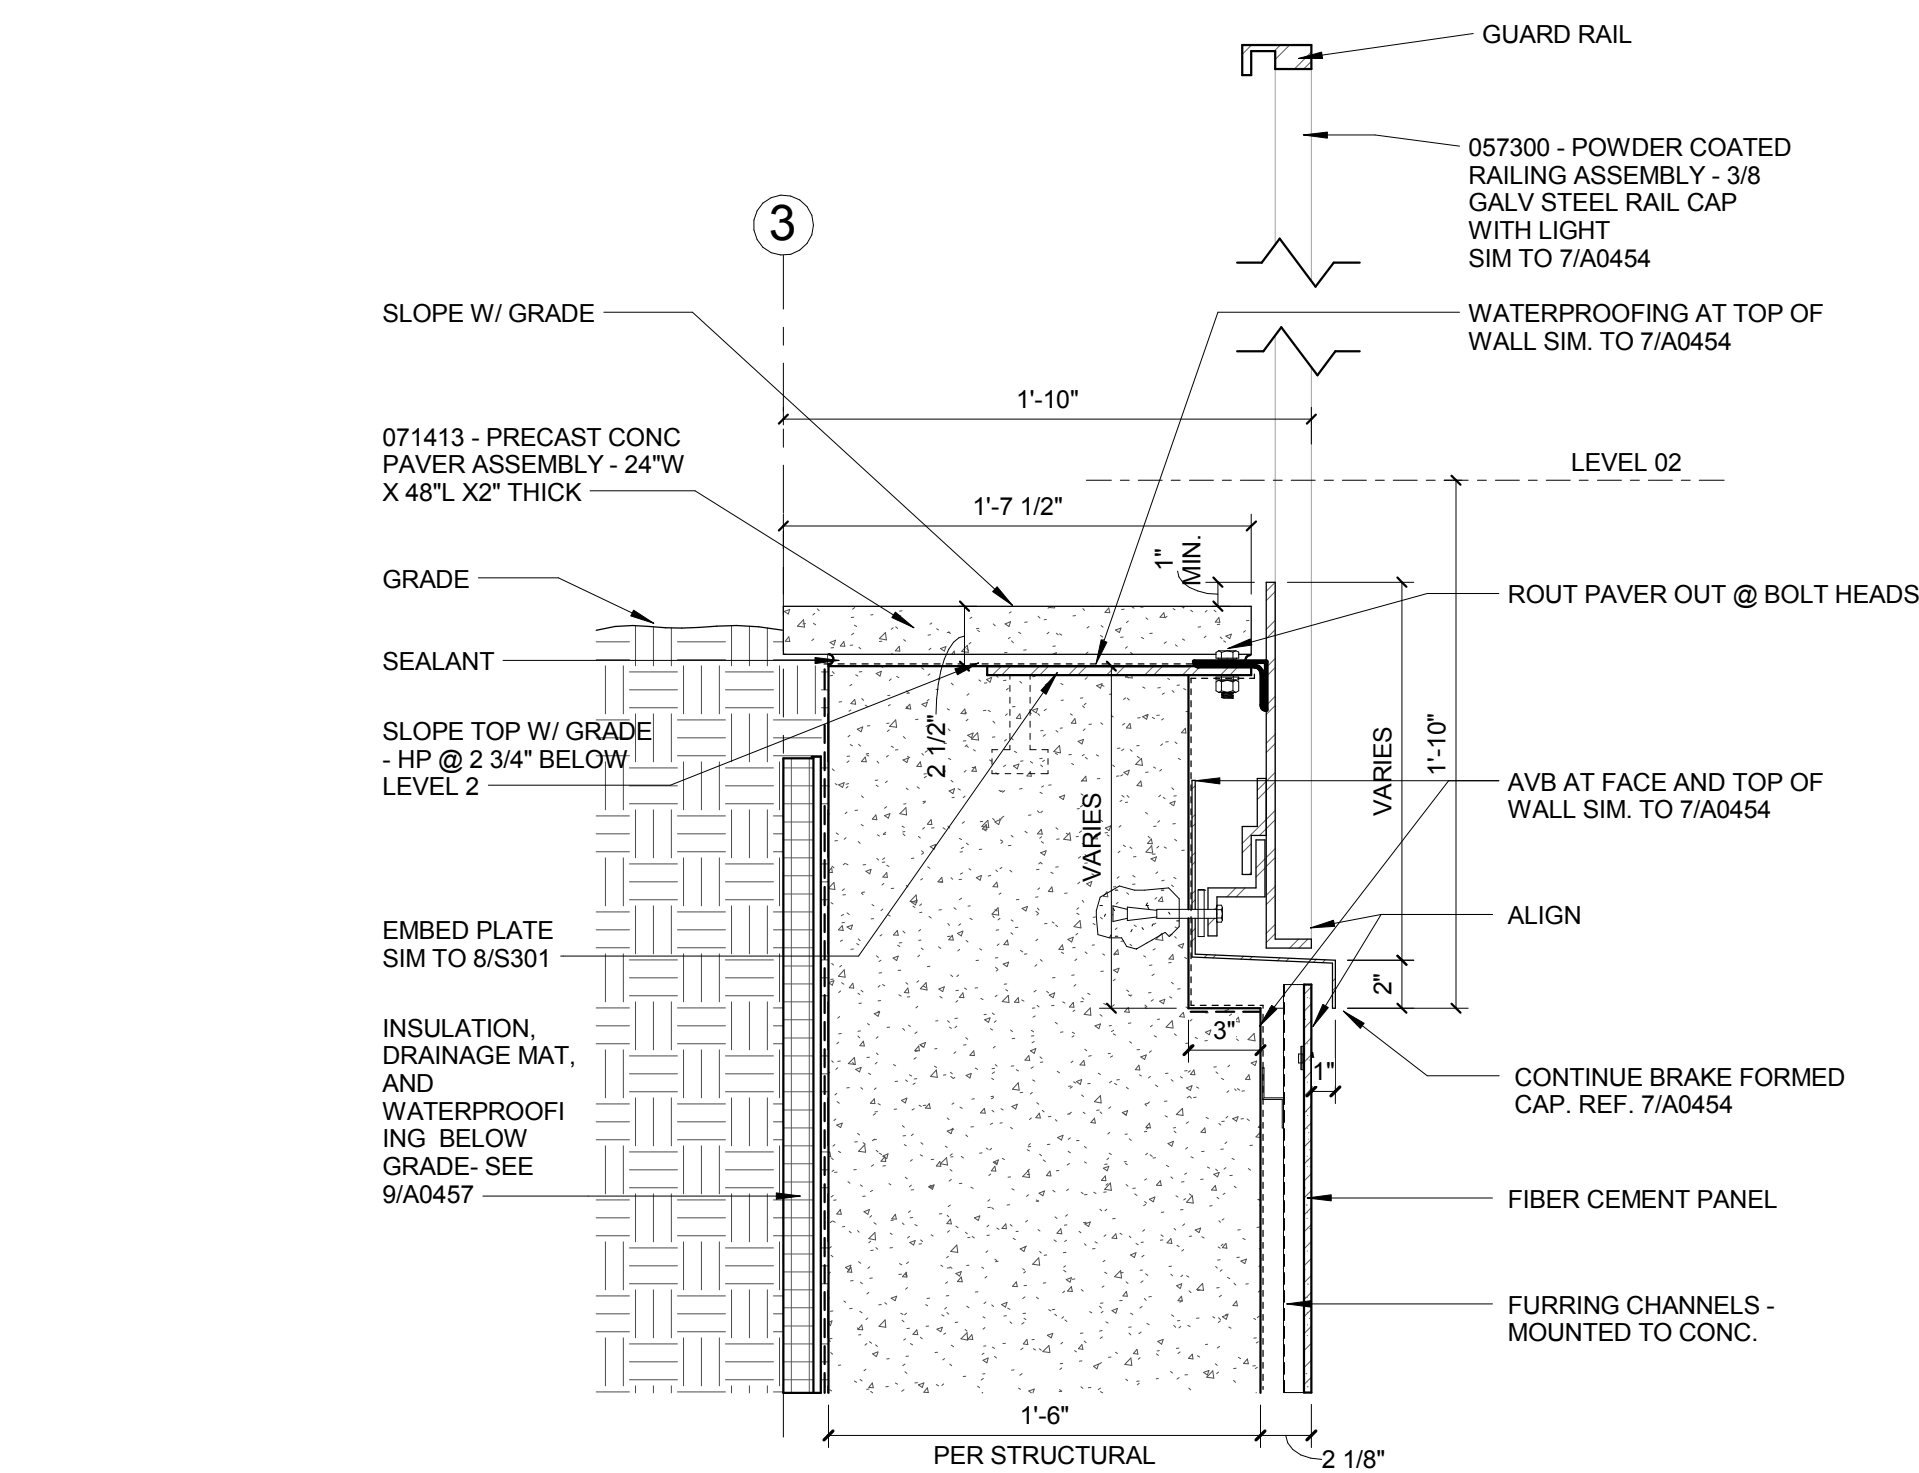

3 SOUTH COURTYARD STAIR - GUARDRAIL DETAIL
1 1/2" = 1'-0"

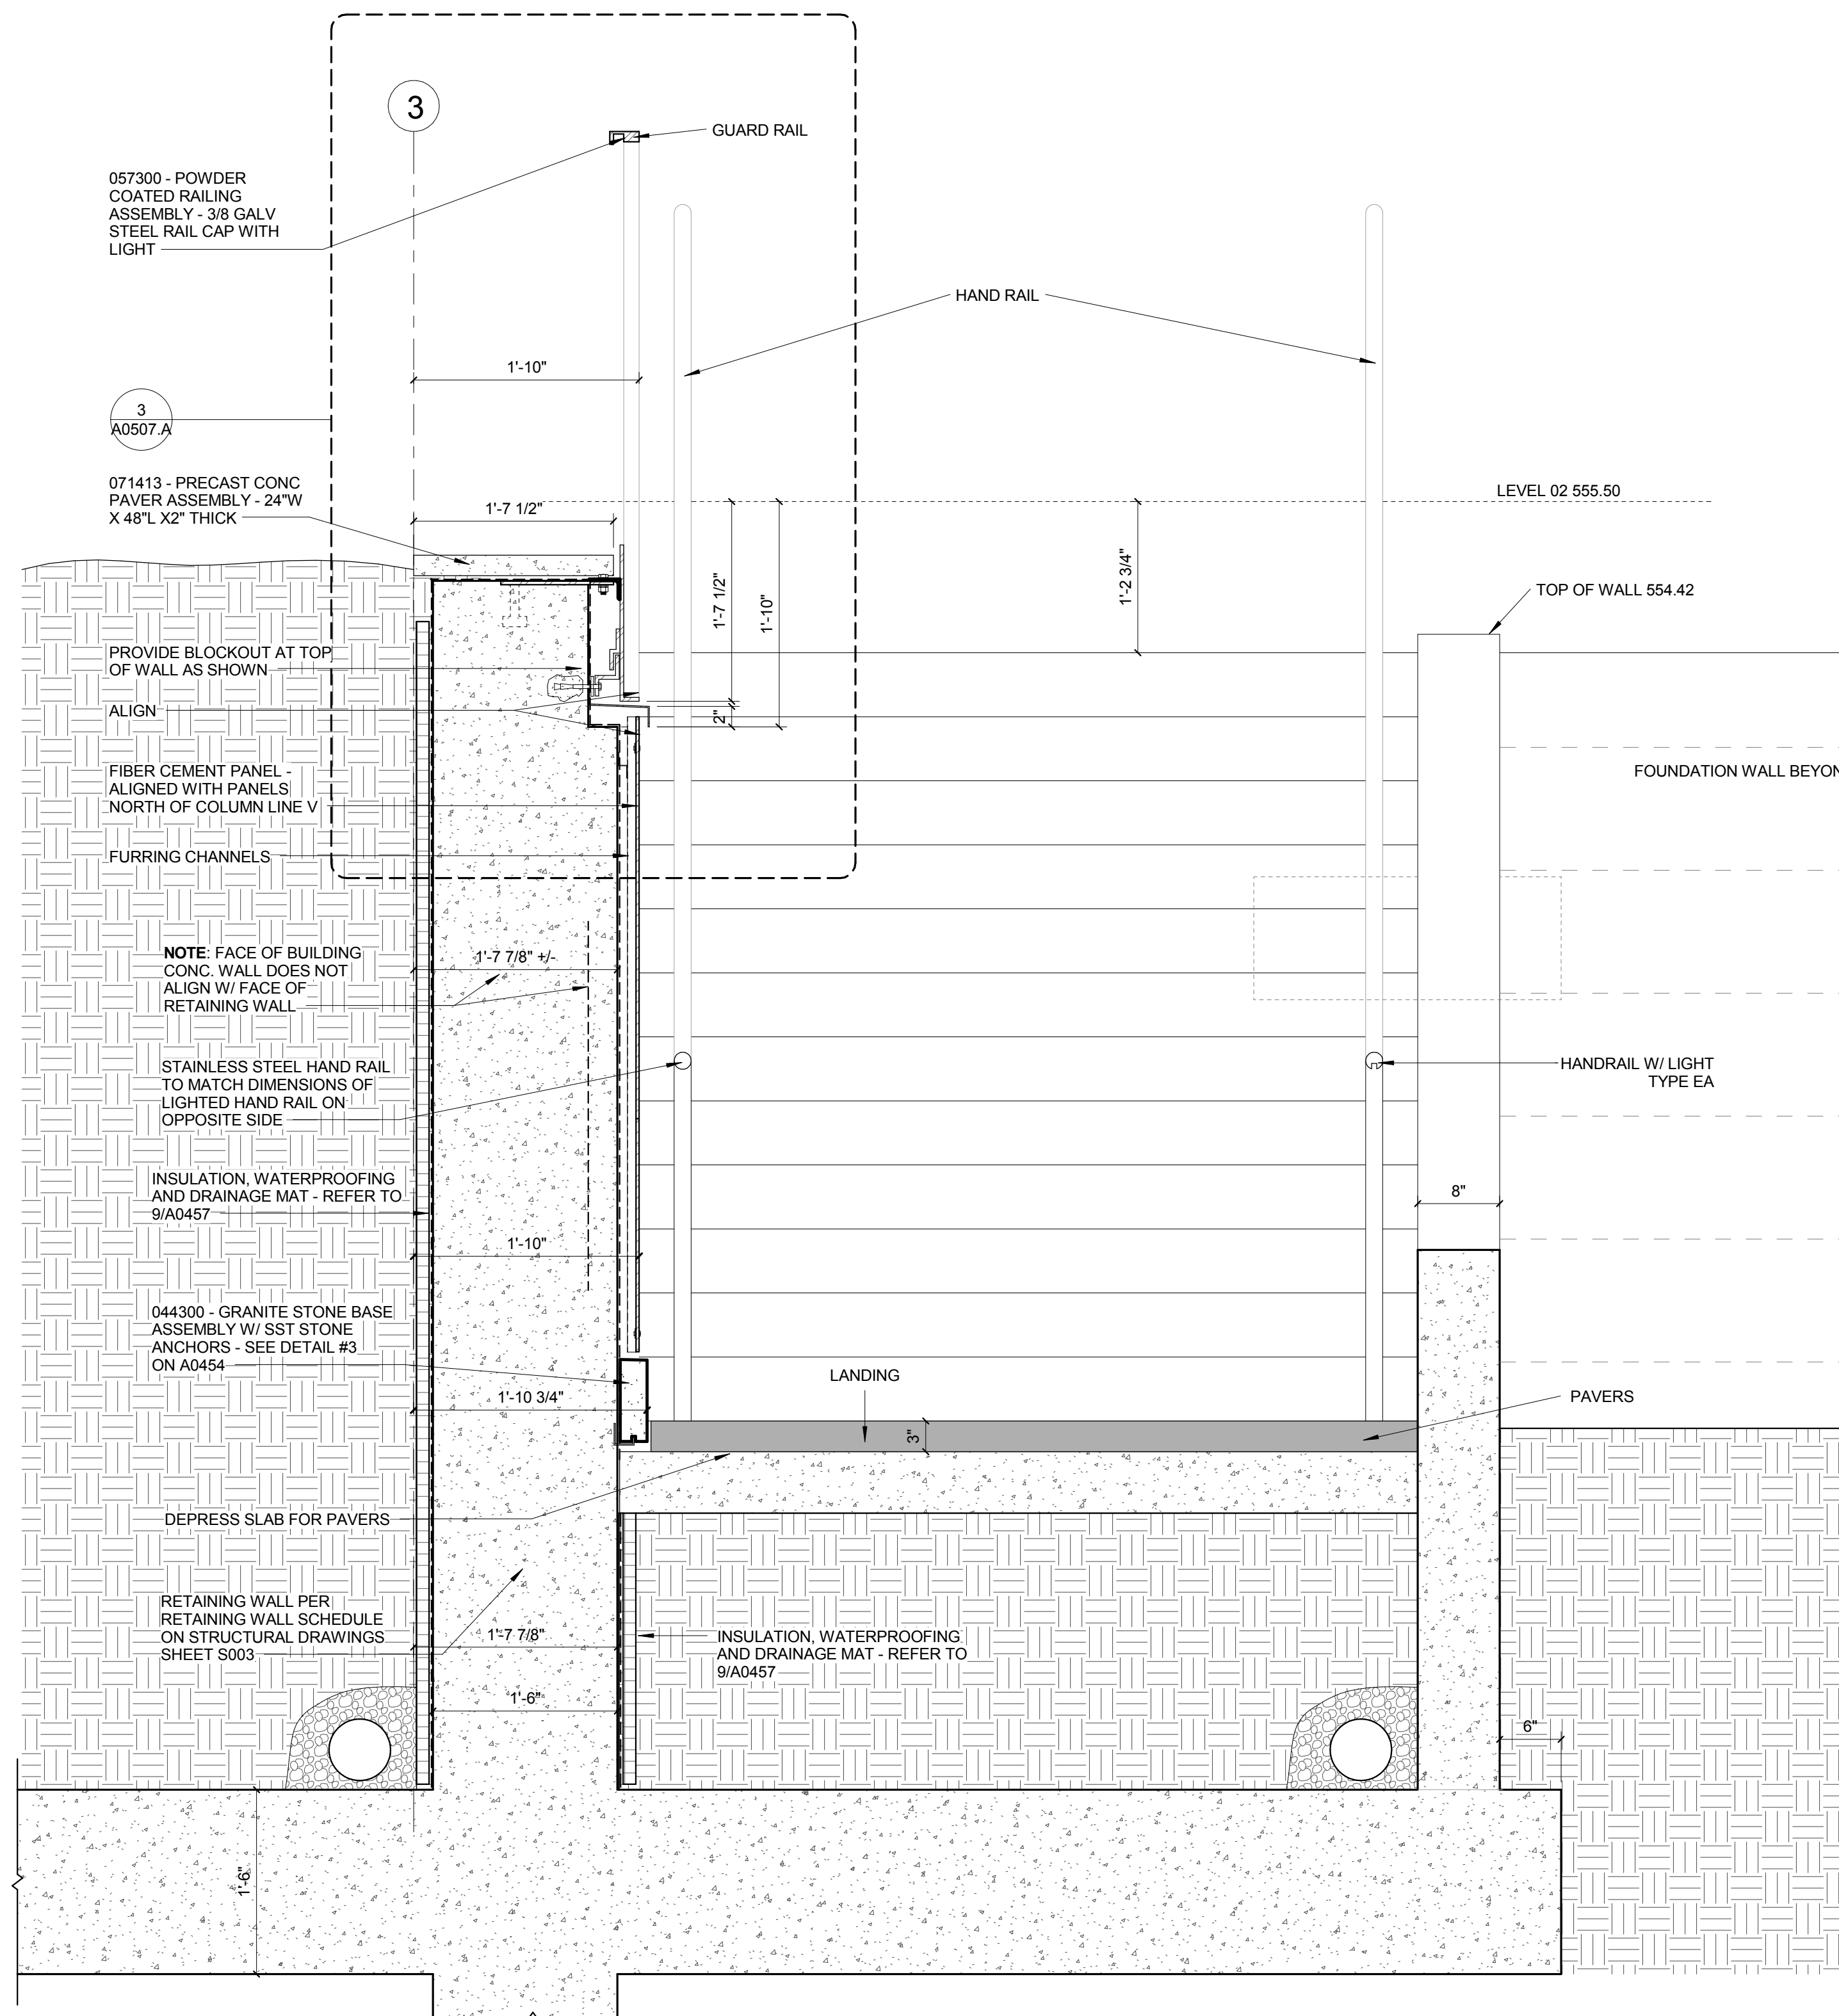

2 SOUTH COURTYARD STAIR - LANDING SECTION
1" = 1'-0"

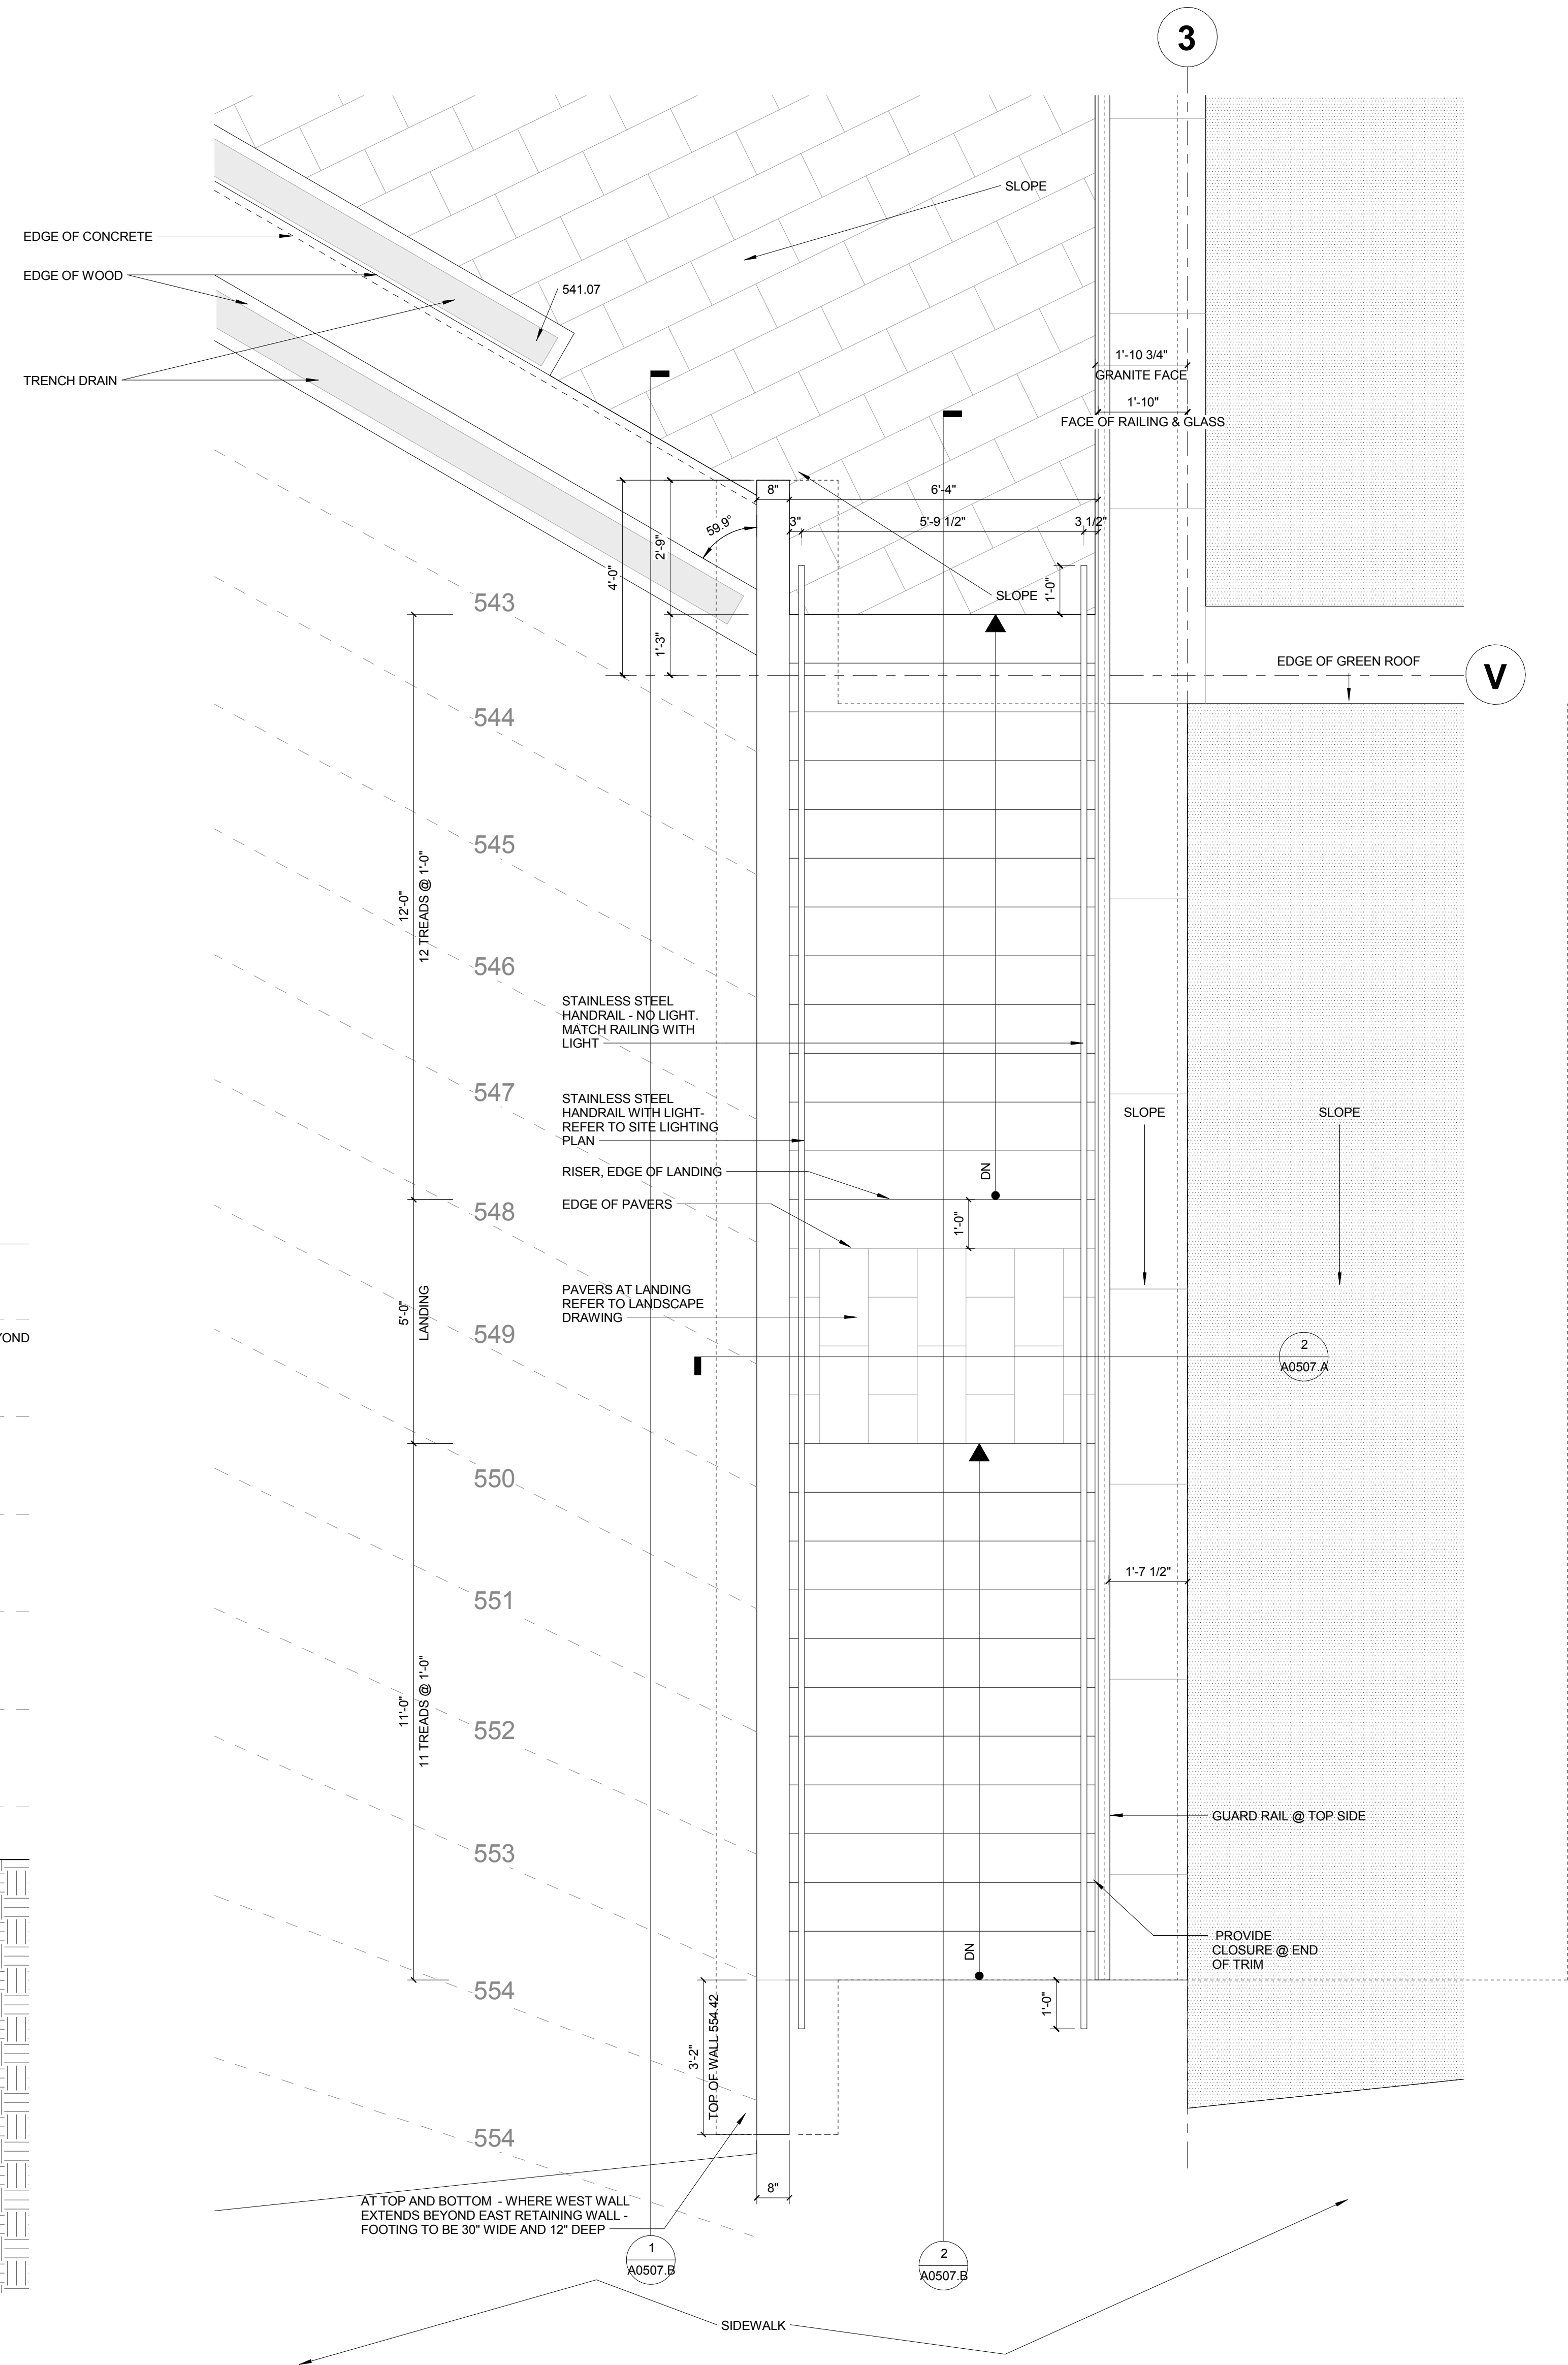

1 SOUTH COURTYARD STAIR - PLAN
1/2" = 1'-0"