




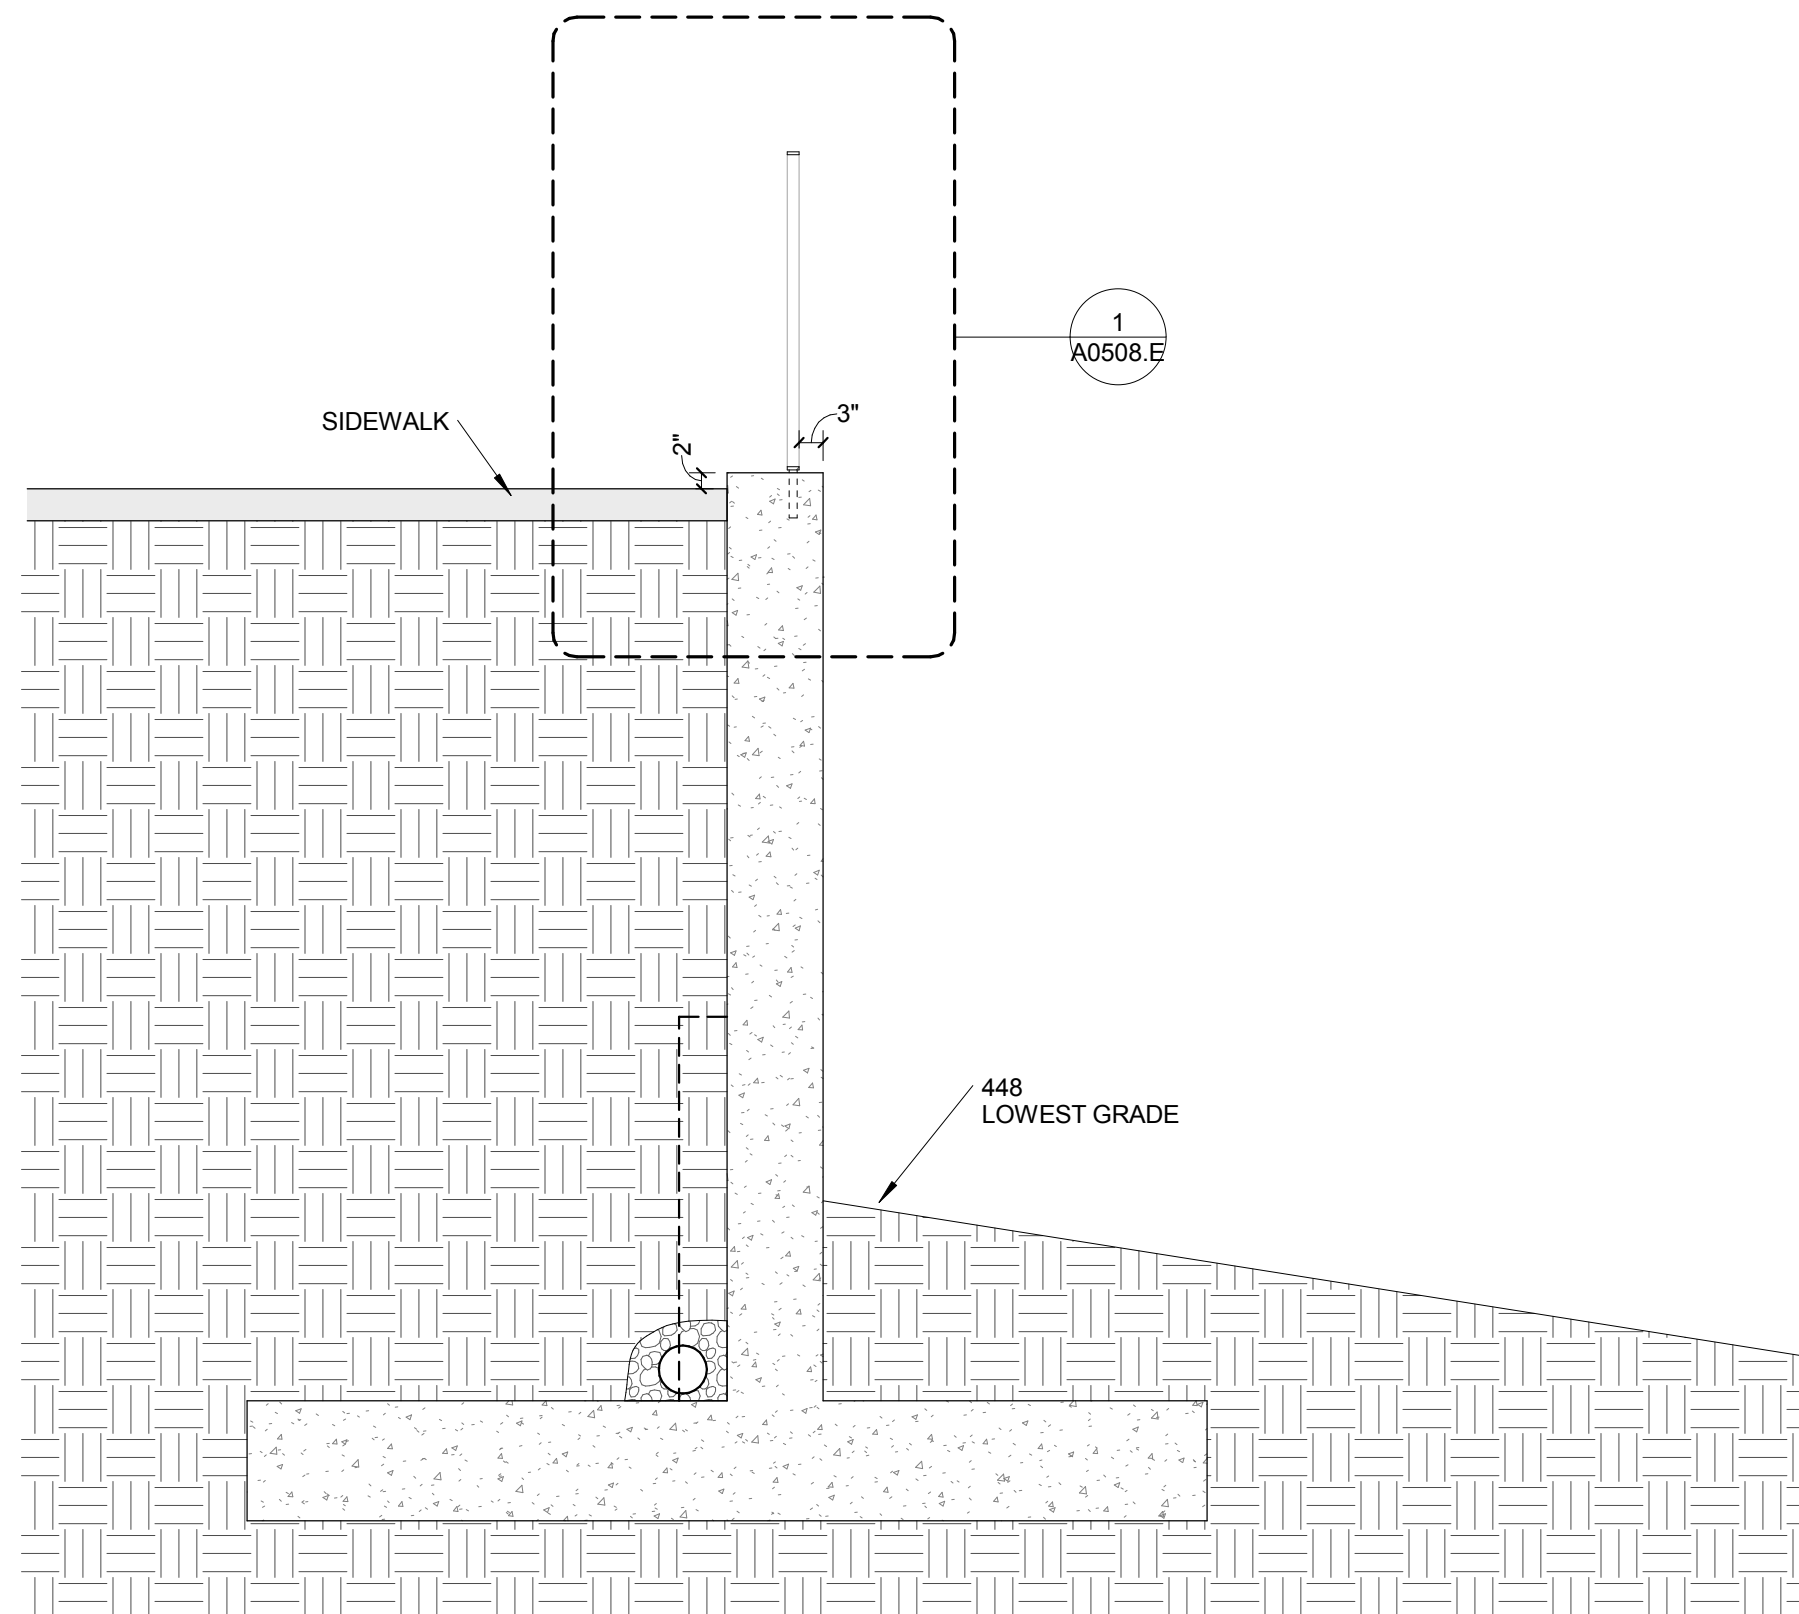

3 West Wall Section
1/2" = 1'-0"

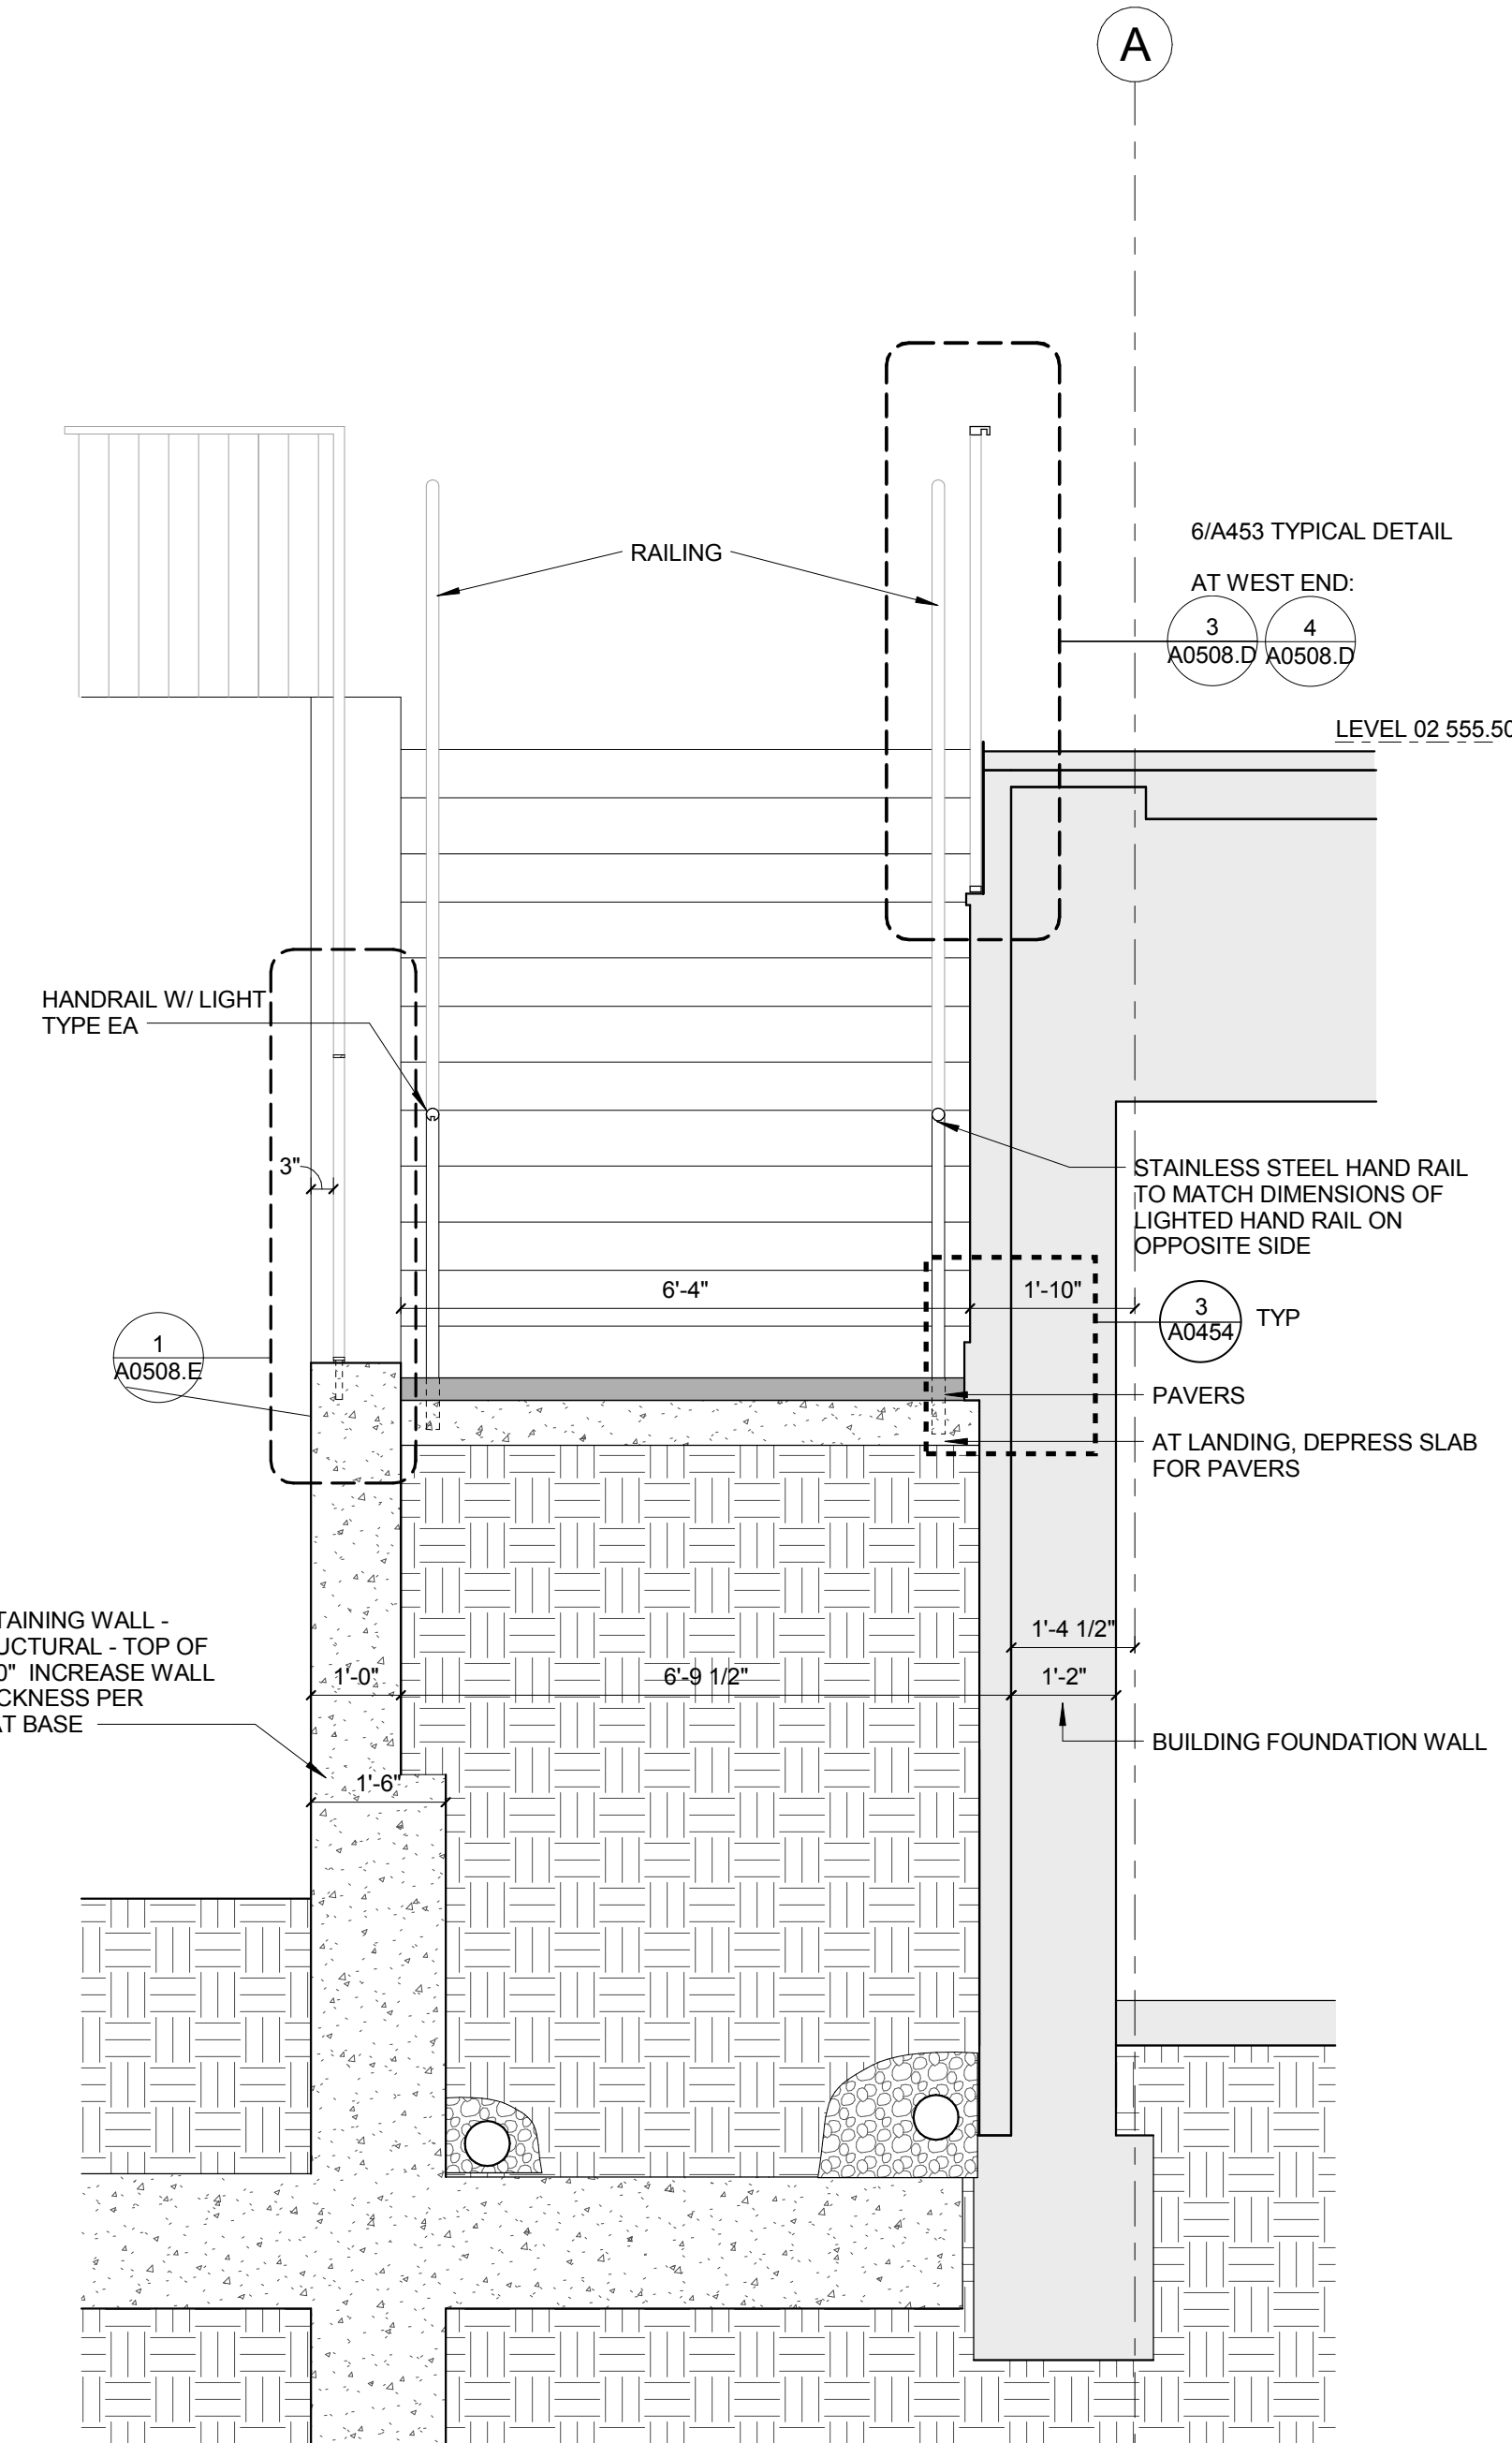

2 WEST STAIR LANDING SECTION
1/2" = 1'-0"

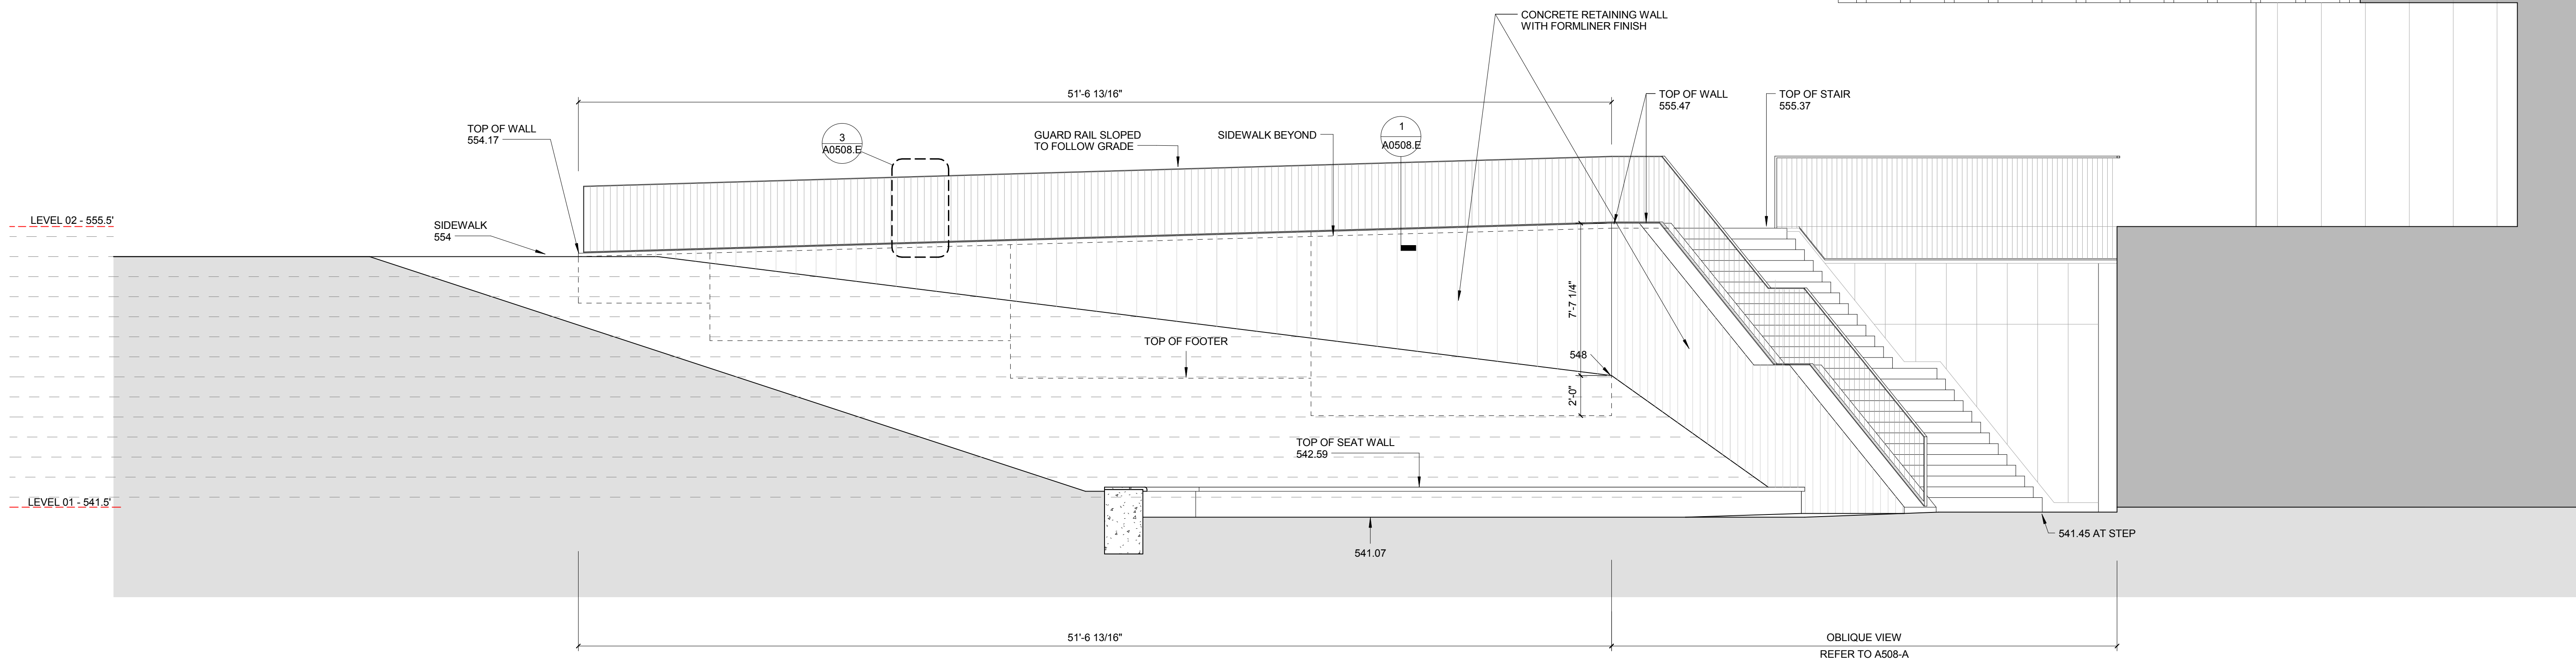

1 West Retaining Wall
1/4" = 1'-0"