




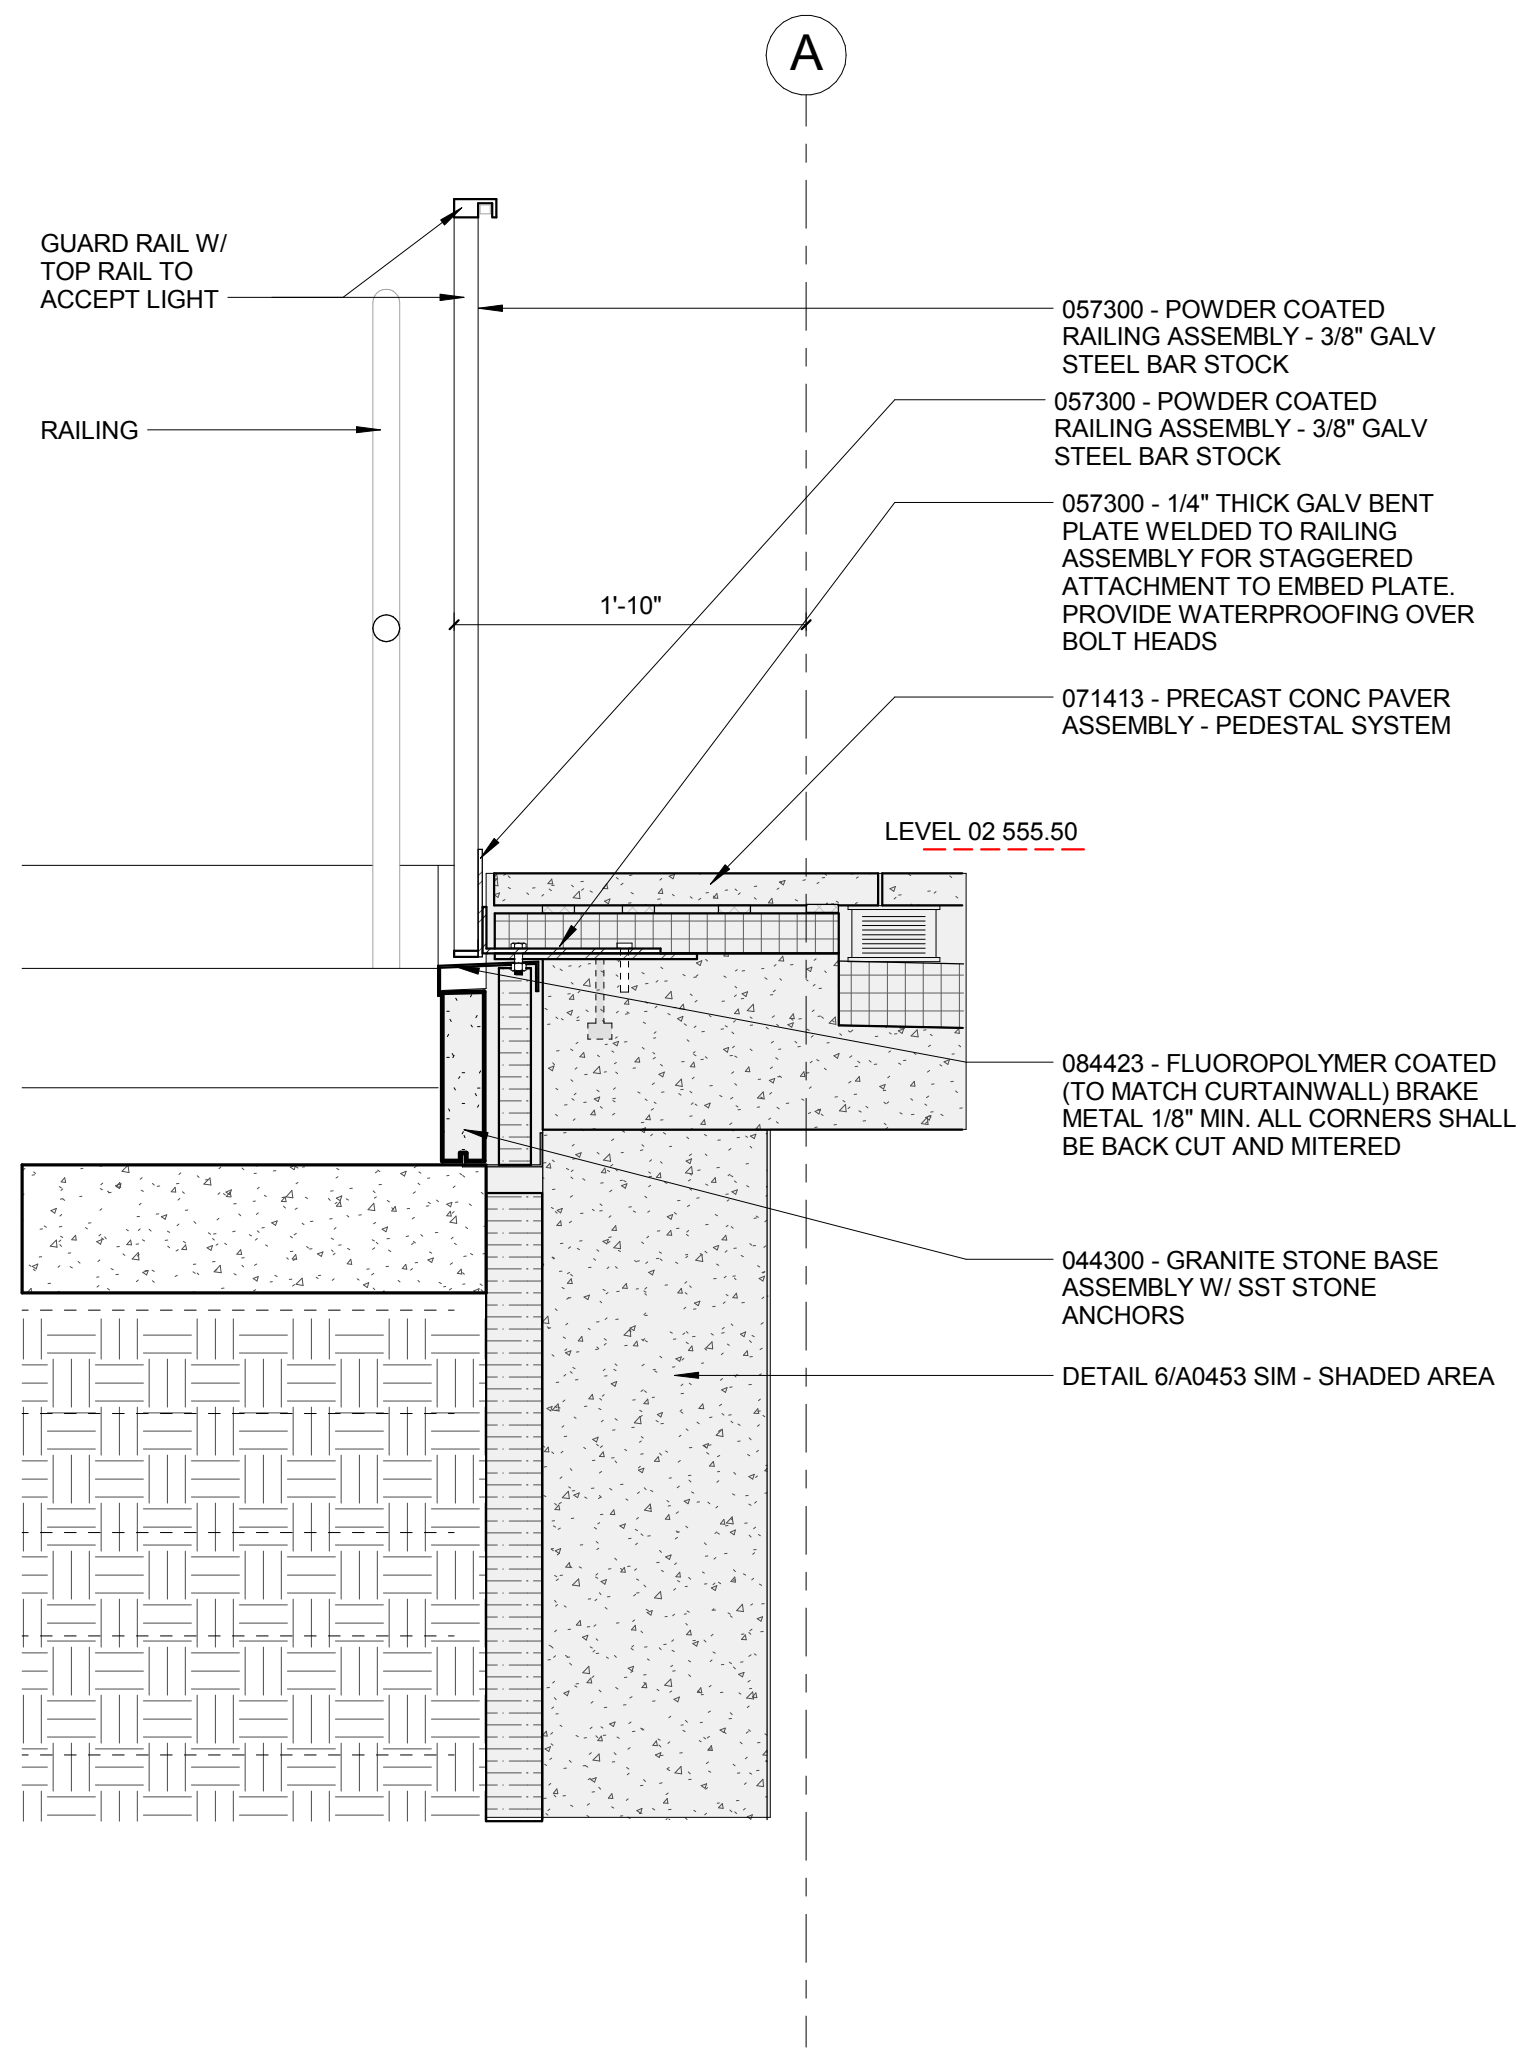


3 NORTH HAND RAIL SECTION 1
1" = 1'-0"

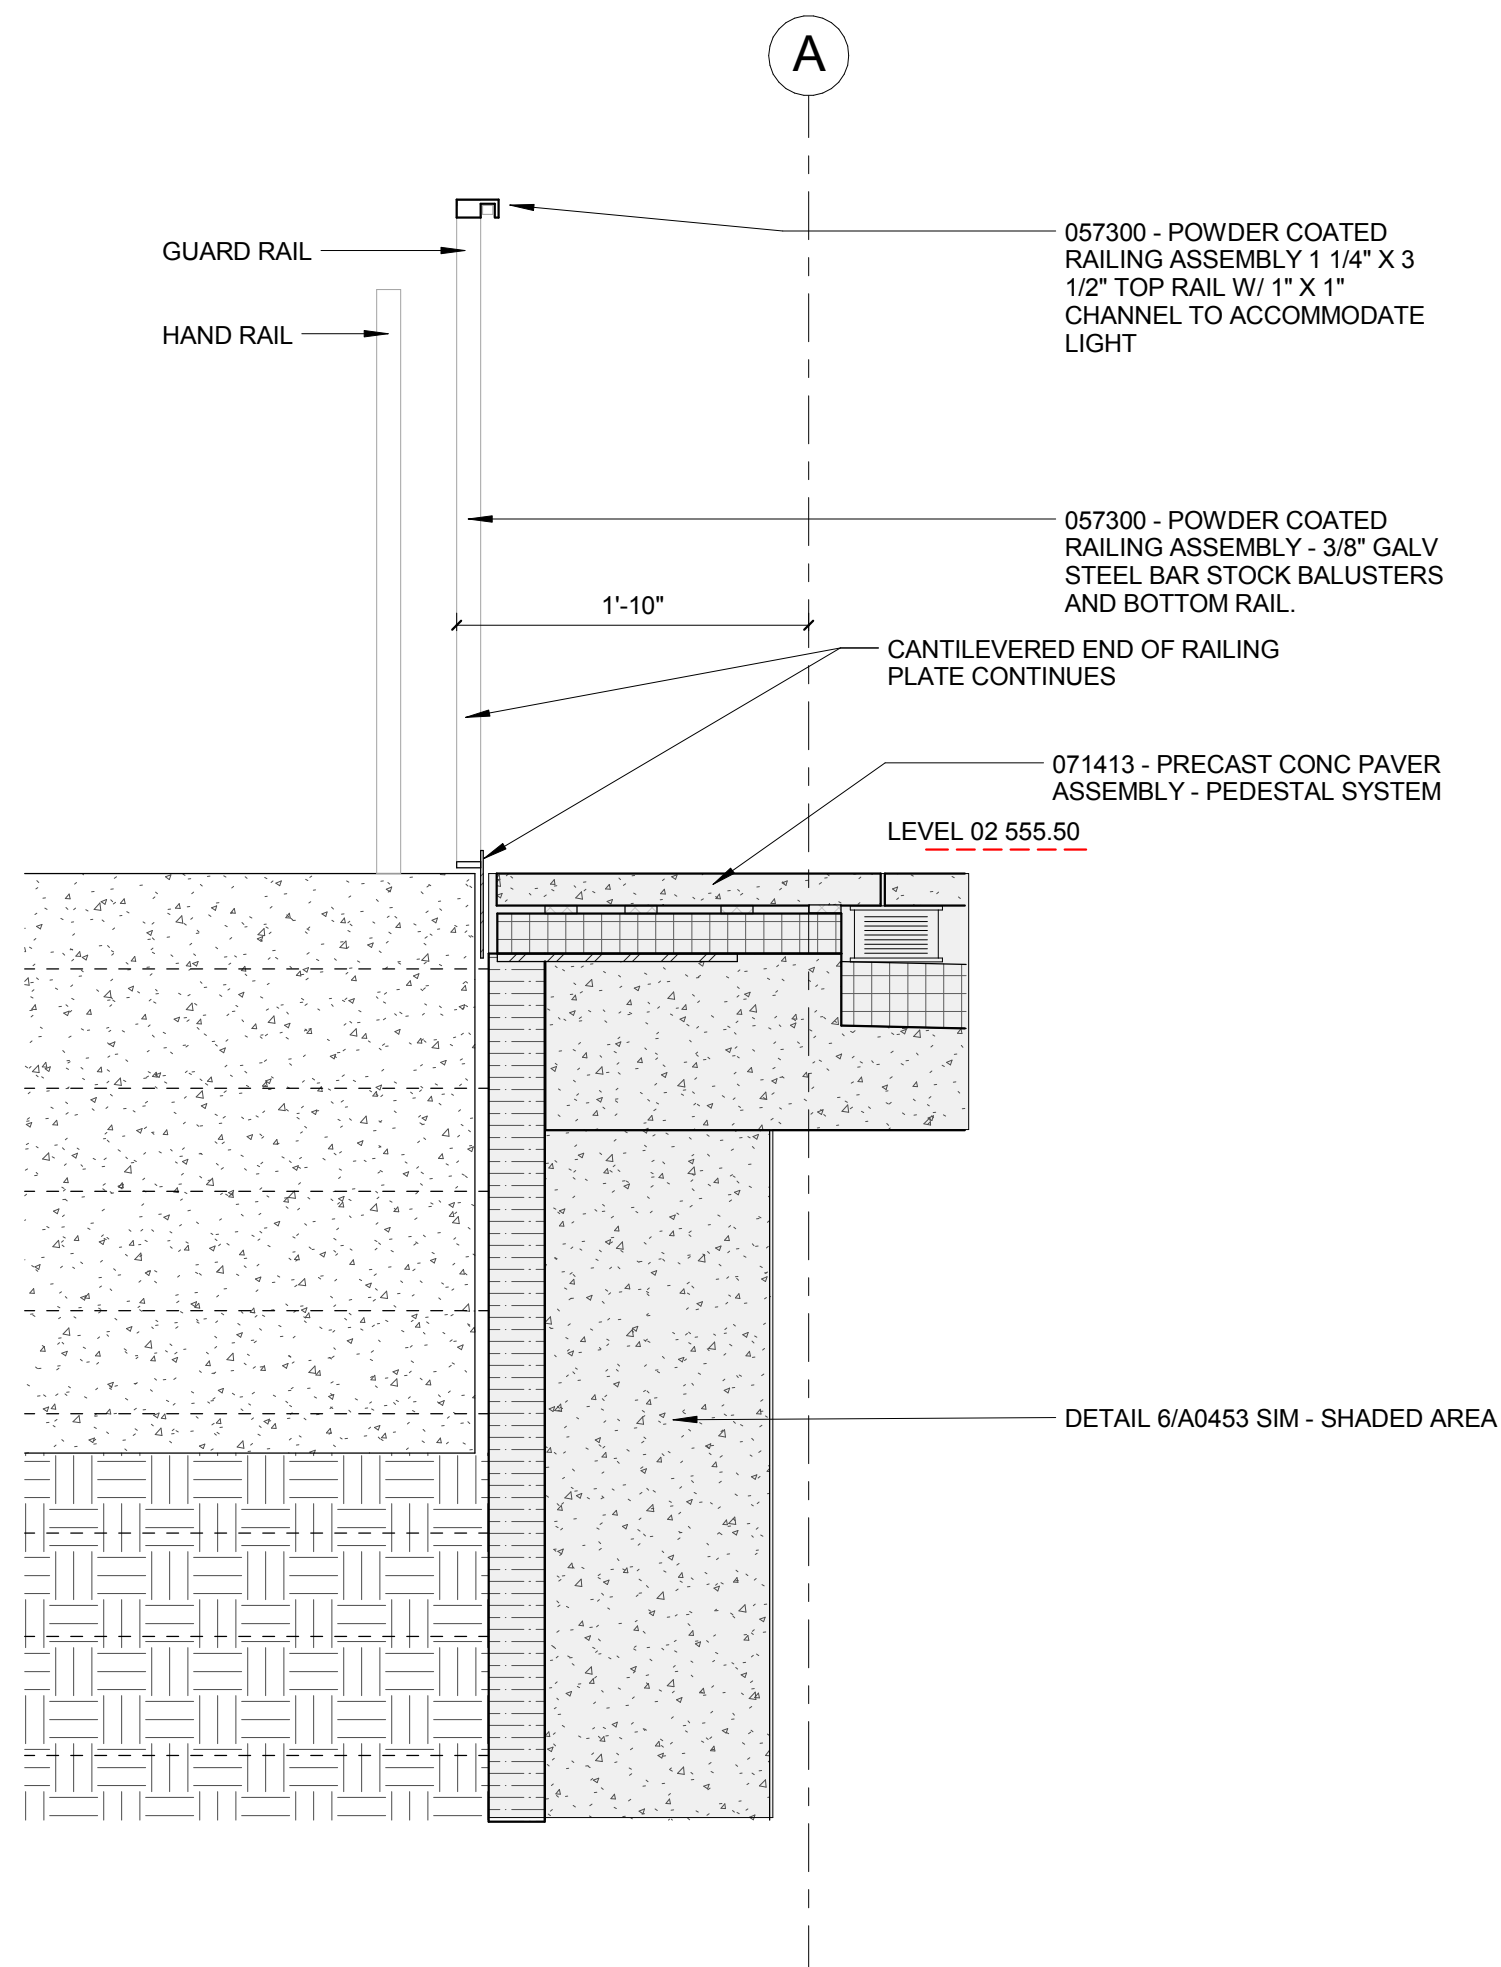

4 NORTH HAND RAIL SECTION 2
1" = 1'-0"

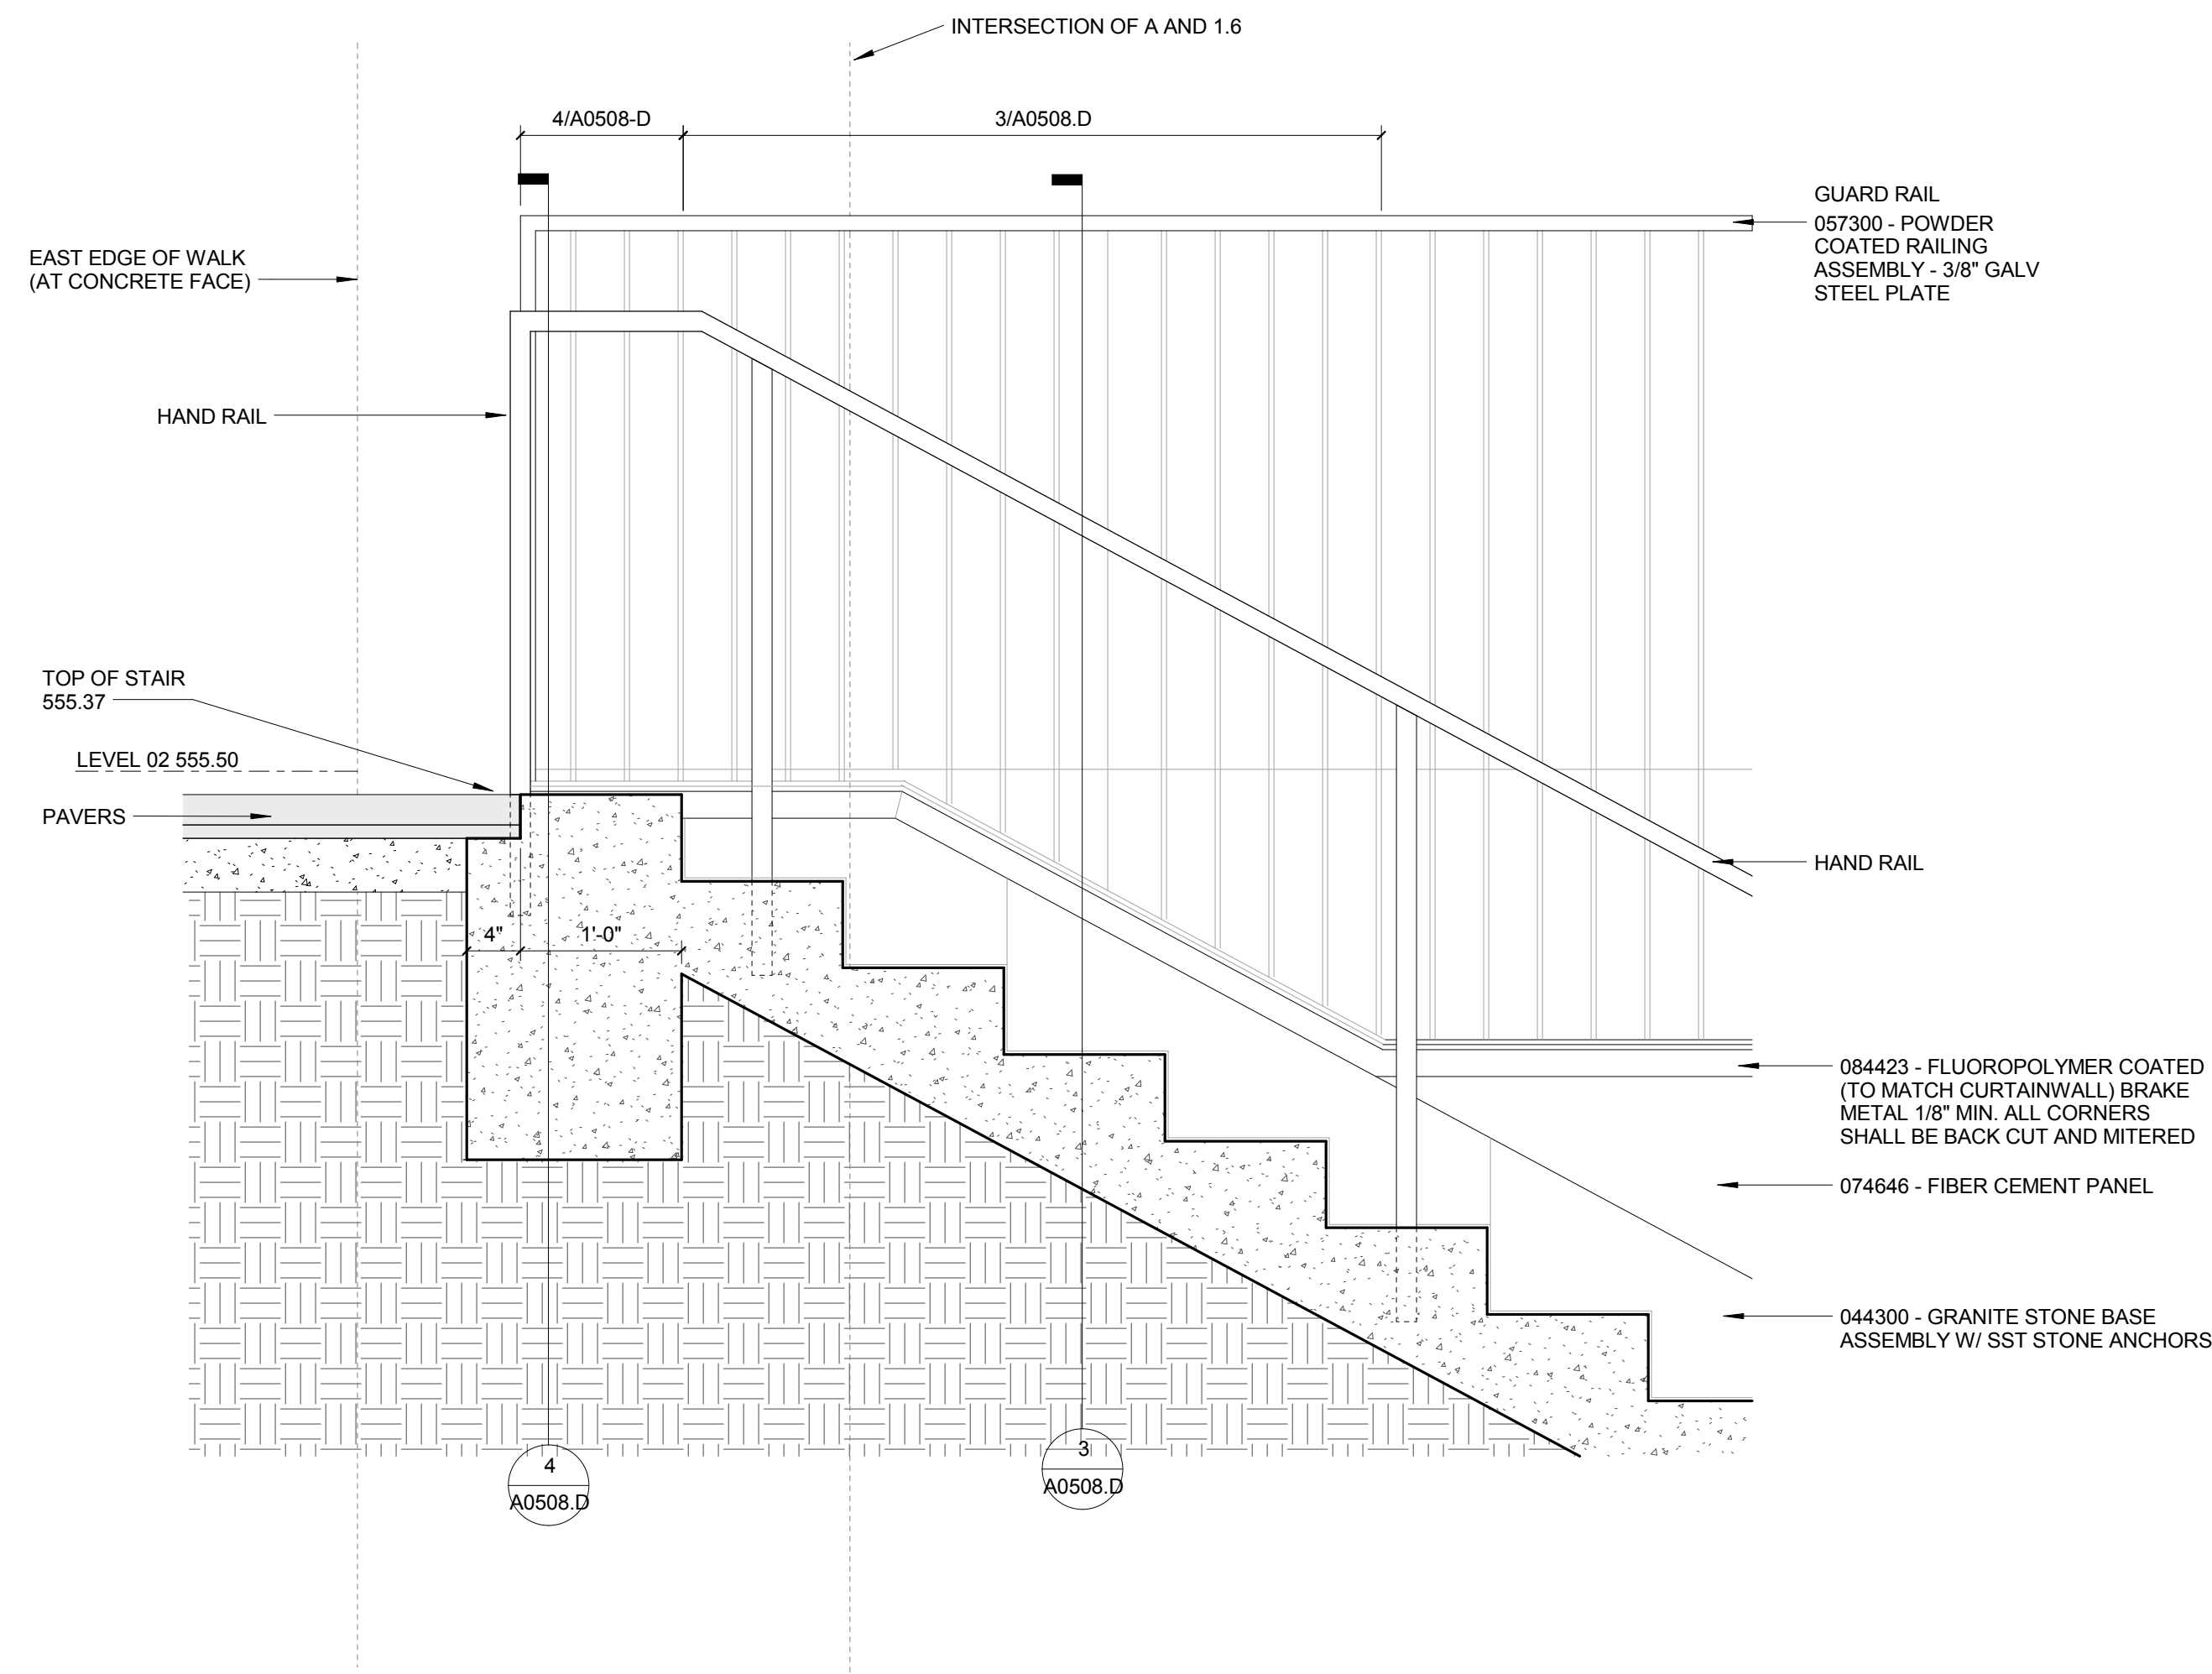

2 NORTH HAND RAIL ELEVATION
1" = 1'-0"

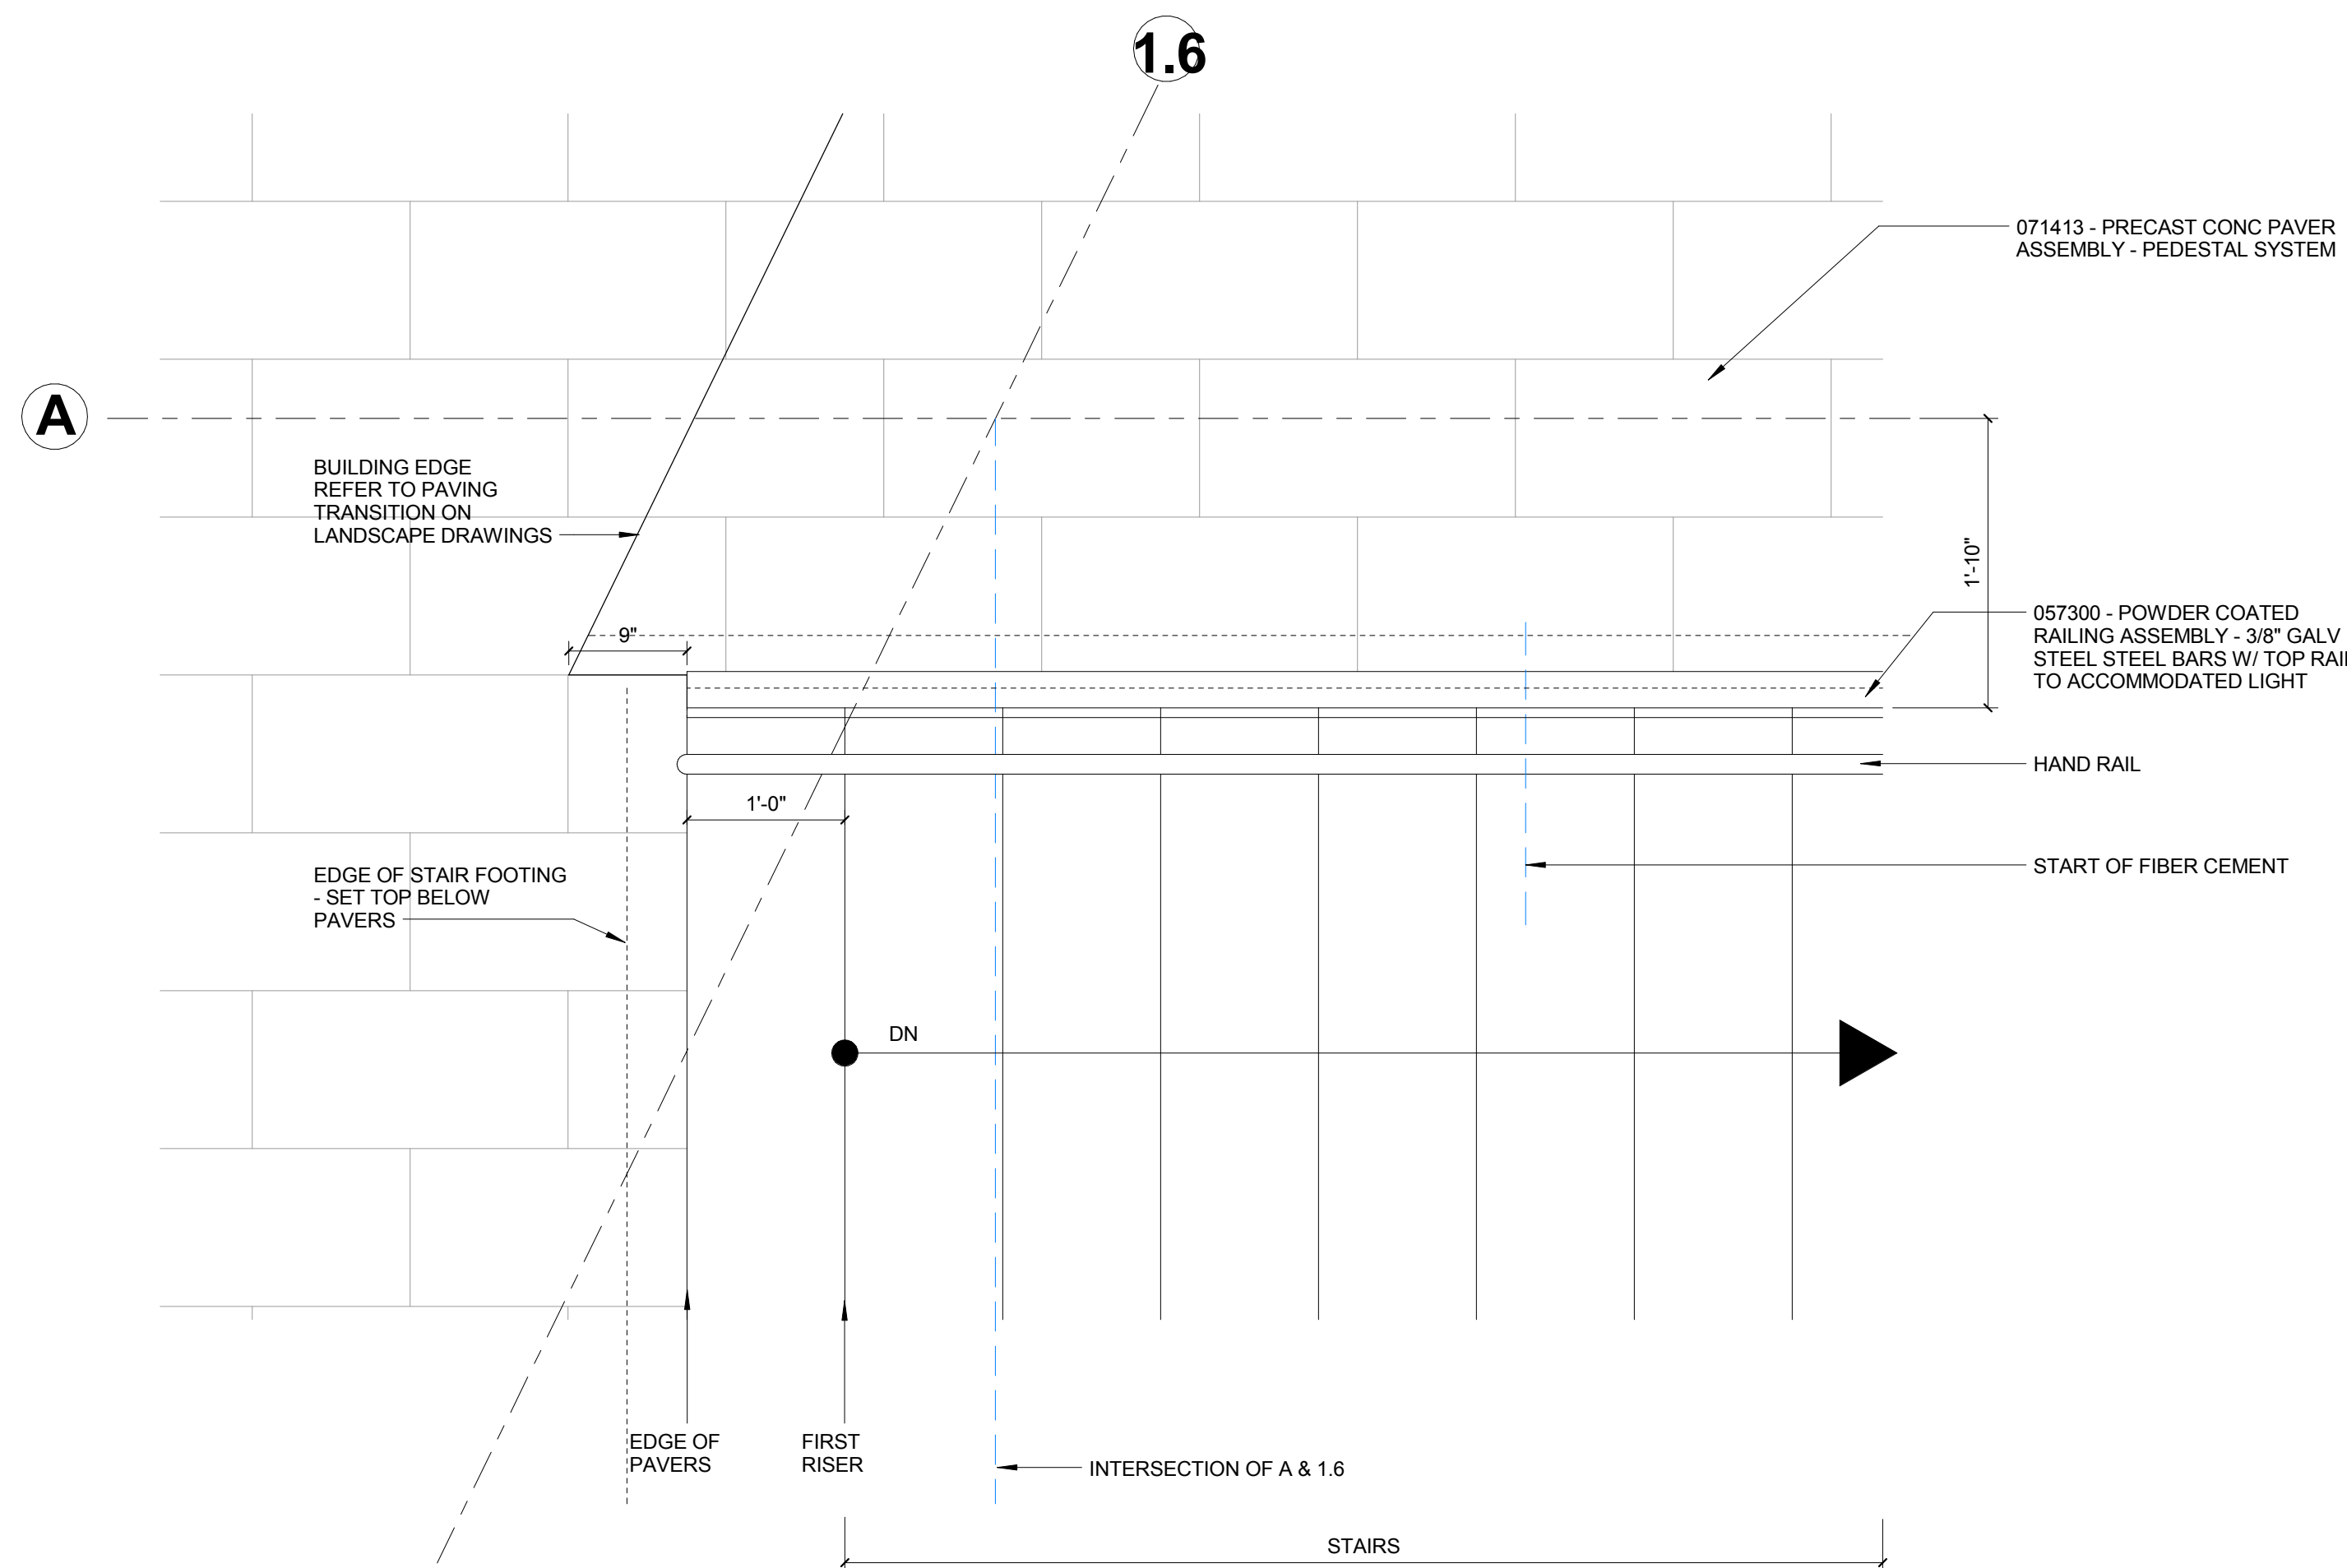

1 NORTH HAND RAIL DETAIL PLAN
1" = 1'-0"