



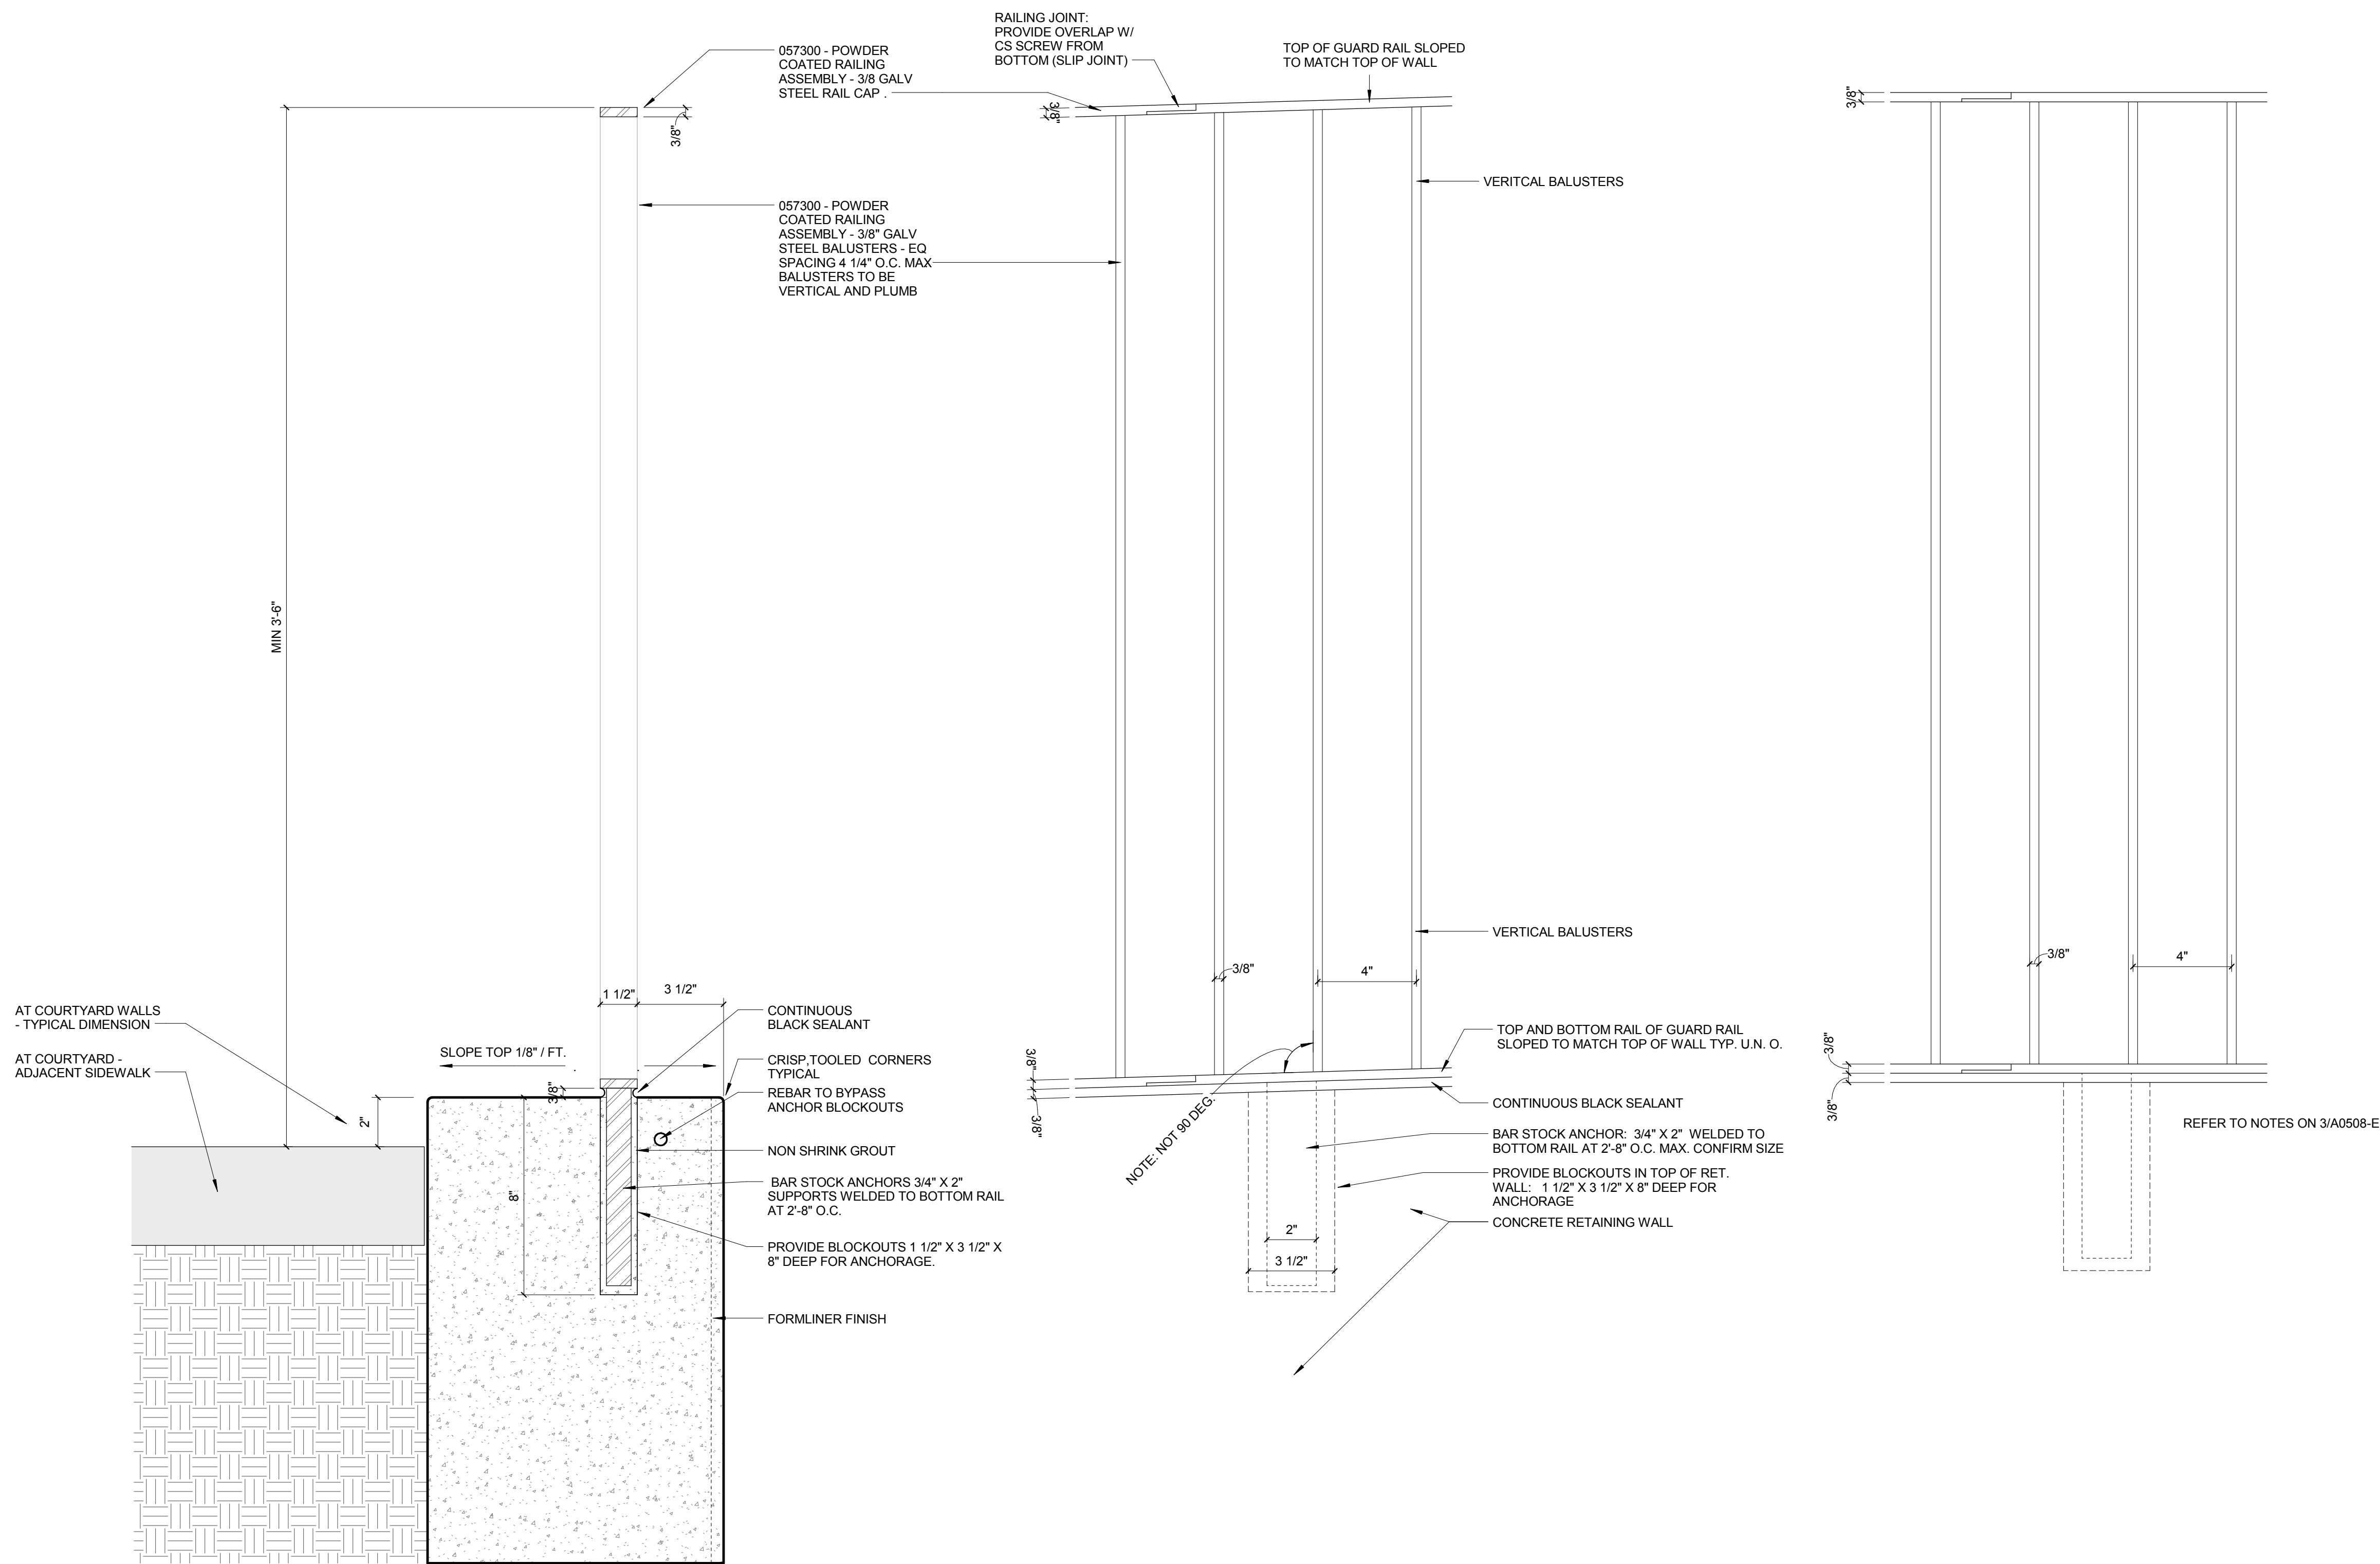

1 WEST WALL & RAIN GARDEN RAILING SECTION
3" = 1'-0"

3 WEST WALL RAILING ELEVATION
3" = 1'-0"

4 RAIN GARDEN RAILING ELEVATION
3" = 1'-0"

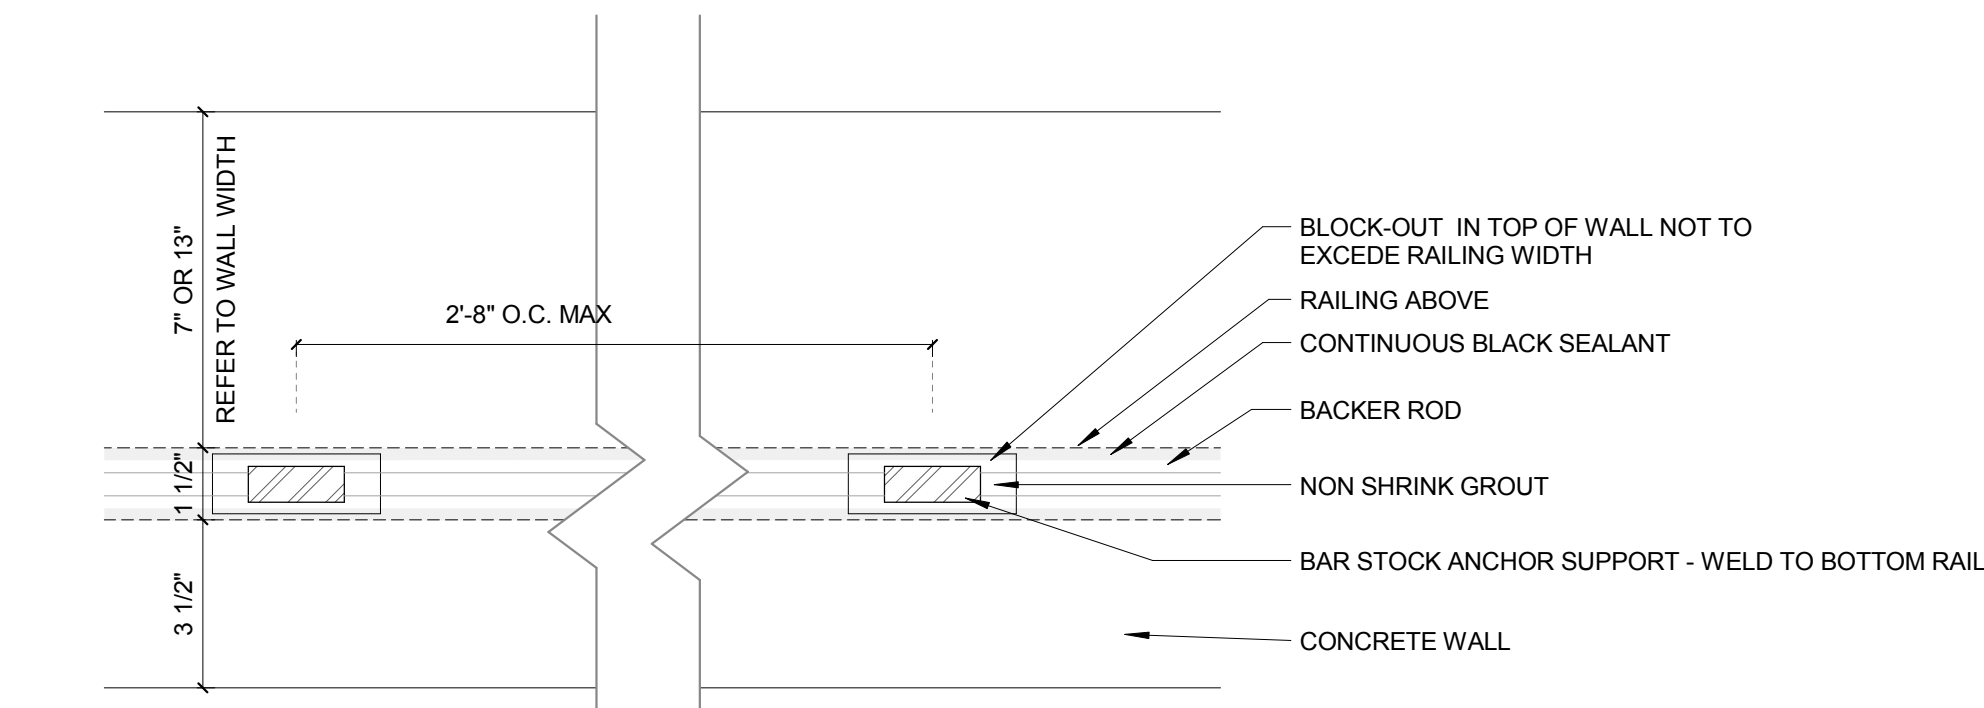

2 WEST WALL & RAIN GARDEN RAILING PLAN
3" = 1'-0"

1	ASI-003	01 AUG 2016
-	ISSUED FOR CONSTRUCTION (BP1)	15 JAN 2016
No.	Description	Date

Drawing Title:

RAILING DETAILS

Project No.: 04561.01 Checked by:

A0508.E