

2	ASI-057	06 APR 2017
1	ASI-003	01 AUG 2016
ISSUED FOR CONSTRUCTION (BP1)		15 JAN 2016
No.	Description	Date



Drawing Title:

SITE WALLS - RAIN
GARDEN


Project No.: 04561.01

Checked by:

A0509.B

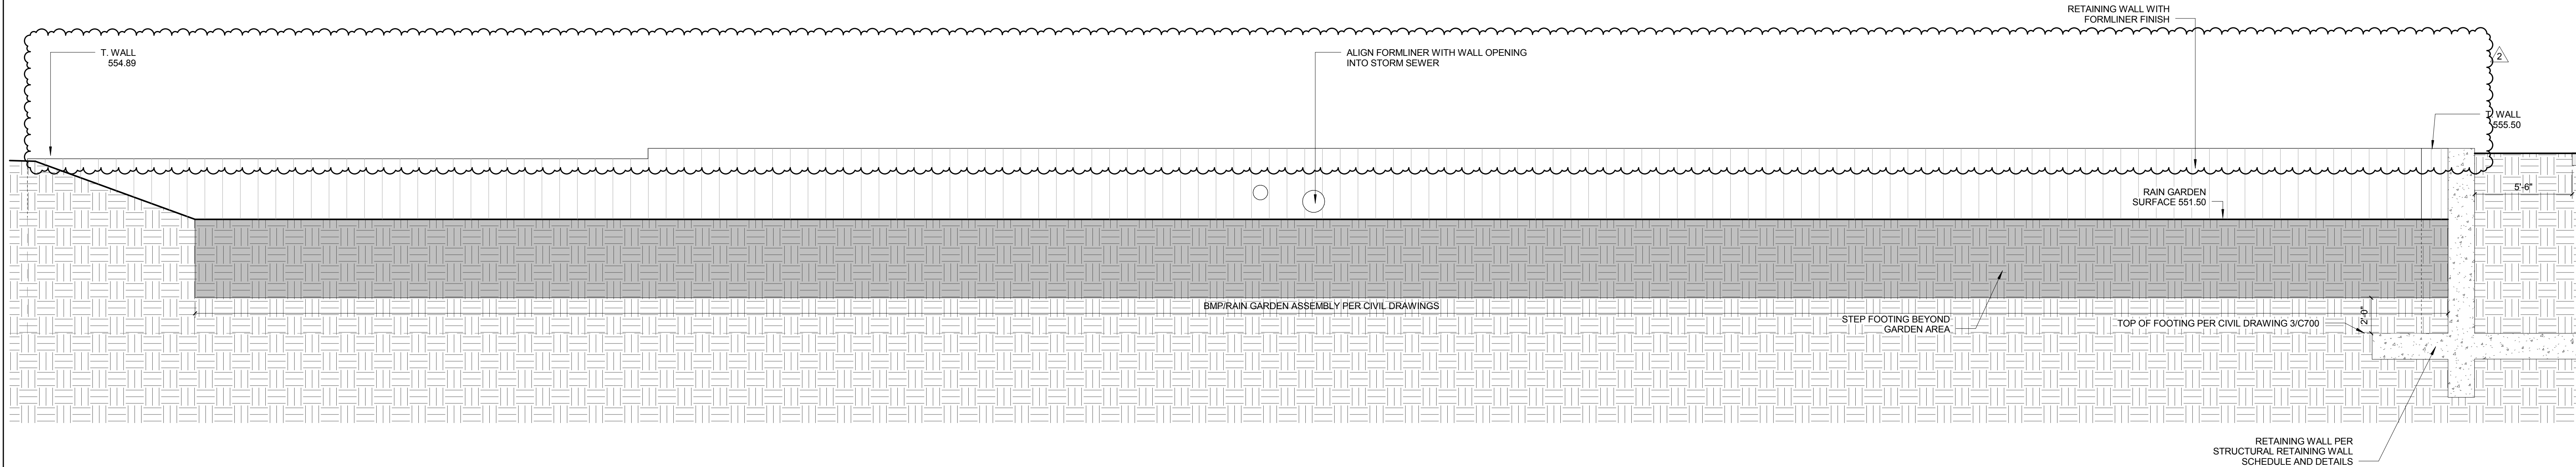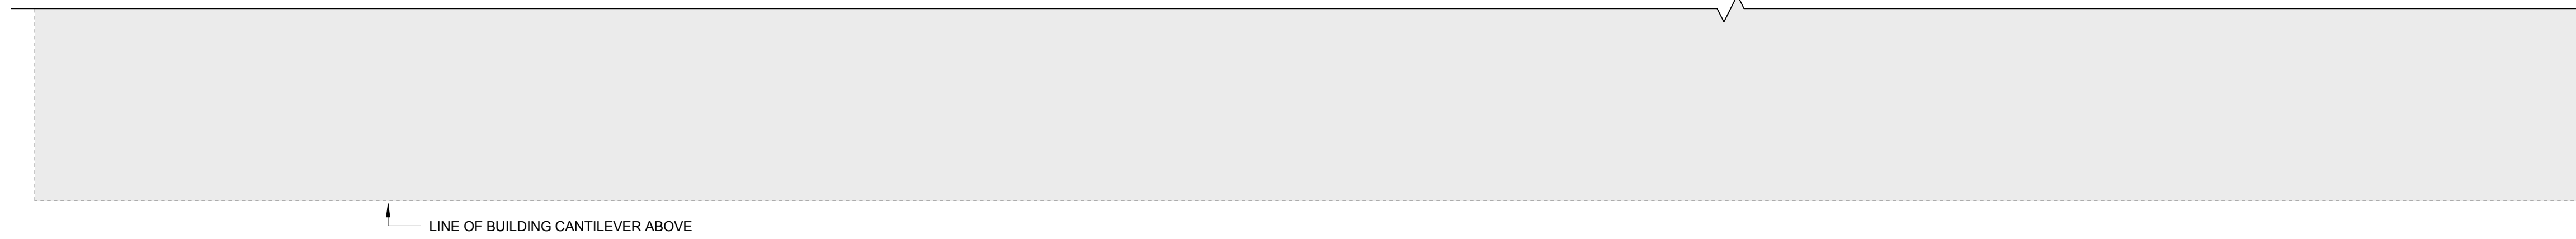

2 RAIN GARDEN EAST WALL
1/4" = 1'-0"

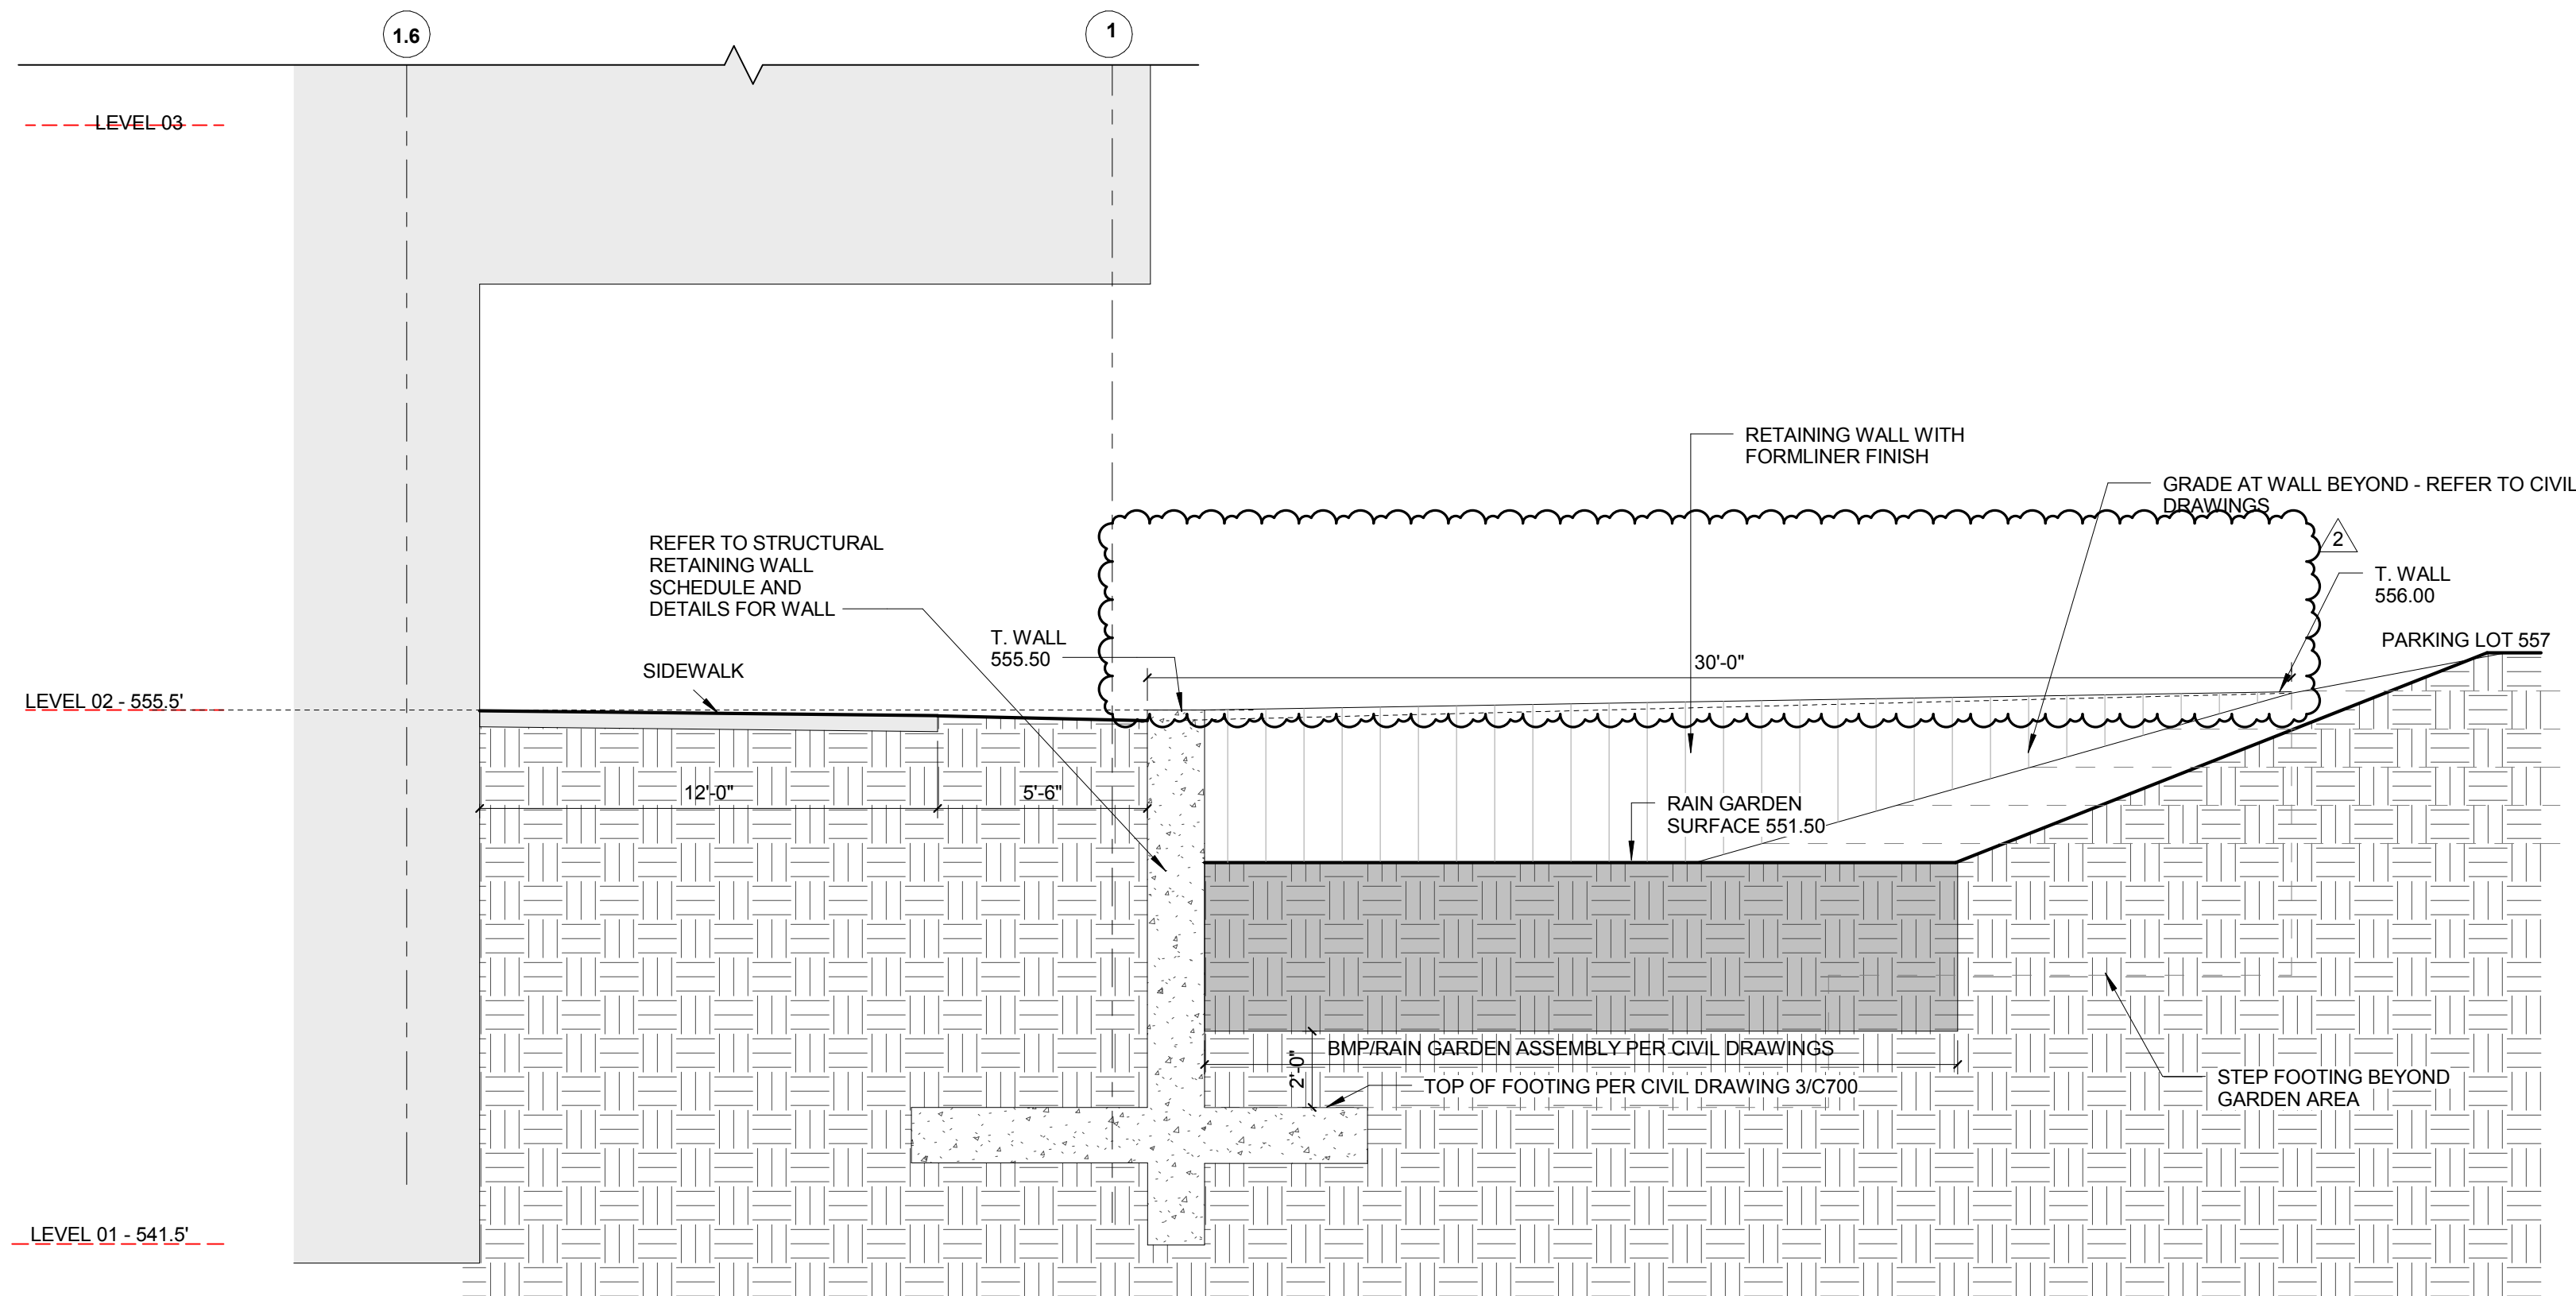

1 RAIN GARDEN SOUTH WALL
1/4" = 1'-0"