




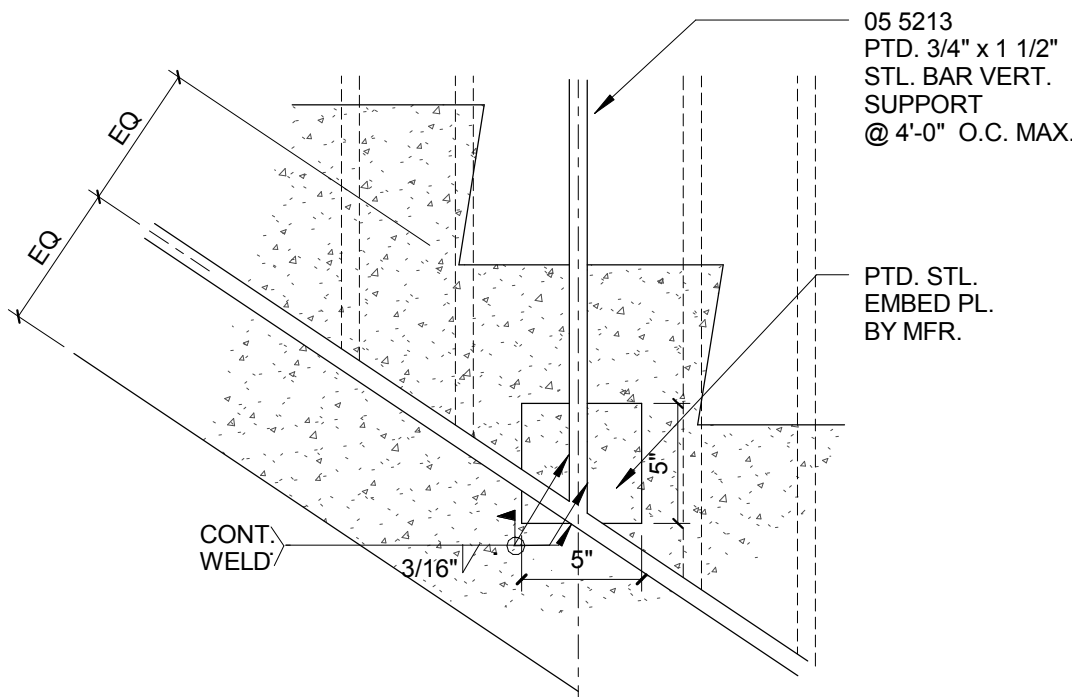


5 RAILING SUPPORT EMBED PL. CONN.
1 1/2" = 1'-0"

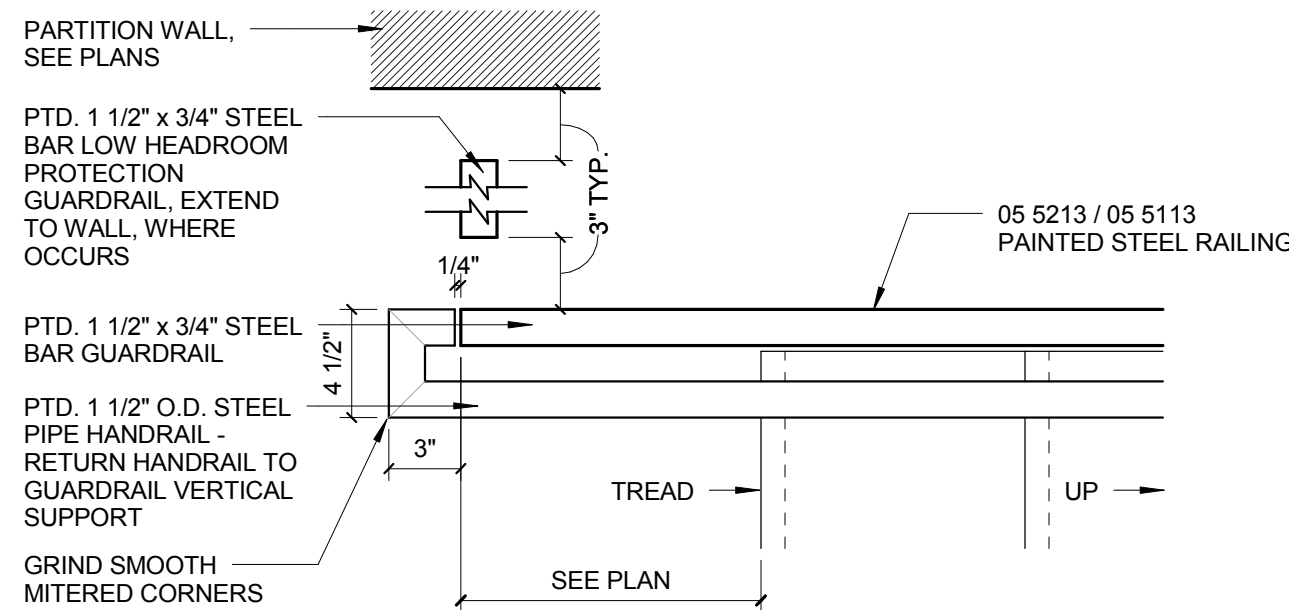


4 RAILING DETAIL - BOTTOM LANDING
1 1/2" = 1'-0"

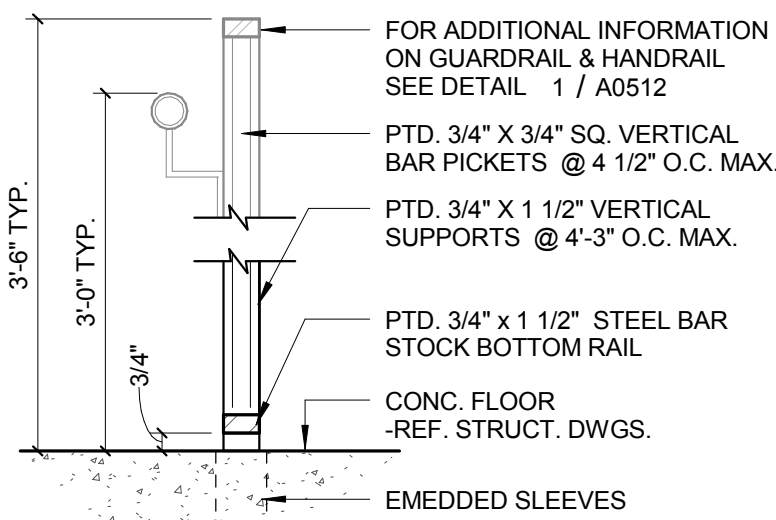

3 RAILING DTL. @ LEVEL 01 LOADING
1 1/2" = 1'-0"

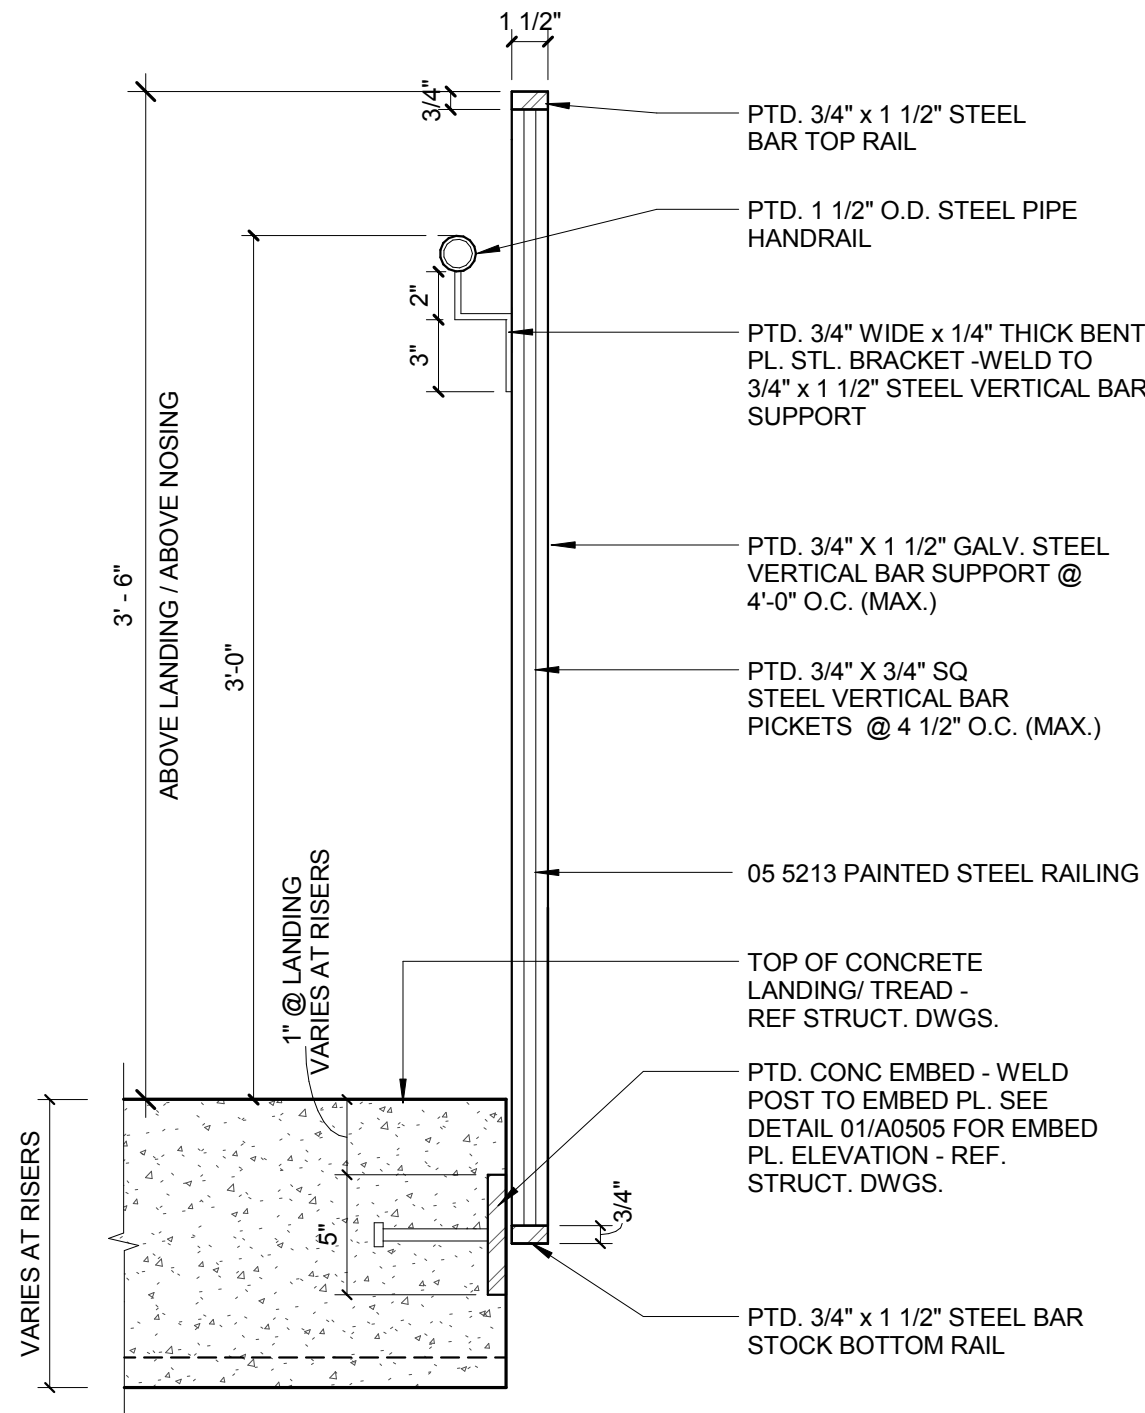

2 TYP. RAILING DTL. @ STAIR & INT. LANDING
1 1/2" = 1'-0"

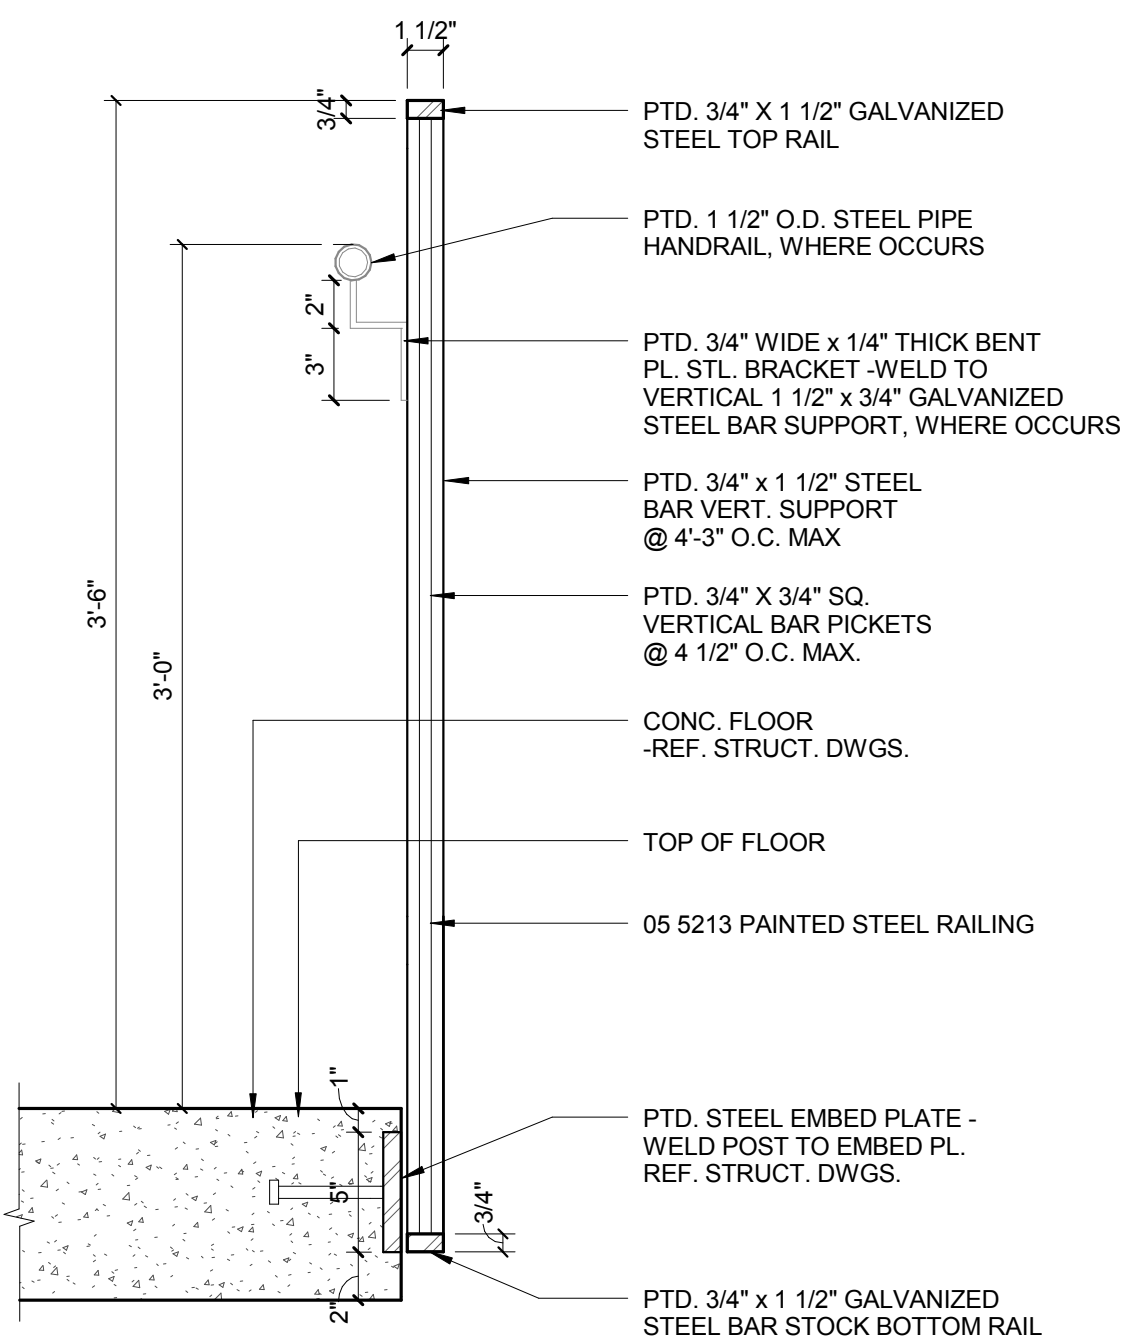

1 TYP. RAILING DTL. @ FLOOR LEVEL
1 1/2" = 1'-0"