



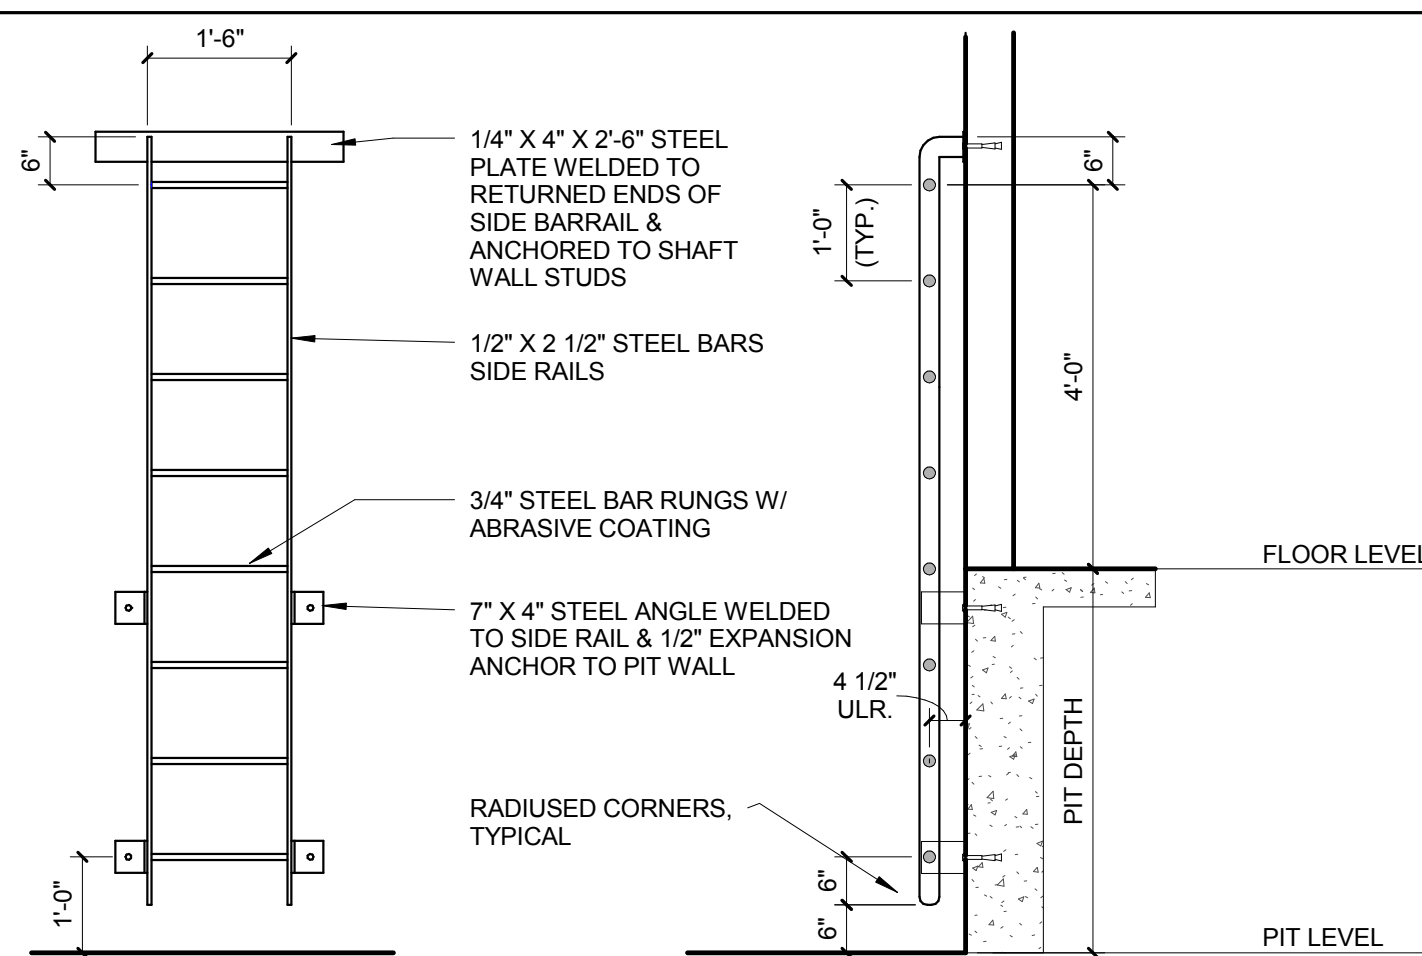


21 A0551 - ELEVATOR PIT LADDER
1/2" = 1'-0"

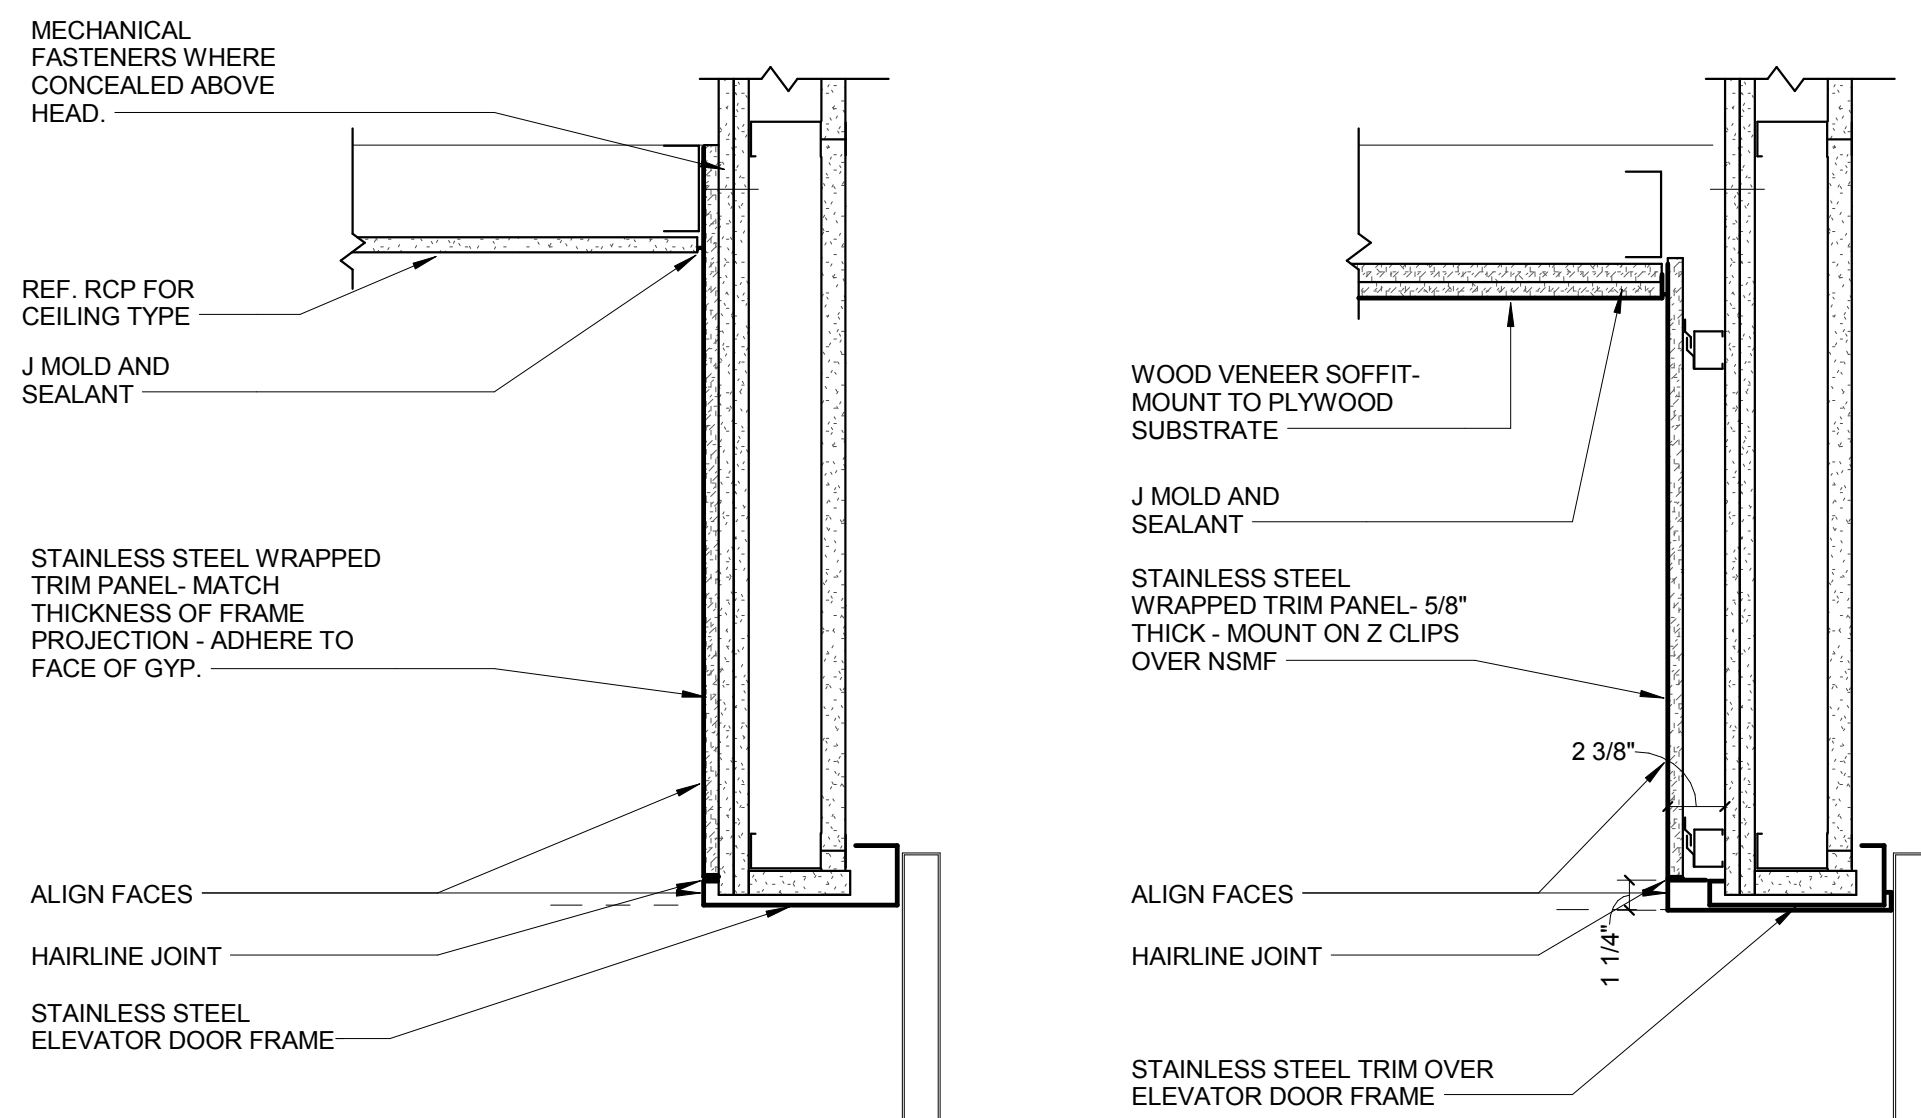


20 ELEVATOR DOOR HEAD DETAIL
1 1/2" = 1'-0"


19 ELEVATOR 2 DOOR HEAD DETAIL
1 1/2" = 1'-0"

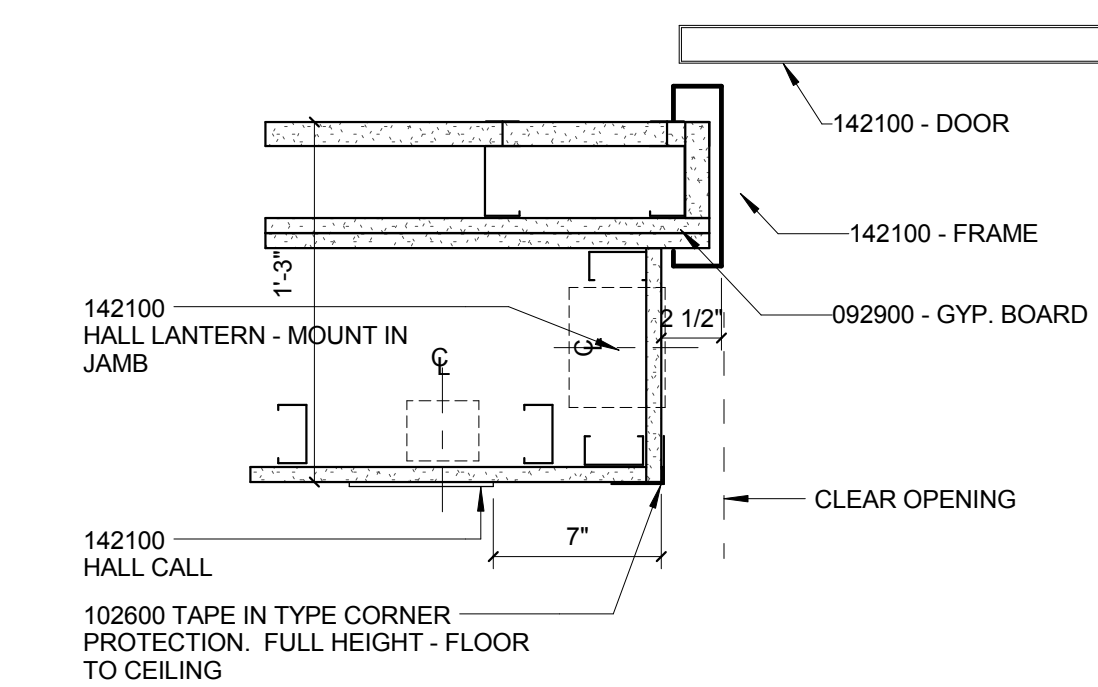


18 ELEVATOR JAMB DETAIL
1 1/2" = 1'-0"

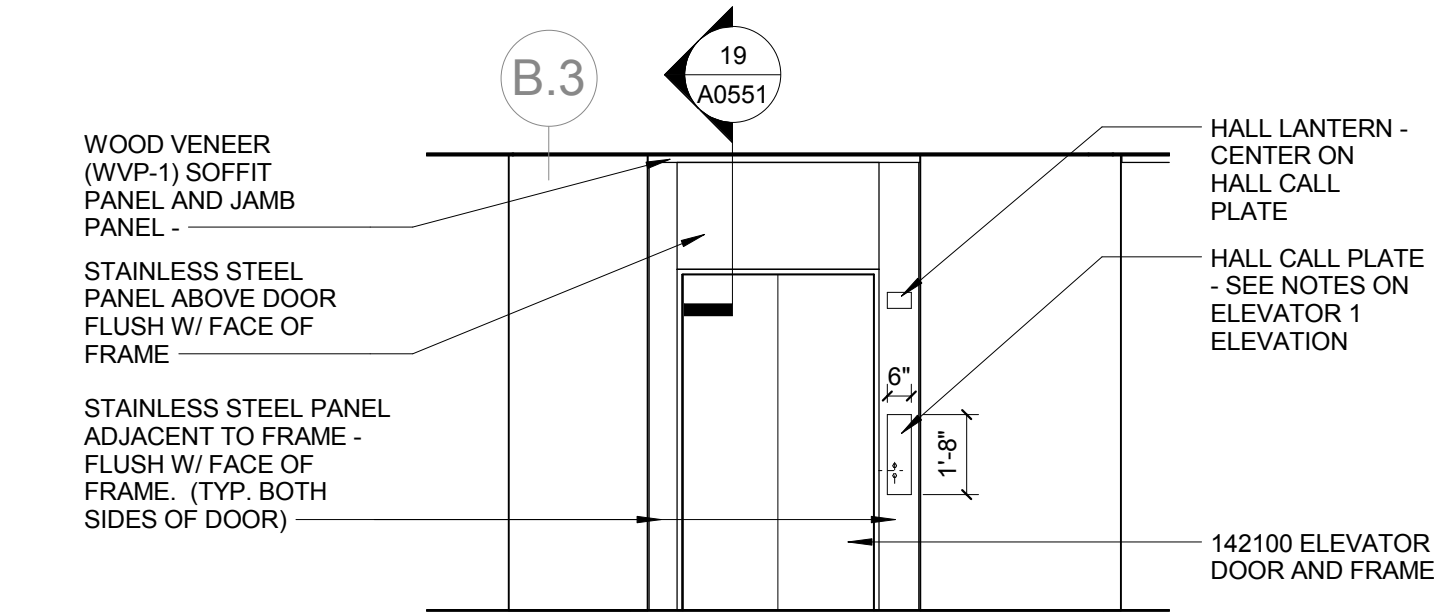


17 ELEVATOR 2 ELEVATION - TYPICAL L01-L04
1/4" = 1'-0"

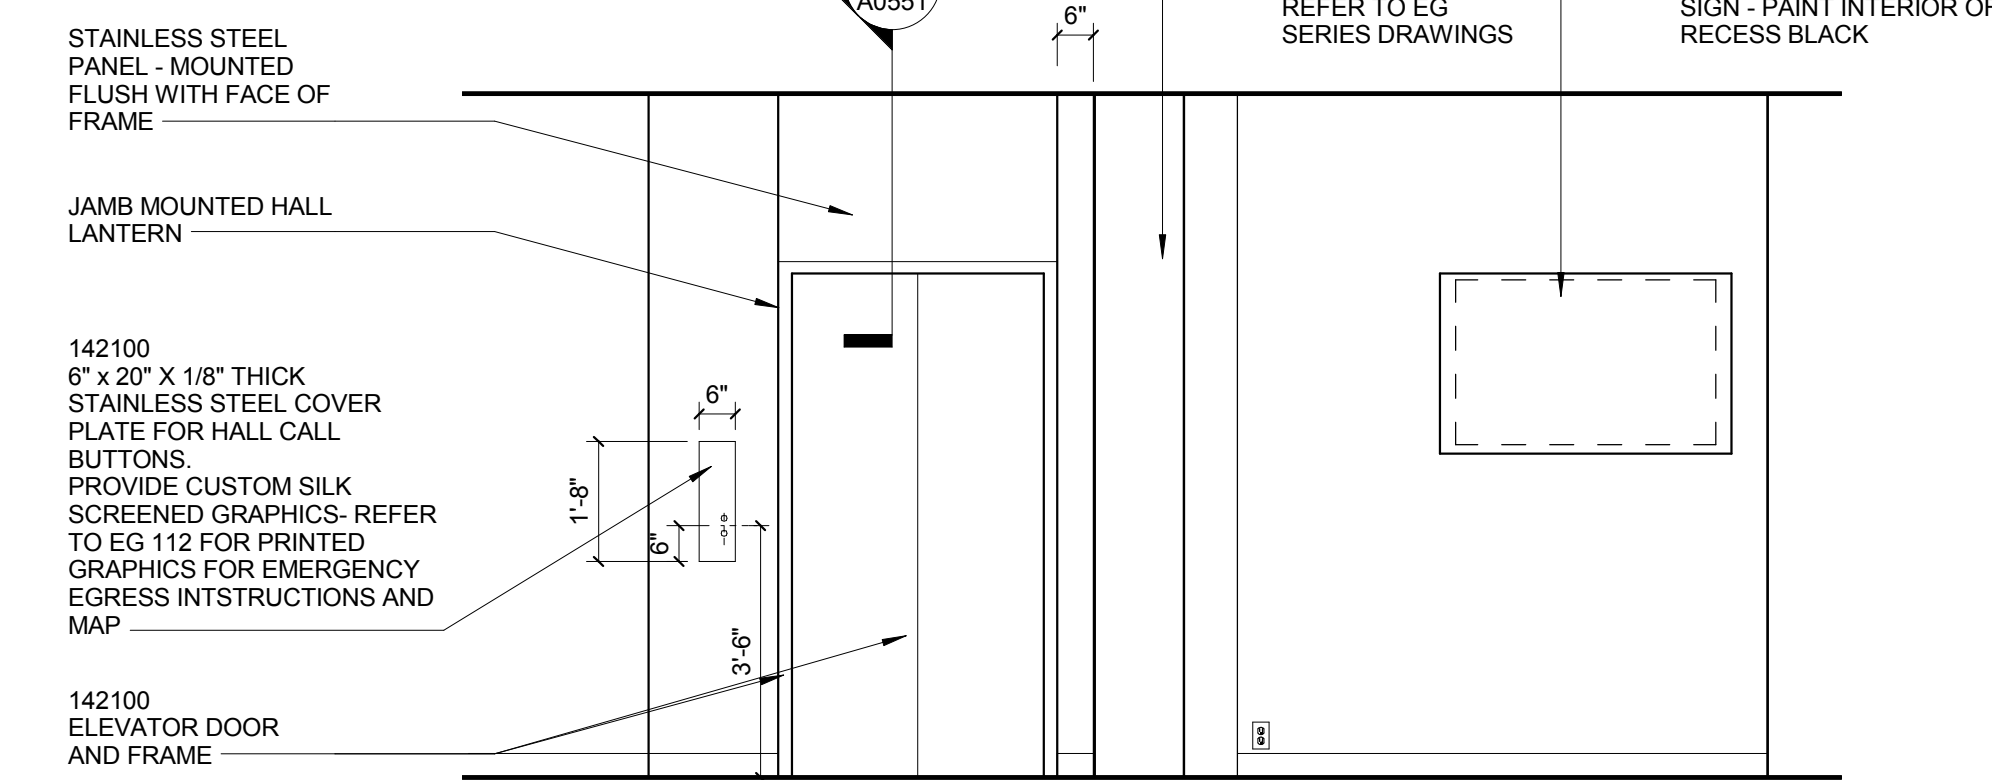


16 ELEVATOR 1 - TYPICAL ELEVATION
3/8" = 1'-0"

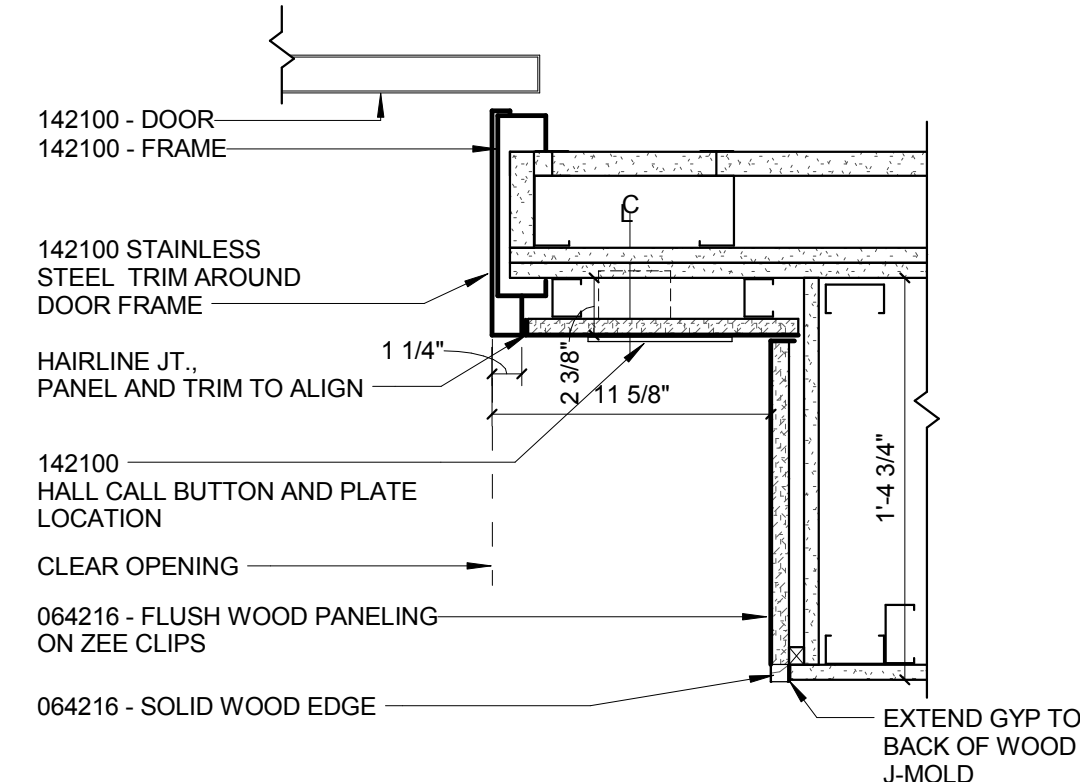


15 ELEVATOR 2 JAMB DETAIL
1 1/2" = 1'-0"

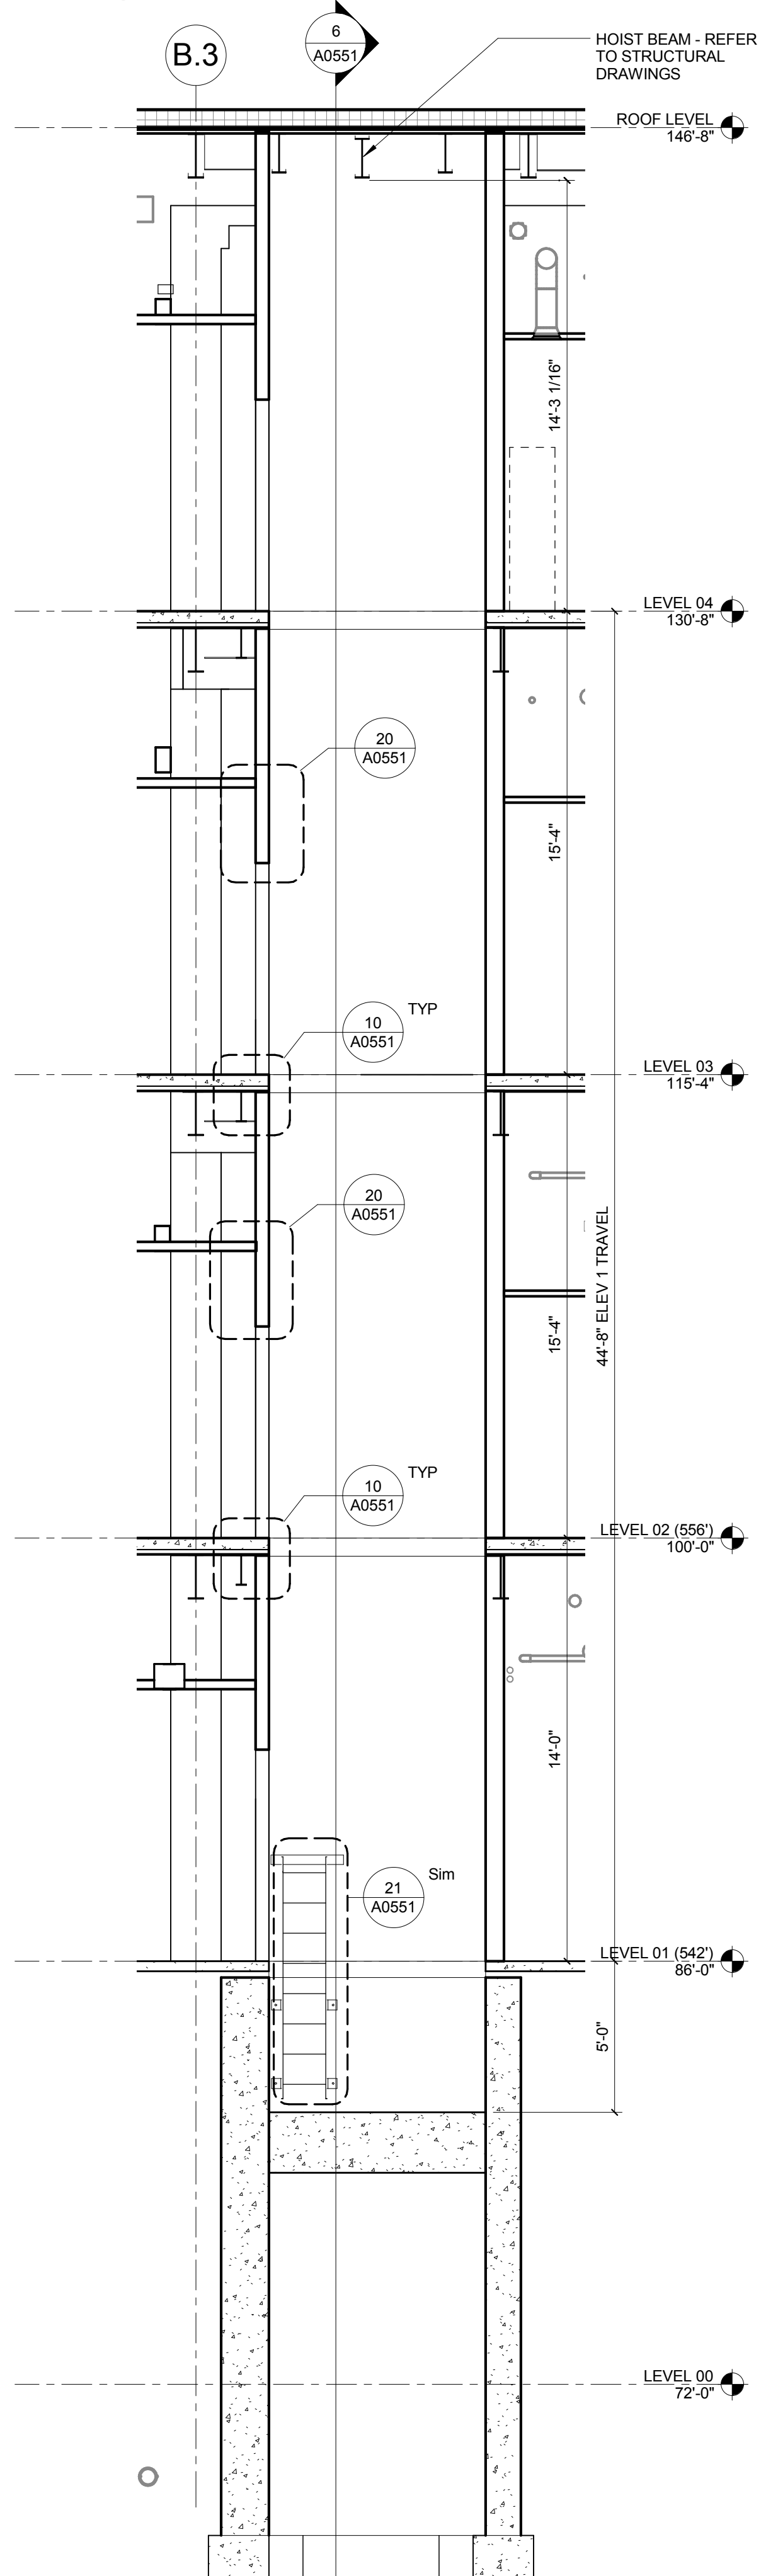


7 ELEVATOR 1 SECTION
1/4" = 1'-0"

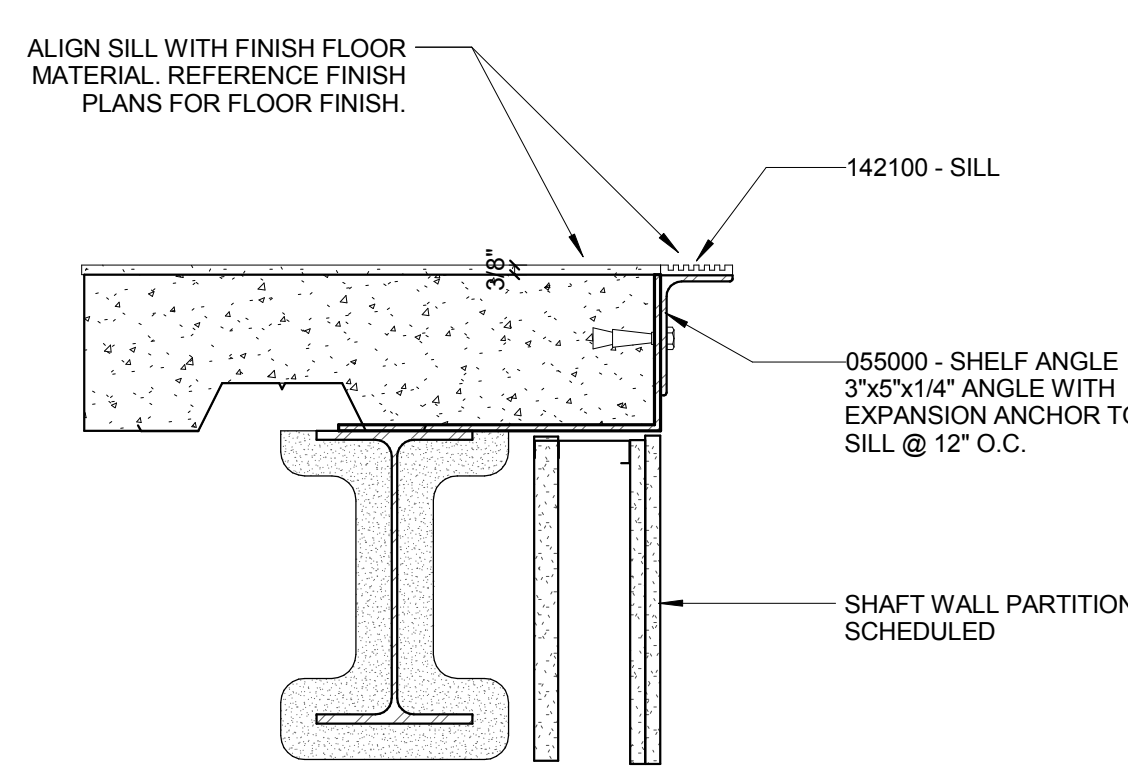


10 ELEVATOR SILL DETAIL
1 1/2" = 1'-0"

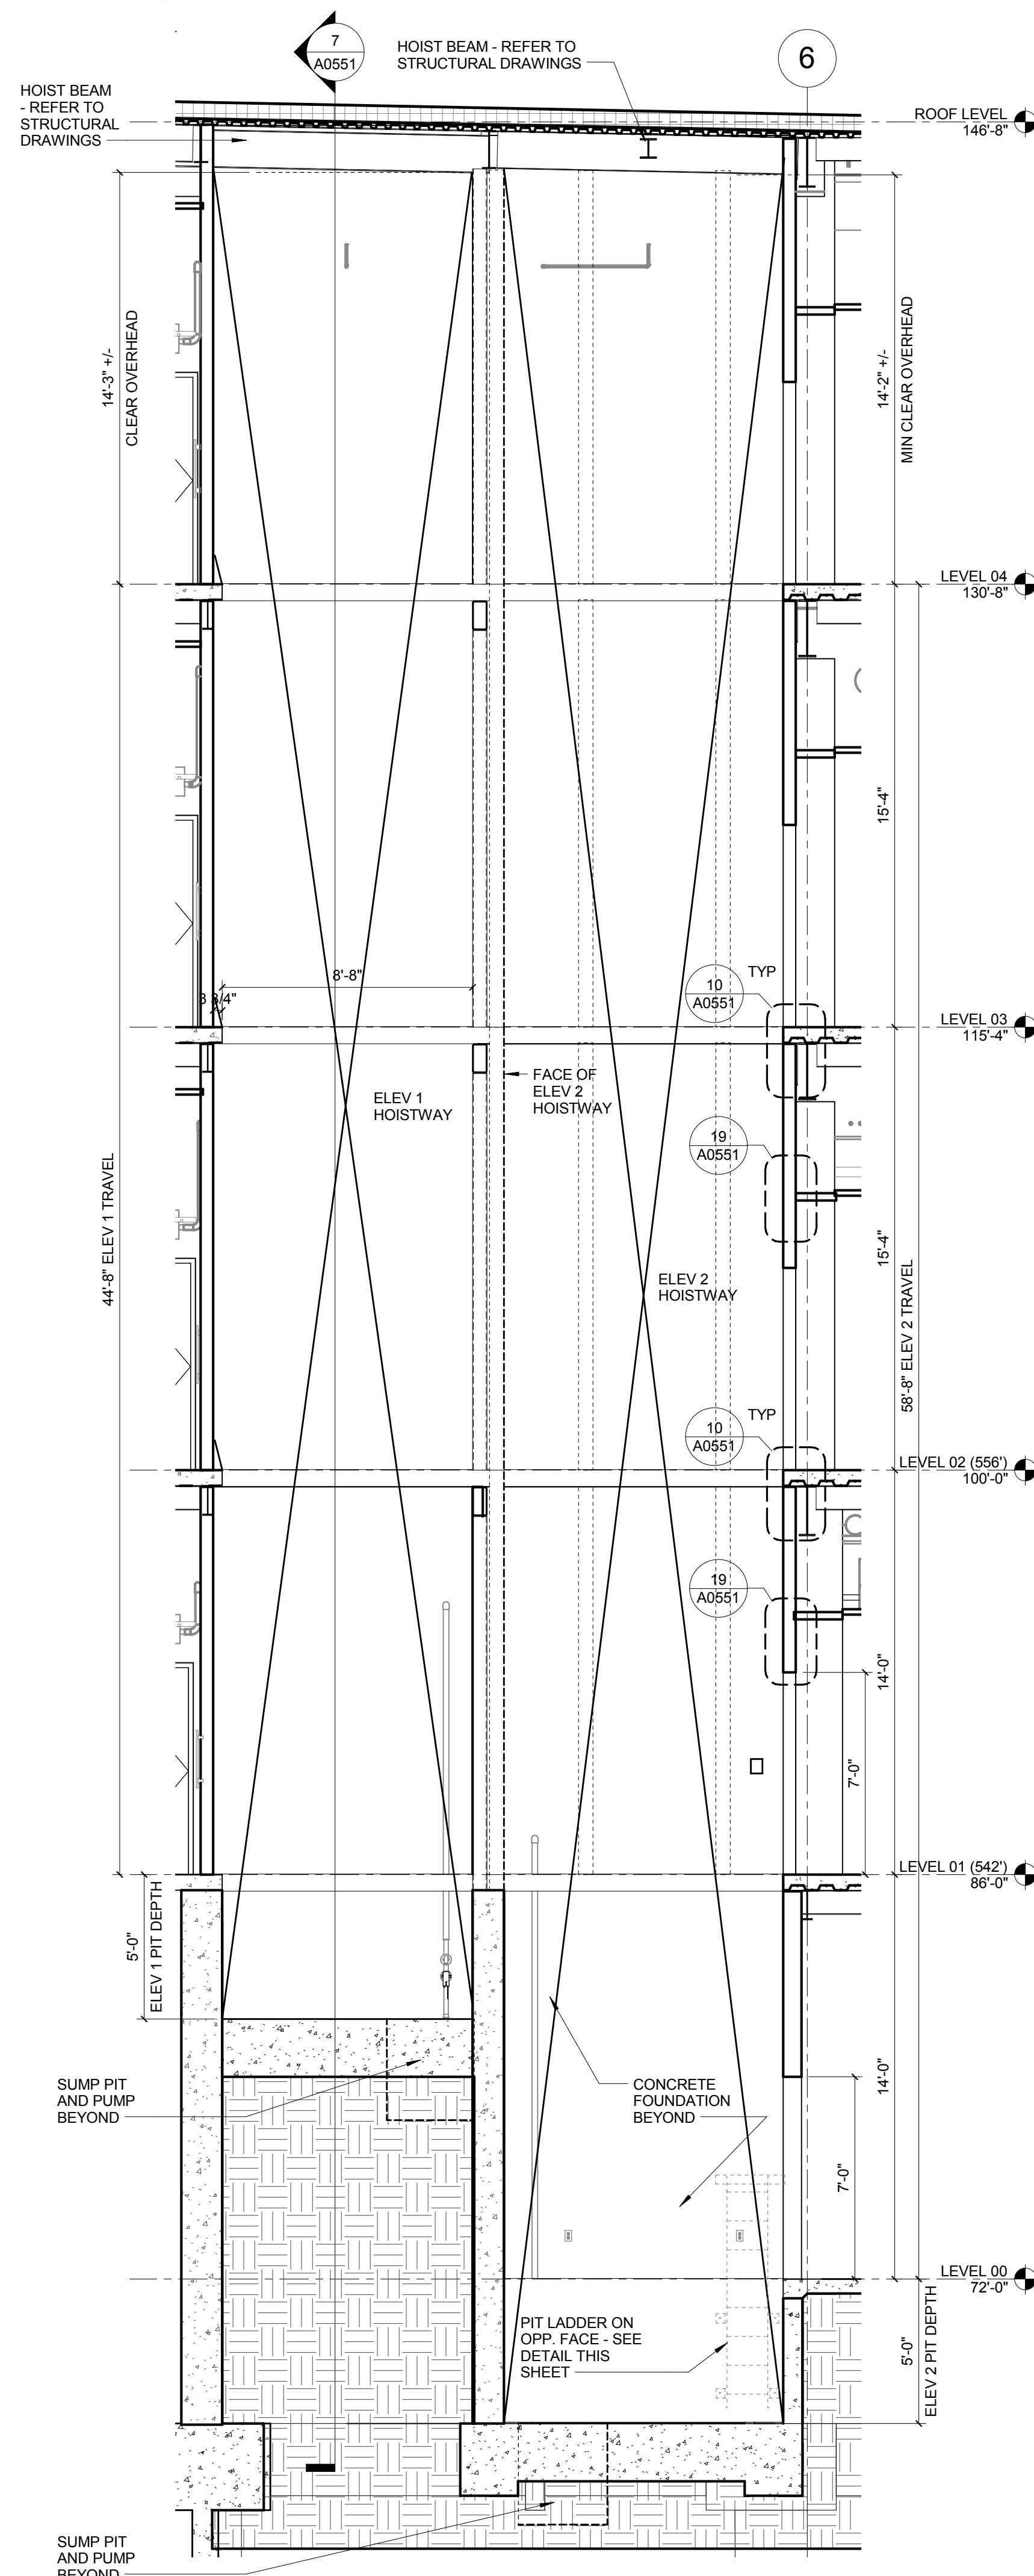


6 ELEVATOR SECTIONS
1/4" = 1'-0"

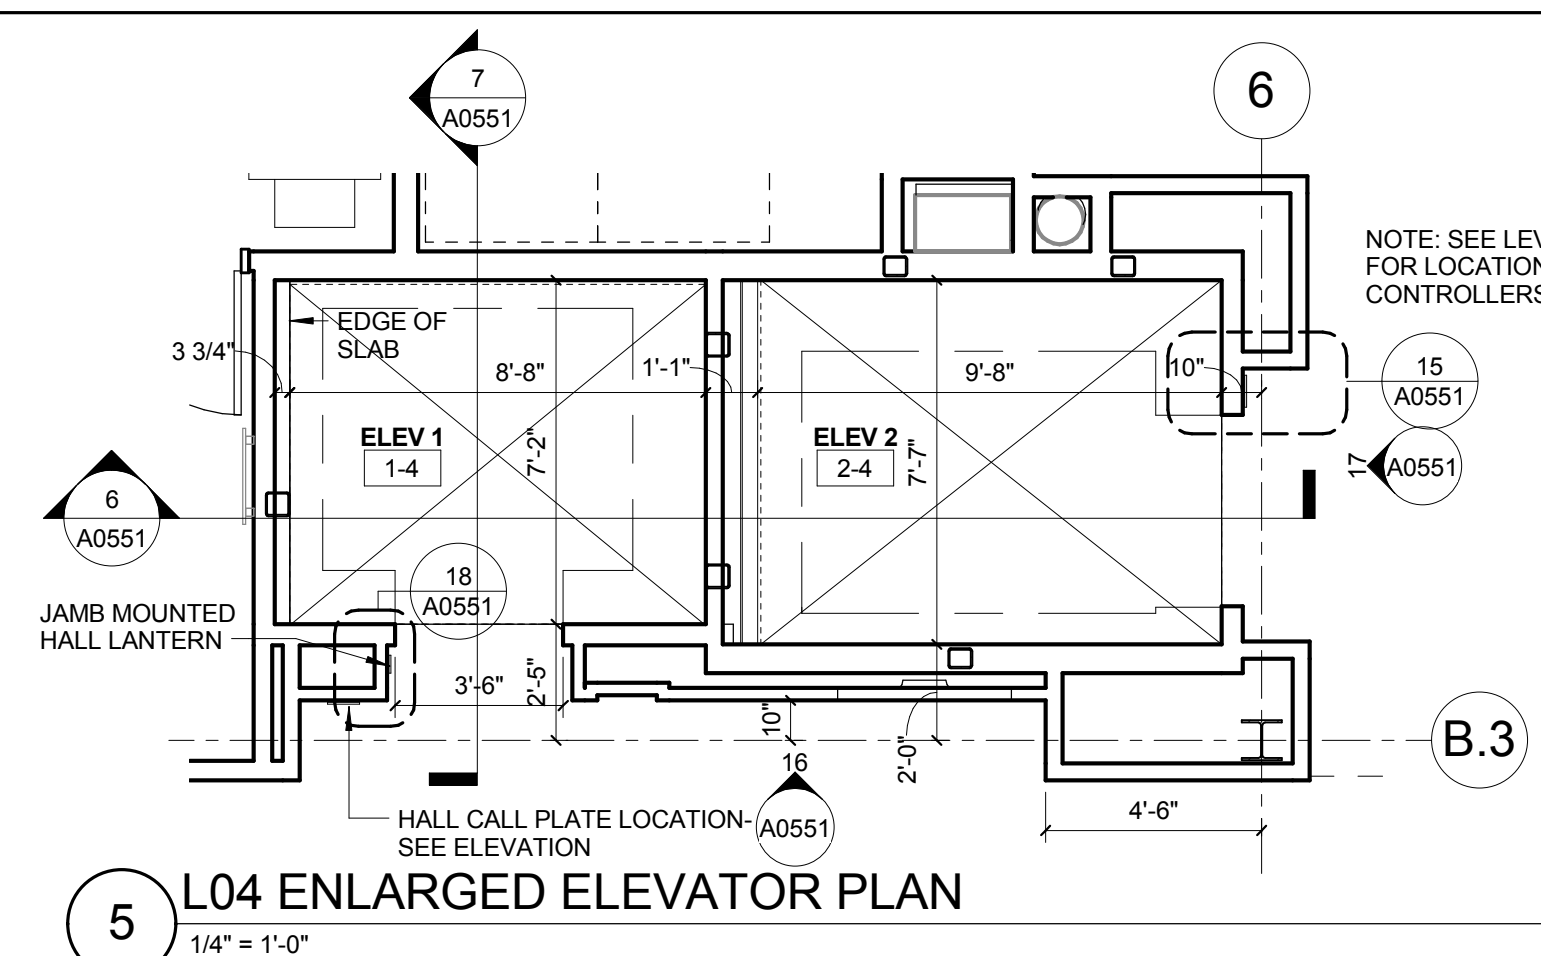


5 L04 ENLARGED ELEVATOR PLAN
1/4" = 1'-0"

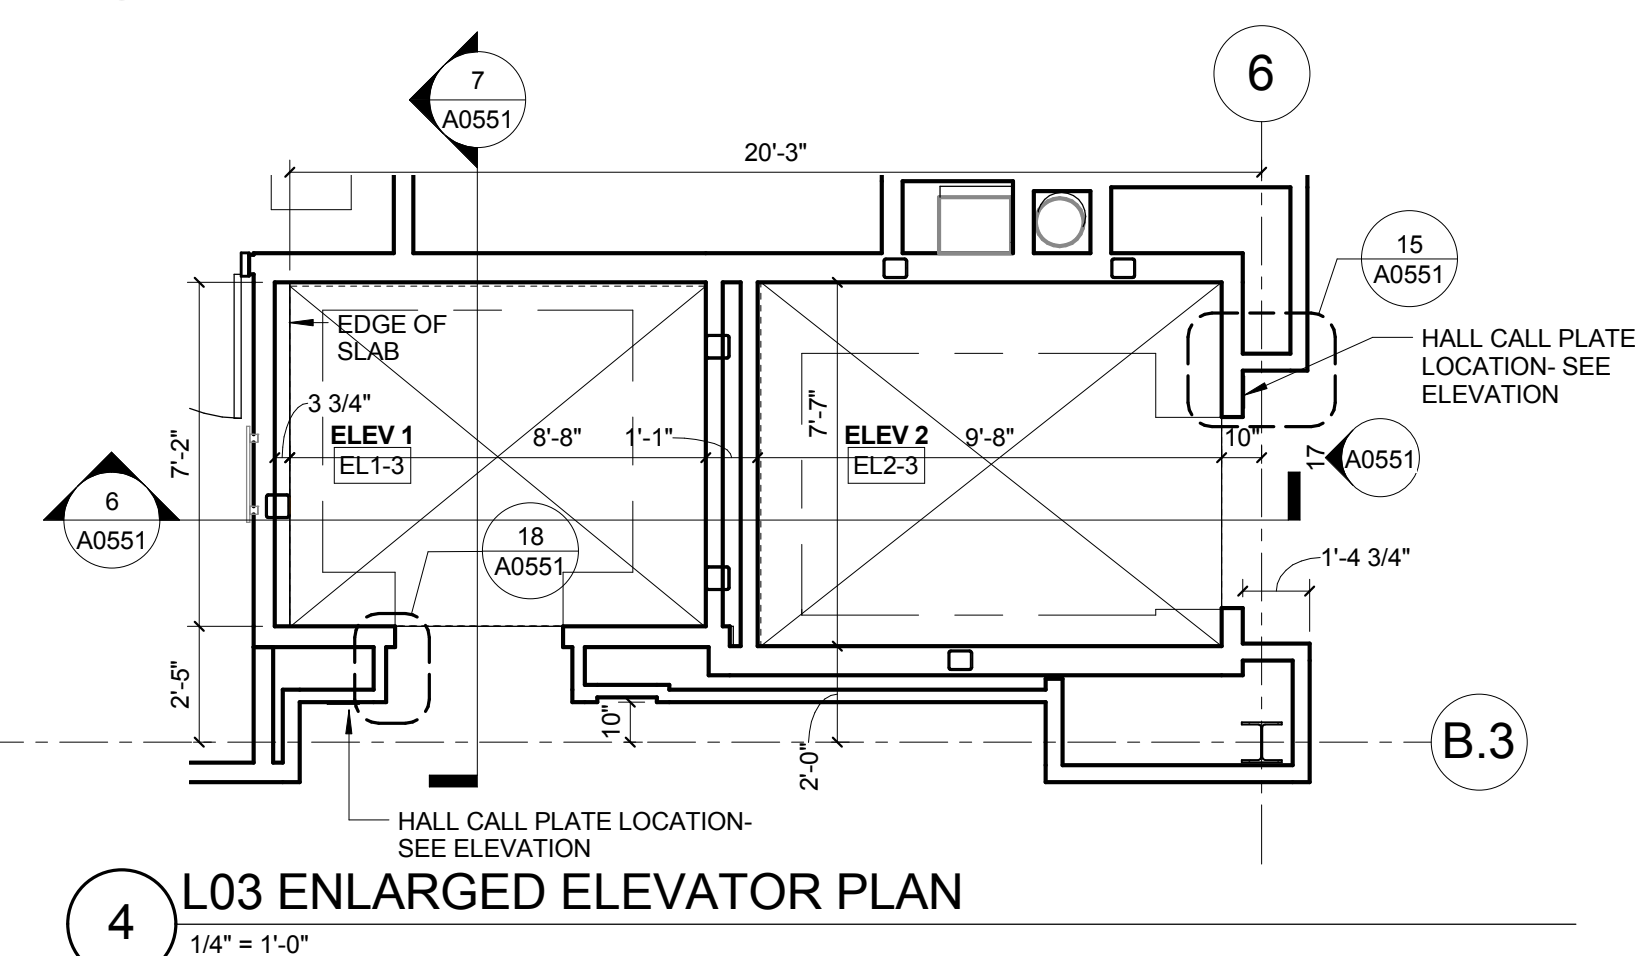


4 L03 ENLARGED ELEVATOR PLAN
1/4" = 1'-0"

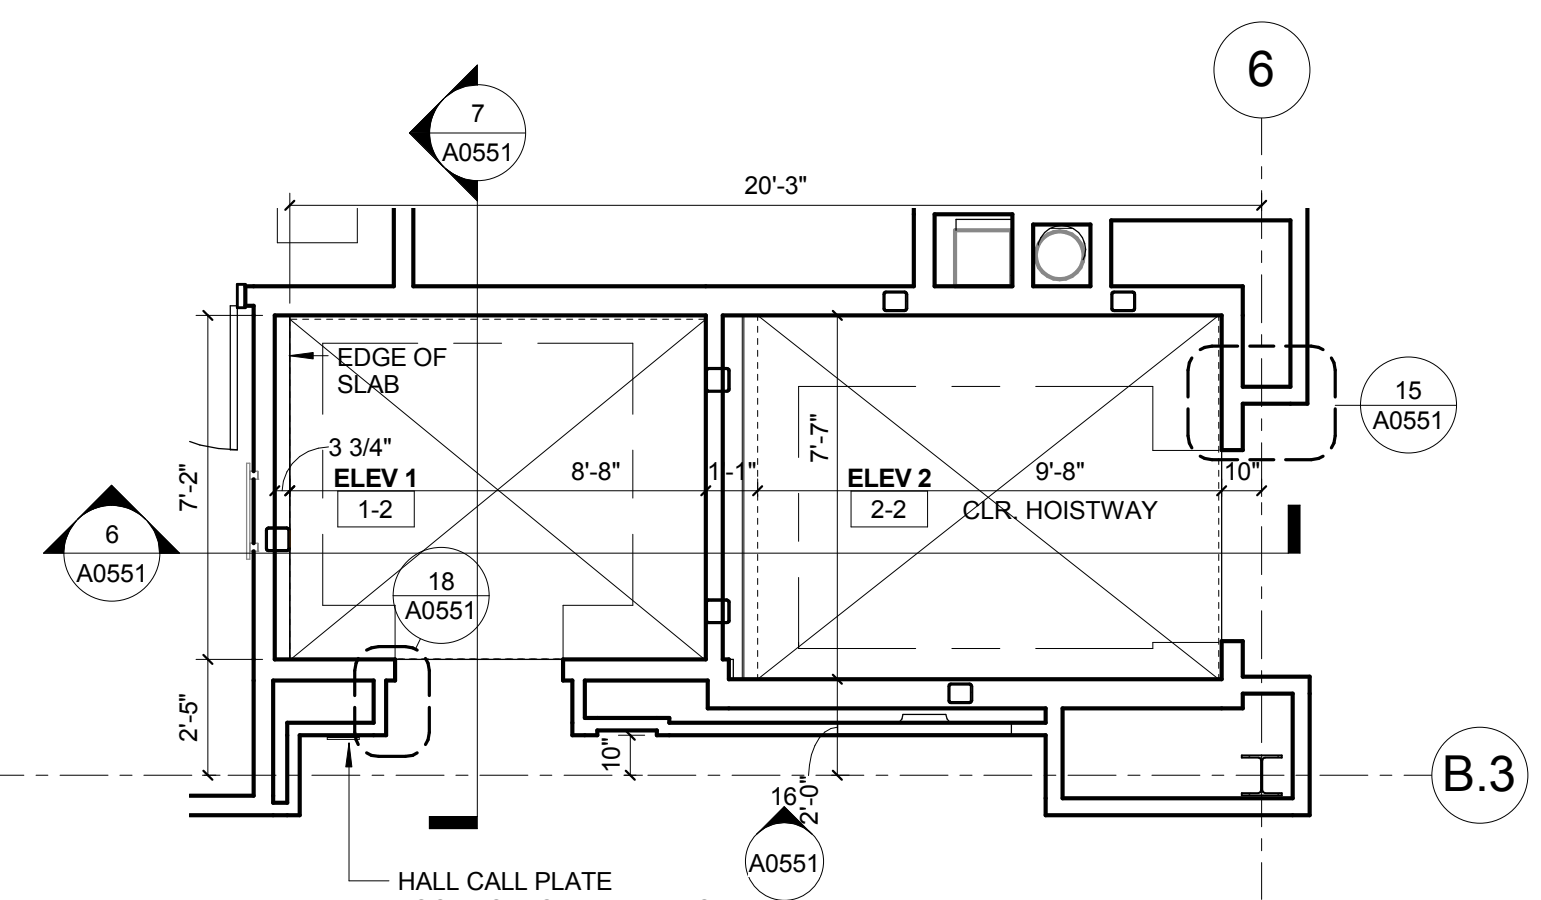

3 LEVEL 02 ENLARGED ELEVATOR PLAN
1/4" = 1'-0"

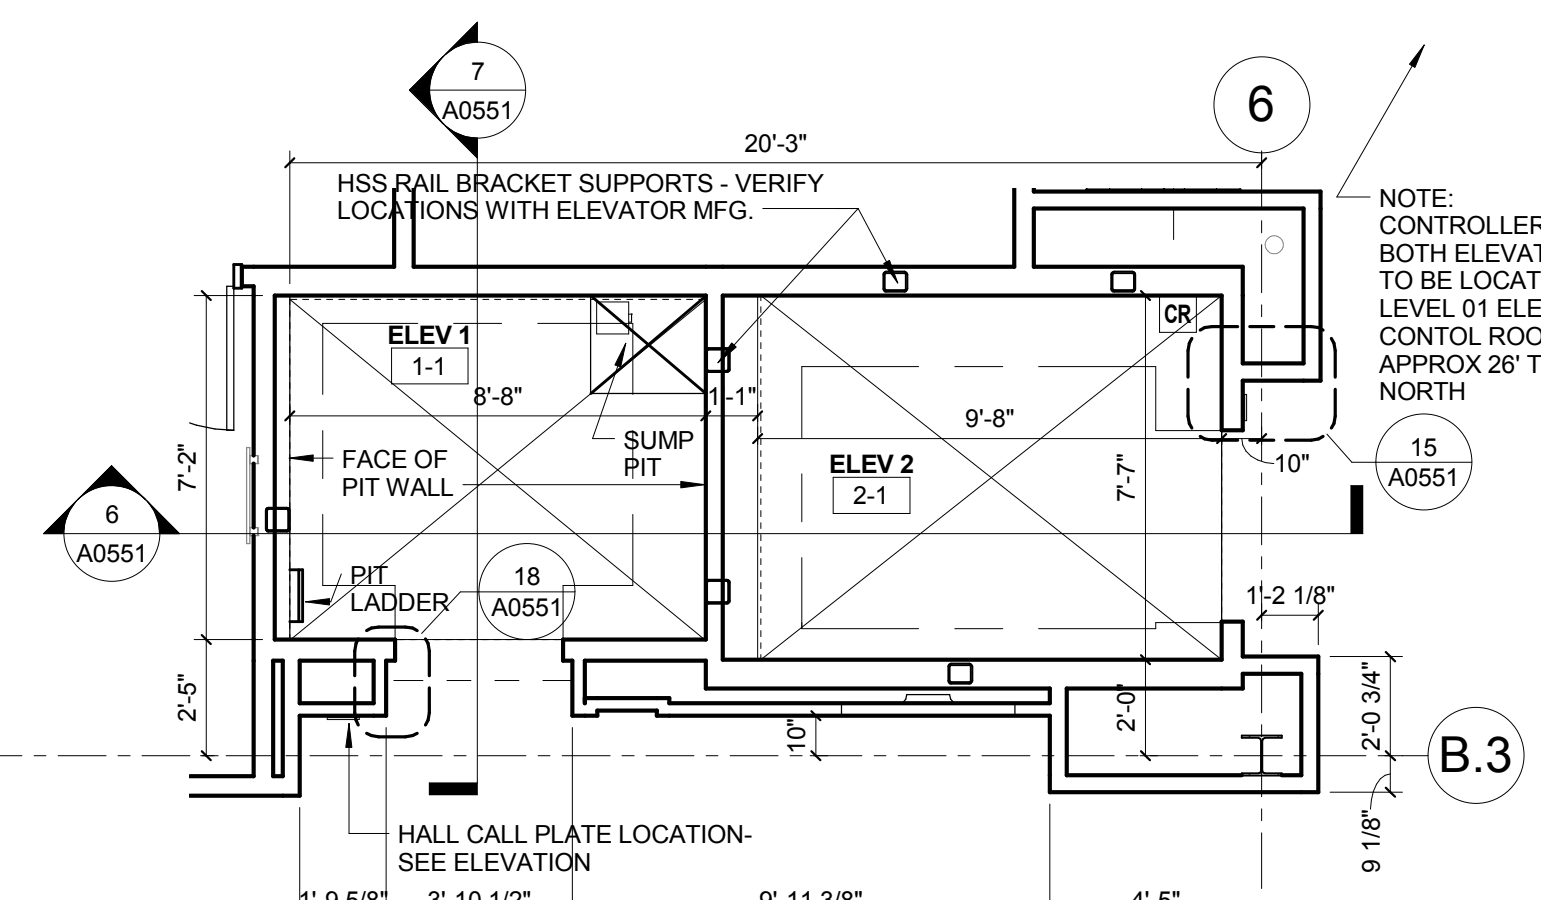

2 LEVEL 01 ENLARGED ELEVATOR PLAN
1/4" = 1'-0"

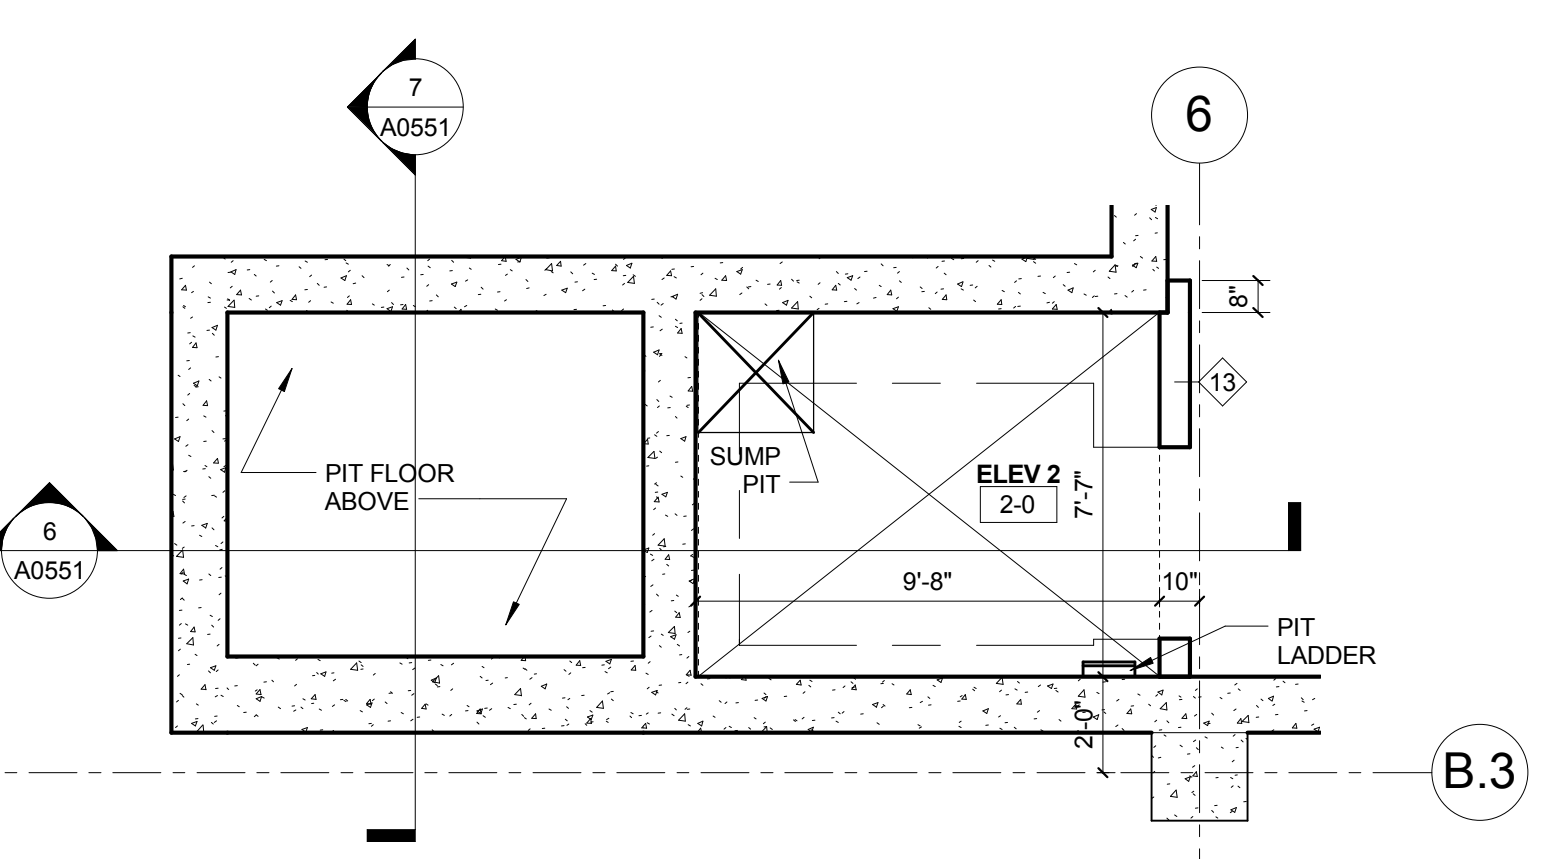

1 LEVEL 00 ENLARGED ELEVATOR PLAN
1/4" = 1'-0"