



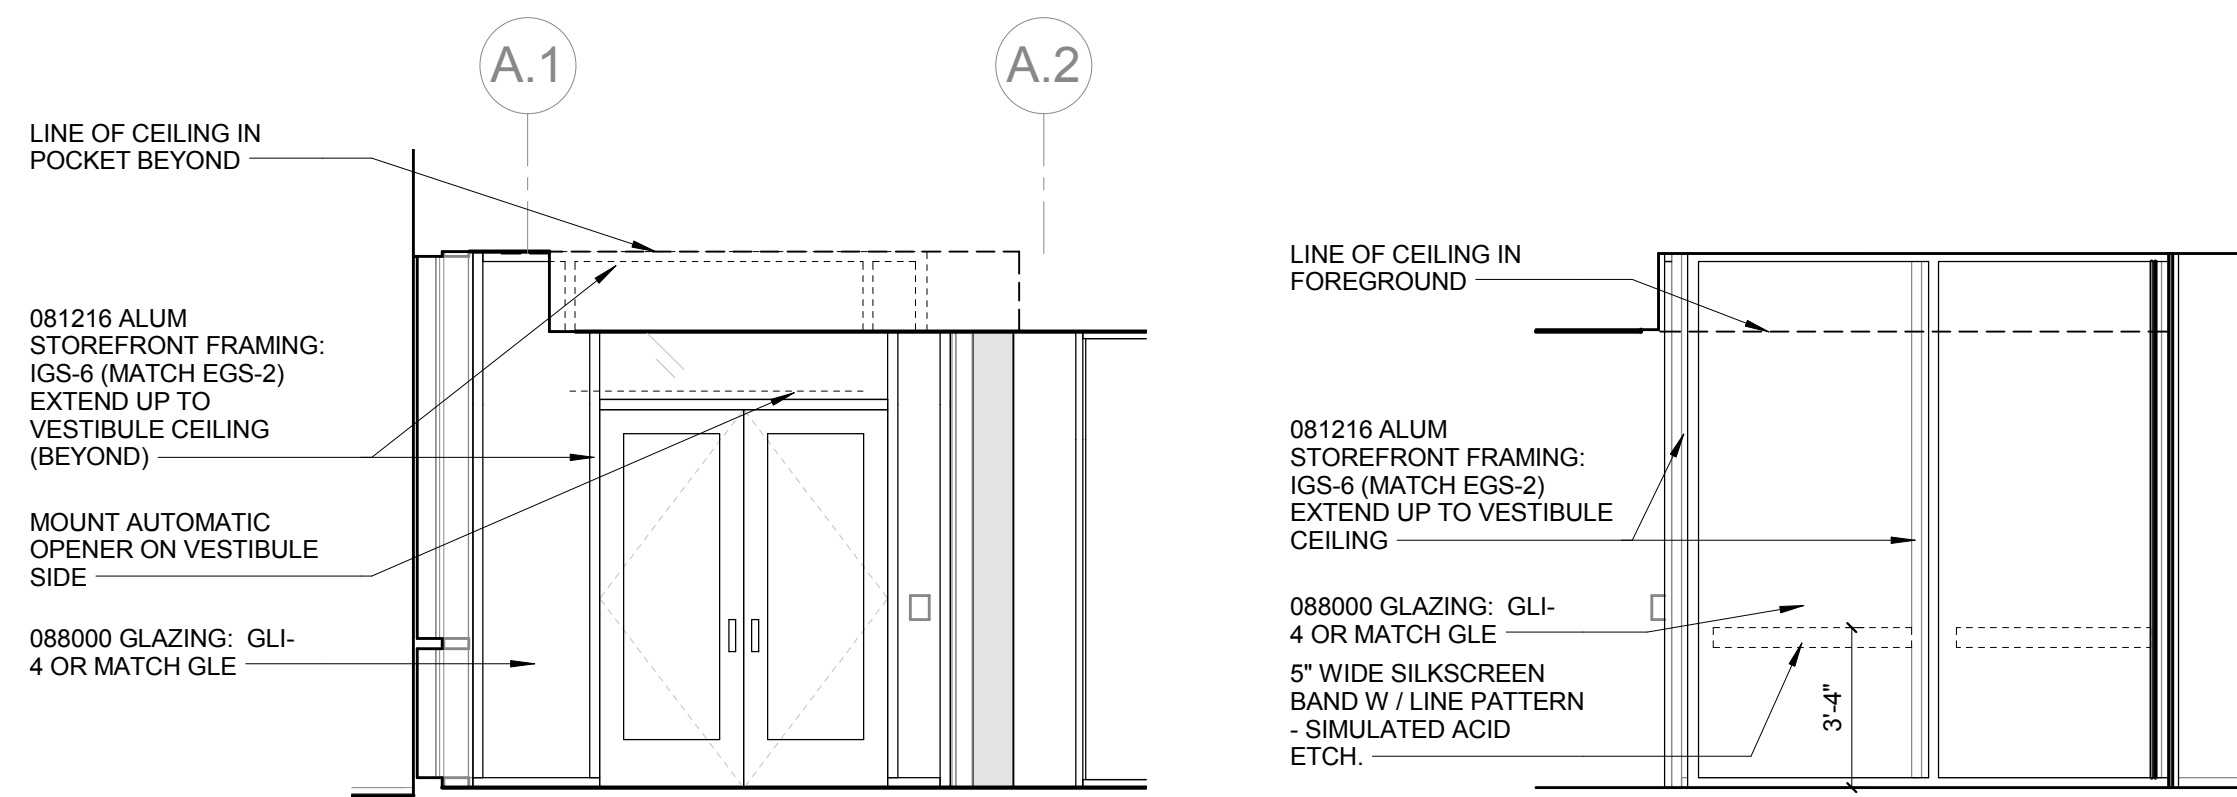


12 LOBBY C250 ELEVATION - WEST
1/4" = 1'-0"

11 CORRIDOR C230 - SOUTH
1/4" = 1'-0"

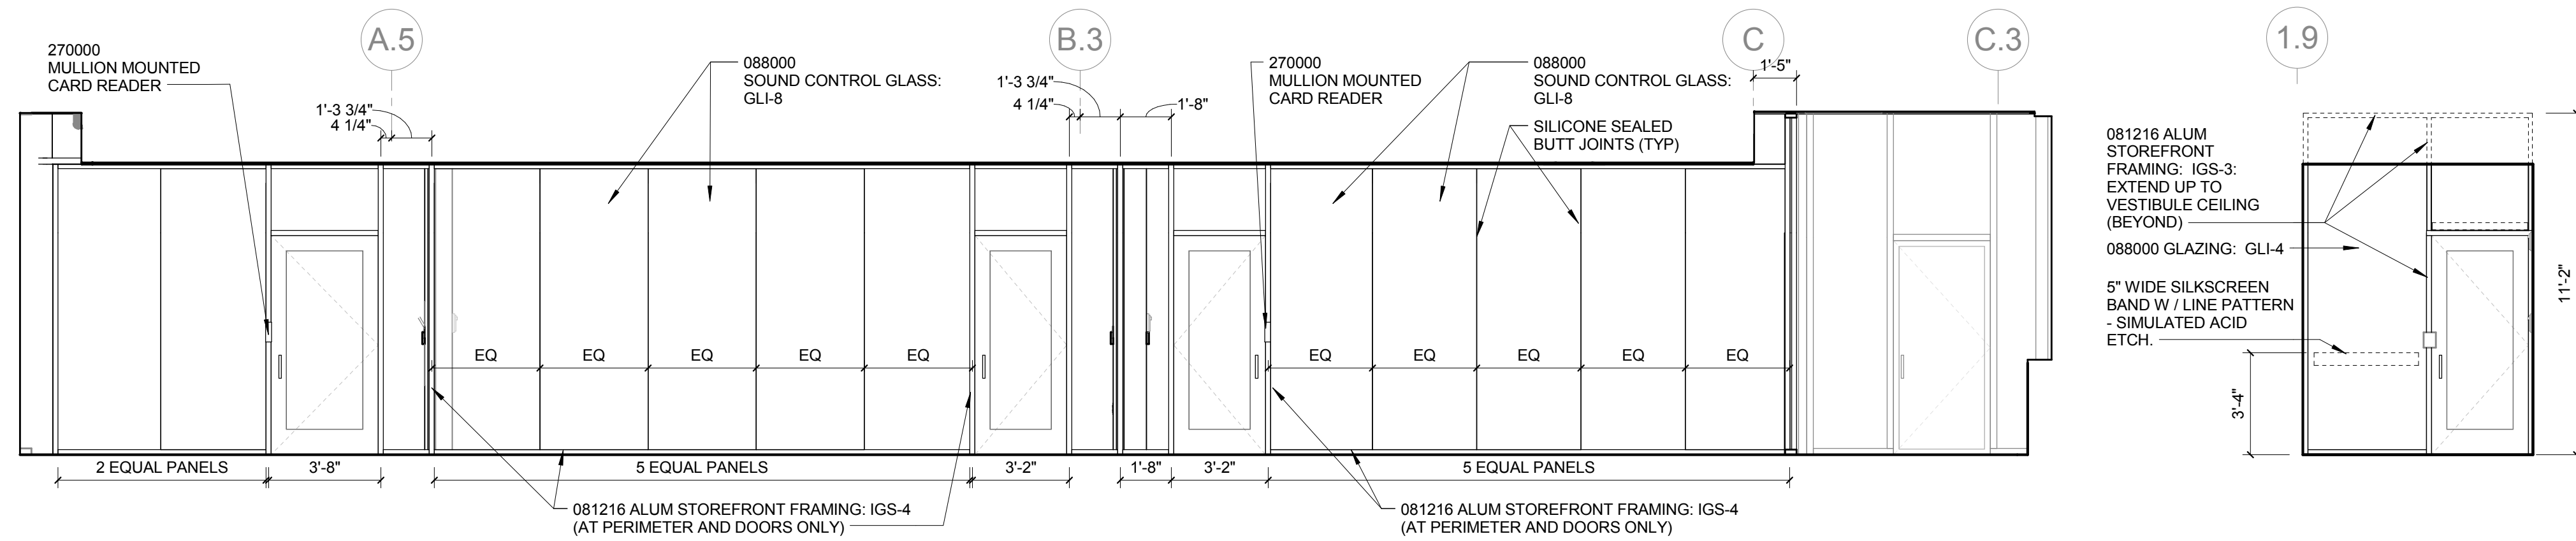


10 L02 CLASSROOM CORRIDOR - WEST
1/4" = 1'-0"


9 ENTRY C230 ELEVATION
1/4" = 1'-0"

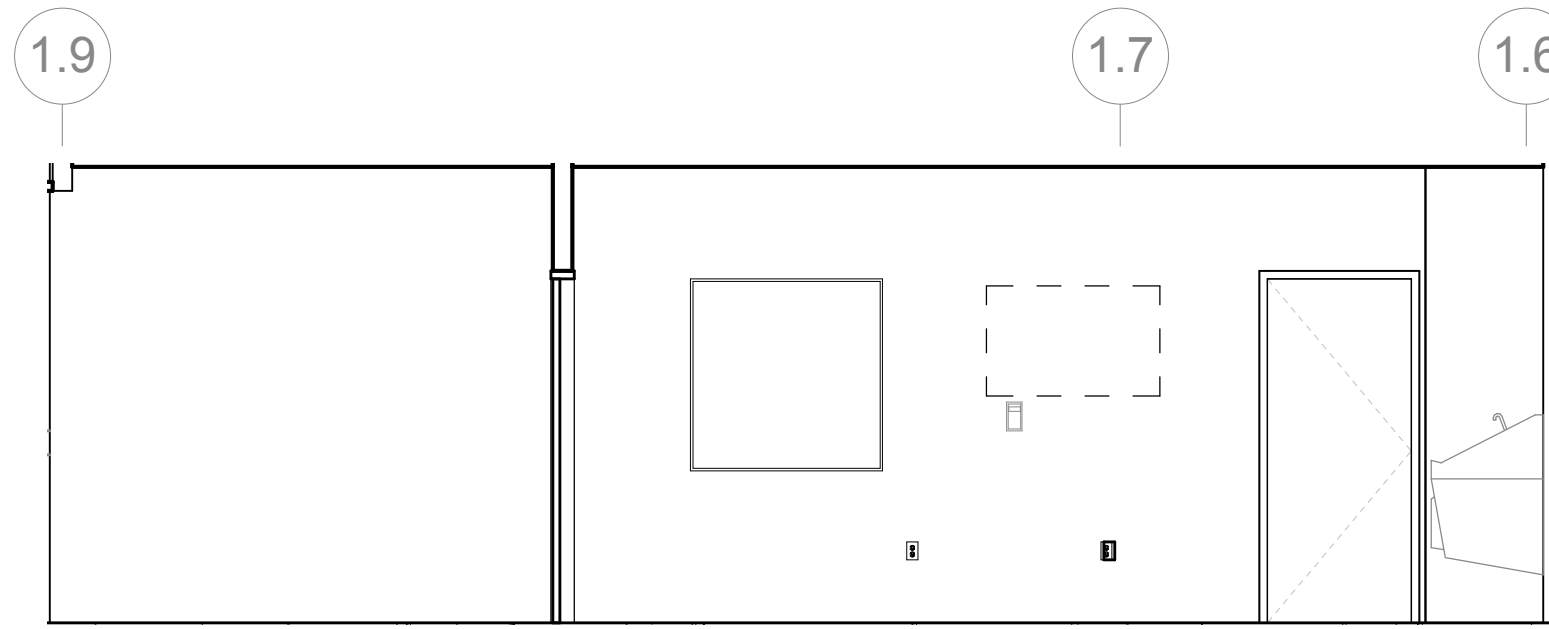


8 CLASSROOM - TEACHING WALL
1/4" = 1'-0"

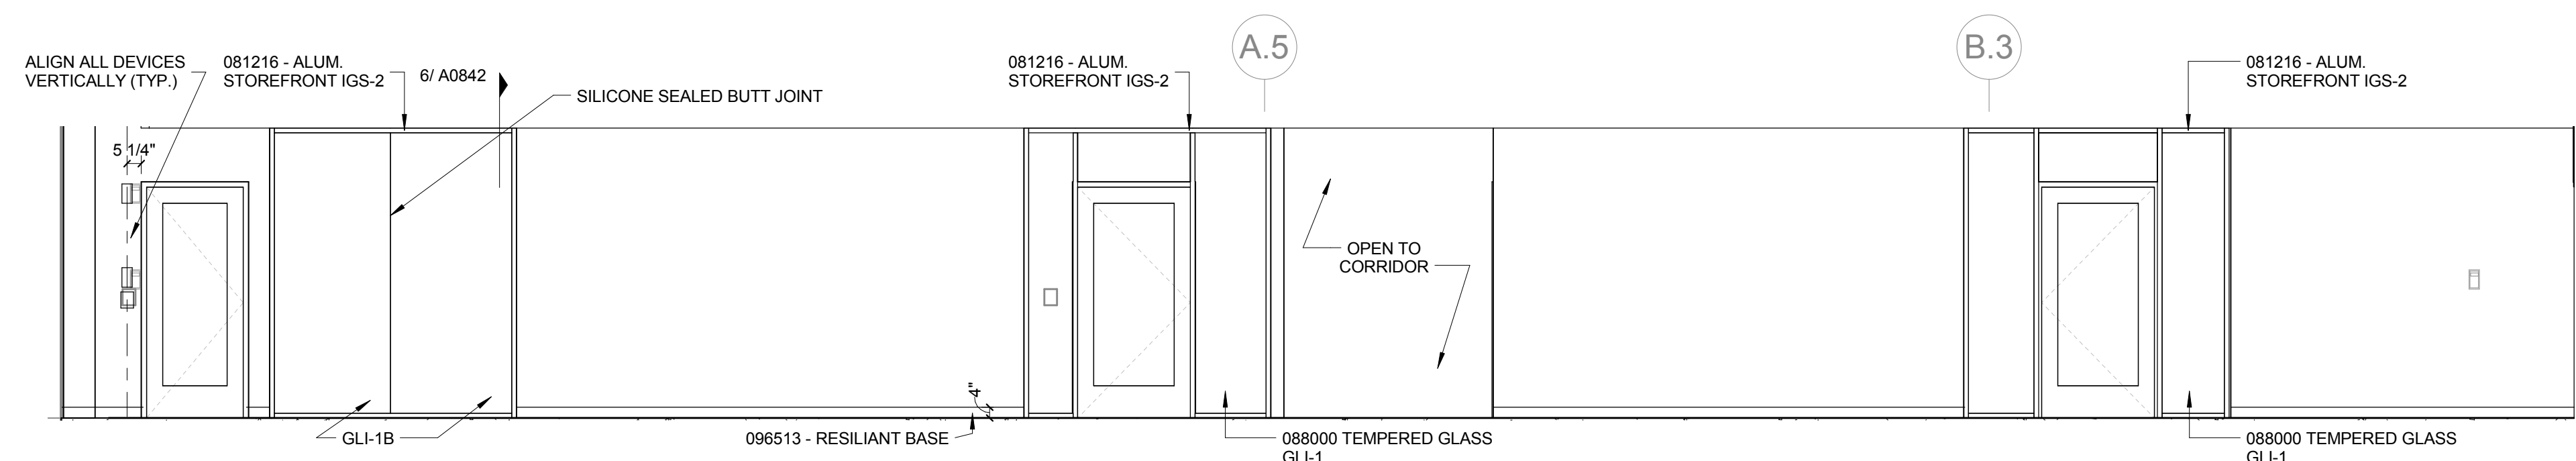


7 L01 PUBLIC CORRIDOR - WEST
1/4" = 1'-0"

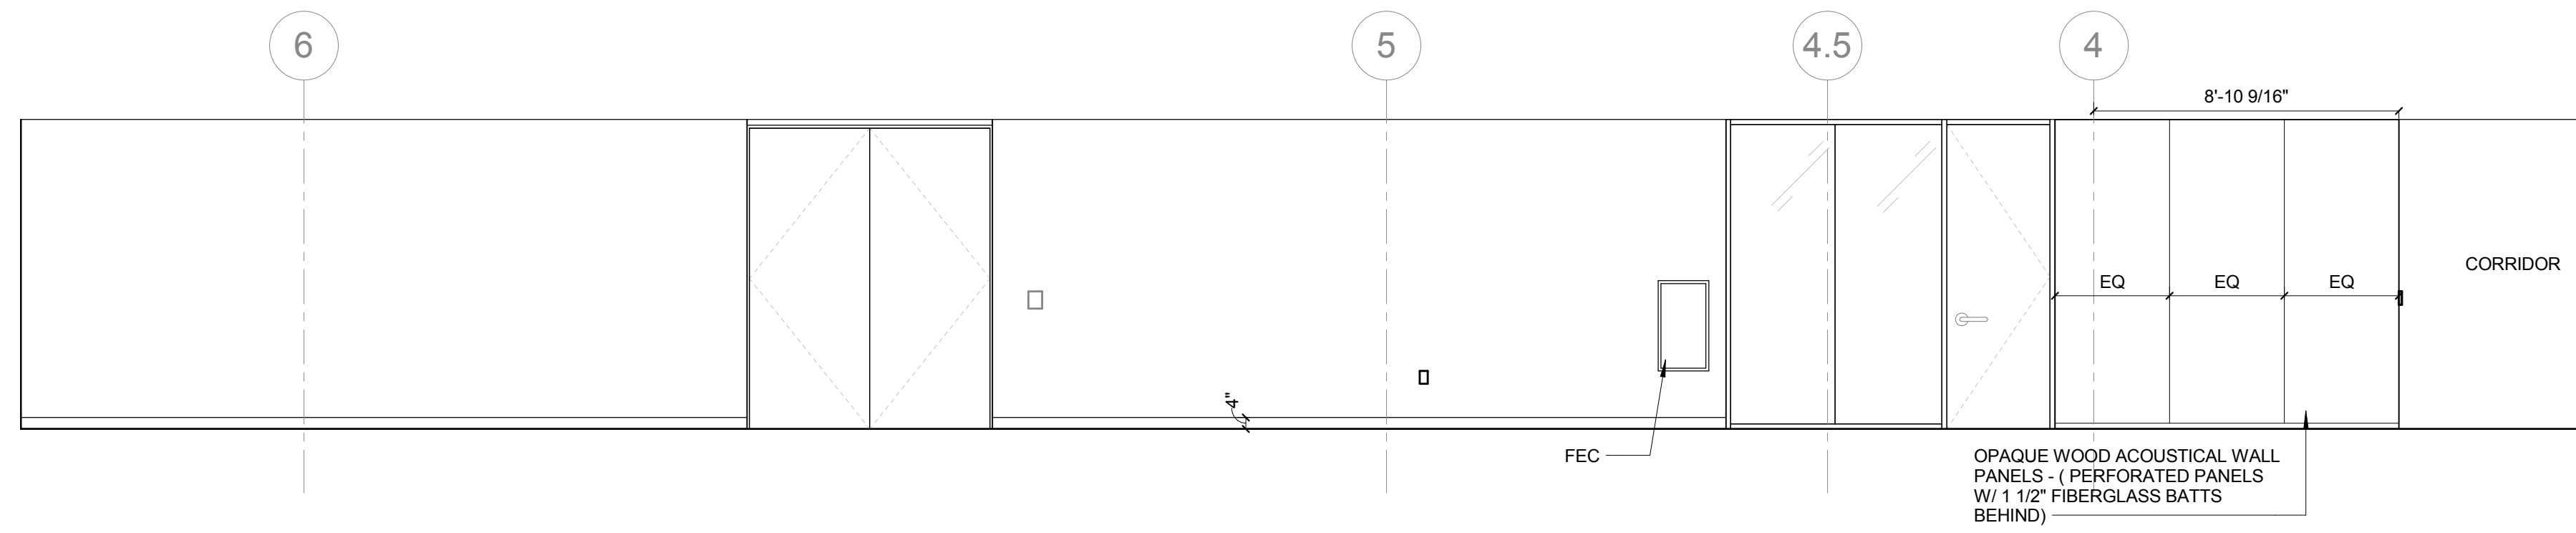


6 L01 PUBLIC CORRIDOR - SOUTH
1/4" = 1'-0"

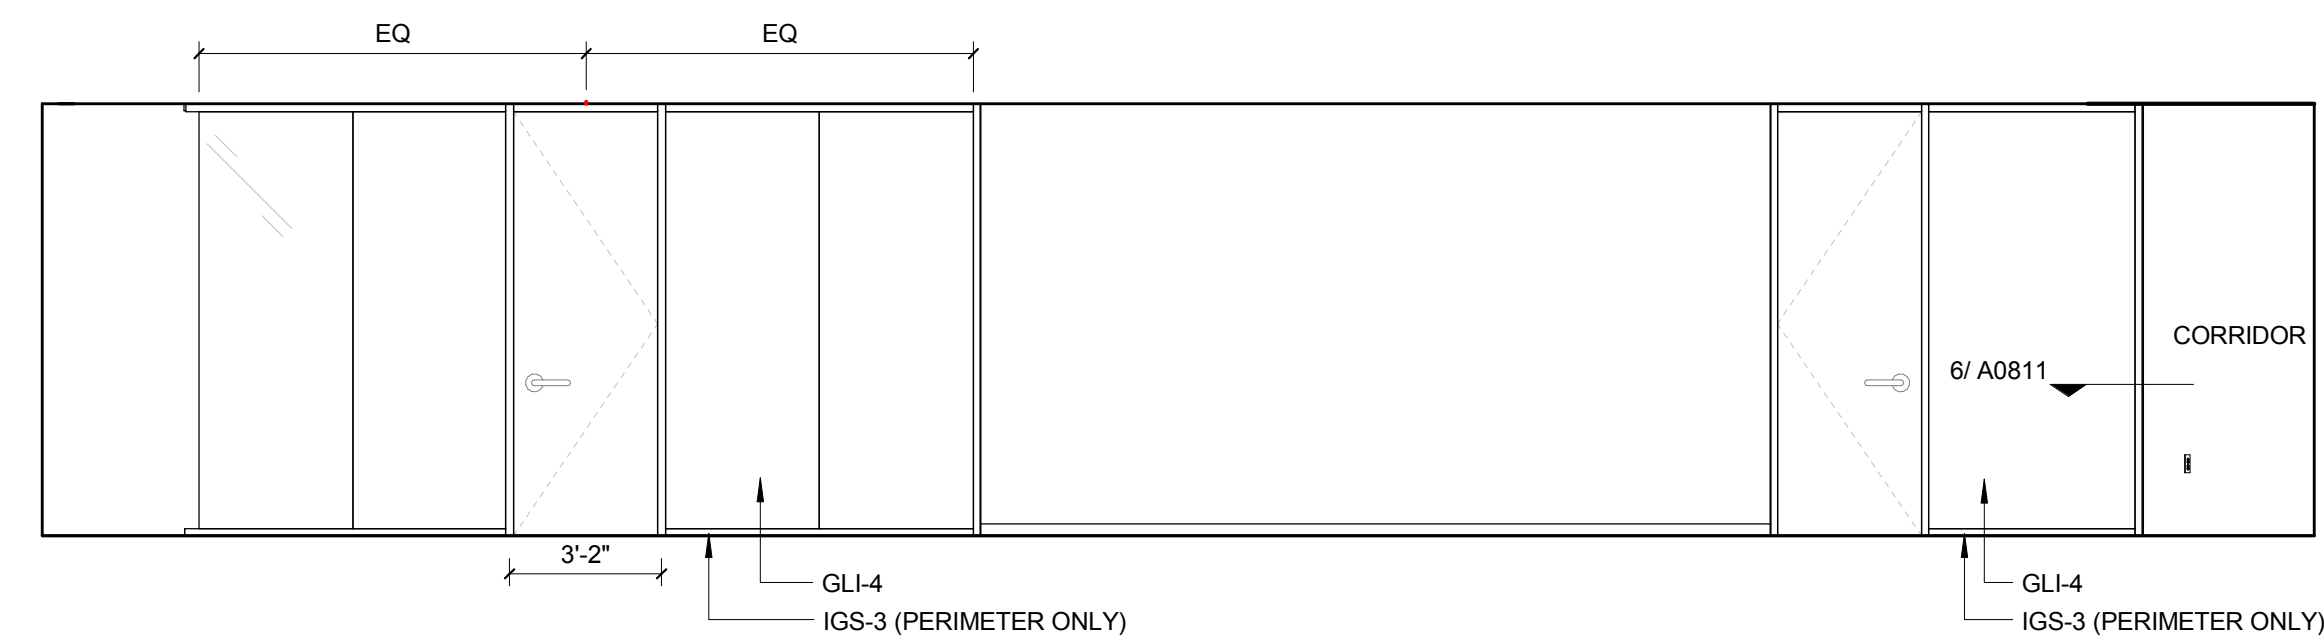

5 L01 CONFERENCE ROOM CORRIDOR ELEVATION - SOUTH
1/4" = 1'-0"

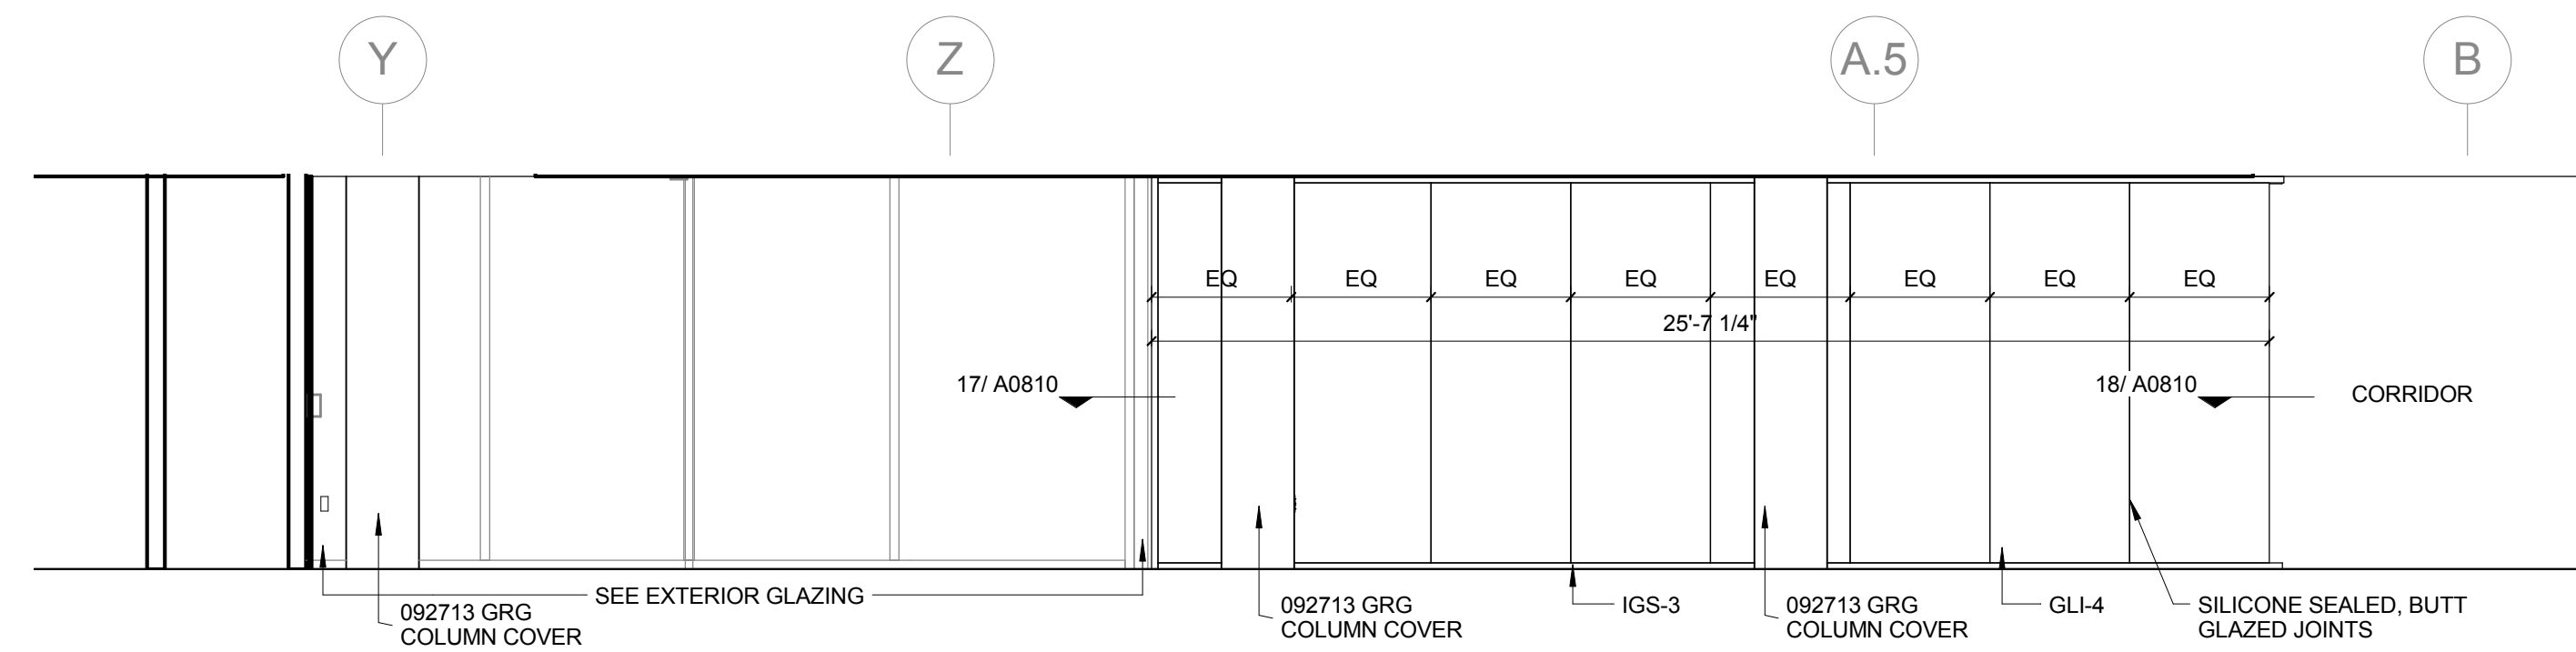

4 L01 PUBLIC SPACE ELEVATION - WEST
1/4" = 1'-0"

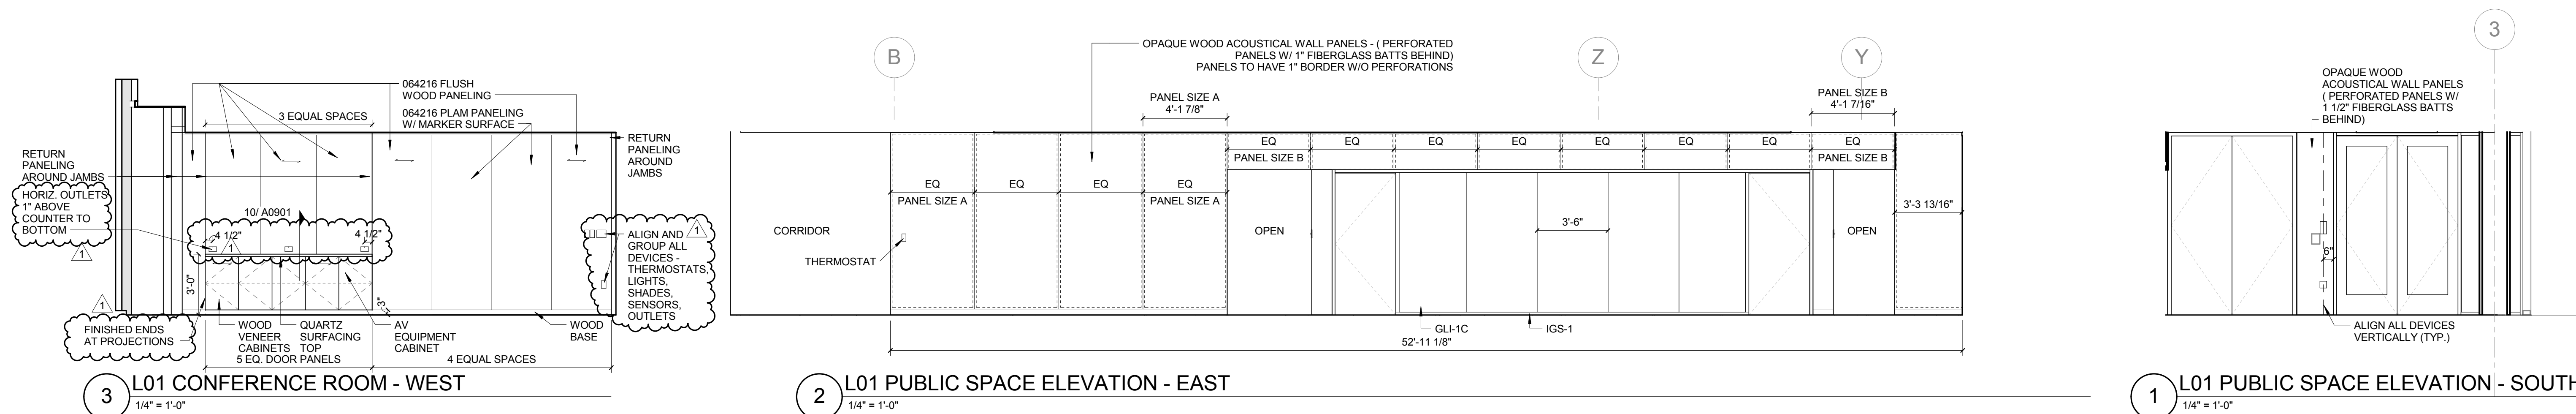

3 L01 CONFERENCE ROOM - WEST
1/4" = 1'-0"

2 L01 PUBLIC SPACE ELEVATION - EAST
1/4" = 1'-0"

1 L01 PUBLIC SPACE ELEVATION - SOUTH
1/4" = 1'-0"