



3 LECTURE HALL ENTRY
1/4" = 1'-0"


6 LECTURE HALL COORIDOR
1/4" = 1'-0"

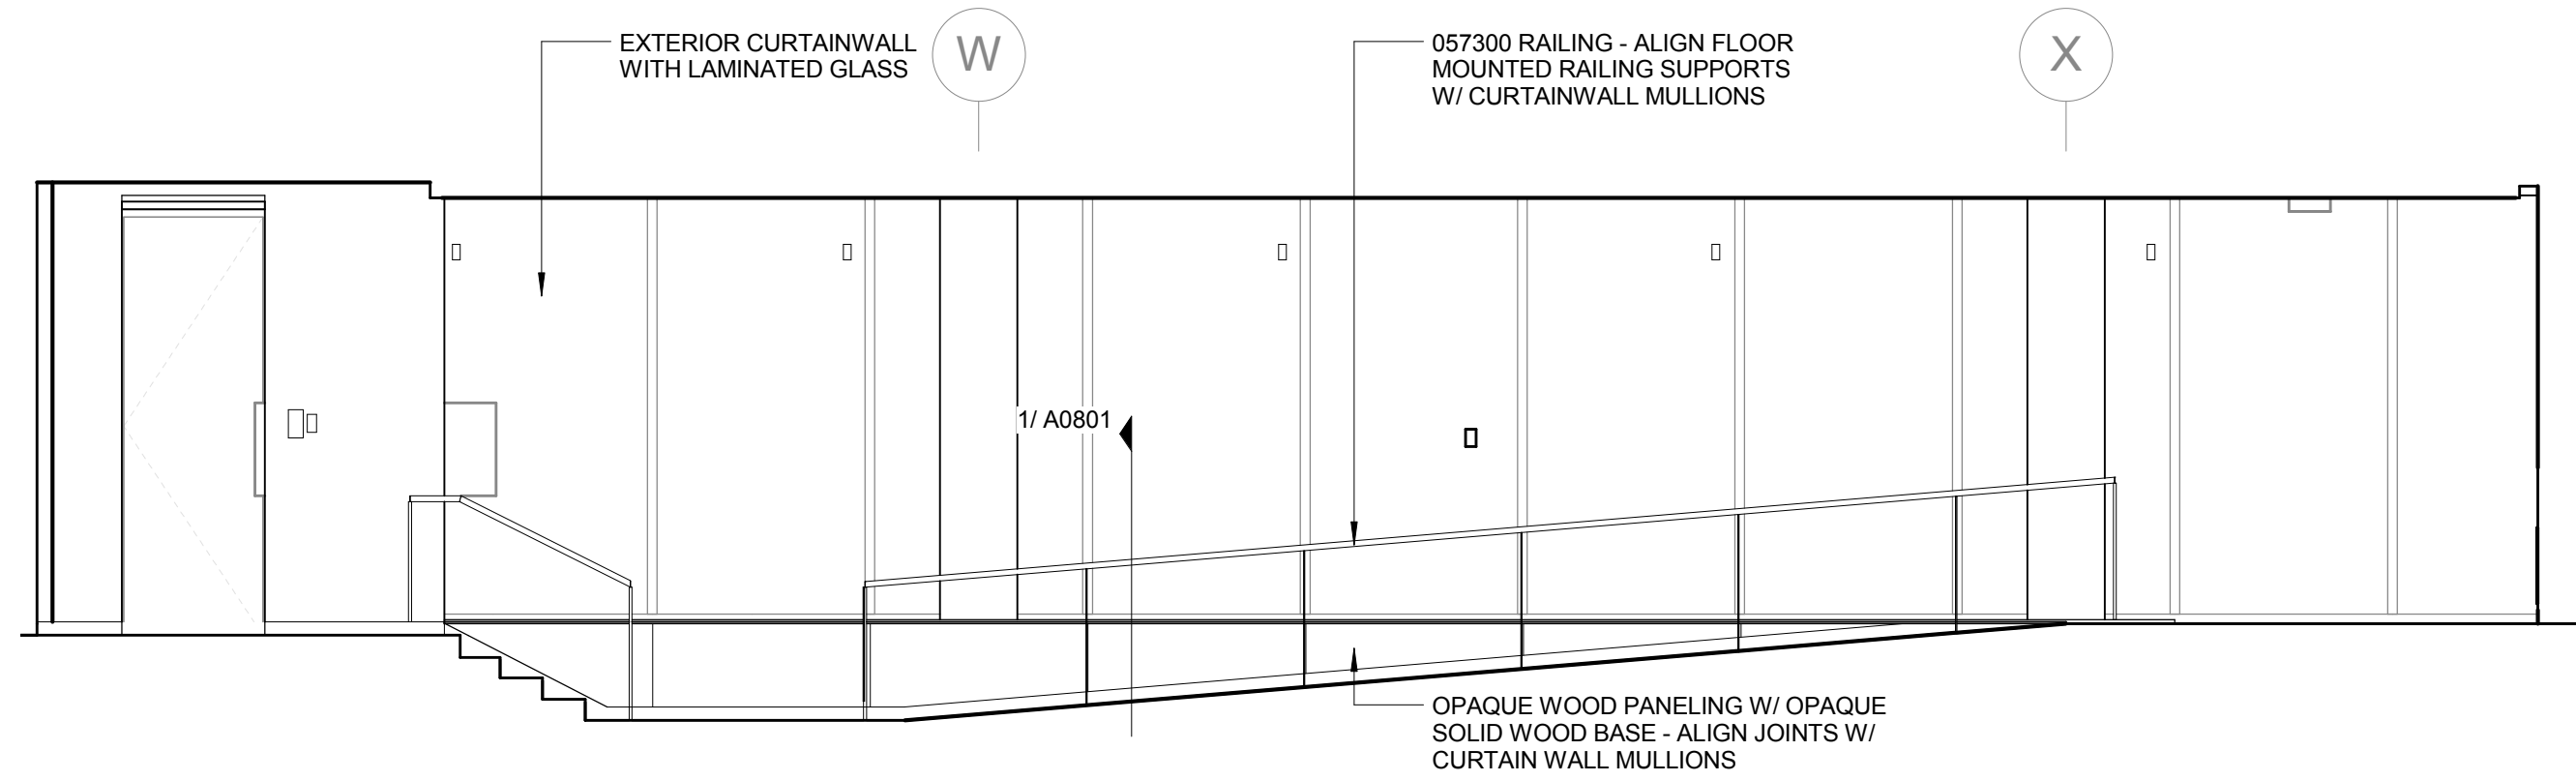


5 L01 LECTURE HALL ELEVATION - WEST
1/4" = 1'-0"

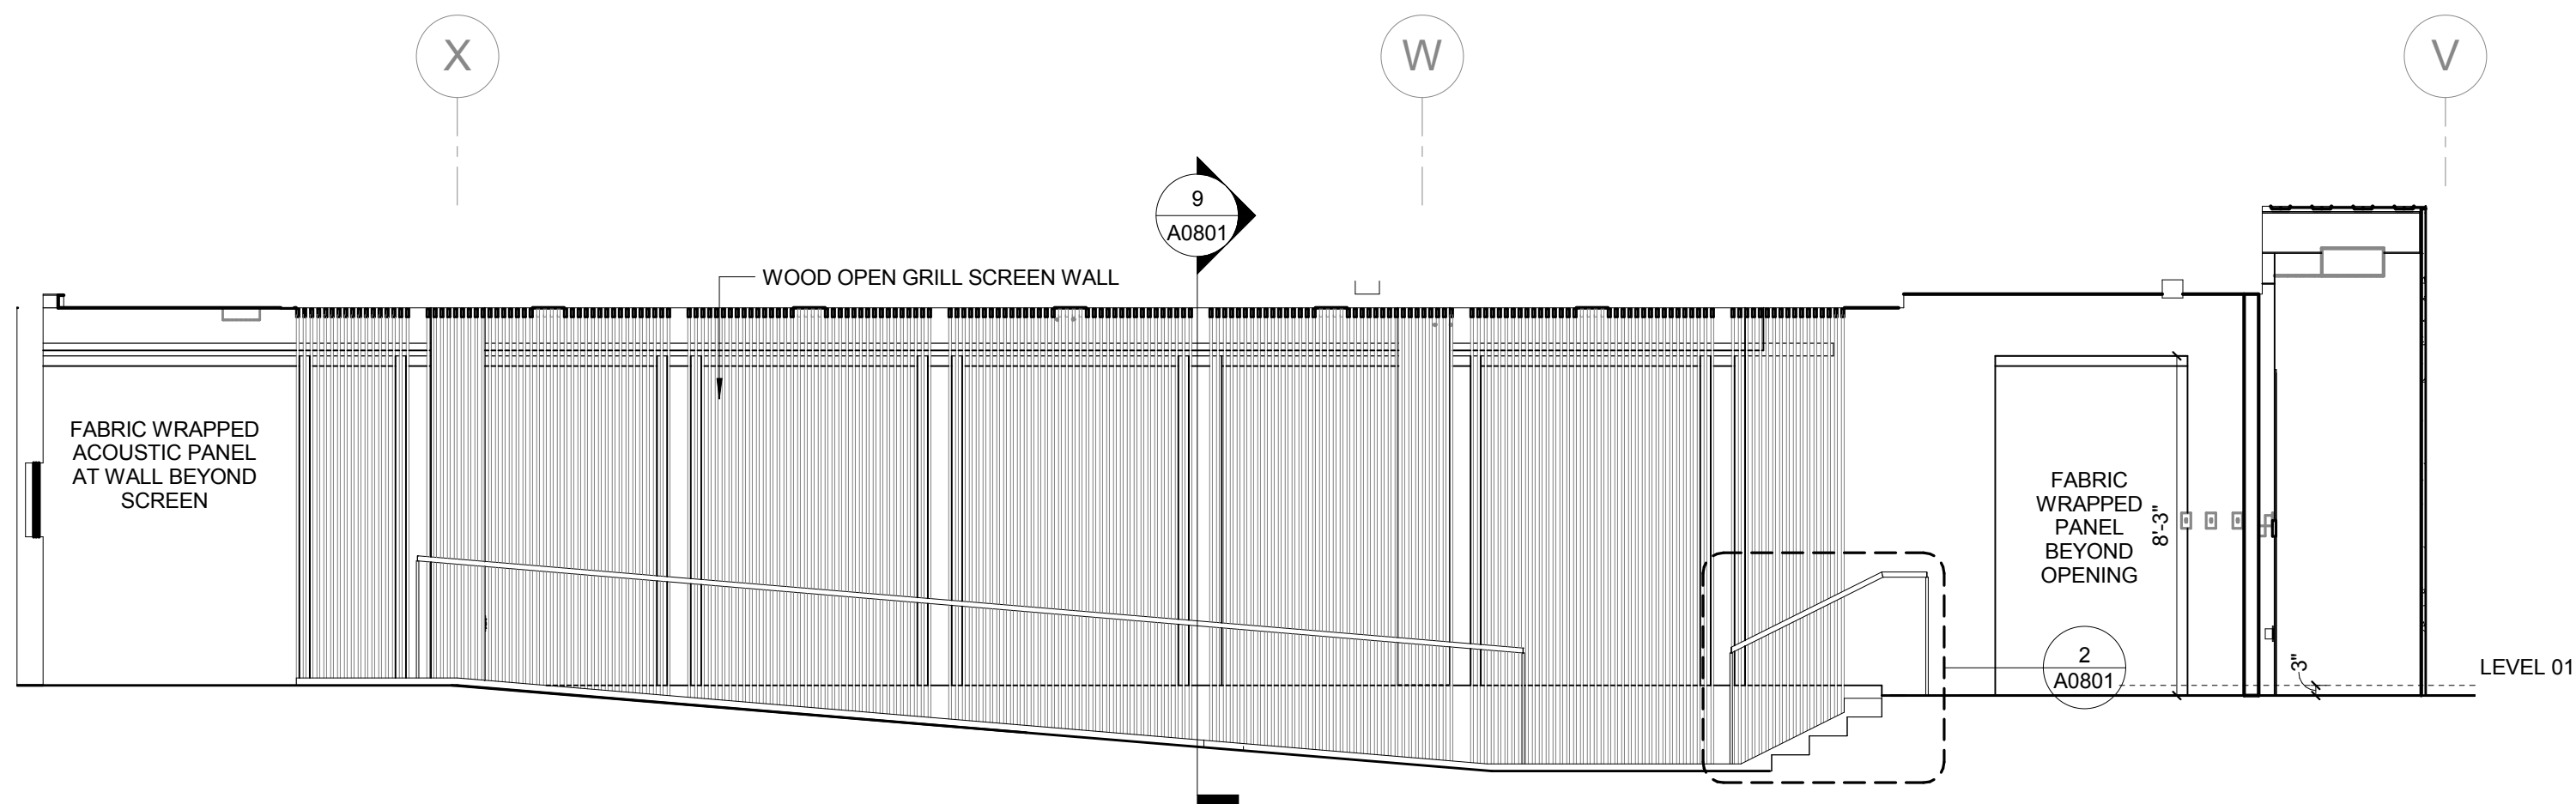


2 L01 LECTURE HALL ELEVATION - EAST
1/4" = 1'-0"

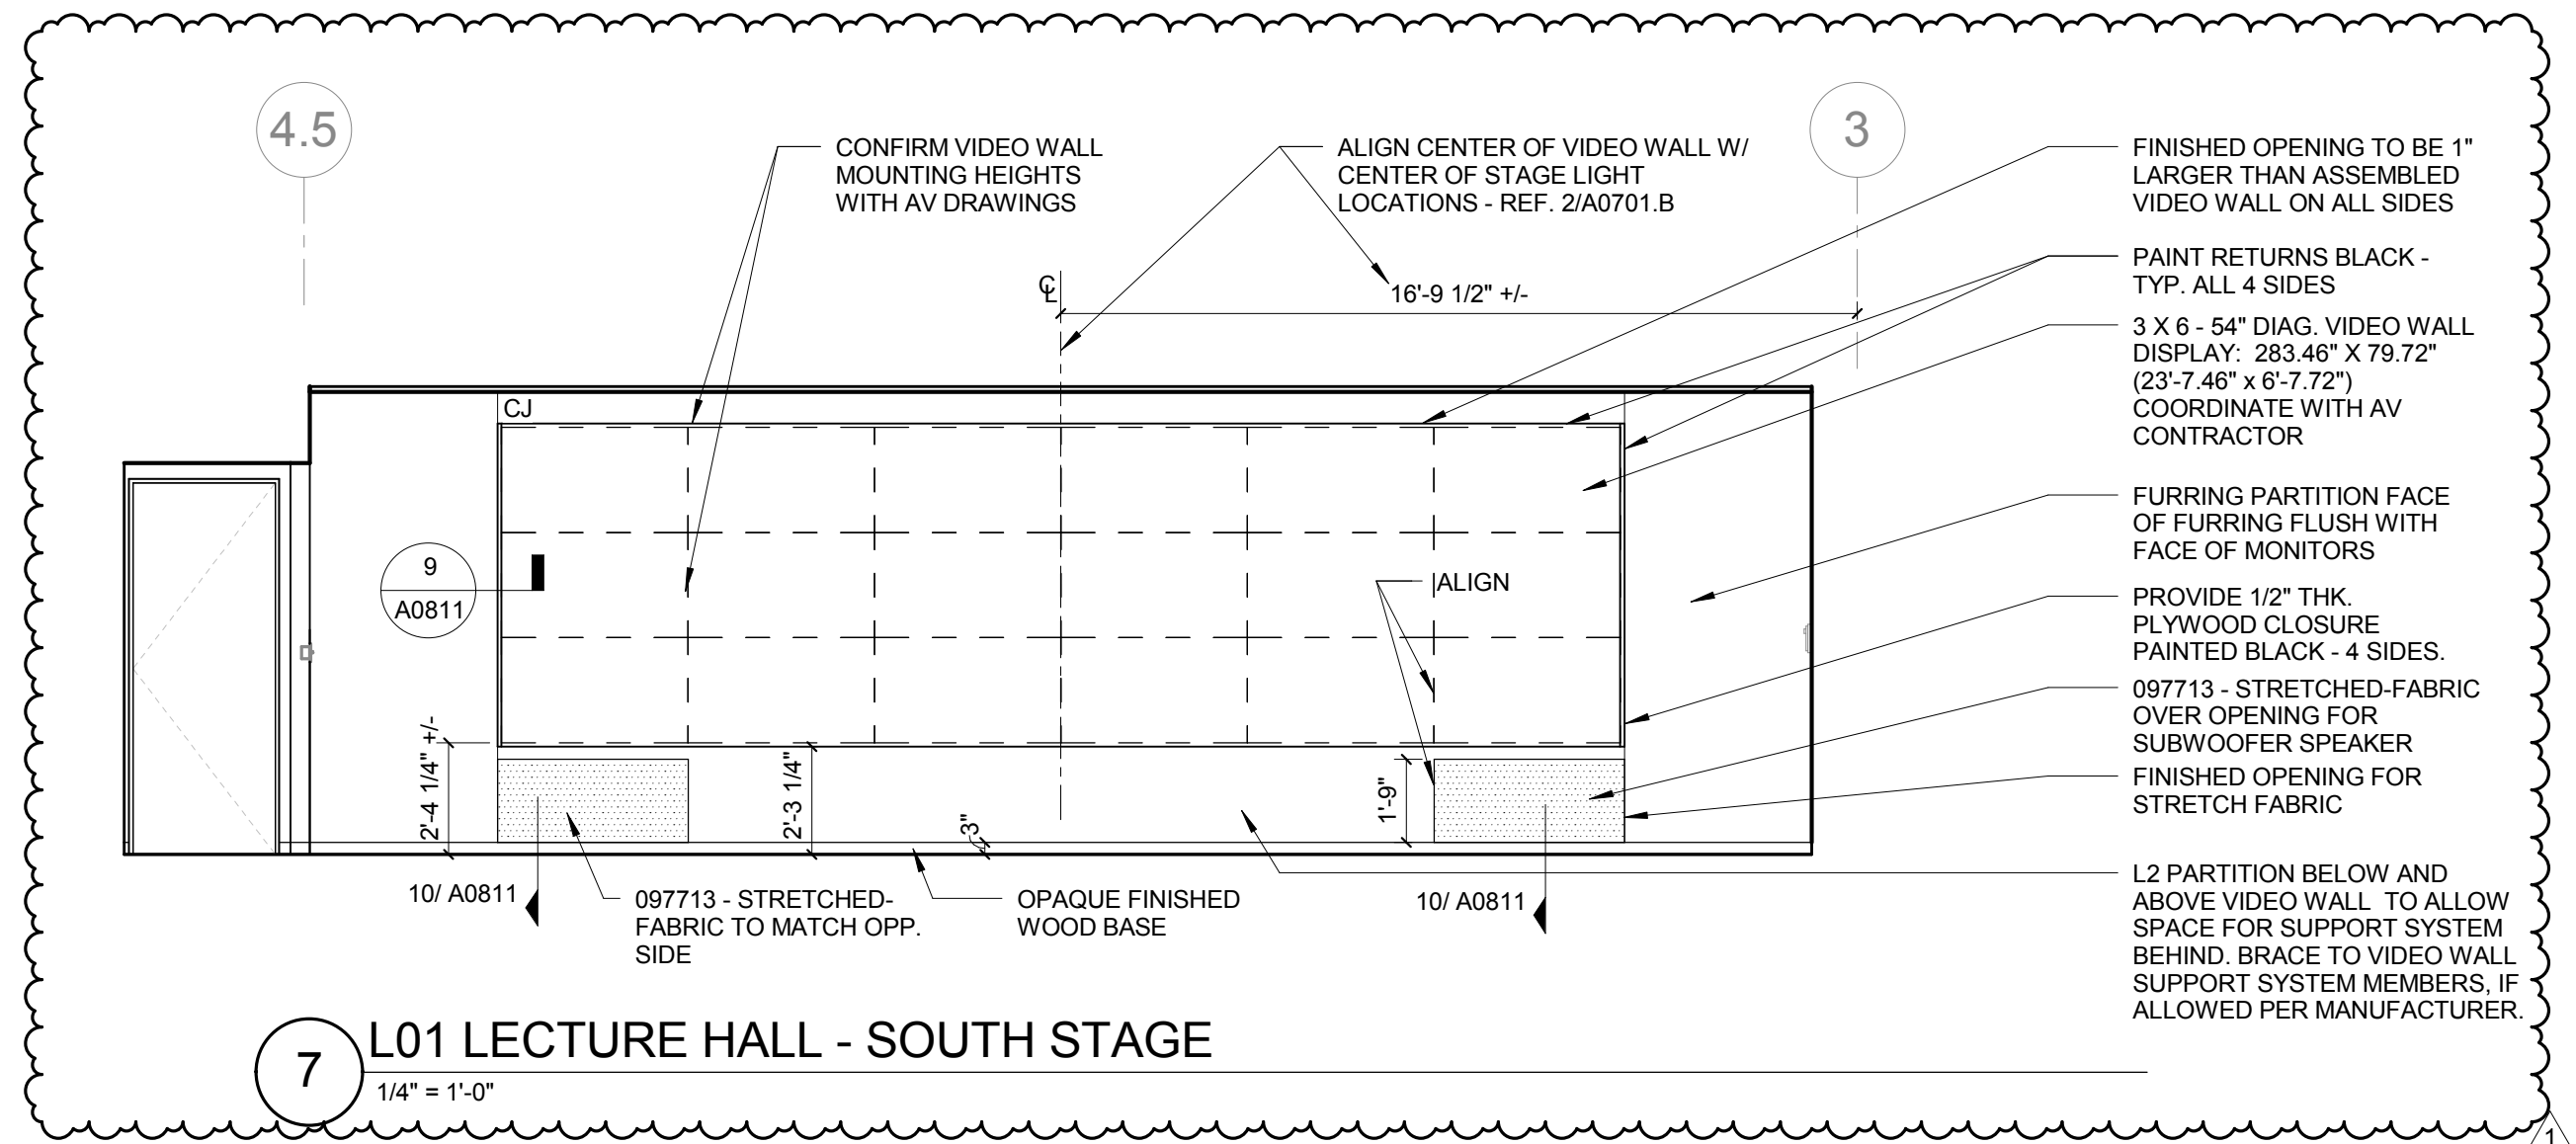

7 L01 LECTURE HALL - SOUTH STAGE
1/4" = 1'-0"

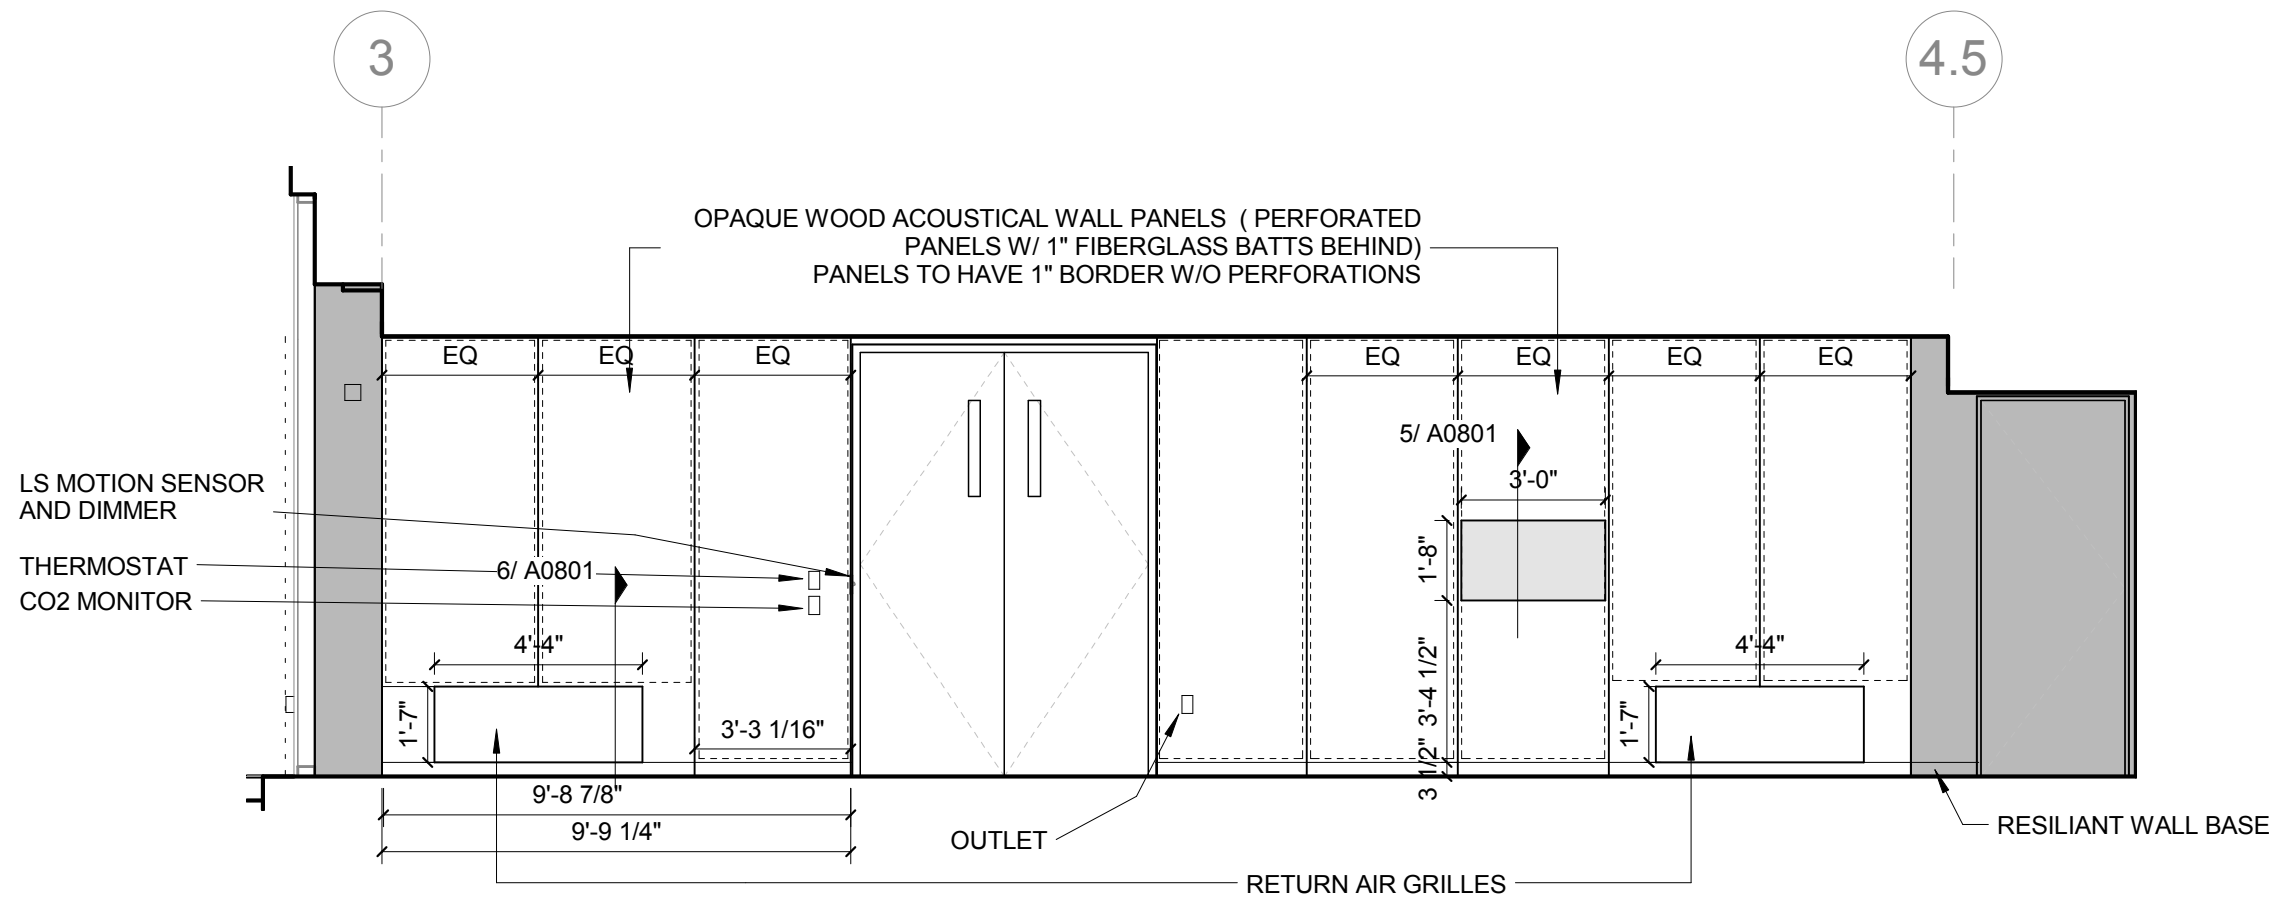

4 L01 LECTURE HALL ELEVATION - NORTH
1/4" = 1'-0"

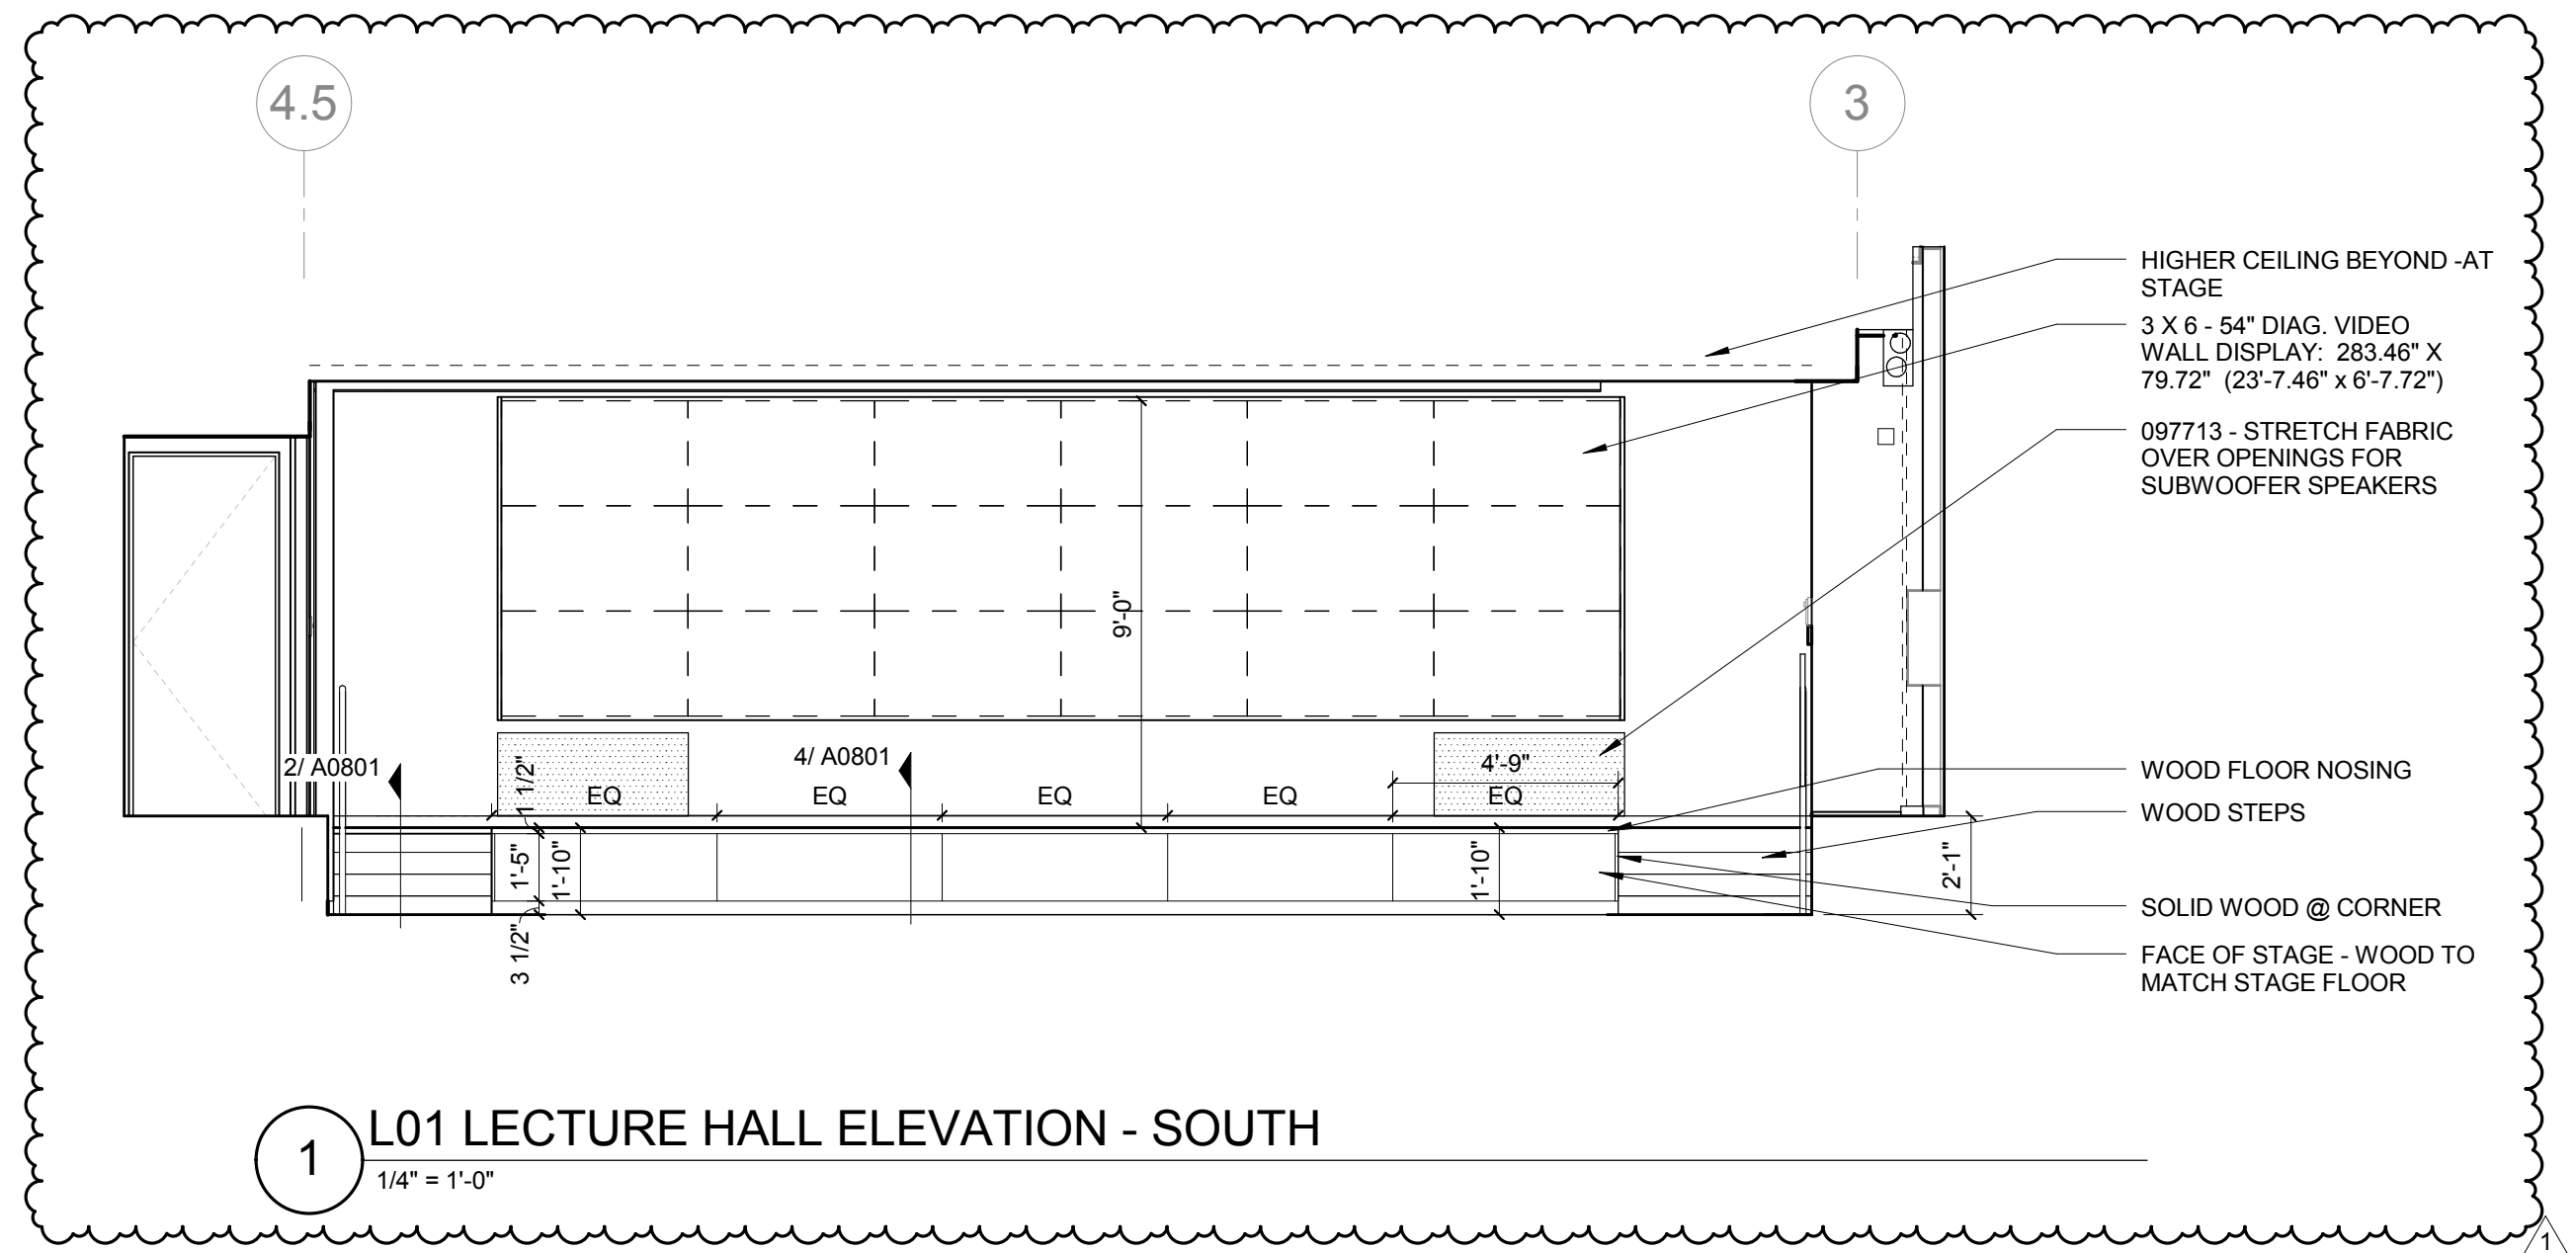

1 L01 LECTURE HALL ELEVATION - SOUTH
1/4" = 1'-0"

1	ASI-063	21 APR 2017
-	ISSUED FOR CONSTRUCTION (BP3)	15 MAR 2016
No.	Description	Date

Drawing Title:

INTERIOR ELEVATIONS
LECTURE HALL

Project No.: 04561.01

Checked by:

A0602