




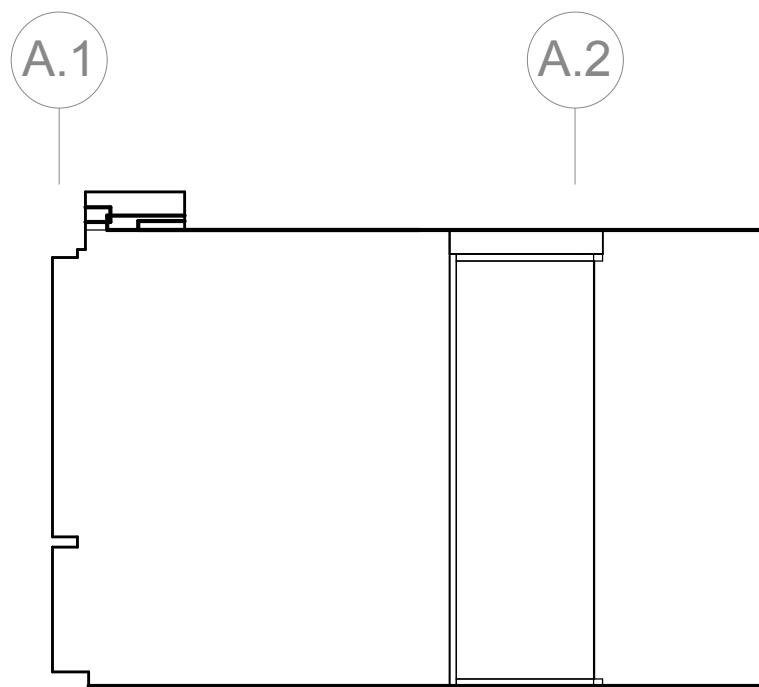


7 L04 CORR C450 - WEST
1/4" = 1'-0"

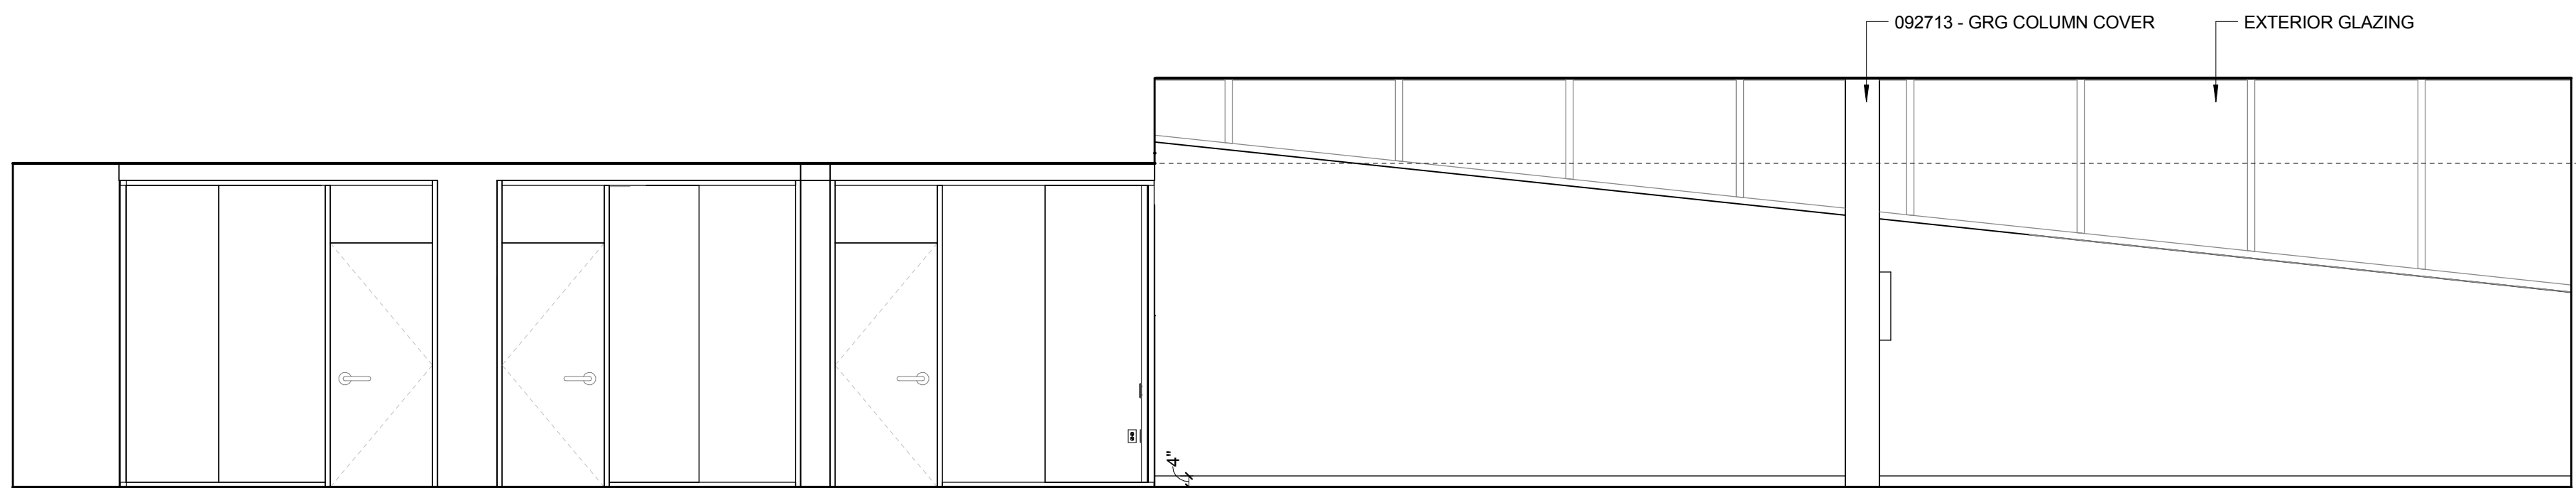


6 L04 CORR C450 - SOUTH
1/4" = 1'-0"

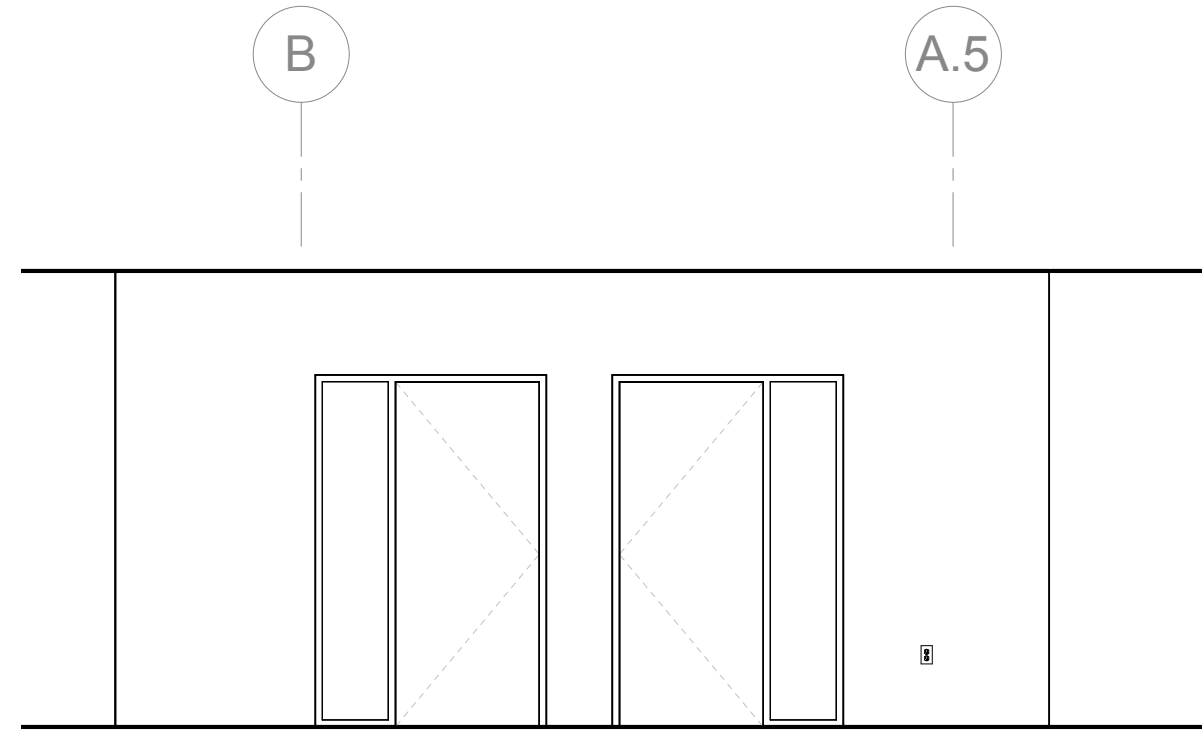


5 L04 CORR C430 - EAST
1/4" = 1'-0"

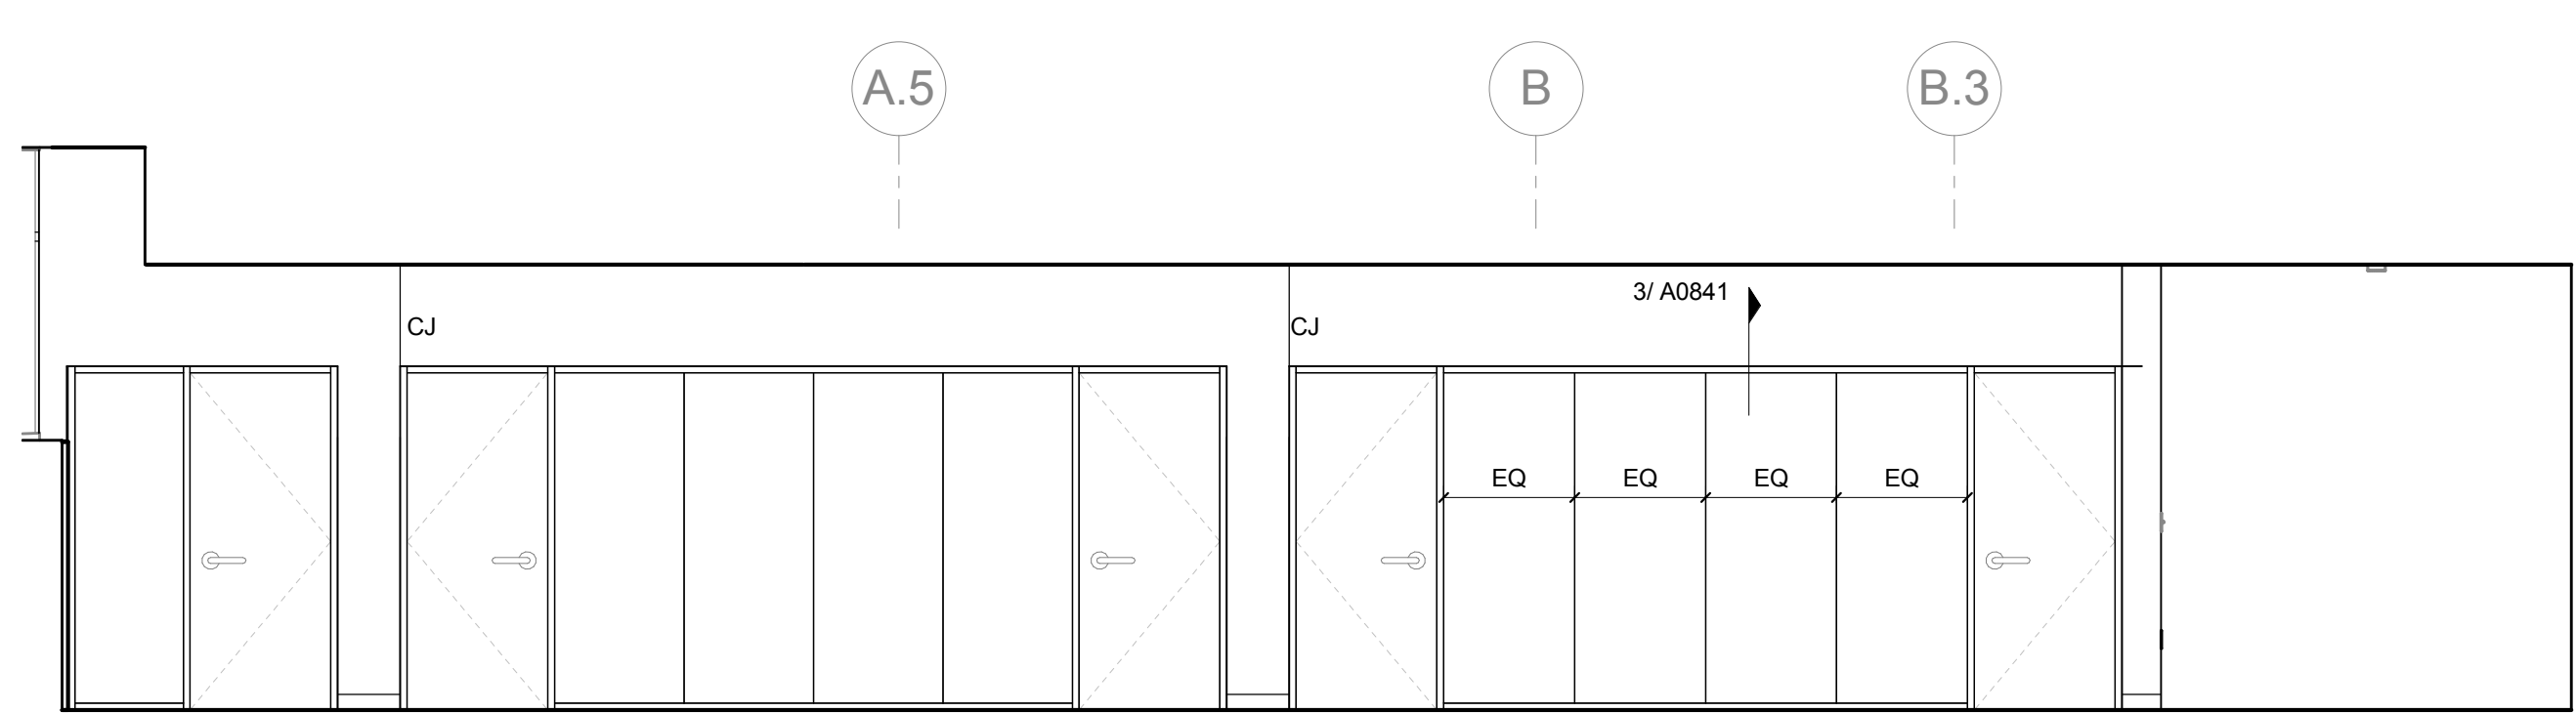


4 L04 CORR C430 - WEST
1/4" = 1'-0"

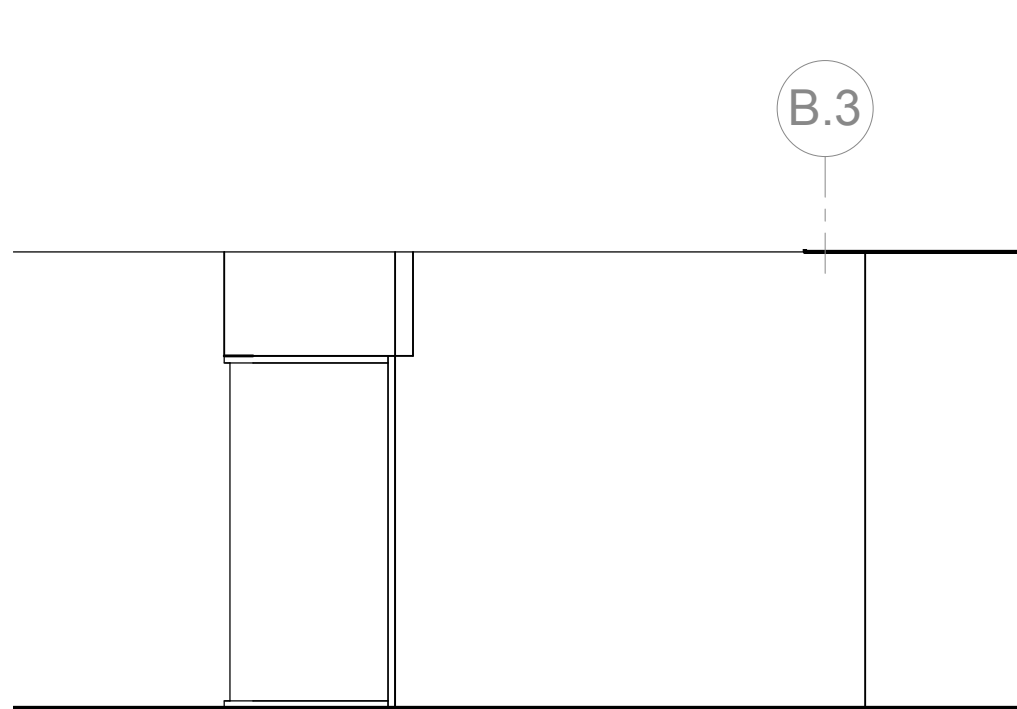

3 L04 CORR C410 - EAST
1/4" = 1'-0"

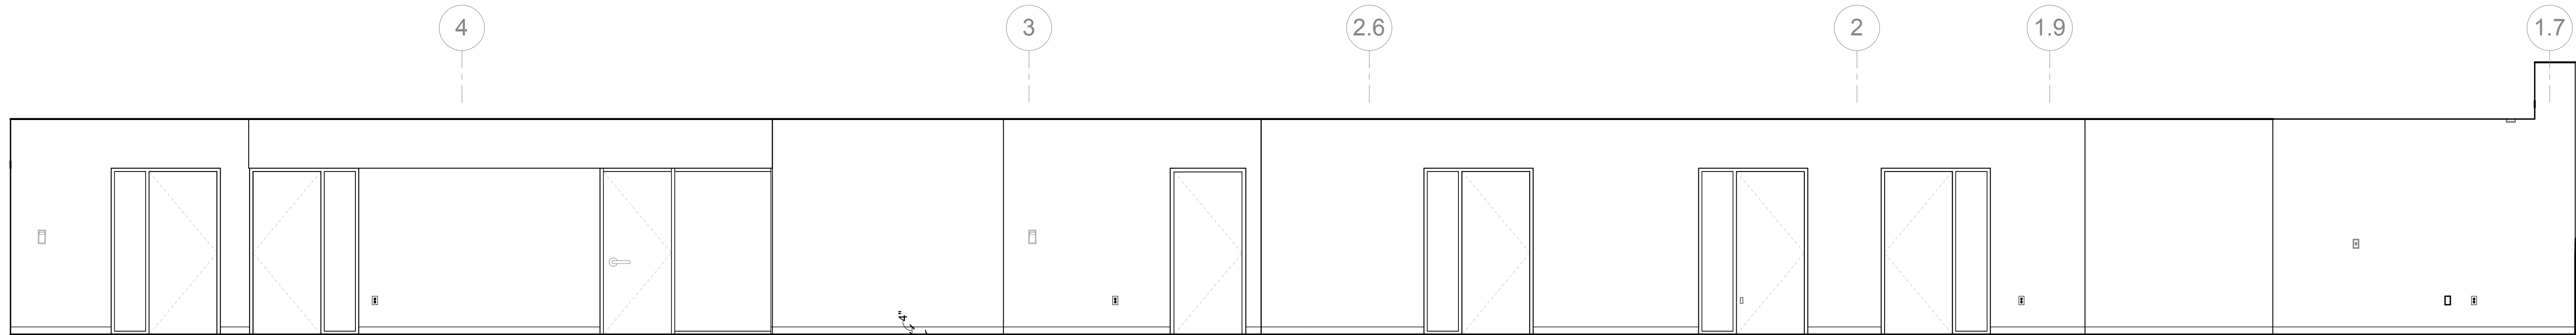

2 L04 CORR C410 - SOUTH
1/4" = 1'-0"

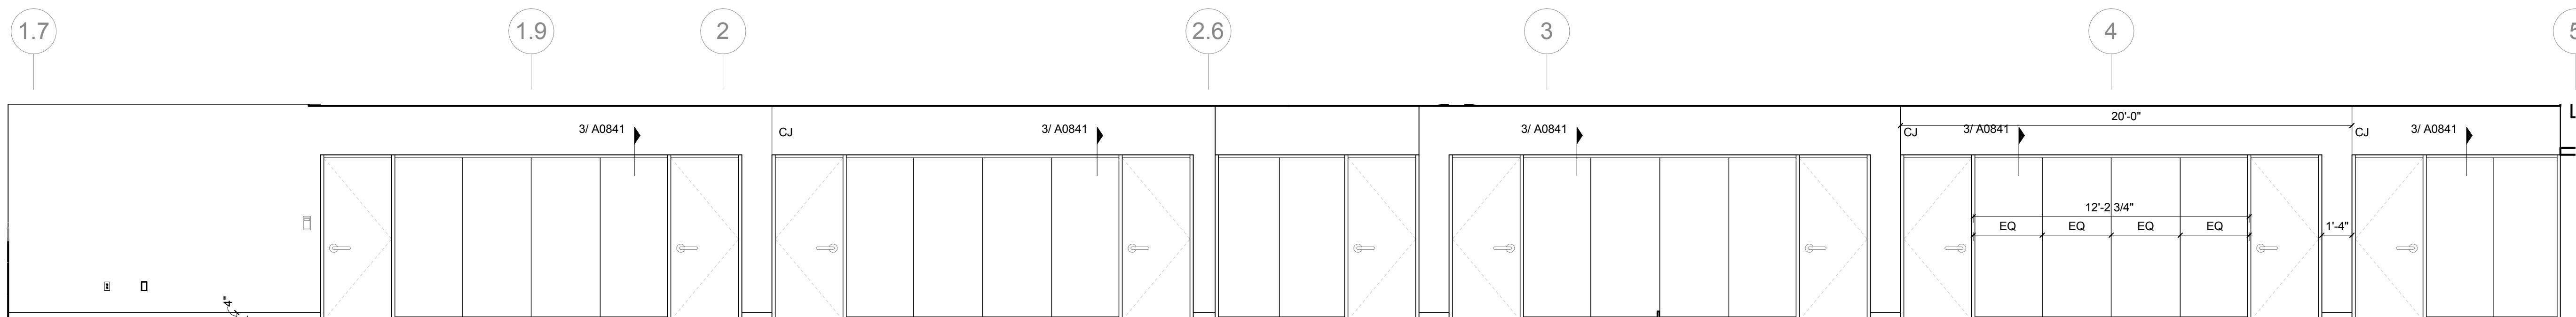

1 L04 CORR C410 - NORTH
1/4" = 1'-0"