


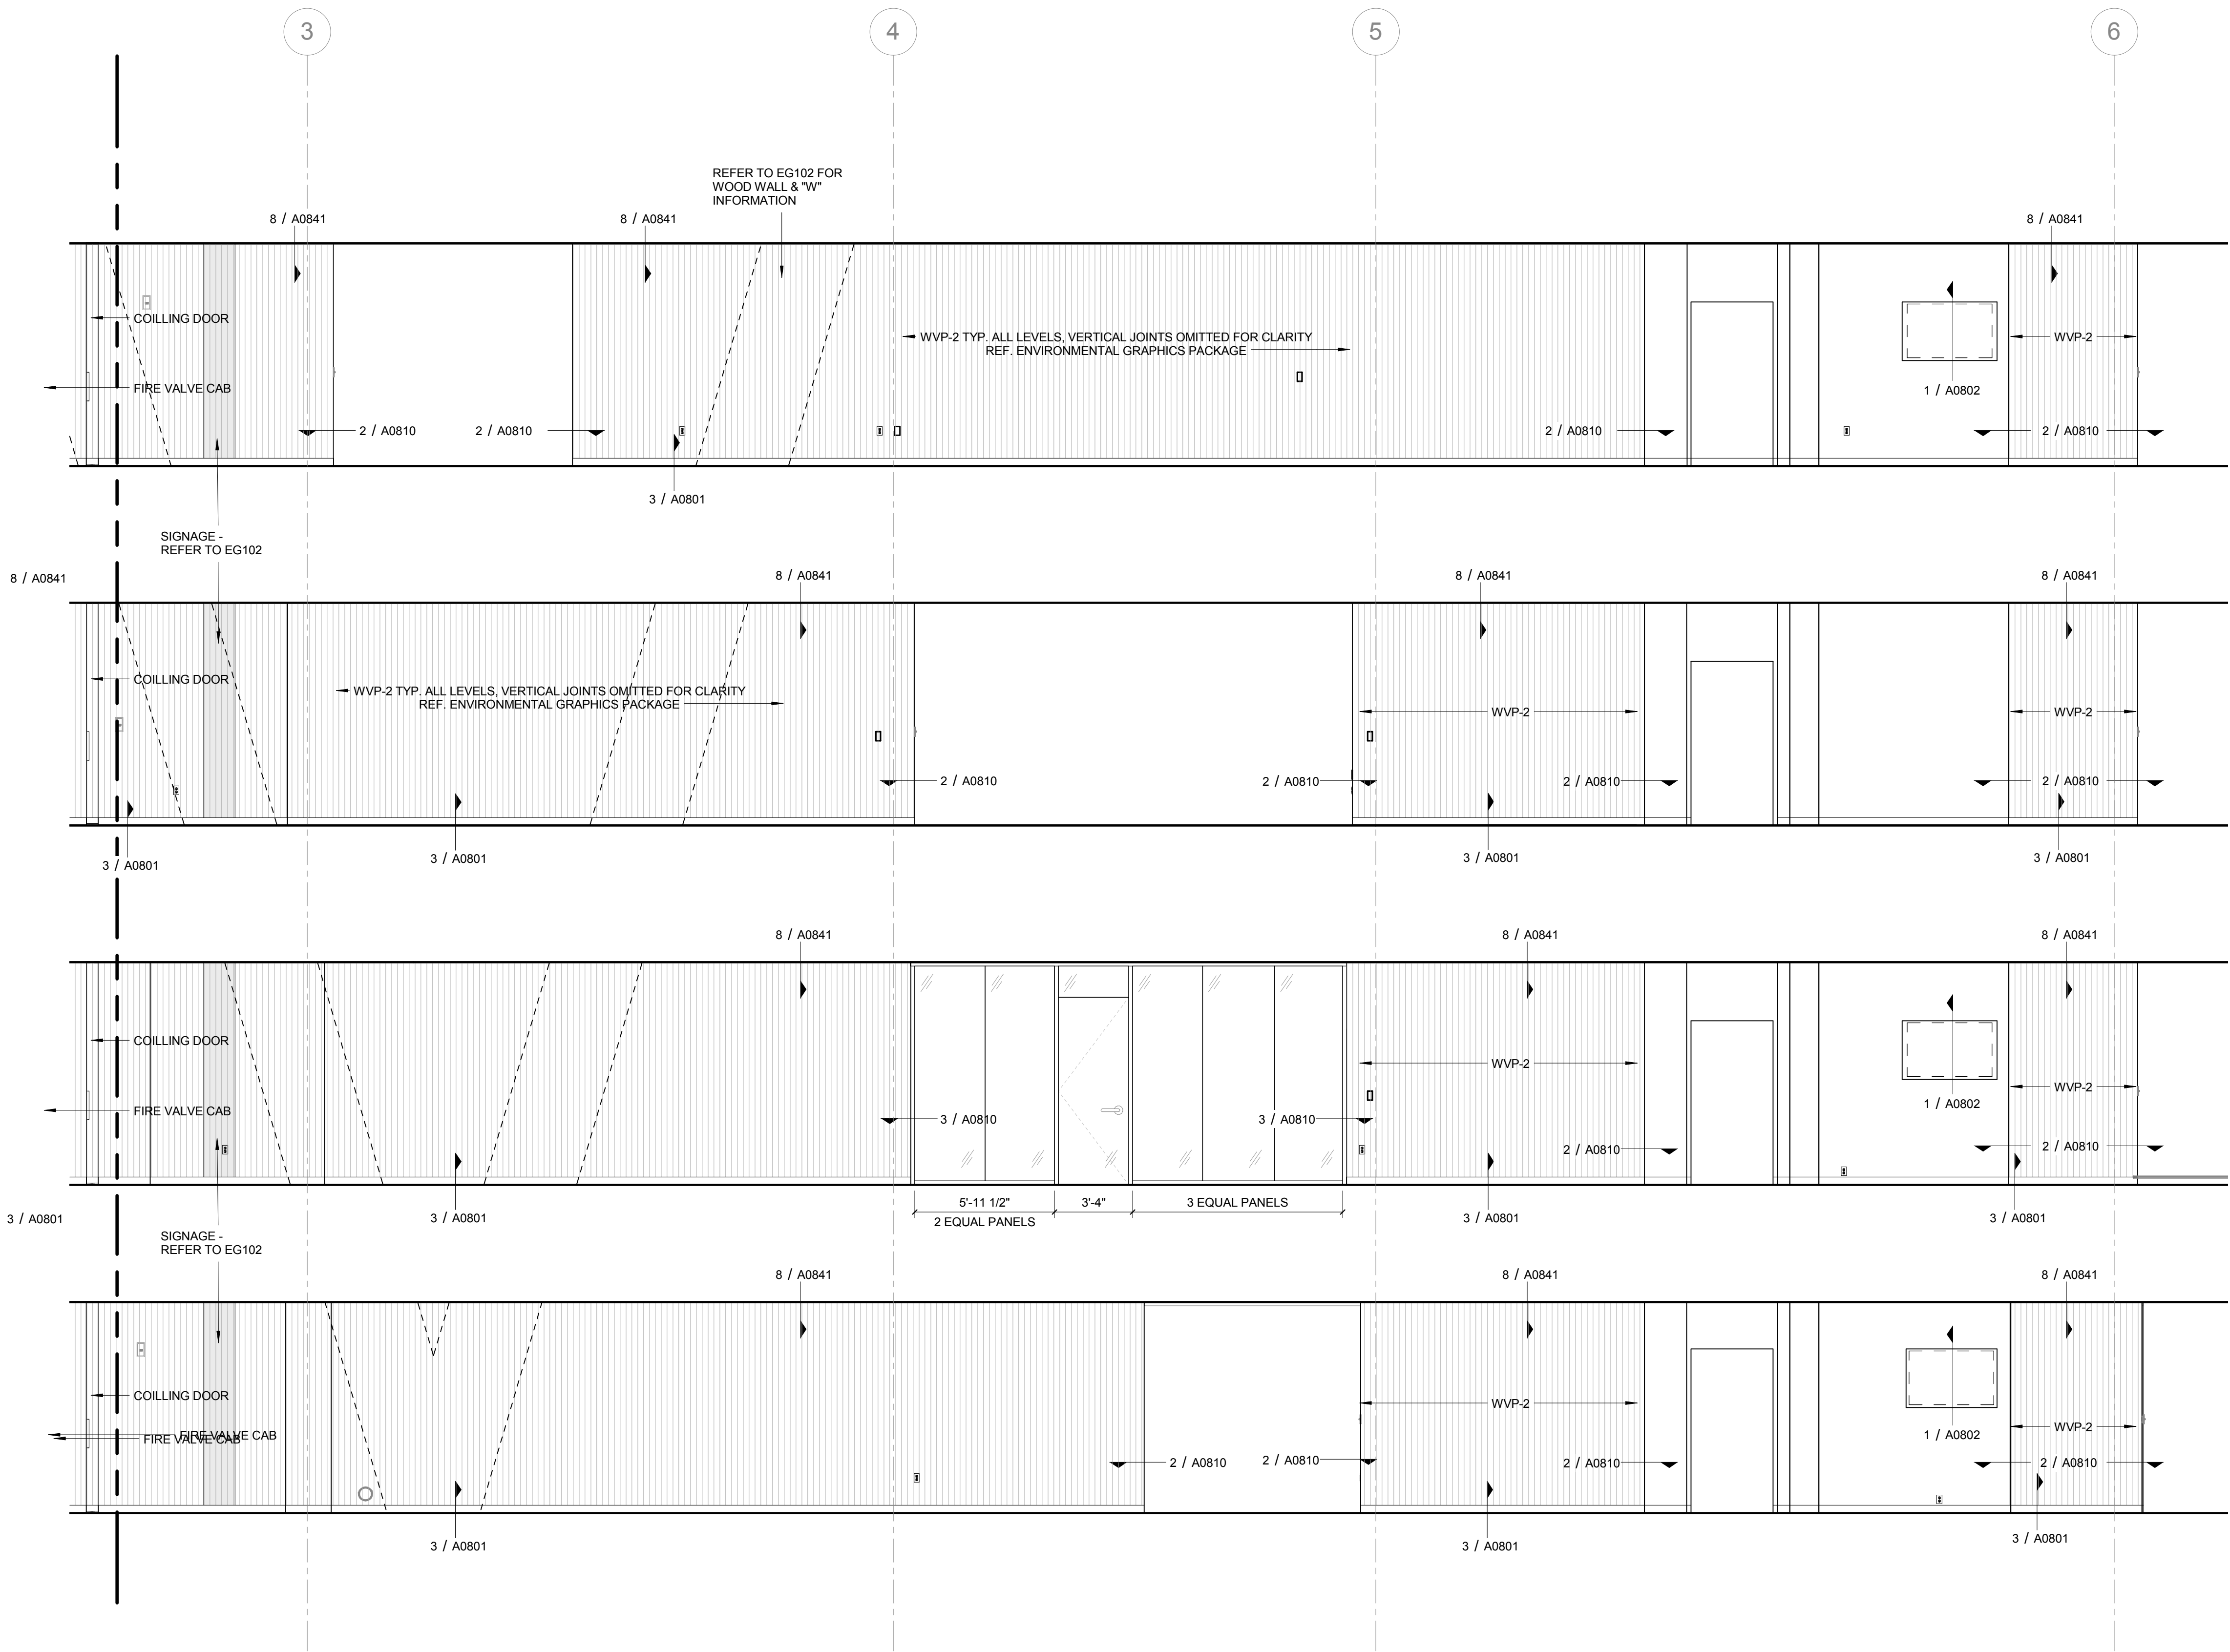

1 FEATURE WALL - PARTIAL NORTH (EAST)
1/4" = 1'-0"

ISSUED FOR CONSTRUCTION (BP3) 15 MAR 2016

No.	Description	Date
-----	-------------	------

Drawing Title:

INTERIOR ELEVATIONS

Project No.: 04561.01

Checked by:

A0606