




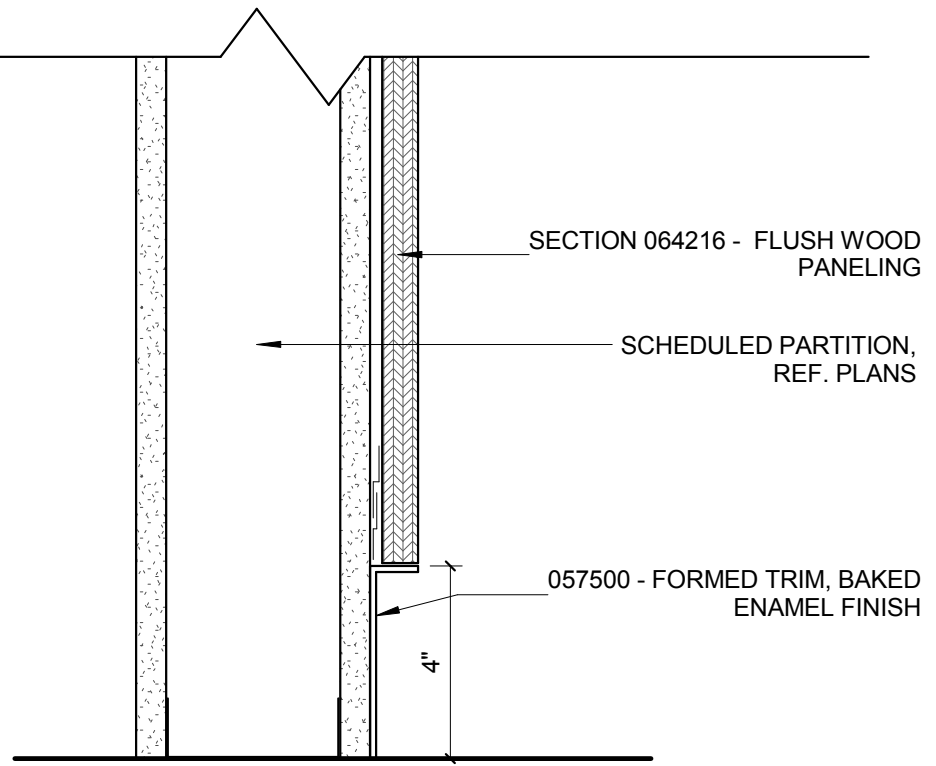

3 TYP. FLUSH WOOD PANEL BASE DETAIL
3" = 1'-0"


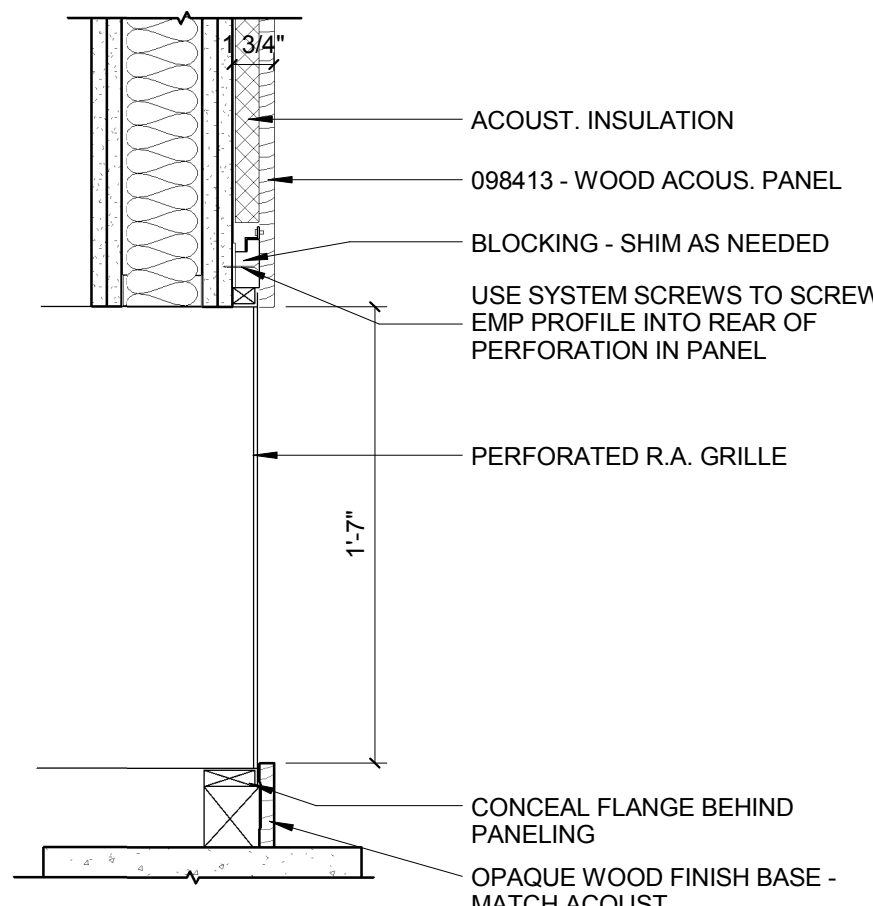


6 LECTURE HALL - RETURN AIR GRILLE DETAIL
1 1/2" = 1'-0"

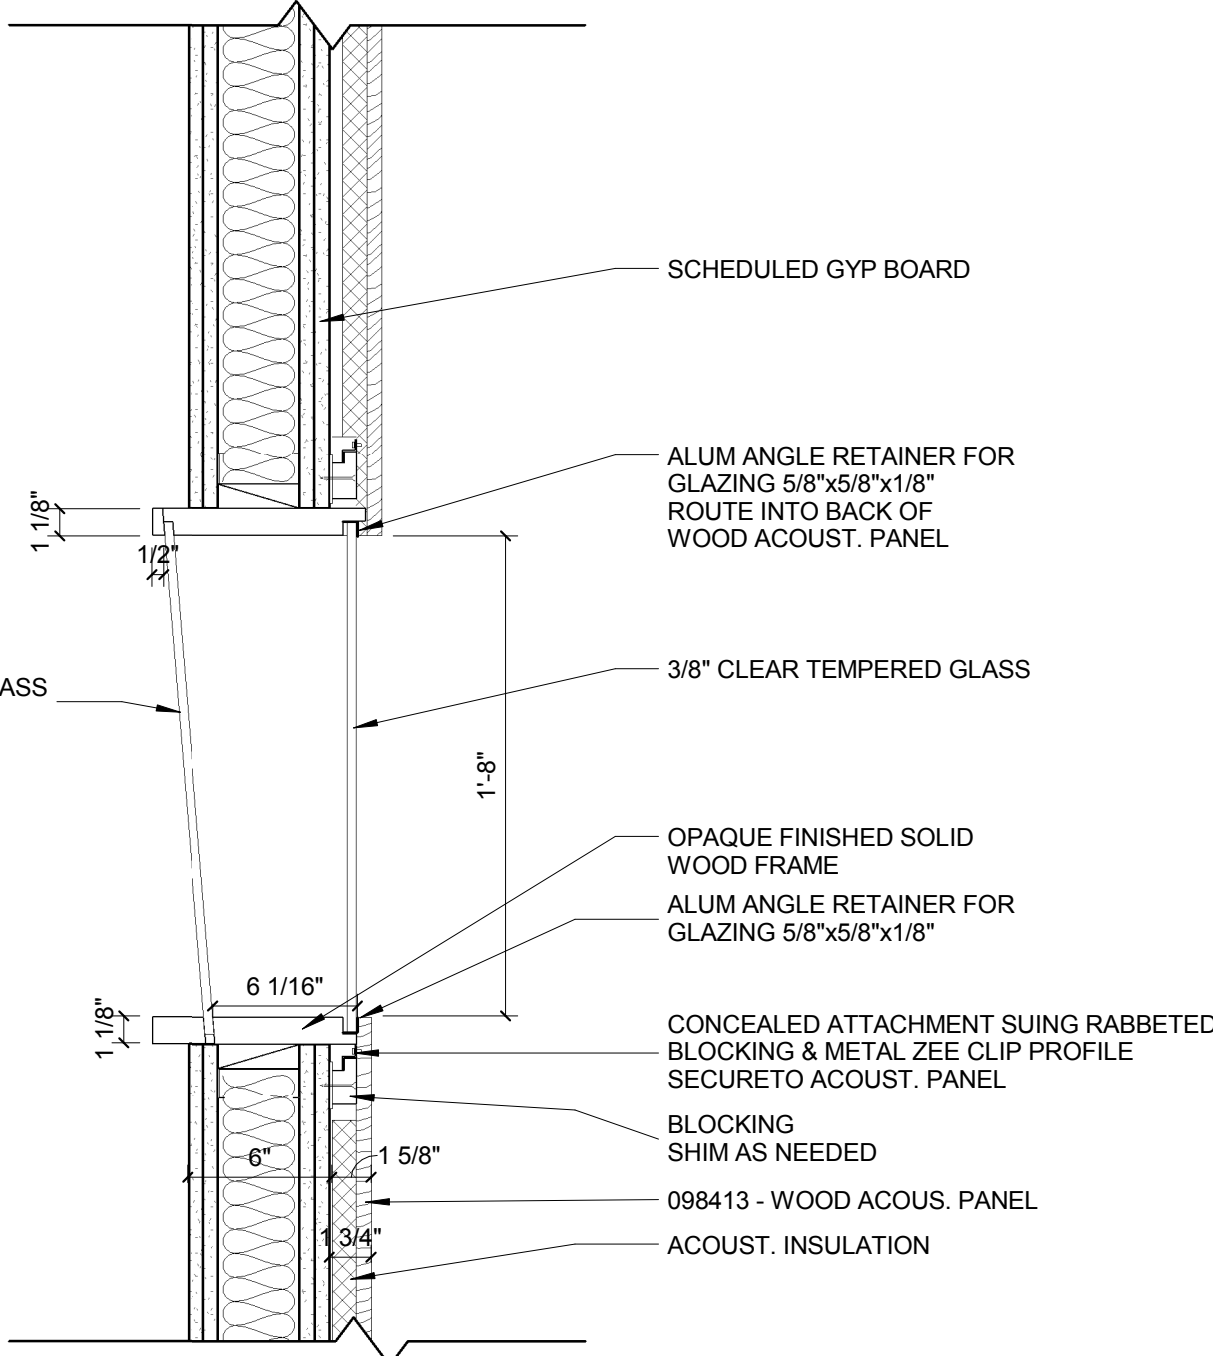


5 LECTURE HALL - CONTROL ROOM WINDOW
1 1/2" = 1'-0"


2 LECTURE HALL STAGE STAIR
1 1/2" = 1'-0"

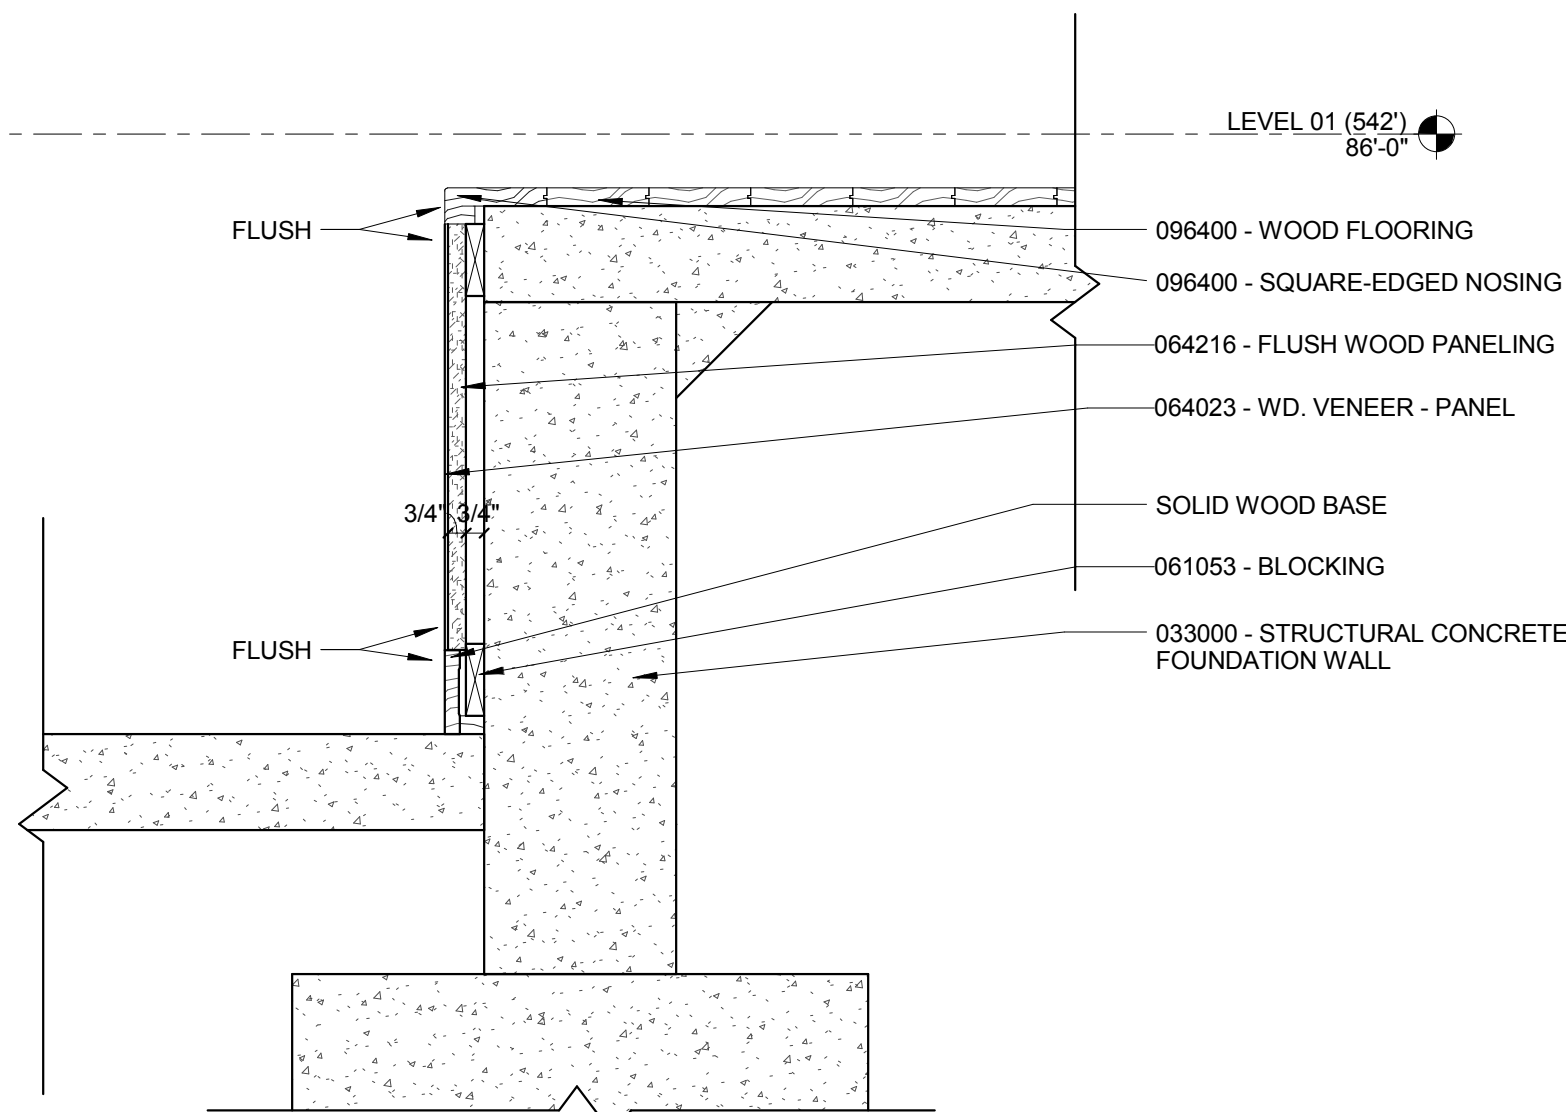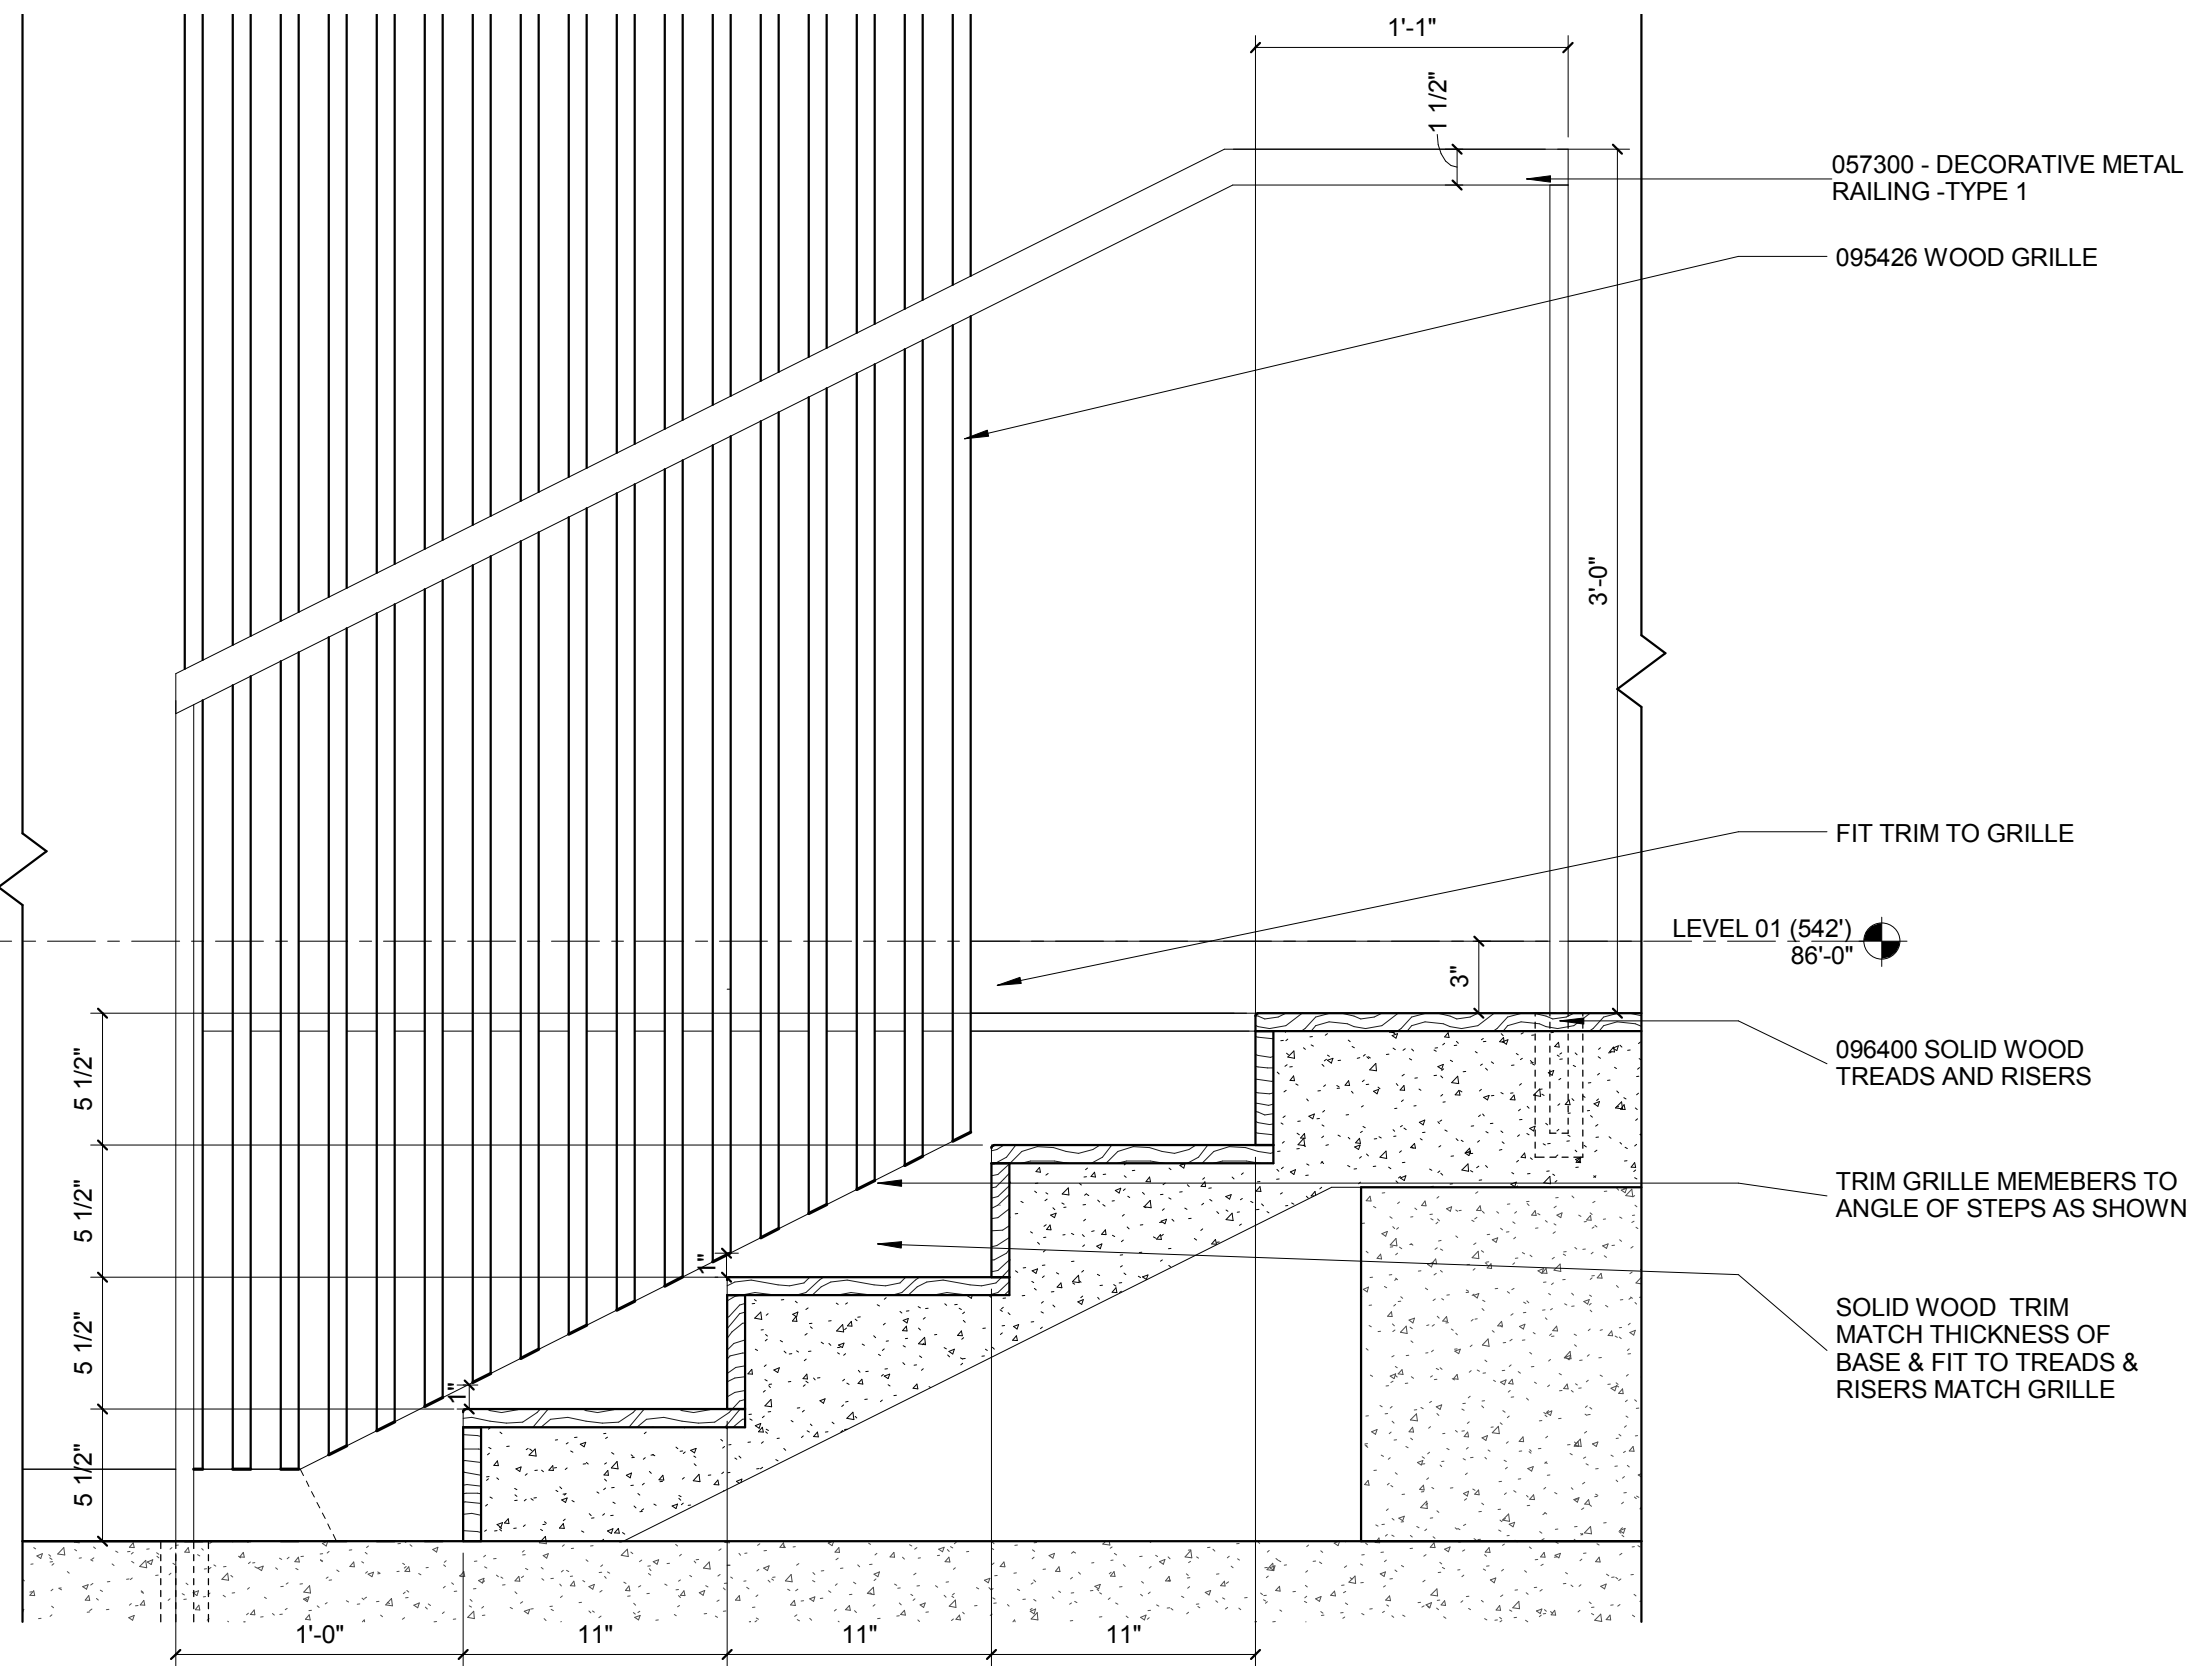

4 EDGE OF STAGE
1 1/2" = 1'-0"

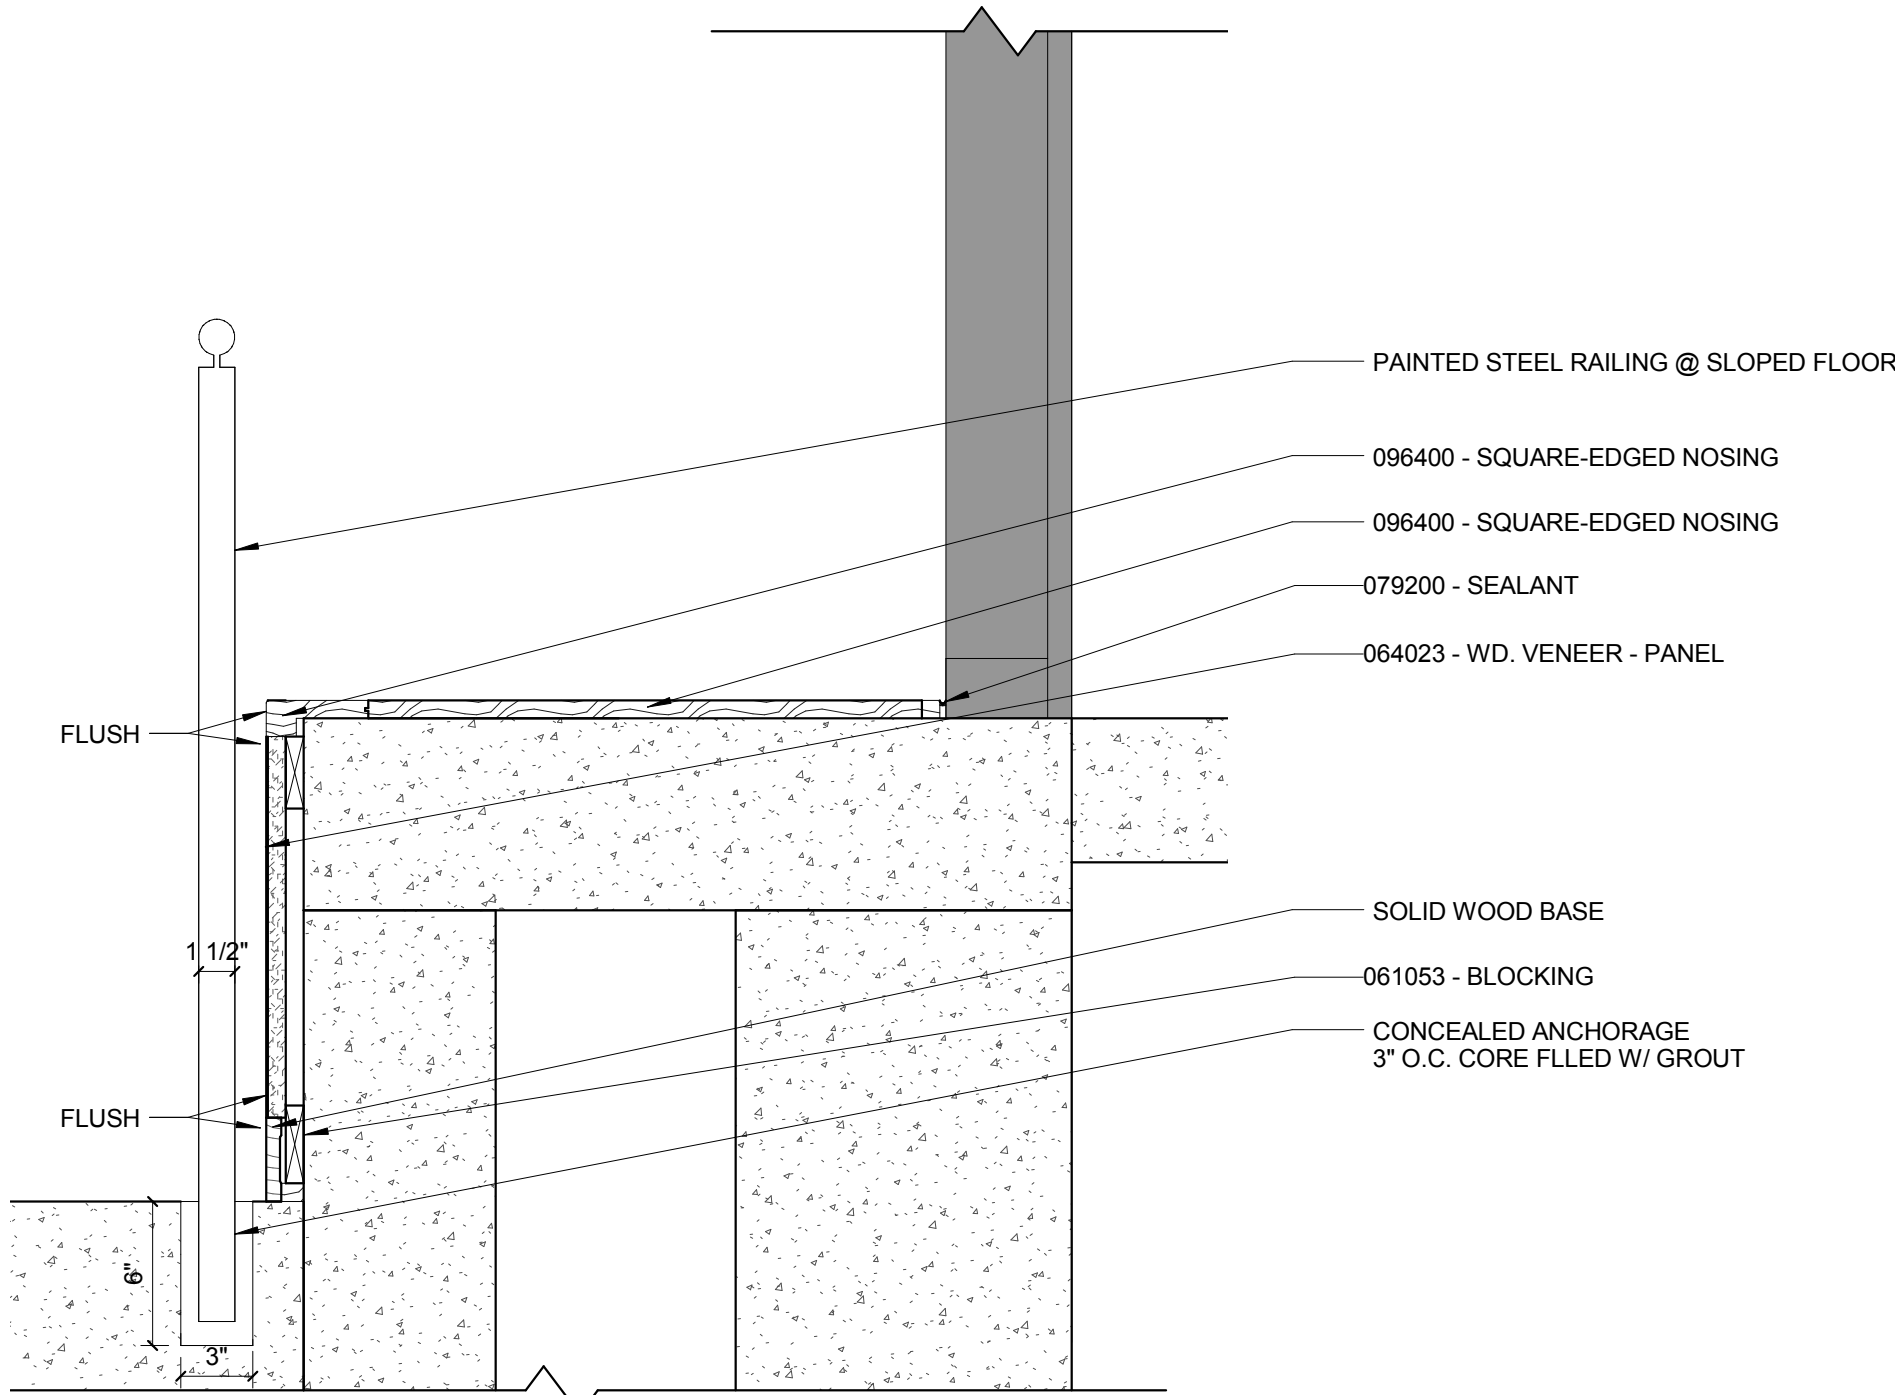

1 SILL DETAIL AT LECTURE HALL
1 1/2" = 1'-0"

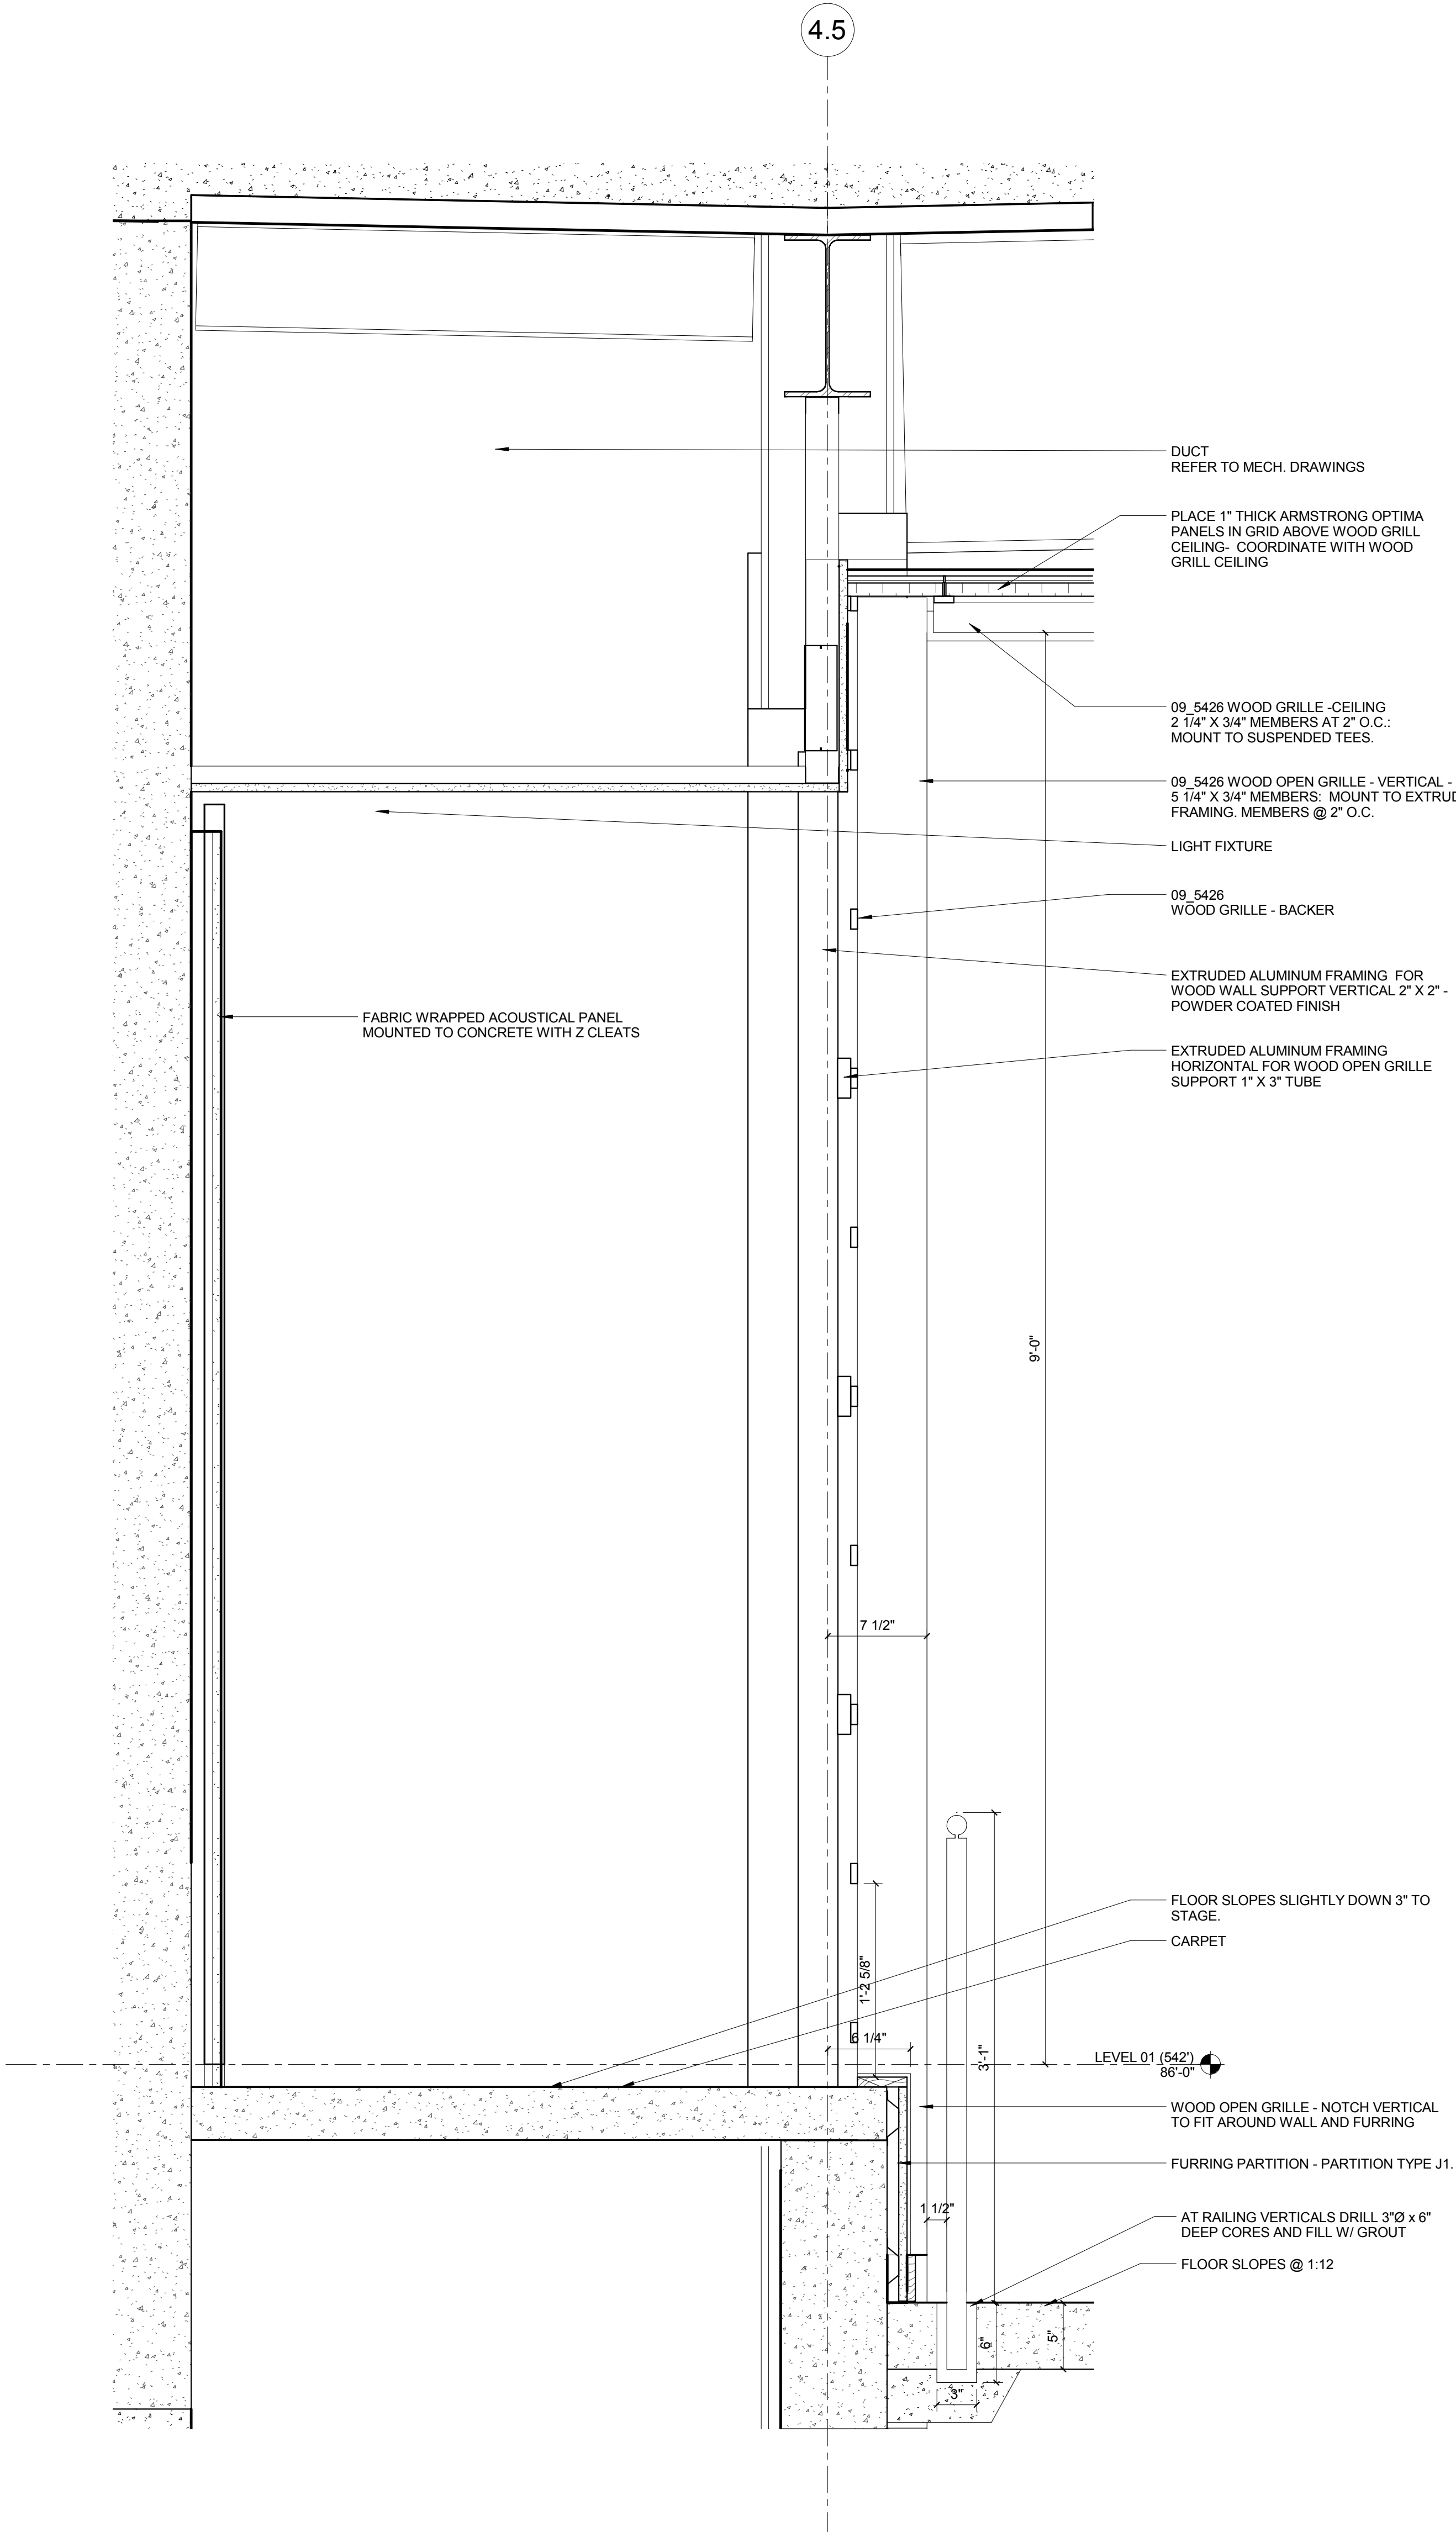

9 A0801 Lecture hall detail section
1 1/2" = 1'-0"