

2	ASI-057	06 APR 2017
1	ADDENDUM 3-2	15 APR 2016
-	ISSUED FOR CONSTRUCTION (BP3)	15 MAR 2016
No.	Description	Date

Drawing Title:

INTERIOR DETAILS

Project No.: 04561.01 Checked by:

A0802


092900 - GYP. BOARD
092216 - NSMF
092900 - ALUM TRIM
B.O.D. GORDON - 314-1/2
1/8" THK. ALUM. PLATE
POWDER COATED, COLOR
TO MATCH WALL PAINT
COLOR.
NO EXPOSED FASTENERS.

ATTACH ALUM. ANGLES TO 1/8" THICK
ALUM. PLATE USING VHB TAPE, FASTEN
ANGLES TO FRAMING.

079100 - EMSEAL
QUITE JOINT
AQUARIUM
BY OTHERS


PLAN DETAIL @ AQUARIUM
VIEWING OPENING JAMB

1 1/2" = 1'-0"

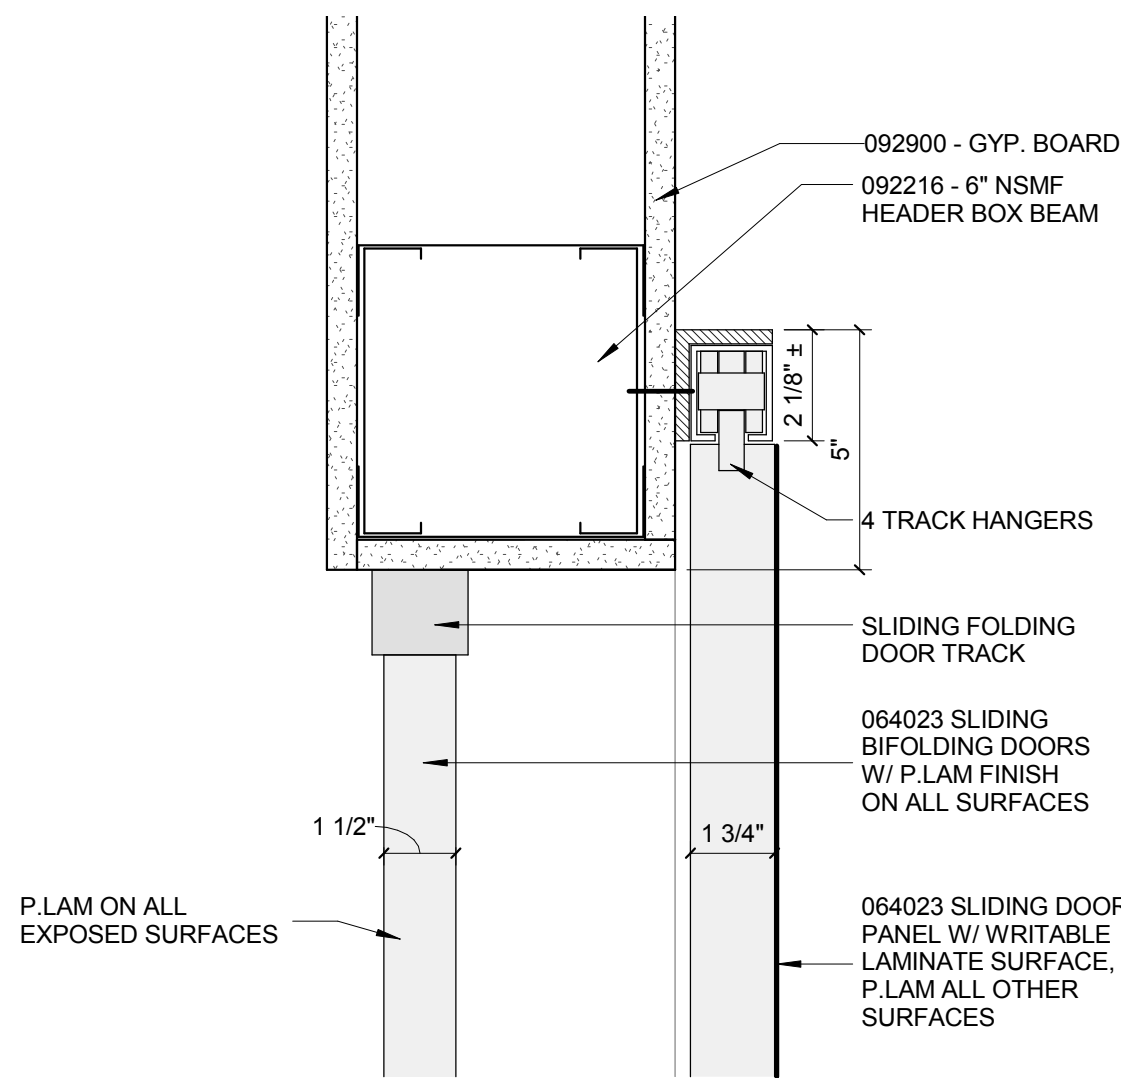

SECTION @ FISH TANK OPENING
AND WHITEBOARD HEAD

3" = 1'-0"

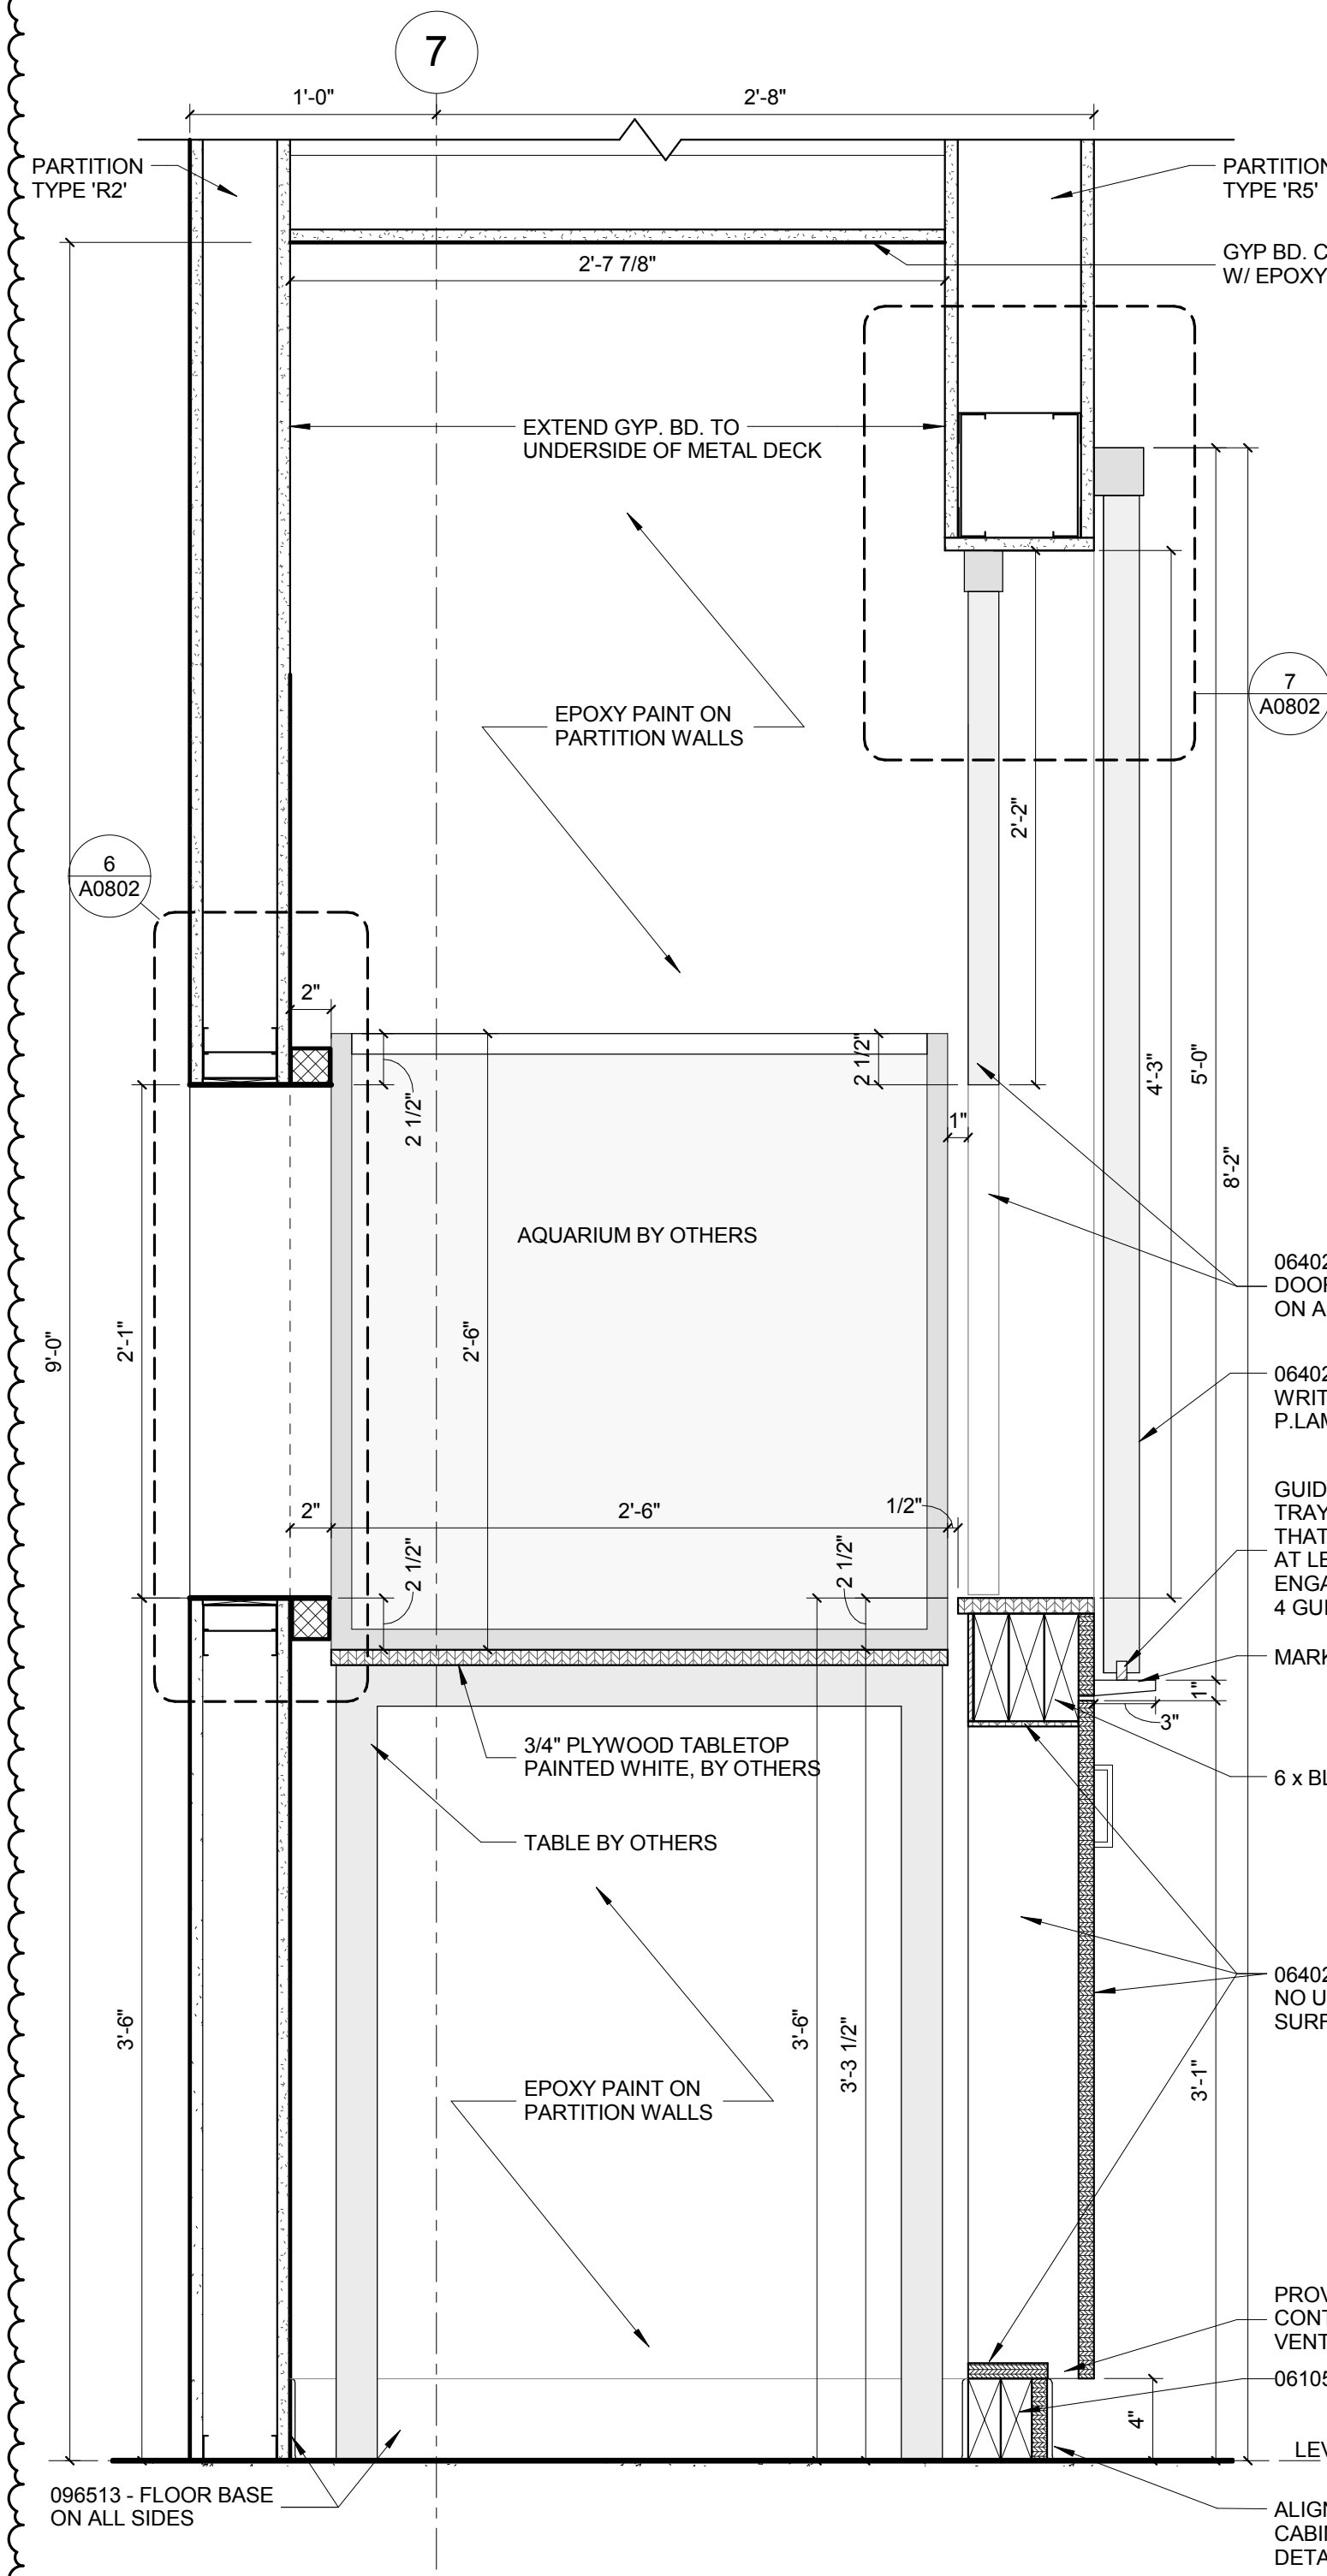

FISH TANK DETAIL SECTION

1 1/2" = 1'-0"

092216 - NSMF
HEADER BOX BEAM
092900 - GYP. BOARD
092900 - ALUM TRIM
B.O.D. GORDON - 314-1/2
1/8" THK. ALUM. PLATE
POWDER COATED,
COLOR TO MATCH
WALL PAINT COLOR.
NO EXPOSED
FASTENERS.

079100 - EMSEAL QUITE JOINT
ON ALL SIDES OF OPENING


AQUARIUM - BY OTHERS
ATTACH ALUM. ANGLES
TO 1/8" THICK ALUM.
PLATE USING VHB TAPE,
FASTEN ANGLES TO
FRAMING. NO EXPOSED
FASTENERS

SHIM AS NEEDED

092900 - ALUM TRIM
B.O.D. GORDON - 314-1/2
092216 - NSMF


DETAIL OF FISH TANK @ CLEAR OPENING

1 1/2" = 1'-0"

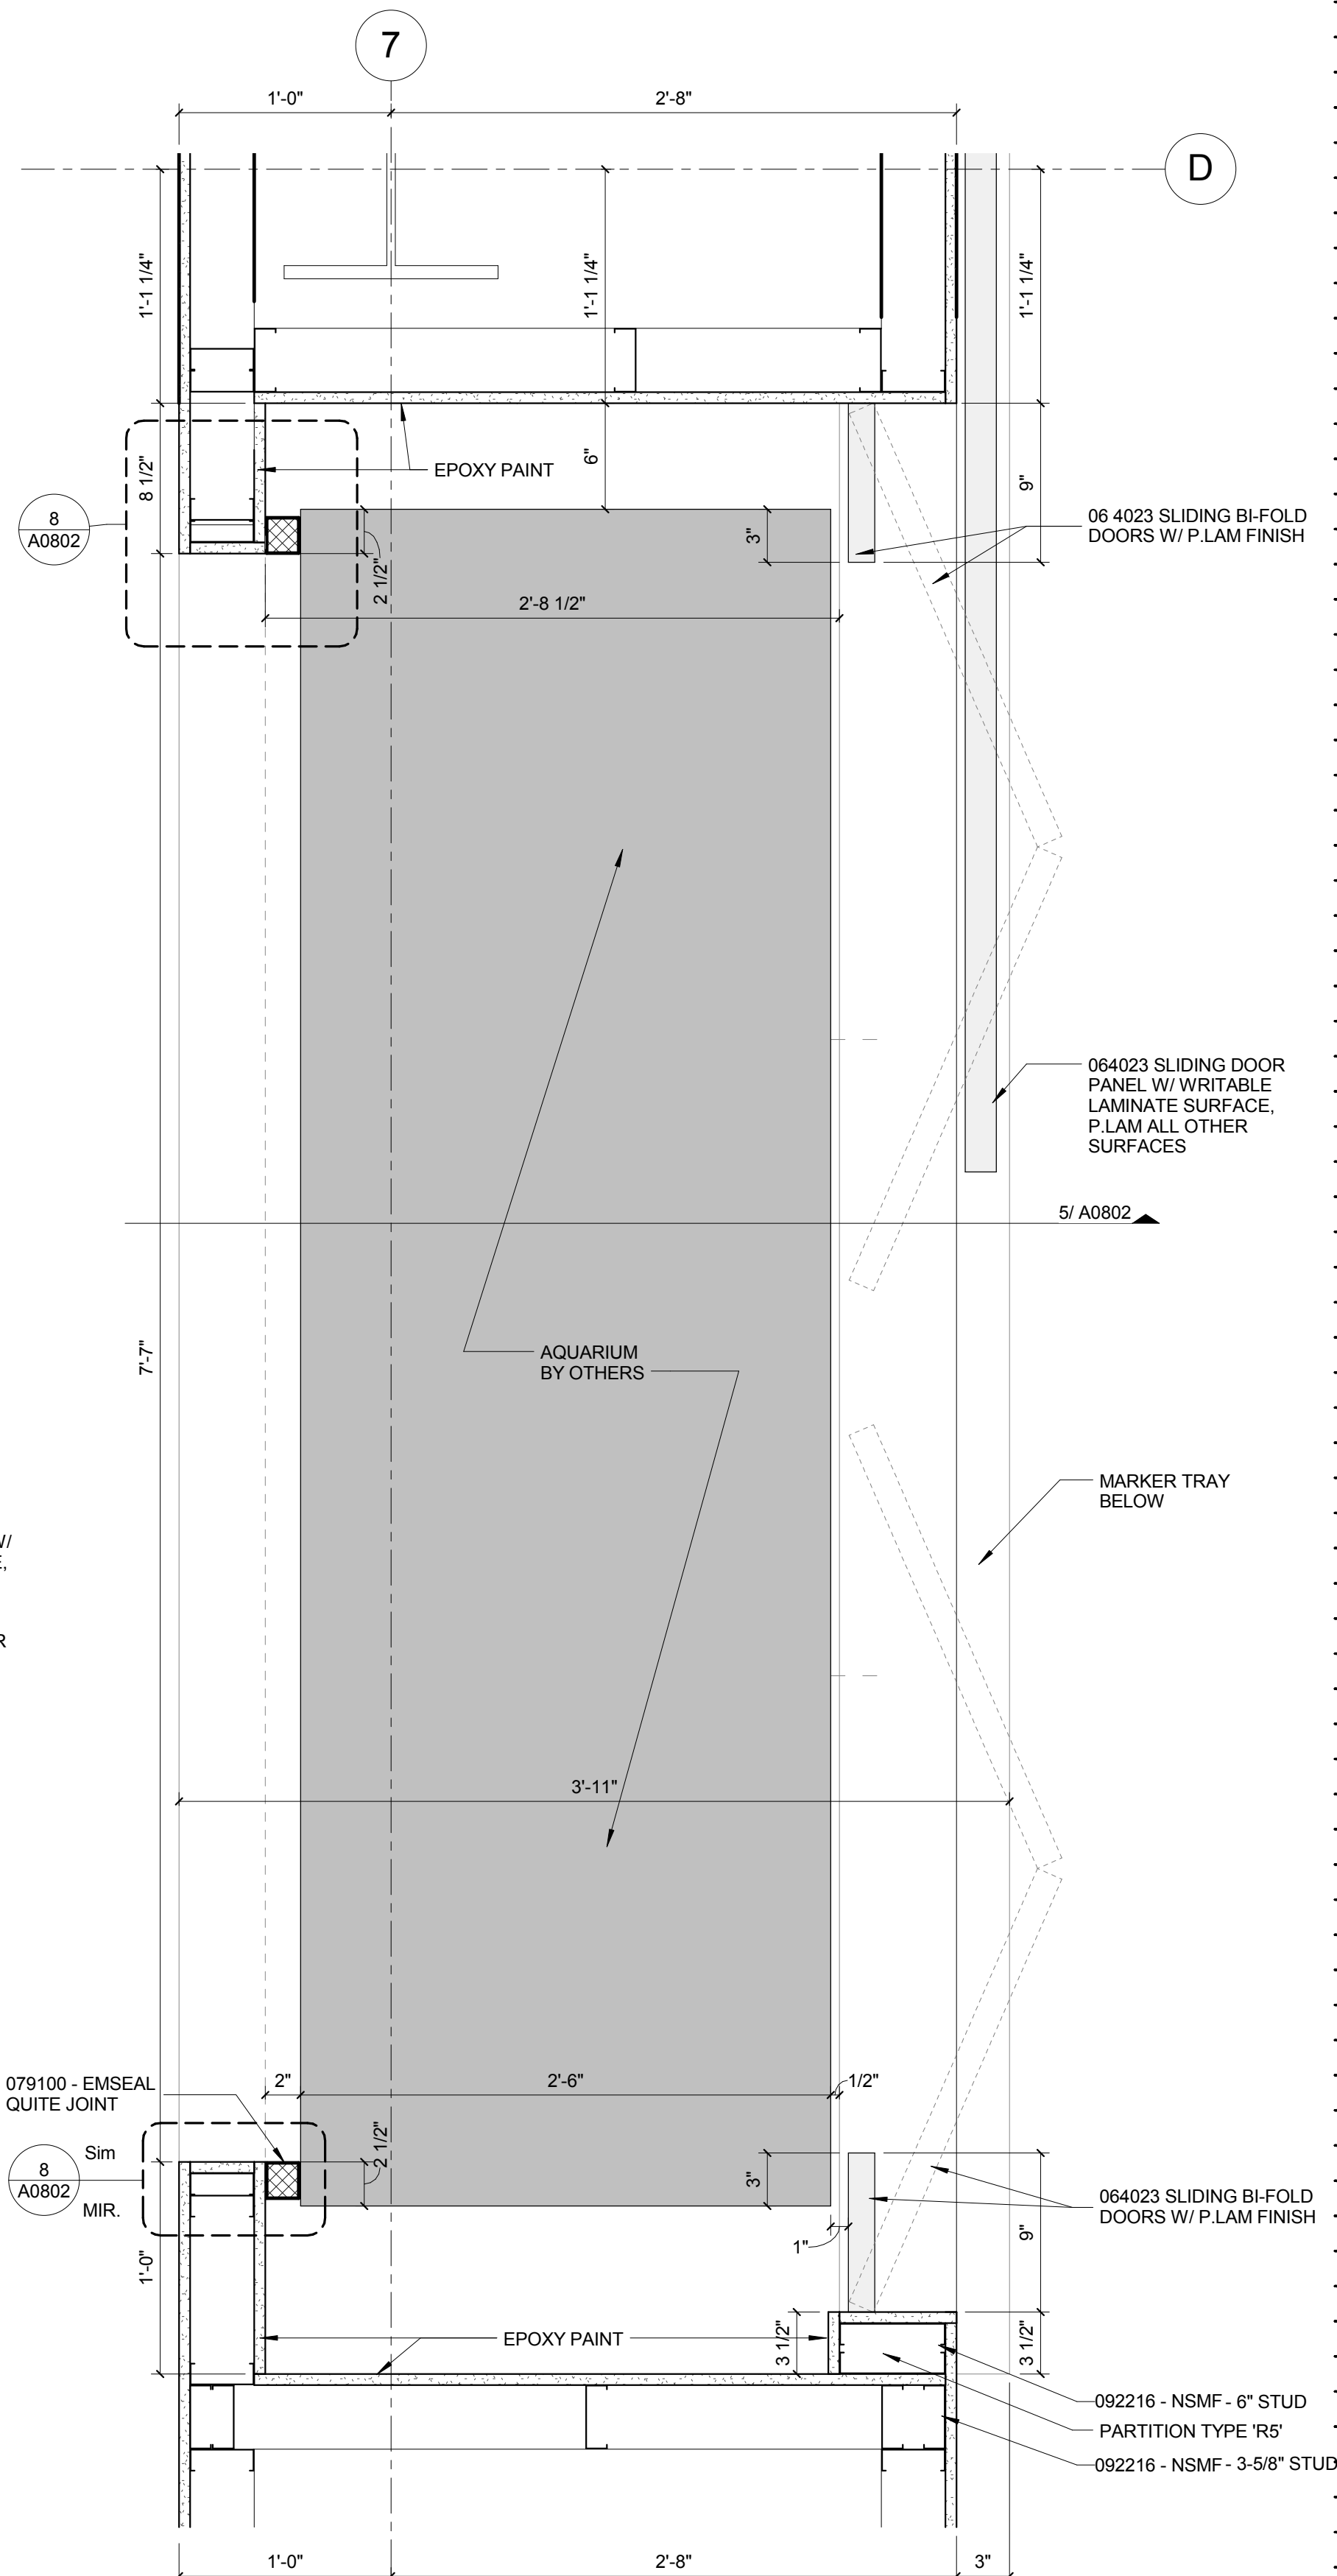


LEVEL 03 - FISH TANK PLAN DETAIL

1 1/2" = 1'-0"

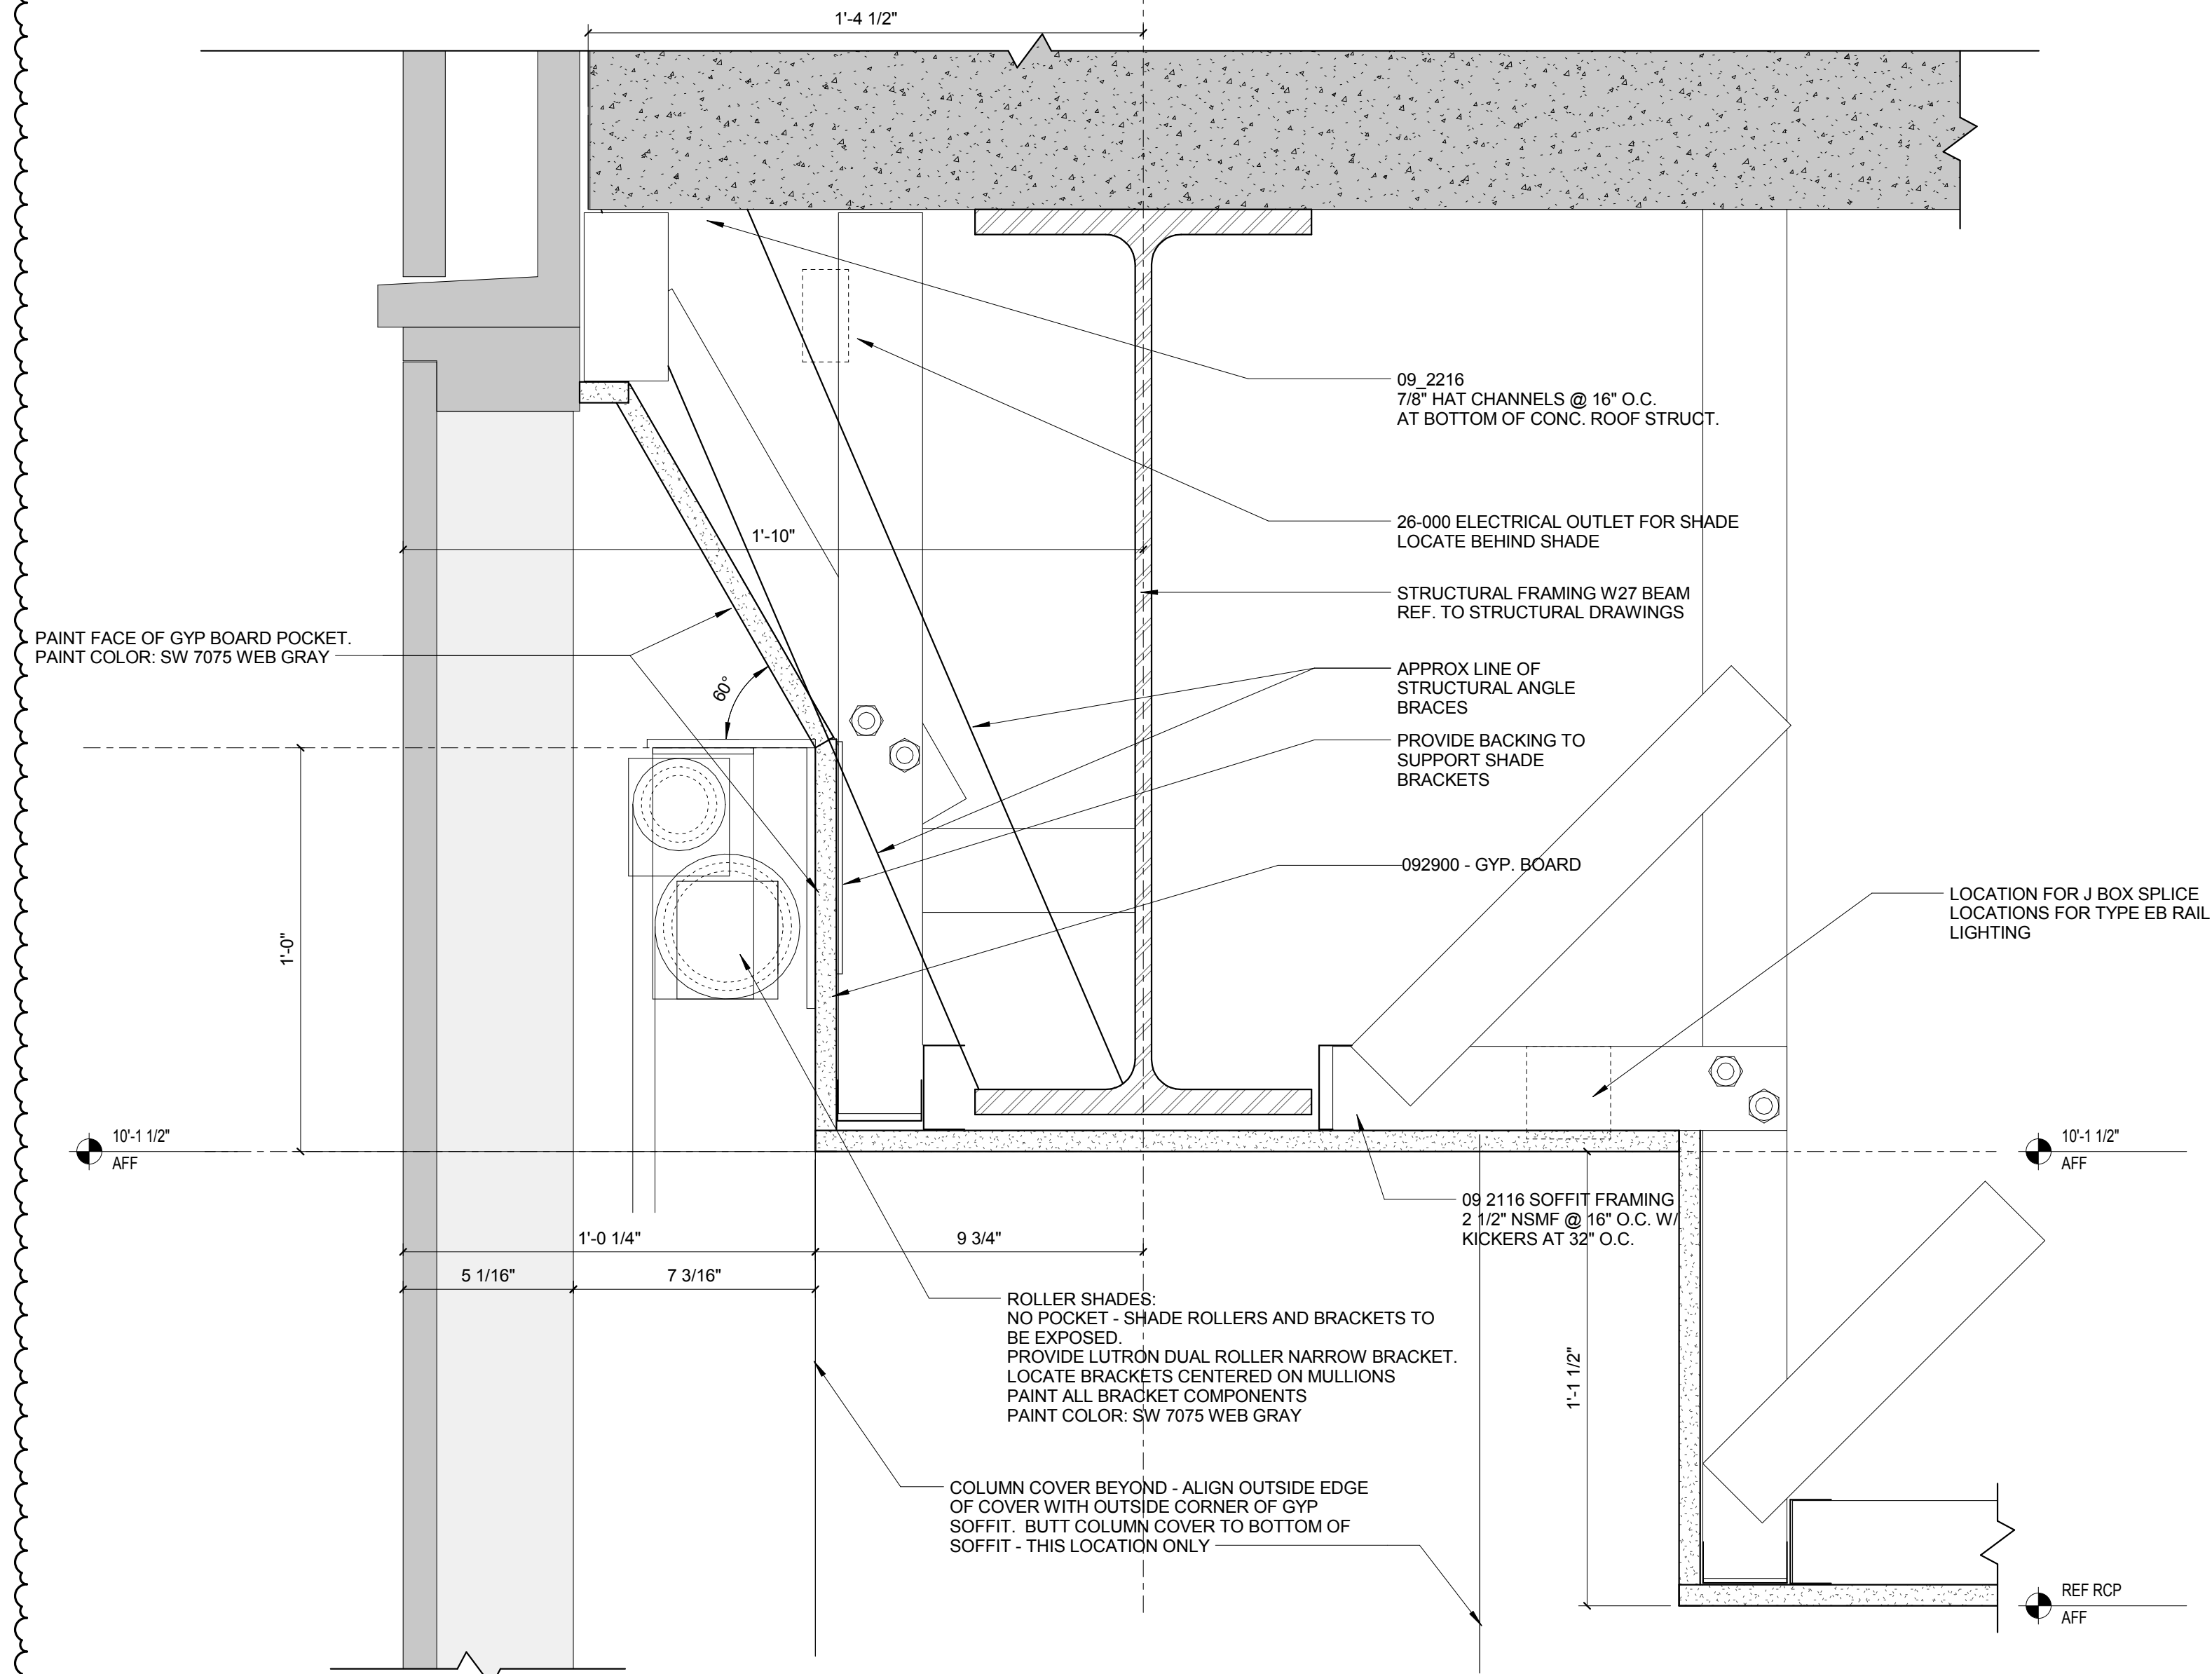


RECESSED MOTORIZED SHADES @ CONFERENCE ROOM

3" = 1'-0"

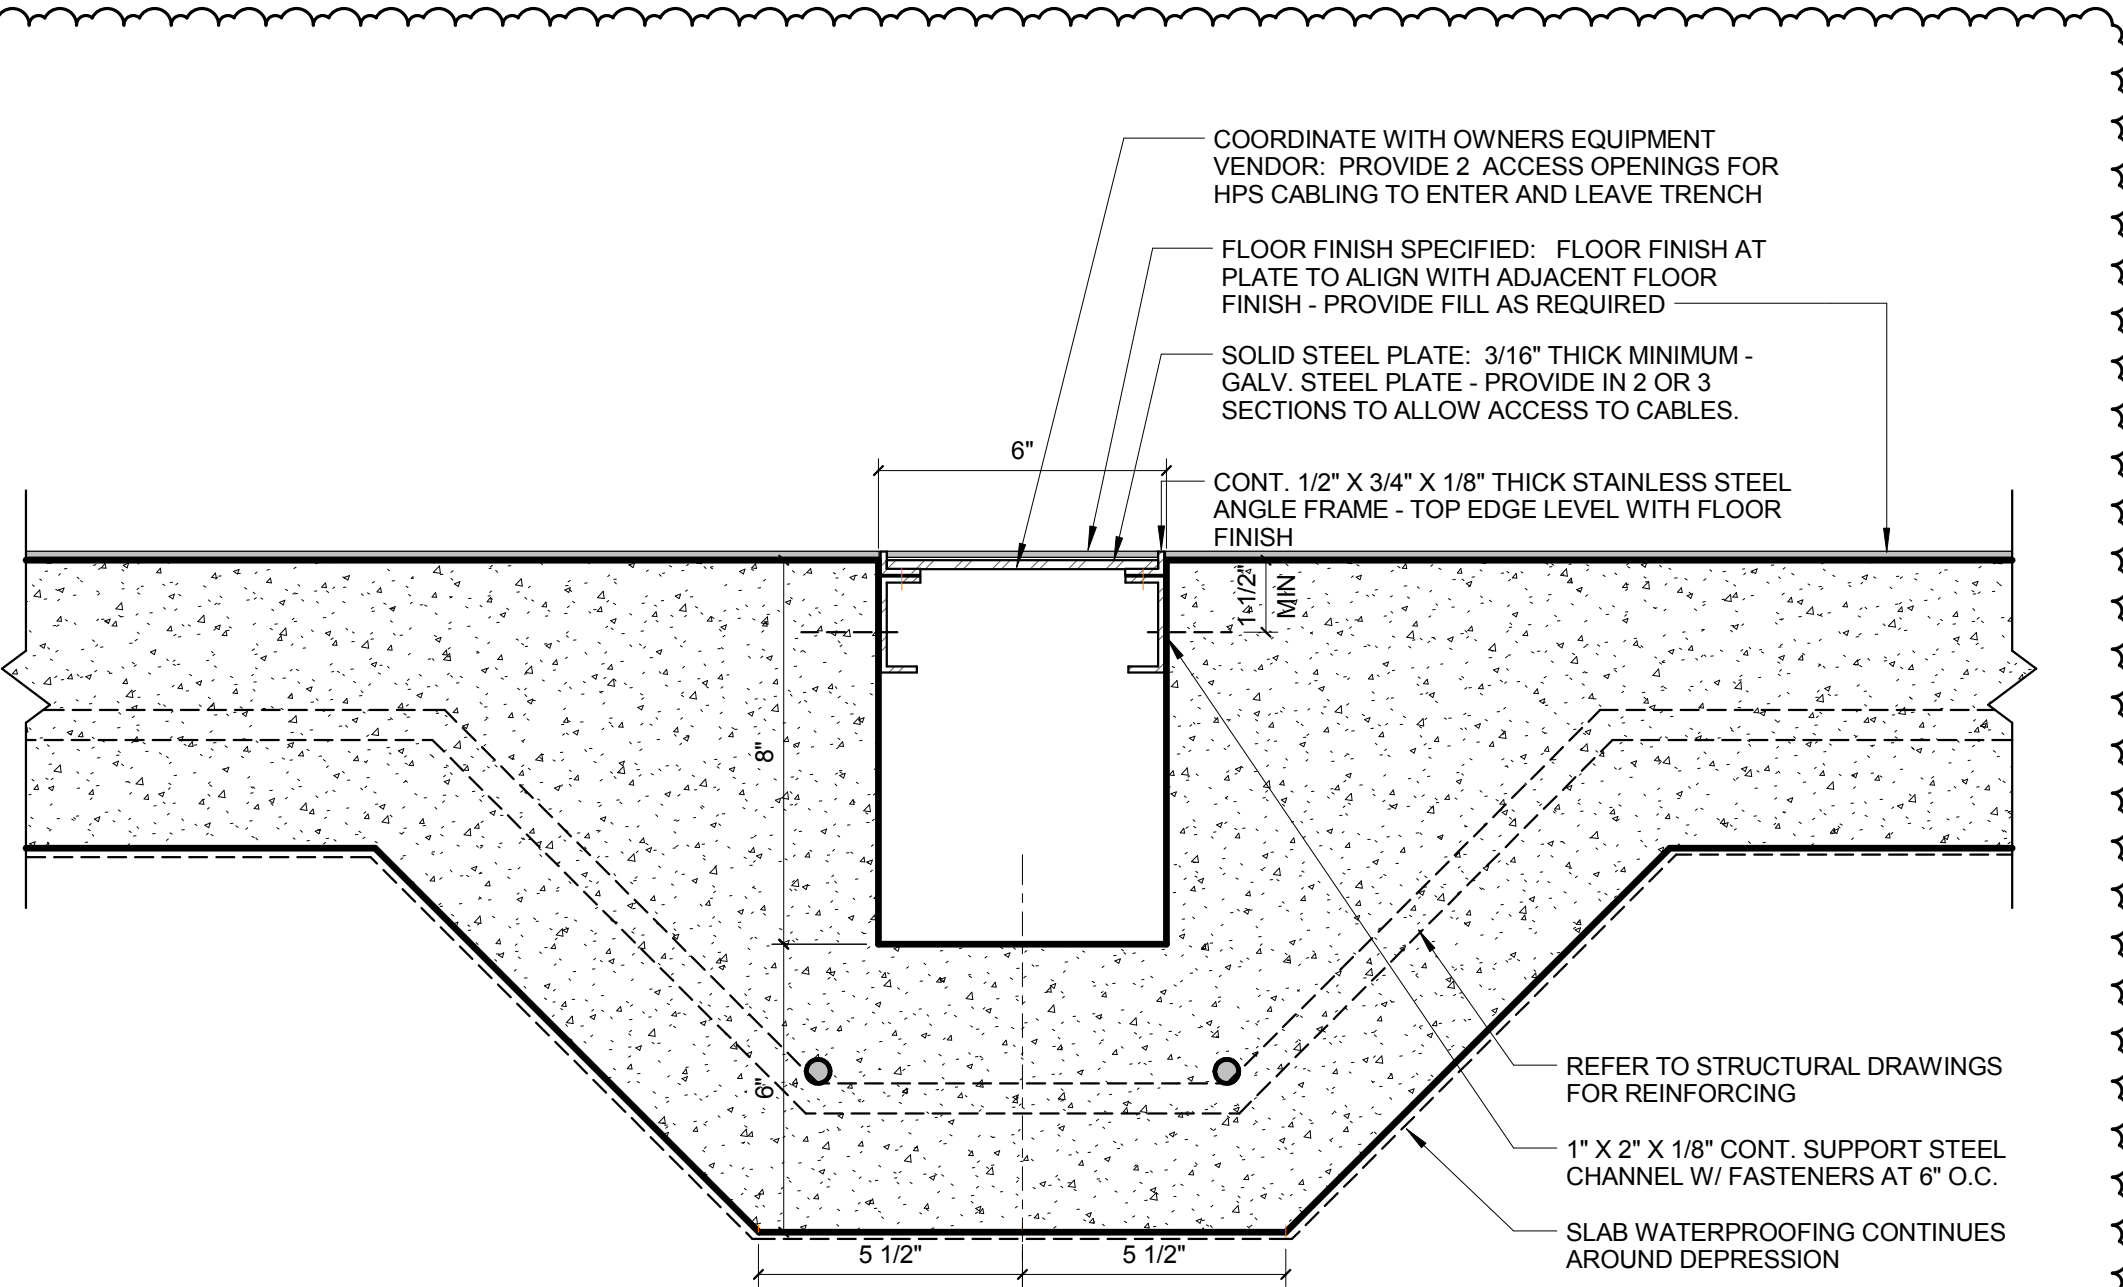

UMBILICAL TRENCH DETAIL

3" = 1'-0"

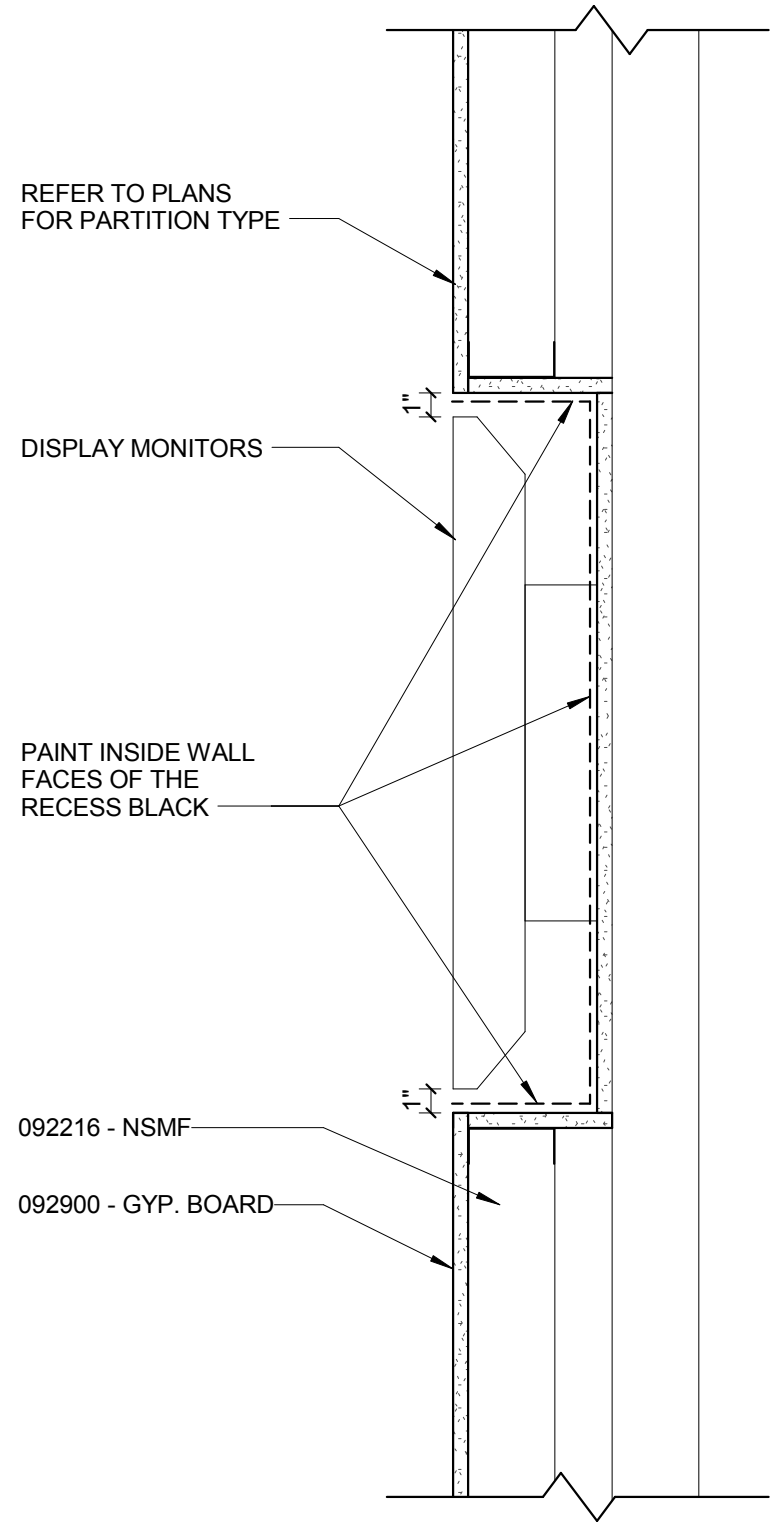

MONITOR SCREEN RECESS

1 1/2" = 1'-0"