



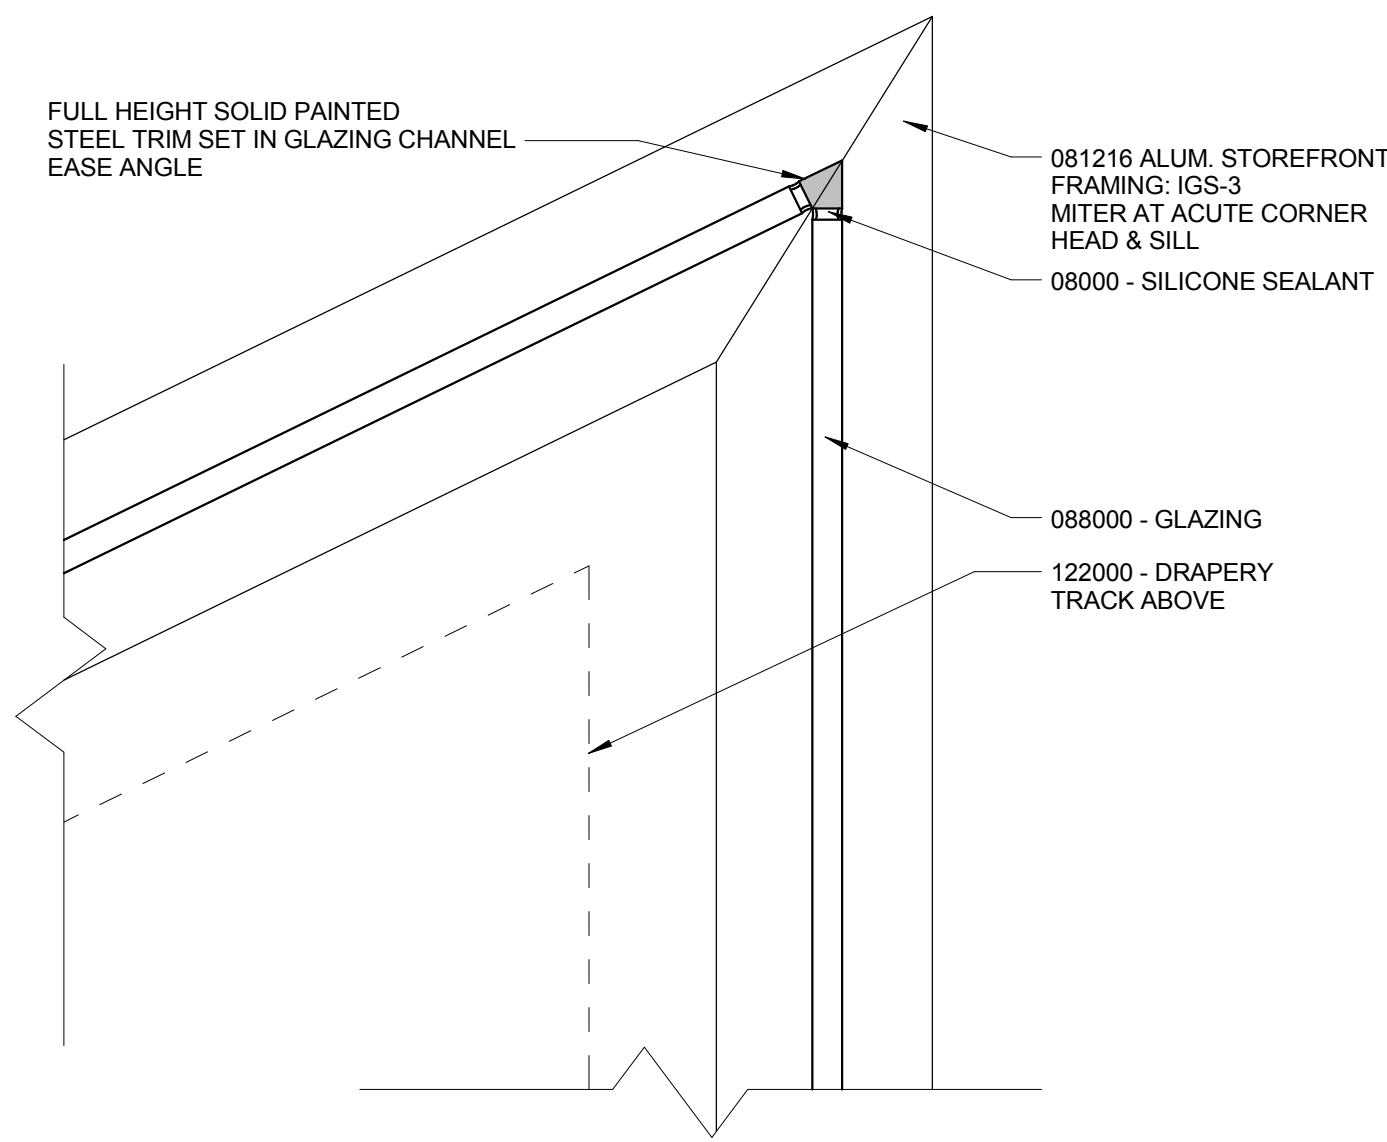


18 CONFERENCE ROOM - MITERED CORNER

3" = 1'-0"

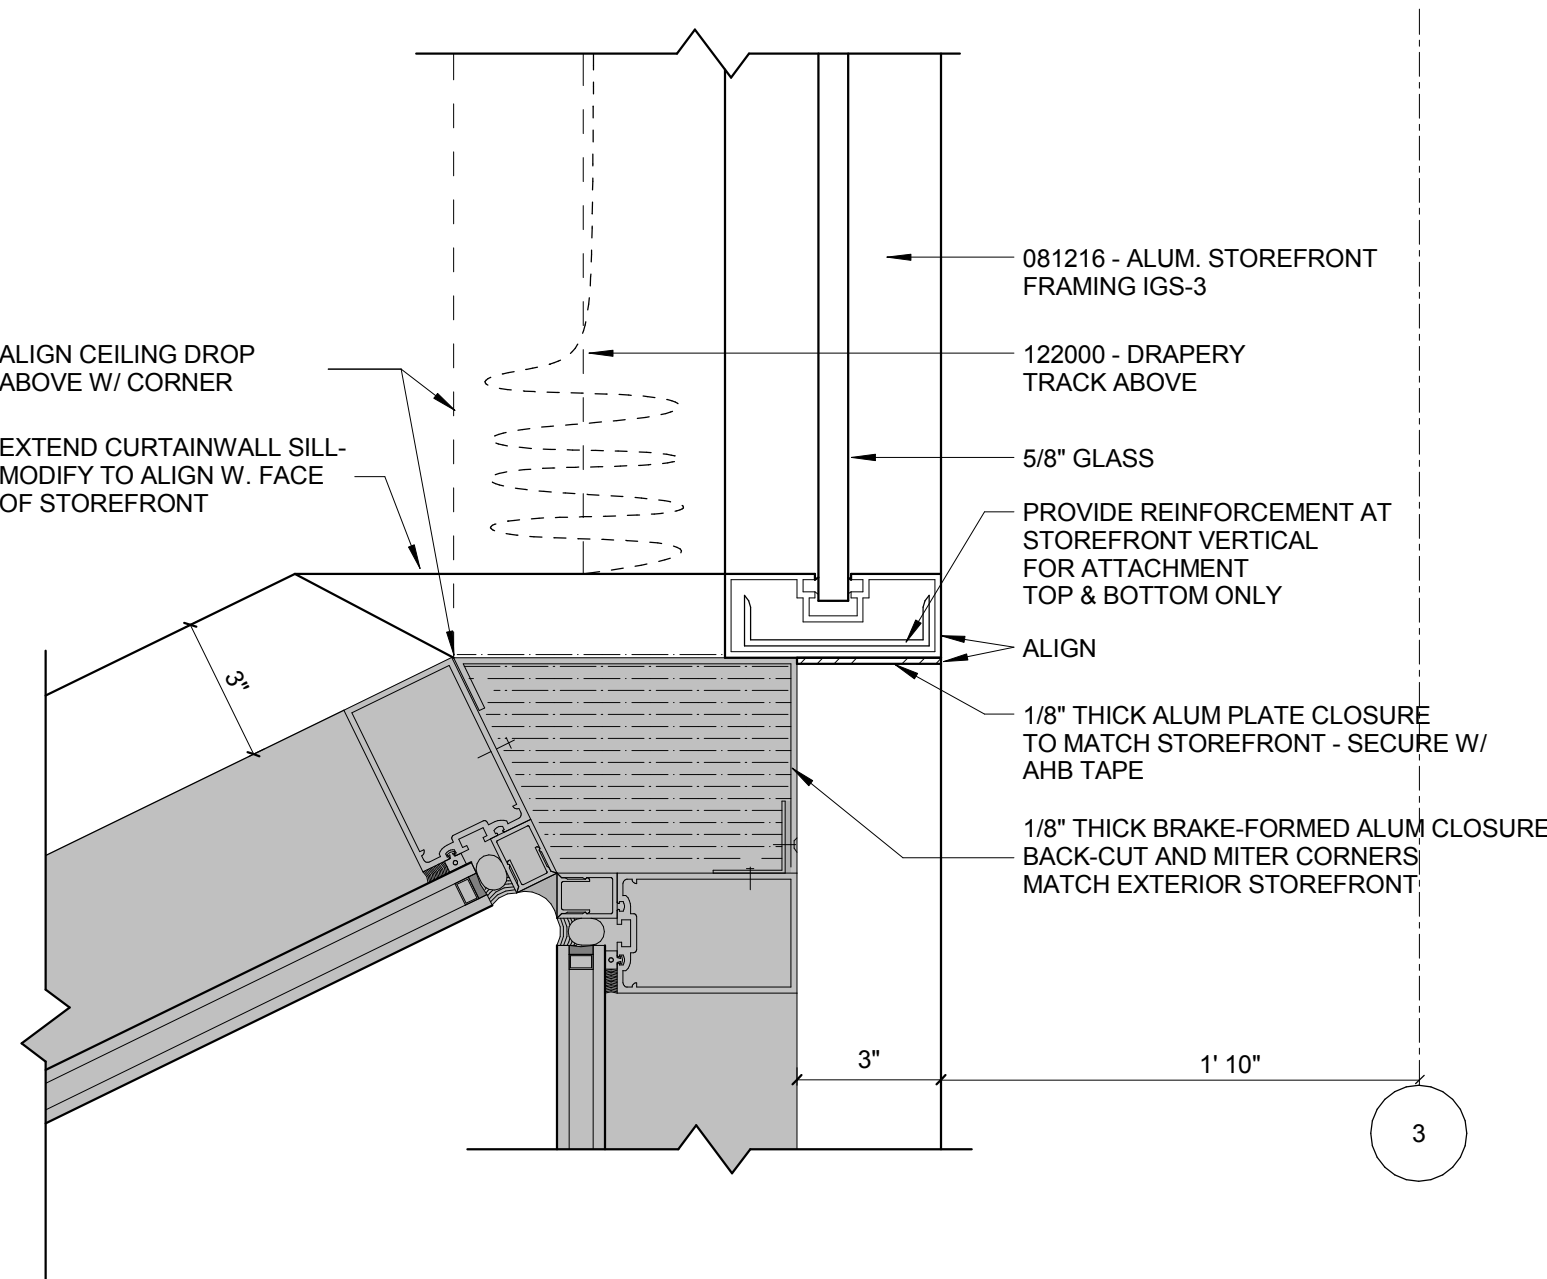


17 EXTERIOR CORNER AT CONFERENCE ROOM

3" = 1'-0"

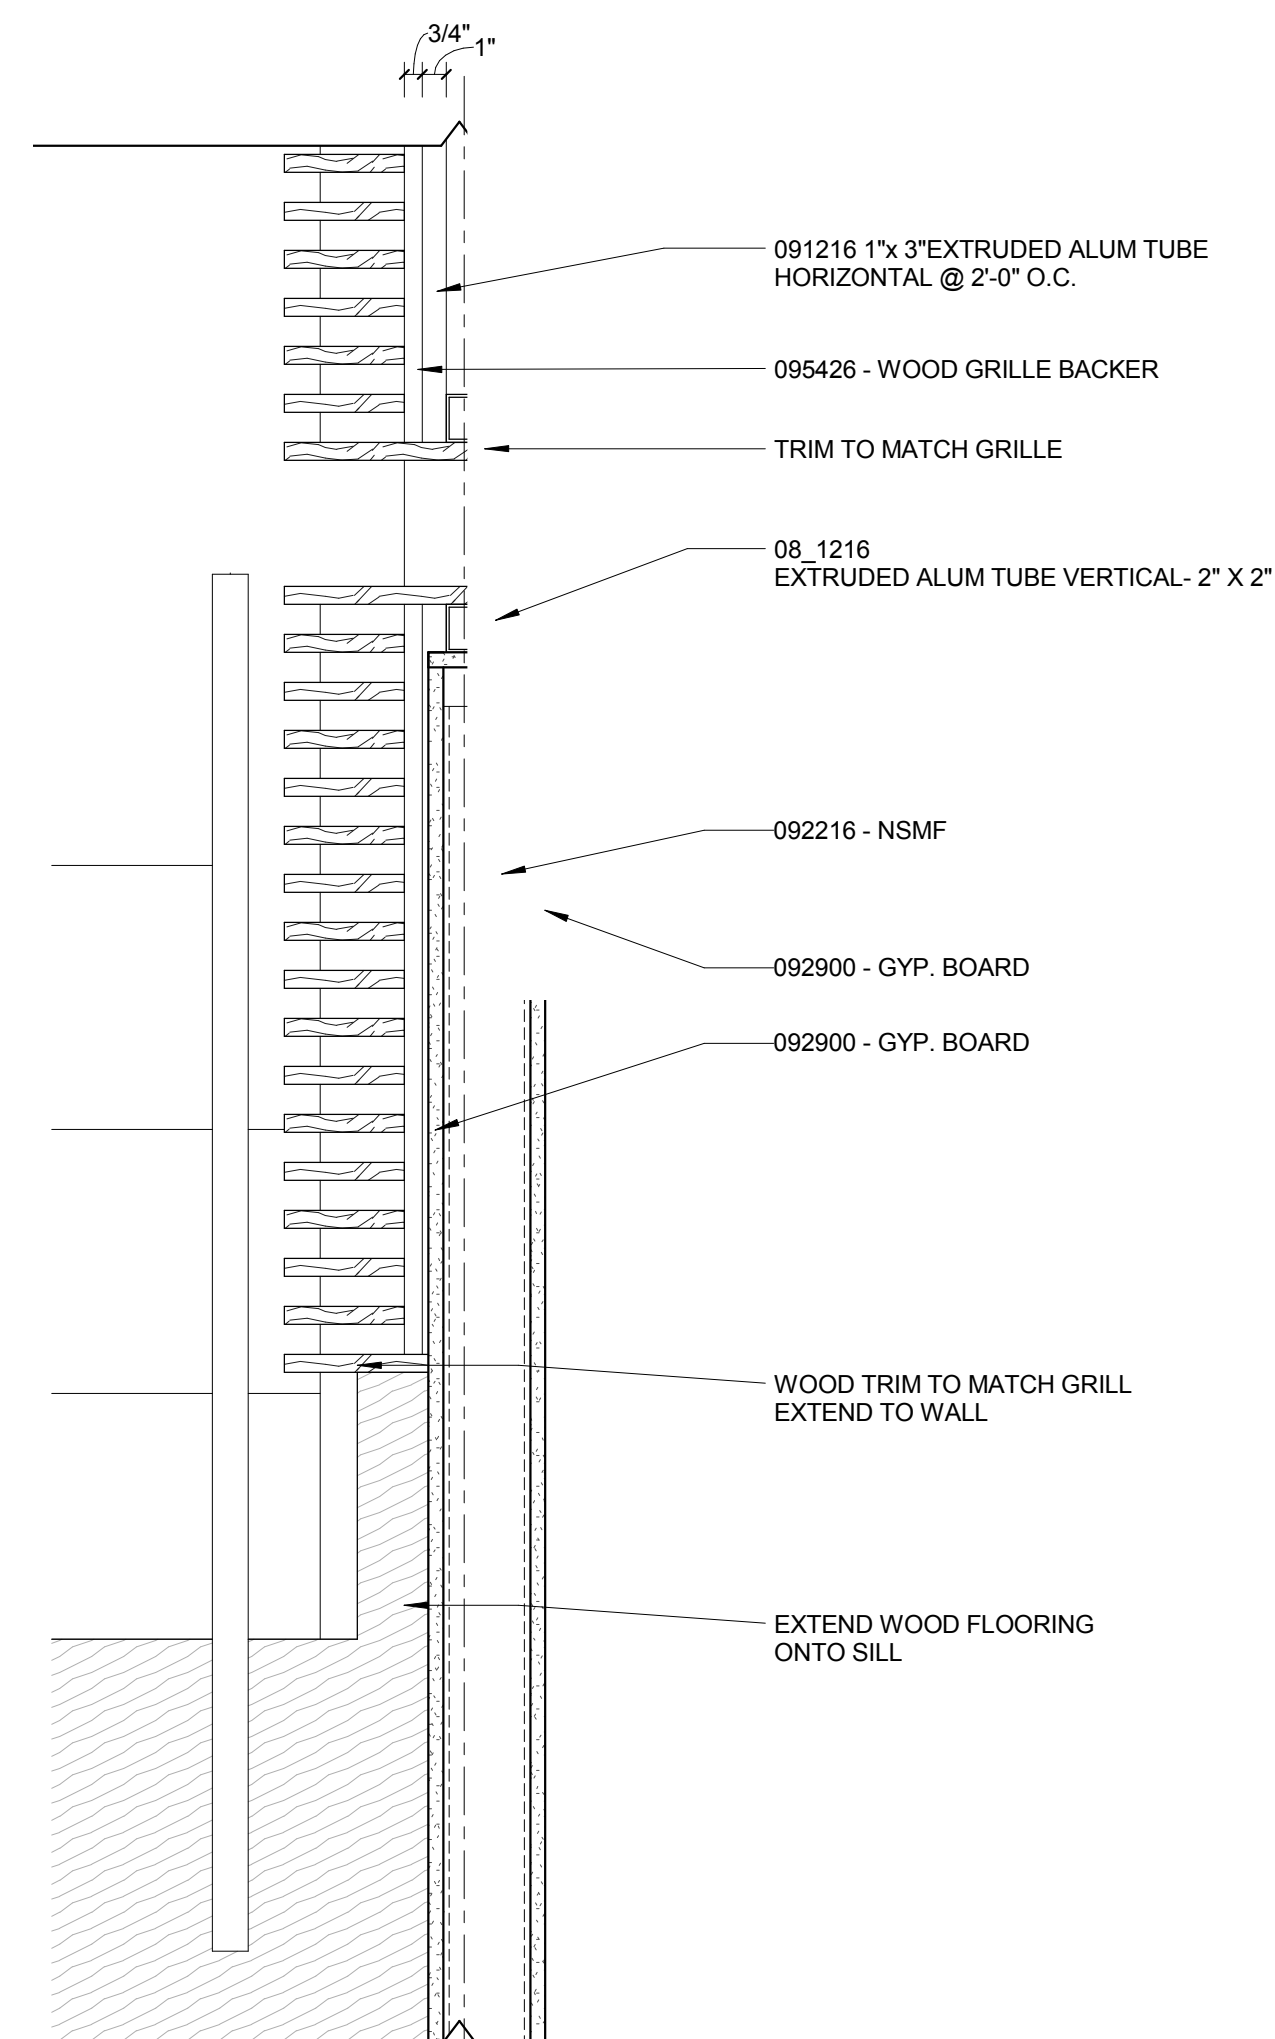


16 WOOD GRILLE AT STAGE STAIR

1 1/2" = 1'-0"

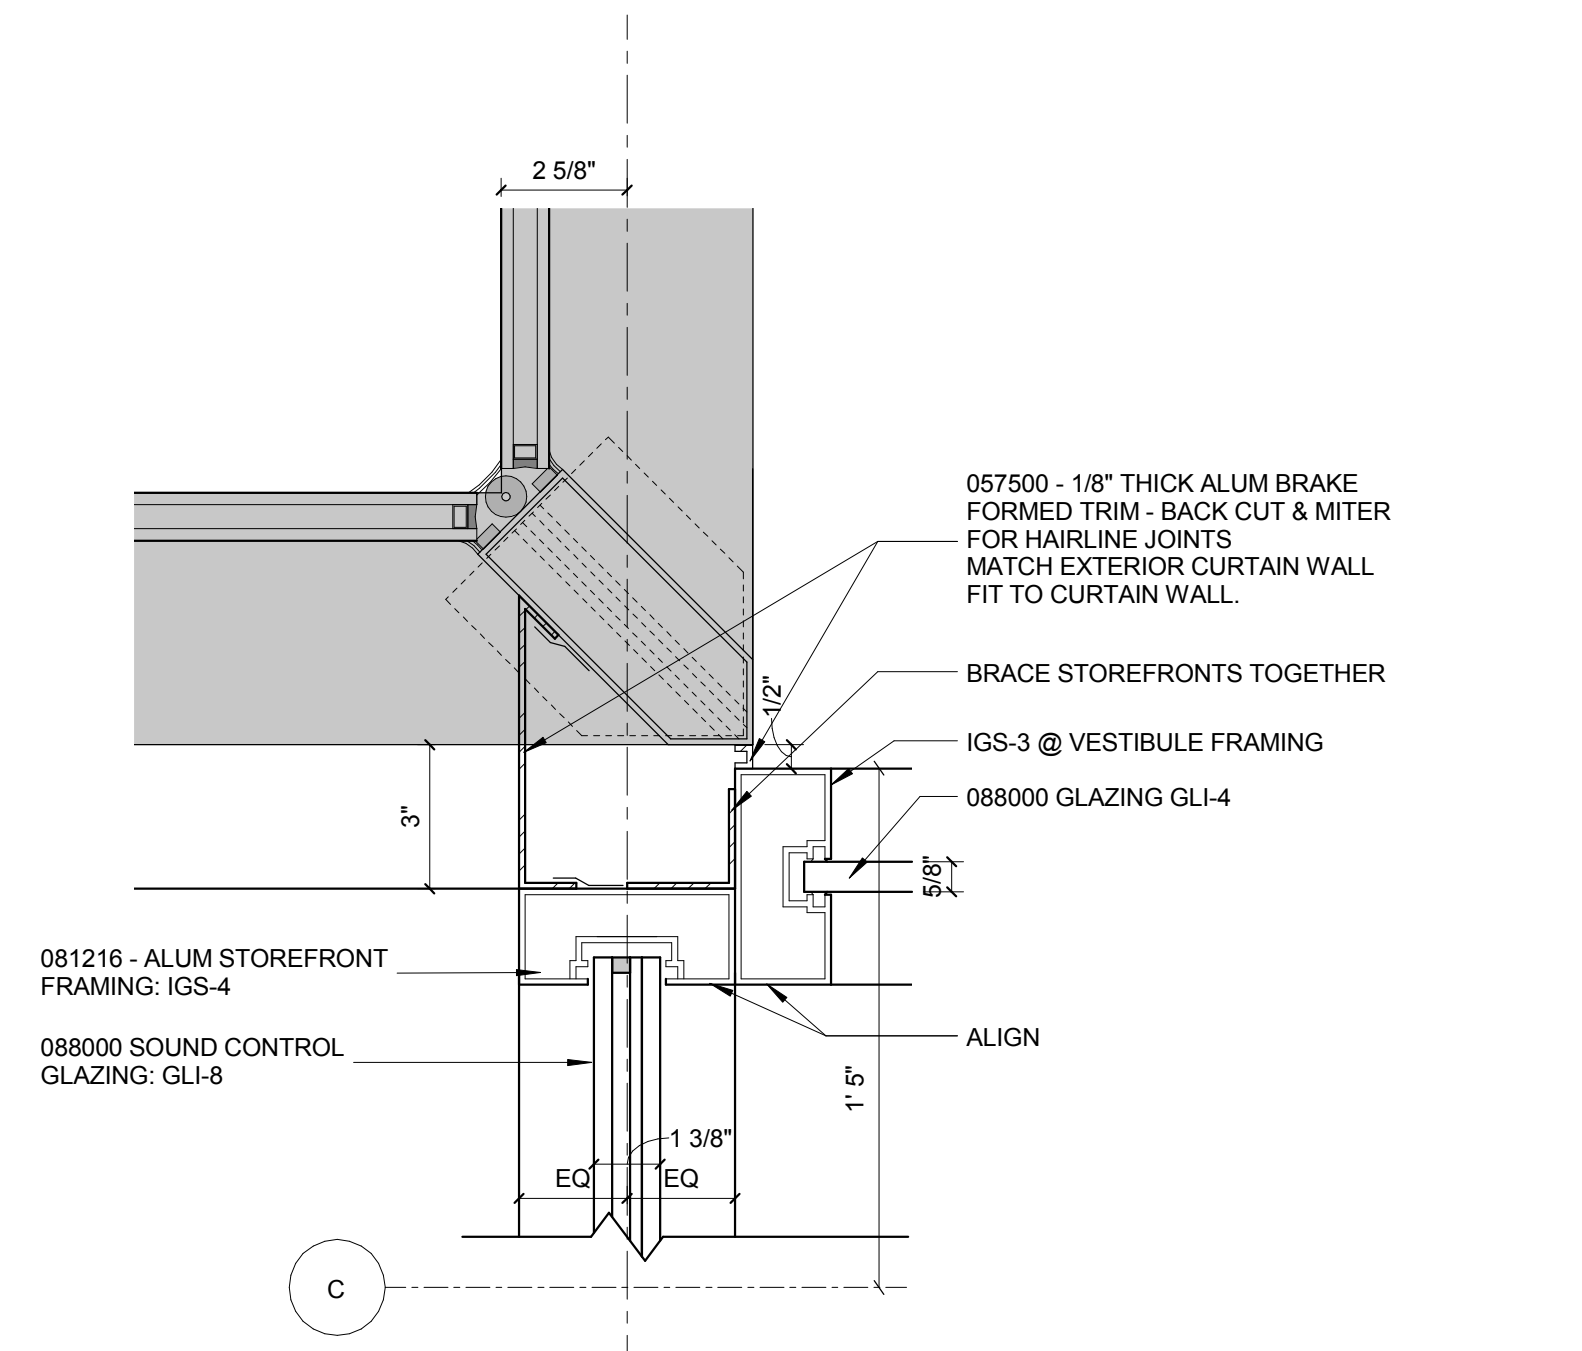


13 PLAN DETAIL - L02 @ EXTERIOR

3" = 1'-0"

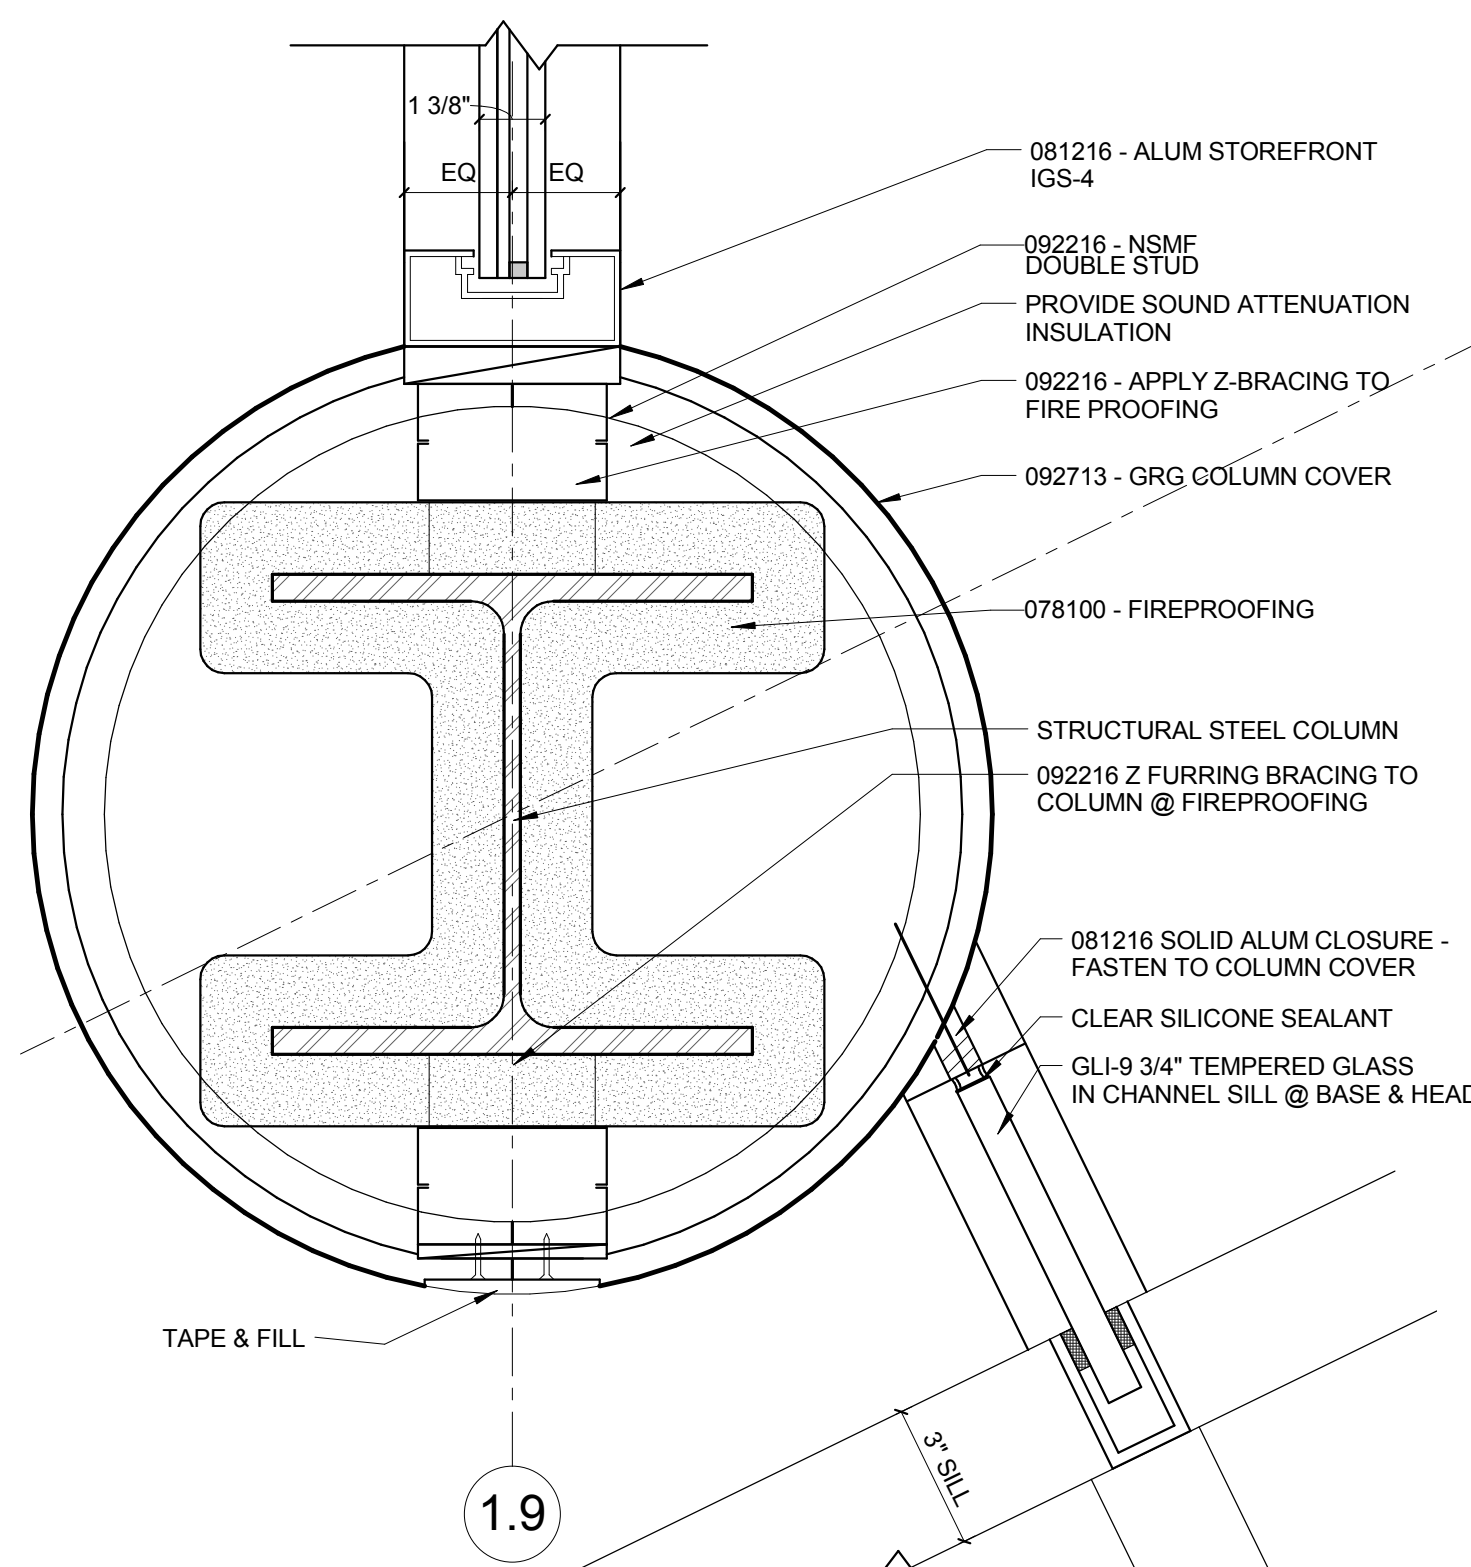


12 COLUMN AT ENTRY

3" = 1'-0"

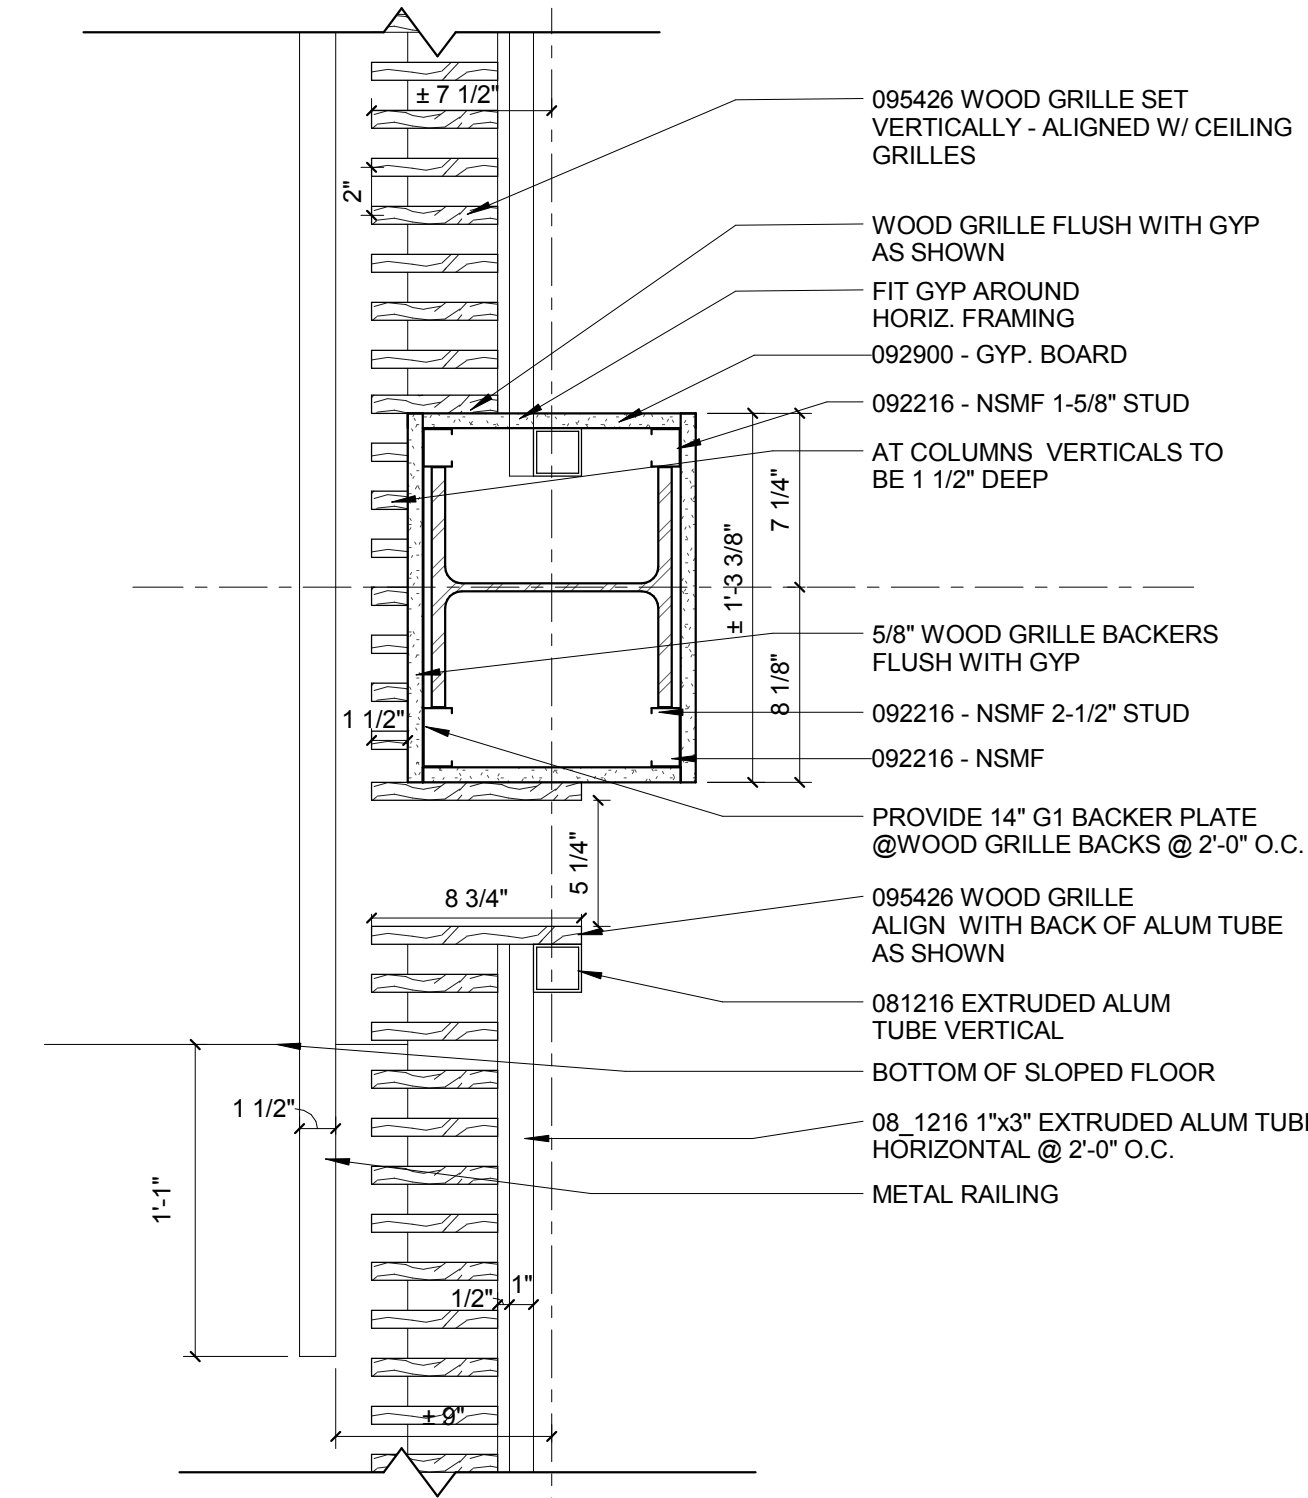


11 PLAN DETAIL - WOOD GRILLE AT COLUMN

1 1/2" = 1'-0"

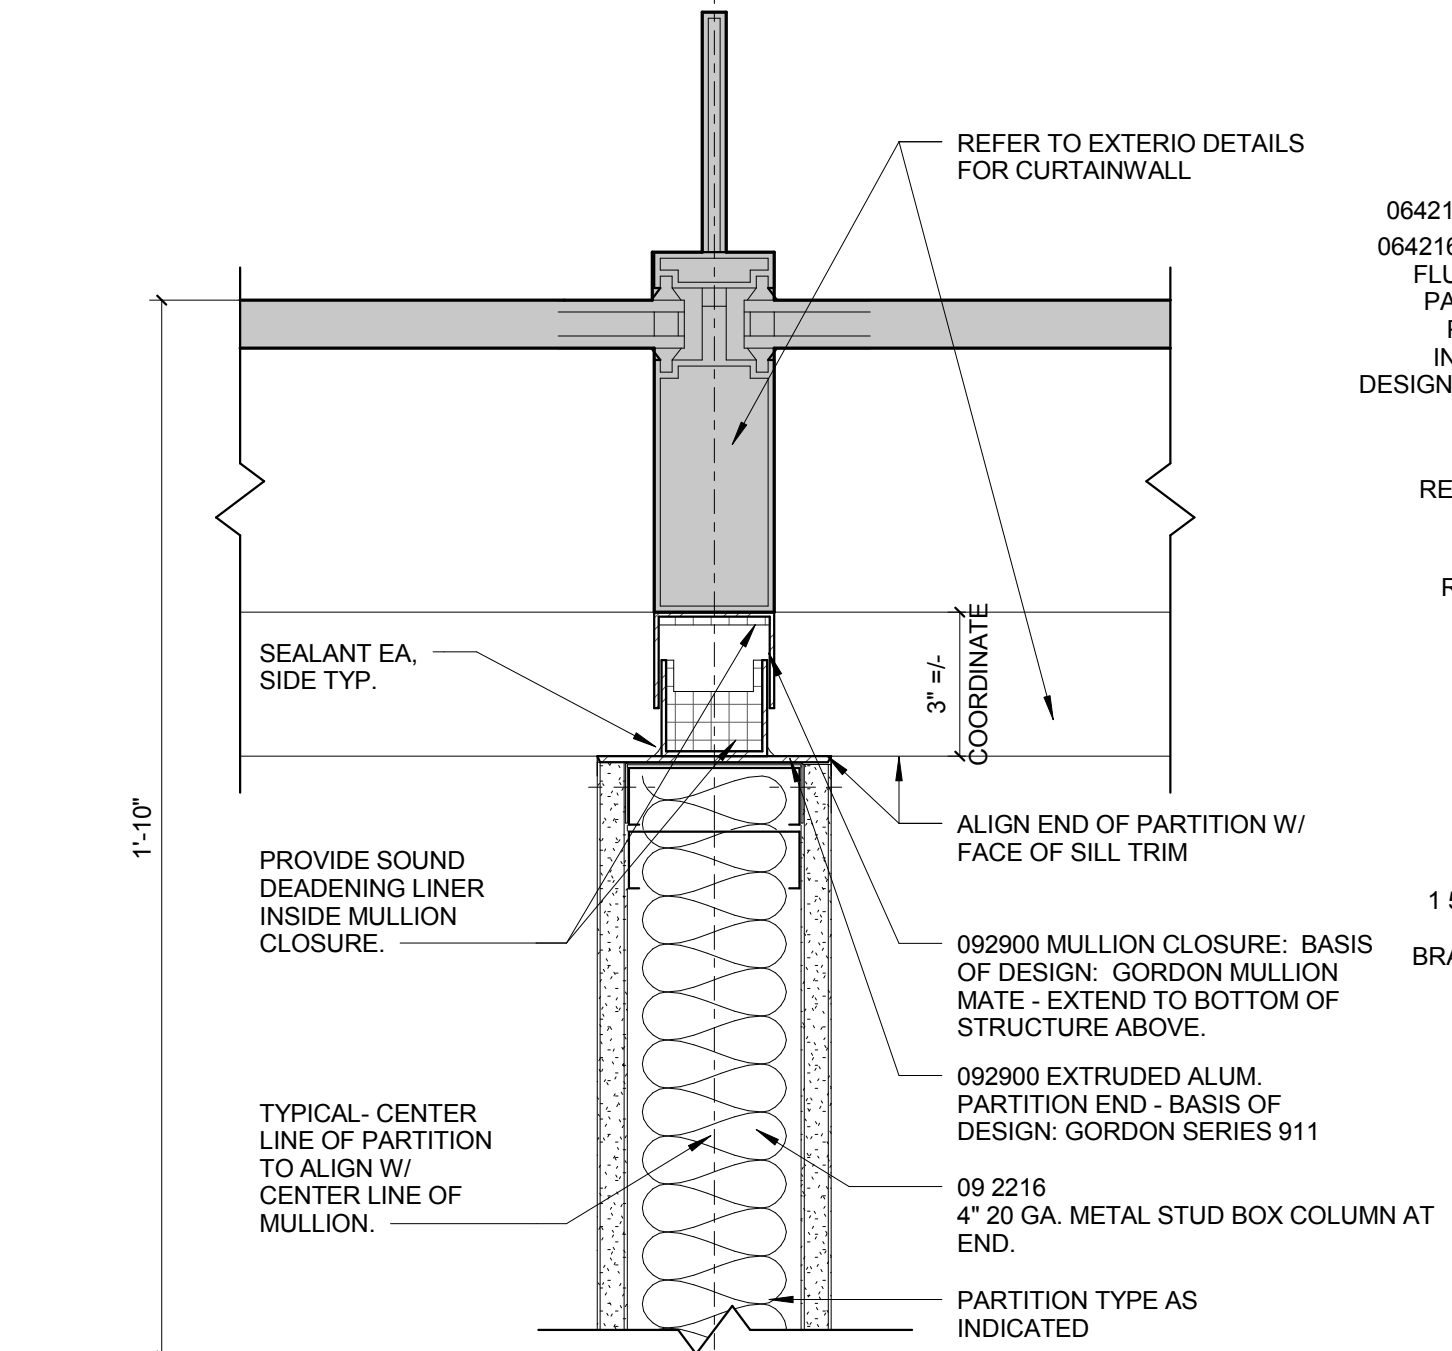


9 PLAN DETAIL AT EXTERIOR CURTAINWALL

3" = 1'-0"

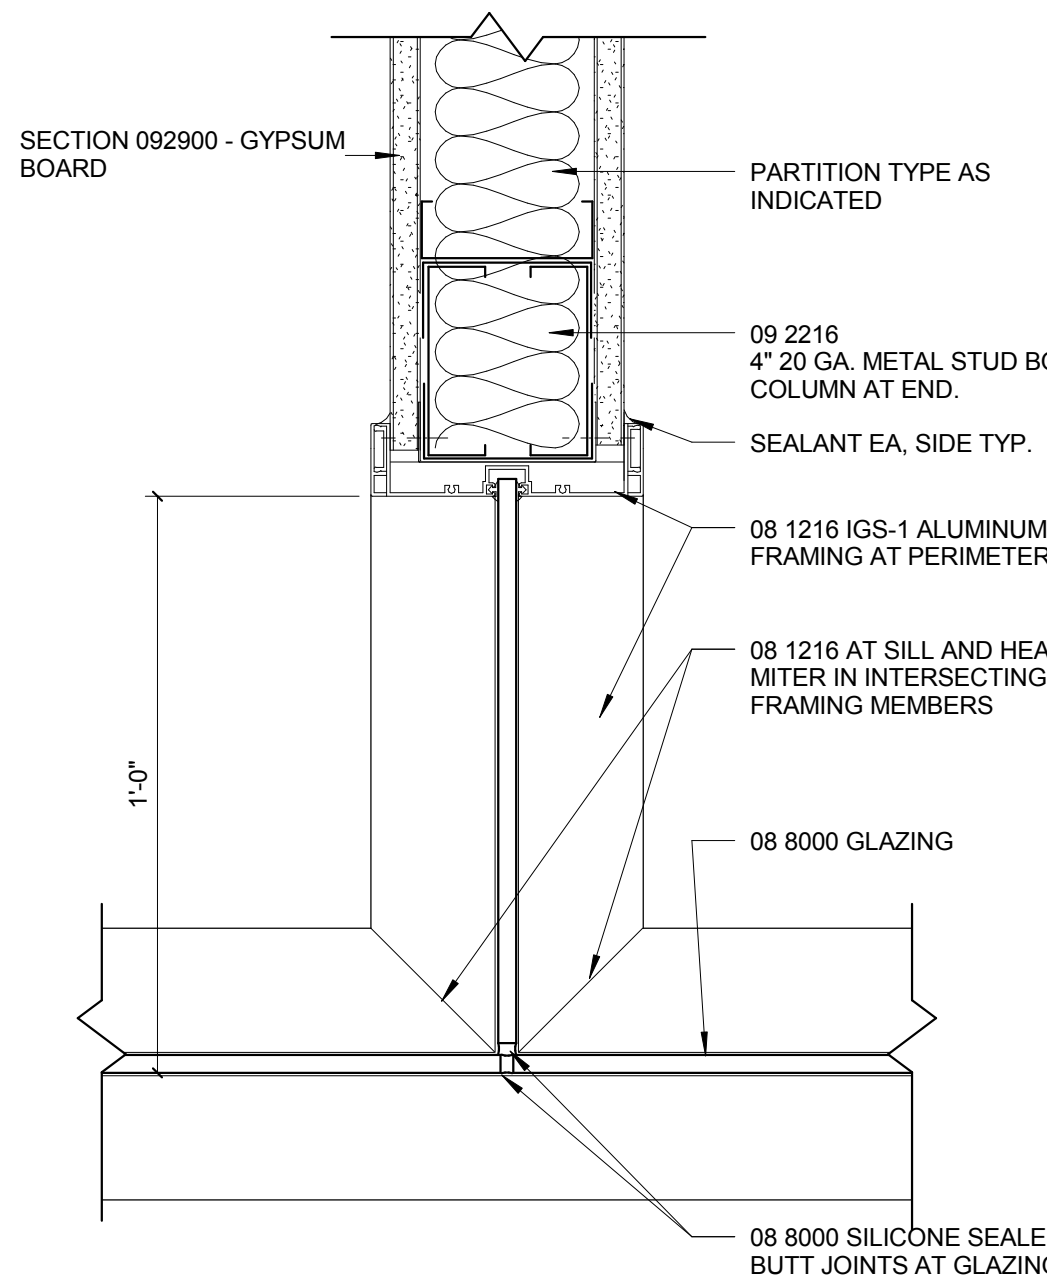


8 PLAN DETAIL AT GLAZING INTERSECTION

3" = 1'-0"

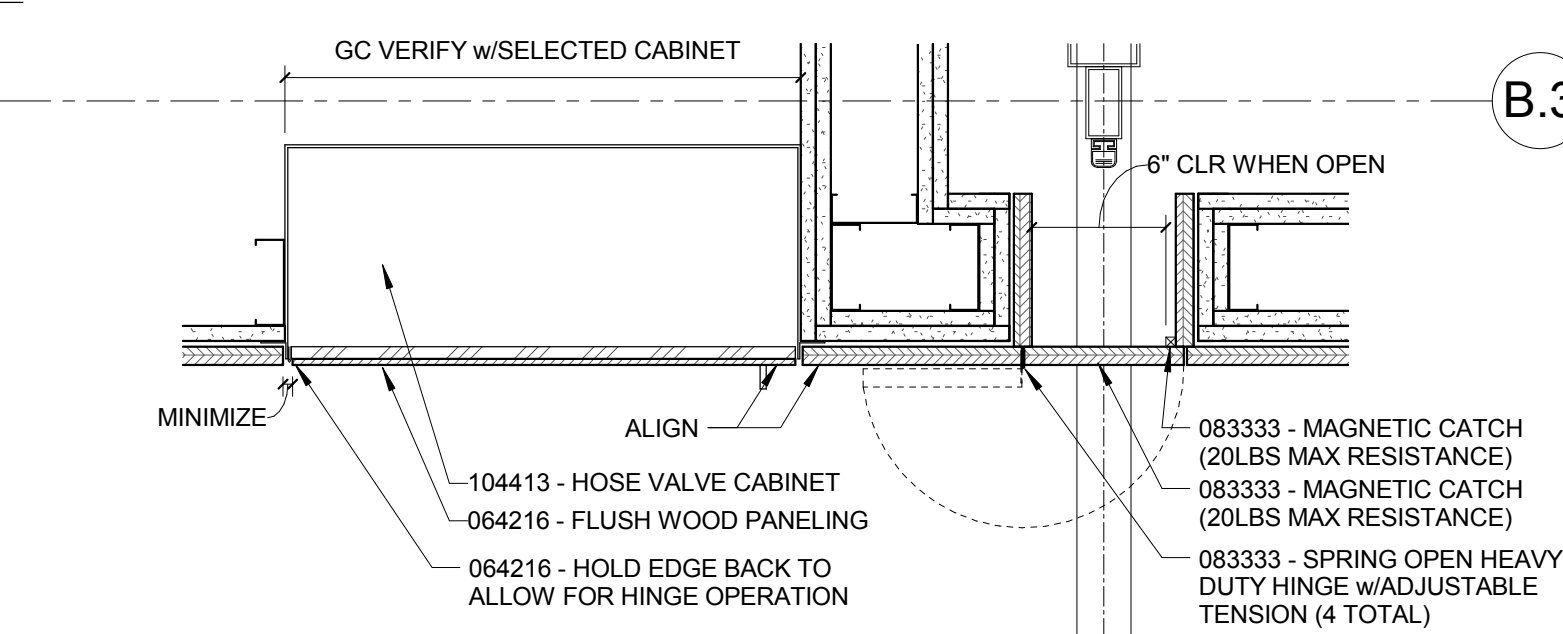


7 PLAN DETAIL - SIDE COILING POCKET/HOSE VALVE CAB

1 1/2" = 1'-0"

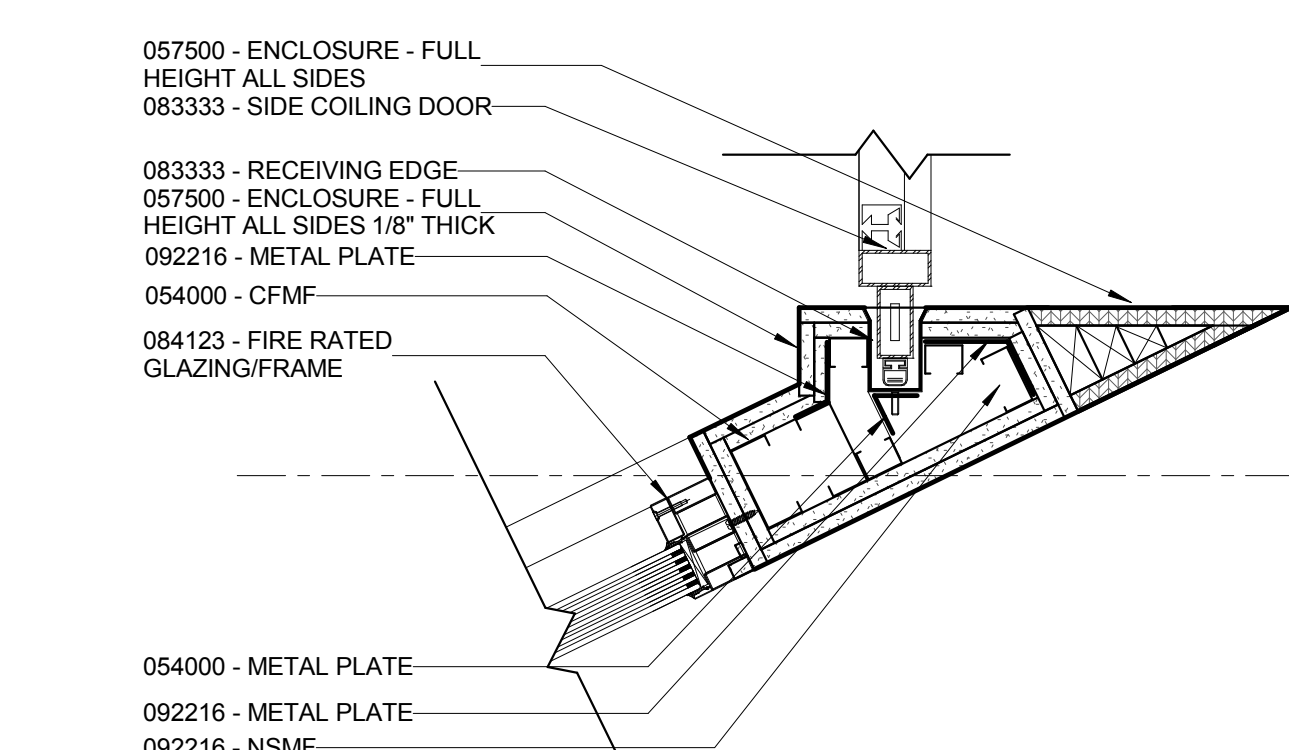


6 PLAN DETAIL - RATED GLAZING/SIDE COILING INTERSECTION

1 1/2" = 1'-0"

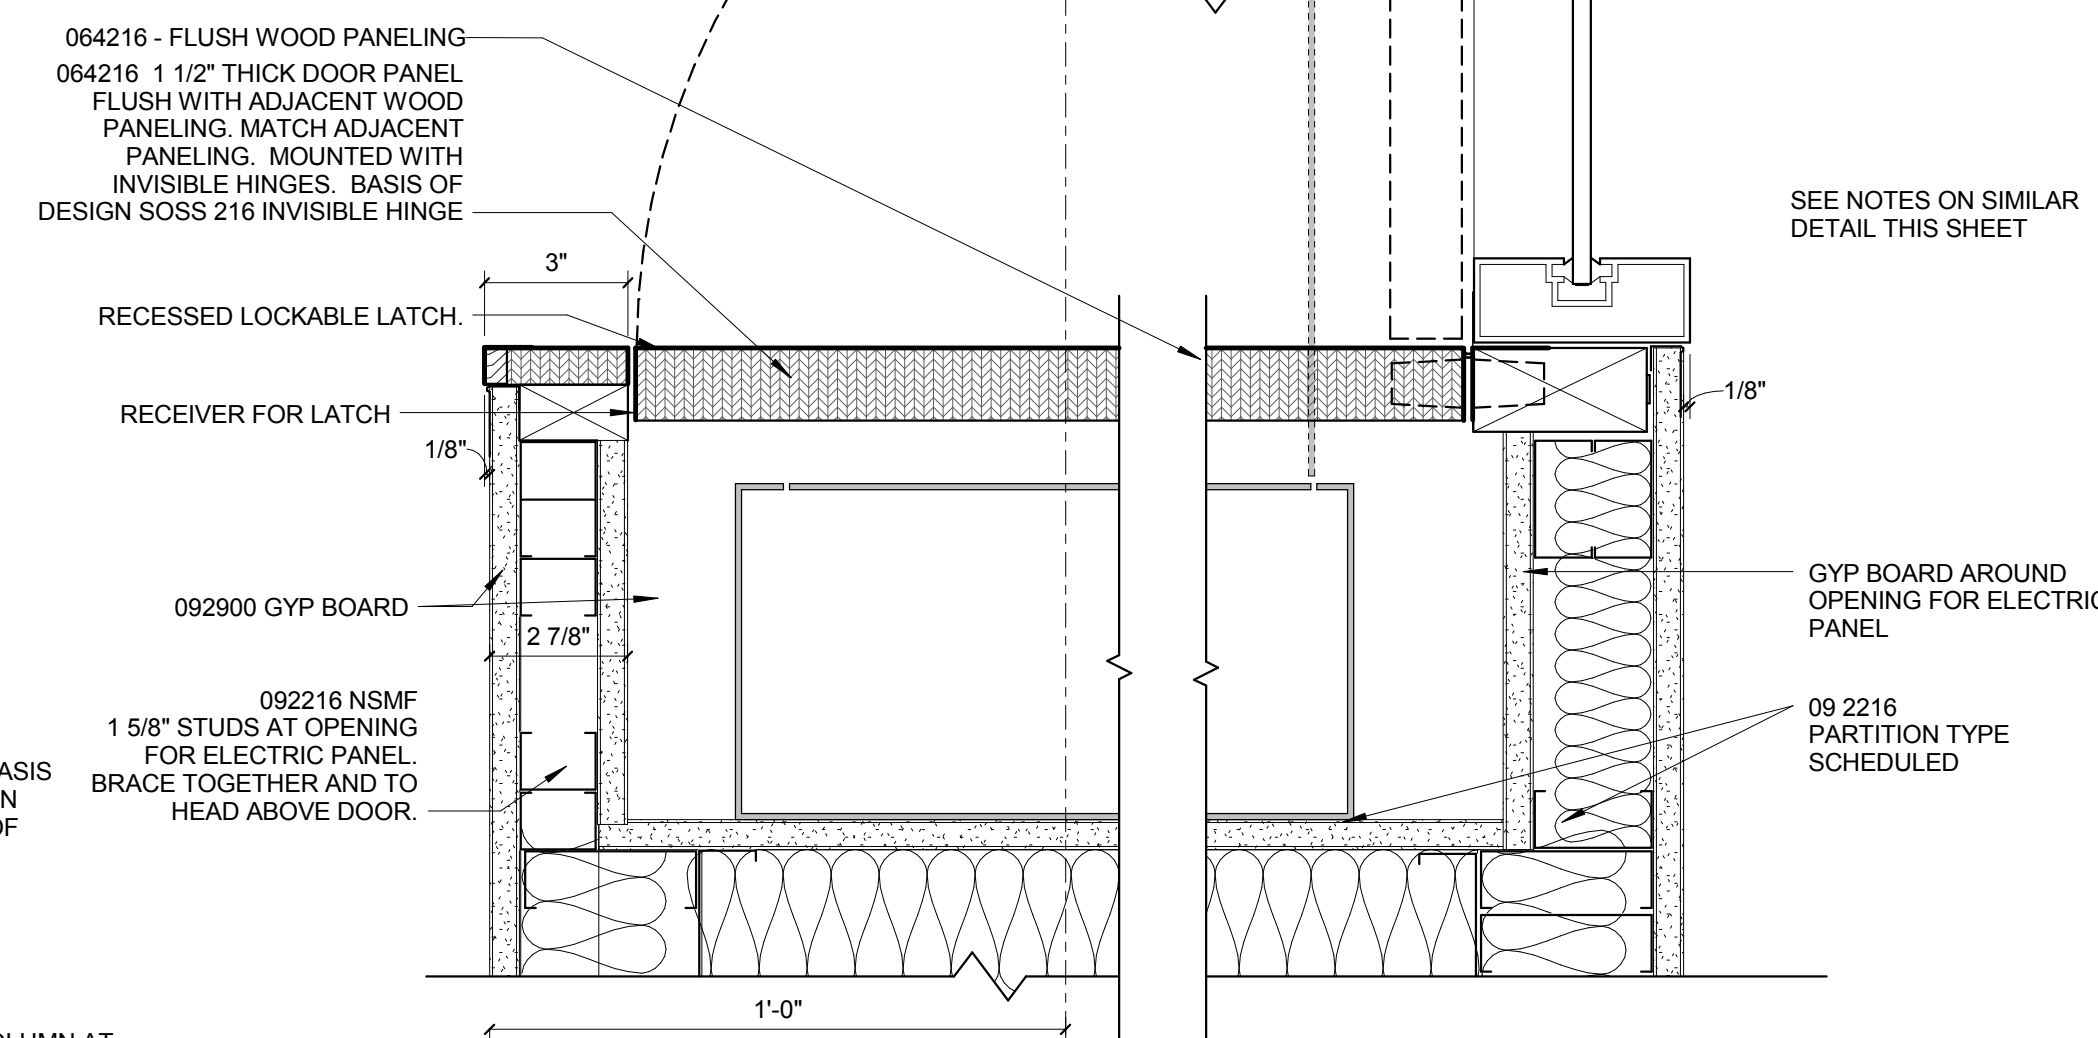


4 PLAN DETAIL AT WOOD JAMB-ELECTRIC PANEL

3" = 1'-0"

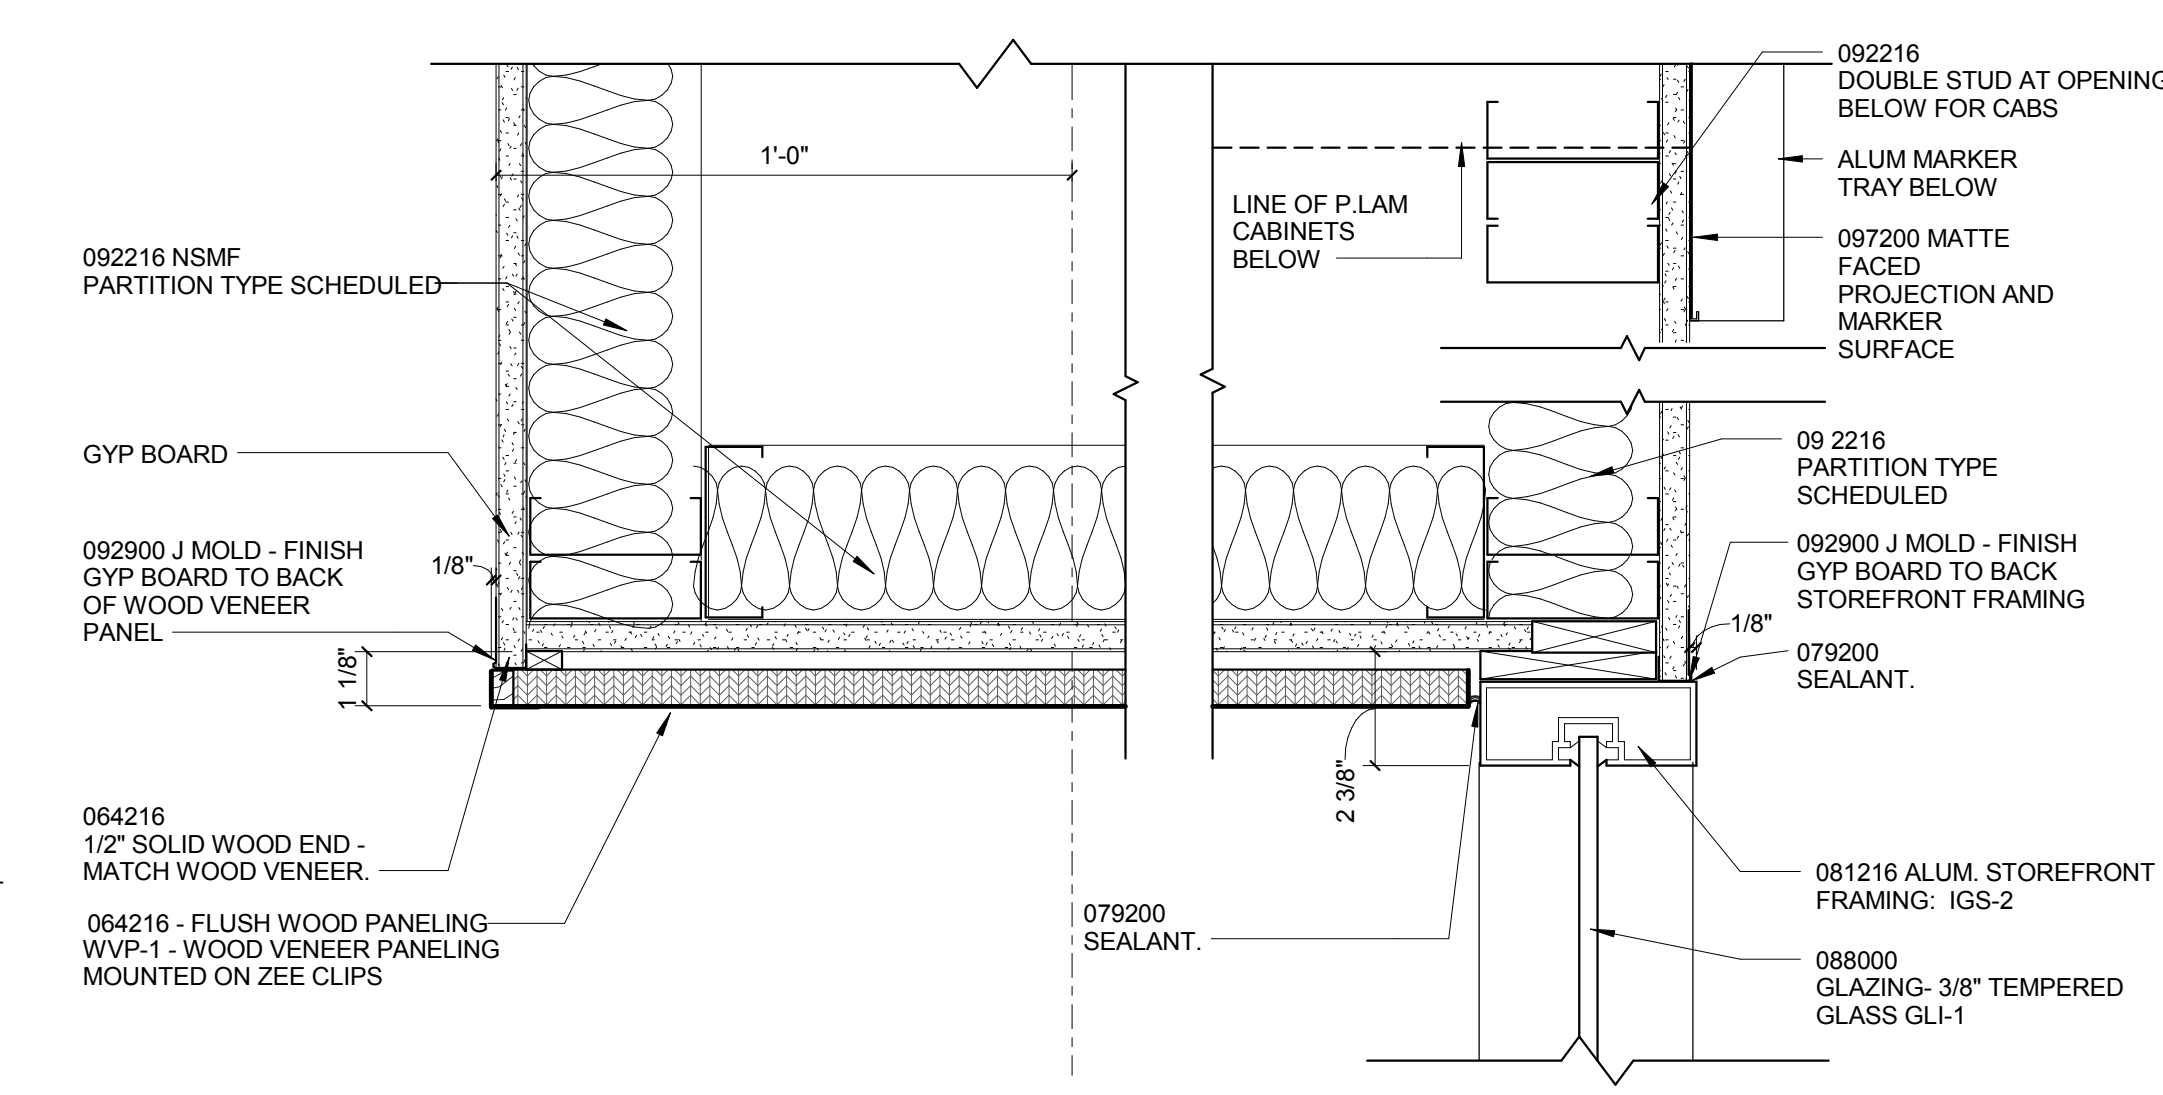


3 PLAN DETAIL AT WOOD JAMB

3" = 1'-0"

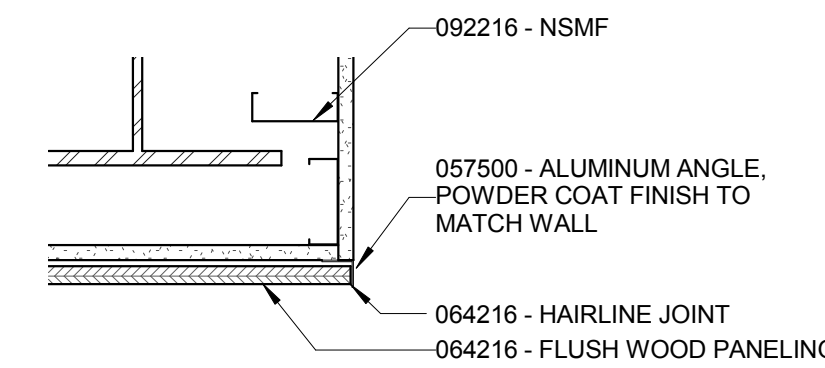

2 PLAN DETAIL - TYP. WOOD PANEL OUTSIDE CORNER TO GWB

1 1/2" = 1'-0"

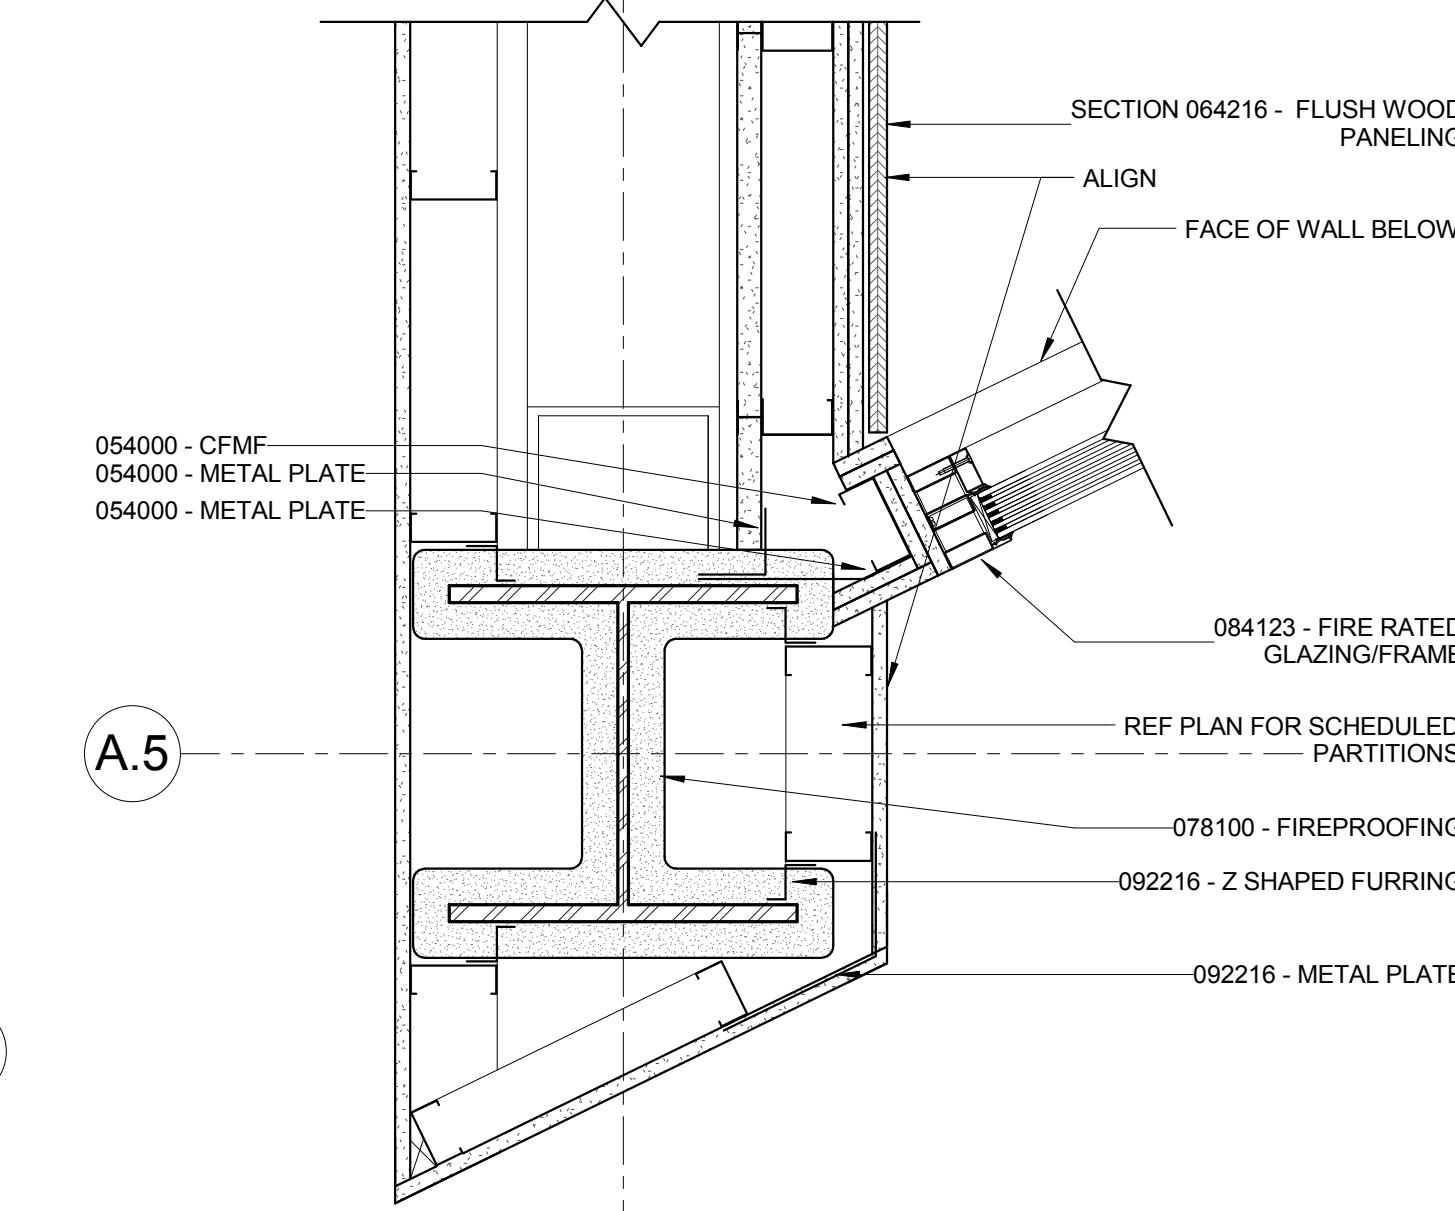

1 PLAN DETAIL - RATED GLAZING @ COLUMN

1 1/2" = 1'-0"