

3	ASH-063	21 APR 2017
2	ASH-060	13 APR 2017
1	ADDENDUM 3-2	16 APR 2016
-	ISSUED FOR CONSTRUCTION (BP3)	15 MAR 2016
No.	Description	Date


Drawing Title:

INTERIOR PLAN DETAILS


Project No.: 04561.01

Checked by:


A0811

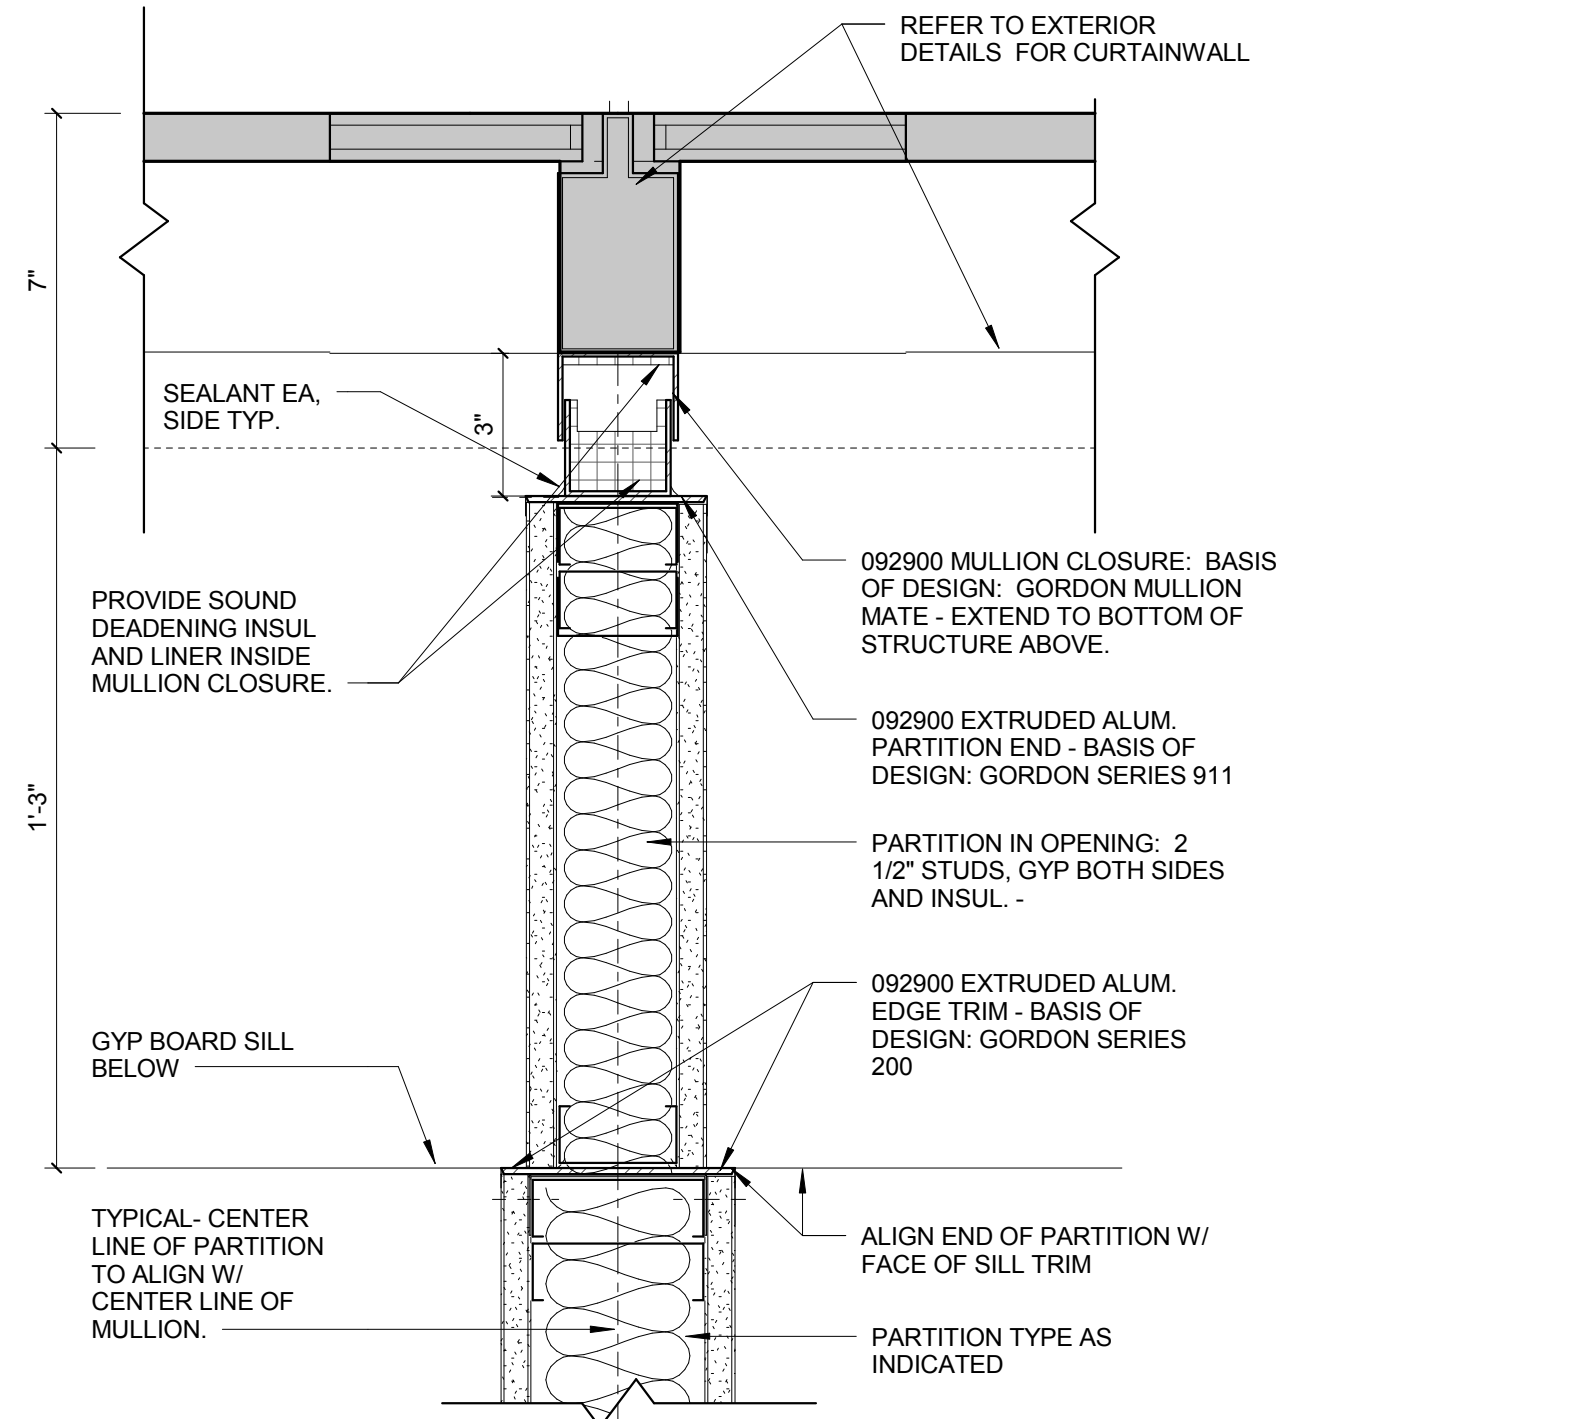


5 PLAN DETAIL AT PROJECTED WINDOW
3" = 1'-0"

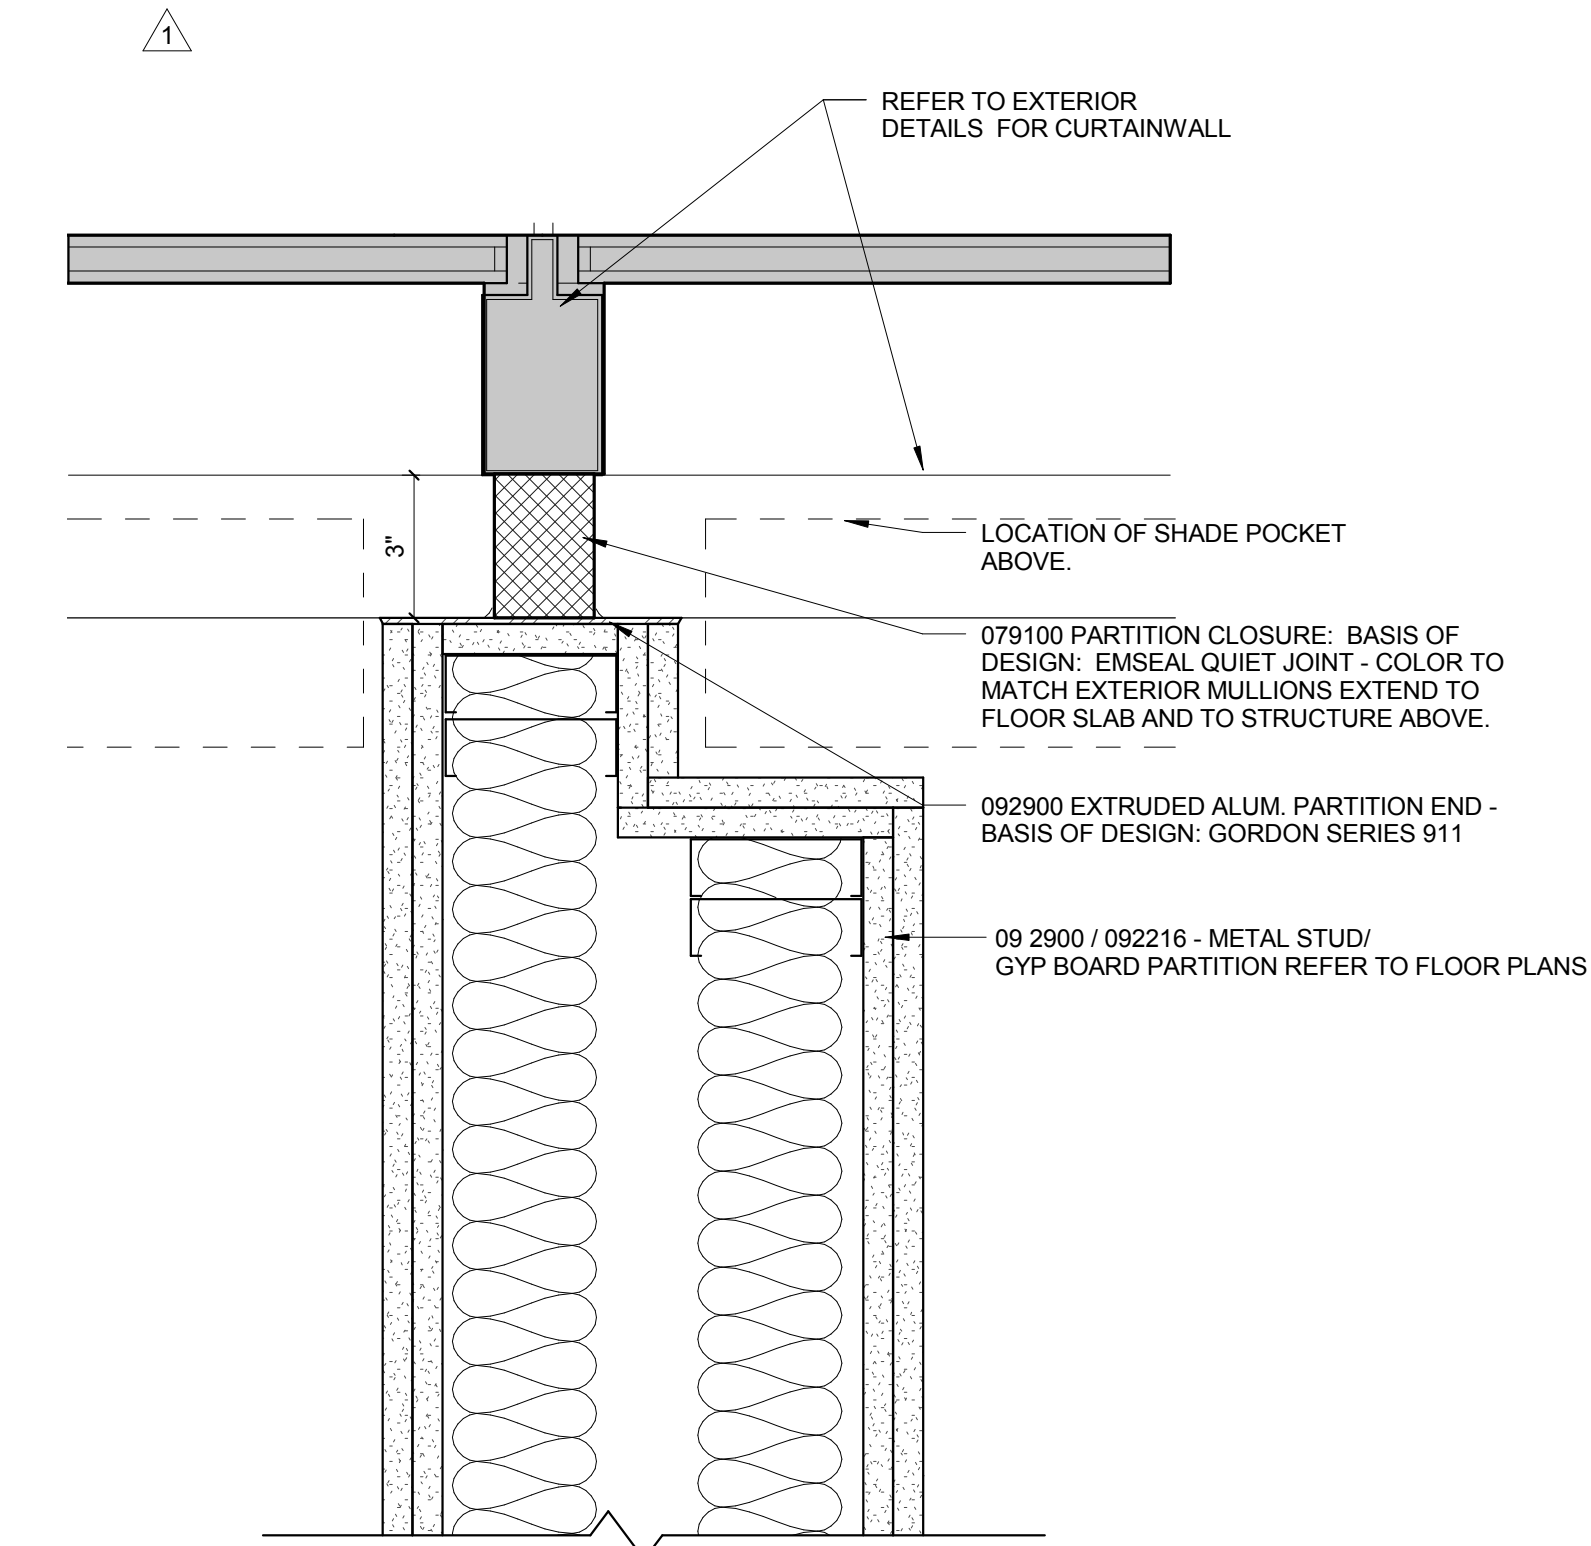


1 PLAN DETAIL - WEST WALL
3" = 1'-0"

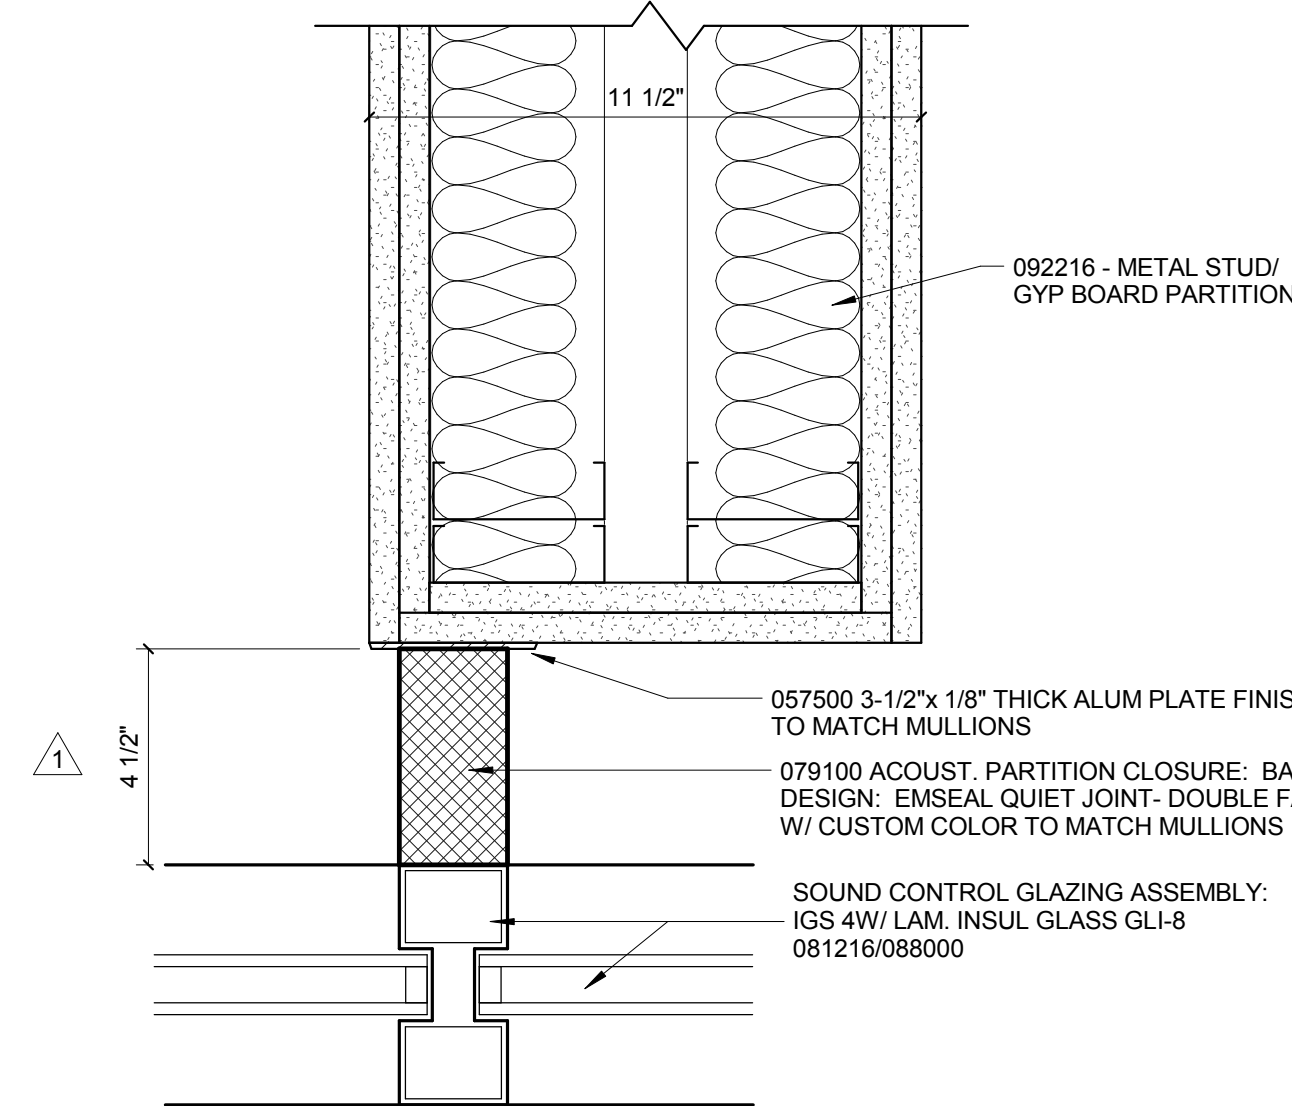


2 PLAN DETAIL - LEVEL 02 @ GLAZING
3" = 1'-0"

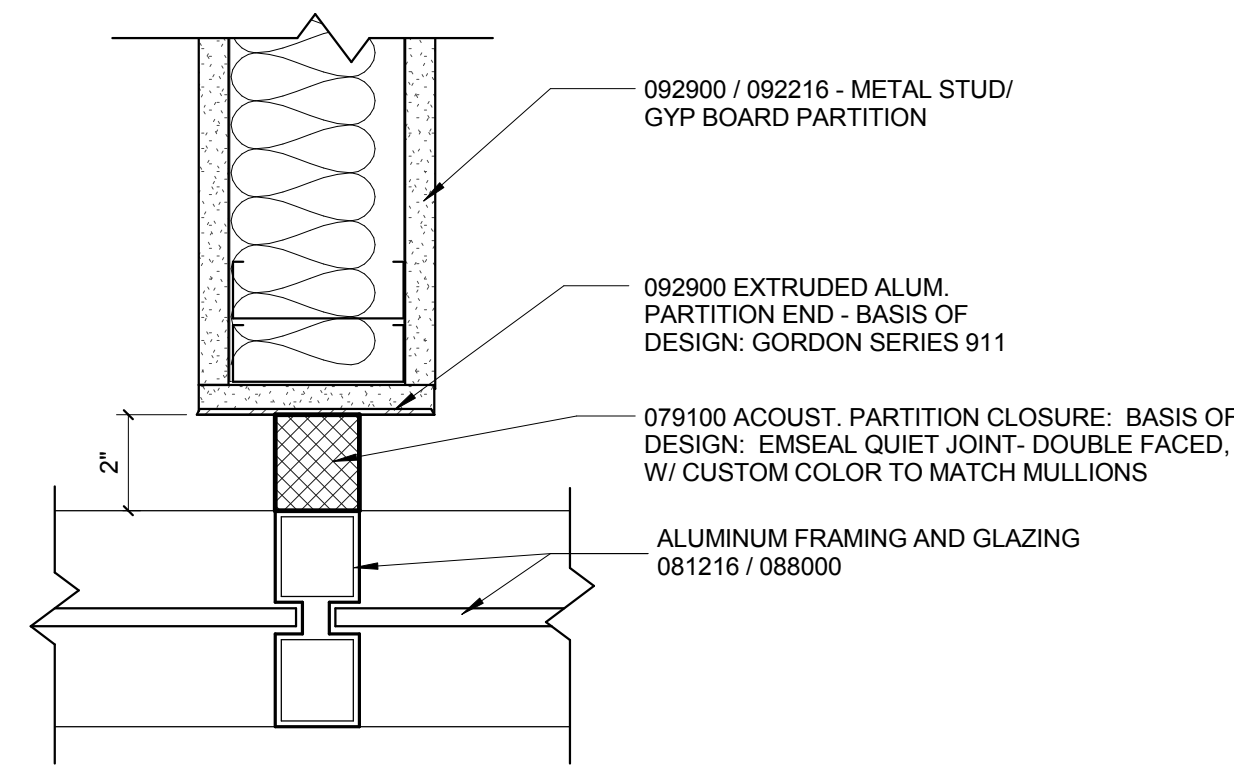

7 PLAN DETAIL - TYPICAL CLOSURE AT GLAZING
3" = 1'-0"

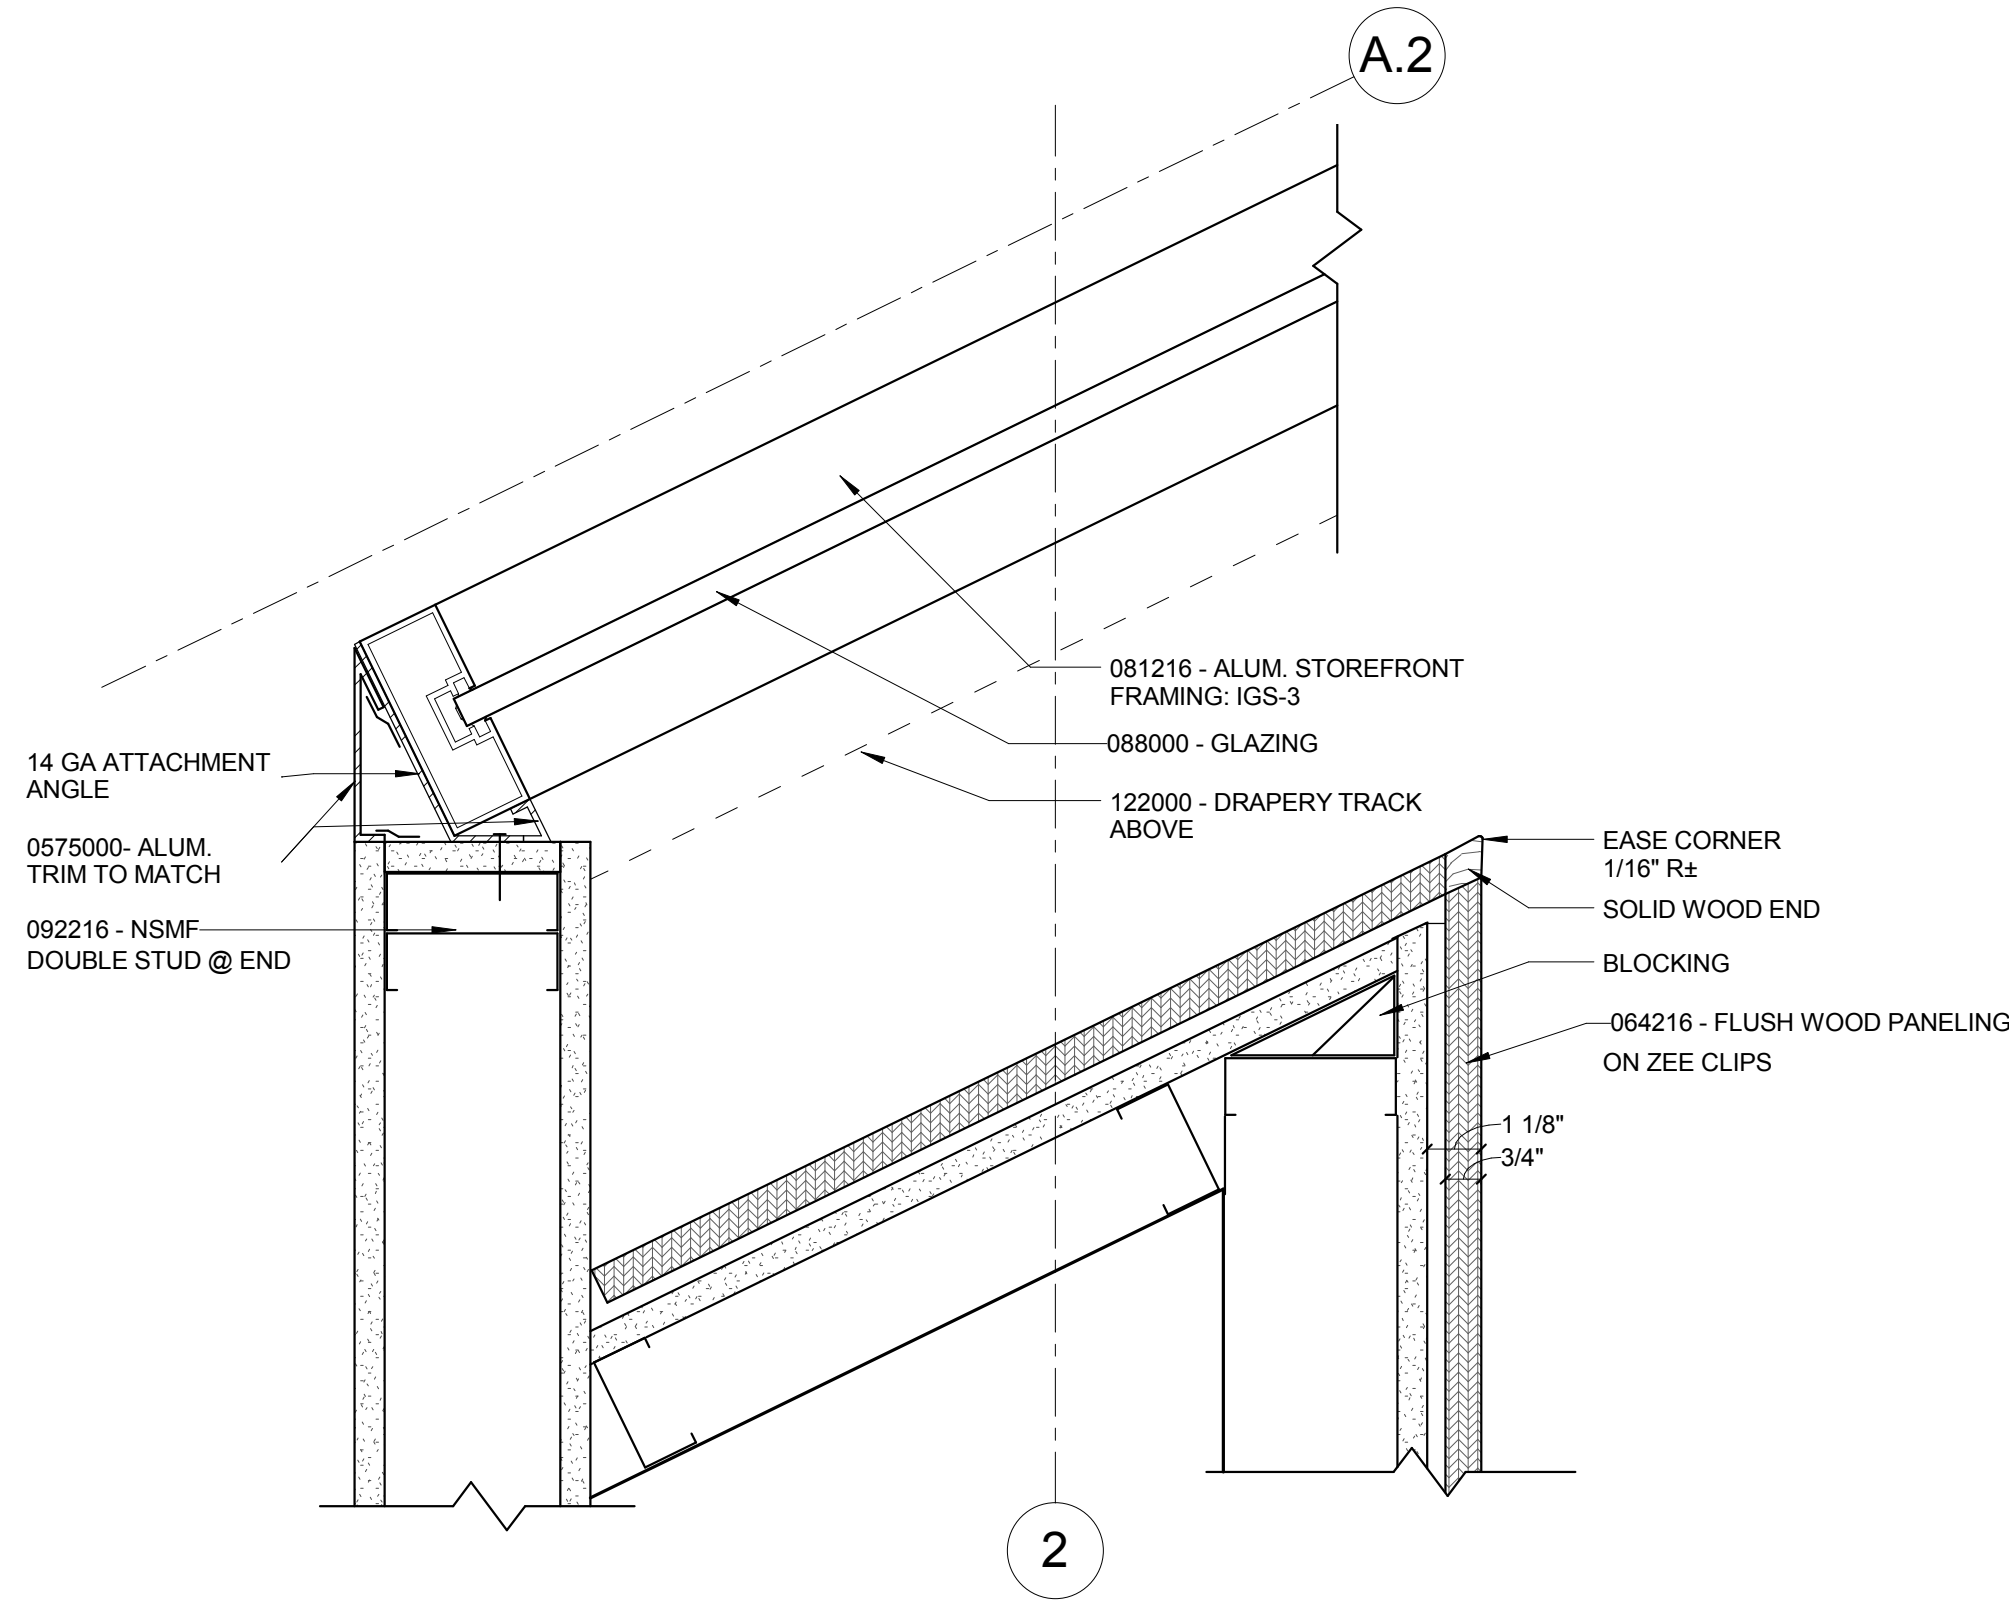


6 PLAN DETAIL AT CONF. ROOM
3" = 1'-0"

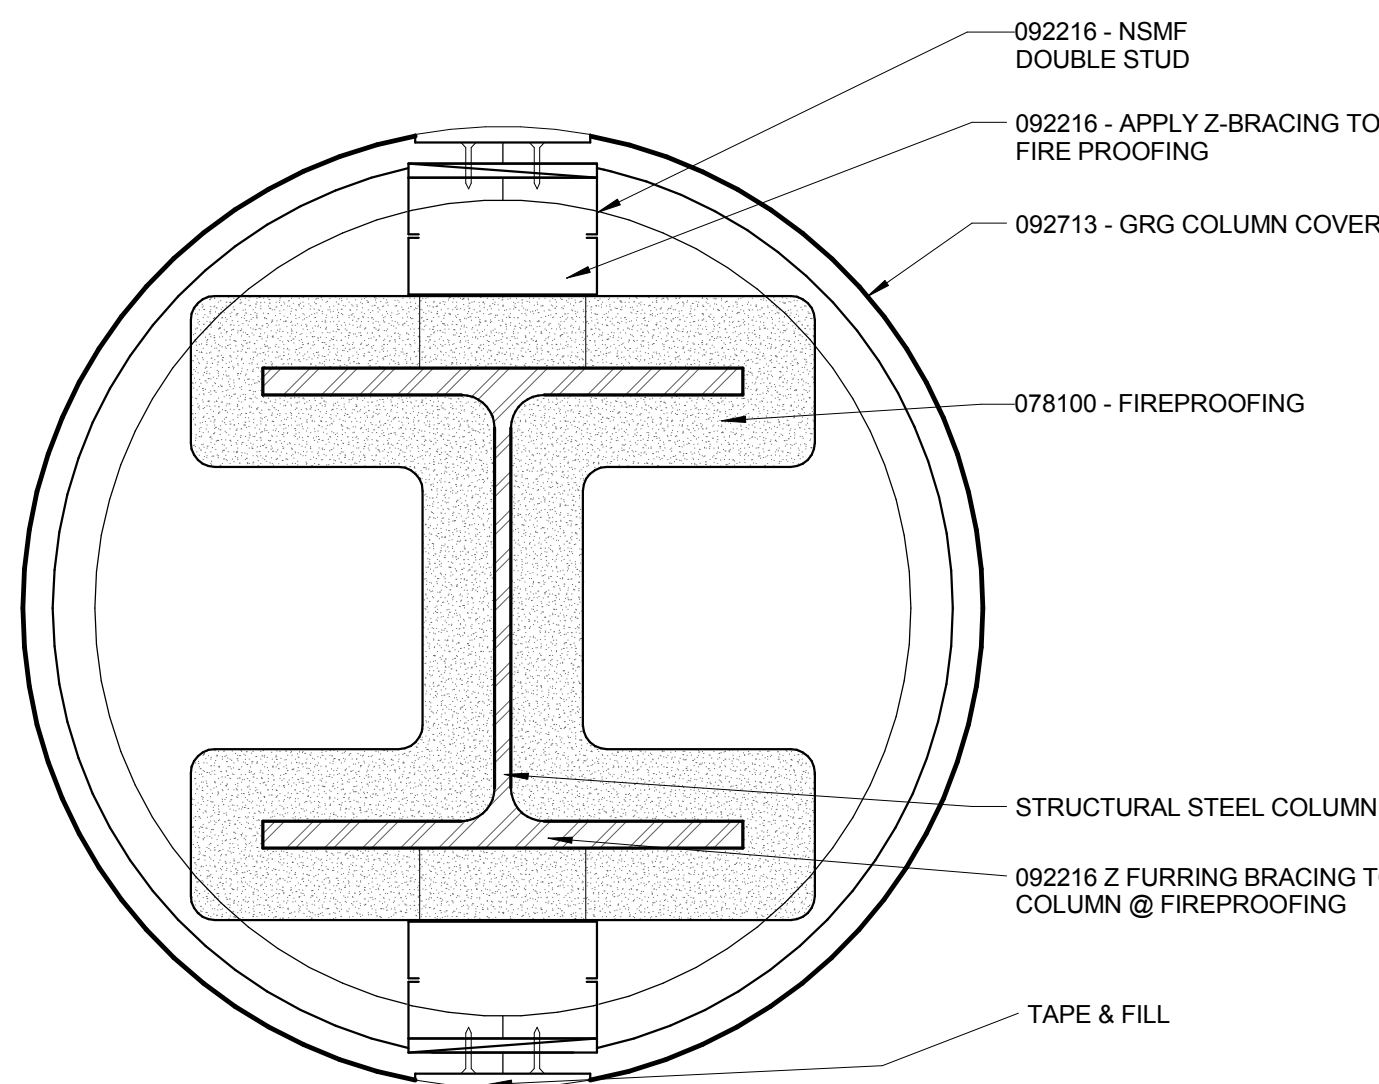


4 TYP. COLUMN
3" = 1'-0"

10 SECTION DETAIL OF VIDEO WALL @ LECTURE HALL
3" = 1'-0"

9 PLAN DETAIL OF VIDEO WALL @ LECTURE HALL
3" = 1'-0"

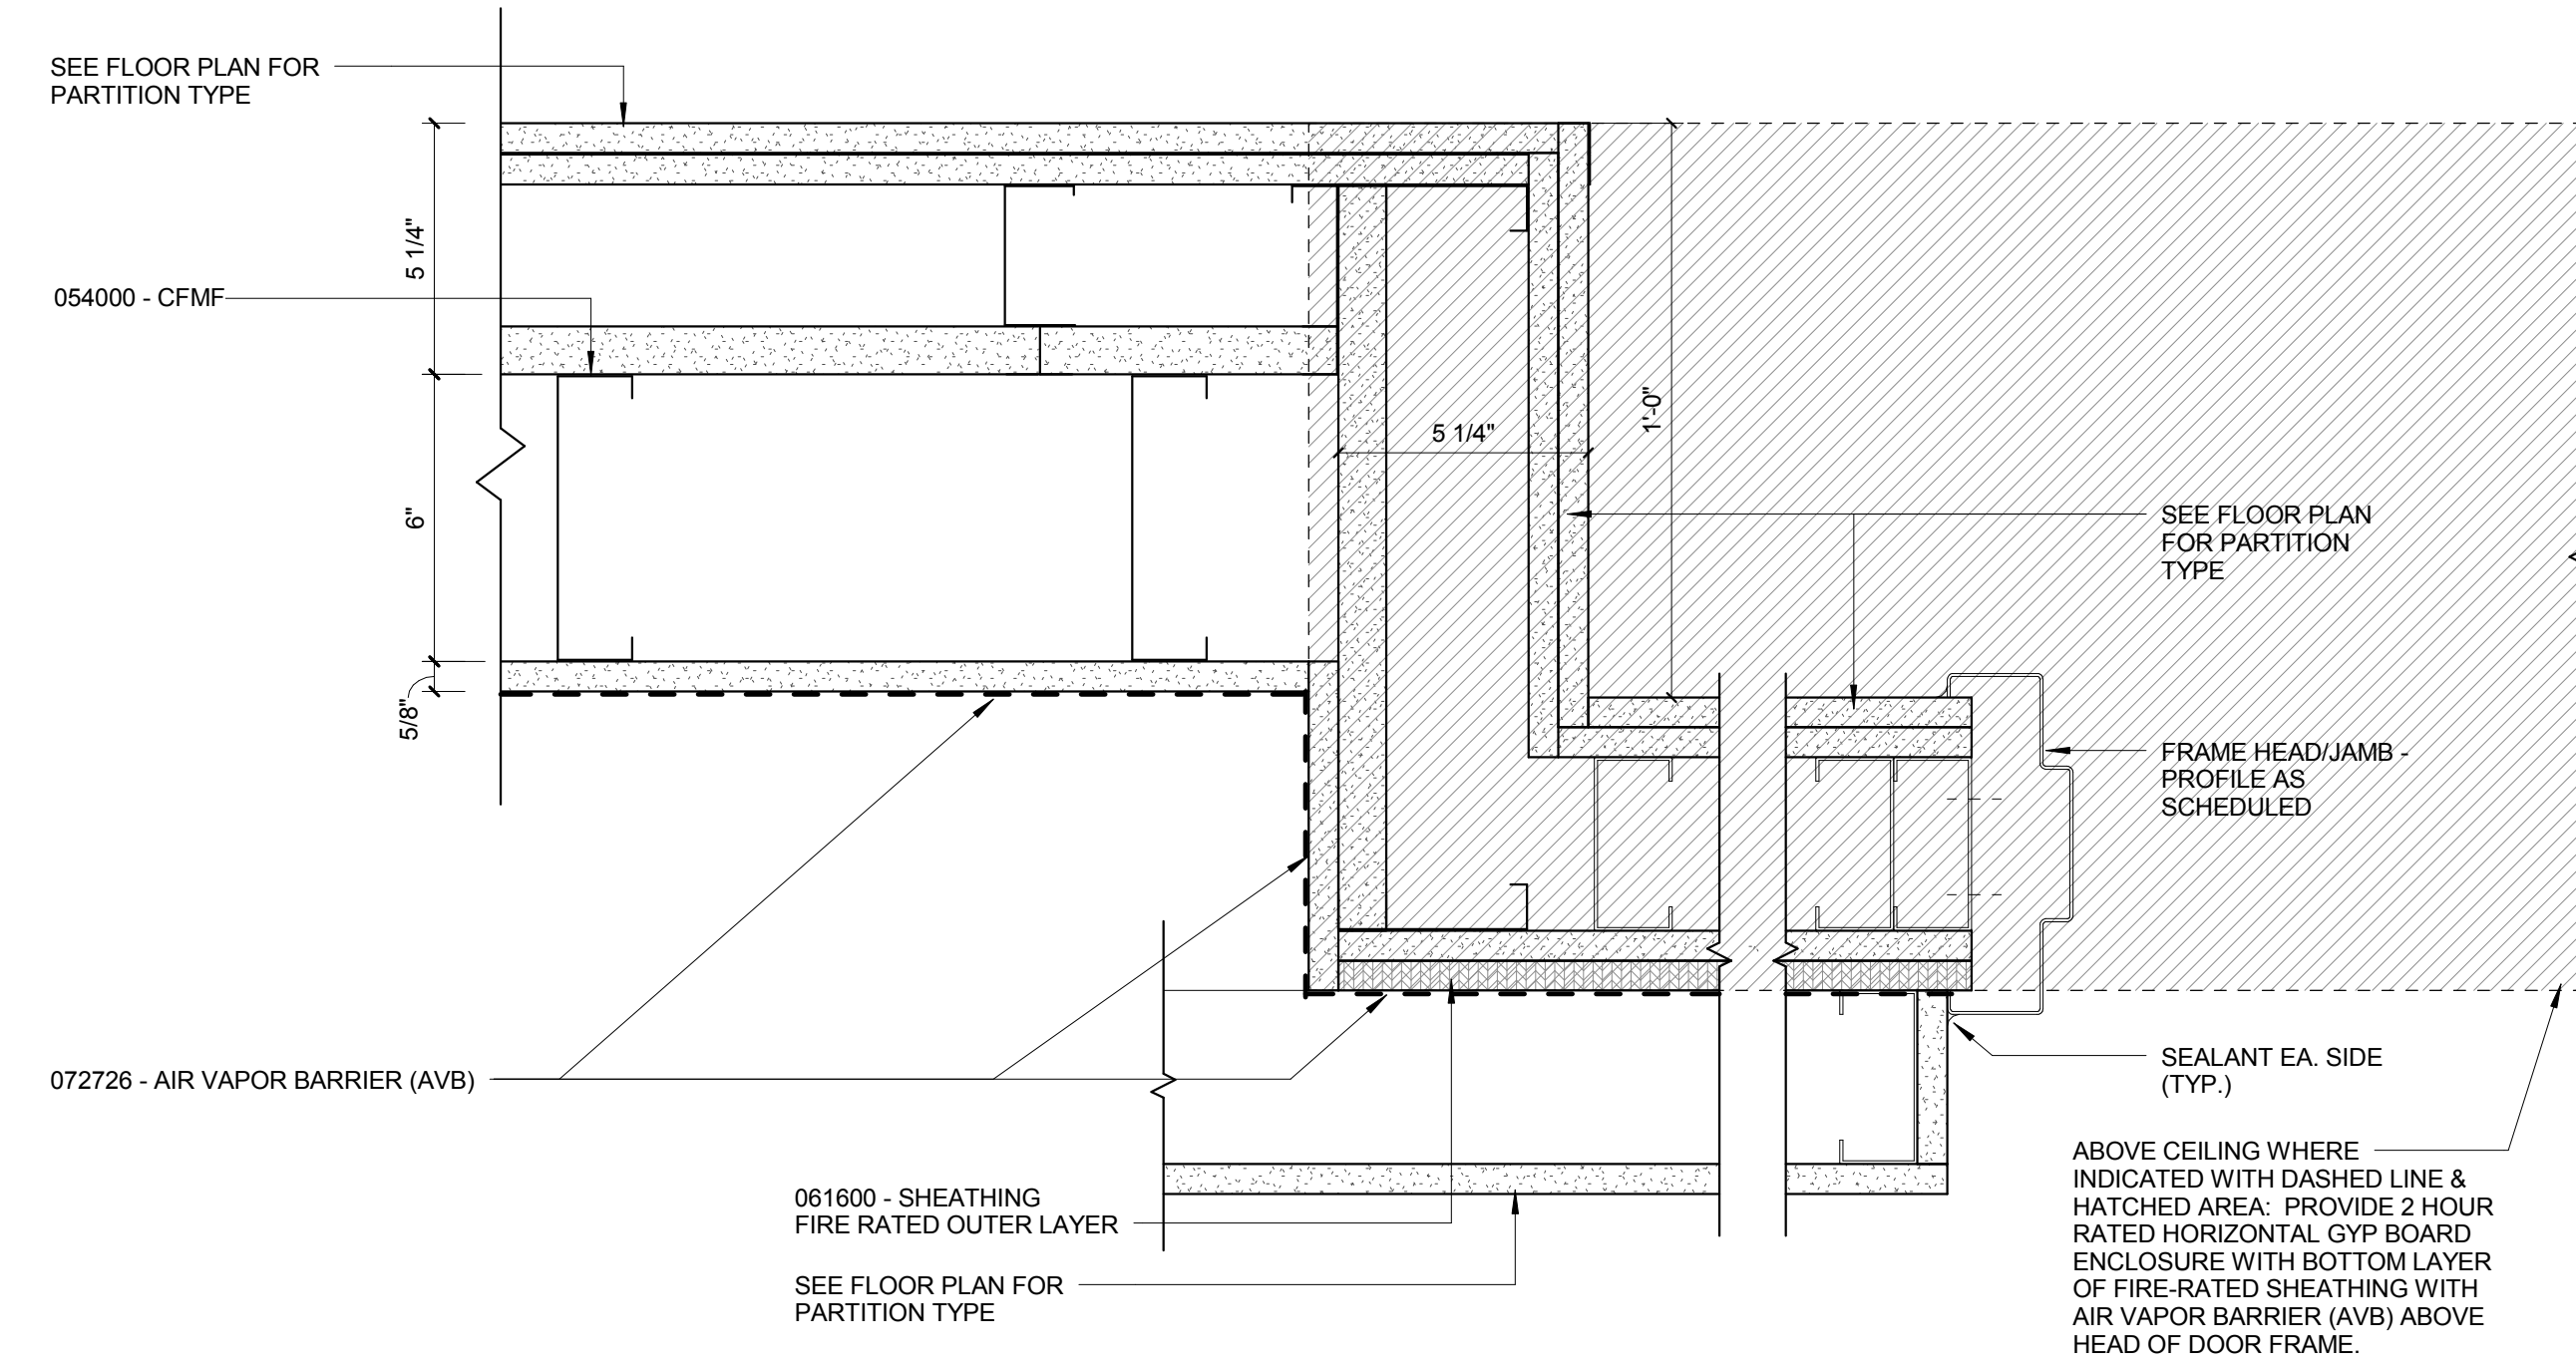

SIMILAR DETAIL FOR DOOR HEAD WITH 2 HR RATED HORIZONTAL ENCLOSURE.

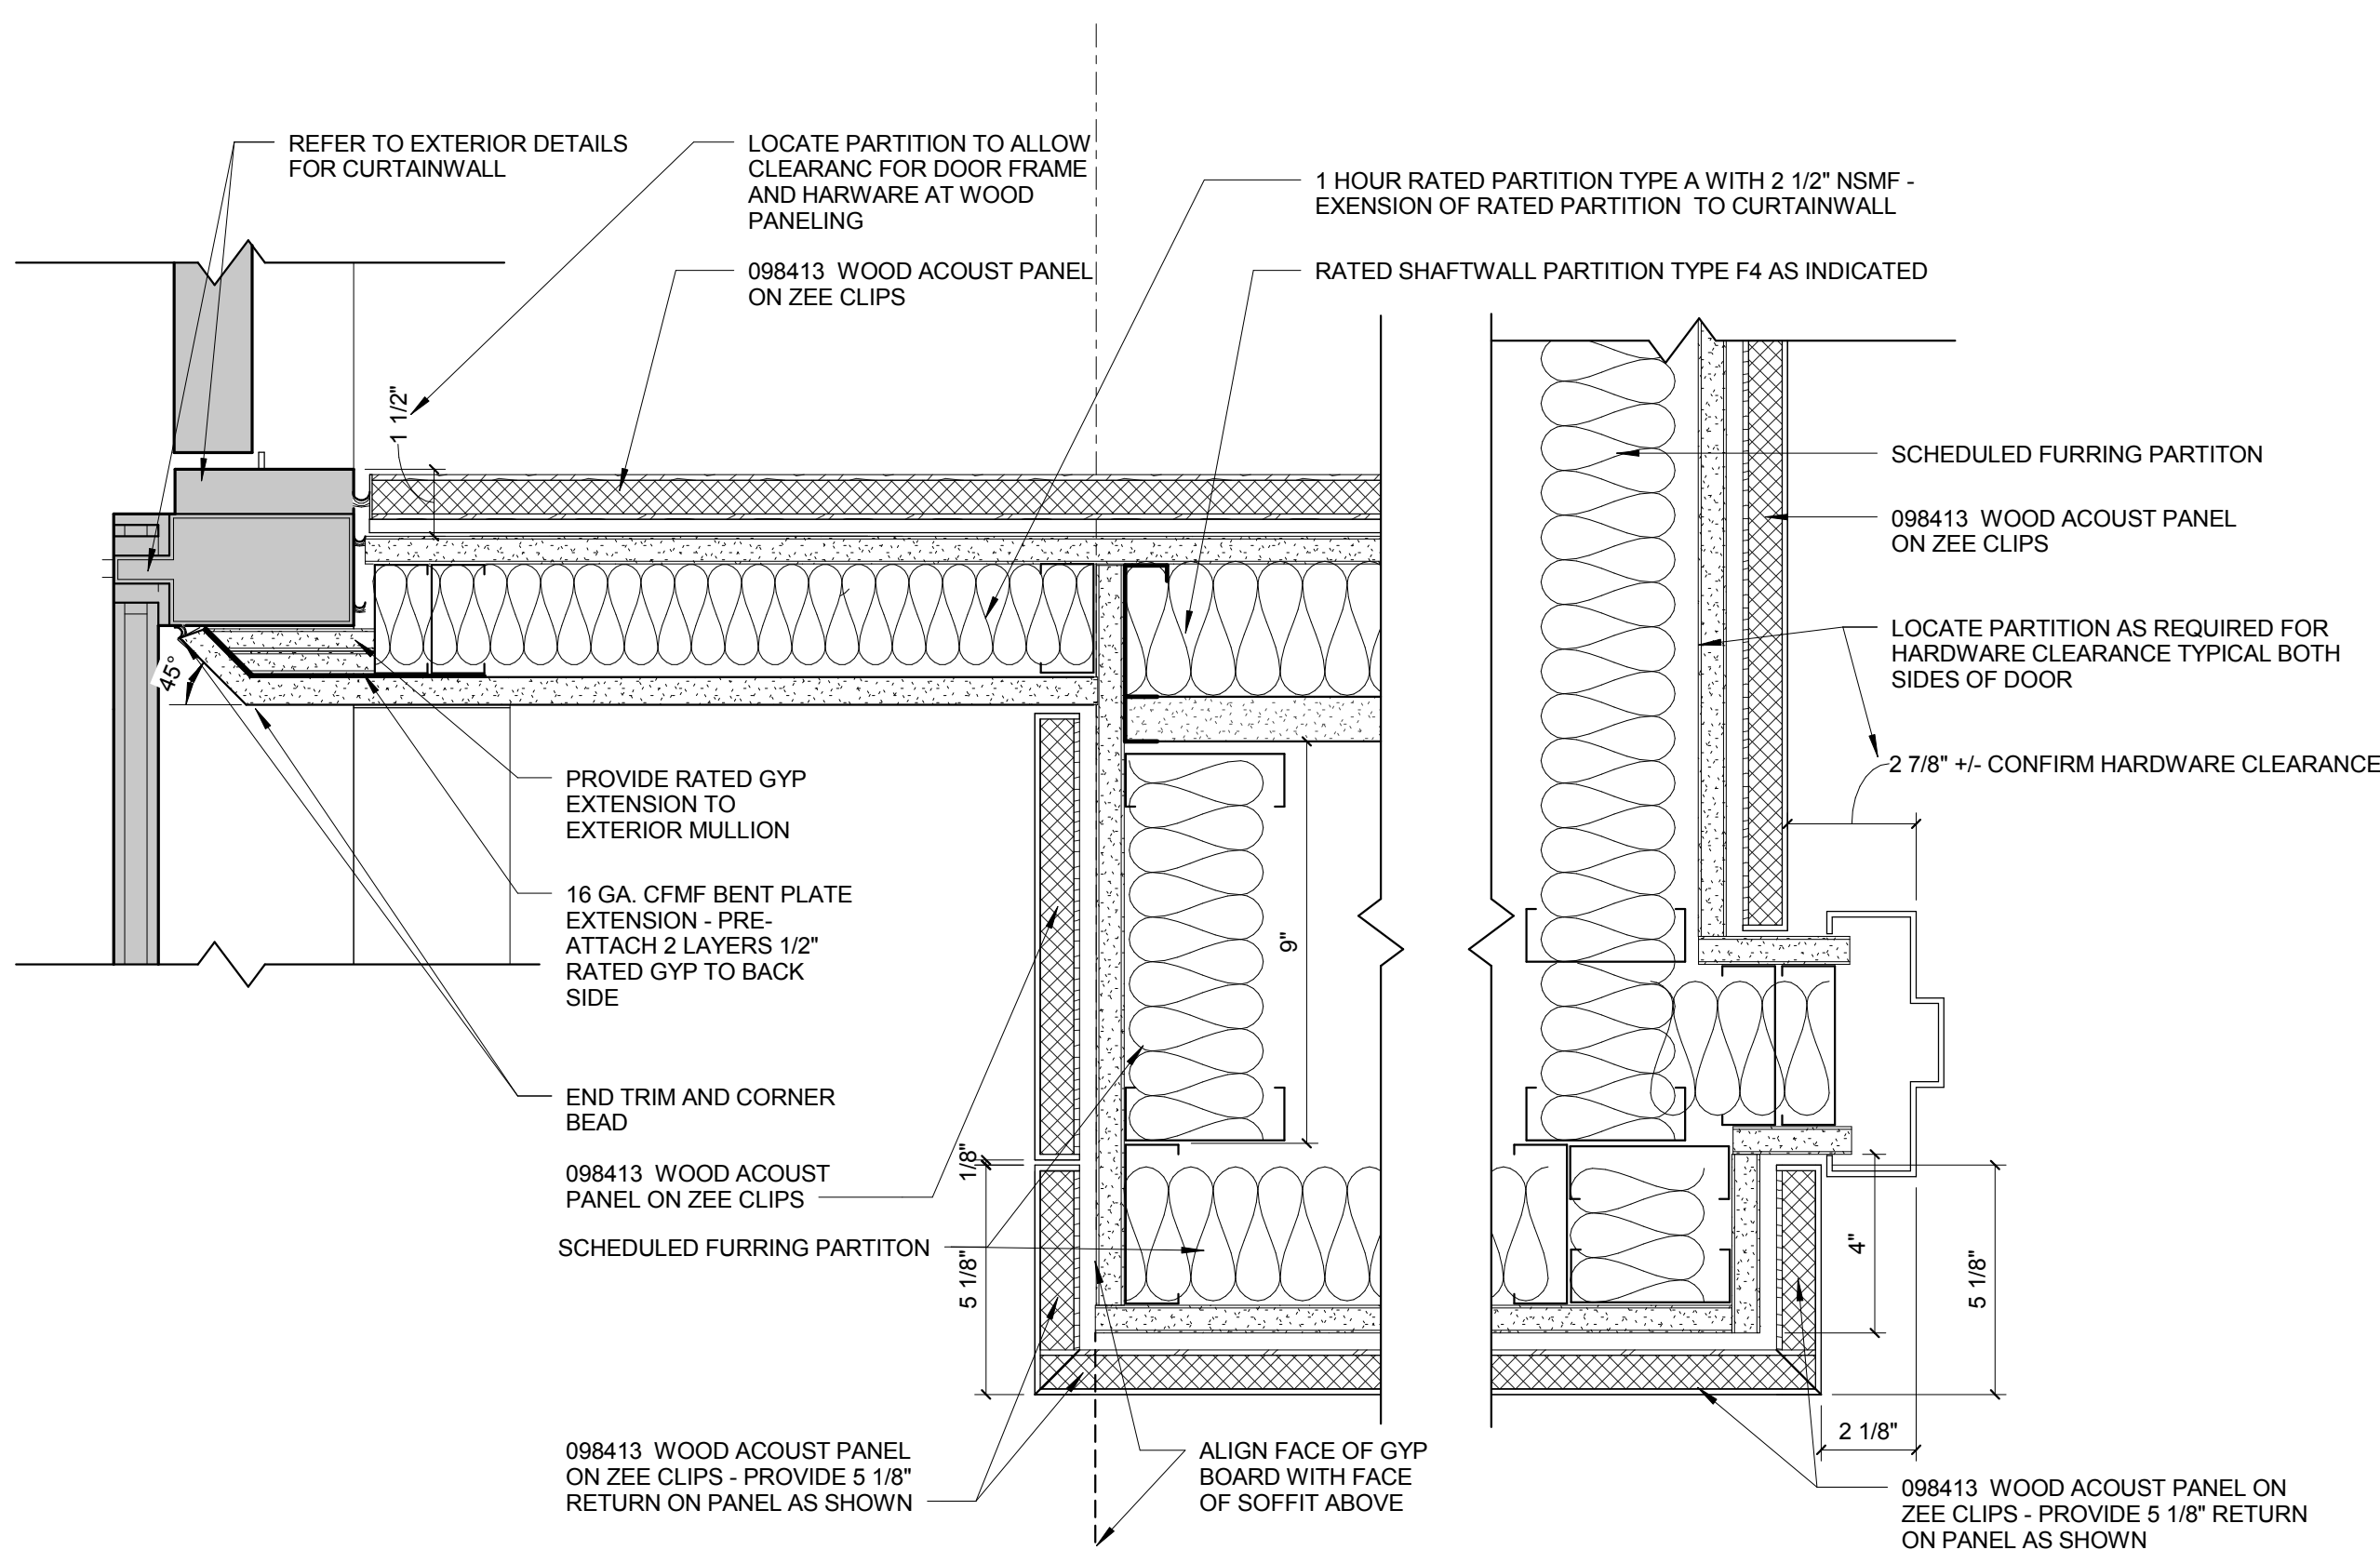

8 PLAN DETAIL AT EXTERIOR CURTAINWALL LECT HALL
3" = 1'-0"