




© Cannon Design 2015
All rights reserved. No part of this document may be reproduced or transmitted in any form without written authorization by The Cannon Corporation.
4/15/2016 4:52:50 PM

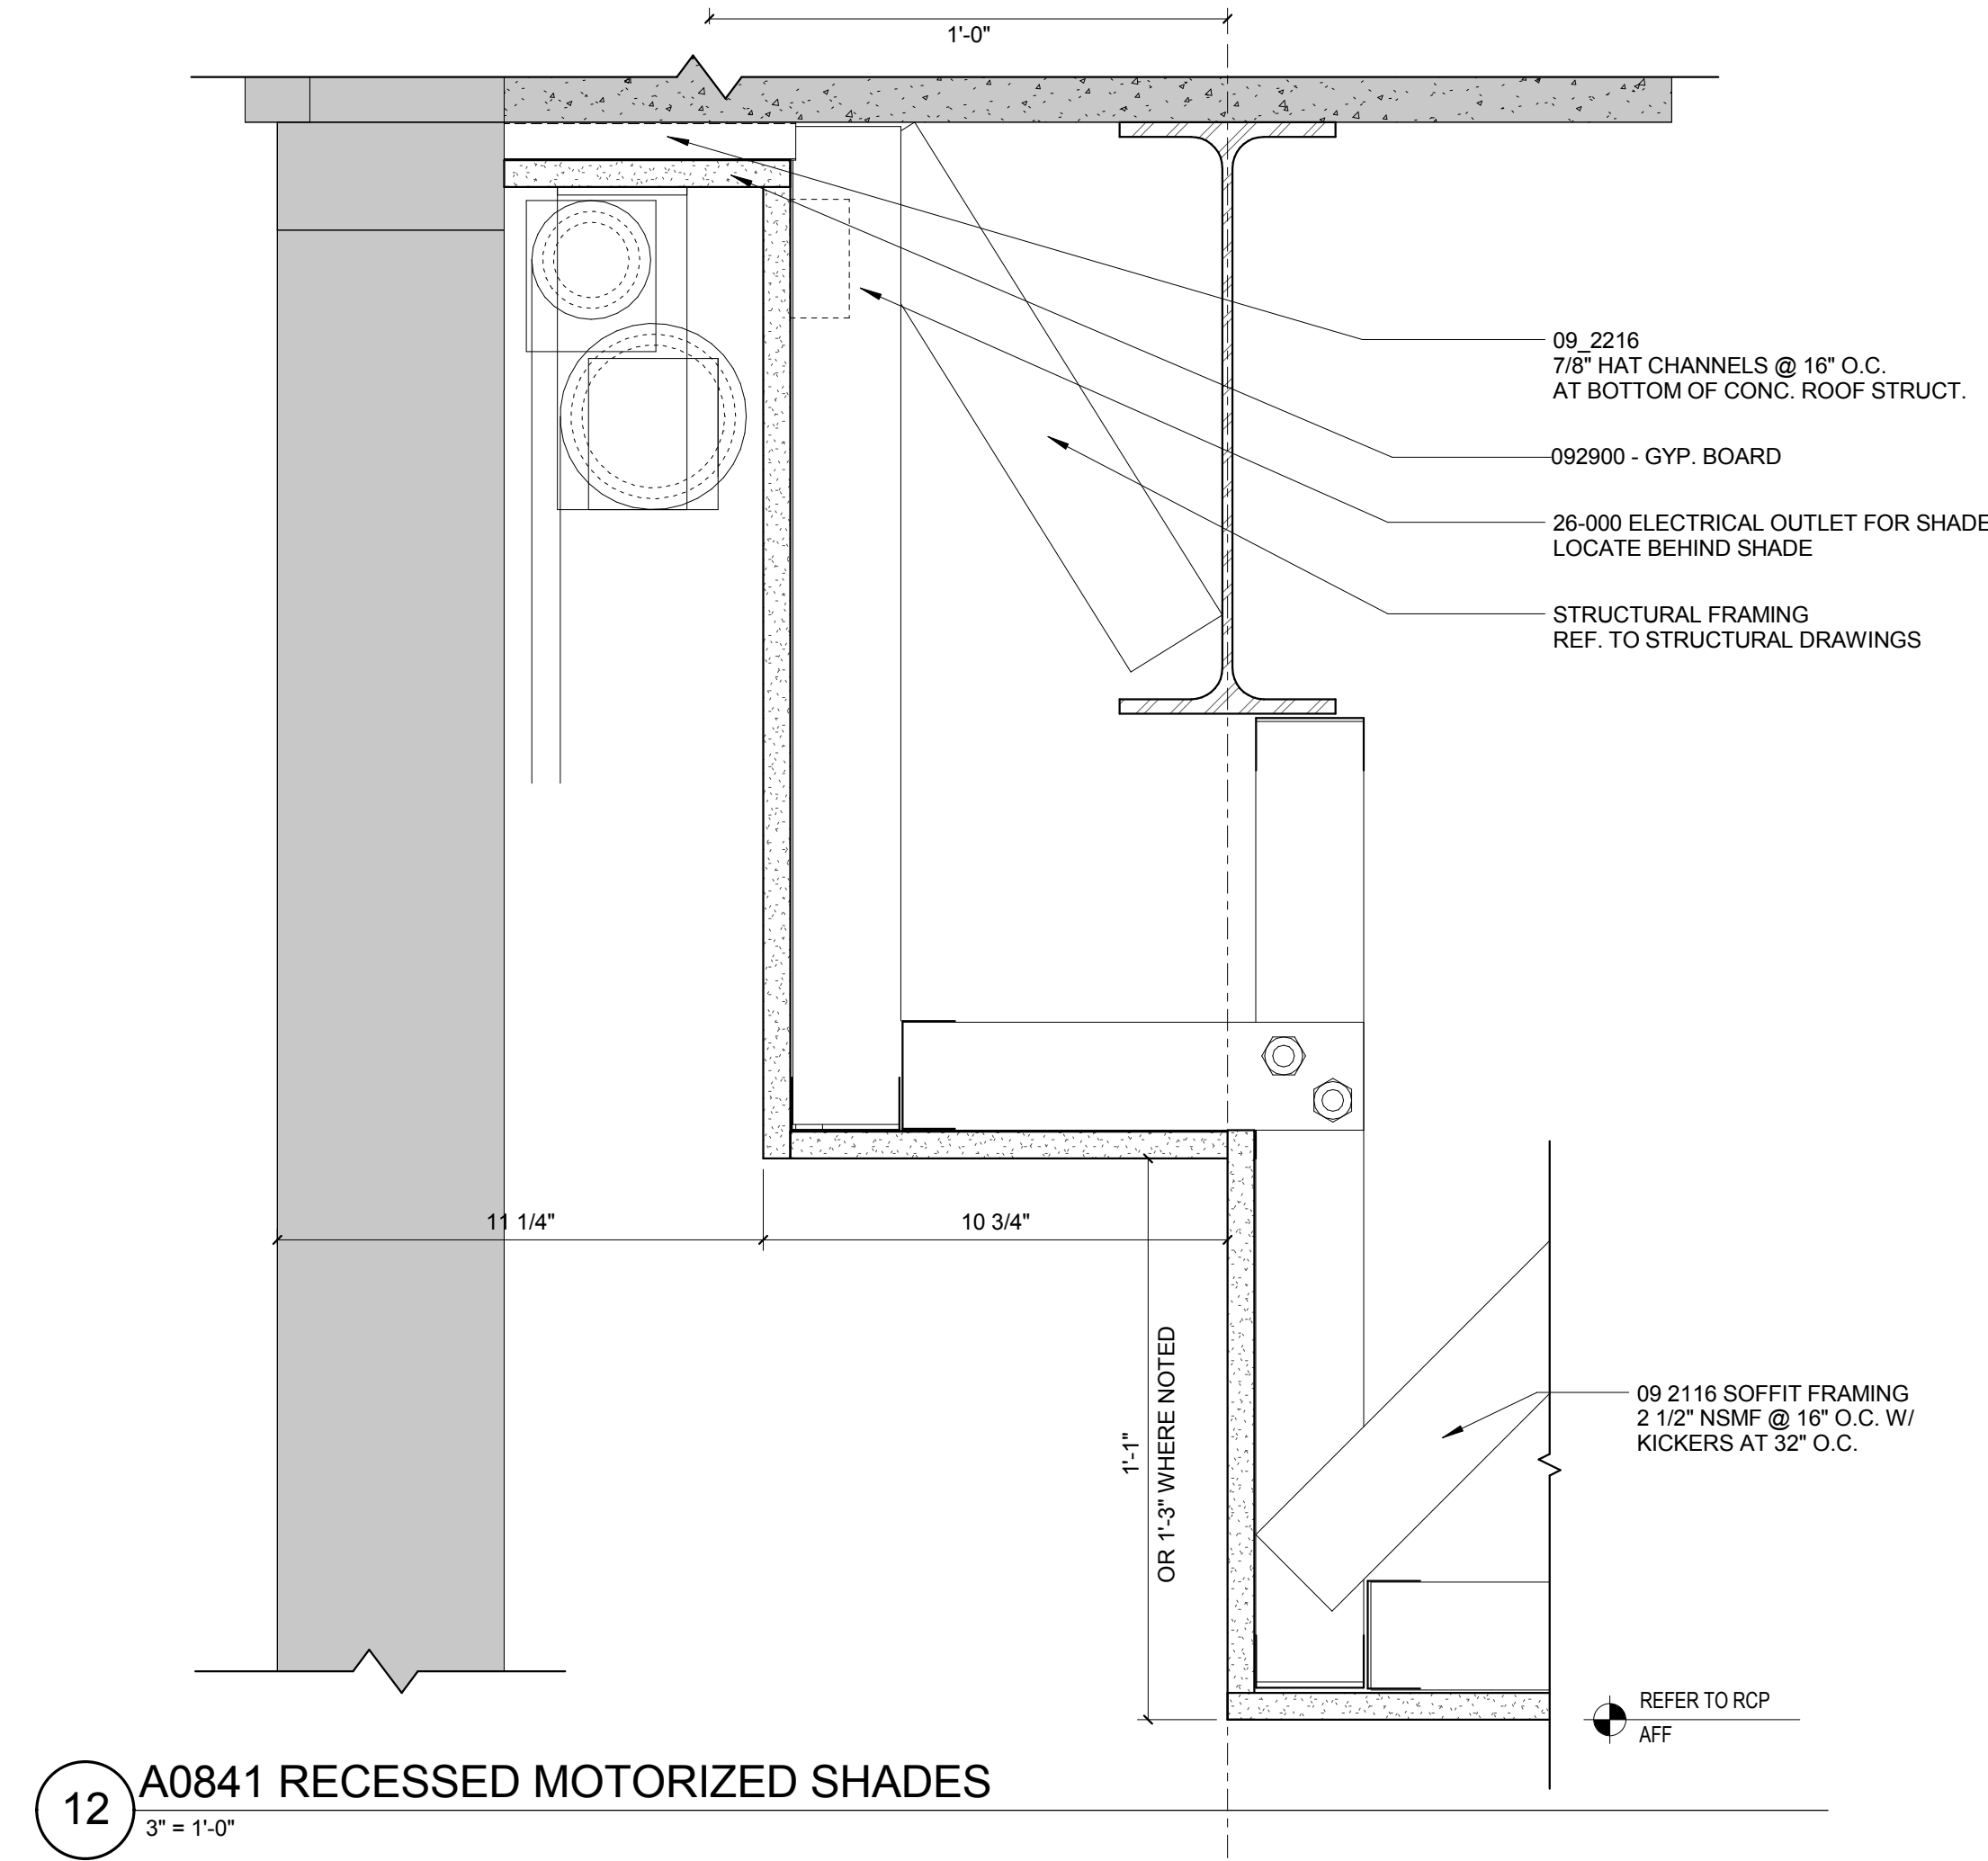


12 A0841 RECESSED MOTORIZED SHADES
3" = 1'-0"

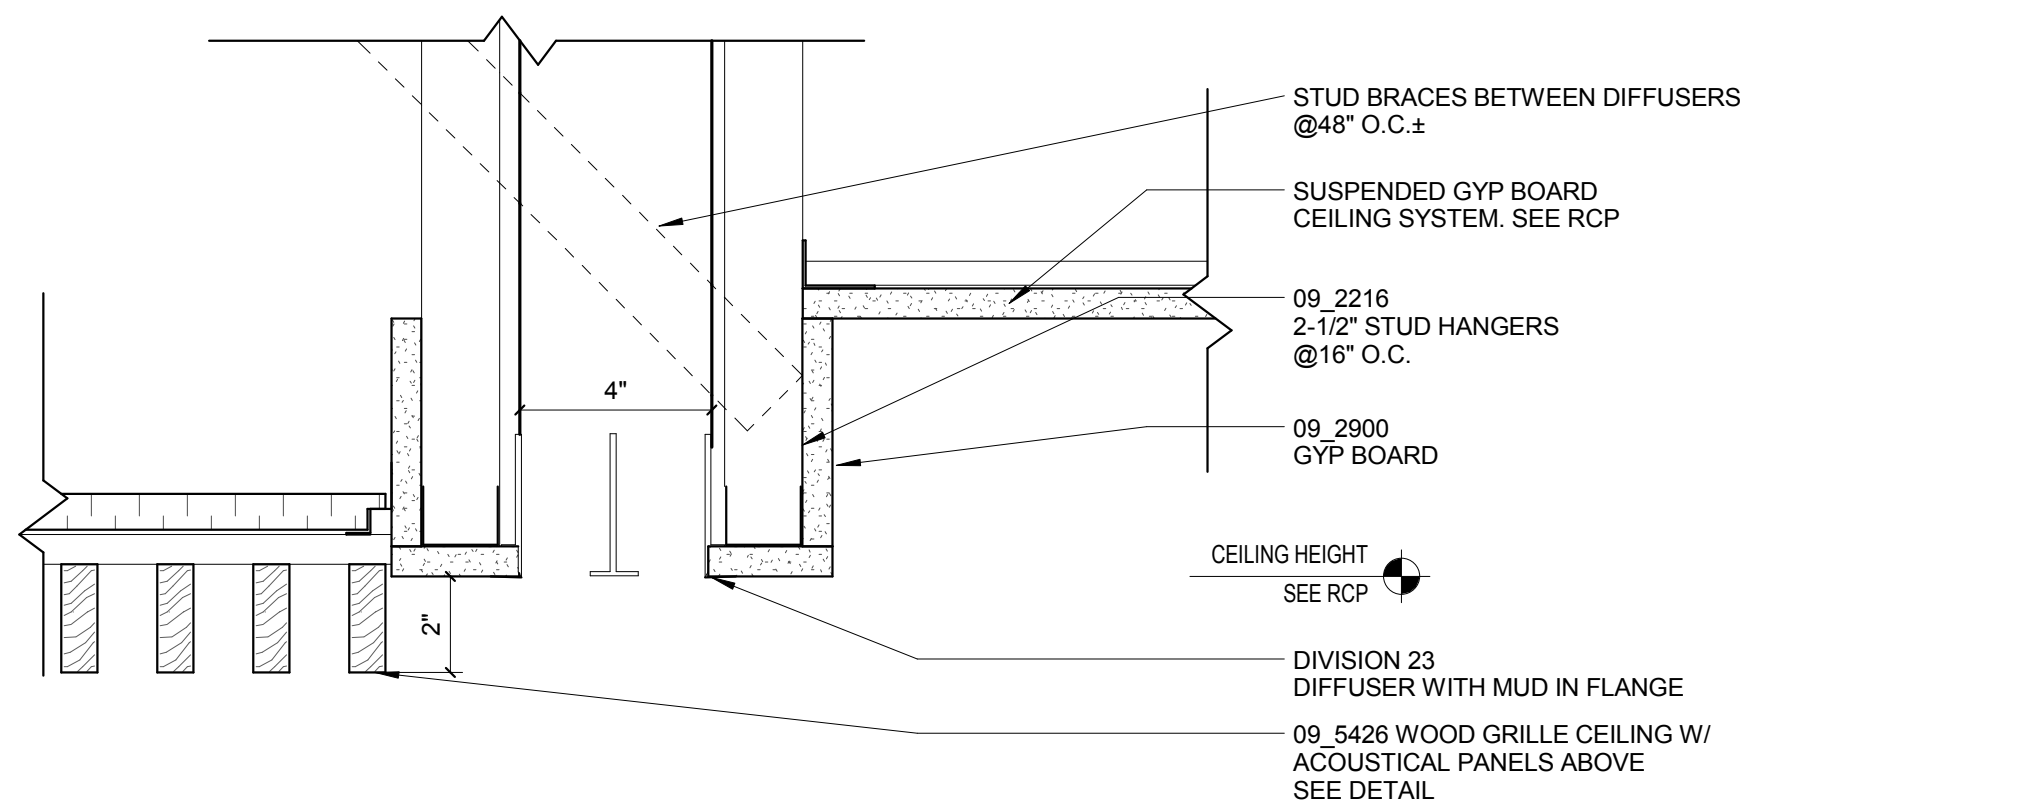


11 A0841 WOOD GRILLE CEILING EDGE DETAIL
3" = 1'-0"

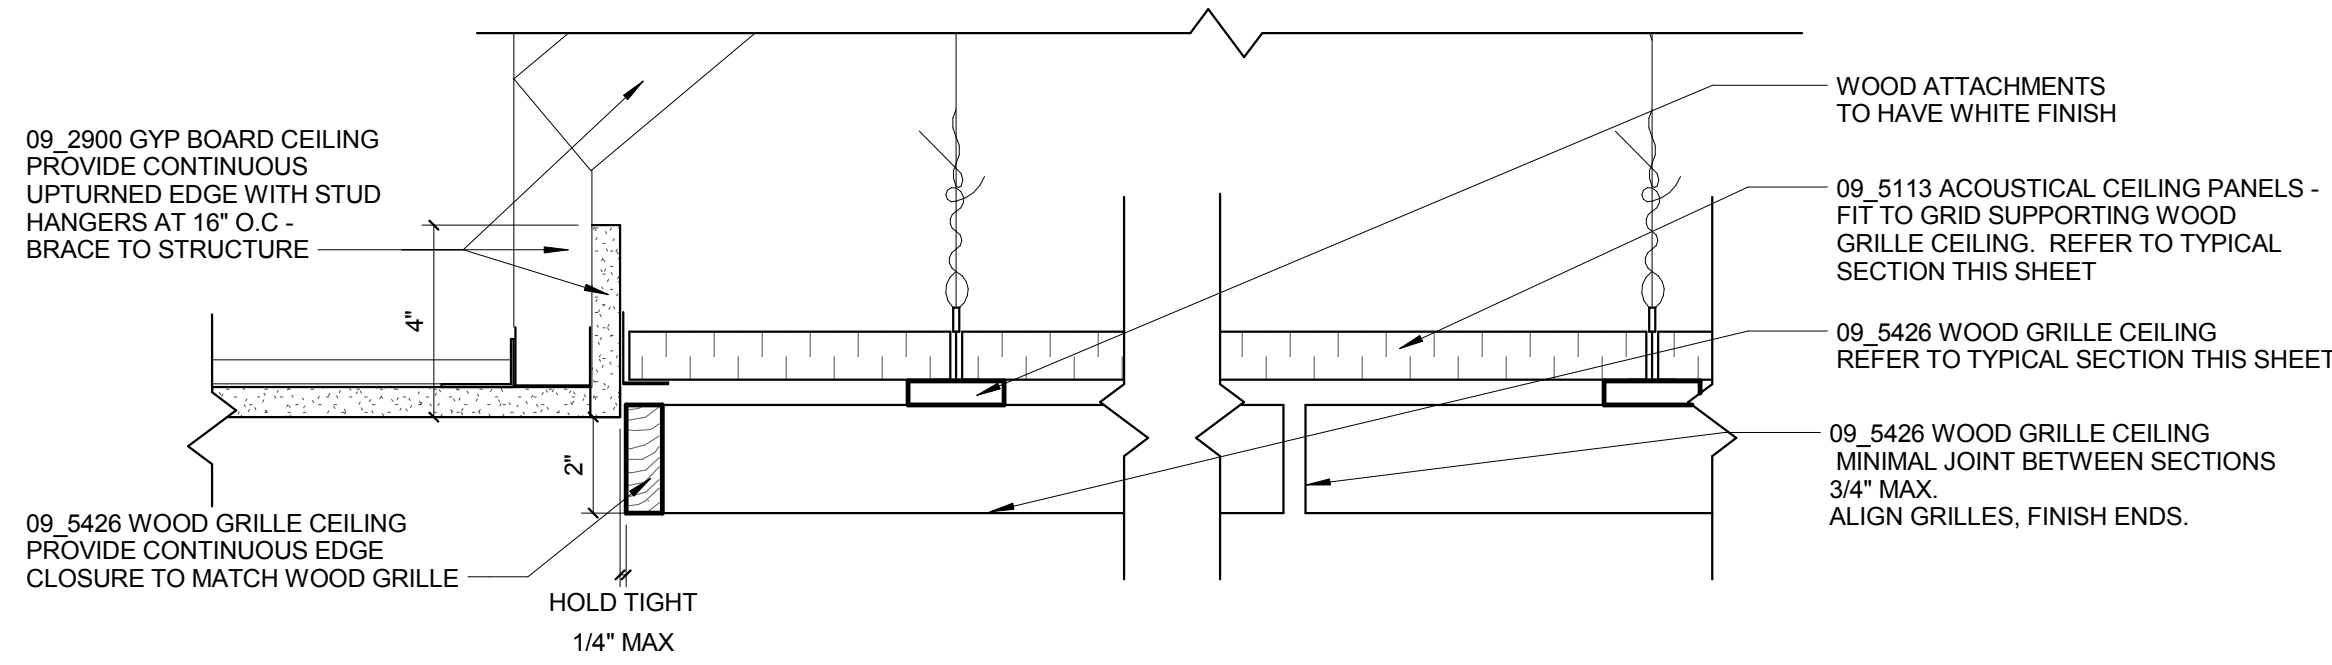


10 WOOD GRILLE CEILING EDGE DETAIL
3" = 1'-0"

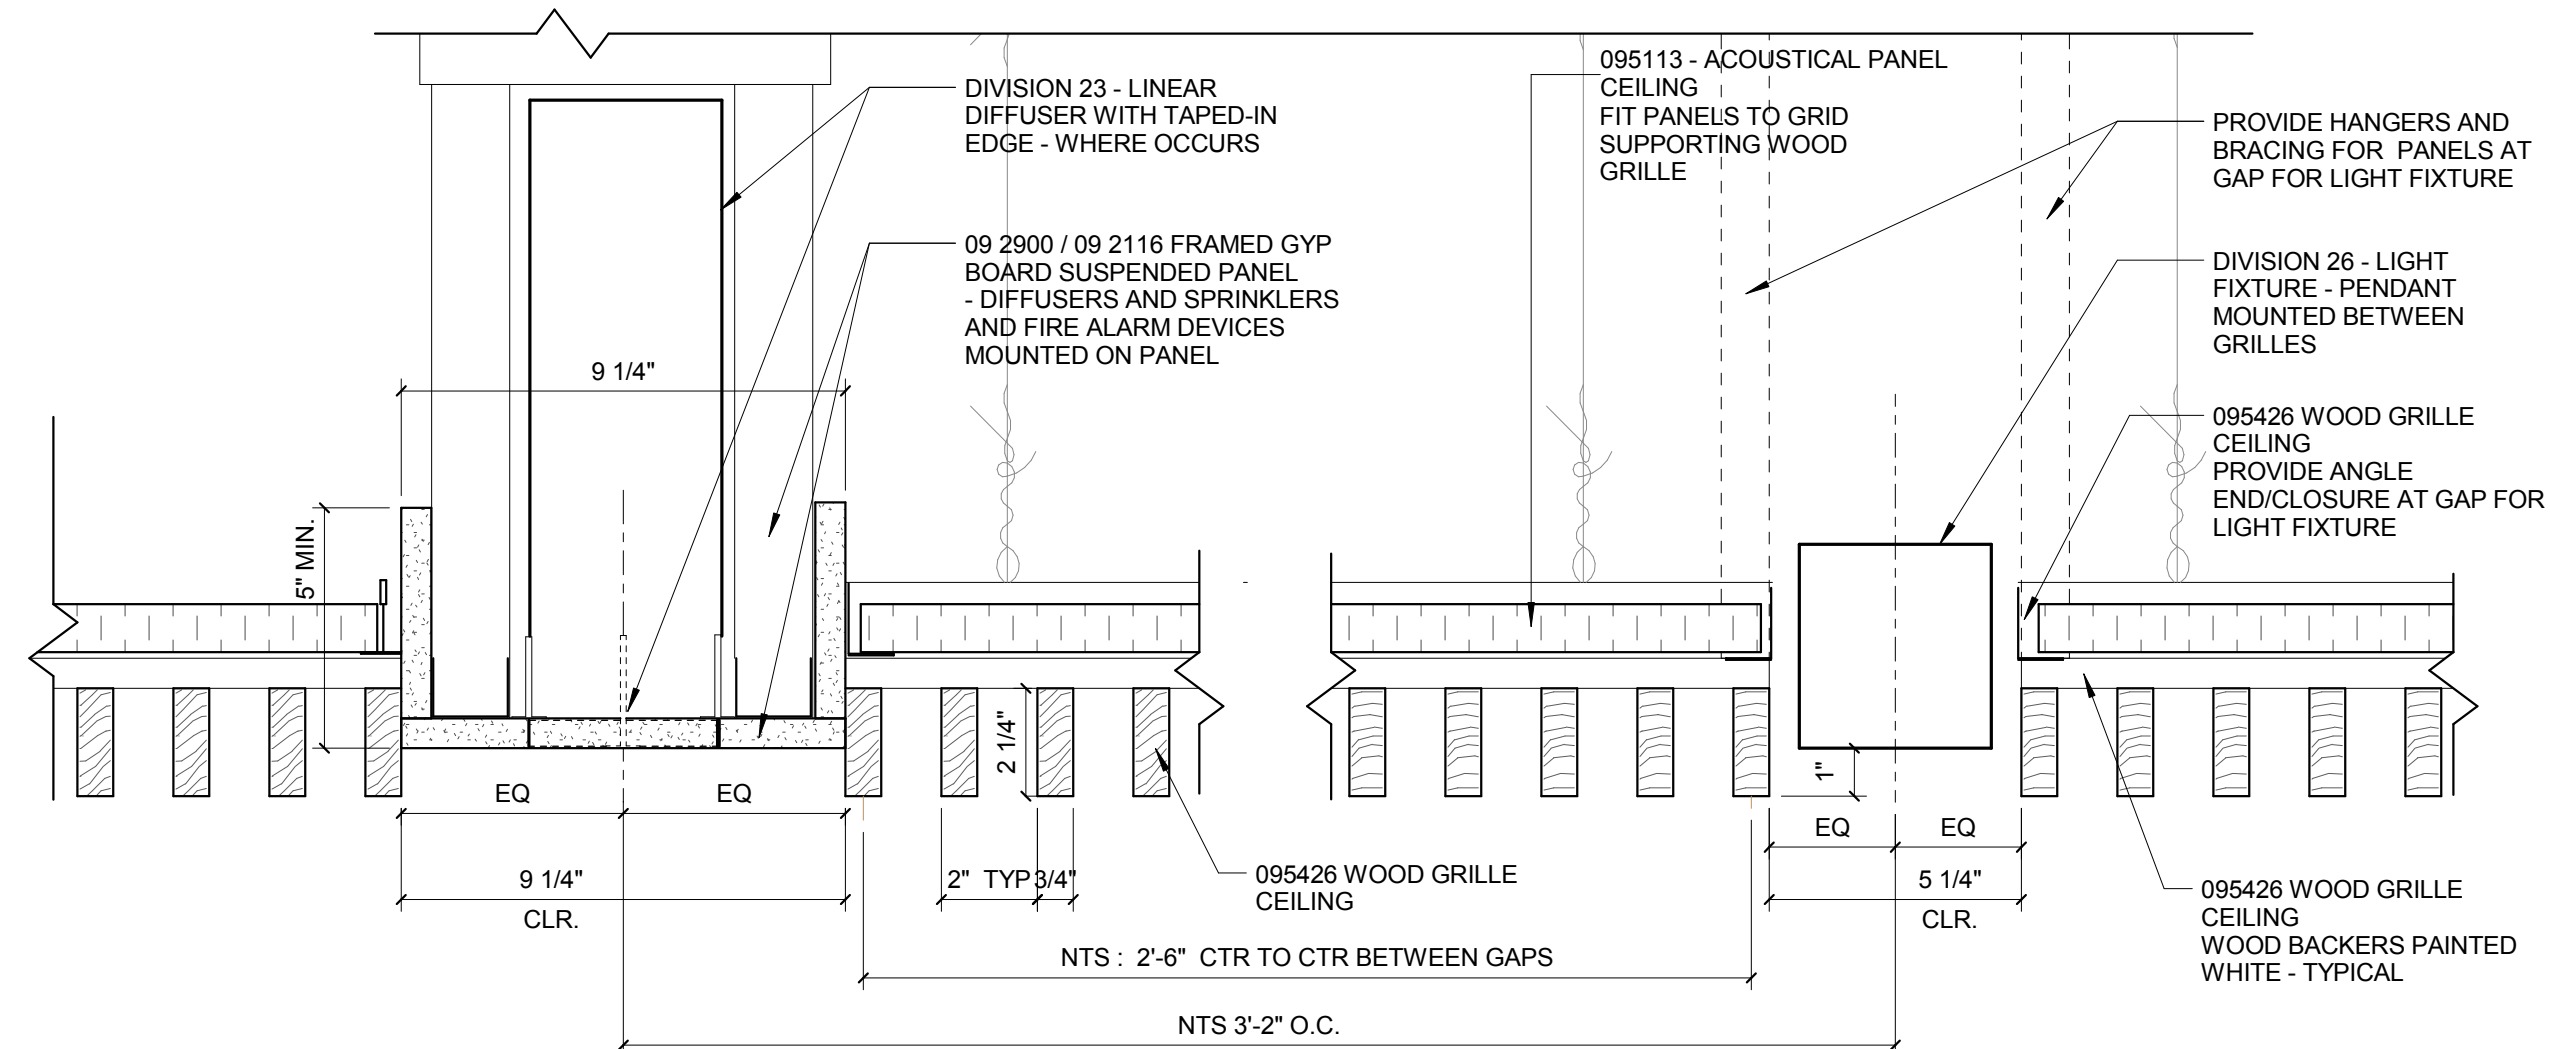


9 WOOD GRILLE CEILING DETAIL
3" = 1'-0"

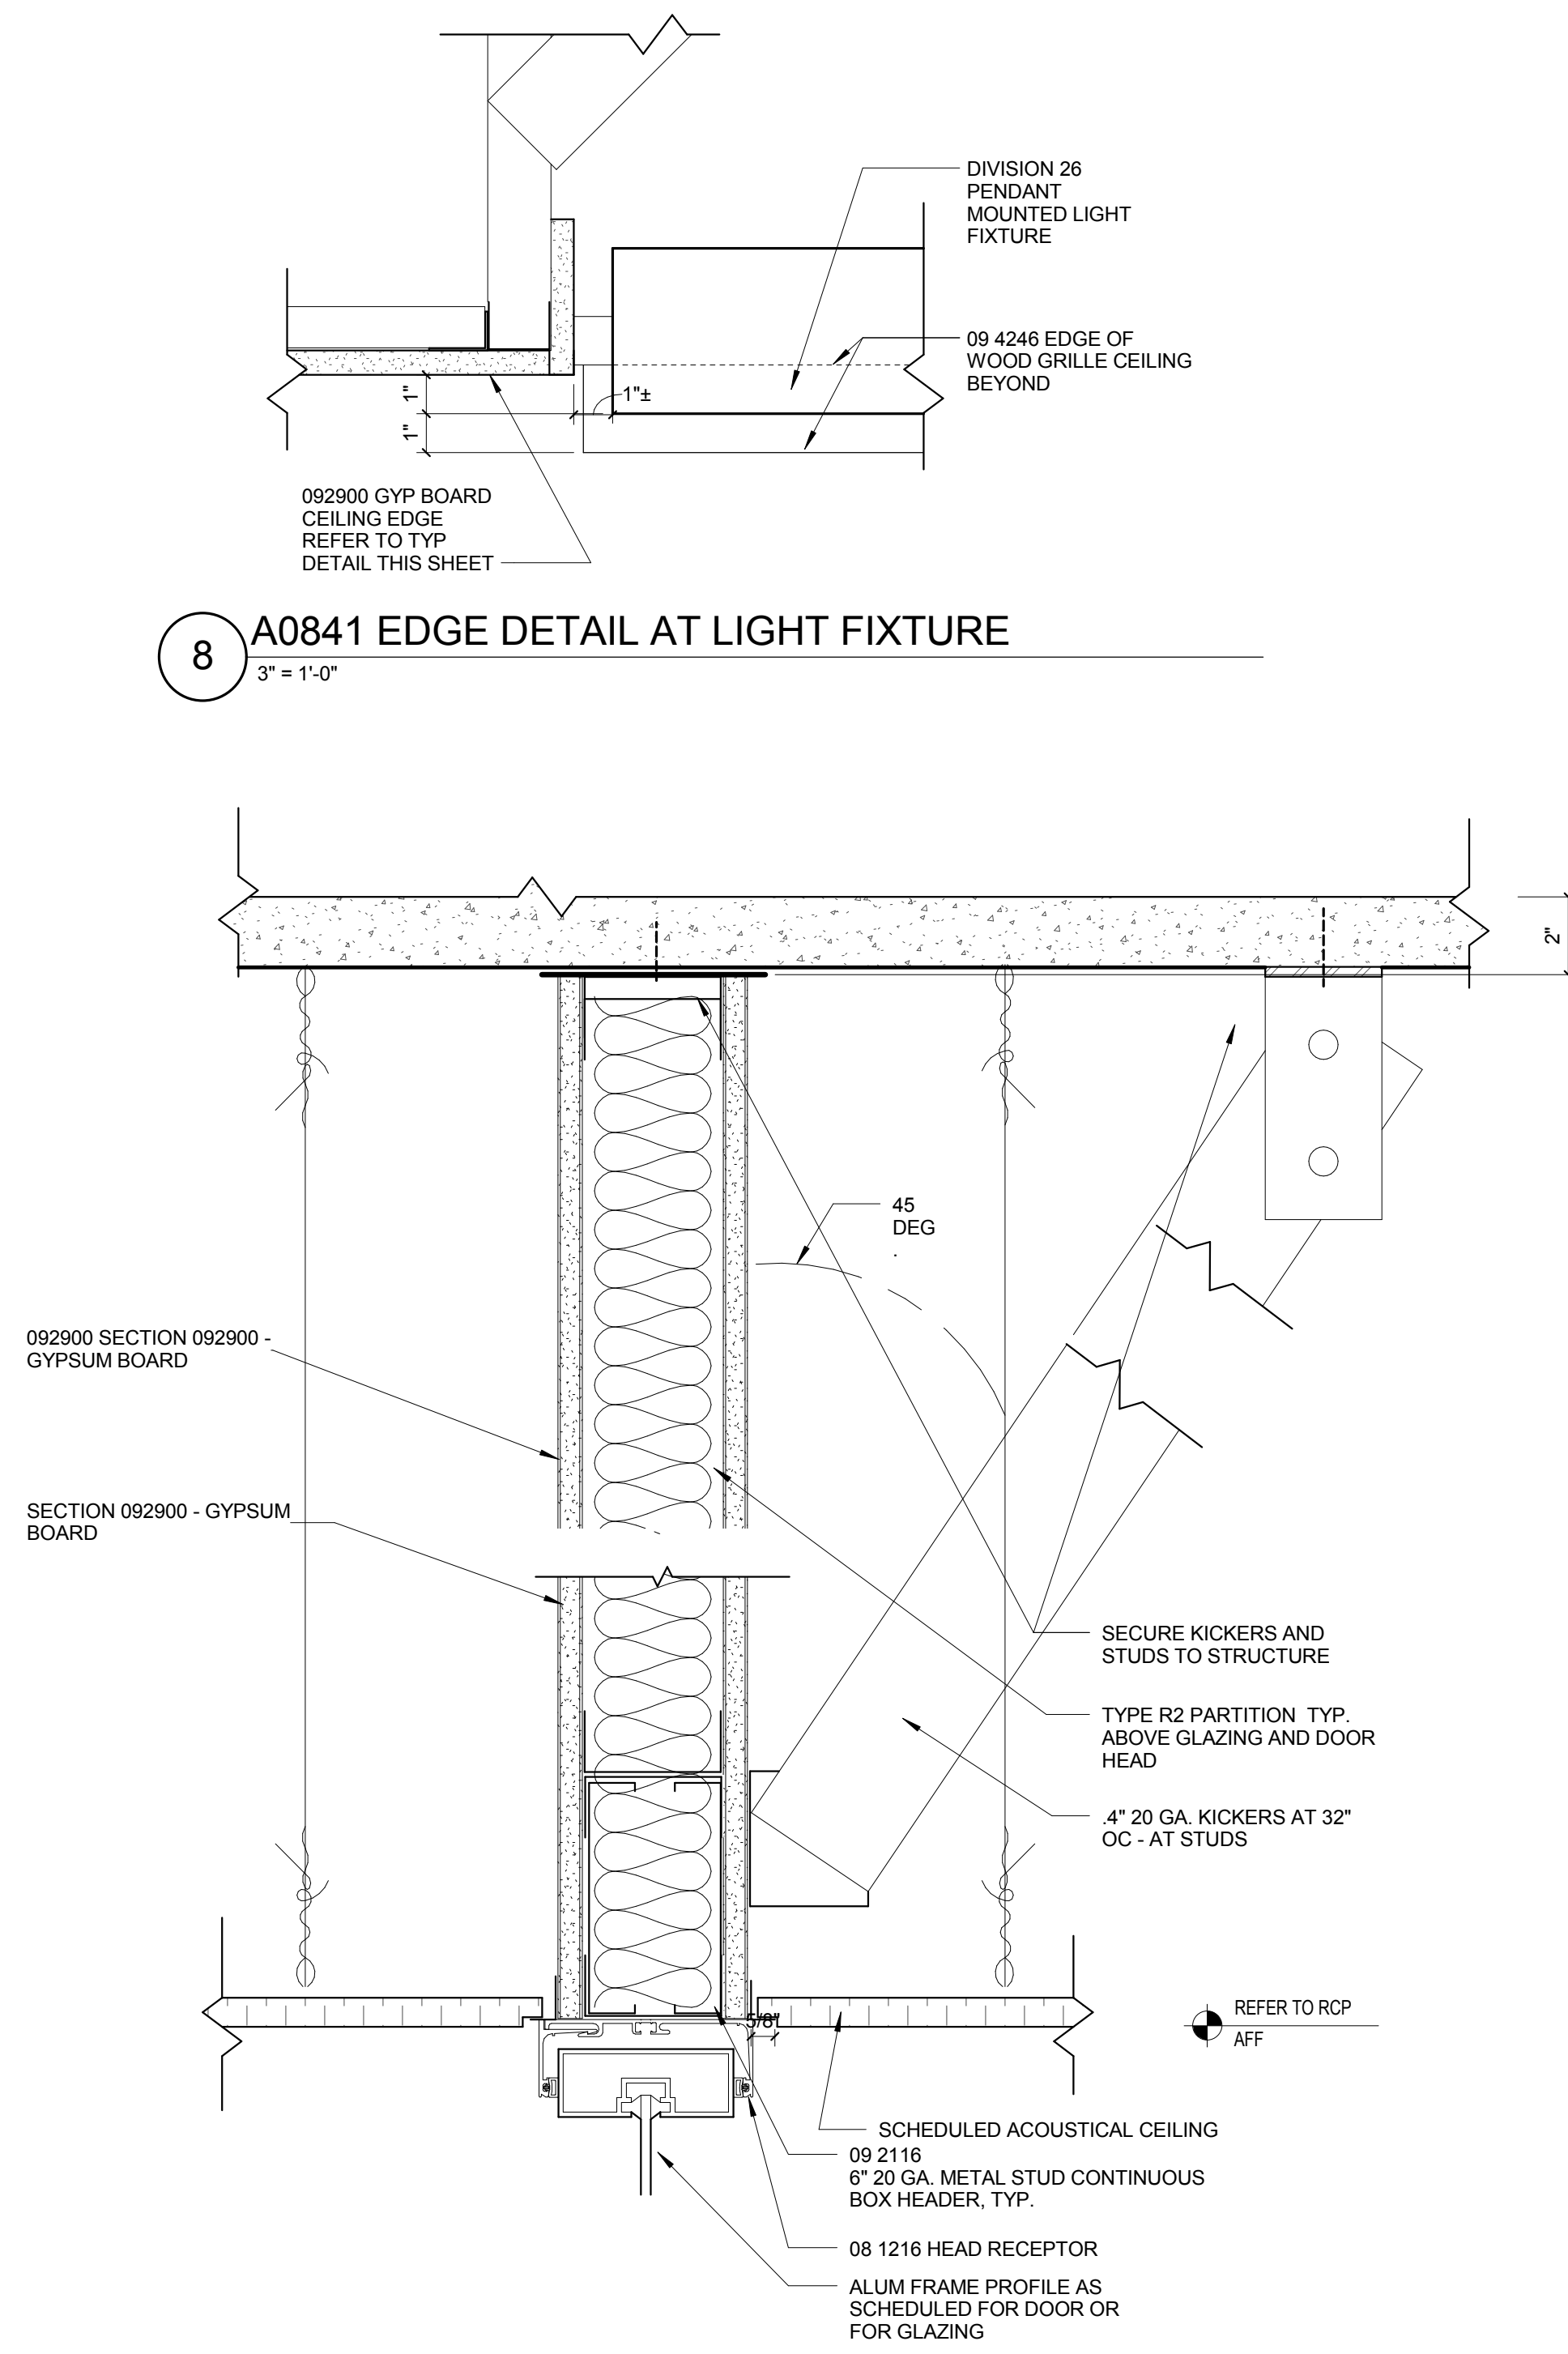


7 A0841 GLAZING STOREFRONT HEAD DETAIL
3" = 1'-0"

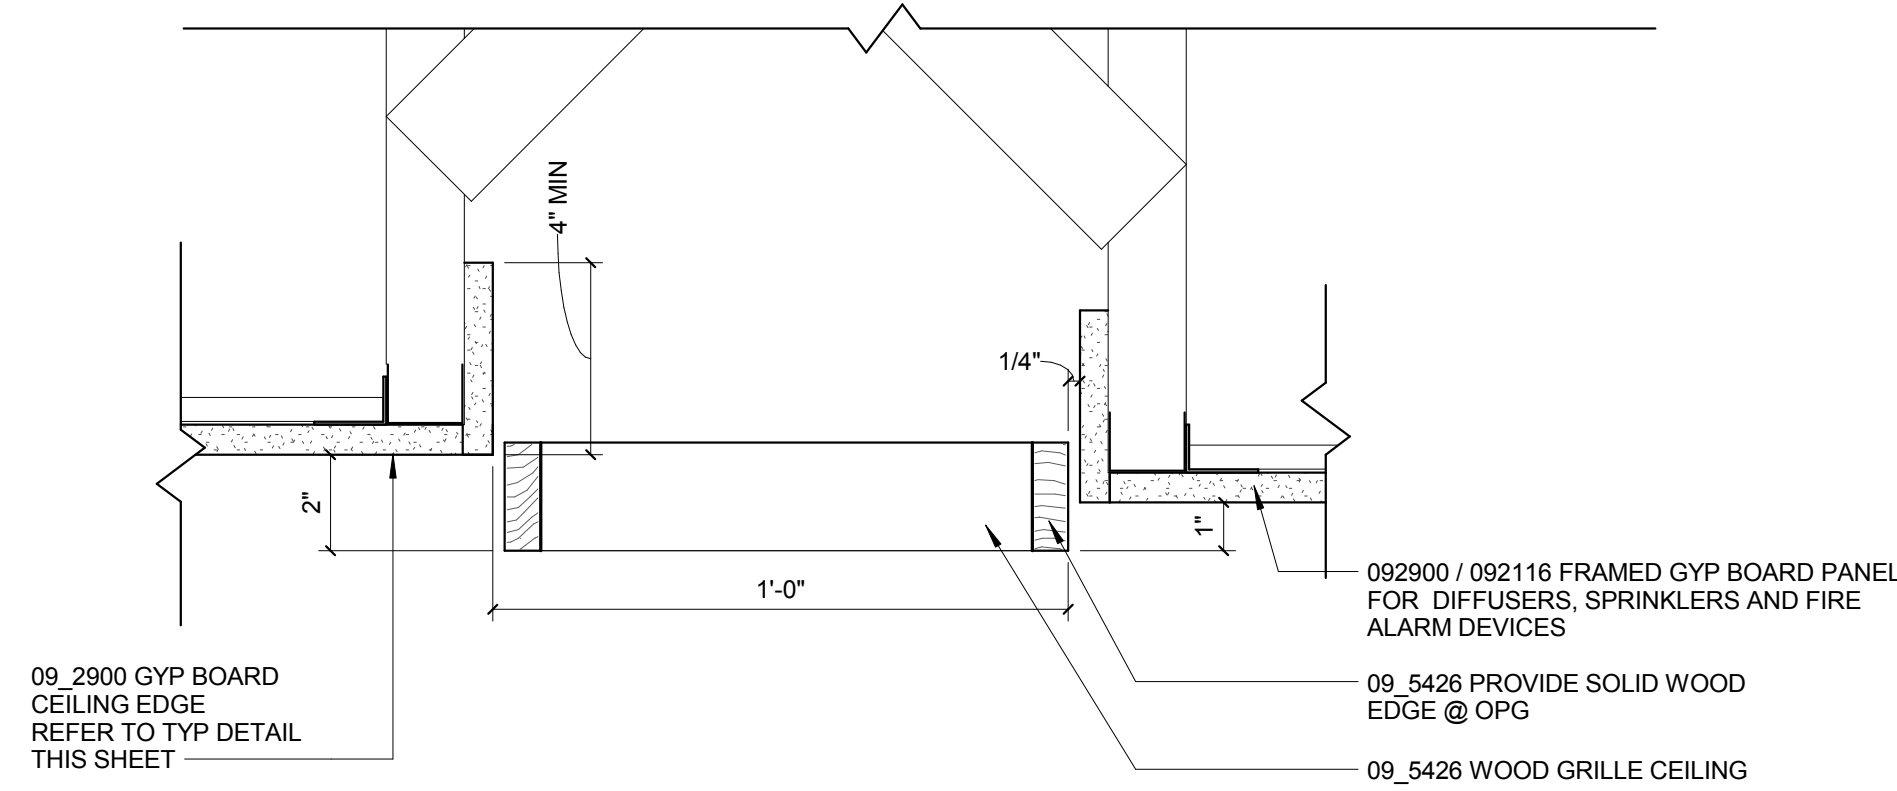


5 A0841 EDGE DETAIL AT DIFFUSER
3" = 1'-0"

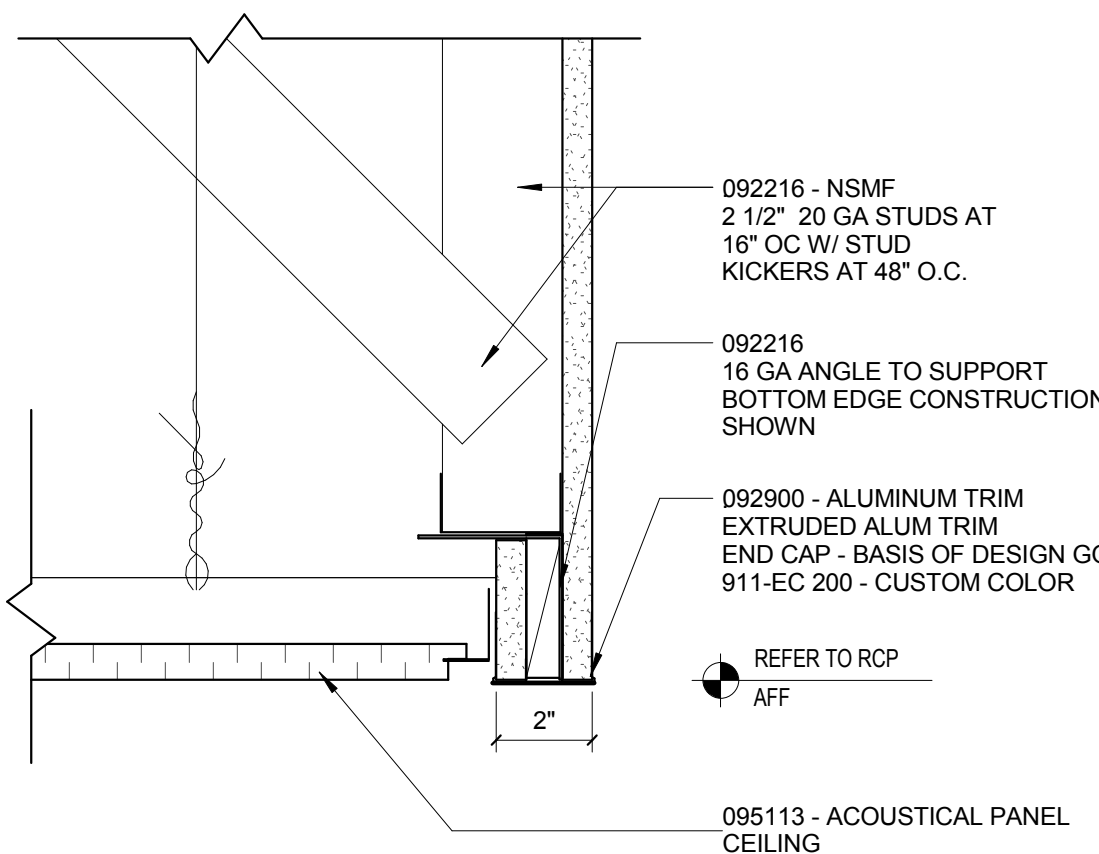


4 ACP EDGE AT OPENING
3" = 1'-0"

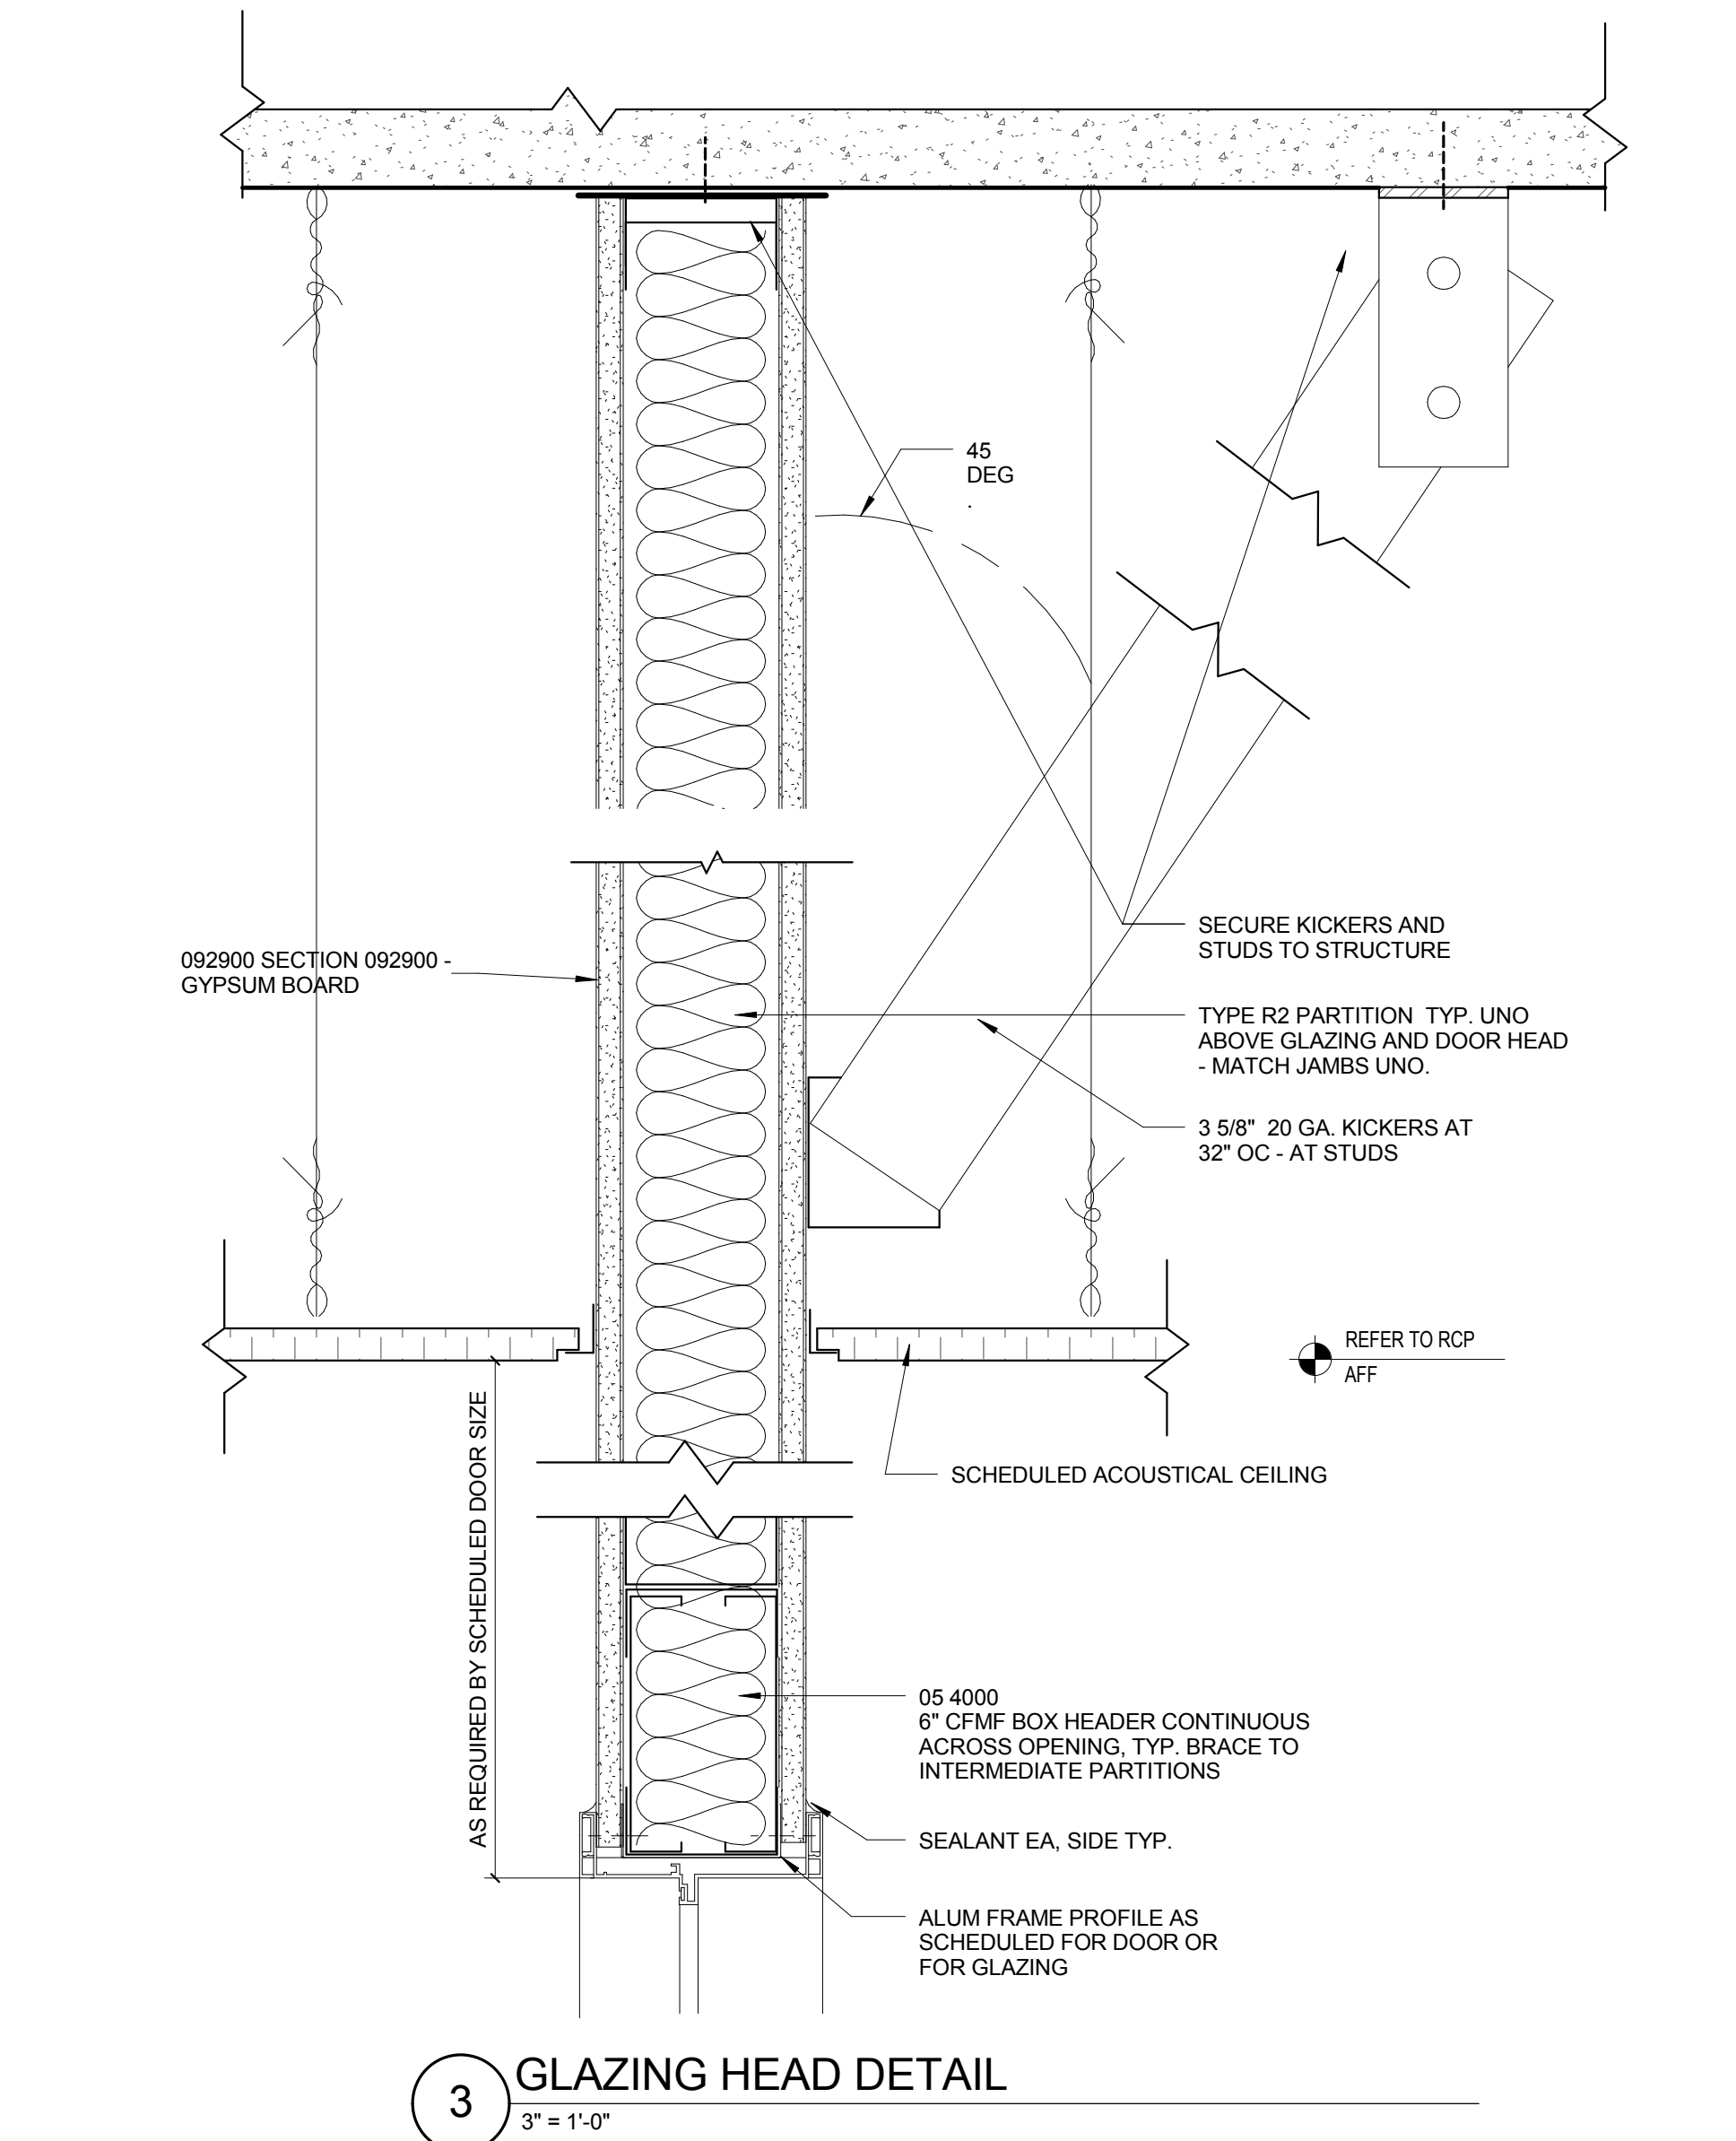

3 GLAZING HEAD DETAIL
3" = 1'-0"

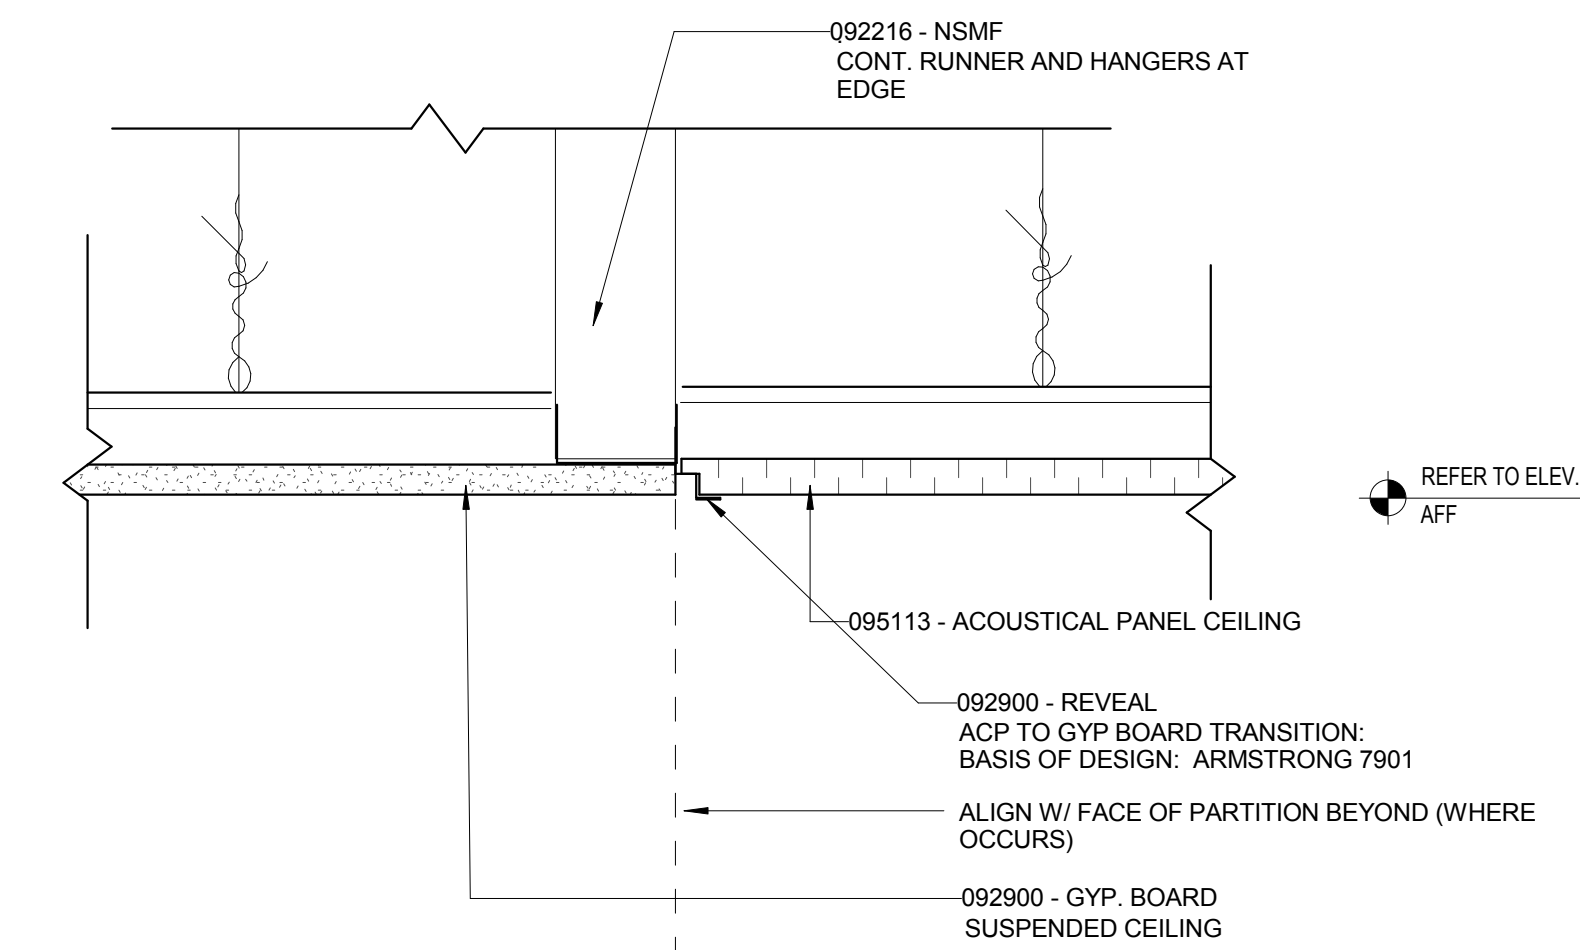

2 GWB TO APC TYP TRANSITION DETAIL
3" = 1'-0"

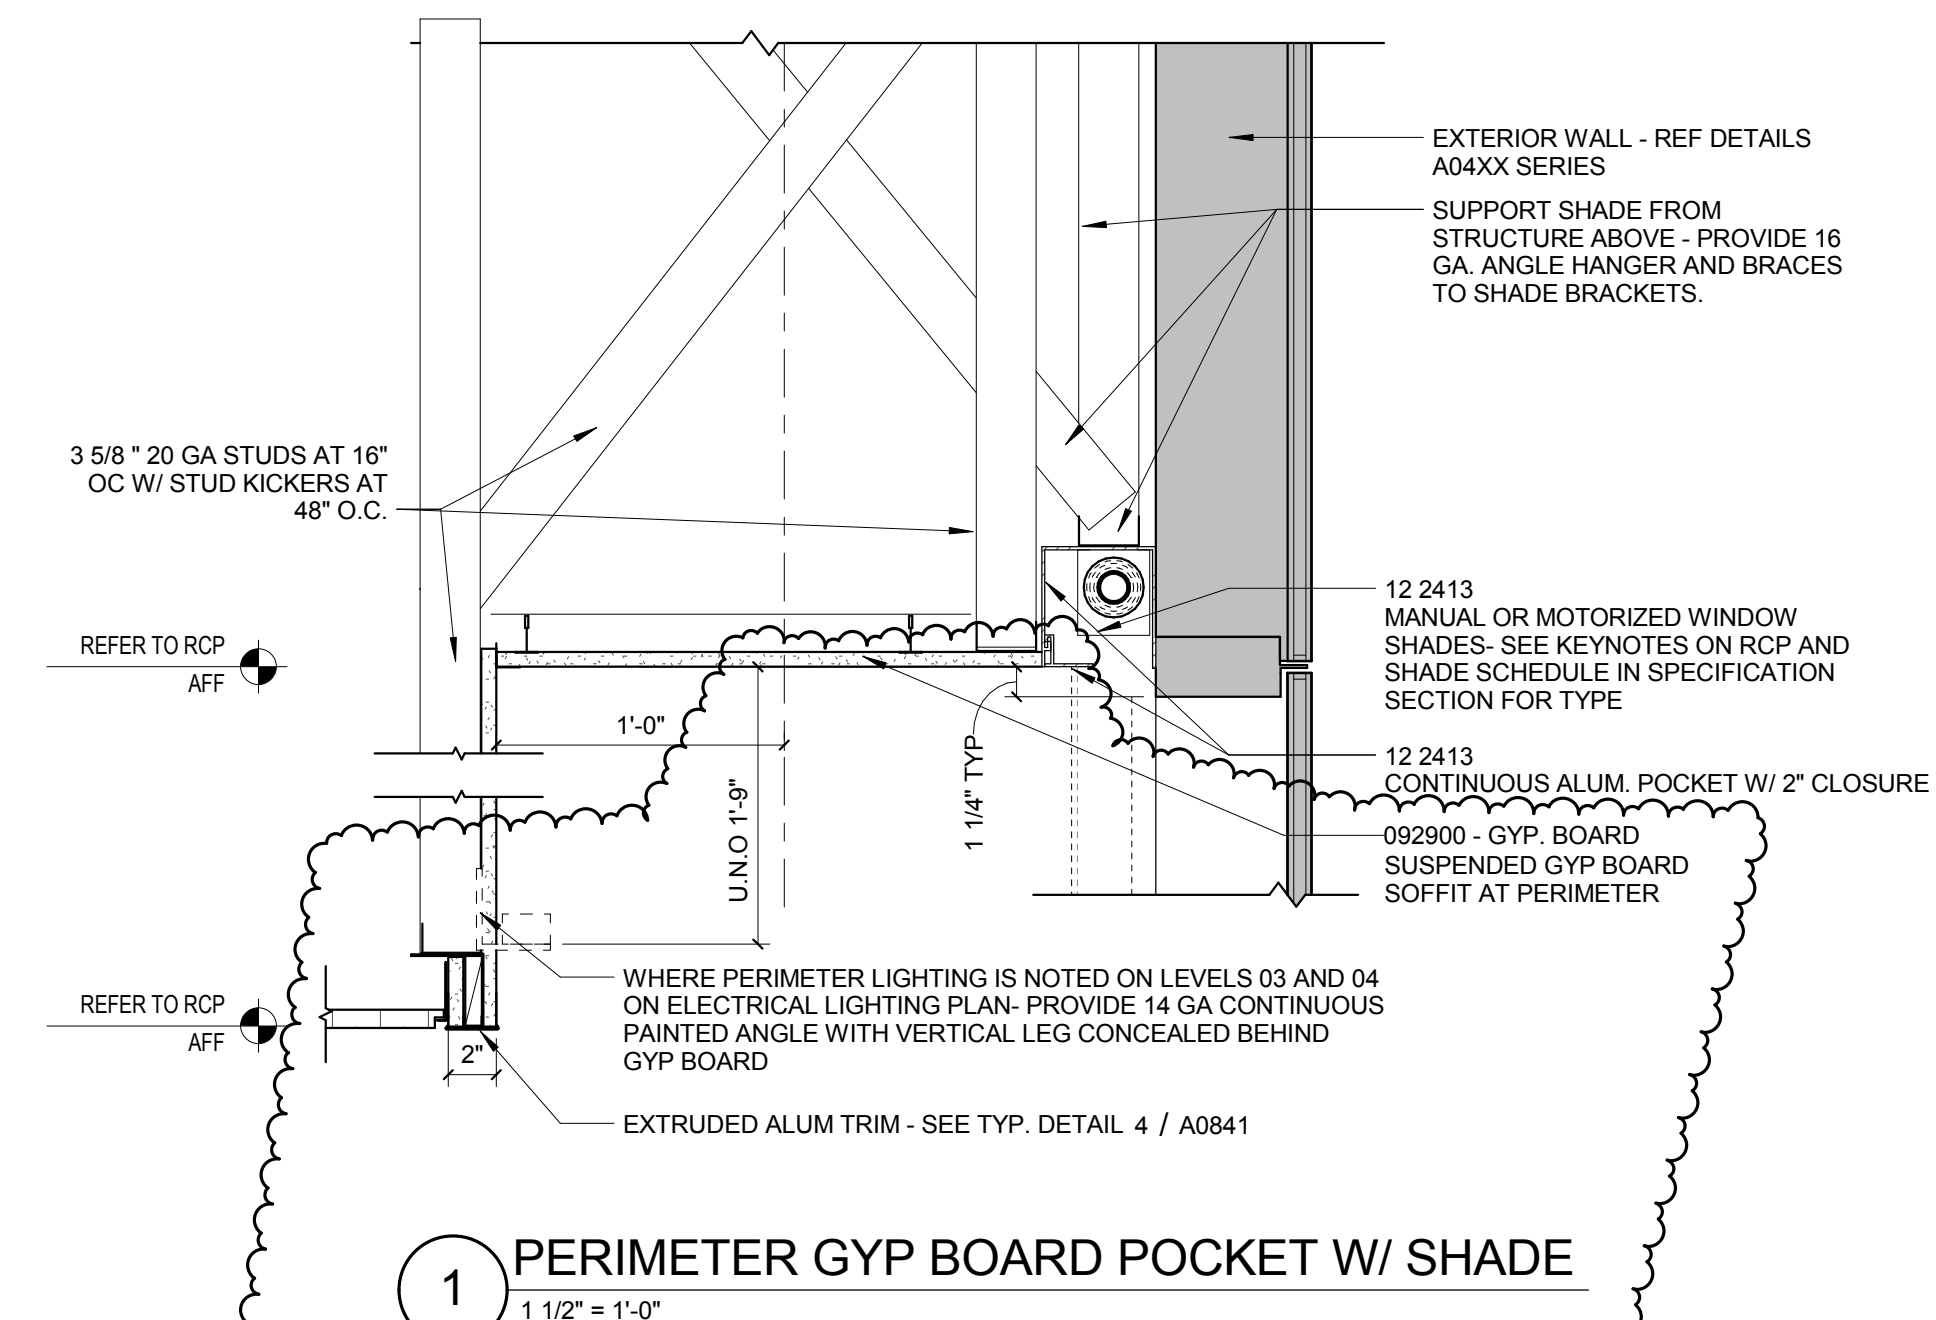

1 PERIMETER GYP BOARD POCKET W/ SHADE
1 1/2" = 1'-0"