




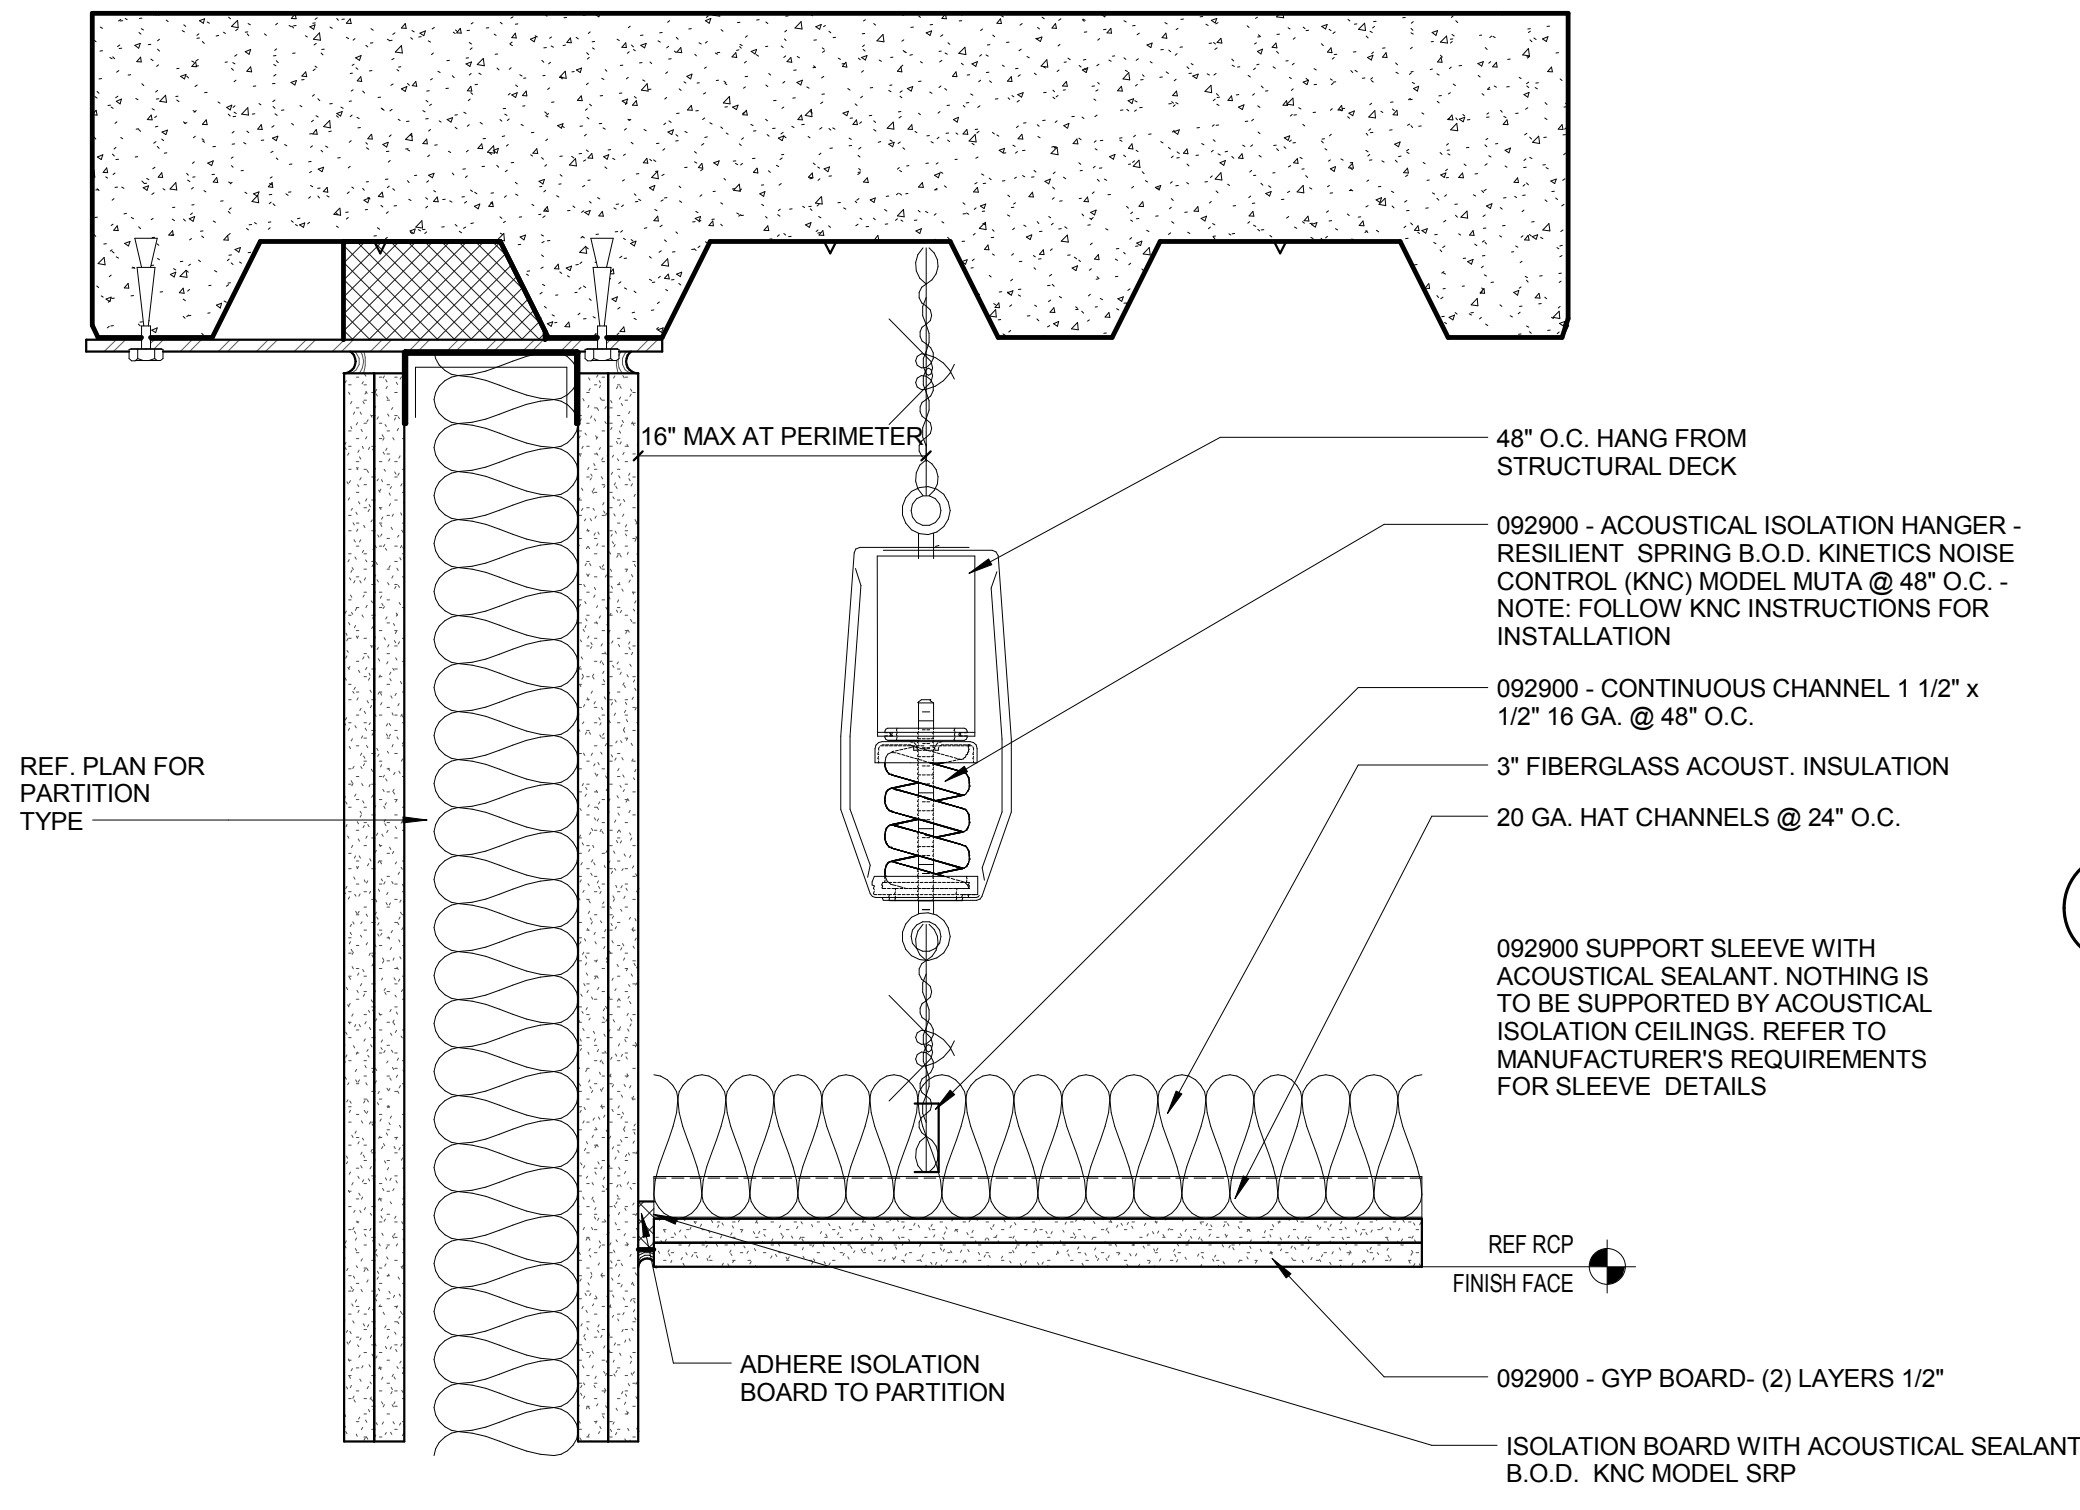


14 ACOUST. ISOLATION CEILING DETAIL
3" = 1'-0"

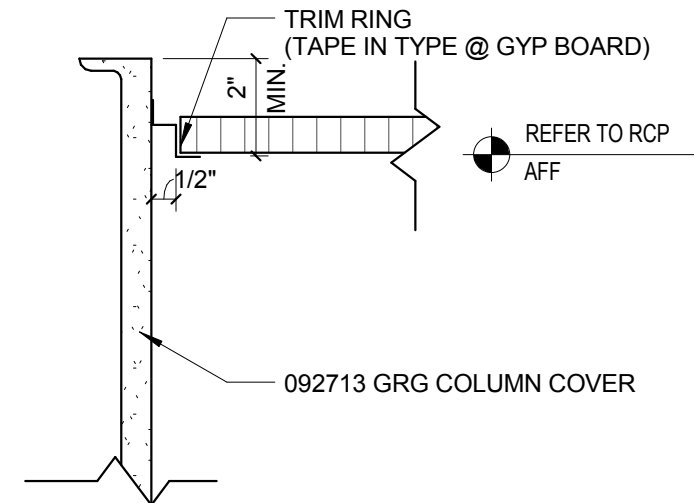


13 COLUMN COVER @ CEILING
3" = 1'-0"

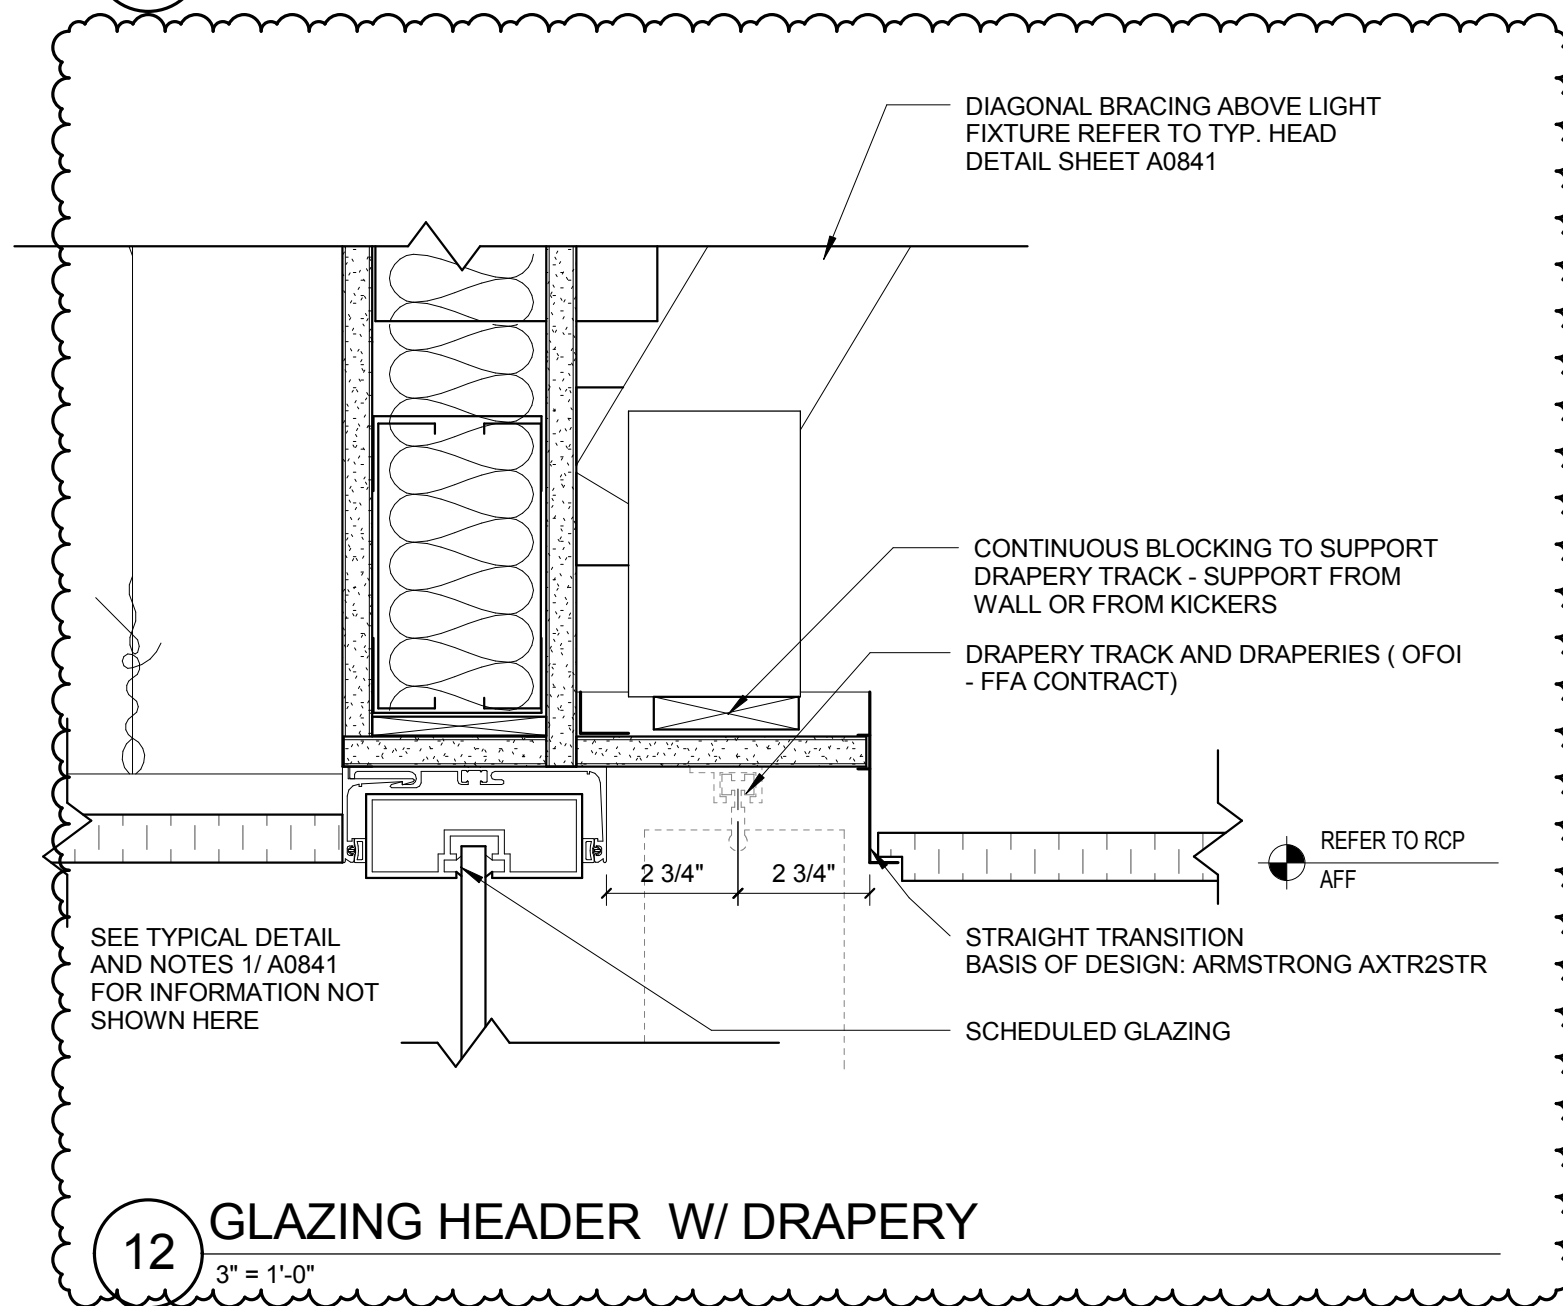


12 GLAZING HEADER W/ DRAPERY
3" = 1'-0"

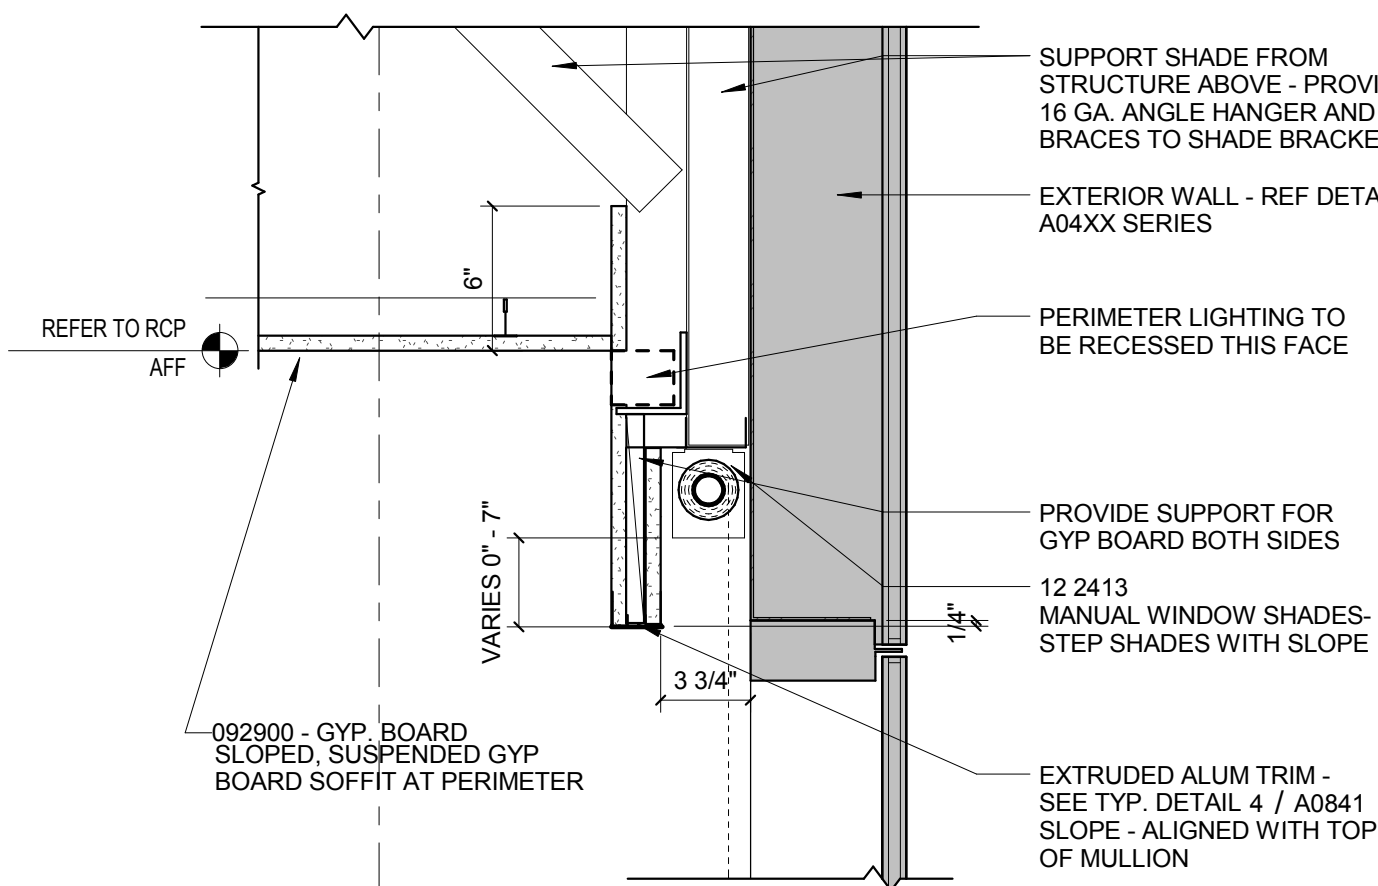


16 PERIMETER GYP BOARD LEVEL 04 AREA B
1 1/2" = 1'-0"

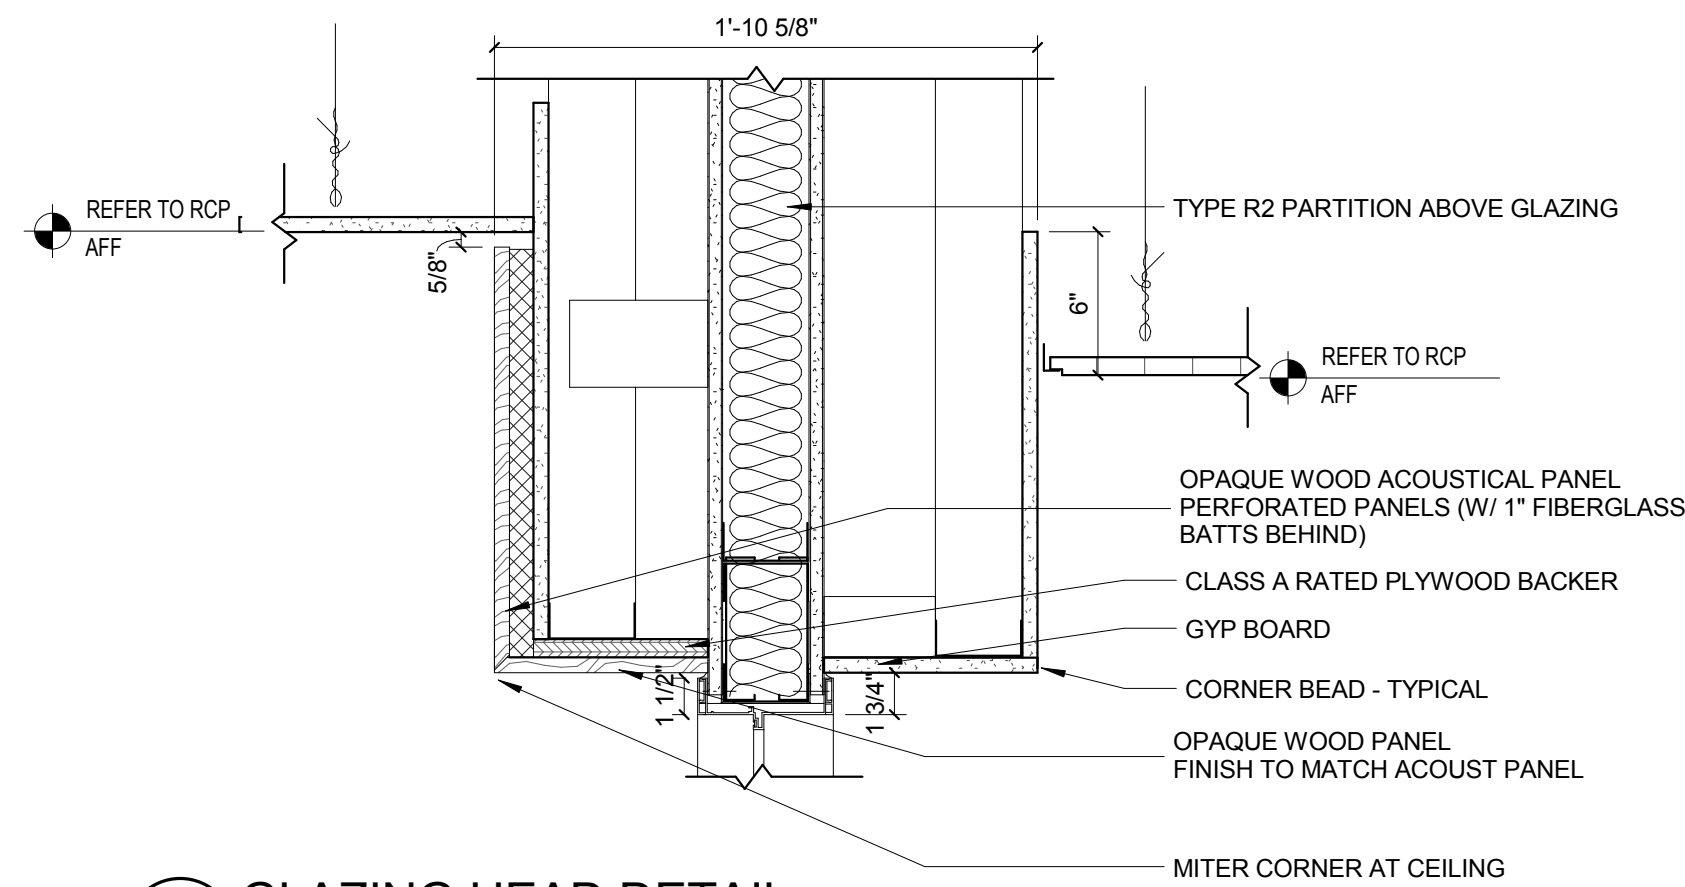


11 GLAZING HEAD DETAIL
1 1/2" = 1'-0"

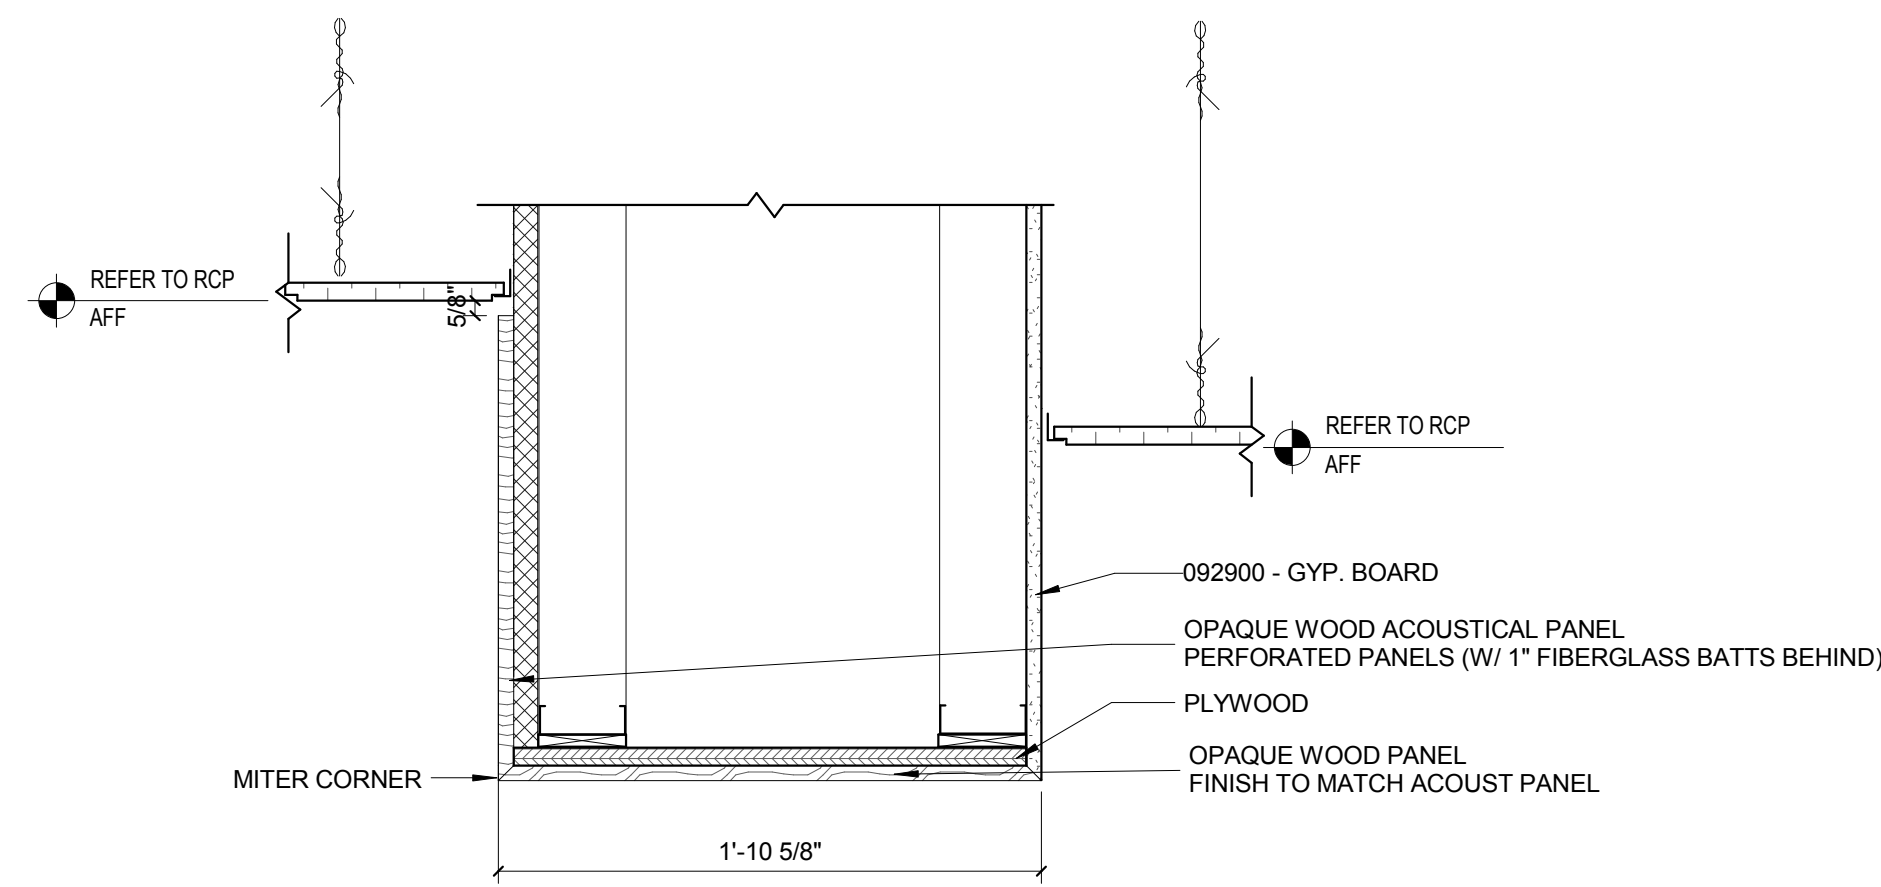


10 GYP TO WOOD PANEL TO GYP
1 1/2" = 1'-0"

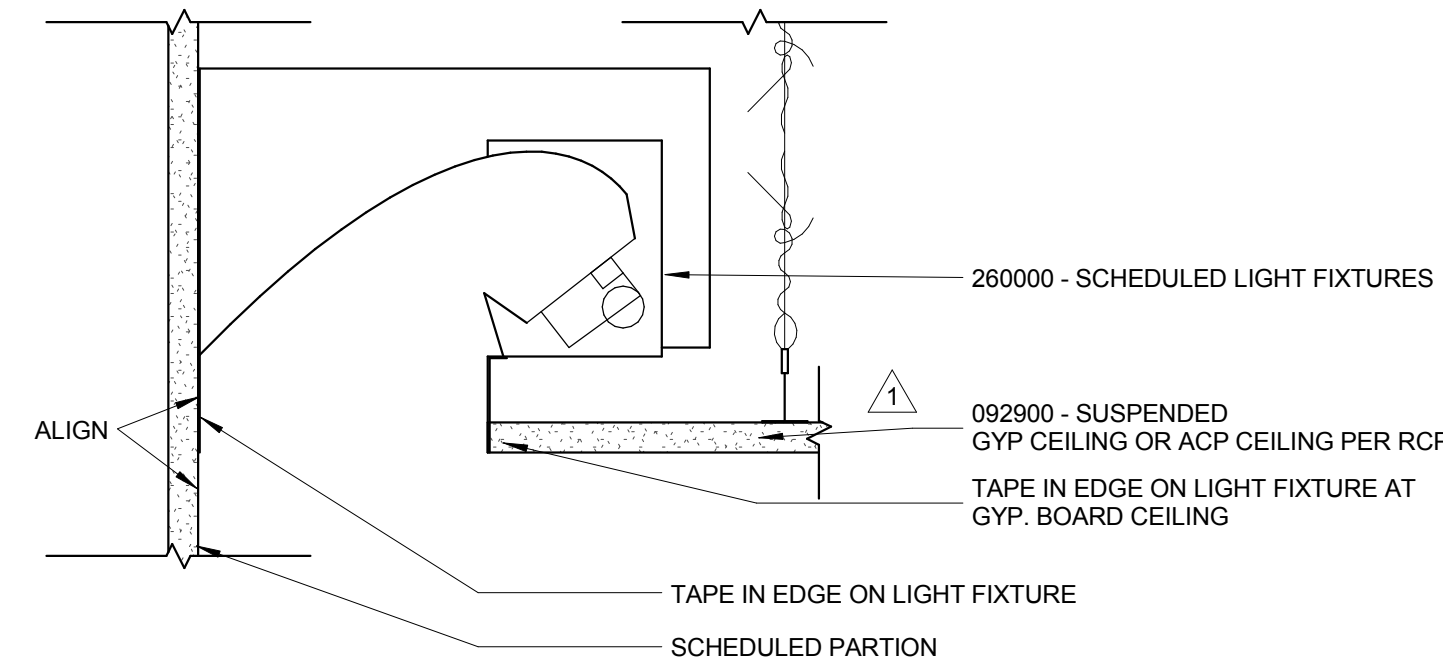


9 TYP PERIMETER LIGHTING DETAIL
3" = 1'-0"

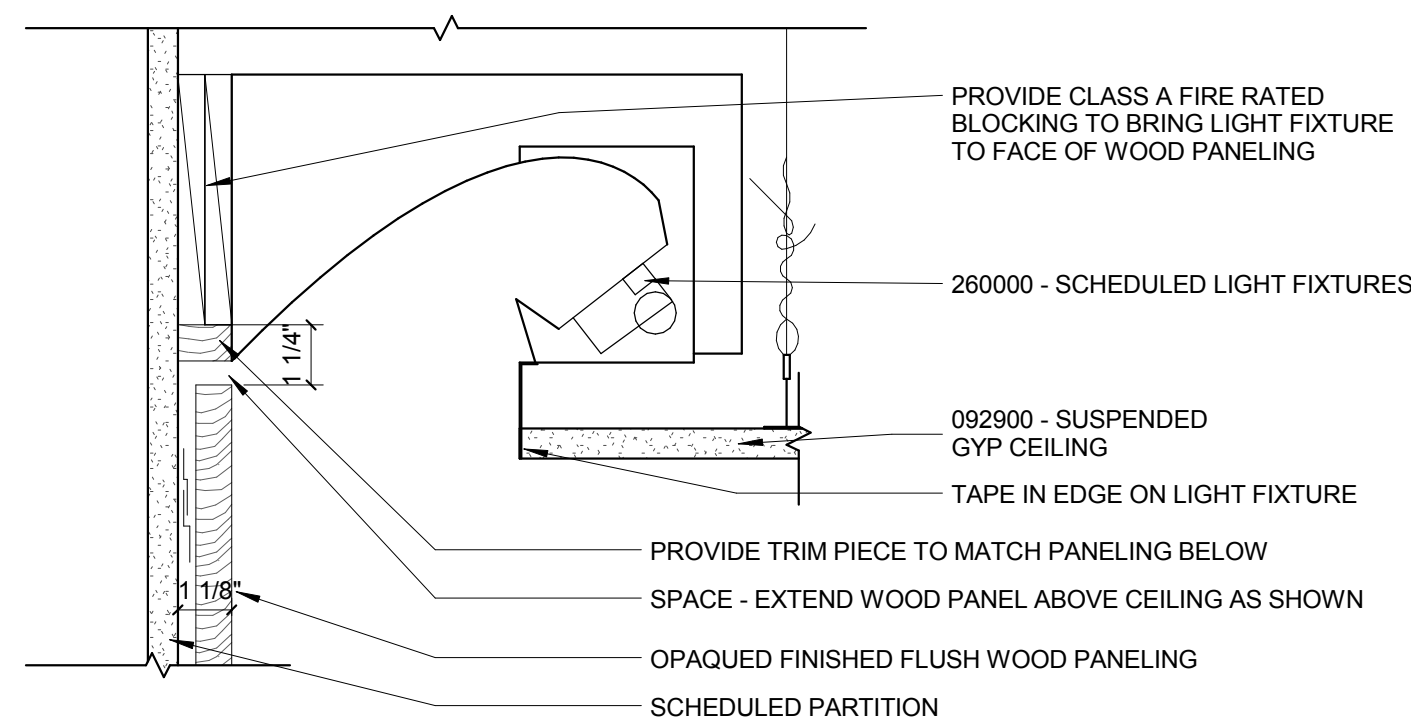


8 TYP PERIMETER LIGHTING DETAIL2
3" = 1'-0"

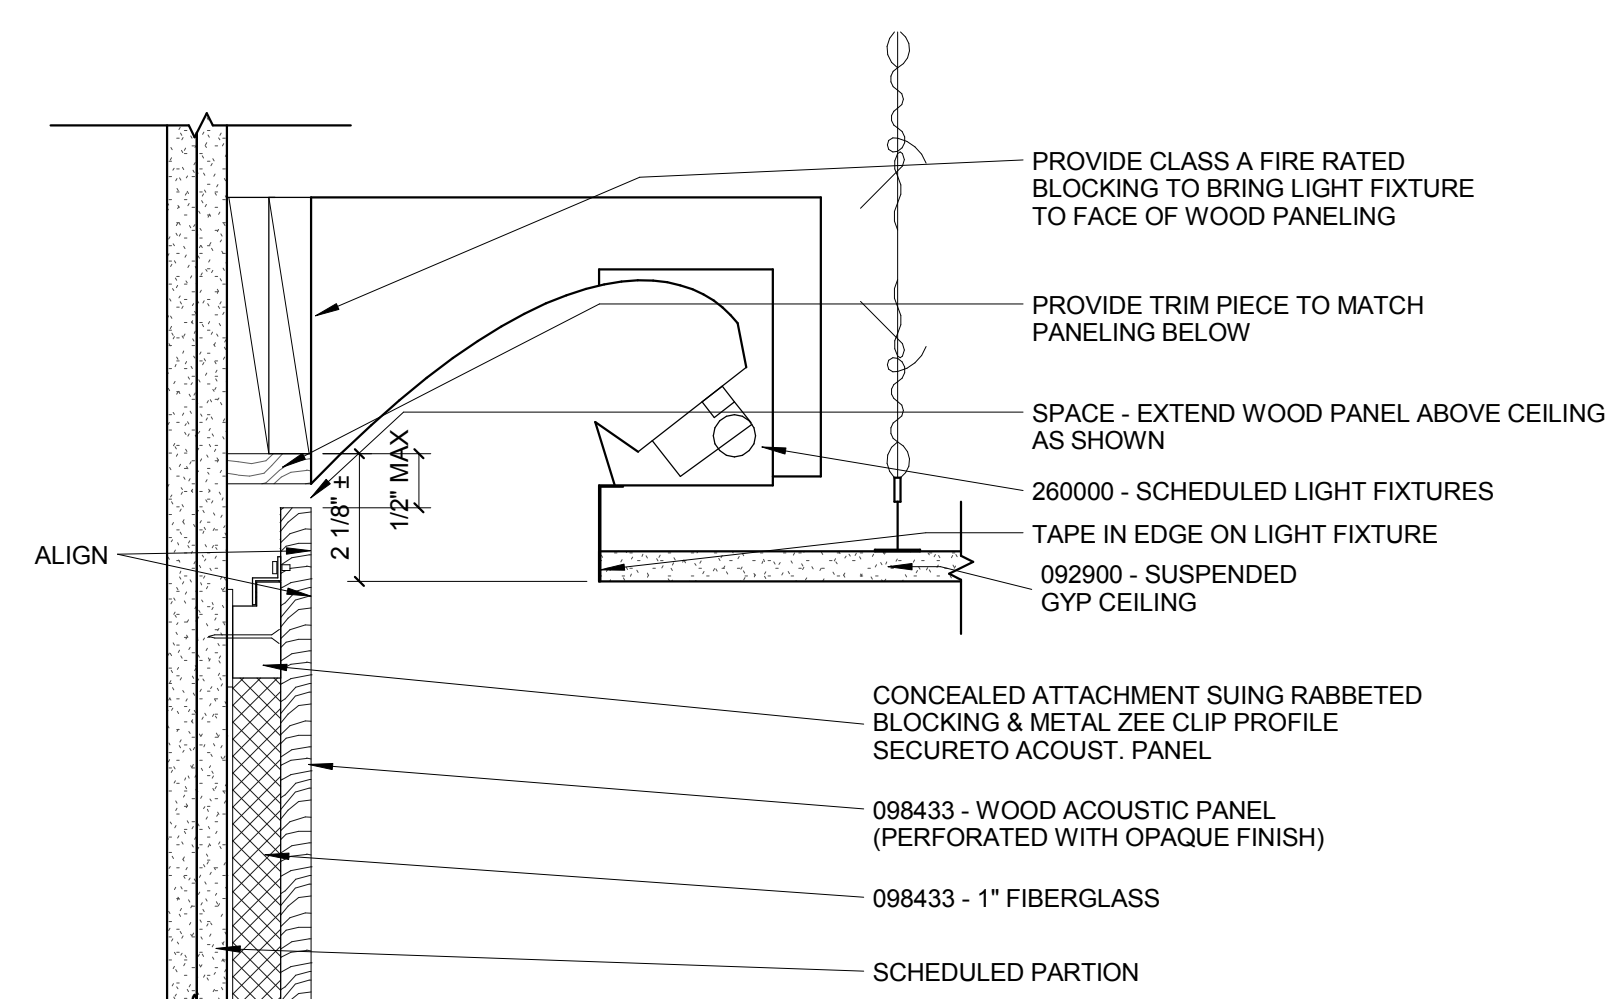


7 LECTURE HALL - N. WALL LIGHTING
3" = 1'-0"

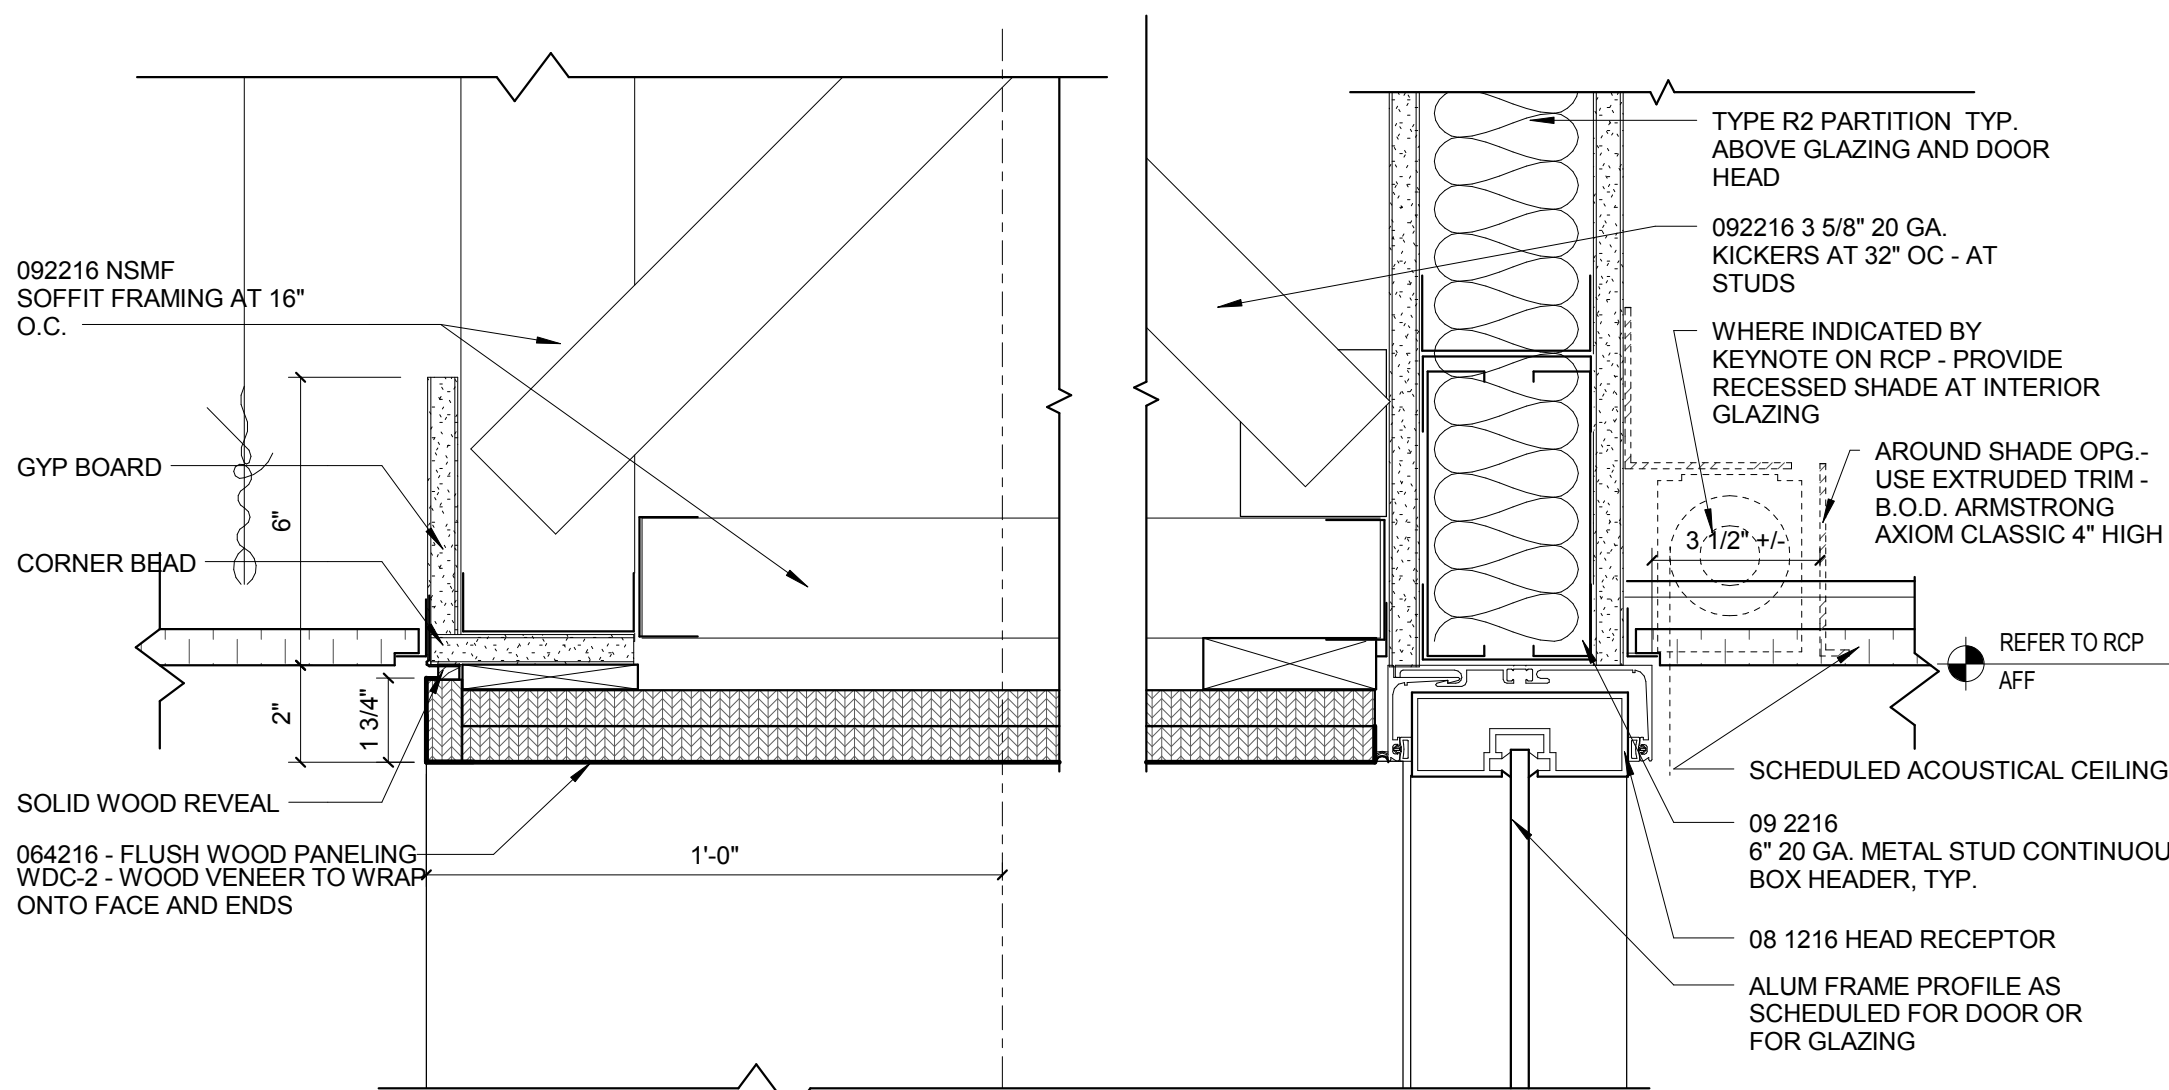


6 WOOD SOFFIT DETAIL
3" = 1'-0"

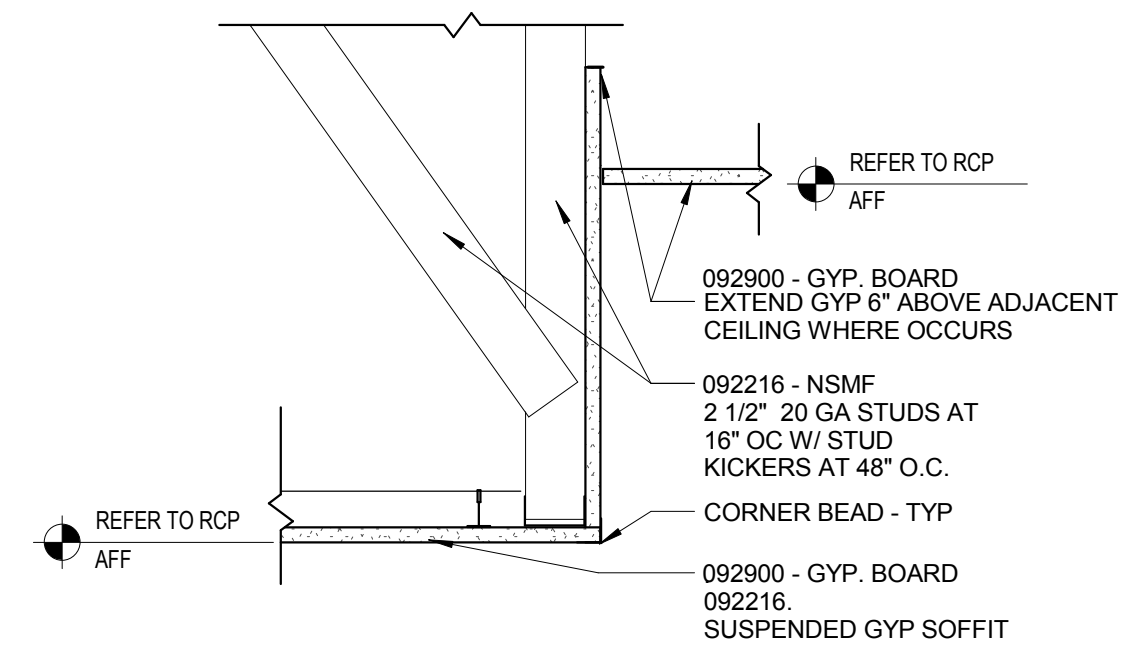


5 GWB EDGE/ CEILING HEIGHT TRANSITION
1 1/2" = 1'-0"

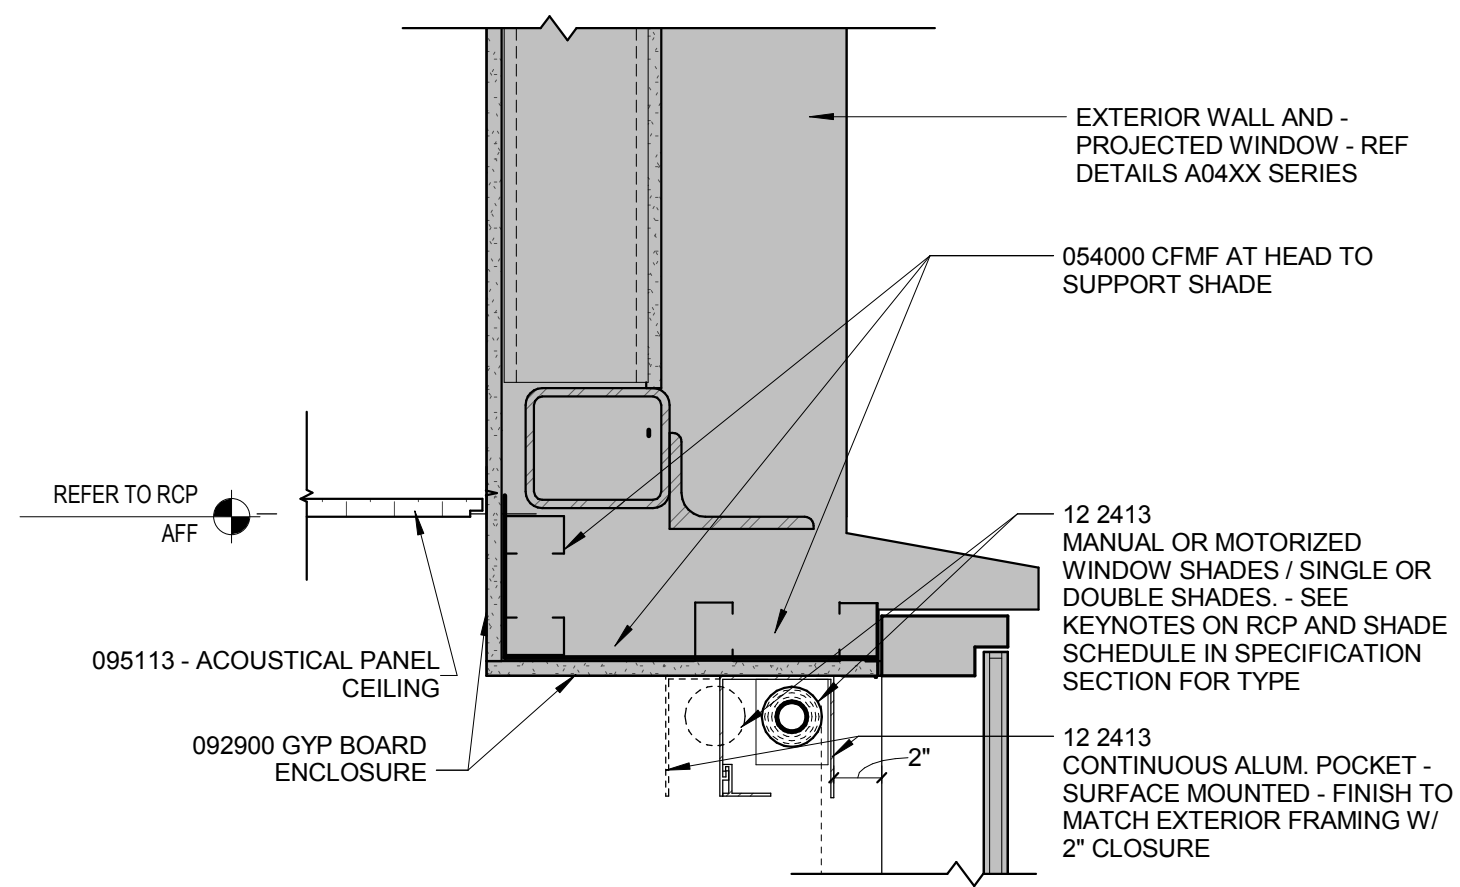


4 PROJECTED WINDOW SHADE - EAST SIDE
1 1/2" = 1'-0"

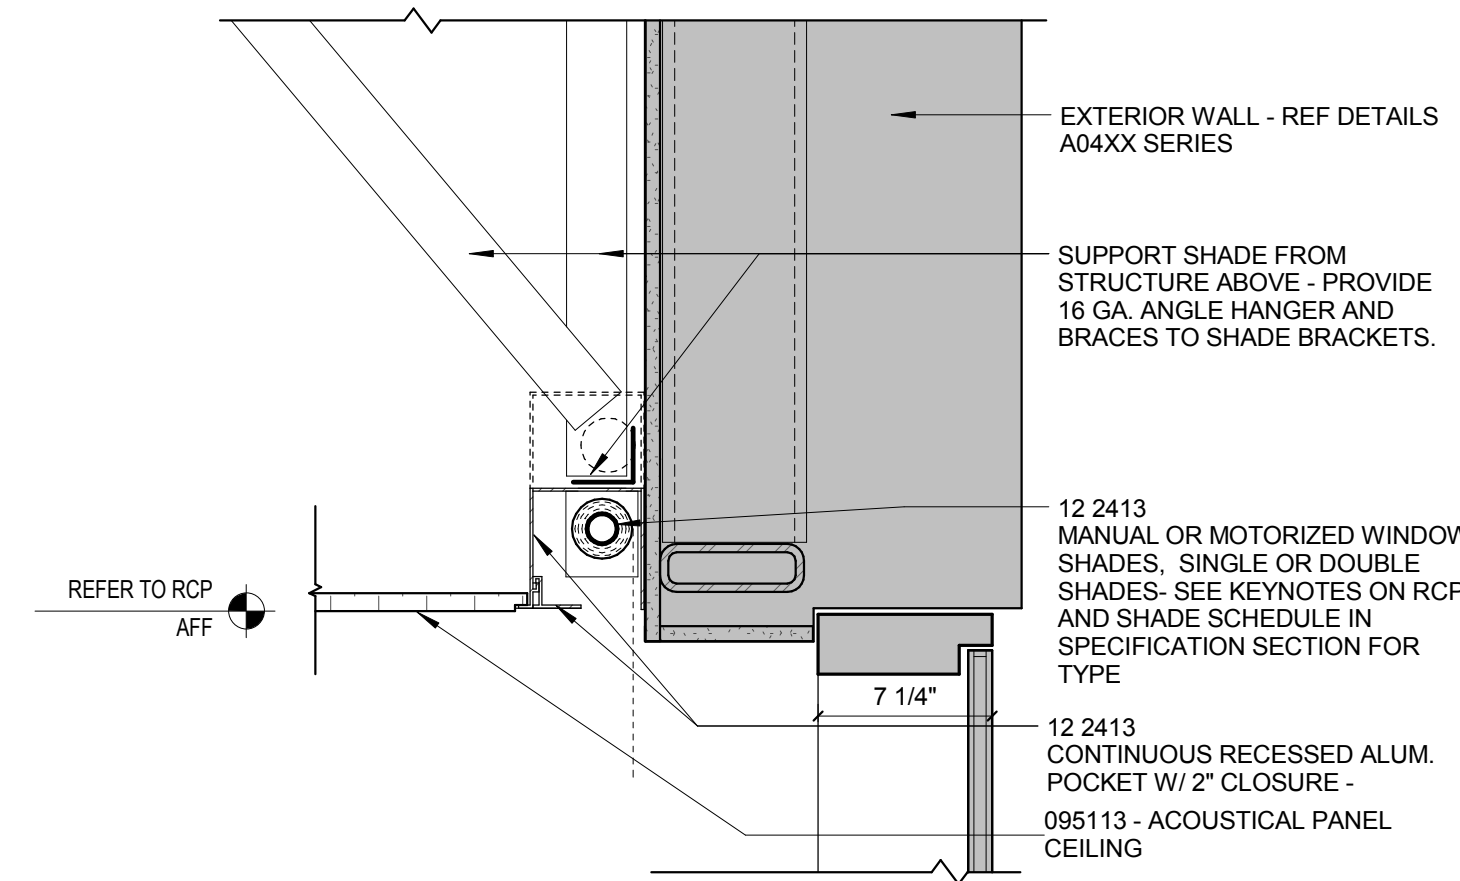

3 RECESSED SHADE - EAST SIDE
1 1/2" = 1'-0"

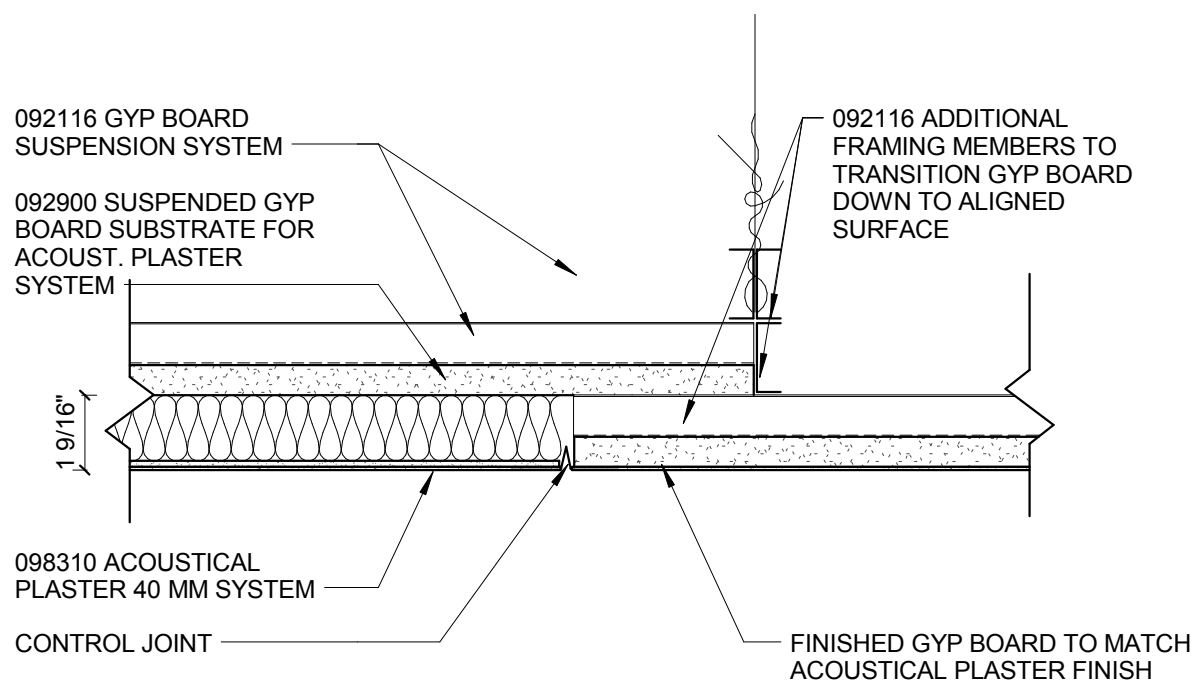

2 ACOUSTIC PLASTER TRANSITION AT JOINT
3" = 1'-0"

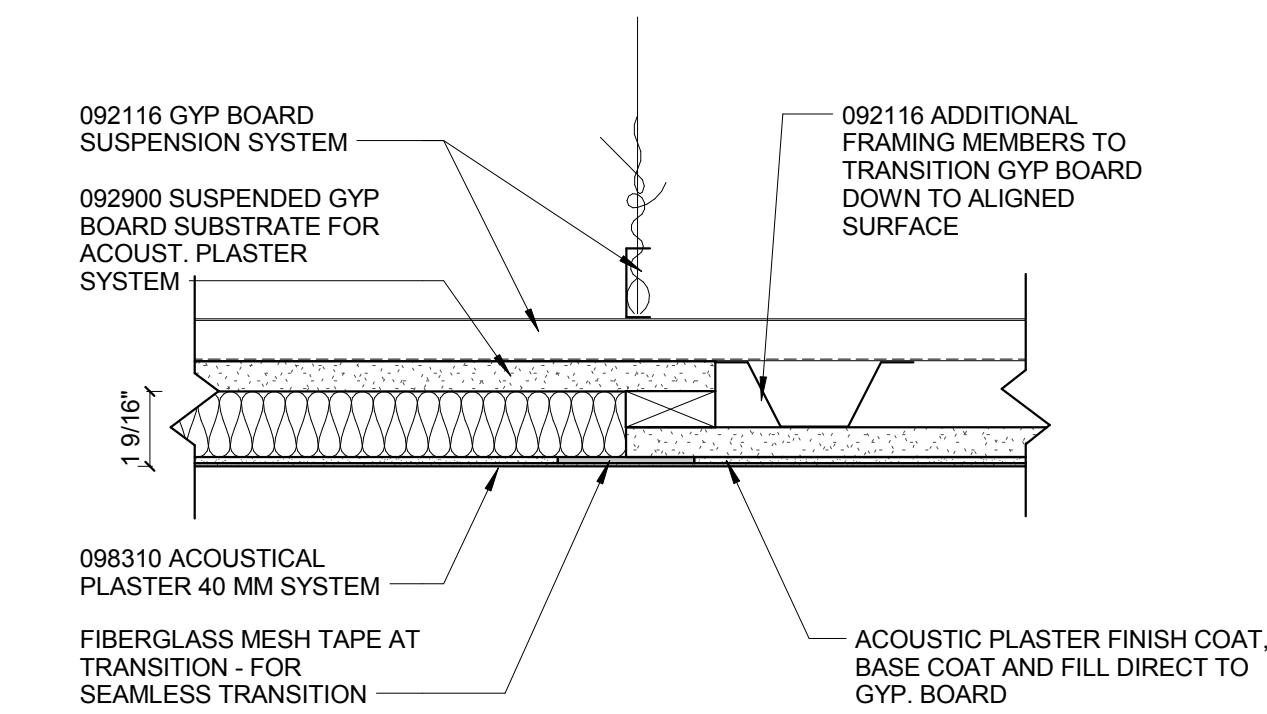

1 ACOUSTIC PLASTER SEAMLESS TRANSITION
3" = 1'-0"

2	ASI-012	12 JUL 2016
1	ADDENDUM 3-2	15 APR 2016
-	ISSUED FOR CONSTRUCTION (BP3)	15 MAR 2016
No.	Description	Date

Drawing Title:

INTERIOR CEILING
DETAILS

Project No.: 04561.01 Checked by:

A0842